

[illegible]



FED. ROAD DIST. NO.	STATE	FED. AID PROJ. NO.	FISCAL YEAR	SHEET NO.	TOTAL SHEETS
HAWAII	HAW.	TH-1 (7) 14	1974	1	61

STATE OF HAWAII
DEPARTMENT OF TRANSPORTATION
HIGHWAYS DIVISION
HONOLULU, HAWAII

INTERSTATE ROUTE H-1
"AS BUILT" PLANS
NORTH LEG ROADWAY SECTION (PAVING)

DEPARTMENT OF TRANSPORTATION
FEDERAL HIGHWAY ADMINISTRATION

DEPARTMENT OF TRANSPORTATION
STATE OF HAWAII

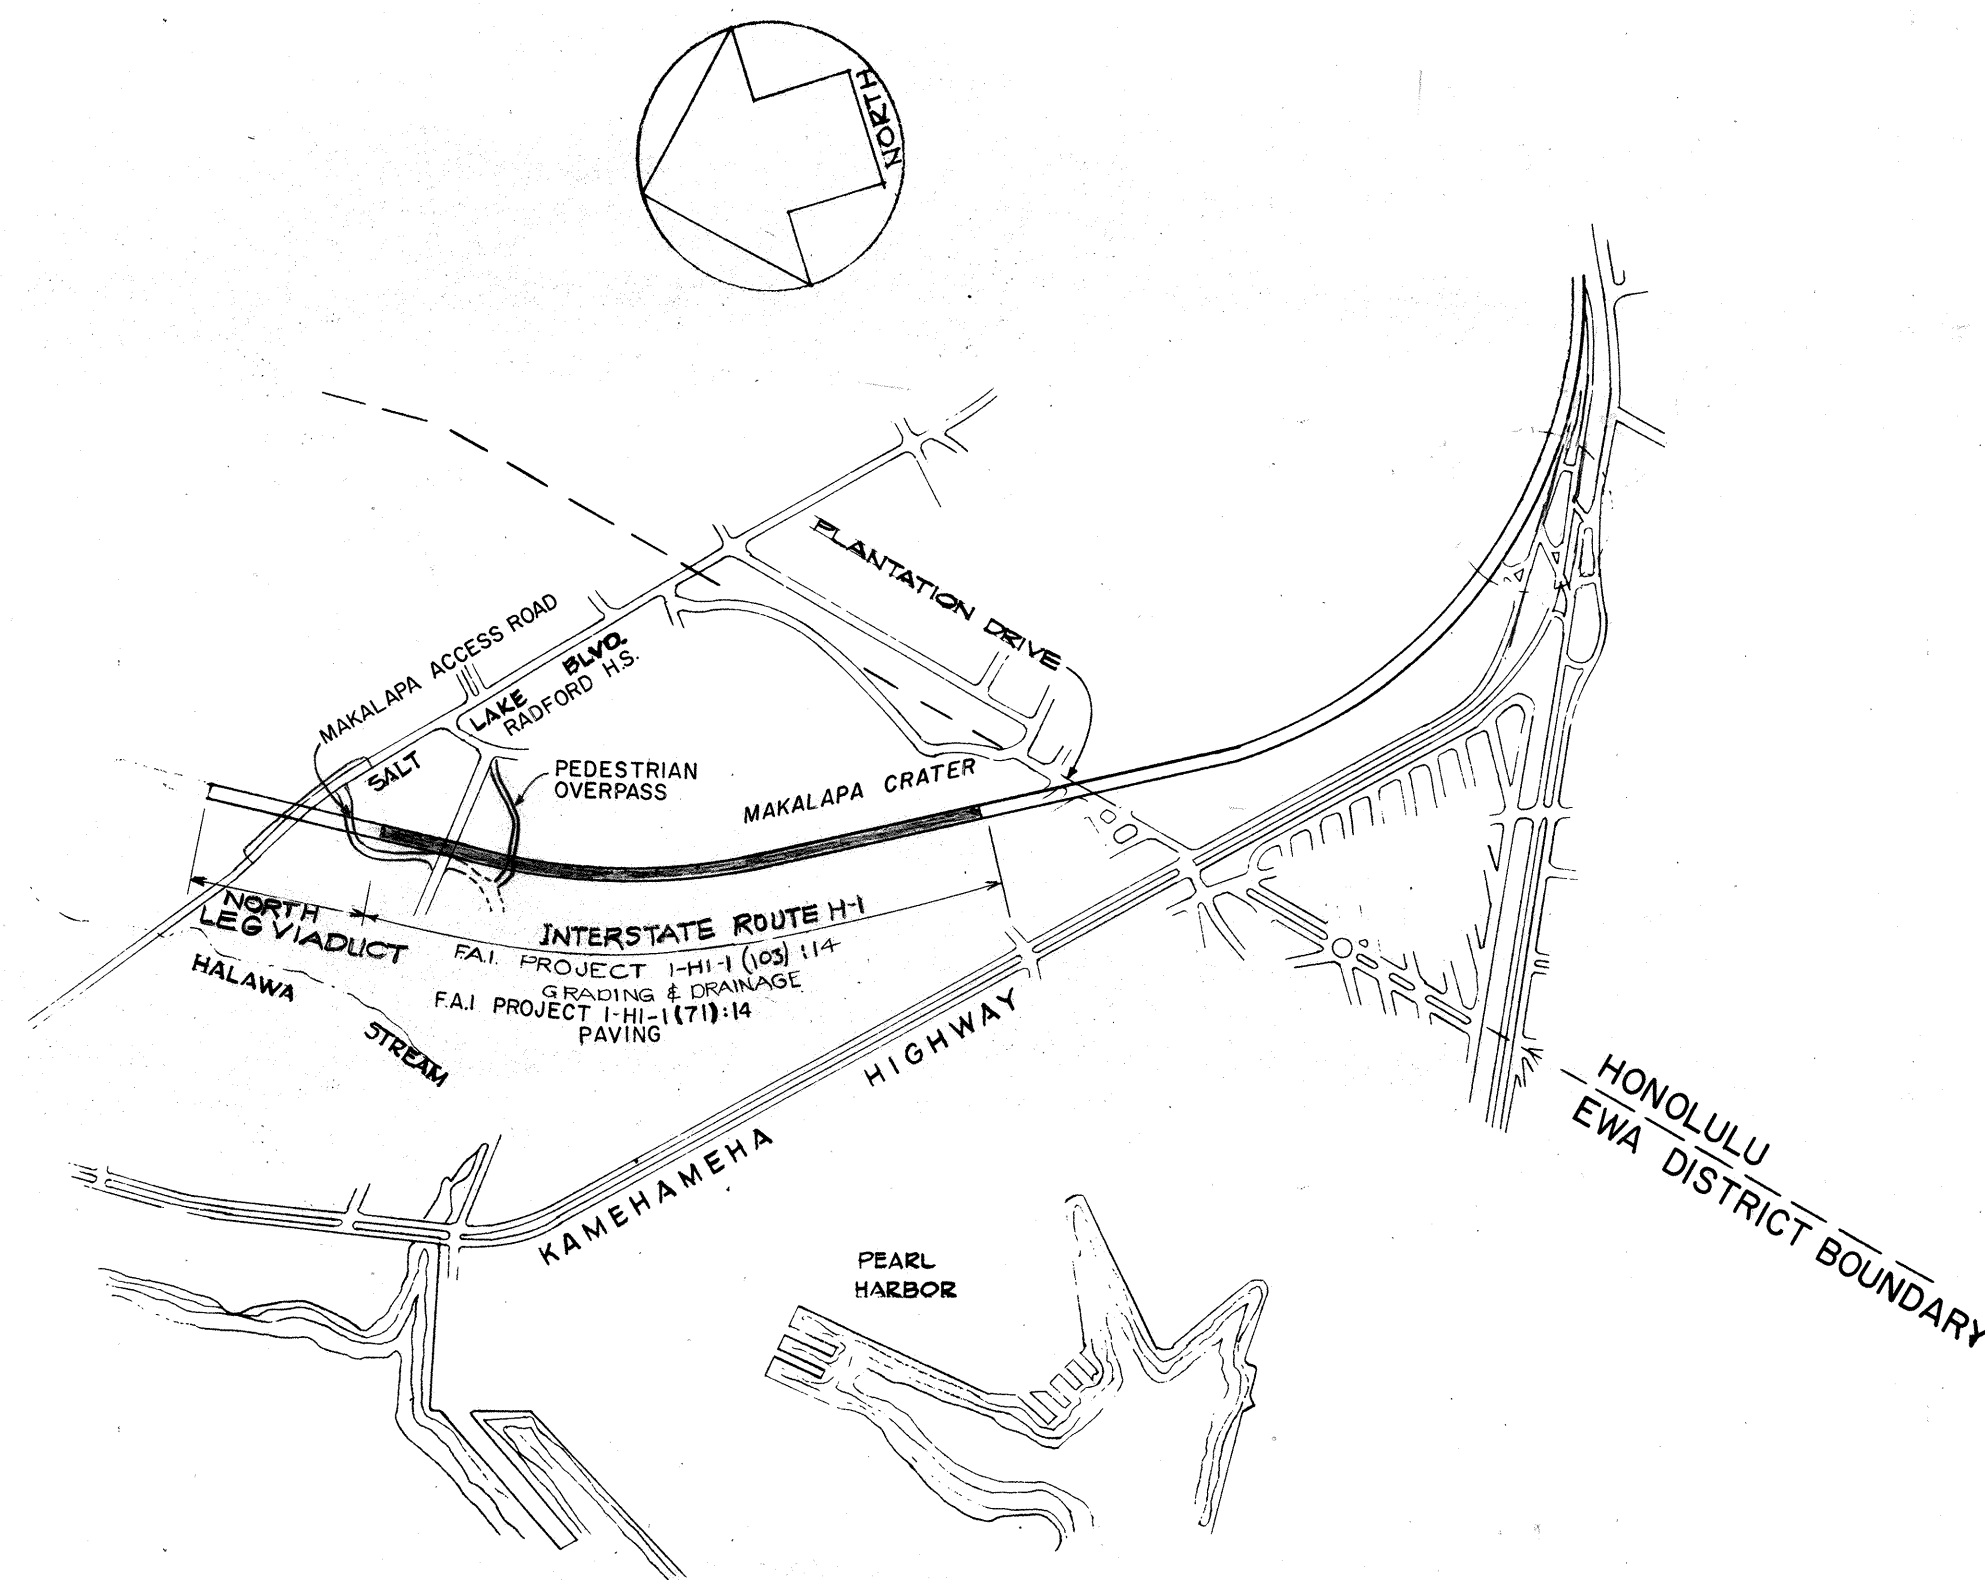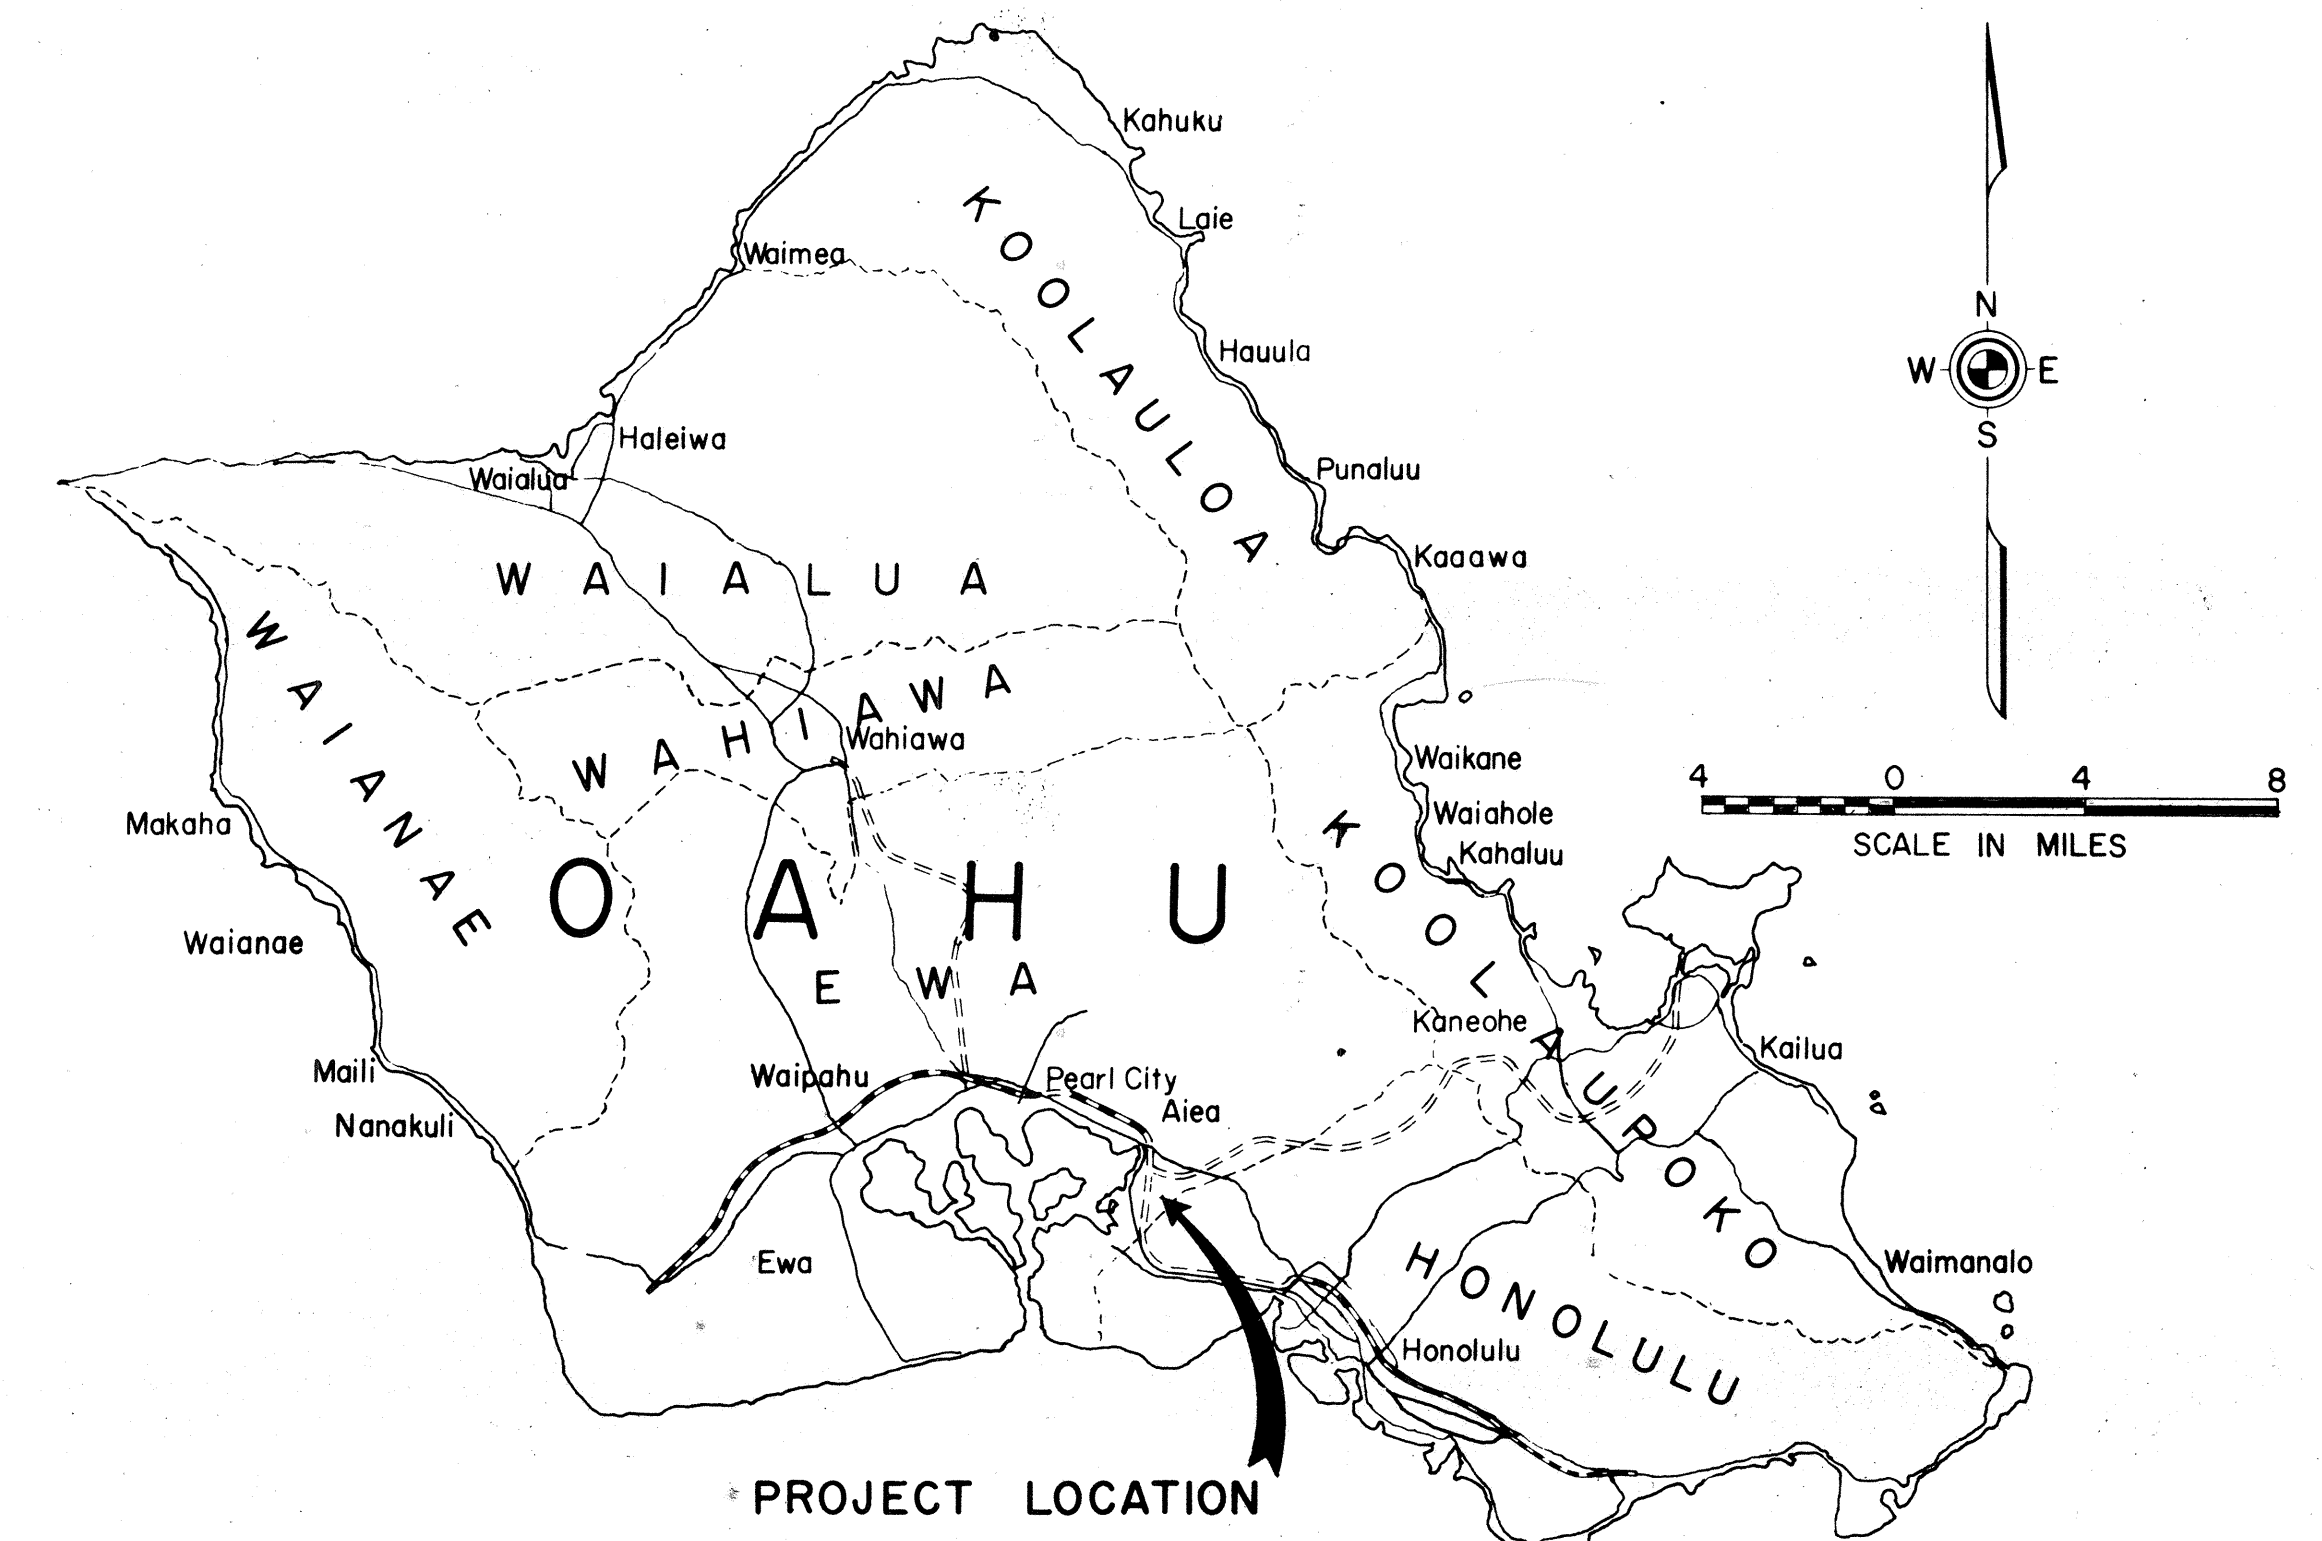

GROSS LENGTH OF PROJECT &
NET LENGTH OF ROADWAY 0.601 MI.

LAYOUT PLAN