


FED. ROAD DIST. NO.	STATE	FED. AID PROJ. NO.	FISCAL YEAR	SHEET NO.	TOTAL SHEETS
HAWAII	HAW.	I-HI-1(119)16	1975	32	200

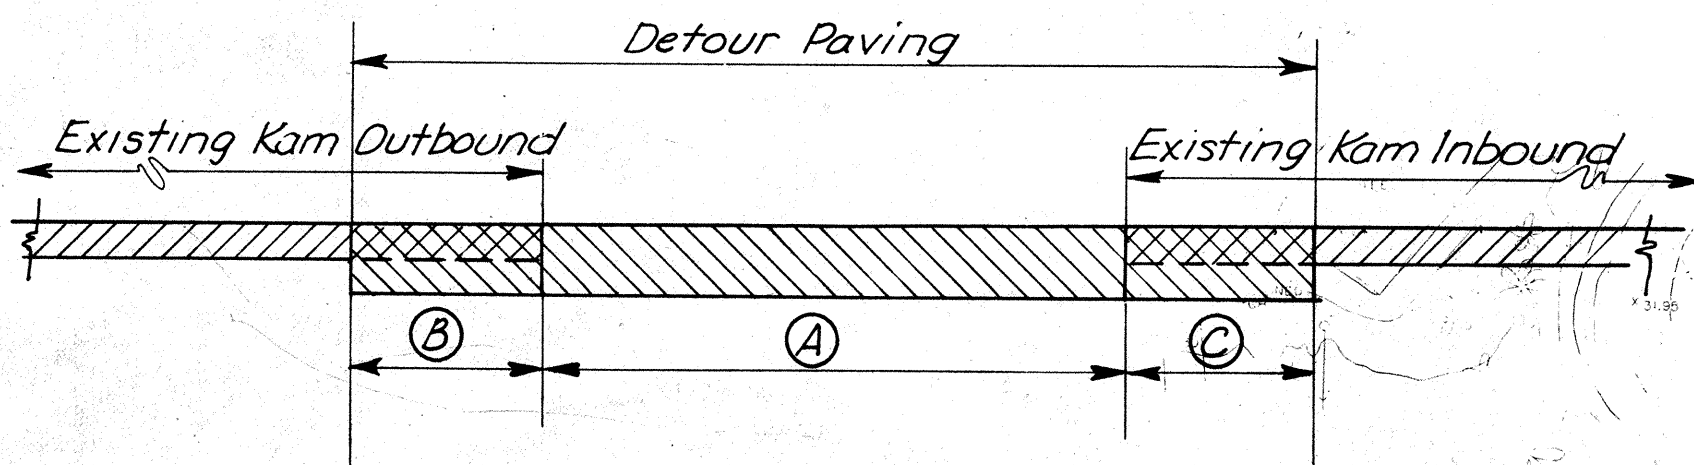


CONSTRUCTION PHASE I
 To Maintain Existing Traffic on Kam Hwy., the following Construction Sequence is recommended:

1. Construct Section A full length of project
2. Relocate Kam Outbound Traffic on Section A Pavement with temporary striping
3. Construct Section B full length of project
4. Relocate Kam Outbound Traffic on construction Phase II detour system with striping as shown on sheets 32, 33, & 34.
5. Construct Section C

See Sheets 3, 4, 6, 7 & 8 and Cross Sections for Paving Limits.

Note: Place Traffic Cones along edges of Cross-over lanes at 25 min intervals with Type II Barricades between Cones on outside curves

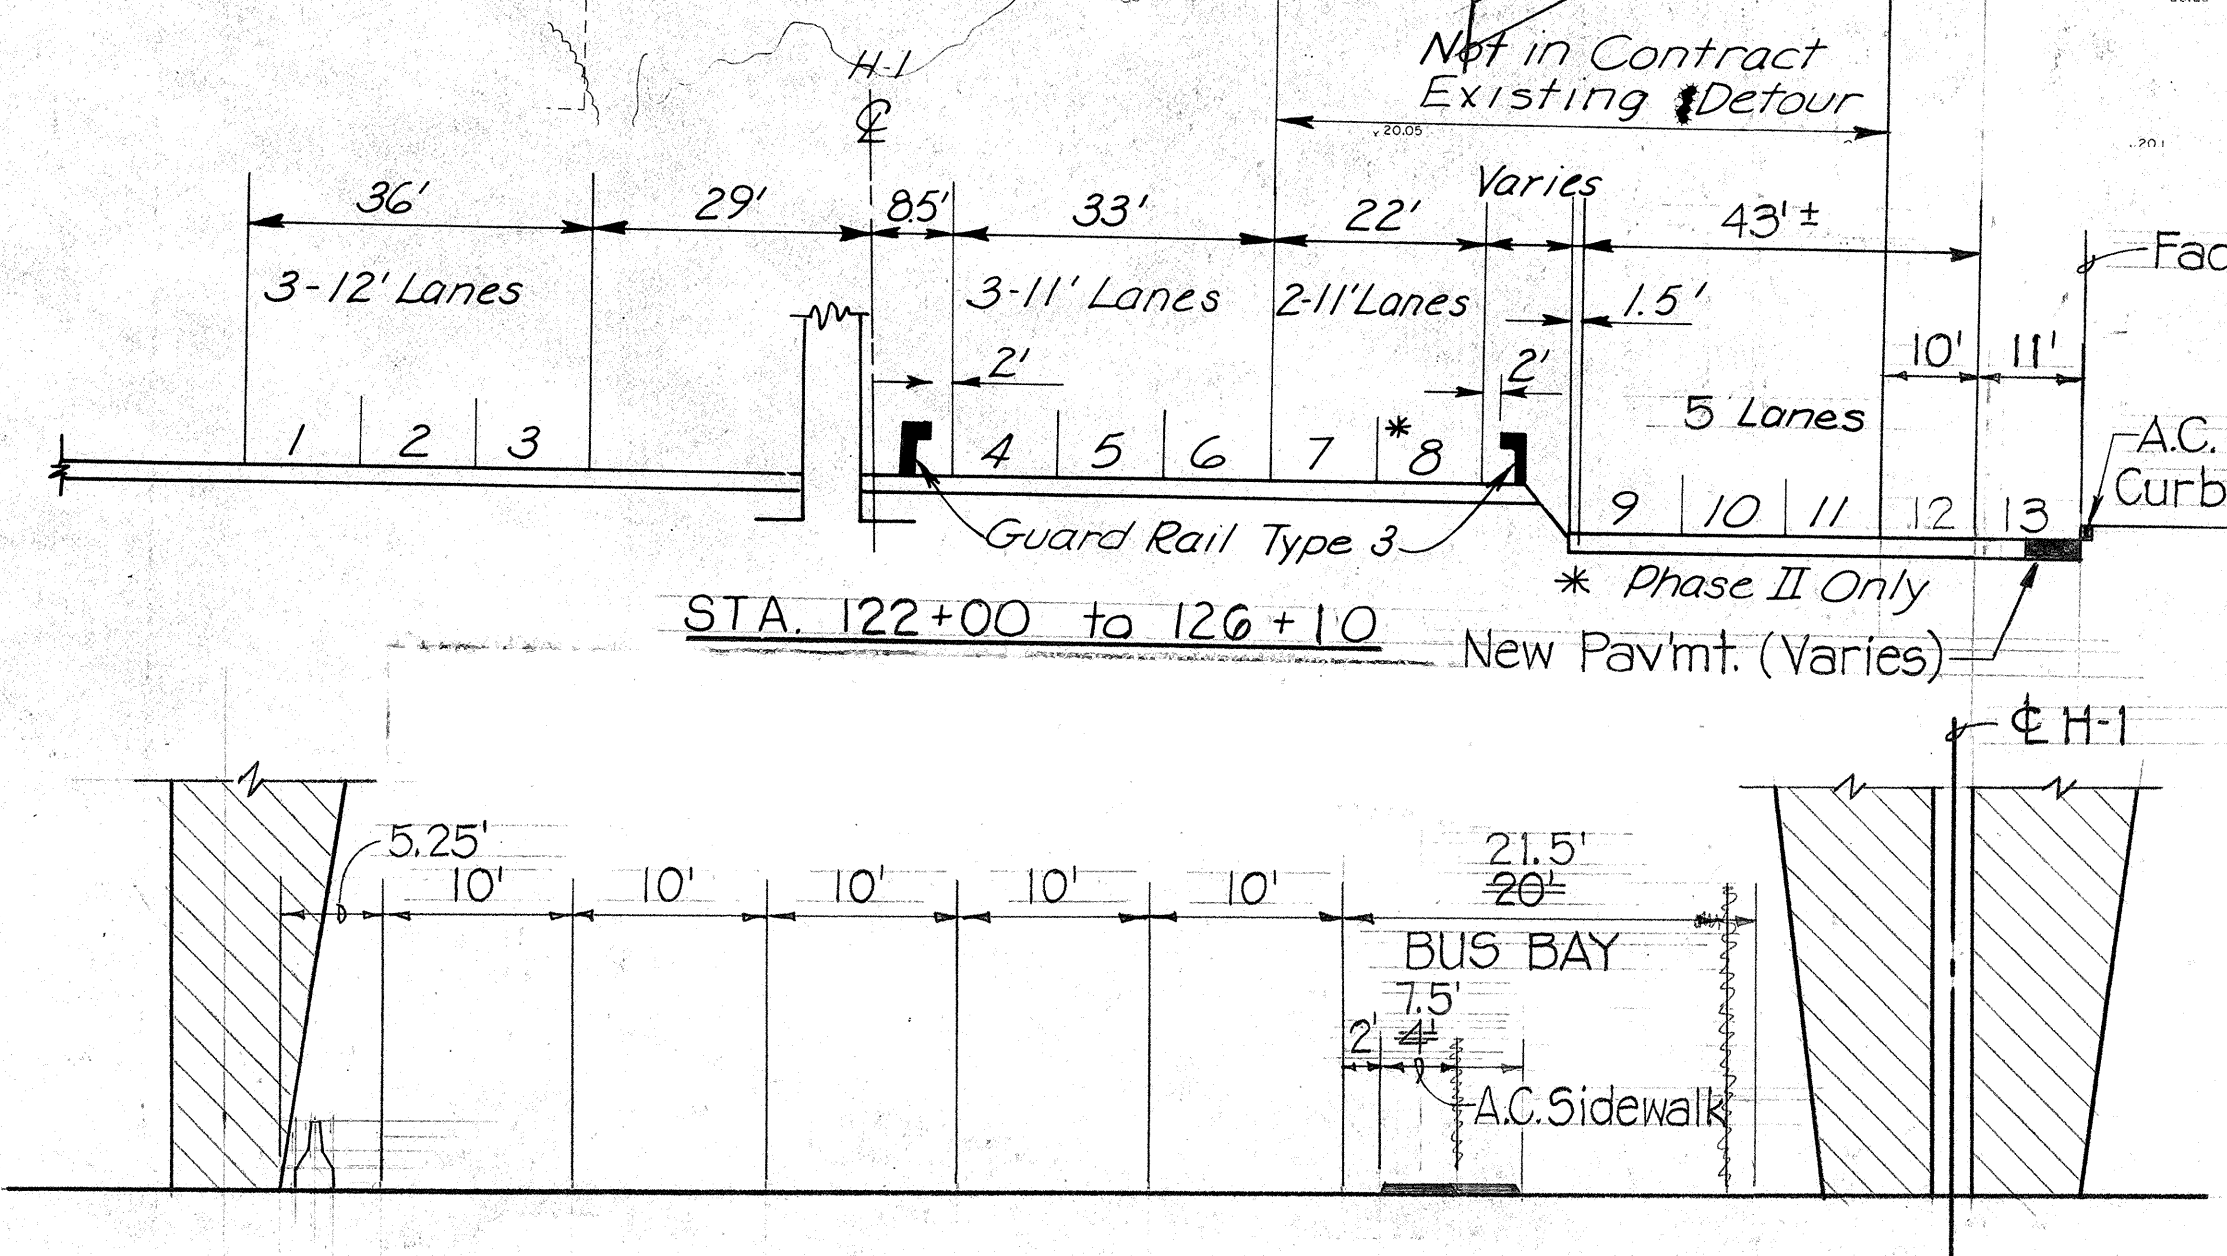

TYPICAL SECTION UNDER VIADUCT

LEGEND

Typ. Traffic Cones, Tubular, 50'(tangent) 25'(curve)

New Guard Rail Type 3 Single

Existing Guard Rail Type 3 Single

New or Relocated Traffic Sign

4" White Lane Stripe -Type C Reflector

4" White Approach Stripe Type C Reflector

Type II Barricades with Tubular Traffic Cones

Pavement Arrow

State Furnished Pole with Luminaire and Bracket.

CONTRACT CHANGE ORDER NO. 45

NEWS SIGNS

W12-1 RM-9 Phase III

W1-4(R)A Phase III

- NOTES:**
1. Remove and Salvage all Signs along Kamehameha Hwy. as directed by the Engineer
 2. All Signs, Striping & Guard Rail indicated as existing will be placed during Project I-HI-1(118):16 and shall remain during Project I-HI-1(119):16 unless otherwise noted.
 3. Those signs indicated as existing which are to be removed but not reset shall be stored as directed by the Engineer.
 4. All Tubular Traffic Cones placed during Project I-HI-1(118):16 which are not used in place or relocated during Project I-HI-1(119):16 shall be removed and stored as directed by the Engineer.

**STATE OF HAWAII
DEPARTMENT OF TRANSPORTATION
HIGHWAYS DIVISION**

**CONSTRUCTION DETOUR
PHASES I, II & III**

AIRPORT INTERCHANGE
F.A.I. PROJ. NO. I-HI-1(119):16

SCALE: 1"=50' DATE: FEB. 1, 1975




SHEET No. 1 OF 4 SHEETS

CONTRACT CHANGE ORDER NO. 30

Edward C. Stevenson

DATE	_____
SURVEY PLANNED BY	_____
DRAWN BY	_____
DESIGNED BY	_____
CHECKED BY	_____
ORIGINAL PLAN	_____
NOTE BOOK	_____
No.	_____

1. Construction of adapters for impact attenuators and placement of attenuators to be done by others
2. Placement of concrete guard rails to be done by others.

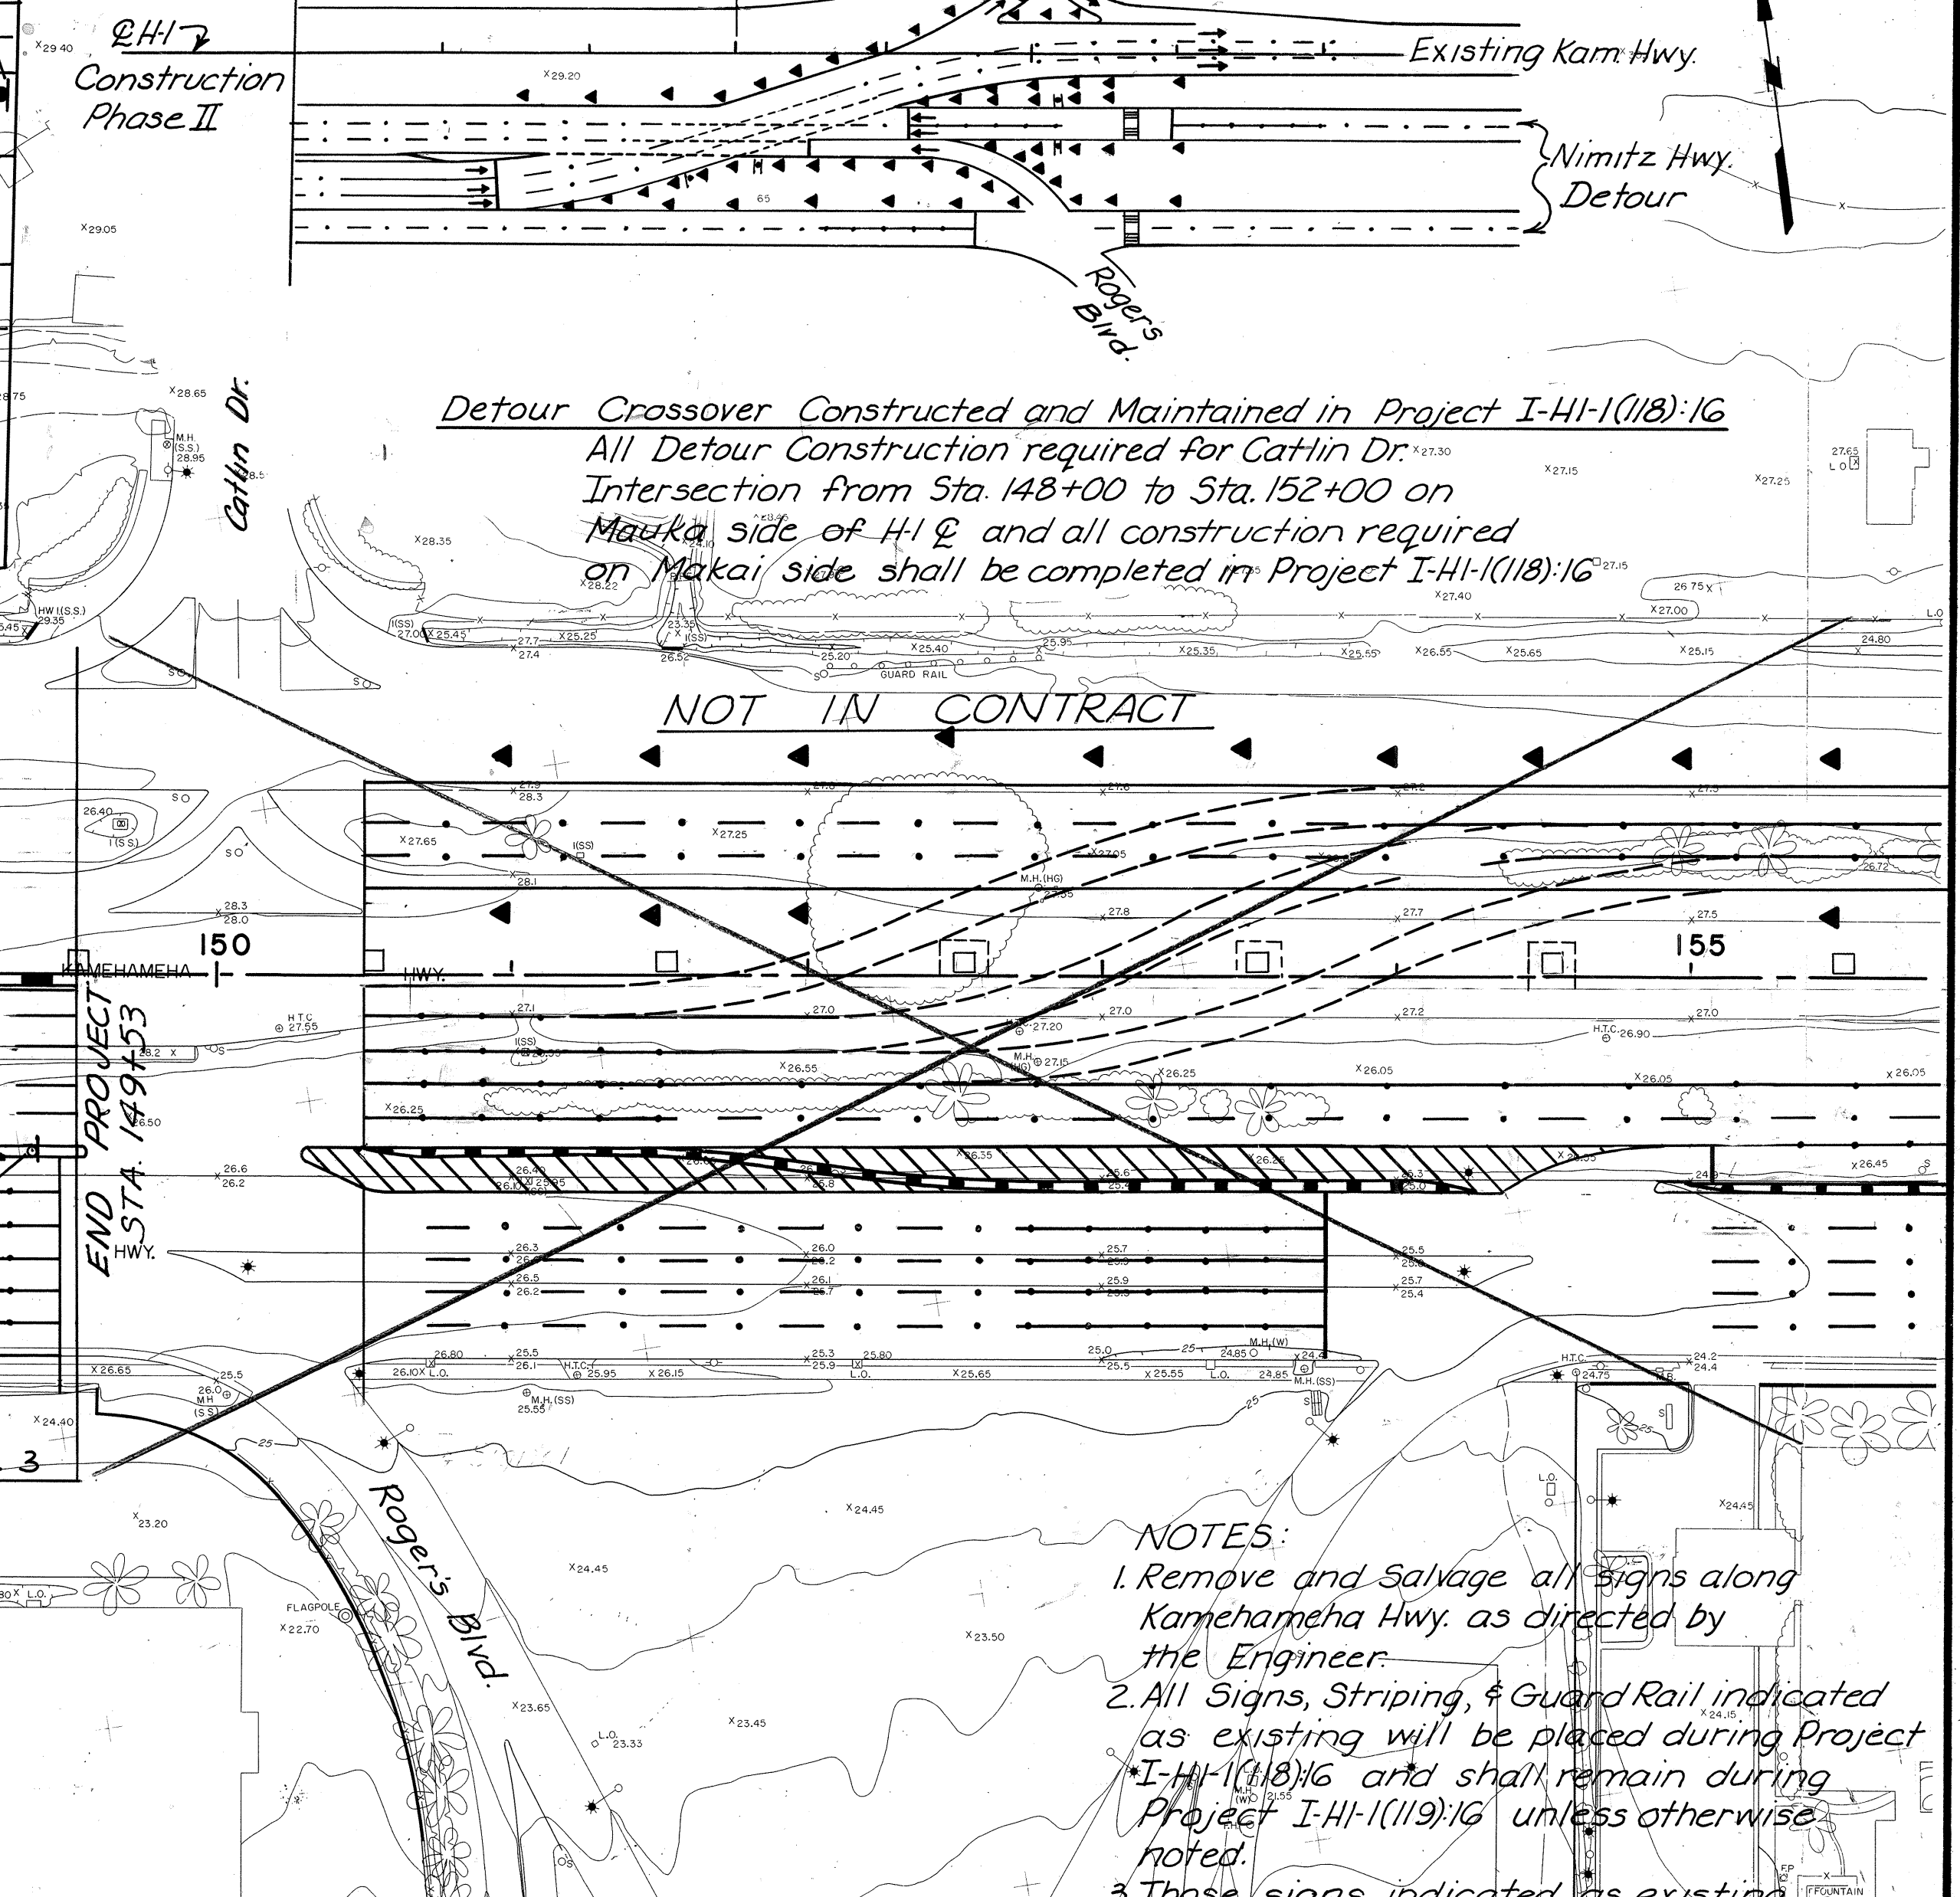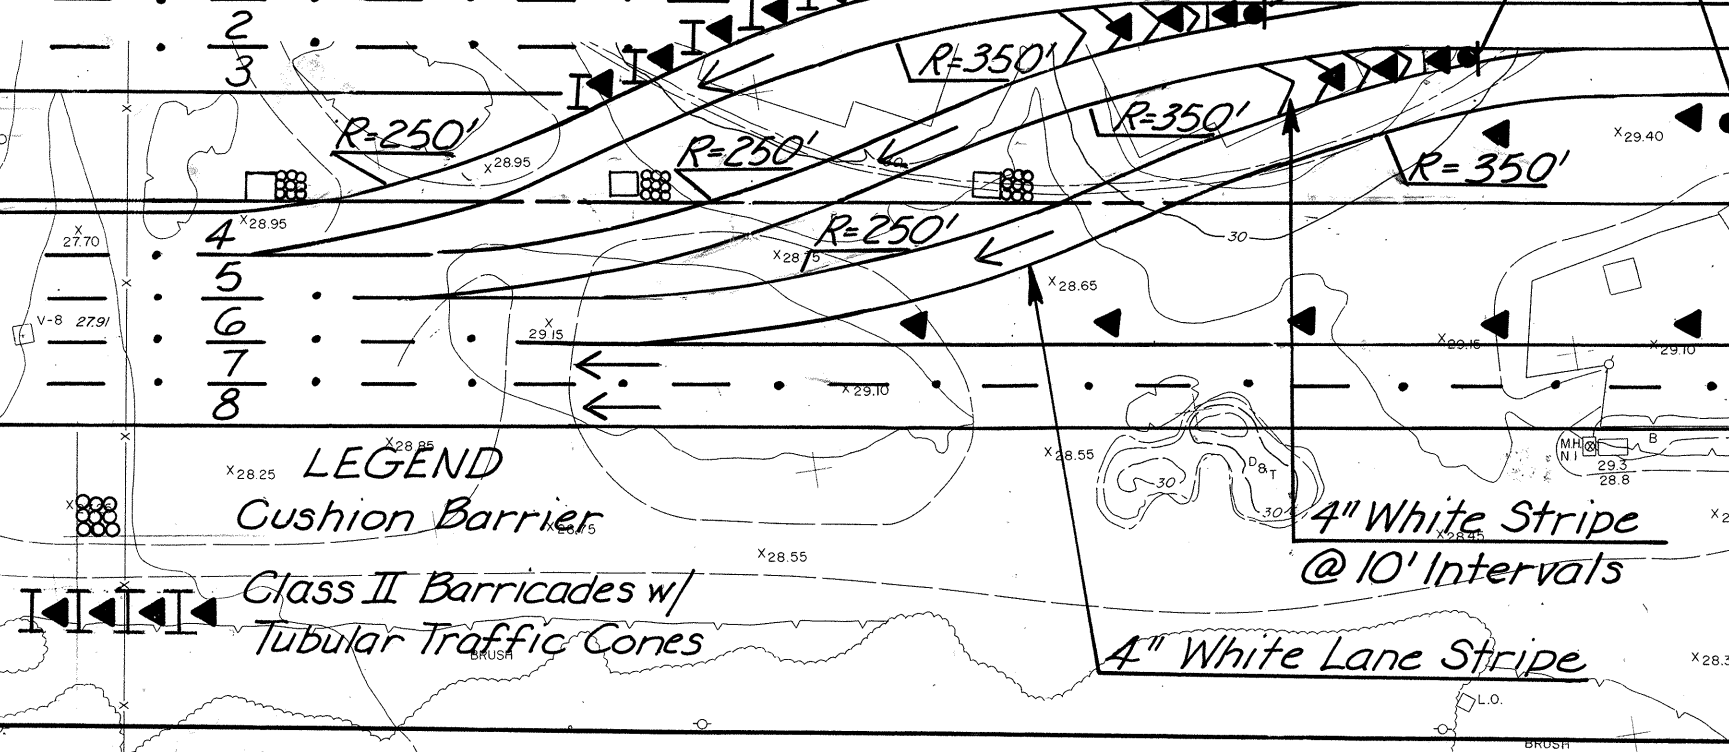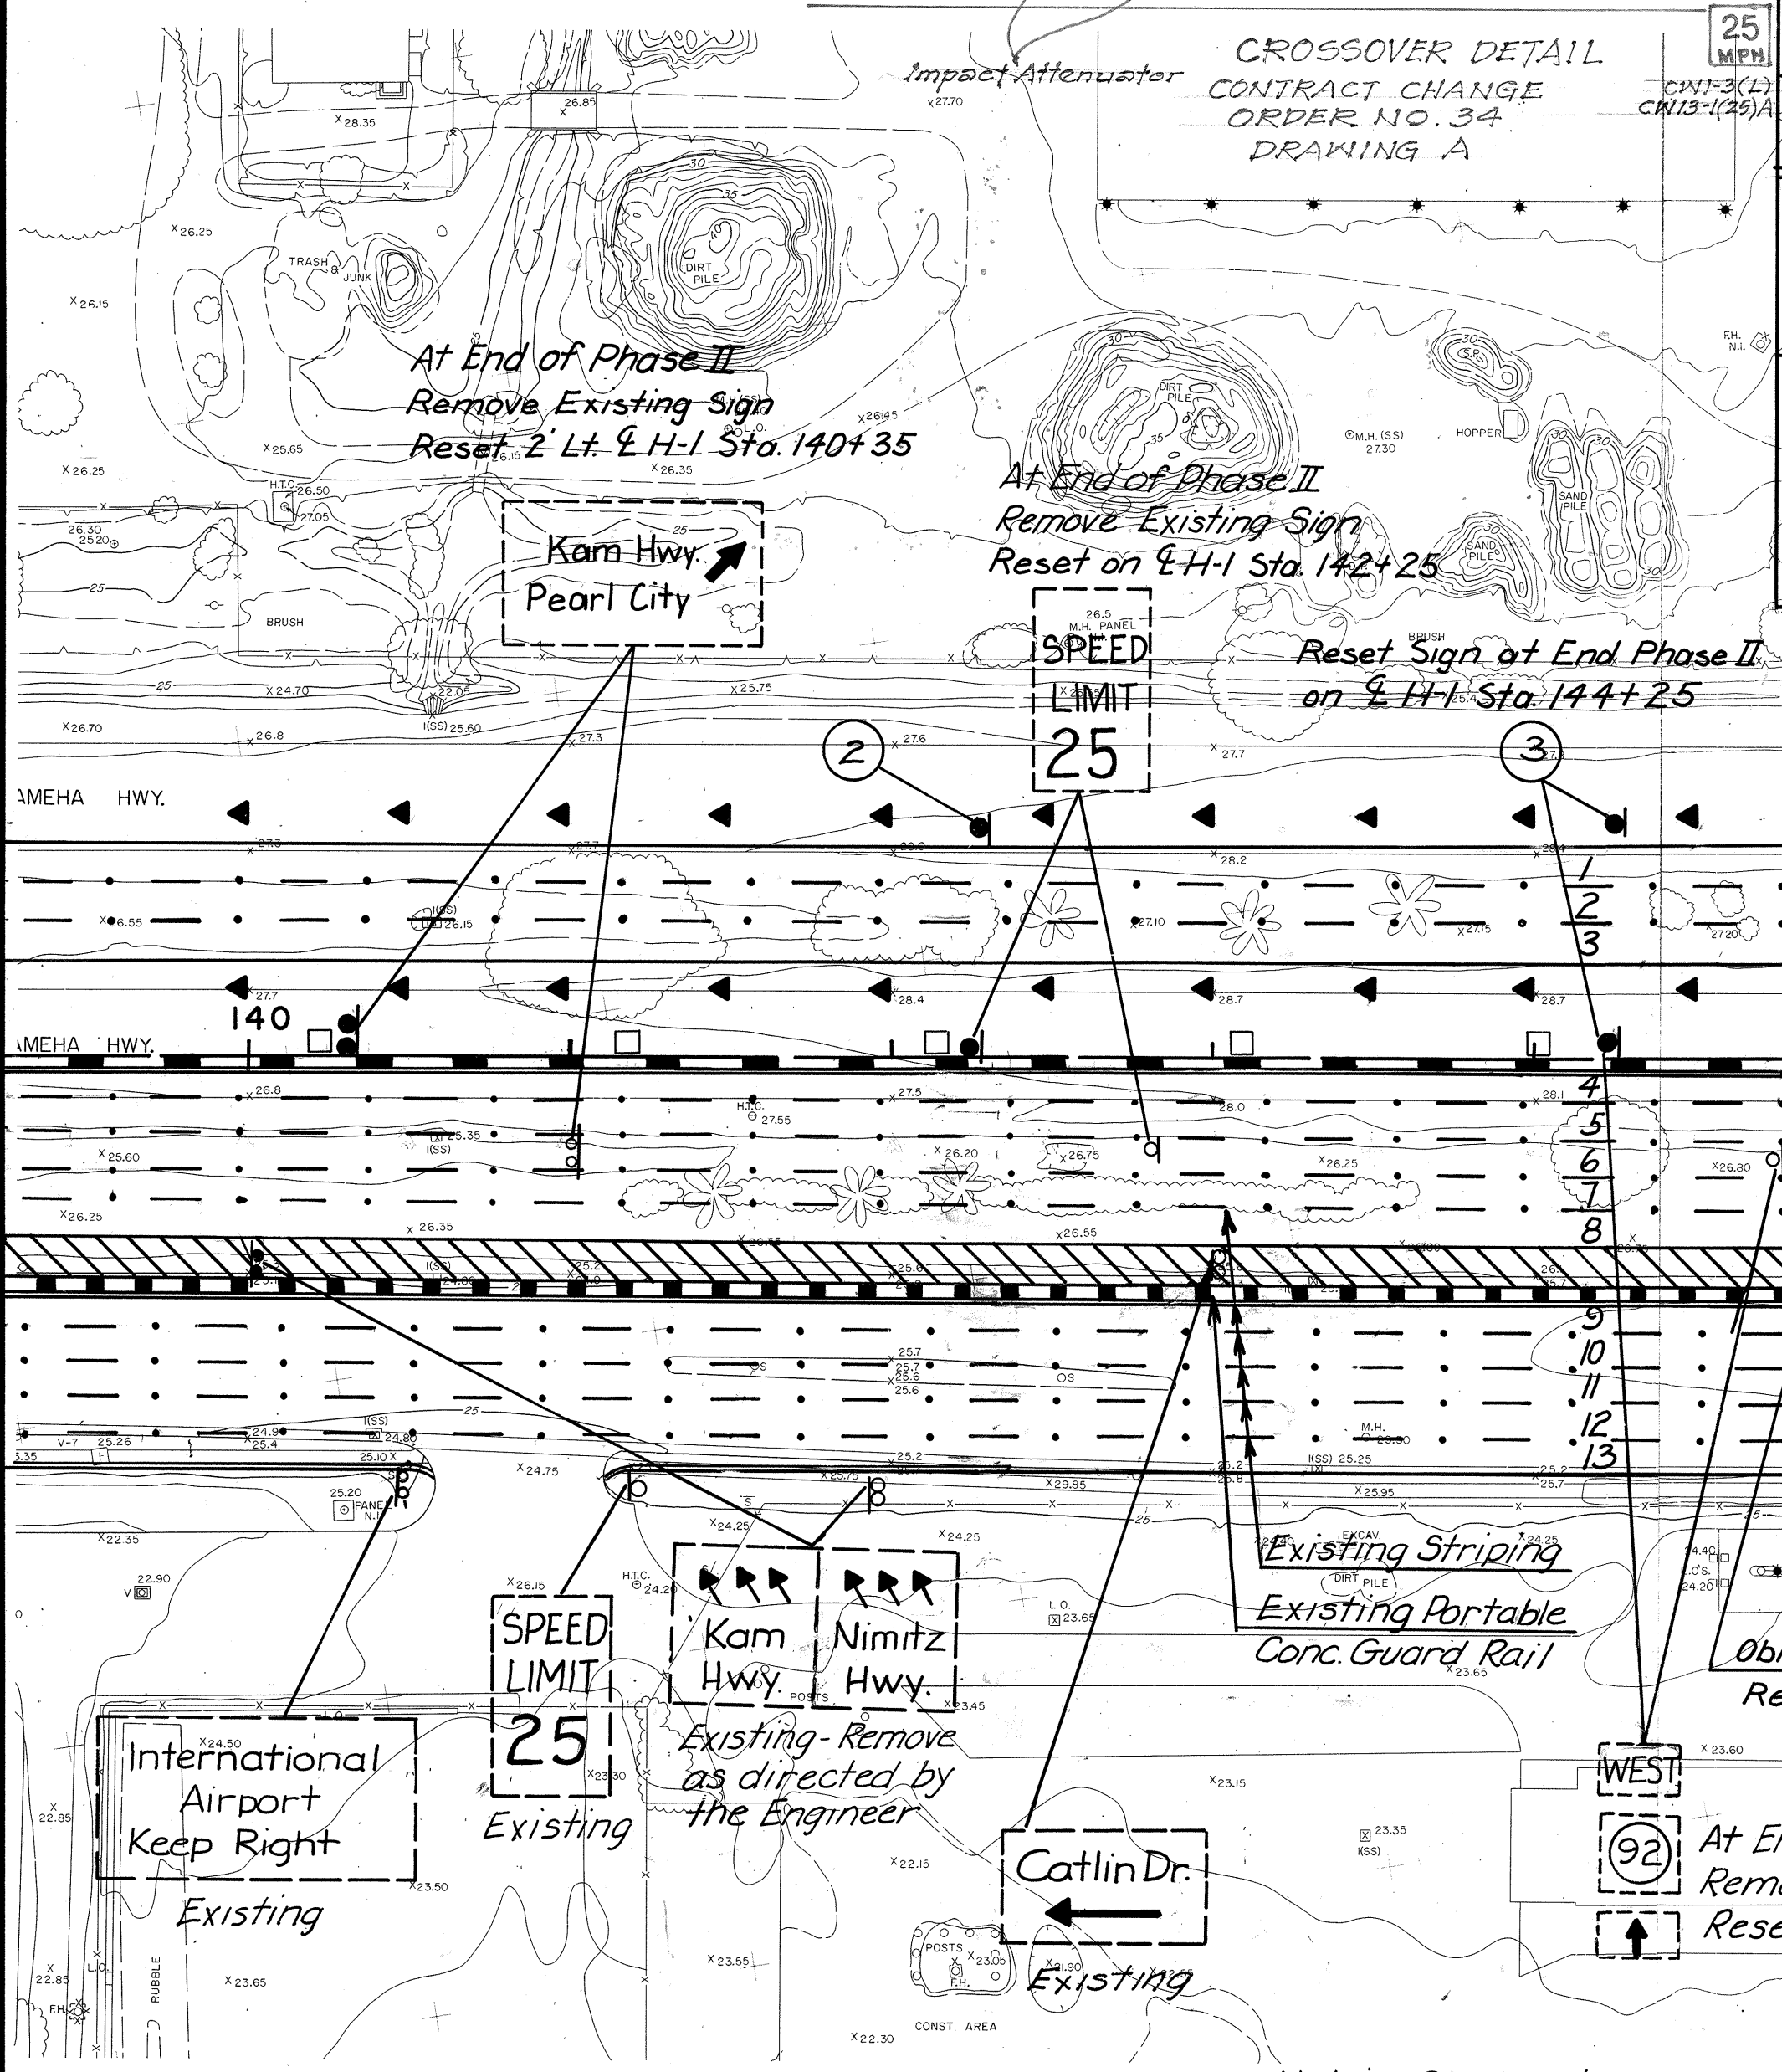

FED. ROAD DIST. NO.	STATE	FED. AID PROJ. NO.	FISCAL YEAR	SHEET NO.	TOTAL SHEETS
HAWAII	HAW.	I-H-1(119)16	1975	34	200


Detour Limits- Sta. 148+00
Project I-41-1(119):16

Detour Crossover Constructed and Maintained in Project I-HI-1(118)-16
All Detour Construction required for Catlin Dr. ^{1430.00}
Intersection from Sta. 148+00 to Sta. 152+00 on
Maui side of H-1 E and all construction required
on Maui side shall be completed in Project I-HI-1(118)-16 ^{1415.00}

NOT IN CONTRACT

NOTES

1. Remove and Salvage all signs along Kamoharaha Hwy. as directed by the Engineer.
2. All Signs, Striping, & Guard Rail indicated as existing will be placed during Project I-H-I-(118):IG and shall remain during Project I-H-I-(119):IG unless otherwise noted.
3. Those signs indicated as existing which are to be removed but not reset shall be stored as directed by the Engineer.
4. All Tubular Traffic Cones placed during Project I-H-I-(118):IG which are not used in-place or relocated during Project I-H-I-(119):IG shall be removed and stored as directed by the Engineer.

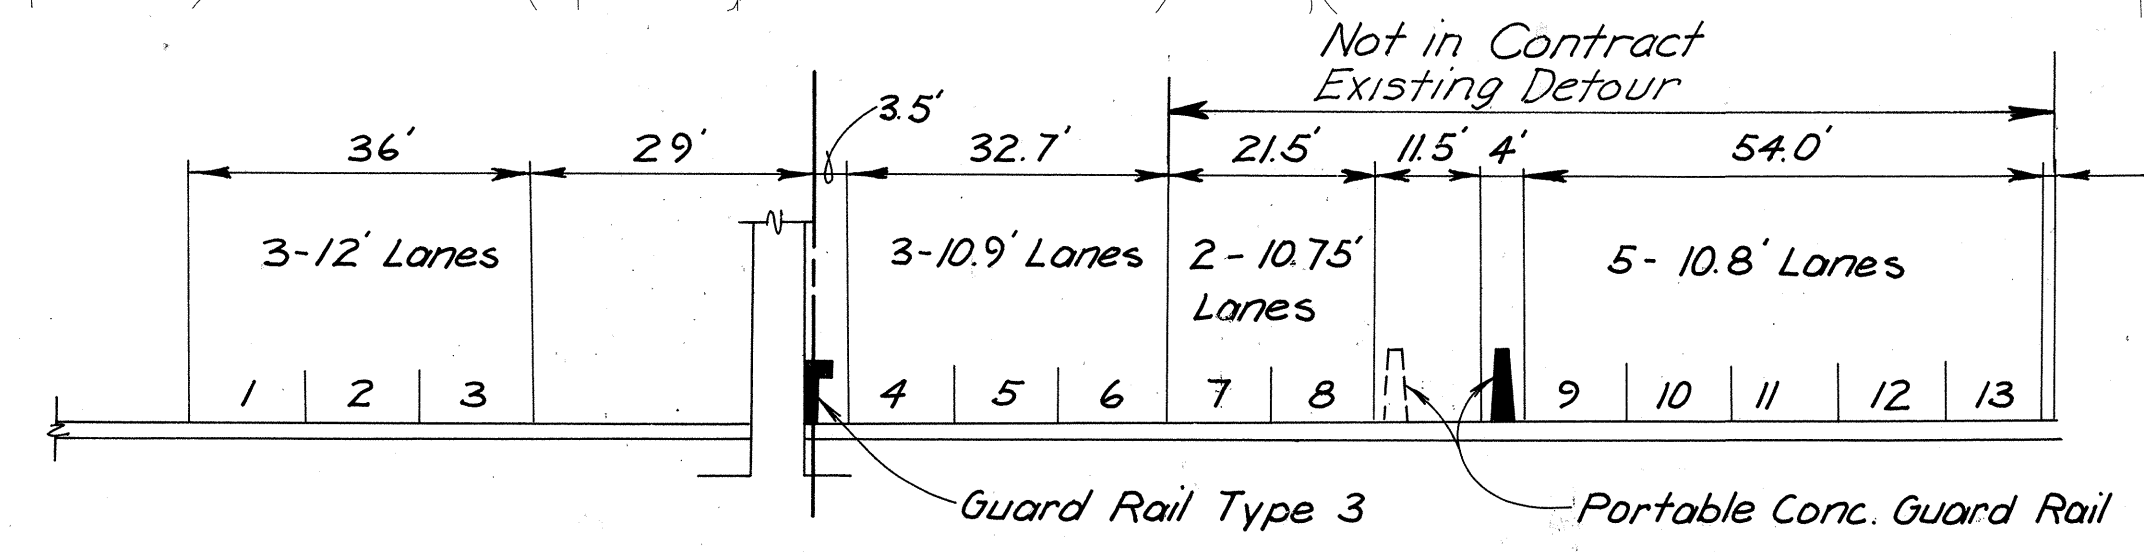

<u>Sta. 140 + 00 to 149 + 53</u>	
DETOUR LANES	Construction Phase II 1, 2, 3, 7, 8, 9, 10, 11, 12, & 13
	Construction Phase III 4, 5, 6, 7, 8, 9, 10, 11, 12, & 13

LEGEND
Traffic Cones, Tubular

- *Exist. Portable Concrete Guard Rail*

New Guard Rail Type 3 Single


- Exist. Guard Rail Type 3 Single

New or Relocated Traffic Sign

4" White Lane Stripe - Type C Reflector

4" White Approach Stripe Type C Reflector

NEW SIGNS

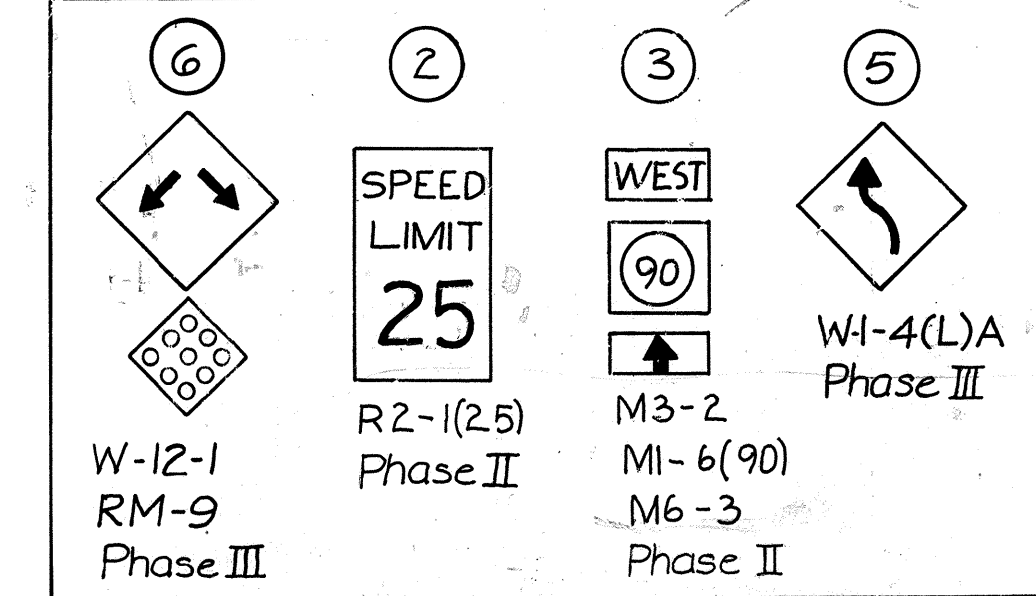

THIS WORK WAS PREPARED BY
ME OR UNDER MY SUPERVISION.
Edward K. Stevens
Signature

**STATE OF HAWAII
DEPARTMENT OF TRANSPORTATION
HIGHWAYS DIVISION**

CONSTRUCTION DETOUR PHASE II & III


AIRPORT INTERCHANGE
F.A.I. PROJ. NO. I-HI-1(119):10

SCALE: 1" = 50'


DATE: FEB. 1, 1975

SHEET No. 3 OF 4 SHEETS

FED. ROAD DIST. NO.	STATE	FED. AID PROJ. NO.	FISCAL YEAR	SHEET NO.	TOTAL SHEETS
HAWAII	HAW.				

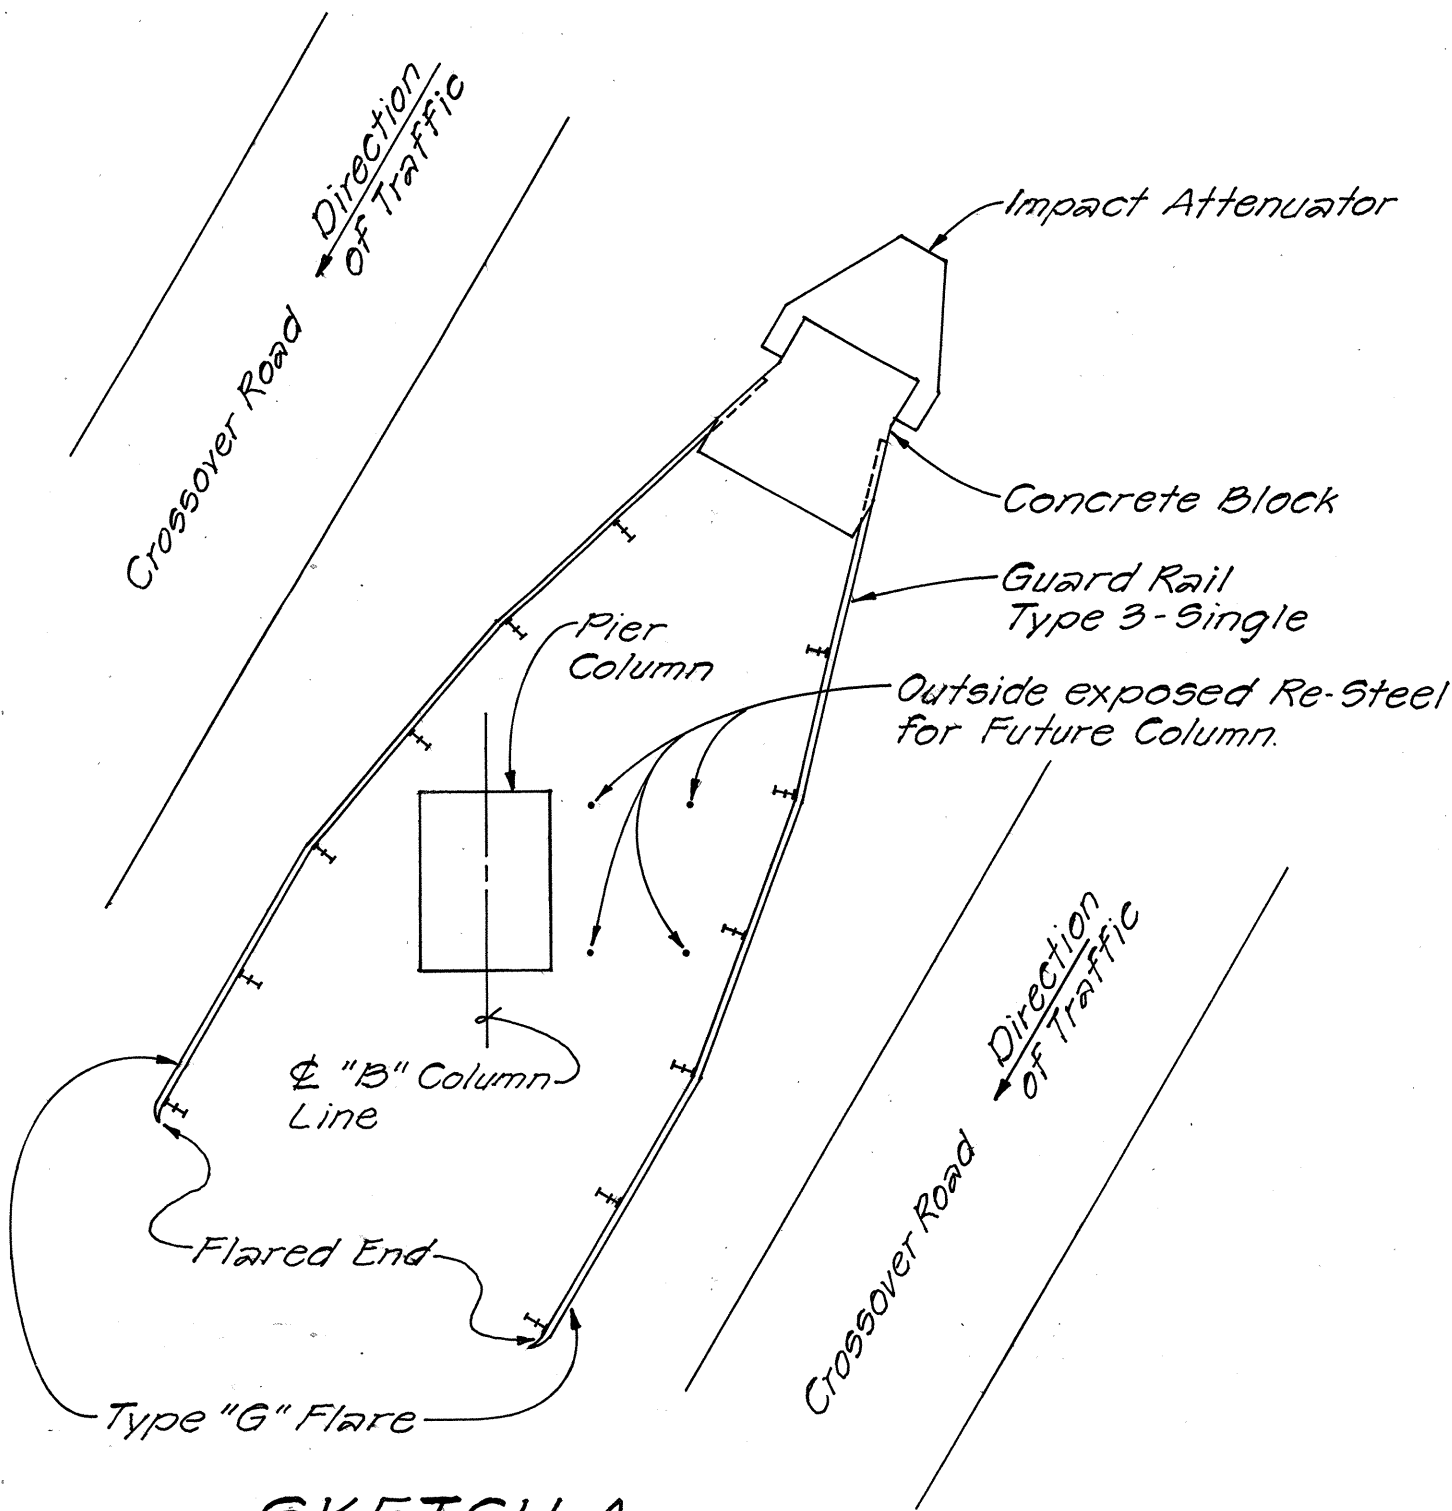


SKETCH A

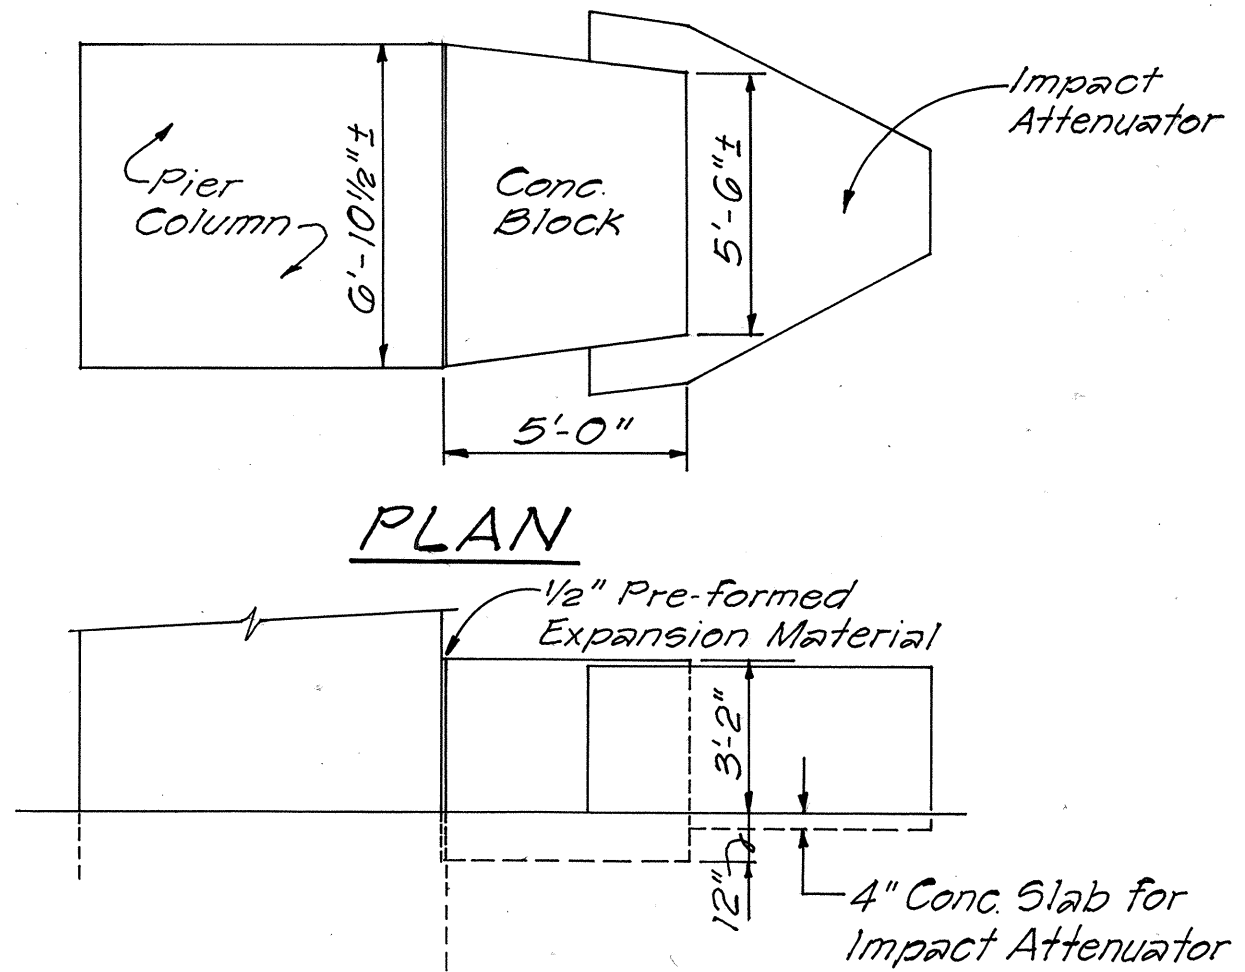


Pier Column on Project I-HI-1(73):15, Str. No. 8,
Pier No 3, 132.88 Ft. Left of H-1 Centerline.


SKETCH C

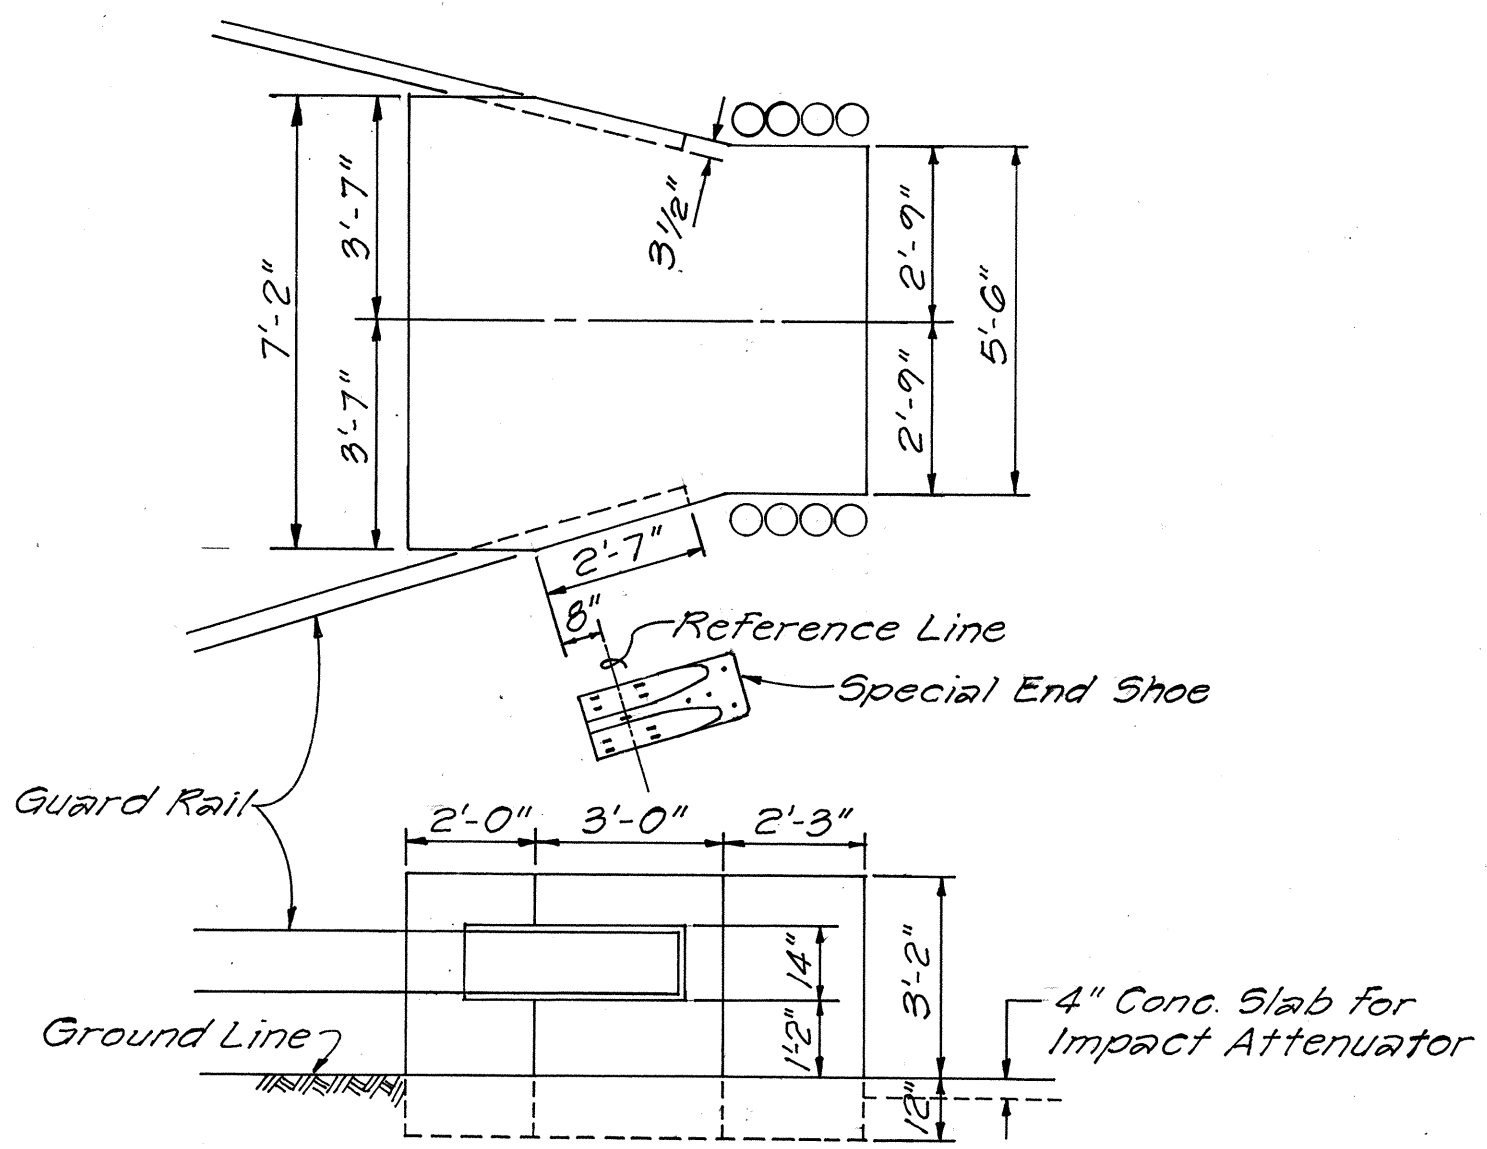

SKETCH B

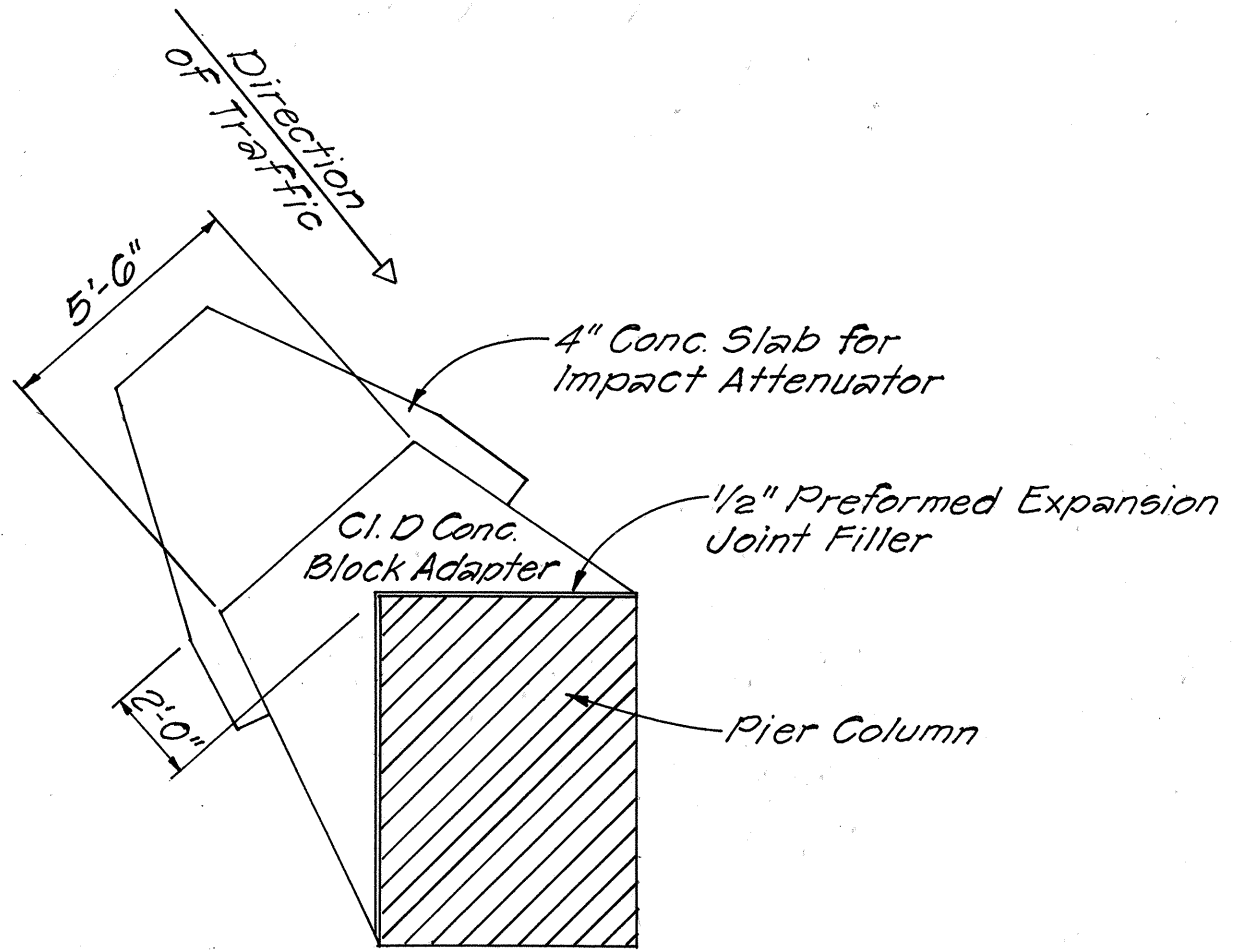

PLAN SKETCH D

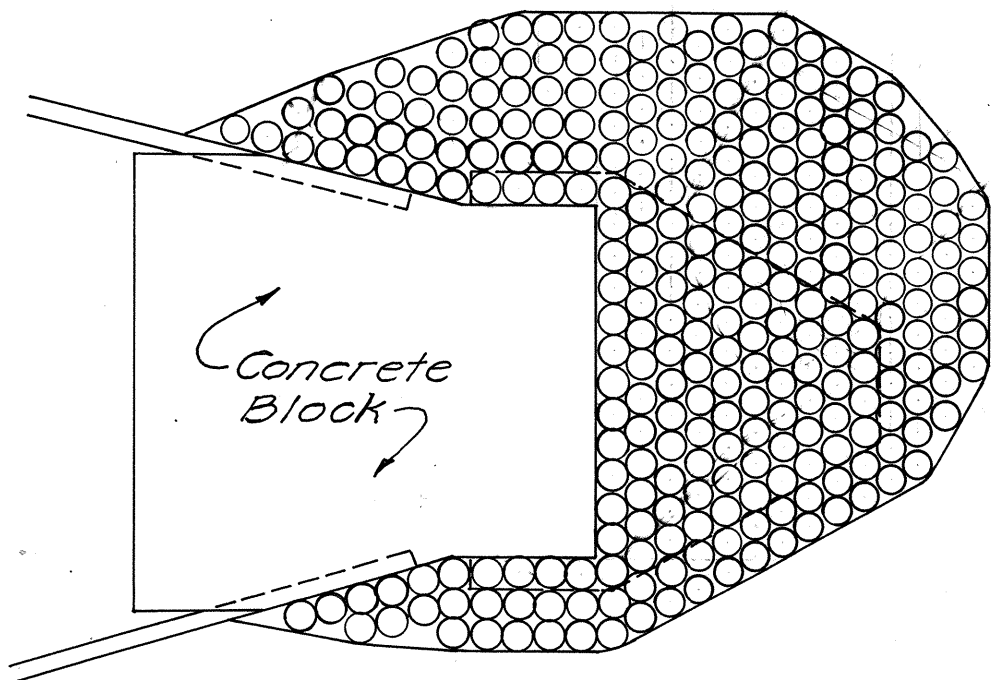

MODIFIED IMPACT ATTENUATOR
AT COLUMN 6B

CONTRACT CHANGE ORDER No. 25

STATE OF HAWAII
DEPARTMENT OF TRANSPORTATION
LAND TRANSPORTATION FACILITIES DIVISION

MISCELLANEOUS DETAILS

AIRPORT INTERCHANGE
F.A.I. Proj. No. I-HI-1(117):16

Scale: Not to scale Date: Dec., 1978

SHEET NO. 1 OF 1 SHEETS

ORIGINAL PLAN	SURVEY PLOTTED BY	DATE
NOTE BOOK	DRAWN BY	"
No.	DESIGNED BY	"
	CHECKED BY	"