



FED. ROAD DIST. NO.	STATE	FED. AID PROJ. NO.	FISCAL YEAR	SHEET NO.	TOTAL SHEETS
HAWAII	HAW.	I-HI-1(119)16	1975	5	200

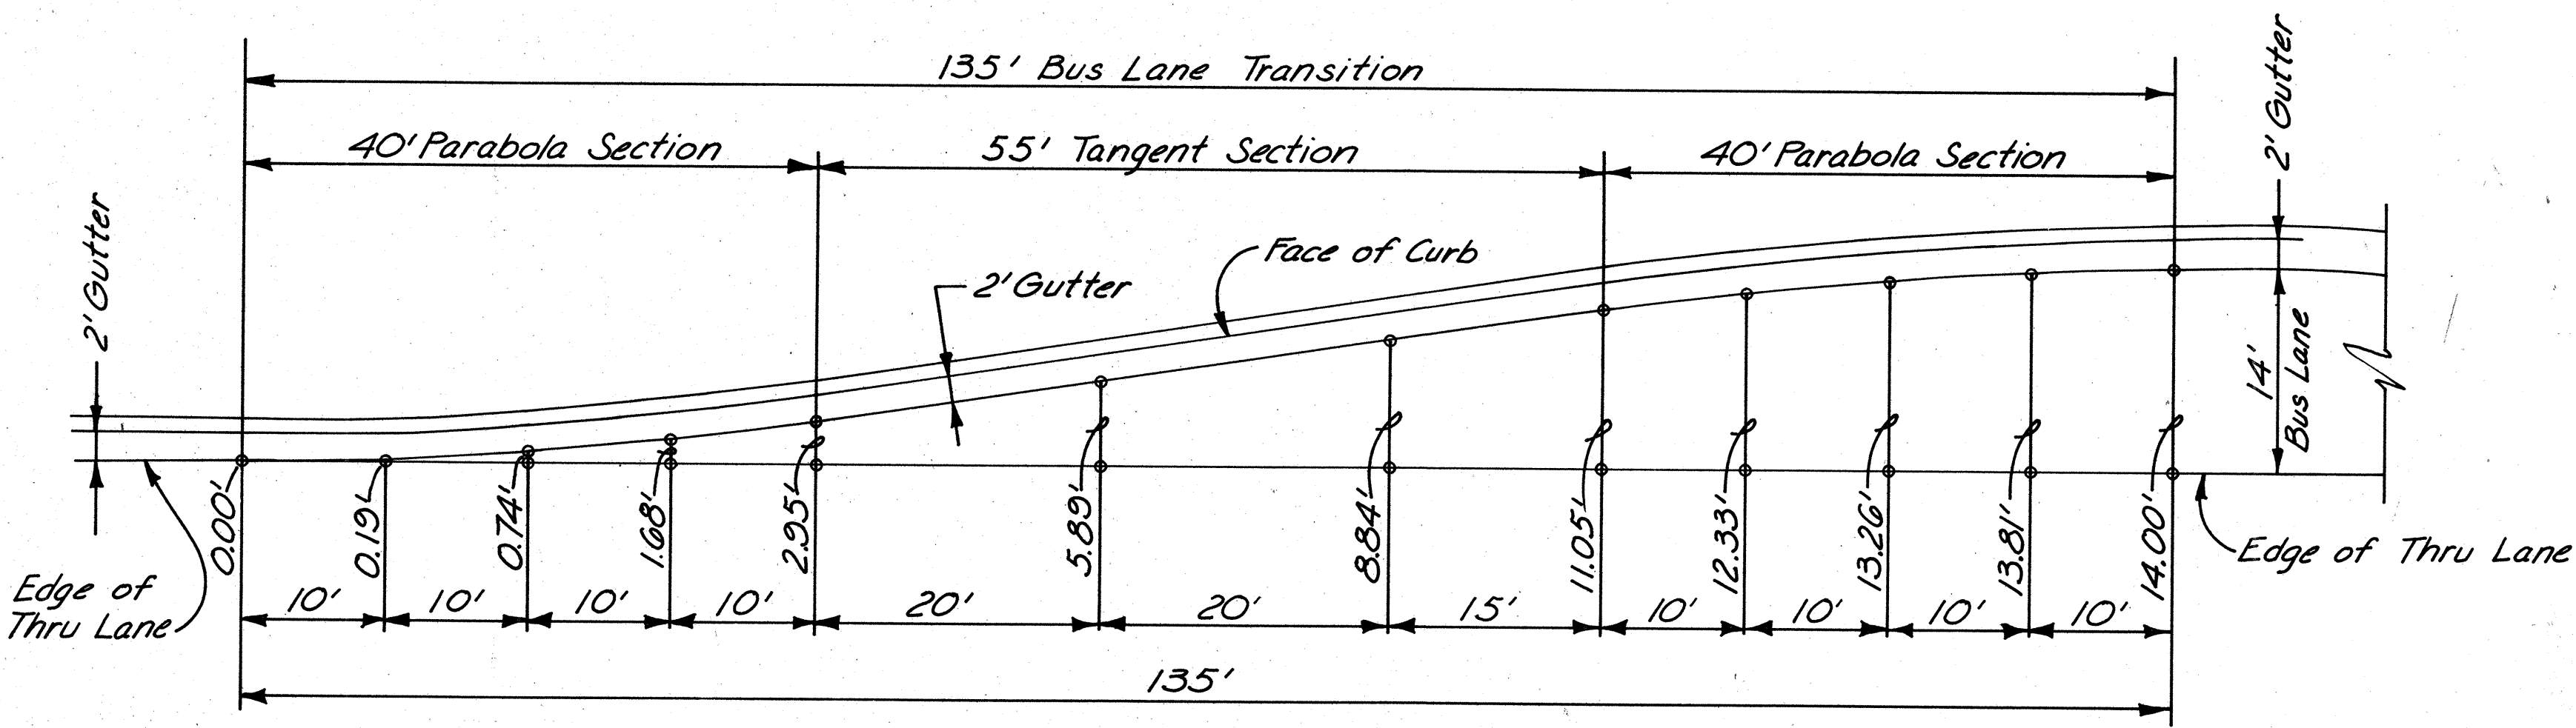


TYPICAL 14' BUS LANE TRANSITION
Scale: 1"=10'

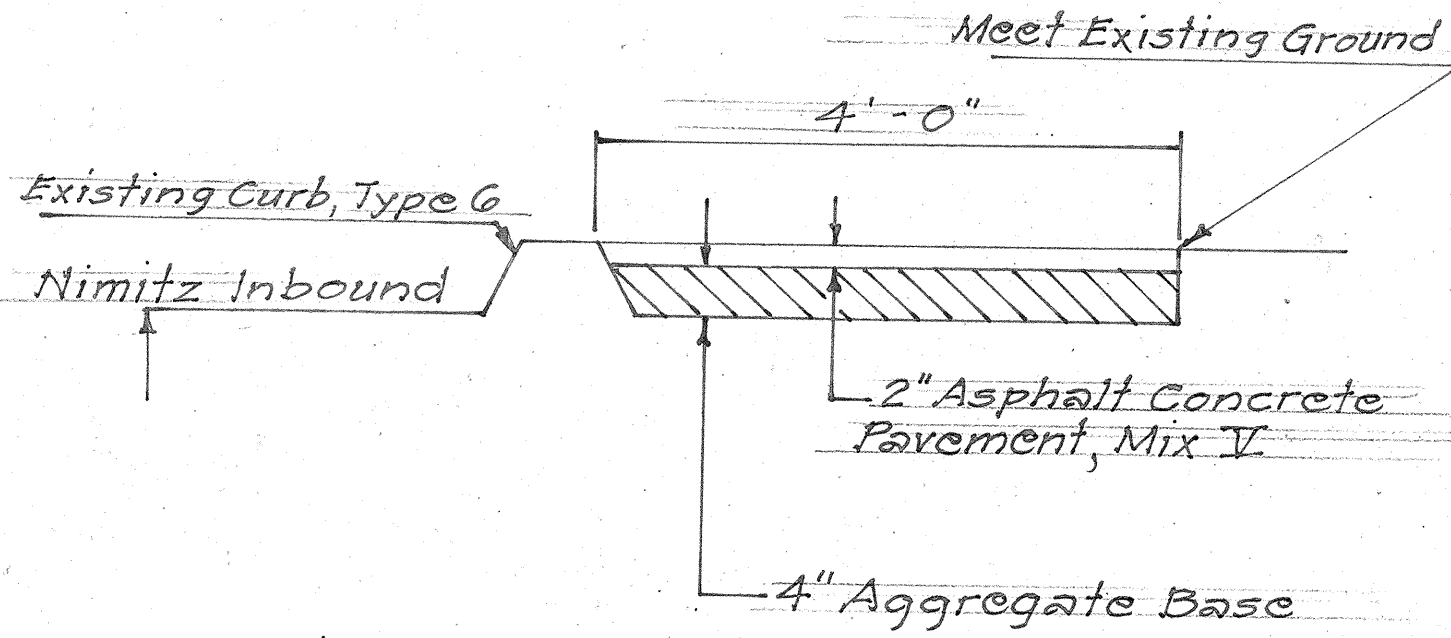


Location:
Right of H-1 & Stations 134+00± to 141+00±
Bituminous Walk
Scale: 3/4"=1'-0"

Contract Change Order No. 38
Drawing A

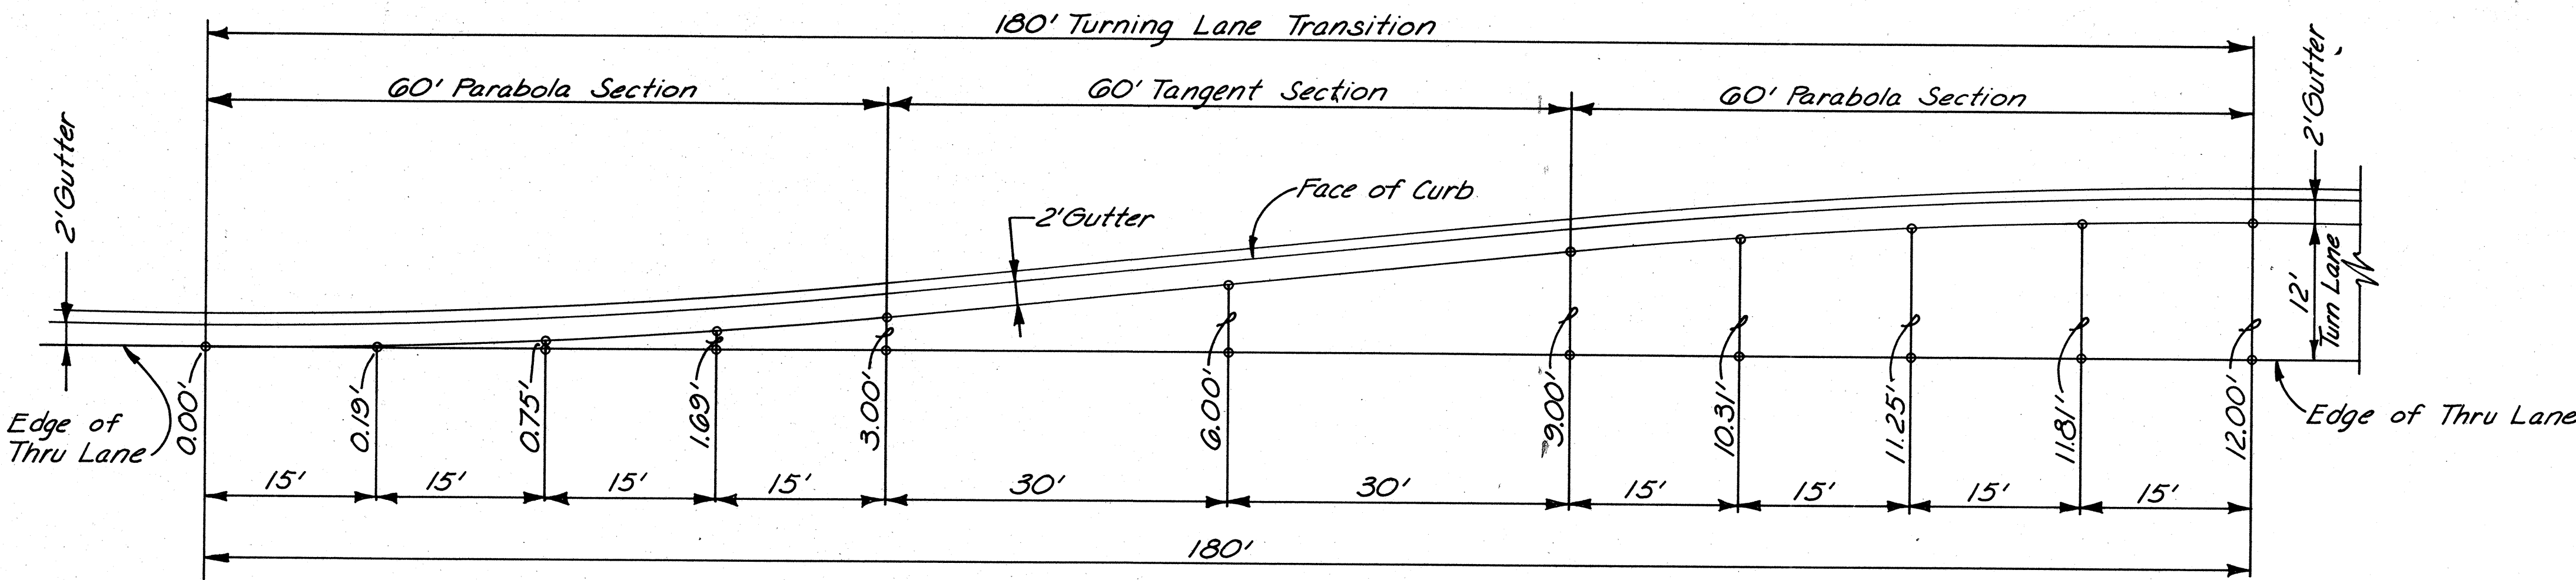

TYPICAL 12' TURNING LANE TRANSITION
Scale: 1"=10'

ORIGINAL PLAN	DATE
DRAWN BY	
DESIGNED BY	
NOTED BY	
CHECKED BY	

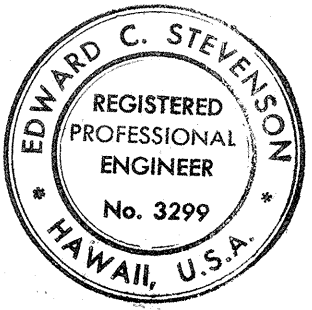

THIS WORK WAS PREPARED BY
ME OR UNDER MY SUPERVISION.
Edward C. Stevenson
Signature

STATE OF HAWAII
DEPARTMENT OF TRANSPORTATION
HIGHWAYS DIVISION

LANE TRANSITIONS

AIRPORT INTERCHANGE
F.A.I. PROJ. NO. I-HI-1(119)16
SCALE: AS SHOWN DATE: FEB. 1, 1975
SHEET No. 1 OF 1 SHEETS