


INDEX TO DRAWINGS	
SHEET NO	DESCRIPTION
1	TITLE
2	CONSTRUCTION PHASING
3 - 4	TYPICAL SECTIONS
5	LANE TRANSITIONS
6 - 8	MAUKA DETOUR PLAN & PROFILE
9 - 11	DRAINAGE PLAN & PROFILE—BIKE TRAIL
12 - 13	BOX CULVERTS PLAN & PROFILE
14 - 20	DRAINAGE STRUCTURES & DETAILS
21 - 22	DRAINAGE SUMMARY
23 - 31	STANDARD DETAILS-DRAINAGE & MISCELLANEOUS
32 - 34	CONSTRUCTION DETOURS-SIGNS & STRIPING
35	DETOUR DETAILS
36	ADJUSTED TRAFFIC SIGNALS
37	SIGNAL DETAILS
38 - 48	STANDARD DETAILS - TRAFFIC
49 - 58	HIGHWAY LIGHTING
59 - 74	LANDSCAPING & IRRIGATION
75	WATER LINE DETAILS
76 - 78	UNDERGROUND UTILITIES LOCATION MAP
79 - 80	INDEX TO VIADUCT STRUCTURE DRAWINGS
81 - 168	VIADUCT STRUCTURE PLANS
169 - 192	VIADUCT STRUCTURE TYPICAL DETAILS
193	STANDARD STRUCTURE DETAILS
194 - 200	CROSS SECTIONS

① 23A, ADD. 25A, ADD. 25B, C.O. 30A, 31S ② 35S-I,
③ C.O. 46A, ④ C.O. 58S, ⑤ C.O. 67S, ⑥ C.O. 109S,
⑦ C.O. 188S-I ARE SUPPLEMENT SHEETS TO THE
CONTRACT PLANS.
NEW TOTAL 211 SHEETS.

STATE OF HAWAII
DEPARTMENT OF TRANSPORTATION
HIGHWAYS DIVISION
HONOLULU, HAWAII
AS BUILT
PLANS FOR
CONSTRUCTION OF A PORTION OF
INTERSTATE ROUTE H-1
AIRPORT INTERCHANGE
FEDERAL AID INTERSTATE PROJECT I-HI-1(119):16
DISTRICT OF HONOLULU
ISLAND OF OAHU

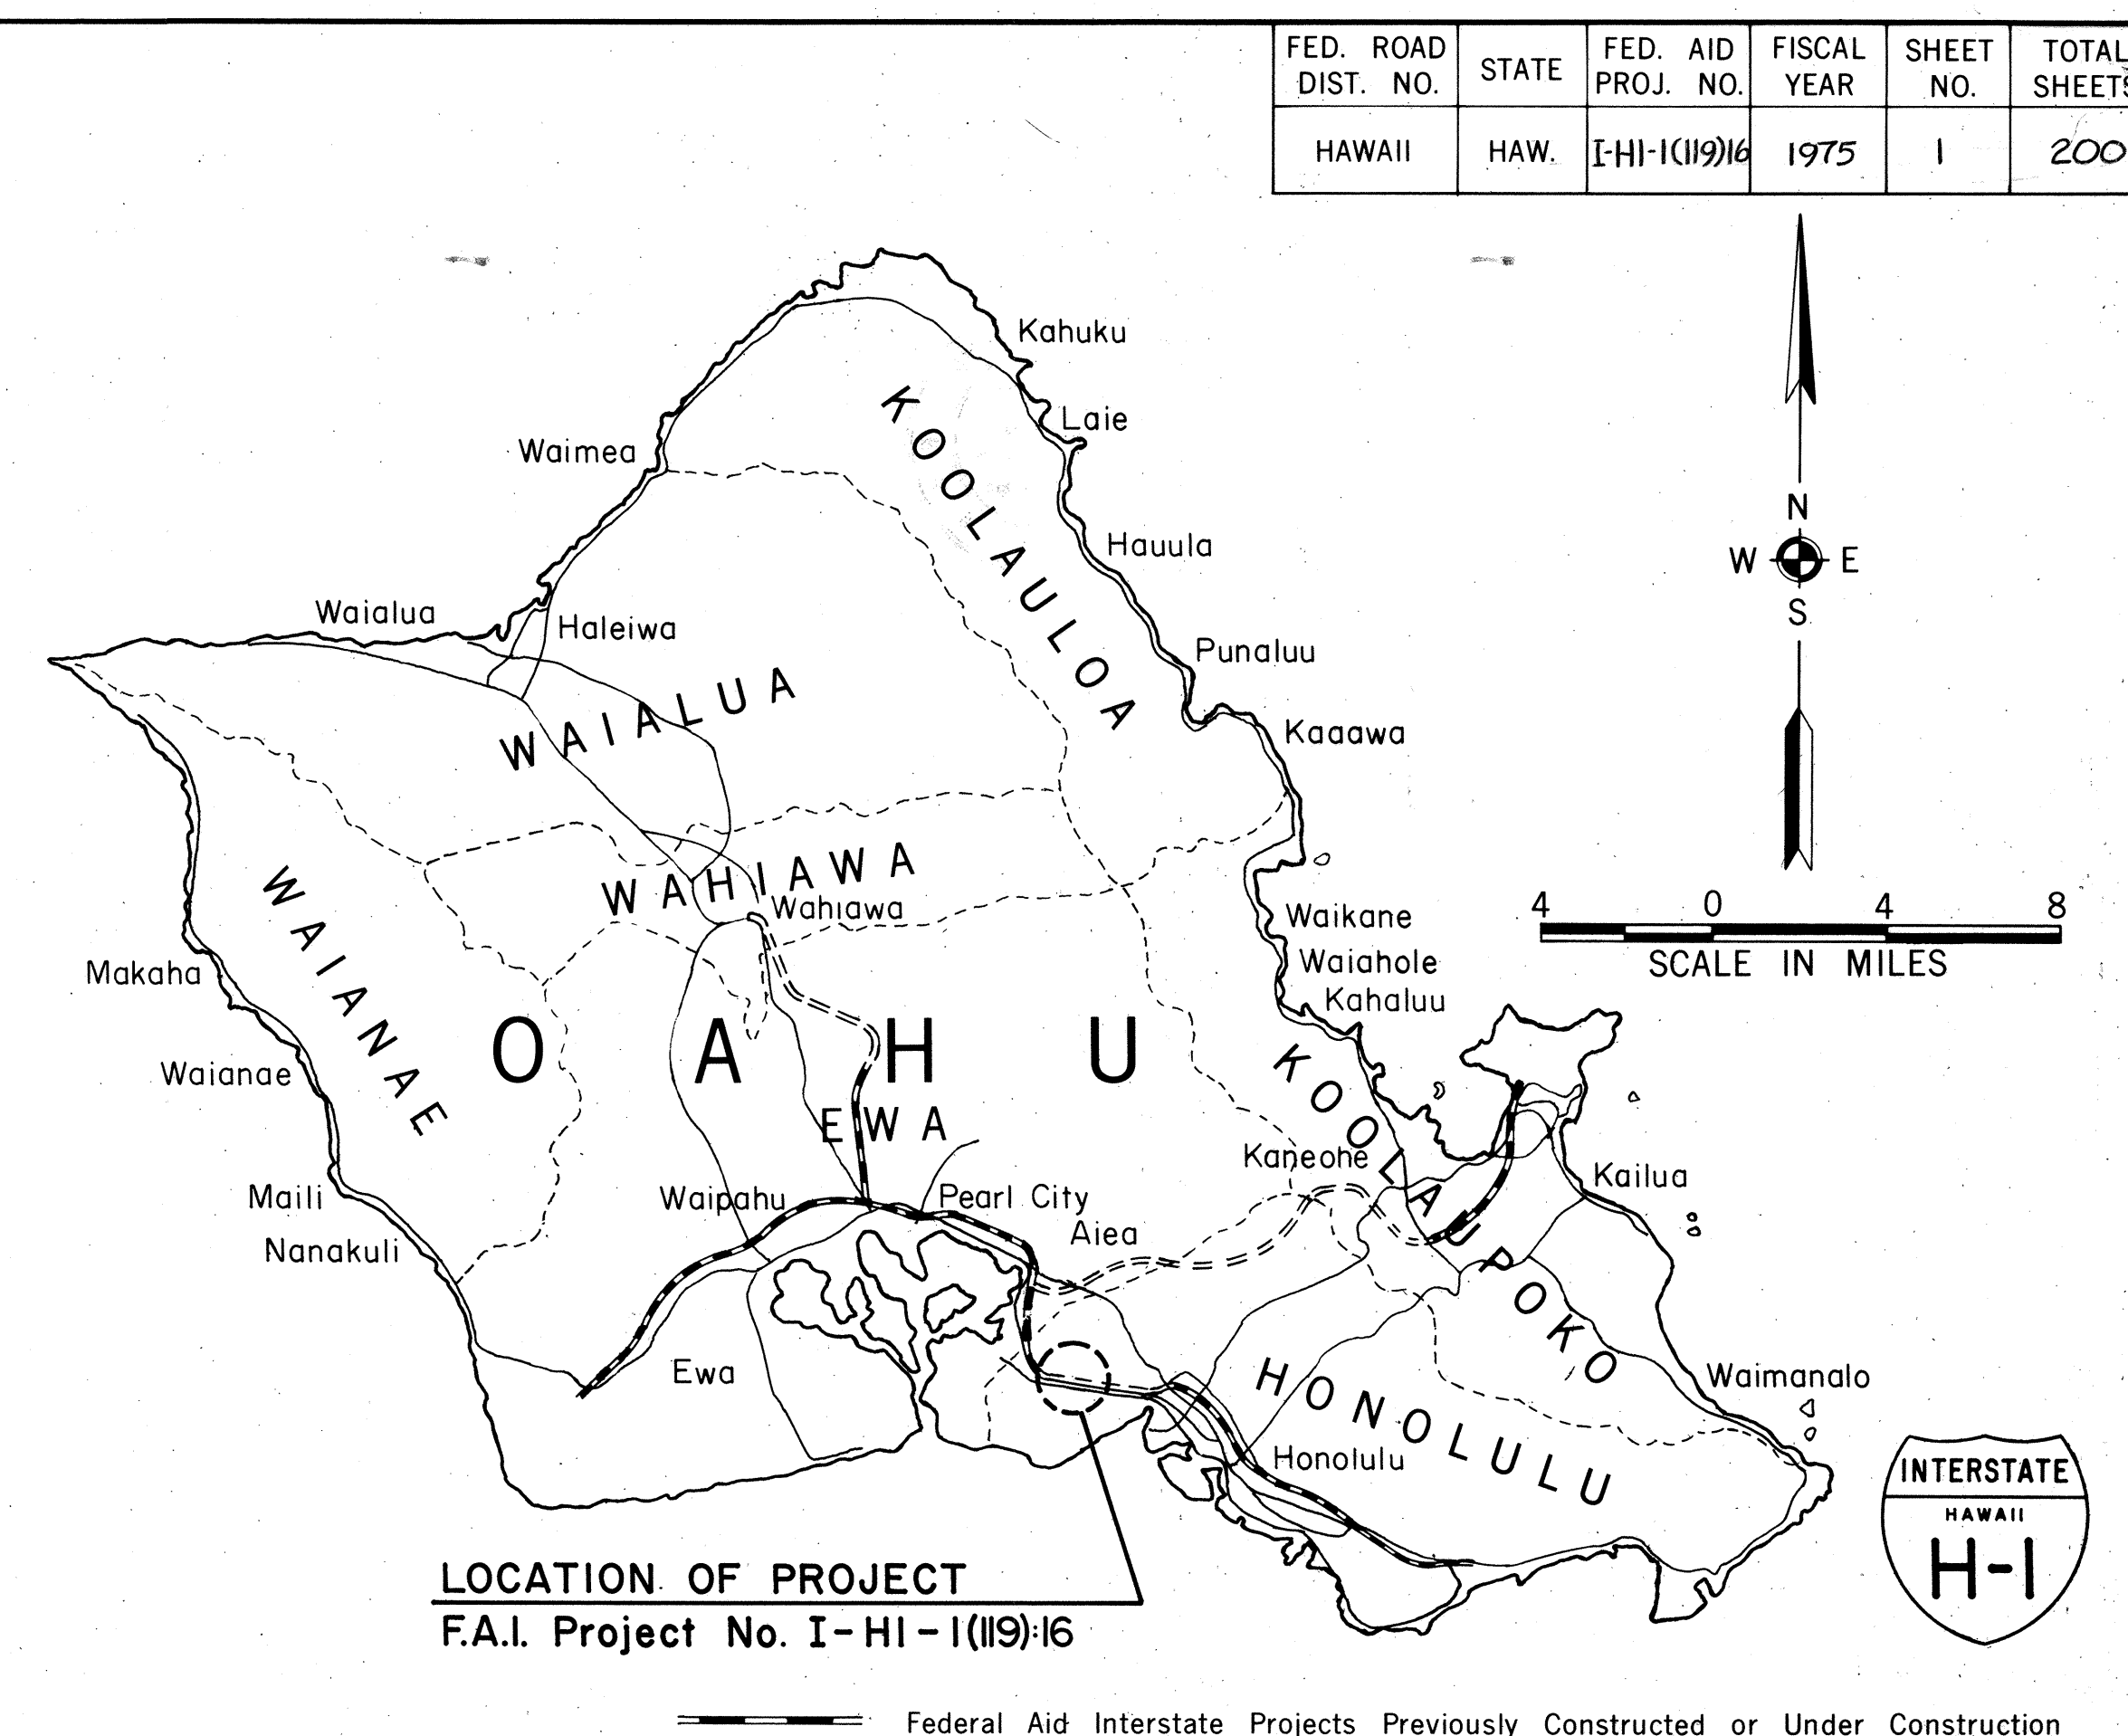

DESIGN CLASSIFICATION


DESIGN ADT (1994) 102,675
DHV 11 %
D 60/40
T 5 %
V 60 M.P.H.

SCALES:

PLANS HOR. 1" = 50'
PROFILES HOR. 1" = 50'
VER. 1" = 10'
DETAIL ROADWAY PLANS HOR. 1" = 20'
CROSS SECTIONS HOR. 1" = 10'
VER. 1" = 5'

ALL CHANGES MADE DURING CONSTRUCTION
HAVE BEEN INCORPORATED ON THESE
PLANS EXCEPT CHANGES IN THE ORIGINAL
THEORETICAL QUANTITIES.

Paul S. Ushigata
RESIDENT ENGINEER
2-22-79
DATE

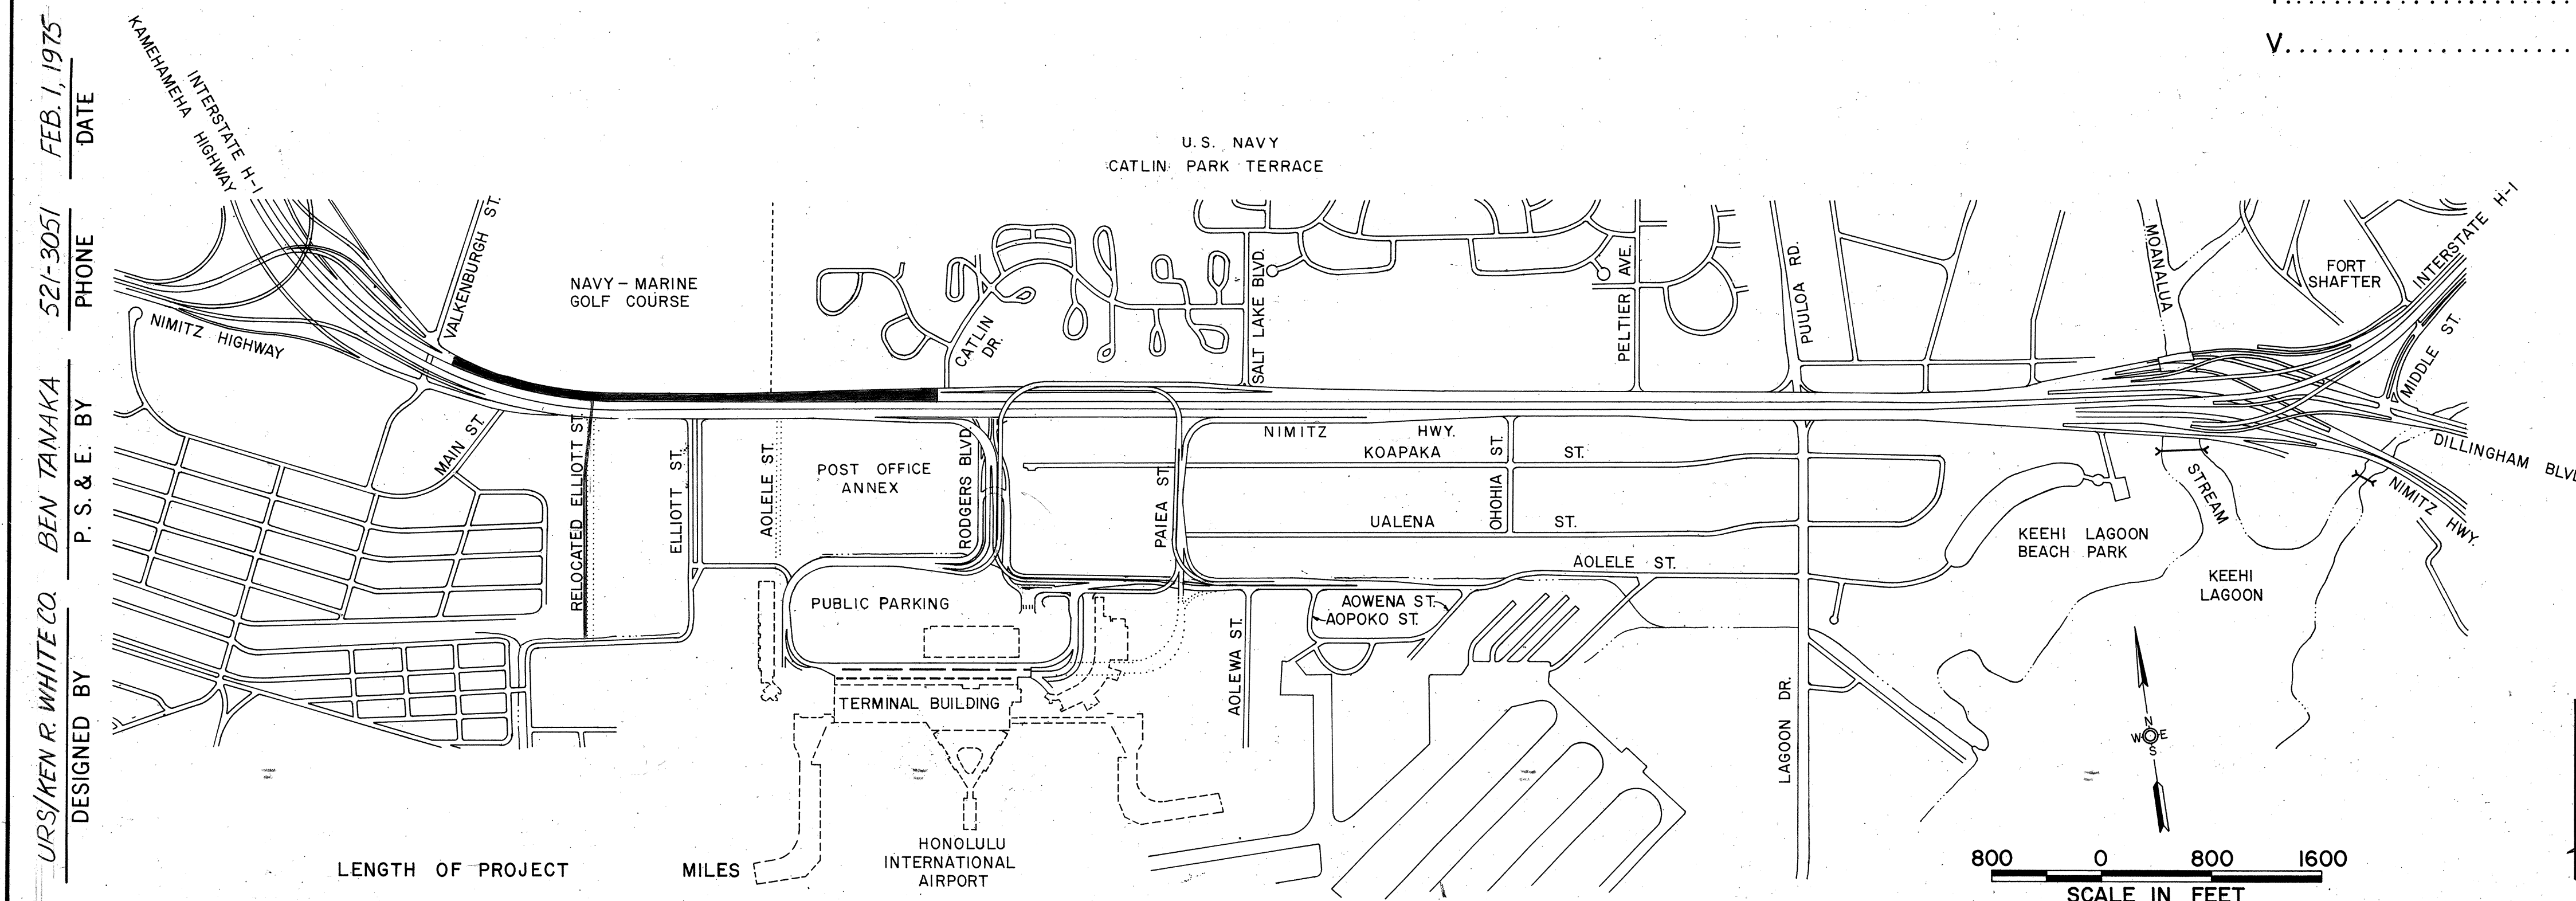

DEPARTMENT OF TRANSPORTATION
FEDERAL HIGHWAY ADMINISTRATION
APPROVED:
DIVISION ENGINEER
2-18-75
DATE

DEPARTMENT OF TRANSPORTATION
STATE OF HAWAII
APPROVED:
DIR. OF TRANSPORTATION
2-12-75
DATE