

Ref. Ref. Wall No. 1

True North

Ref. Lunaliilo Fwy.

To Koko Head

To Ewa

Ref. Ref. Wall No. 2

Ref. Edge of Deck



PLAN

Span No. 1

At Brg. Abut. No. 1
Sta. 204+19.76
Az. 199°-57'-26"

Dimensions: 5'-2"±, 7'-1"±, 7'-4"±, 5'-9½"±, 5'-9½"±, 7'-4"±, 8'-4"±, 7'-4"±

Labels: G-6, G-5b, G-5a, G-2, G-1, G-1, G-2, G-5, G-6

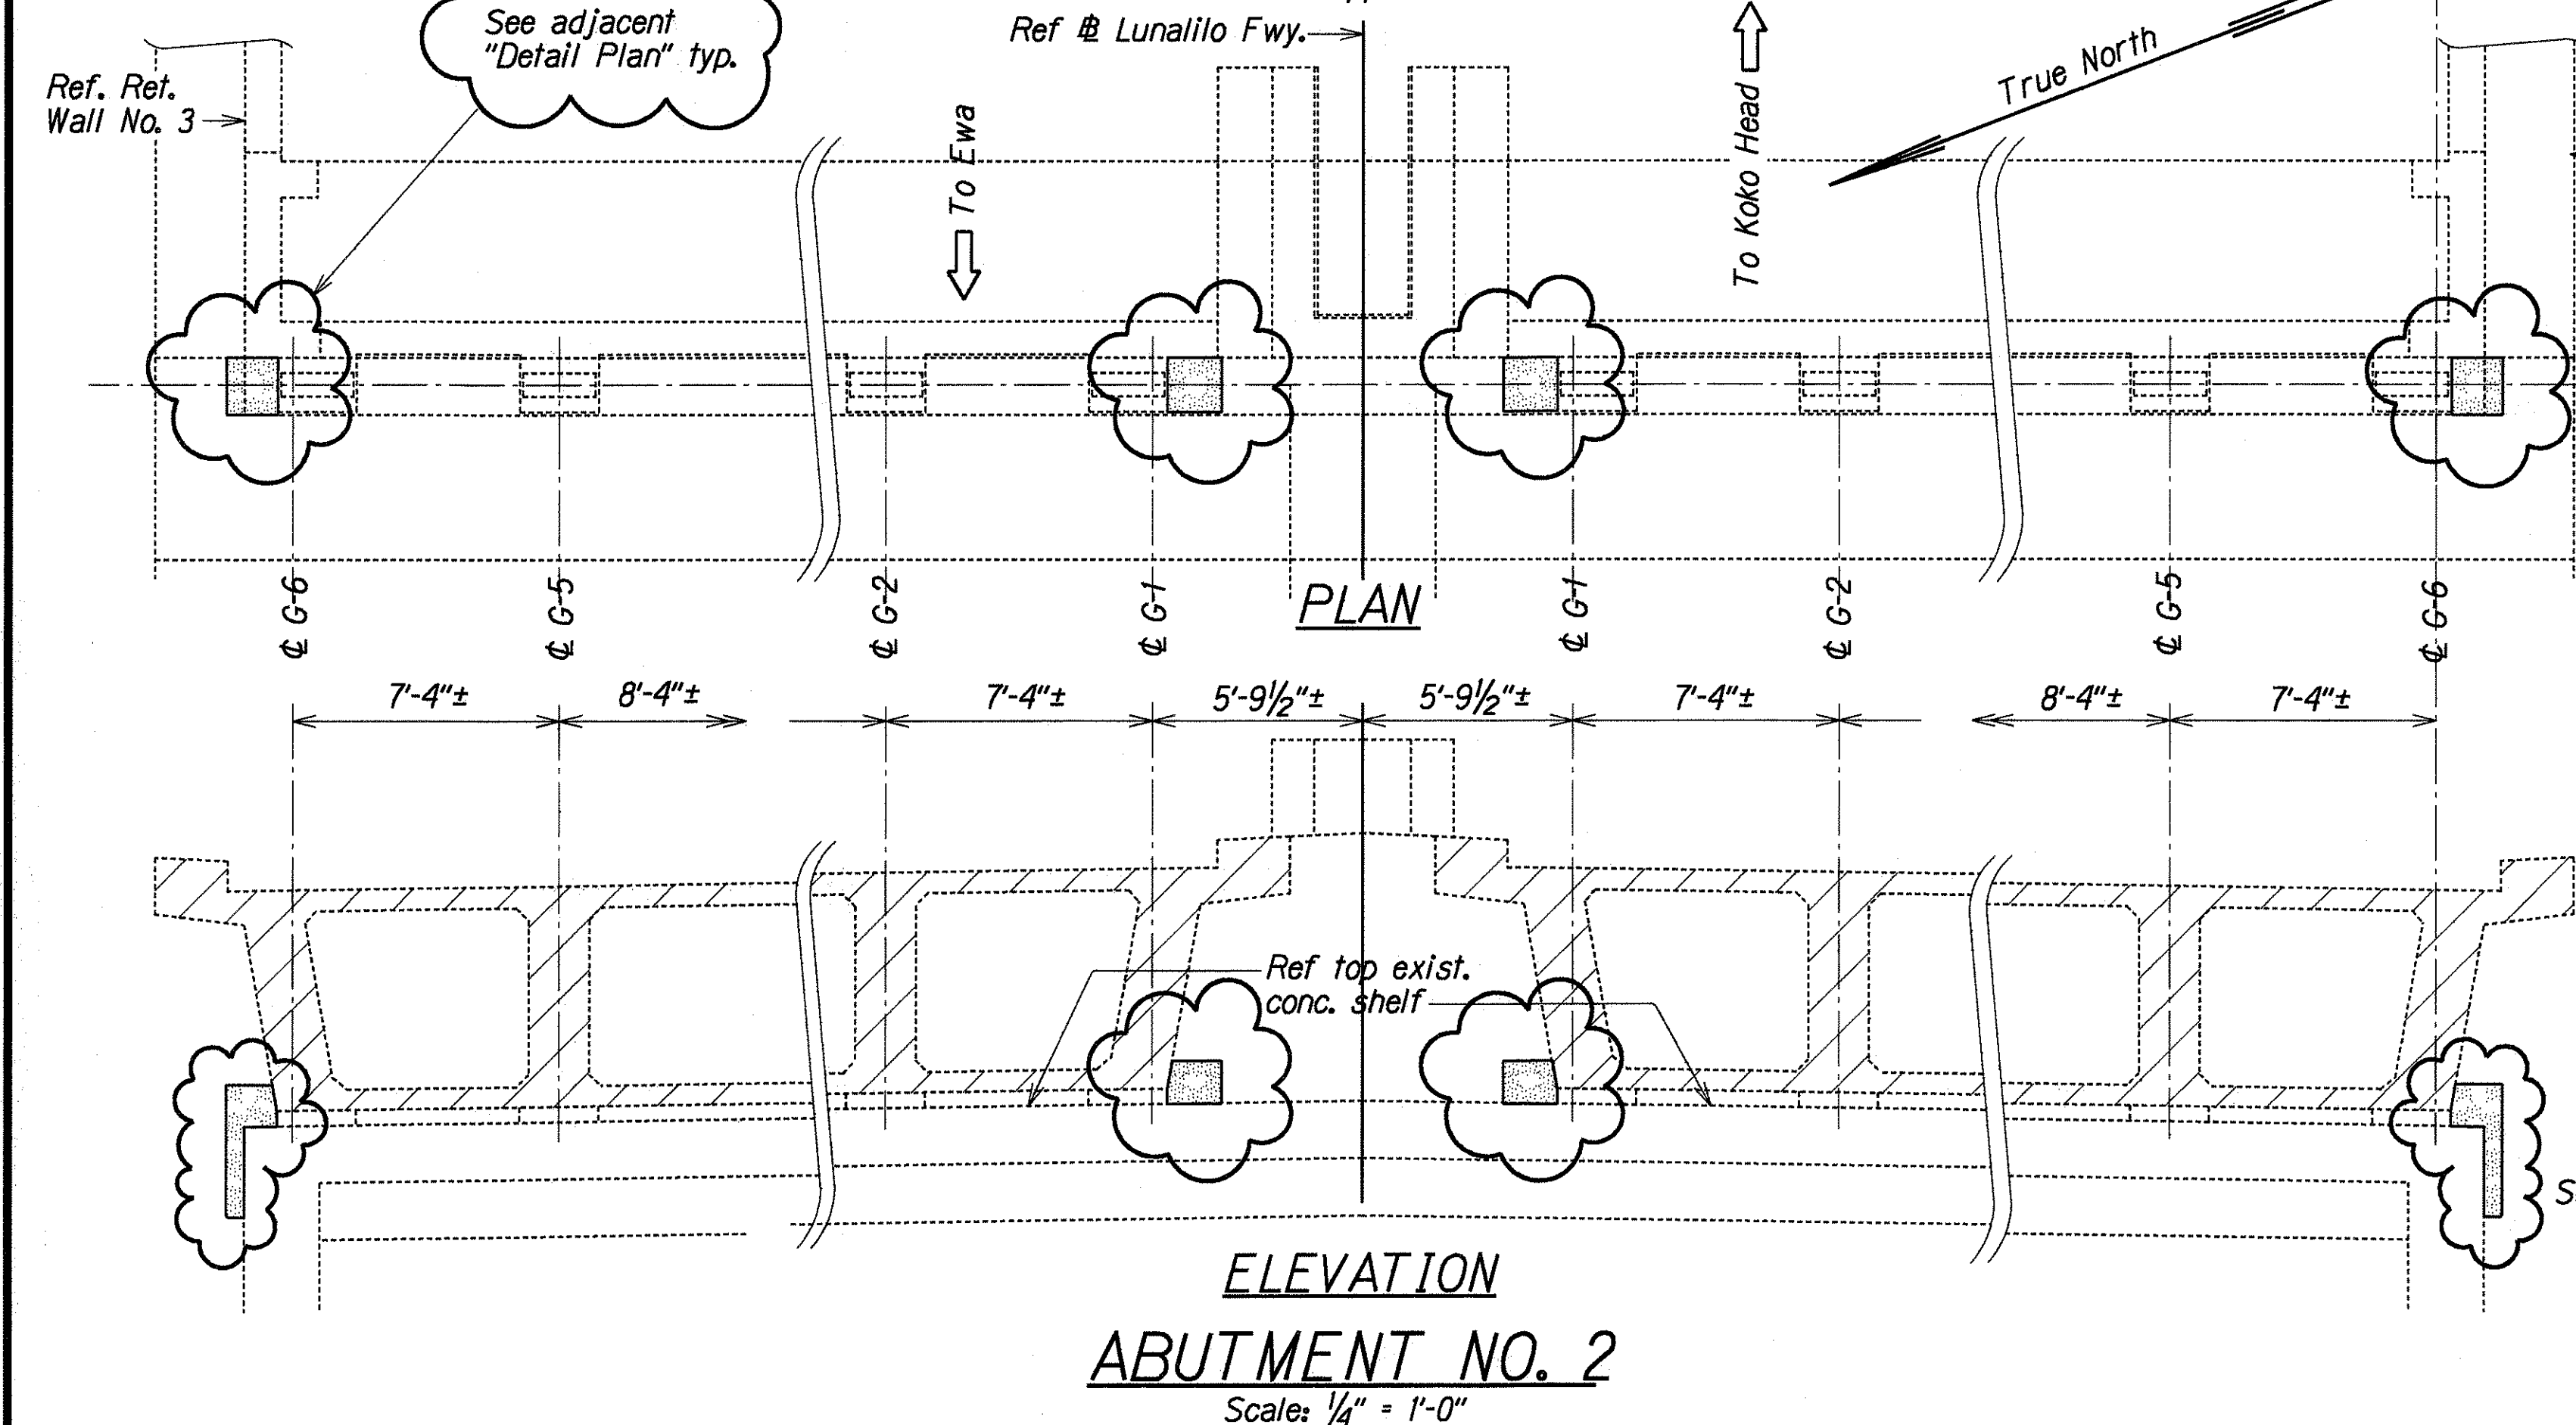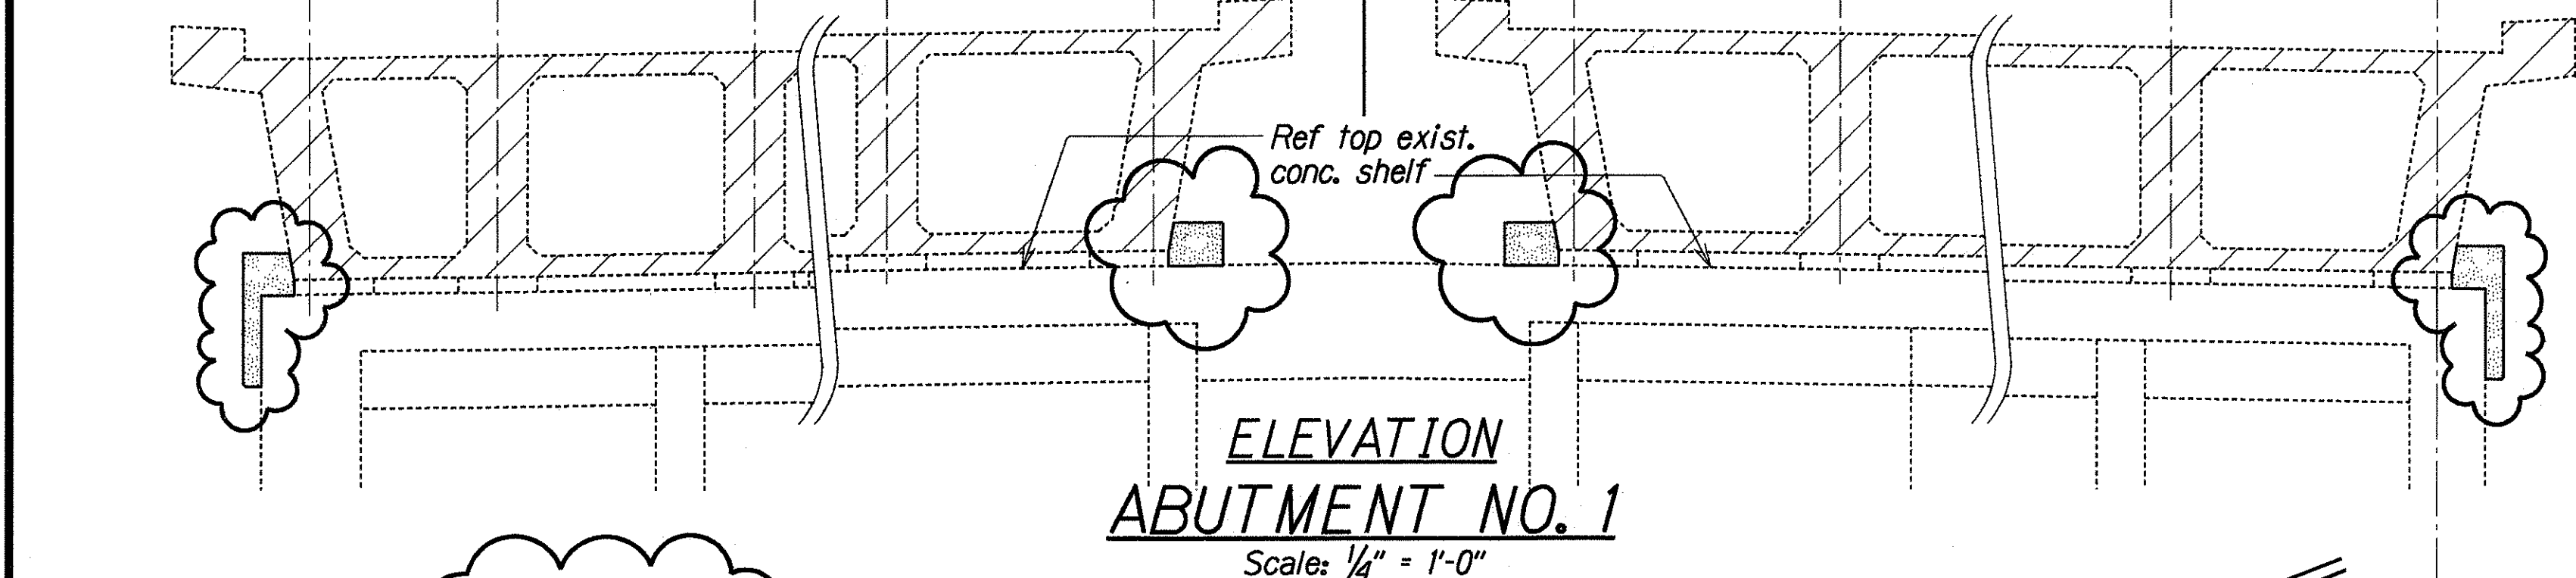

16