


FED. ROAD DIST. NO.	STATE	FED. AID PROJ. NO.	FISCAL YEAR	SHEET NO.	TOTAL SHEETS
HAWAII	HAW.	IM-H1-1(232)	2000	10	84

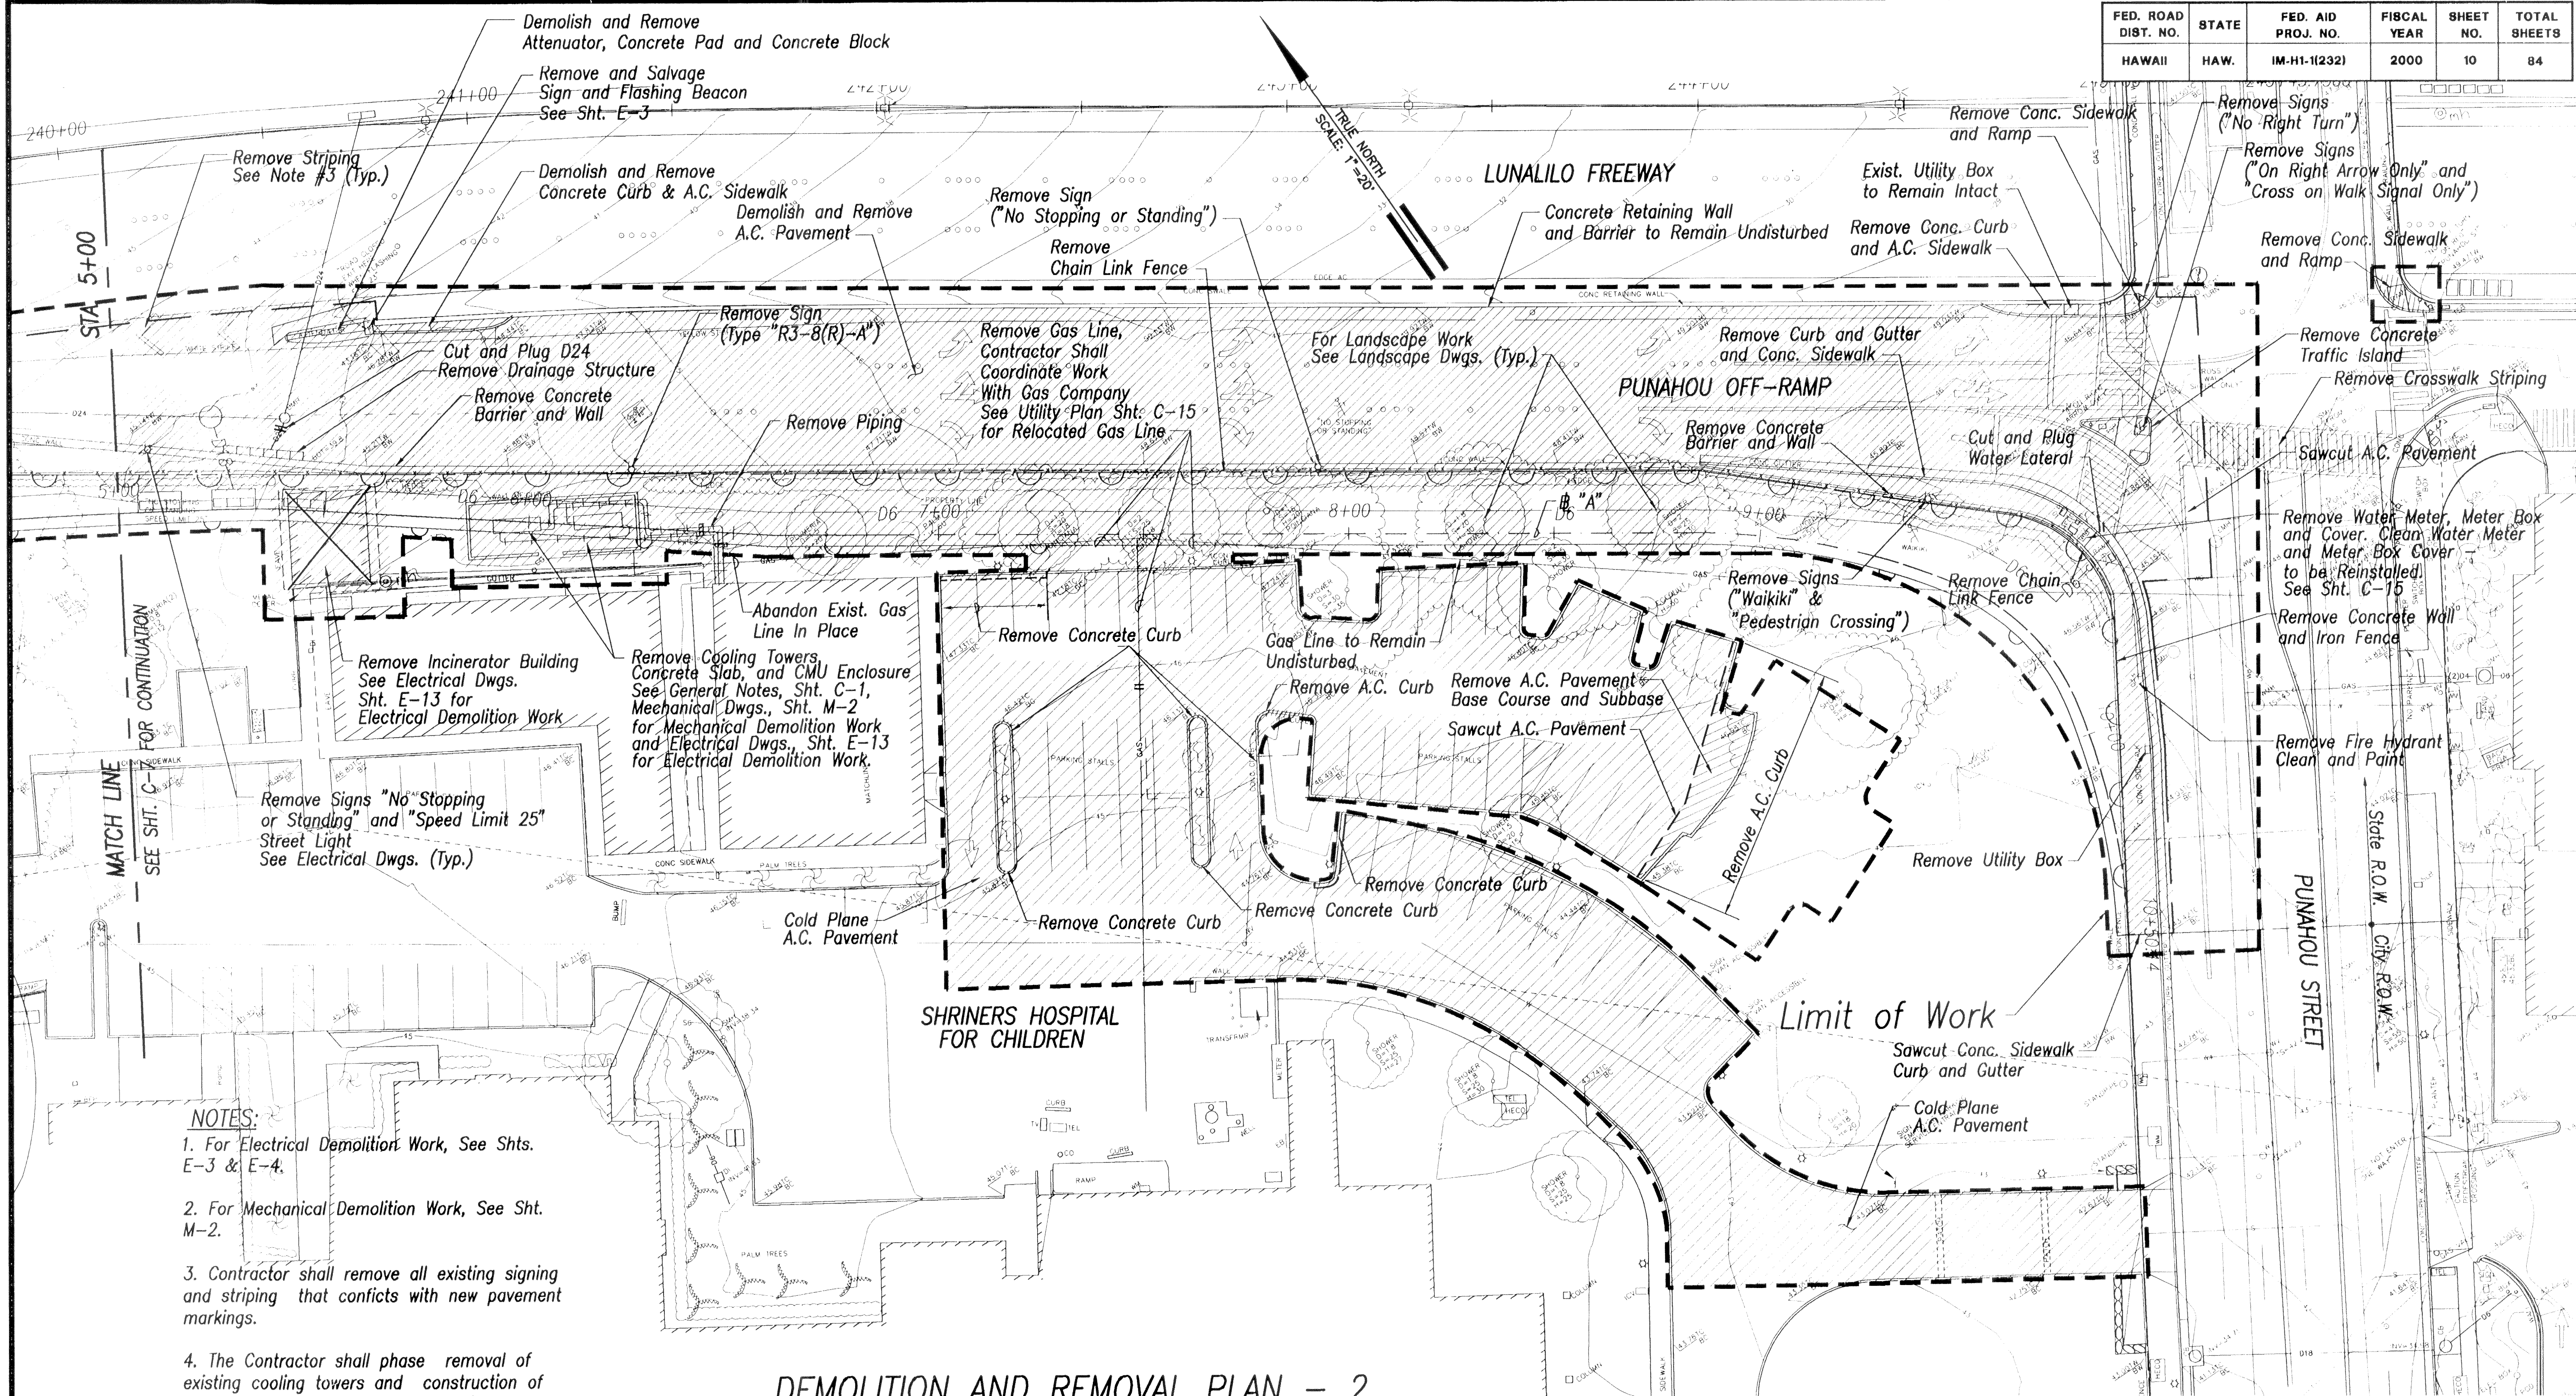



- NOTES:**
1. For Electrical Demolition Work, See Shts. E-3 & E-4.
 2. For Mechanical Demolition Work, See Sht. M-2.
 3. Contractor shall remove all existing signing and striping that conflicts with new pavement markings.
 4. The Contractor shall phase removal of existing cooling towers and construction of new cooling towers to provide continuous cooling tower operation.
 5. The Contractor shall install erosion control measures prior to the start of construction activities. See sheet C-19.
 6. Contractor shall phase demolition work and provide temporary signing and striping to provide smooth and continuous traffic flow. This work shall be considered incidental to the cost of the various contract items.

7. The Contractor shall comply with the Best Management Practices Stated on Sheet C-20, and shown on C-19

DEMOLITION AND REMOVAL PLAN - 2

SCALE: 1" = 20'

APPROVED:	
<i>M. J. [Signature]</i> Chief, Civil Engineering (Proj. Eng. DPP)	6/20/00 Date
<i>Catherine R. Dunger</i> Chief, Planning and Engineering, BWS (For Construction Within City R/W Only)	5/24/00 Date

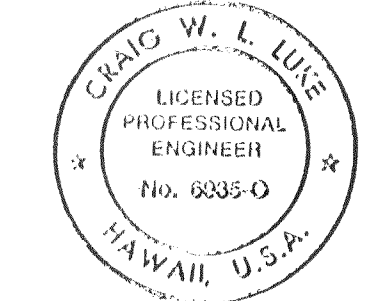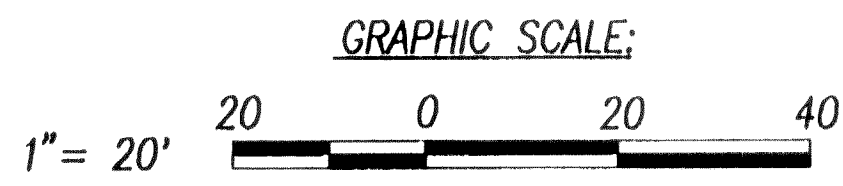

THIS WORK WAS PREPARED BY ME OR UNDER MY SUPERVISION.
 SIGNATURE: *[Signature]* DATE: 5/14/00

STATE OF HAWAII
DEPARTMENT OF TRANSPORTATION
HIGHWAYS DIVISION
DEMOLITION AND REMOVAL PLAN - 2
INTERSTATE ROUTE H-1
PUNAHOU ST. OFF-RAMP IMPROVEMENTS
F.A.I. Proj. No. IM-H1-1(232)
Scale: 1" = 20' Date: 4/28/00
SHEET No. C-8 OF 36 SHEETS

DESIGNED BY	DATE
DRAWN BY	
CHECKED BY	
NOTED BY	
QUANTITIES BY	
CHECKED BY	