


FED. ROAD DIST. NO.	STATE	FED. AID PROJ. NO.	FISCAL YEAR	SHEET NO.	TOTAL SHEETS
HAWAII	HAW.	IM-H1-1(232)	2000	16R	84

PAVING LEGEND	
	4" Cold Plane & 4" A.C. Overlay
	A.C. Pav't. w/ U.P.B.C.
	A.C. Pav't. w/o U.P.B.C.
	Concrete Pav't. w/ U.P.B.C.
	Reconstruct A.C. Pavement

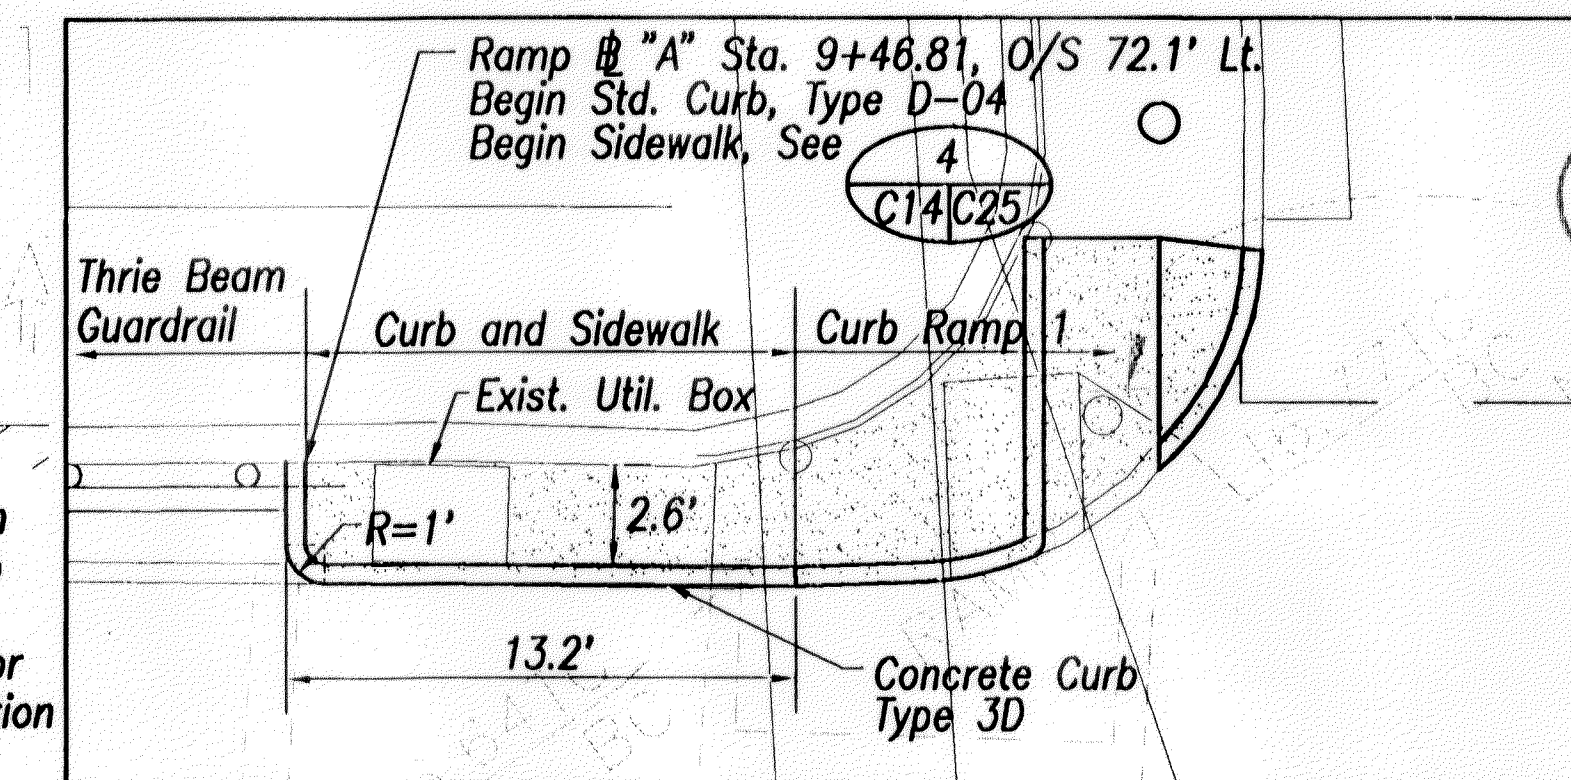


INSET
Scale: 1" = 5'

KAPIOLANI HOSPITAL CONC. ISLAND CURB RETURN STATIONS

- # "A" Sta. 9+55.73 O/S 46.15' LT.
- # "A" Sta. 9+56.30 O/S 42.49' LT.
- # "A" Sta. 9+72.82 O/S 41.63' LT.
- # "A" Sta. 9+73.55 O/S 45.18' LT.
- # "A" Sta. 9+66.11 O/S 58.51' LT.
- # "A" Sta. 9+64.05 O/S 58.68' LT.

CURVE DATA

	7	8	9	10	11
Δ	15°44'26"	02°45'25"	50°20'36"	18°31'01"	16°42'50"
$\Delta/2$	07°52'13"	01°22'42.5"	25°10'18"	9°15'33.5"	08°21'25"
R	20.00'	180.00'	65.00'	100.00'	100.00'
T	2.76'	4.33'	30.55'	29.51'	14.69'
C	5.48'	8.66'	55.29'	50.24'	29.07'
L	5.49'	8.66'	57.11'	50.49'	29.17'

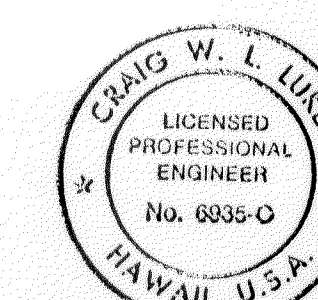

STATE OF HAWAII
DEPARTMENT OF TRANSPORTATION
HIGHWAYS DIVISION
INTERSECTION PLAN
INTERSTATE ROUTE H-1
PUNAHOU ST. OFF-RAMP IMPROVEMENTS
F.A.I. Proj. No. IM-H1-1(232)

Scale: 1" = 10' Date: 4/28/00

SHEET No. C-14 OF 36 SHEETS

DATE	6/20/01
SURVEY PLOTTED BY	REVISION
DESIGN BY	REVISION
TRACED BY	REVISION
CHECKED BY	REVISION
ORIGINAL PLAN	REVISION
NOTE BOOK	REVISION
No.	REVISION

6/20/01	REVISED CURVE DATA 10.
12/27/00	ADDED TIES TO SAWCUT CORNERS REVISED CURVE DATA 11.
DATE	REVISION

INTERSECTION PLAN

SCALE: 1" = 10'

