


FED. ROAD DIST. NO.	STATE	FED. AID PROJ. NO.	FISCAL YEAR	SHEET NO.	TOTAL SHEETS
HAWAII	HAW.	IM-H1-1(232)	2000	19R	84


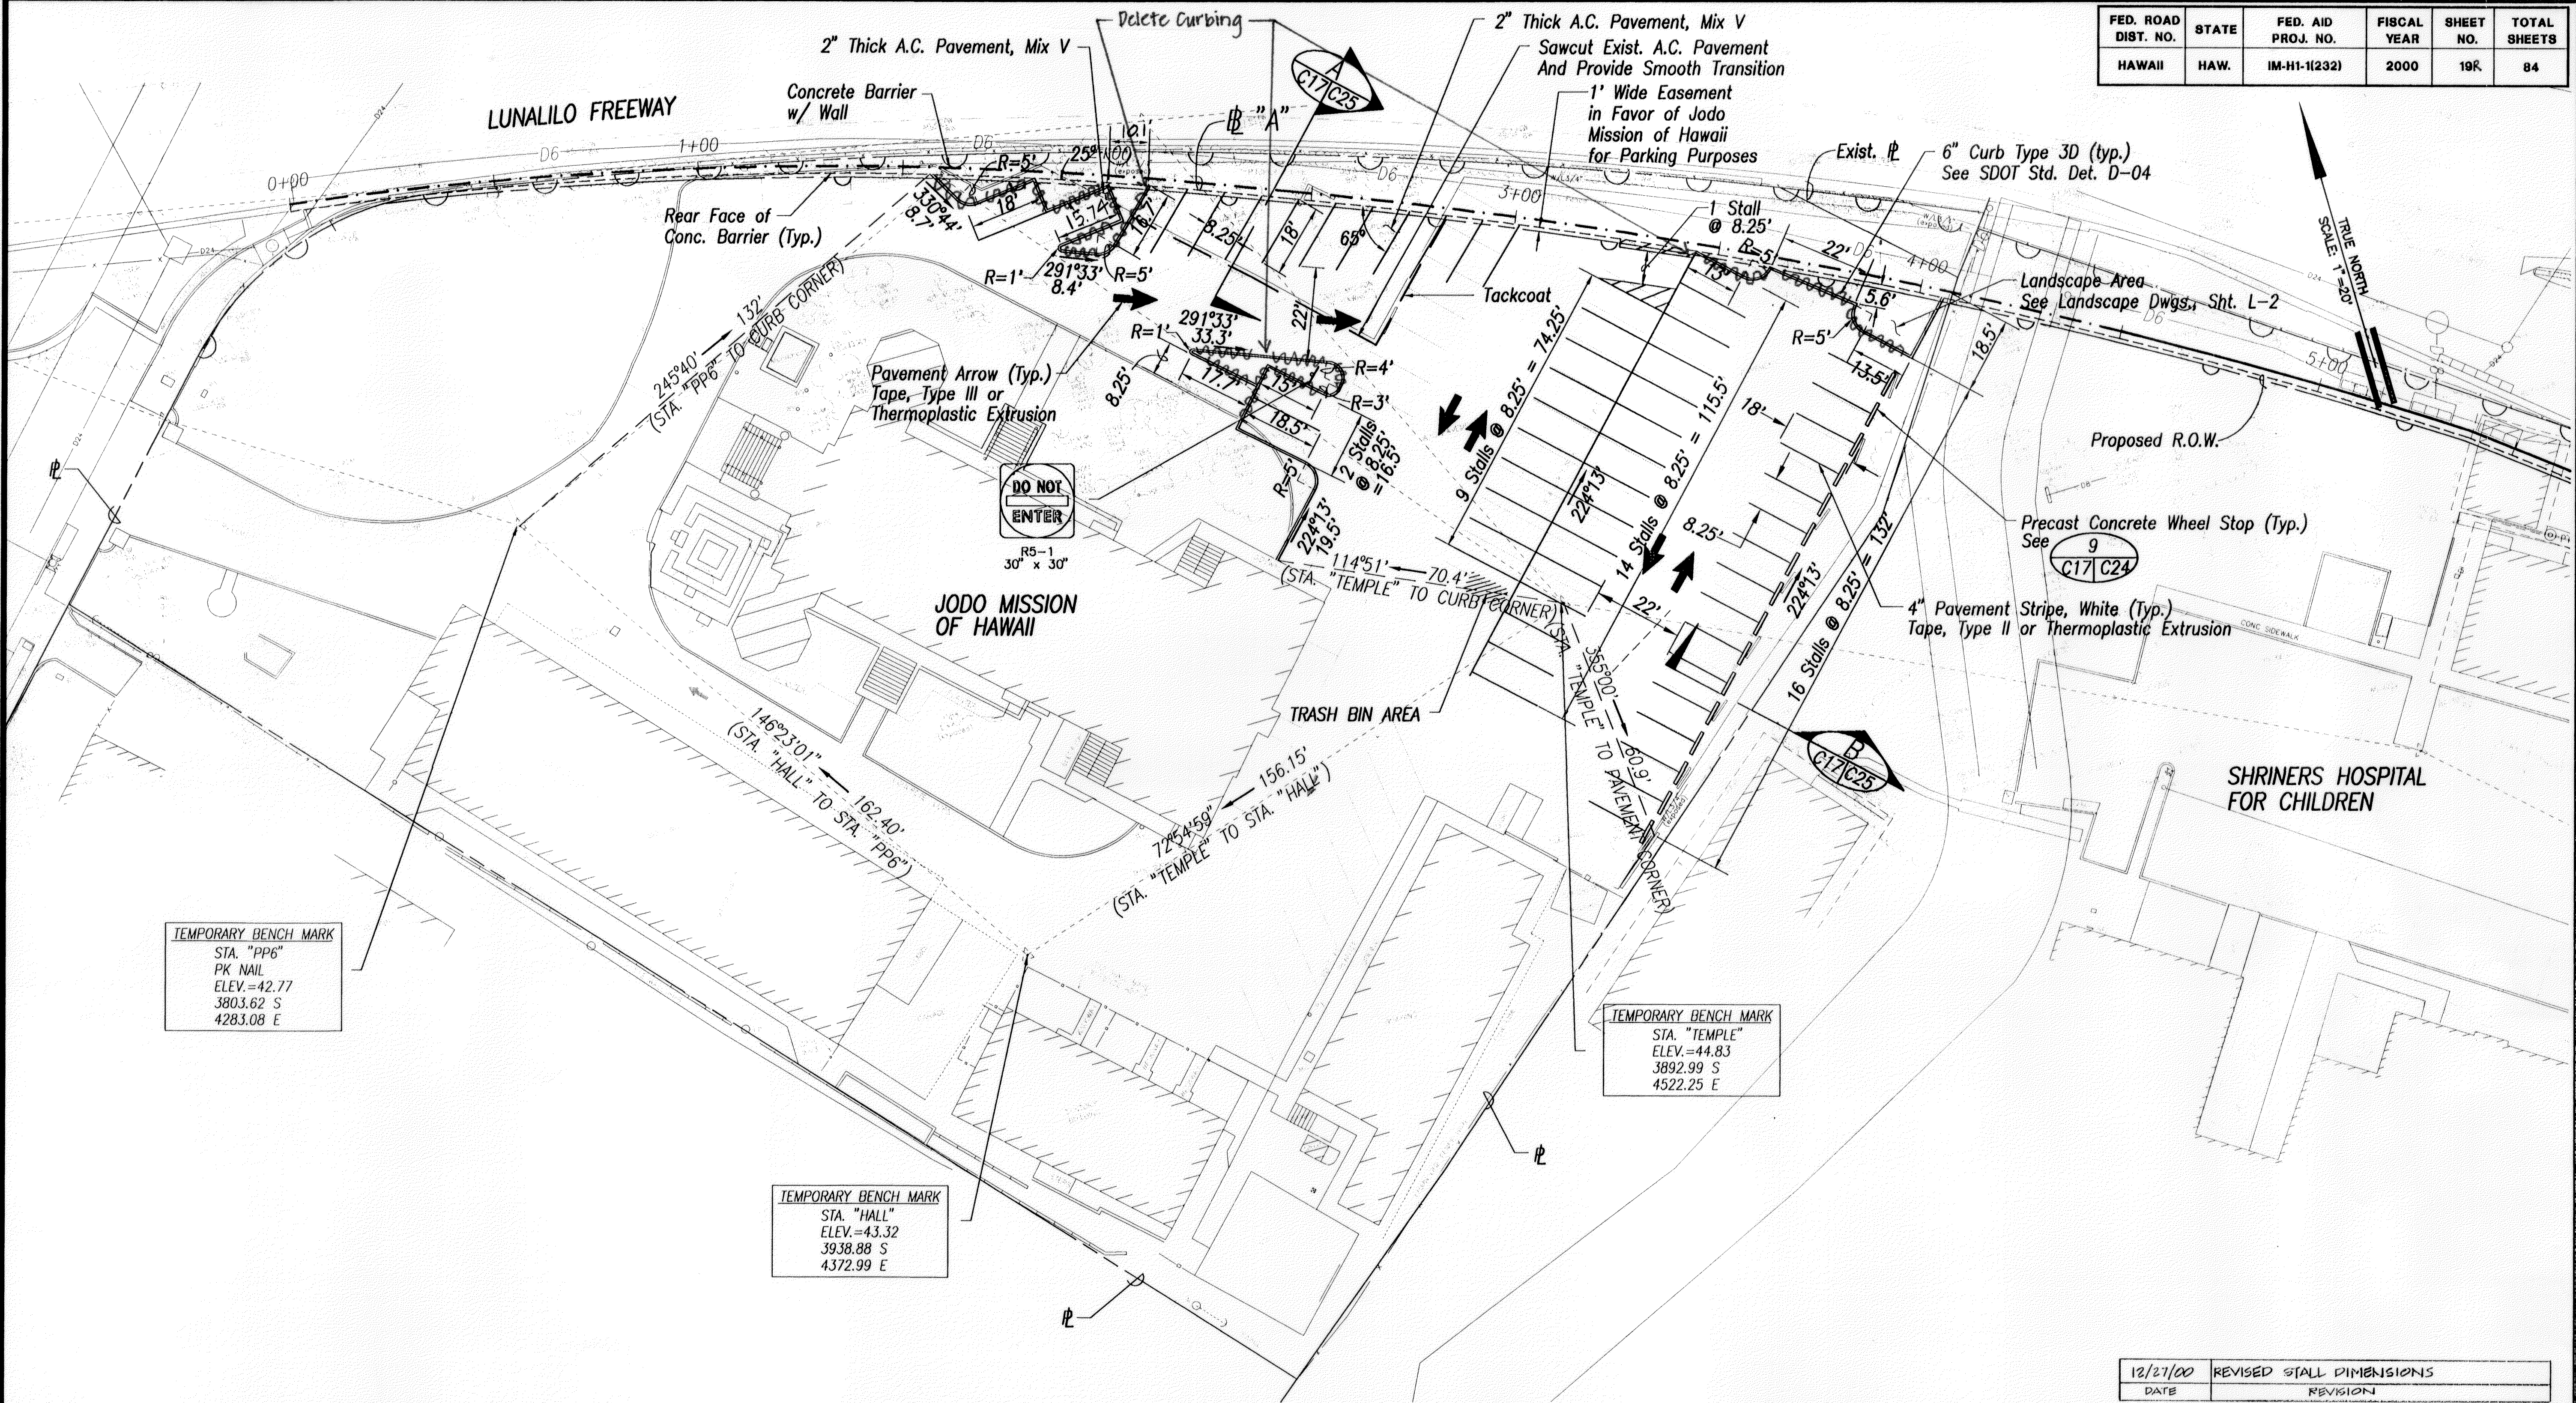


TEMPORARY BENCH MARK
STA. "PP6"
PK NAIL
ELEV.=42.77
3803.62 S
4283.08 E

TEMPORARY BENCH MARK
STA. "HALL"
ELEV.=43.32
3938.88 S
4372.99 E

TEMPORARY BENCH MARK
STA. "TEMPLE"
ELEV.=44.83
3892.99 S
4522.25 E

**JODO MISSION OF HAWAII
SITE LAYOUT AND UTILITY PLAN**
SCALE: 1" = 20'

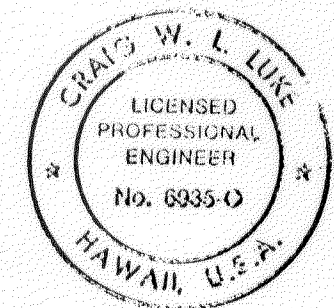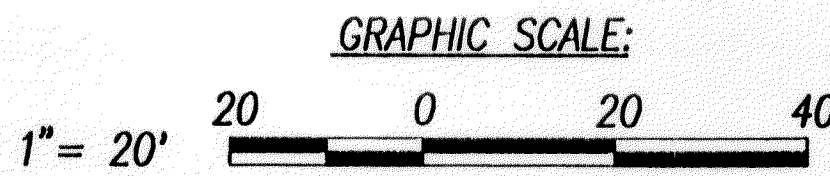

THIS WORK WAS PREPARED BY ME
OR UNDER MY SUPERVISION.

SIGNATURE
DATE

12/27/00	REVISED STALL DIMENSIONS
DATE	REVISION

STATE OF HAWAII
DEPARTMENT OF TRANSPORTATION
HIGHWAYS DIVISION

**JODO MISSION OF HAWAII
SITE LAYOUT AND UTILITY PLAN**

INTERSTATE ROUTE H-1
PUNAHOU ST. OFF-RAMP IMPROVEMENTS
F.A.I. Proj. No. IM-H1-1(232)

Scale: 1" = 20' Date: 4/28/00

SHEET No. C-17 OF 36 SHEETS

GENERAL PLAN	SURVEY PLOTTED BY	DATE
	DESIGNED BY	
	DESIGNED BY	
	QUANTITIES BY	
NOTE BOOK	NO.	
	CHECKED BY	

"AS-BUILT"