


INDEX TO DRAWINGS	
SHEET NO.	DESCRIPTION
1	TITLE SHEET
2	GENERAL NOTES AND LEGEND
3 - 4	NPDES GENERAL NOTES
5	ROADWAY PLAN
6 - 7	DRAINAGE DETAILS AND NOTES



FED. ROAD DIST. NO.	STATE	PROJ. NO.	FISCAL YEAR	SHEET NO.	TOTAL SHEETS
HAWAII	HAW.	H1A-01-99	2001	1	7

STATE OF HAWAII
DEPARTMENT OF TRANSPORTATION
HIGHWAYS DIVISION
HONOLULU, HAWAII
"AS-BUILT"
PLANS FOR
**INTERSTATE ROUTE H-1
DRAINAGE IMPROVEMENTS**
**RELINING 120" CULVERT, VICINITY OF
MAKAKILO INTERCHANGE**
PROJECT NO. H1A-01-99


DISTRICT OF EWA
ISLAND OF OAHU

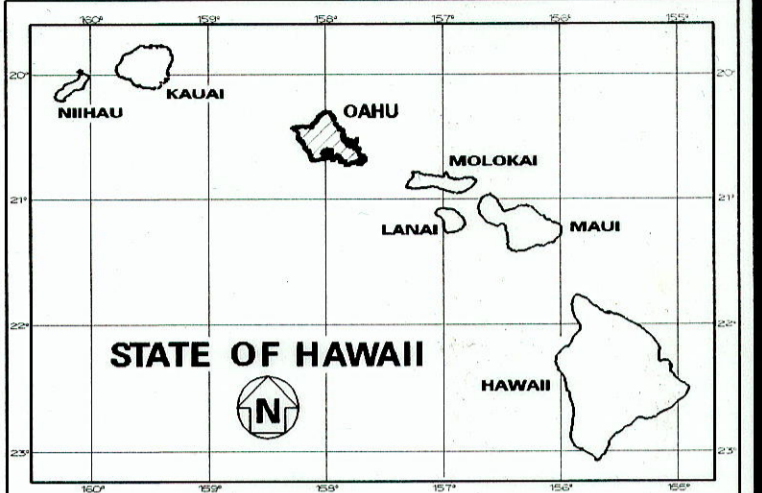


LOCATION OF PROJECT

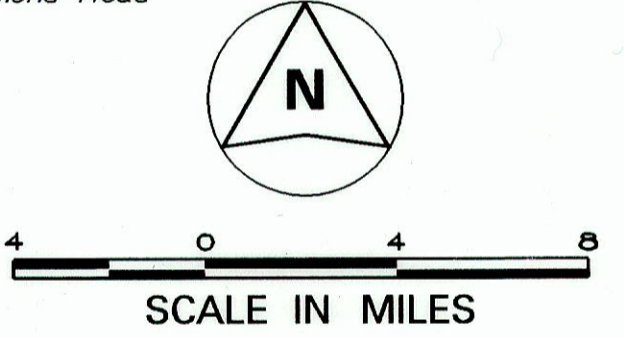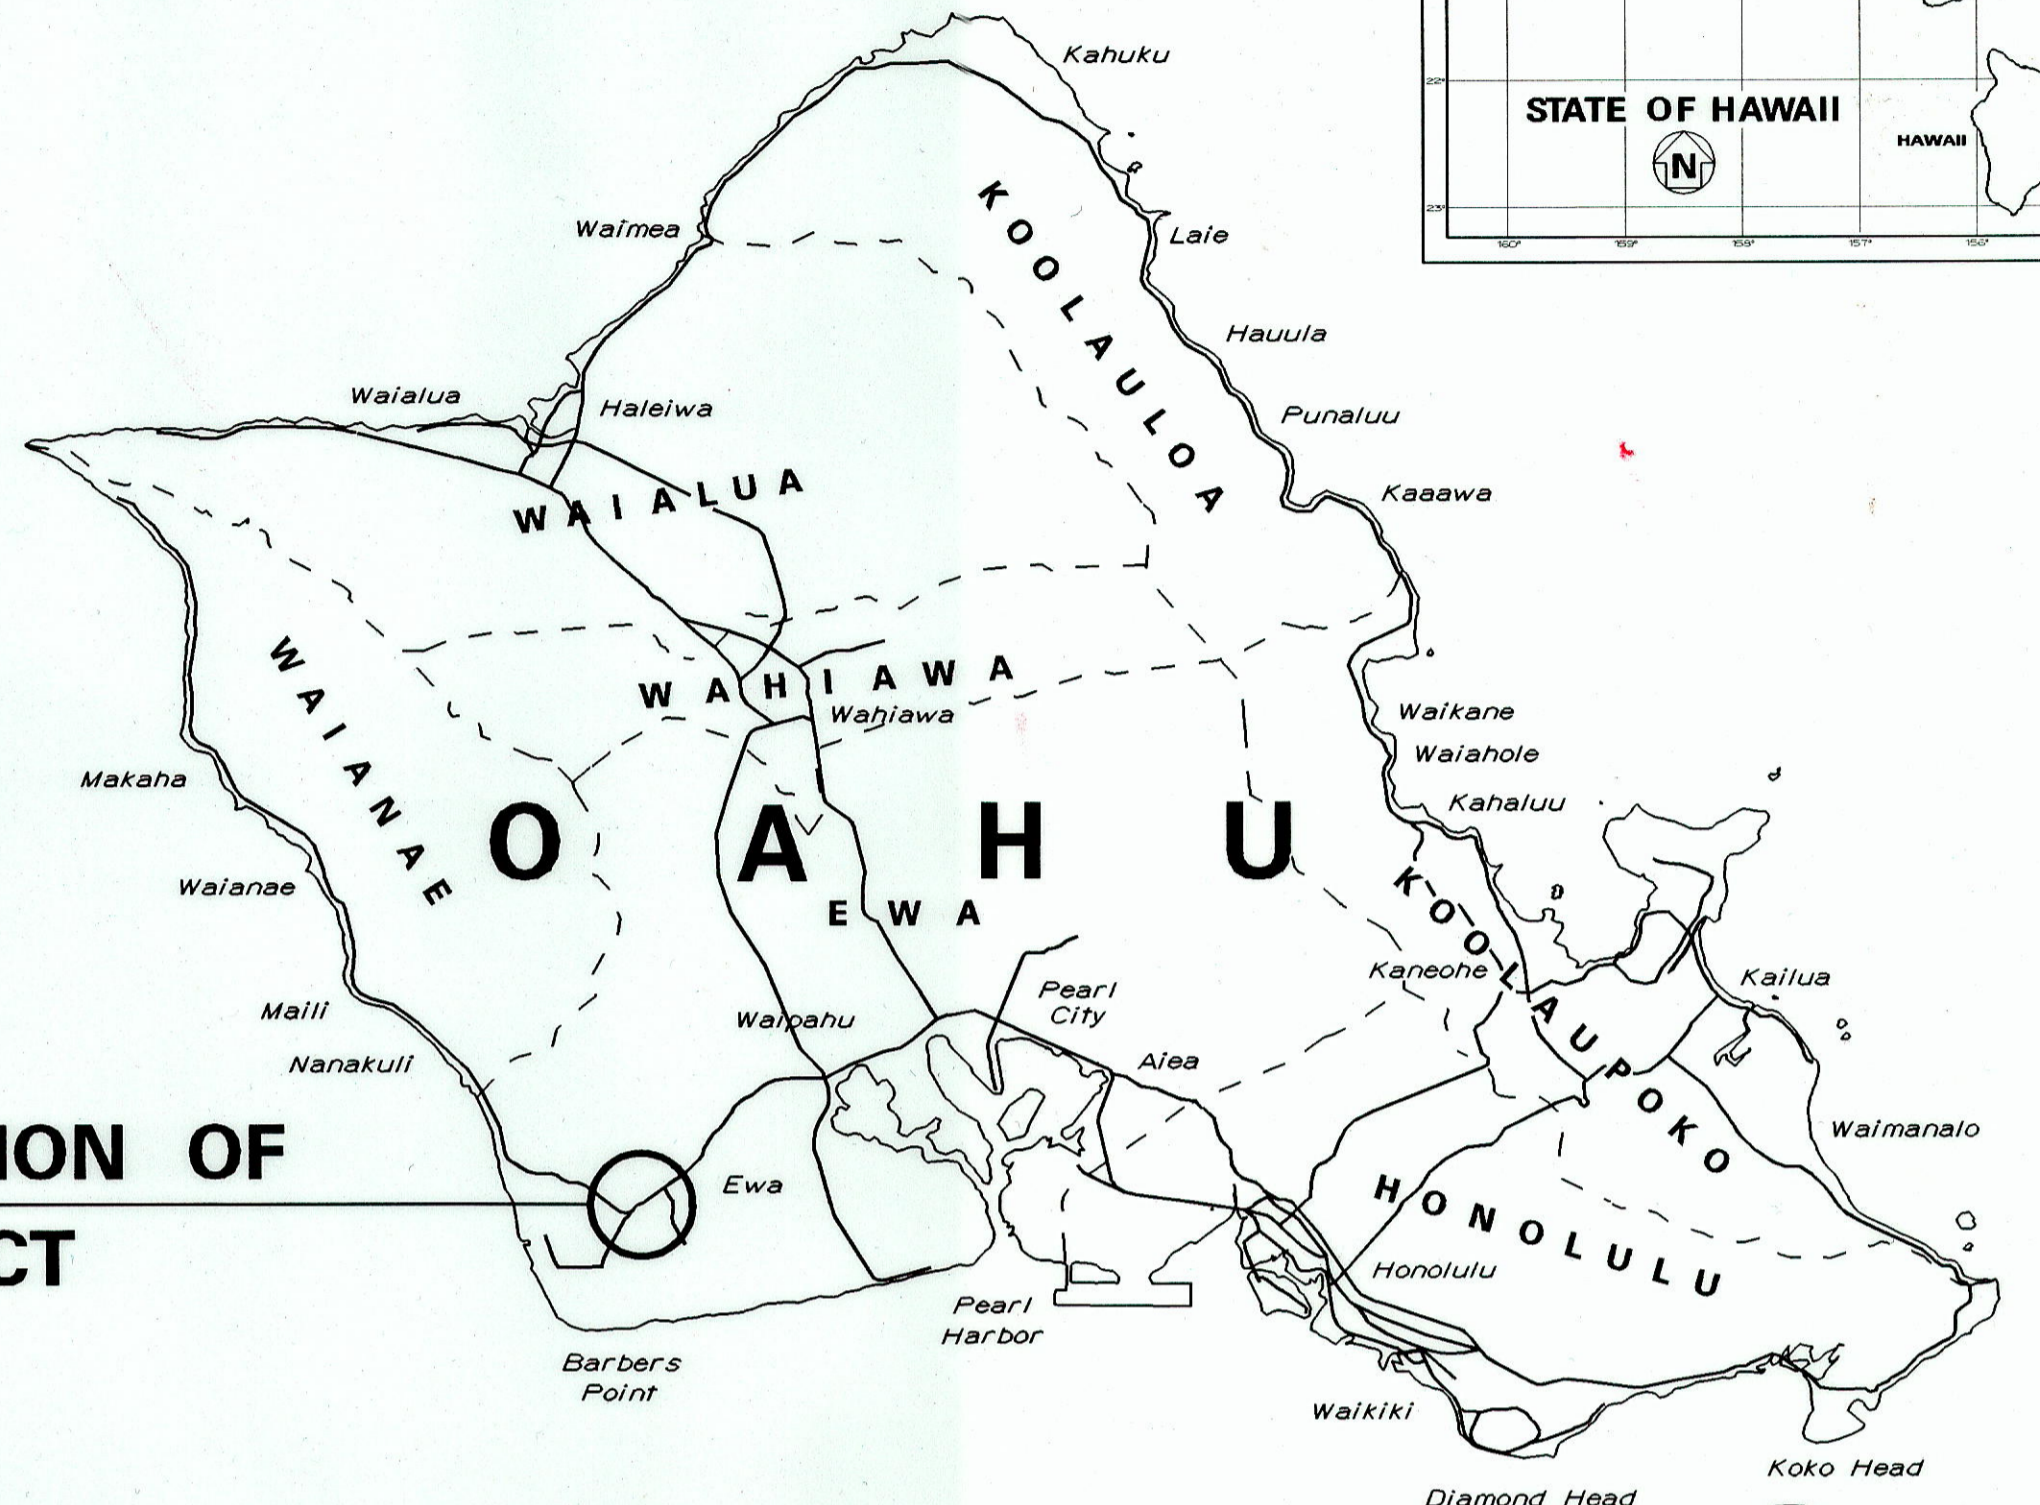

MILE POST 1.22 TO MILE POST 1.22

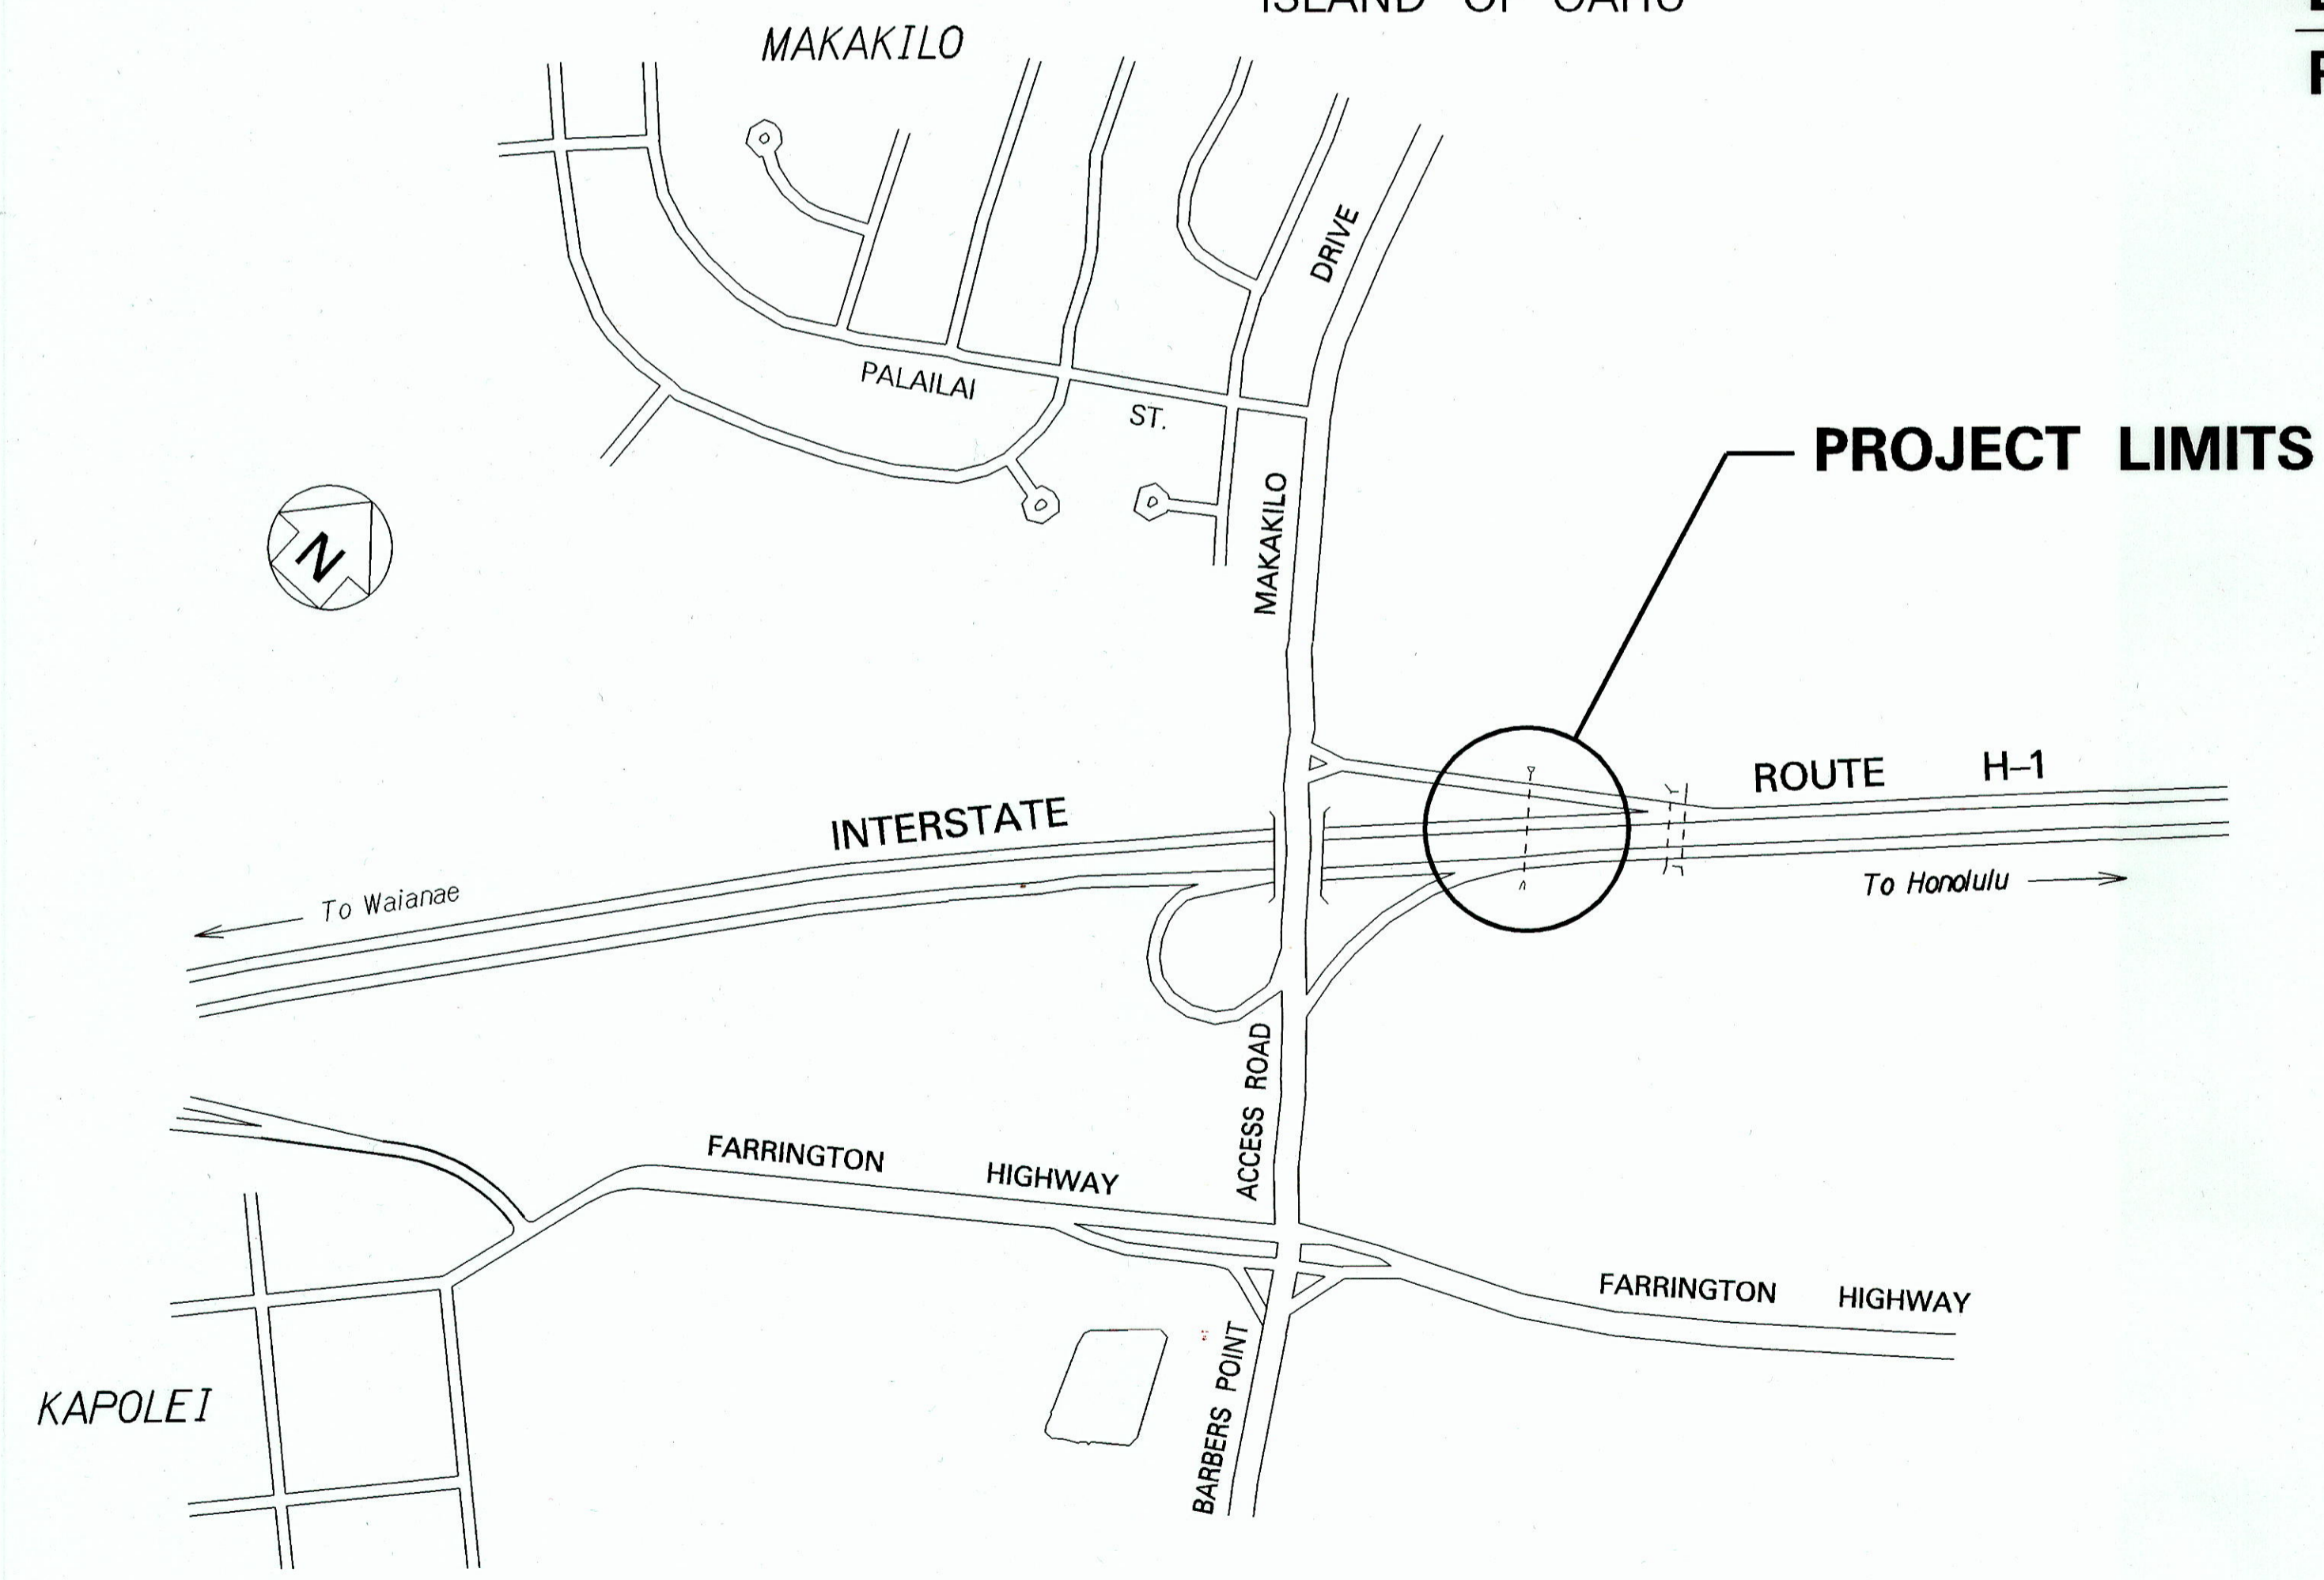

LAYOUT PLAN

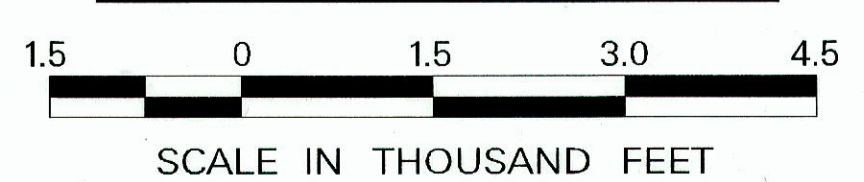

NO SIGNIFICANT CHANGES WERE MADE DURING CONSTRUCTION ON THESE PLANS EXCEPT CHANGES IN THE ORIGINAL THEORETICAL QUANTITIES. FOR ACTUAL QUANTITIES, REFER TO PROJECT LEDGER AND/OR COMPUTATION BOOK.

[Signature] *[Signature]*
RESIDENT ENGINEER DATE

DEPARTMENT OF TRANSPORTATION
STATE OF HAWAII
APPROVED:
[Signature] 5-11-01
FOR DIR. OF TRANSPORTATION DATE

UNIT "C"
DESIGNED BY
R. HIRONAKA
P. S. & E. BY
692-7575
PHONE
MAY 2001
DATE