


FED. ROAD DIS. NO.	STATE	PROJ. NO.	FISCAL YEAR	SHEET NO.	TOTAL SHEETS
HAWAII	HAW.	BR-H1-1(226)	2003	35	36

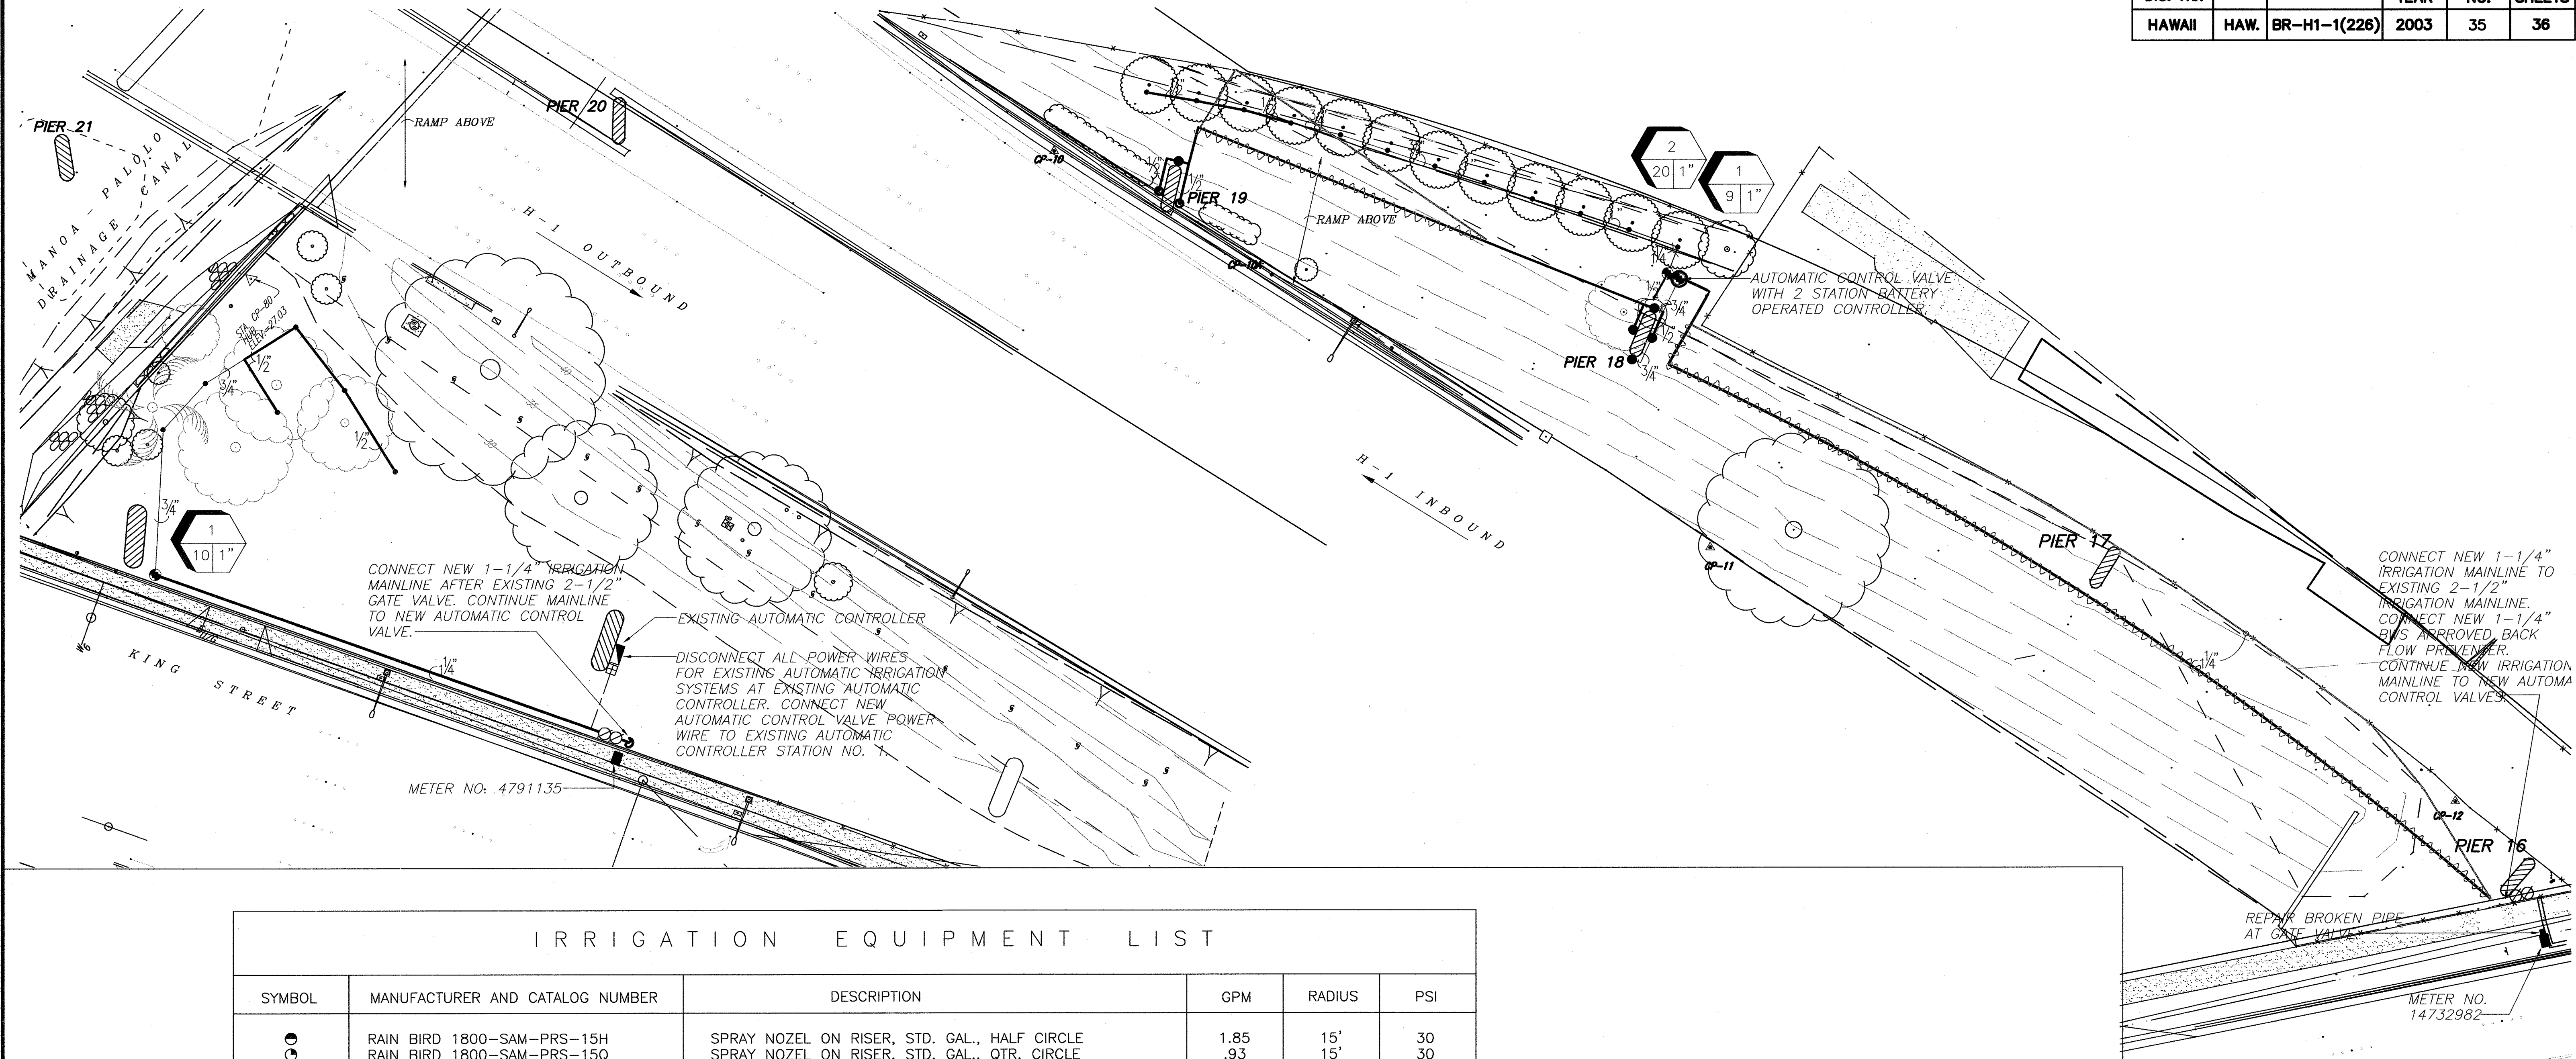

IRRIGATION EQUIPMENT LIST


SYMBOL	MANUFACTURER AND CATALOG NUMBER	DESCRIPTION	GPM	RADIUS	PSI
●	RAIN BIRD 1800-SAM-PRS-15H	SPRAY NOZEL ON RISER, STD. GAL., HALF CIRCLE	1.85	15'	30
●	RAIN BIRD 1800-SAM-PRS-15Q	SPRAY NOZEL ON RISER, STD. GAL., QTR. CIRCLE	.93	15'	30
●	RAIN BIRD 1300A-F	ADJUSTABLE FULL CIRCLE FLOOD BUBBLER ON RISER	1.7	-	30
⊙	RAINBIRD EFB-CP SERIES WITH RAINBIRD TBOS (OR EQUAL)	REMOTE CONTROL VALVE WITH BATTERY OPERATED REMOTE CONTROLLER			
⊙	RAINBIRD EFB-CP SERIES (OR EQUAL)	REMOTE CONTROL VALVE			
⊙	BUCKNER QB44BLAR07 (OR EQUAL)	QUICK COUPLER VALVE, KEY, HOSE SWIVEL ELLS			
⊙	EXISTING AUTOMATIC CONTROLLER				
⊙	PULL BOX				
⊙	FEBCO 860	BACKFLOW PREVENTER			
—	PVC SCHEDULE 40 PIPE	IRRIGATION MAIN			
—	PVC CLASS 200 PIPE	IRRIGATION LATERAL			
—	PVC SCHEDULE 80 PIPE	IRRIGATION CONDUIT			
⬢	STATION NUMBER				
⬢	GPM OF SYSTEM / SIZE OF RCV				
○	SIZE OF SLEEVE				
⬢	SIZE OF CONDUIT				

RECORD DRAWING
 The details, locations and other information shown are based on information provided by others. The design consultant cannot assure the accuracy and completeness of the information. The user of this drawing shall be responsible to verify its accuracy and completeness

LEGEND FOR AS-BUILT POSTINGS

~~~~~ Squiggly line for as-built deletion

**NOTE:**  
 CONTRACTOR TO FIELD VERIFY LOCATIONS OF EXISTING IRRIGATION LINES AND EQUIPMENT. SEE DEPARTMENT OF TRANSPORTATION HIGHWAYS DIVISION DRAWINGS F.A.I. PROJECT NO. I-HI-1(5):24 UNIT 2.

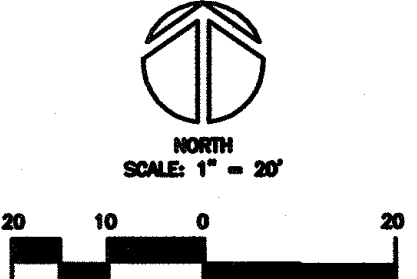

THIS WORK WAS PREPARED BY ME OR UNDER MY SUPERVISION

STATE OF HAWAII  
 DEPARTMENT OF TRANSPORTATION  
 HIGHWAYS DIVISION

LANDSCAPE IRRIGATION PLAN  
 AND  
 IRRIGATION EQUIPMENT LIST

INTERSTATE ROUTE H-1, SEISMIC RETROFIT PH. 2  
 KAPIOLANI INTERCHANGE  
 FAIP NO.BR-H1-1(226)

SCALE: AS NOTED DATE: JUNE 2002  
 SHEET No. L-2 OF 3 SHEETS

|             |       |
|-------------|-------|
| DESIGNED BY | _____ |
| CHECKED BY  | _____ |
| DRAWN BY    | _____ |
| PLANNED BY  | _____ |
| REVIEWED BY | _____ |
| DATE        | _____ |

AS-BUILT

