


INDEX TO DRAWINGS	
SHEET NO.	DESCRIPTION
1	TITLE SHEET
2	LIST OF ABBREVIATIONS & SYMBOLS & ESTIMATED QUANTITIES
3	STANDARD PLANS SUMMARY
4 (C1)	CONSTRUCTION NOTES
5 (C2)	ENVIRONMENTAL NOTES - 1
6 (C3)	ENVIRONMENTAL NOTES - 2
7 (C4)	BORING LOGS
8 (C5)	EXISTING PIER LAY-OUT & KEY PLAN
9 - 12	SITE PLANS
13 - 20 (C10-C17)	TEMPORARY STRIPING PLANS
21 - 23 (C18-C20)	RESTRIPING PLANS
24 (C21)	TRAFFIC CONTROL PLAN FOR KAPIOLANI BLVD OFFRAMP CLOSURE
25	GENERAL BRIDGE RETROFIT NOTES & LIMITS OF PAYMENT FOR STRUCTURAL EXCAVATION & BACKFILL
26	LONGITUDINAL SECTION - RAMP STRUCTURE PIERS 18, 19 & 21
27	TYPE 1 RESTRAINER DETAILS
28	CABLE YIELD INDICATOR & SEAT EXTENDER DETAILS
29	ACCESS HATCH DETAILS
30	PILED FOOTING RETROFIT PLANS & DETAILS - PIERS 18 & 21
31	PILED FOOTING RETROFIT PLAN & DETAILS - PIER 19
32	PILE DETAILS, PILE FOOTING RETROFIT SCHEDULE
33	TOP DECK SPALL REPAIR PLAN, DETAILS & NOTES
34	LANDSCAPE DEMOLITION PLAN, LANDSCAPE PLANTING PLAN, NOTES & DETAILS
35	LANDSCAPE IRRIGATION PLAN & EQUIPMENT LIST
36	LANDSCAPE IRRIGATION NOTES & DETAILS

Sato & Associates, Inc. Emilio Barraga, Jr. 692-7546 Sept 2002
DESIGNED BY P.S. & E. BY PHONE DATE


SURVEY PLOTTED BY	DATE
DRAWN BY	
DESIGNED BY	
CHECKED BY	
NOTE BOOK	
NO.	

STATE OF HAWAII
DEPARTMENT OF TRANSPORTATION
HIGHWAYS DIVISION
HONOLULU, HAWAII
"AS-BUILT"
PLANS FOR
INTERSTATE ROUTE H-1,
SEISMIC RETROFIT
KAPIOLANI INTERCHANGE
PHASE 2
FEDERAL AID INTERSTATE PROJECT NO. BR-H1-1 (226)
DISTRICT OF HONOLULU
ISLAND OF OAHU

FED. ROAD DIST. NO.	STATE	FED. AID PROJ. NO.	FISCAL YEAR	SHEET NO.	TOTAL SHEETS
HAWAII	HAW.	BR-H1-1 (226)	2003	1	38

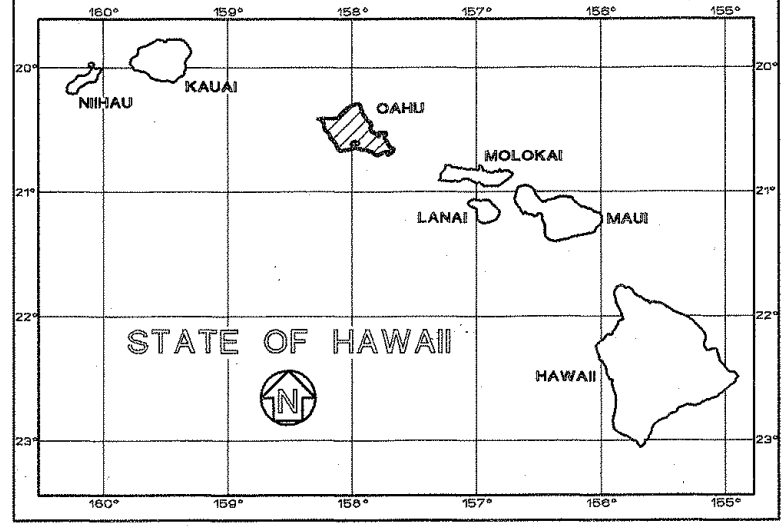


LOCATION OF PROJECT

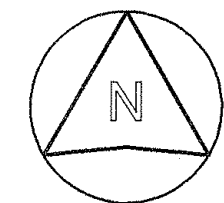

SCALE IN MILES

MILE POST 25.25 TO MILE POST 25.40

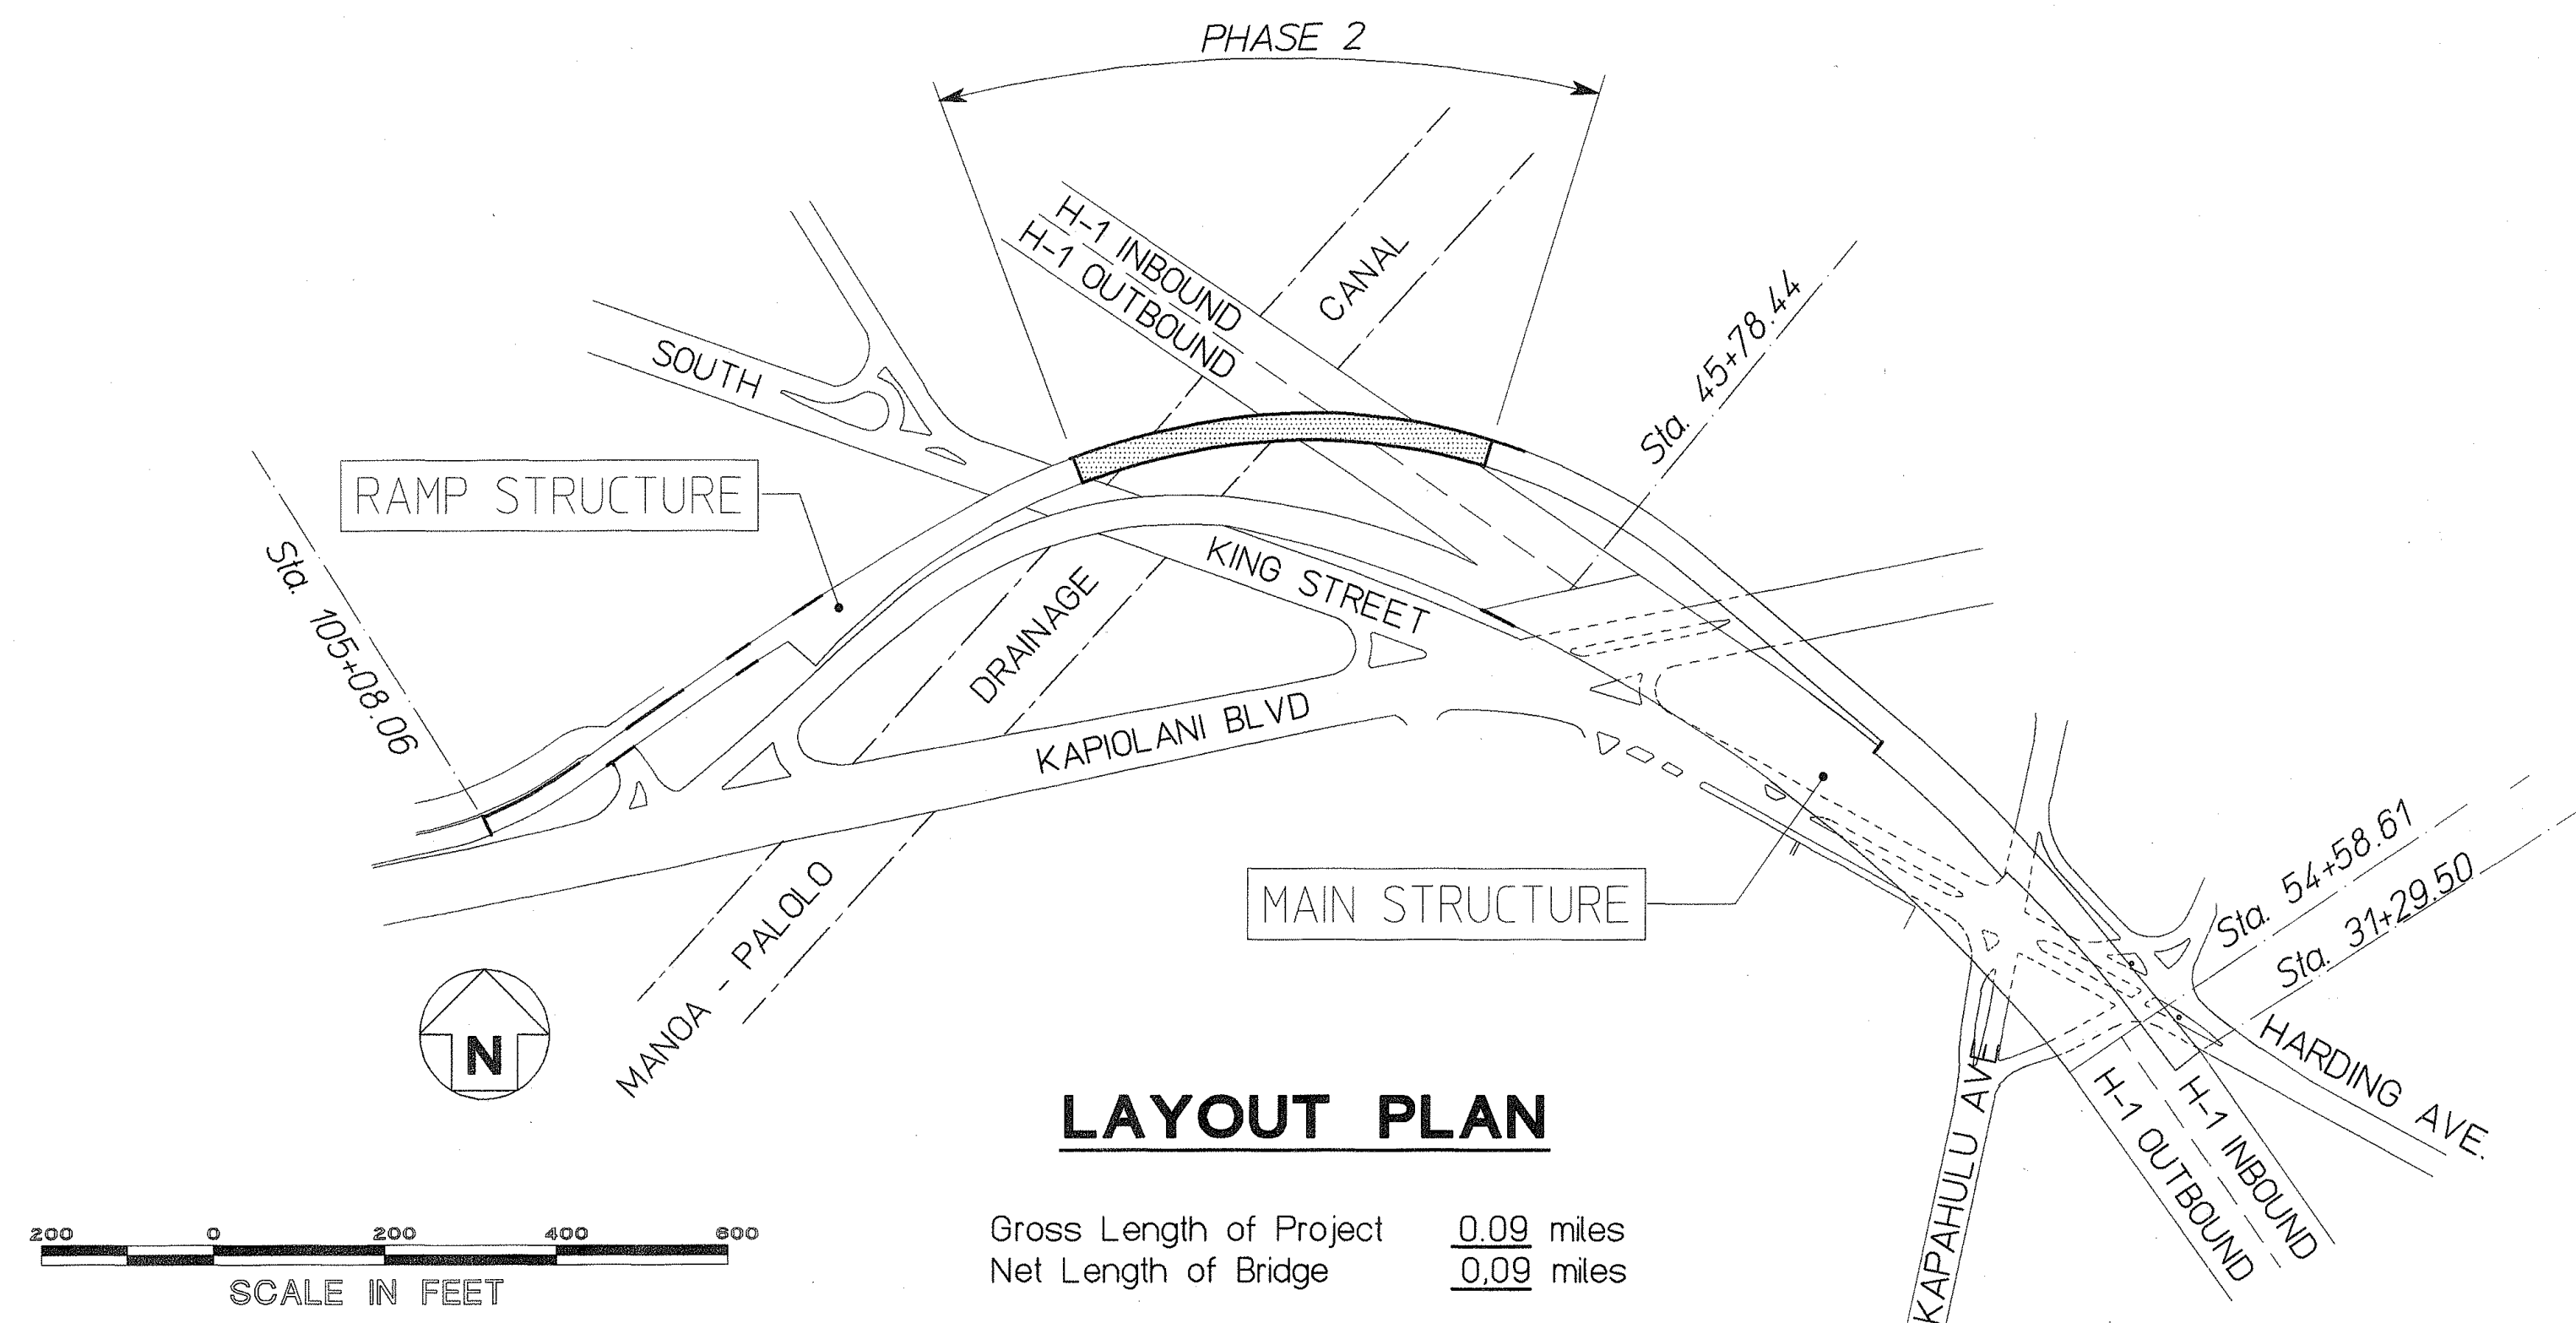

LAYOUT PLAN

SCALE IN FEET

Gross Length of Project 0.09 miles
Net Length of Bridge 0.09 miles

CHANGES MADE DURING CONSTRUCTION HAVE BEEN INCORPORATED ON THESE PLANS EXCEPT CHANGES IN THE ORIGINAL THEORETICAL QUANTITIES. FOR ACTUAL QUANTITIES, REFER TO PROJECT LOGS AND/OR COMPUTATION BOOK.

8/3/09

DEPARTMENT OF TRANSPORTATION, STATE OF HAWAII
APPROVED: [Signature] 10/15/02
DIR OF TRANSPORTATION DATE