


INDEX TO DRAWINGS	
SHEET NO.	DESCRIPTION
1	TITLE SHEET
2	CONSTRUCTION PHASING
3-6	VIADUCT STRIPING & SIGNING
7-8	VIADUCT SIGN PANELS & FRAME
9-15	FRONTAGE ROAD DETOUR
16-17	DETOUR SIGN PANELS
18-19	DETOUR DETAILS & SIGN SUMMARY
20-23	DETOUR SIGNAL PLANS
24-25	DETOUR PAVING, SIGNAL & TRAFFIC DETAILS
26	PORTABLE CONCRETE GUARD RAIL
27-44	STANDARD DETAILS
45-63	VIADUCT LIGHTING
64-65	RAMP FOOTING LOCATIONS
66-68	UTILITY LOCATION MAP
69	INDEX TO VIADUCT PLANS
70-140	VIADUCT PLANS
141-164	TYPICAL DETAILS
165	STANDARD DETAILS
166-173	EXPRESSWAY SIGN BRIDGES

STATE OF HAWAII
DEPARTMENT OF TRANSPORTATION
DIVISION
HONOLULU, HAWAII
"AS BUILT"
PLANS FOR
CONSTRUCTION OF A PORTION OF
INTERSTATE ROUTE H-1
AIRPORT INTERCHANGE
FEDERAL AID INTERSTATE PROJECT I-HI-I(120):16
DISTRICT OF HONOLULU
ISLAND OF OAHU

FED. ROAD DIST. NO.	STATE	FED. AID PROJ. NO.	FISCAL YEAR	SHEET NO.	TOTAL SHEETS
HAWAII	HAW.	FHH(120):16	1976	1	173

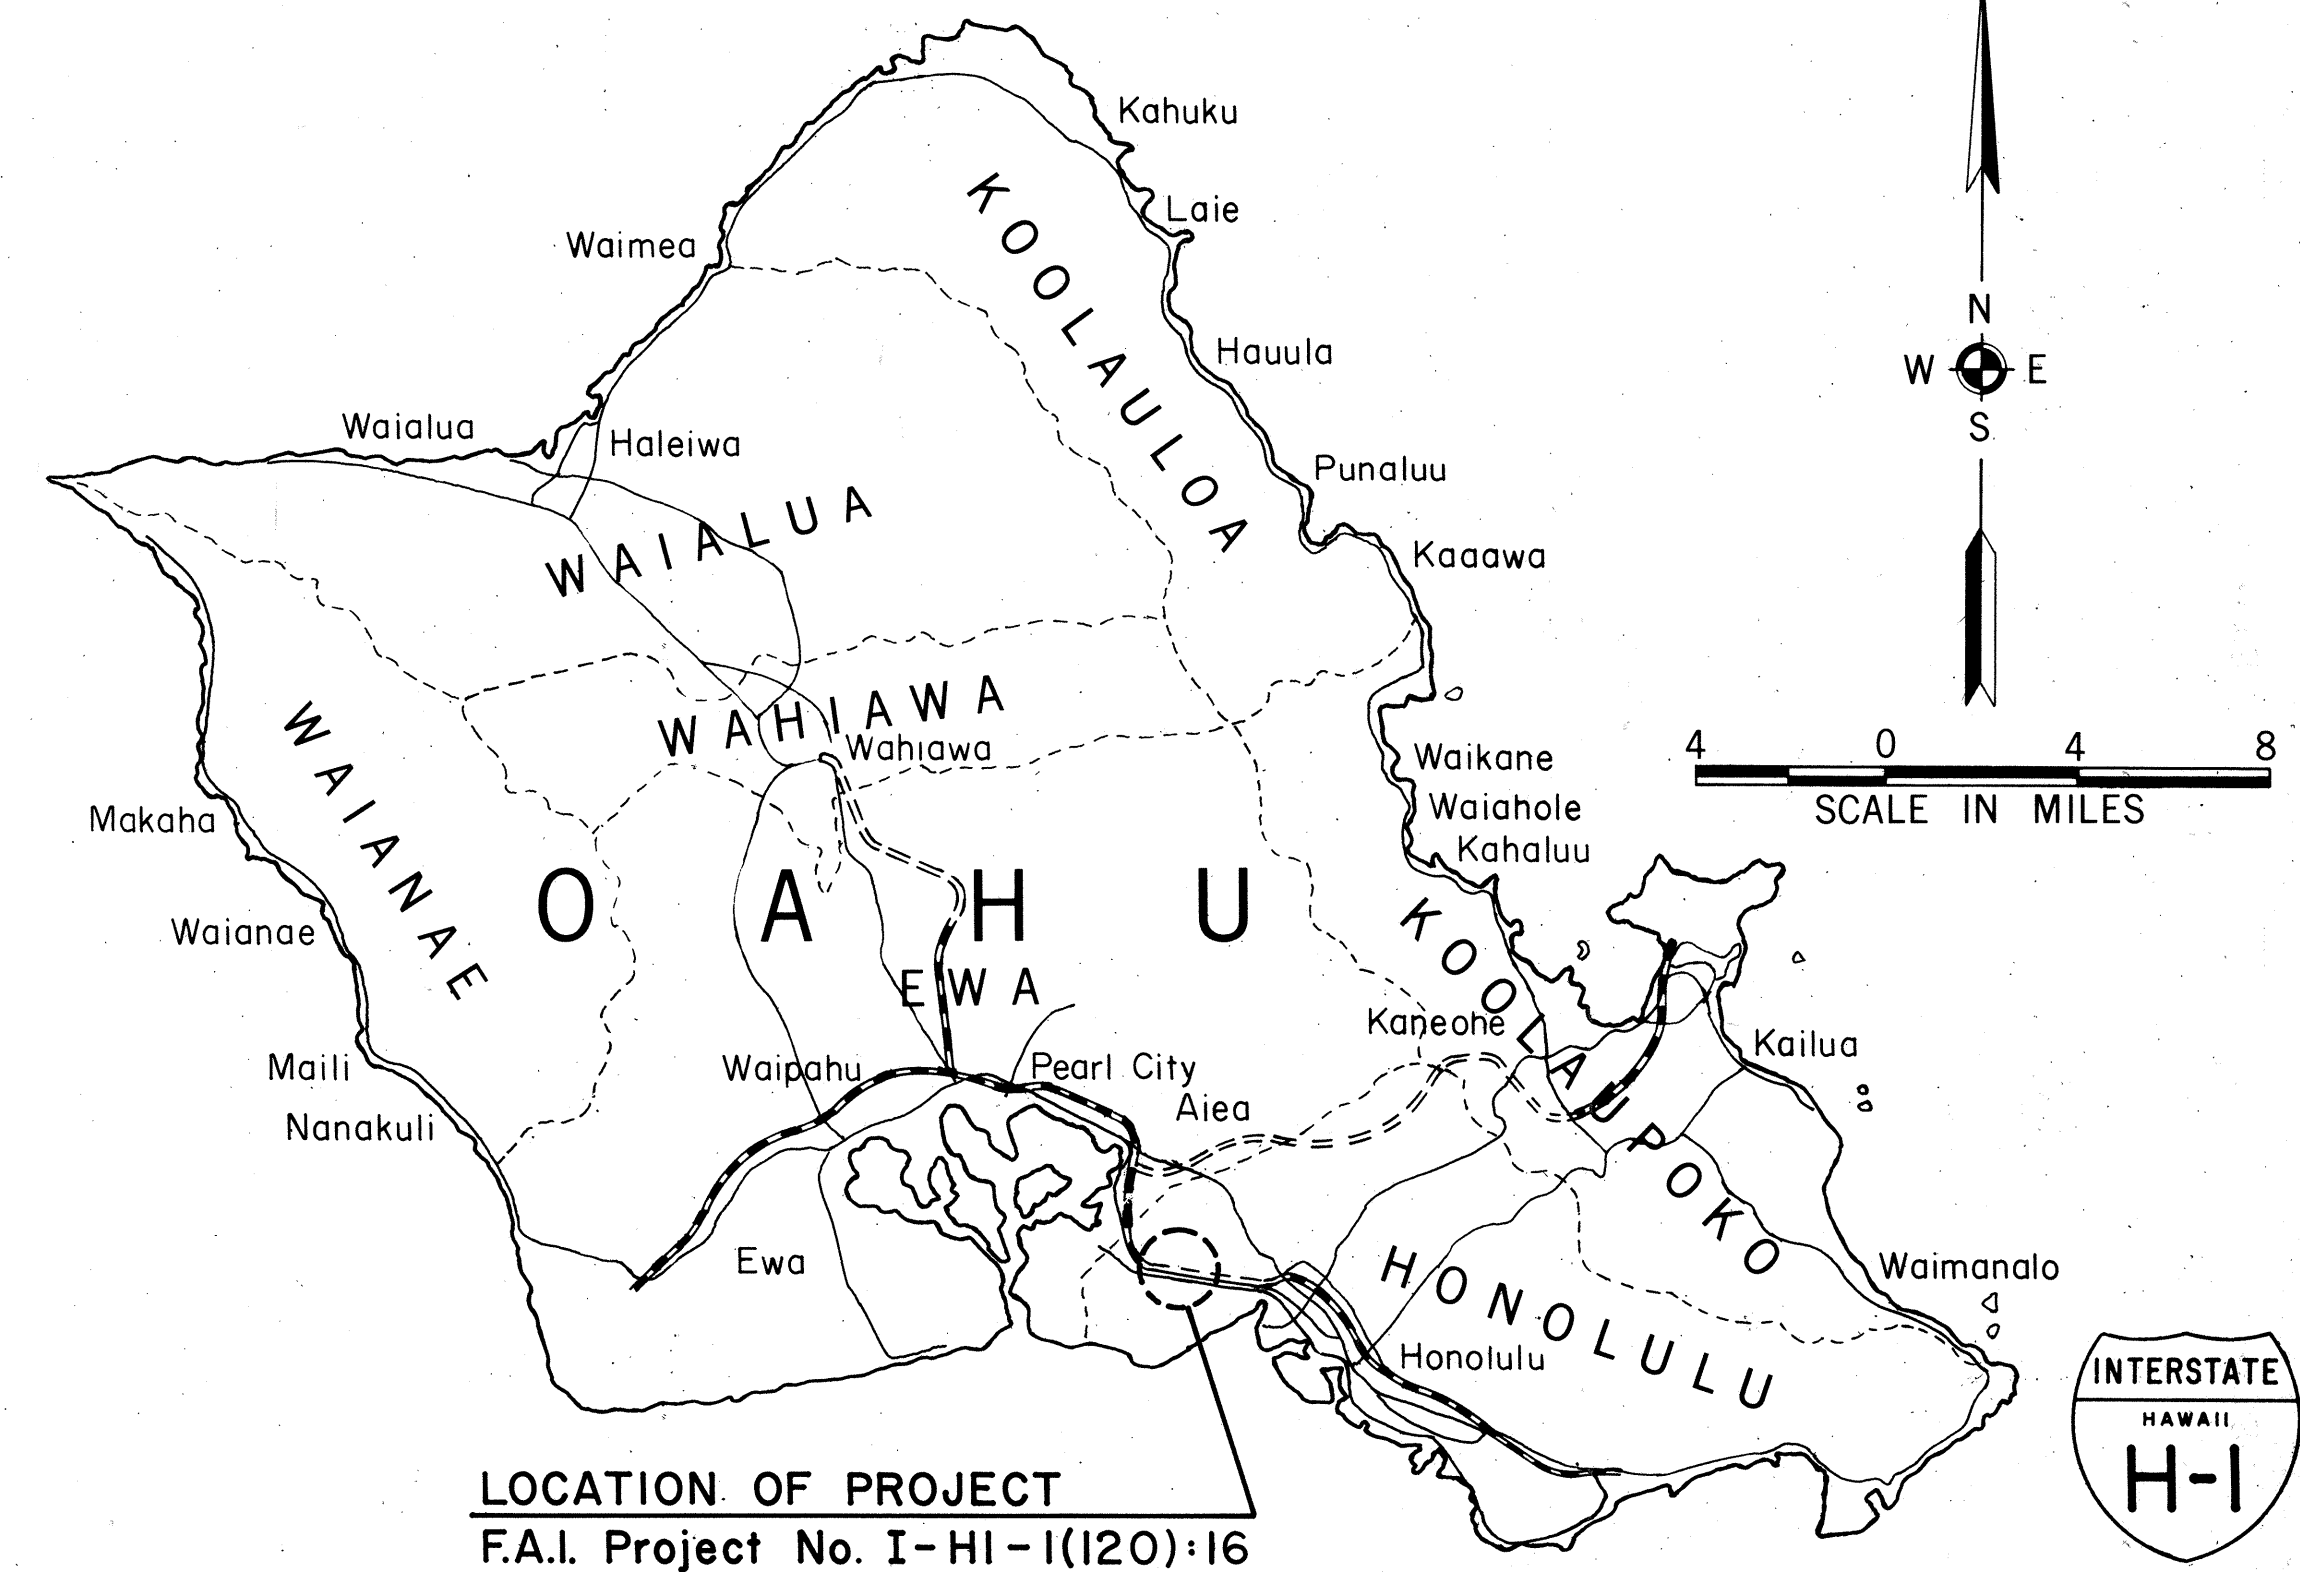

DESIGN CLASSIFICATION

DESIGN ADT (1994)	102,675
DHV	11%
D	60/40
T	5%
V	60 MPH

SCALES:

PLANS	HOR.	1" = 50'
PROFILES	HOR.	1" = 50'
	VER.	1" = 10'
DETAIL ROADWAY PLANS	HOR.	1" = 20'
CROSS SECTIONS	HOR.	1" = 10'
	VER.	1" = 5'

ALL CHANGES MADE DURING CONSTRUCTION HAVE BEEN INCORPORATED ON THESE PLANS EXCEPT CHANGES IN THE ORIGINAL THEORETICAL QUANTITIES.

David H. Jamushiro 11/7/80
RESIDENT ENGINEER DATE

DEPARTMENT OF TRANSPORTATION
FEDERAL HIGHWAY ADMINISTRATION
APPROVED: [Signature]
DIVISION ENGINEER 4-8-76
DATE

DEPARTMENT OF TRANSPORTATION
STATE OF HAWAII
APPROVED: [Signature]
DIR. OF TRANSPORTATION 11/5/75
DATE

