



FED. ROAD DIST. NO.	STATE	FED. AID PROJ. NO.	FISCAL YEAR	SHEET NO.	TOTAL SHEETS
HAWAII	HAW.	I-H-10016	1976	67	173

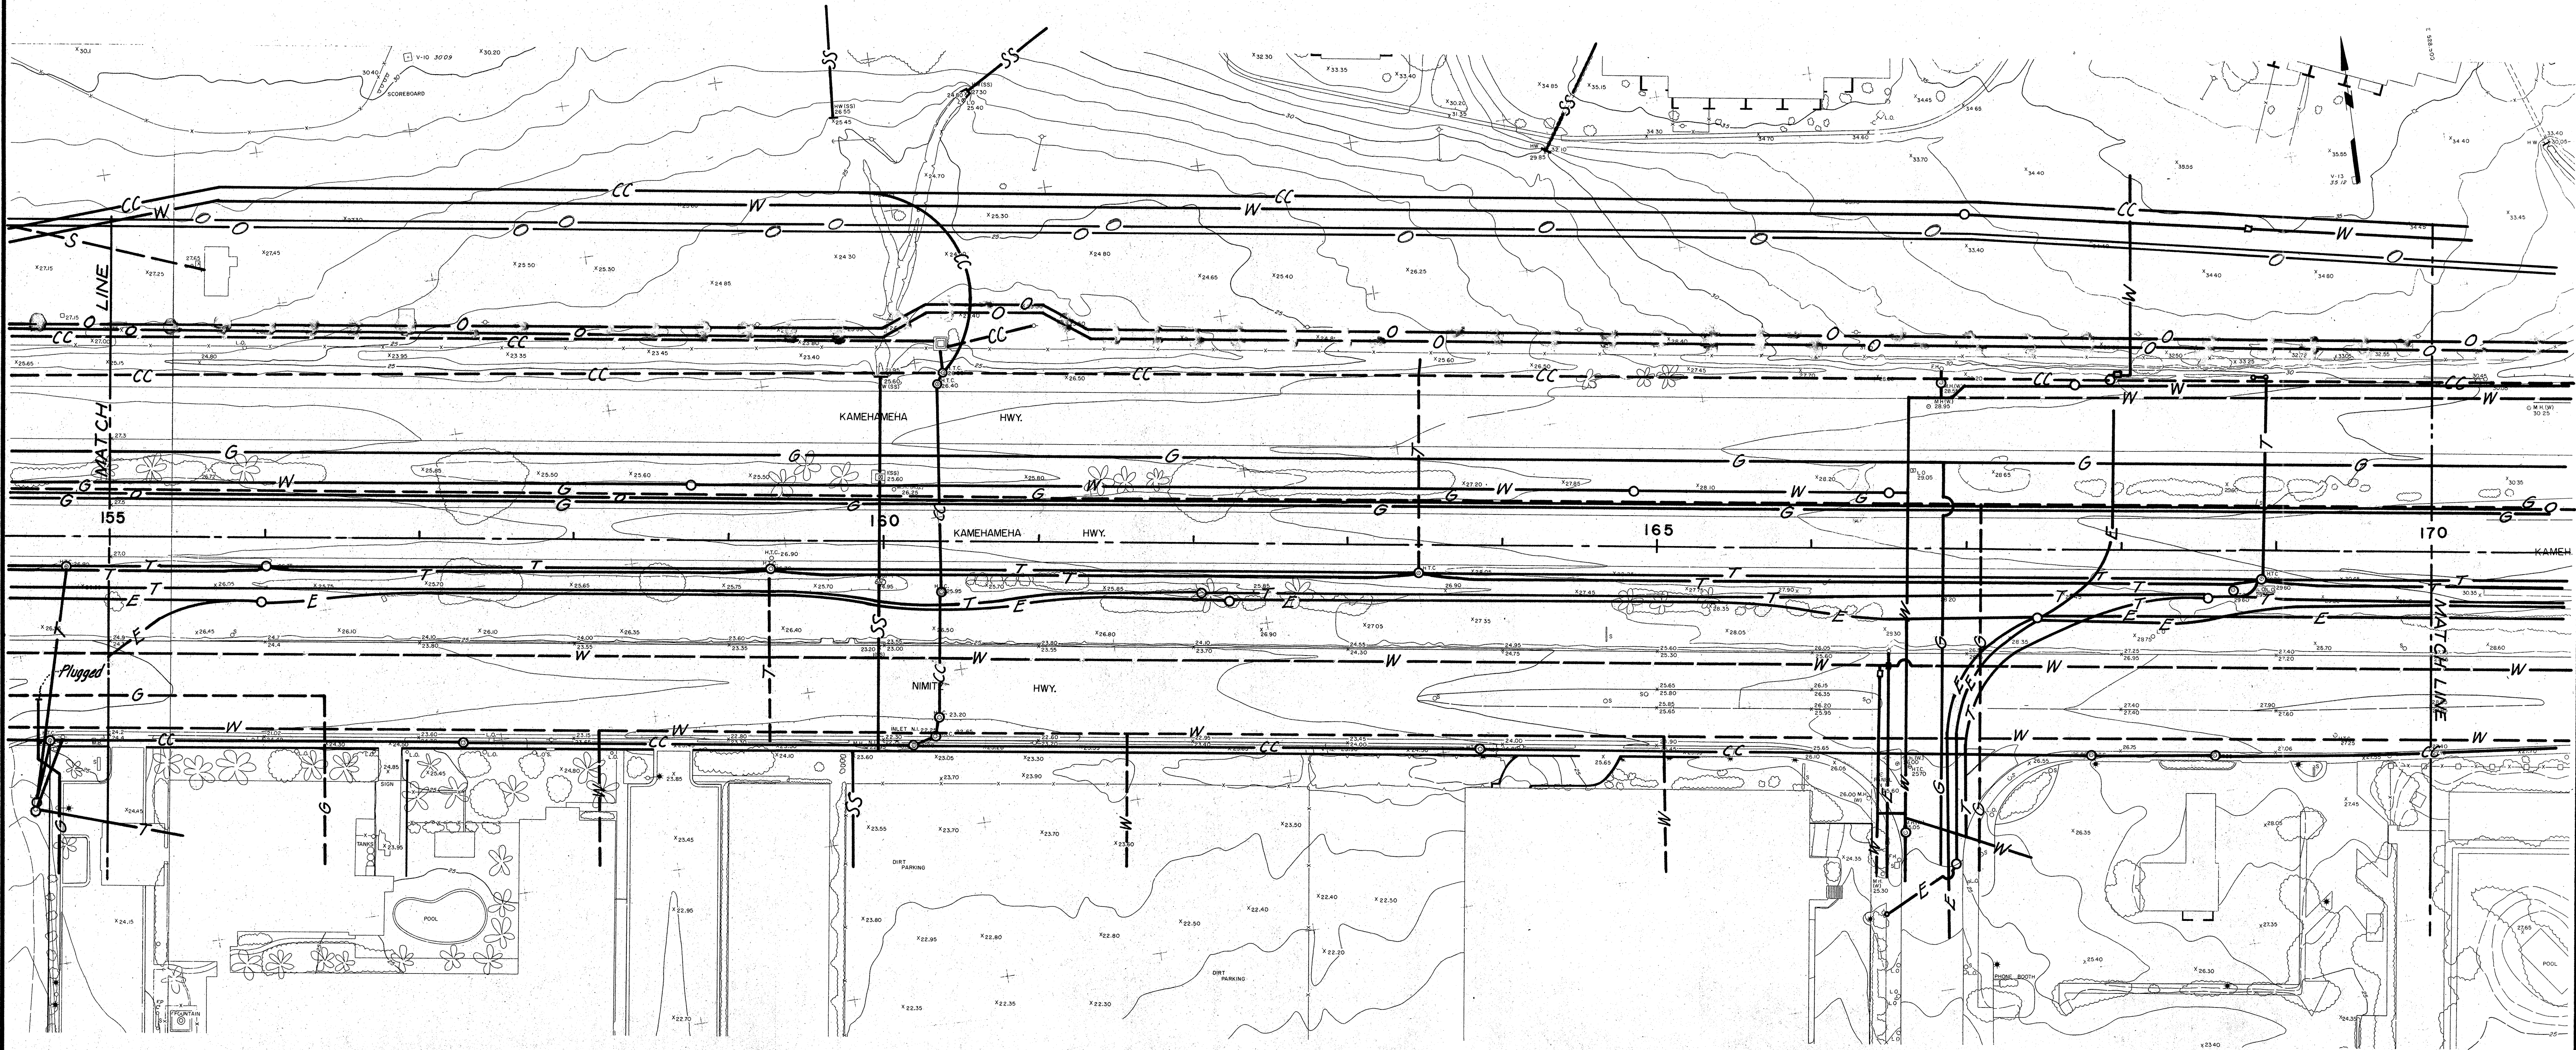

510-76	Oil Line 130" LT H-1E changed to Abandoned
DATE	REVISION

DATE	
DESIGNED BY	
CHECKED BY	
NOTED BY	
ORIGINAL PLAN	

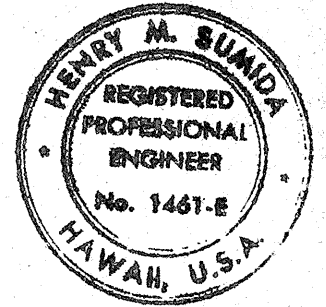

THIS WORK WAS PREPARED BY
ME OR UNDER MY SUPERVISION
Henry M. Sumida


STATE OF HAWAII
DEPARTMENT OF TRANSPORTATION
HIGHWAYS DIVISION

UNDERGROUND UTILITIES
LOCATION MAP

AIRPORT INTERCHANGE
FAI PROJ NO I-H-10016
SCALE: 1" = 50'
DATE: NOV. 1, 1975


SHEET No. 2 OF 3 SHEETS

FED. ROAD DIST. NO.	STATE	FED. AID PROJ. NO.	FISCAL YEAR	SHEET NO.	TOTAL SHEETS
HAWAII	HAW.	EH-H(120)16	1976	68	173

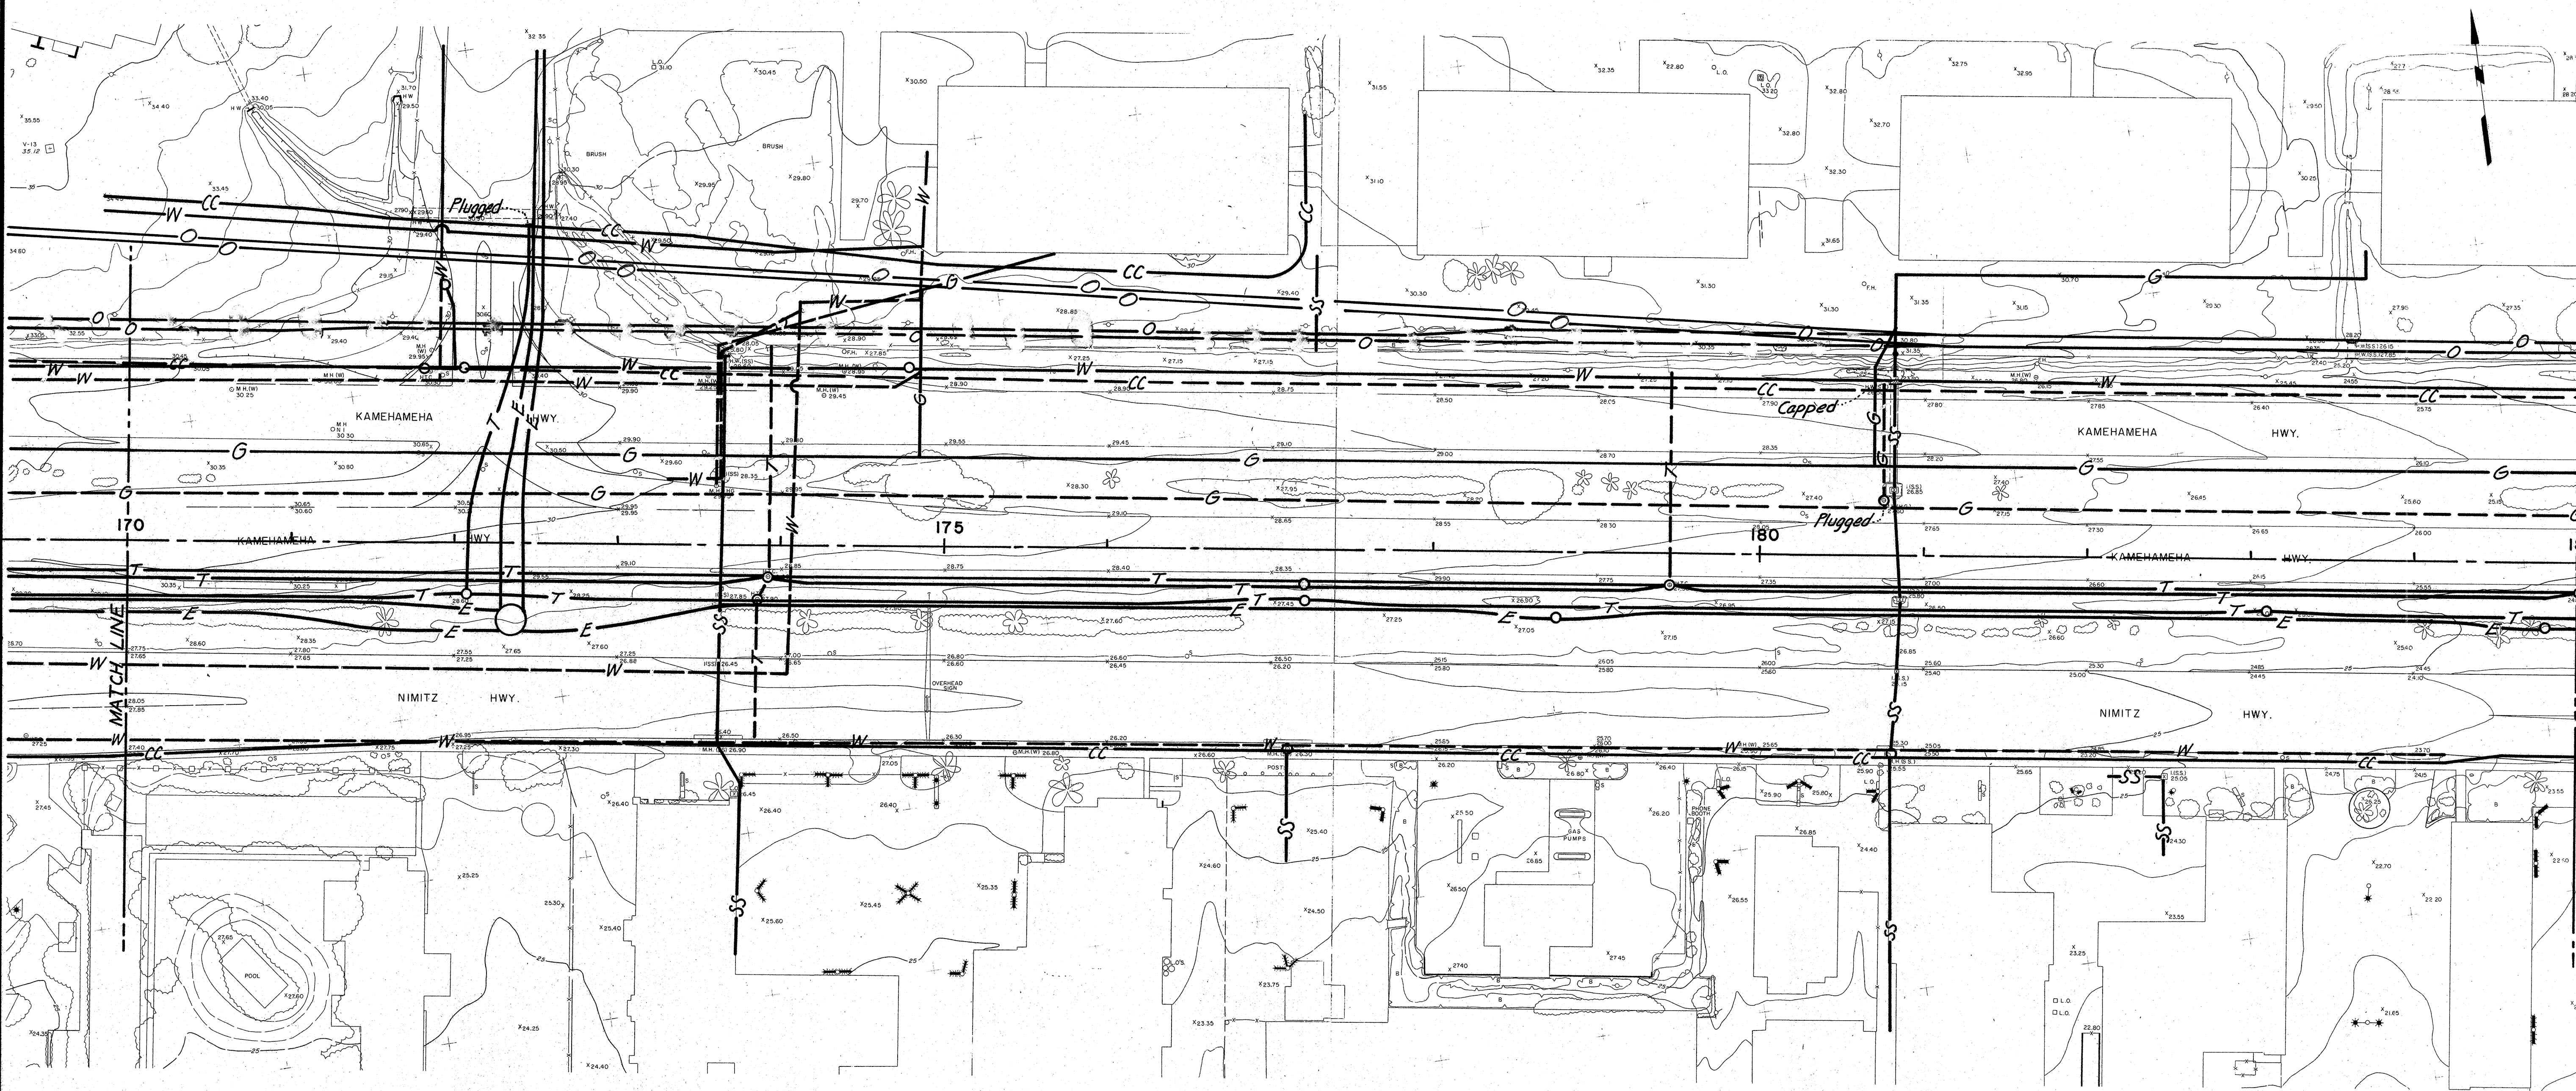

DATE	
SURVEY PLOTTED BY	
DRAWN BY	
DESIGNED BY	
QUANTITIES BY	
CHECKED BY	
ORIGINAL PLAN	
NOTE BOOK	
NO.	

5-10-76	Oil Line 130' Lt H-I & Changed to Abandoned
DATE	REVISION

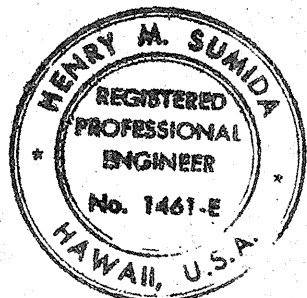

THIS WORK WAS PREPARED BY
ME OR UNDER MY SUPERVISION.
Henry M. Sumida

STATE OF HAWAII
DEPARTMENT OF TRANSPORTATION
HIGHWAYS DIVISION

UNDERGROUND UTILITIES
LOCATION MAP

AIRPORT INTERCHANGE
FAI PROJ. NO. I-HI-1(120)16

SCALE 1" = 50'

DATE: NOV. 1, 1975

SHEET No. 3 OF 3 SHEETS