
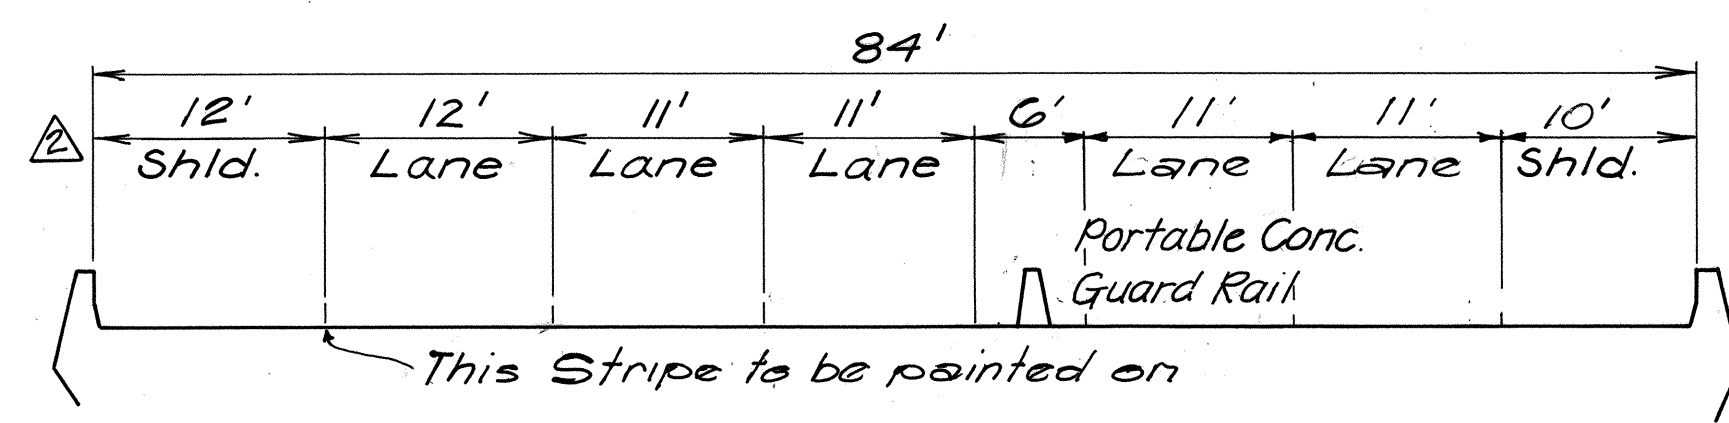
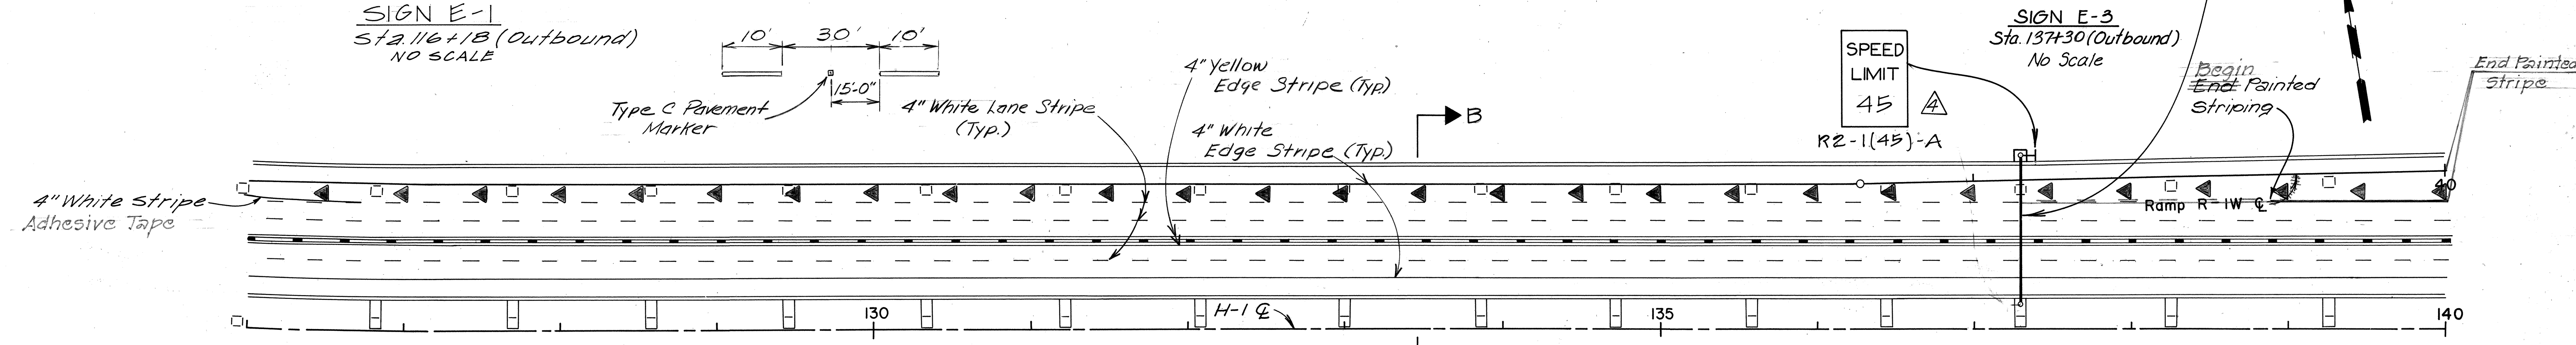
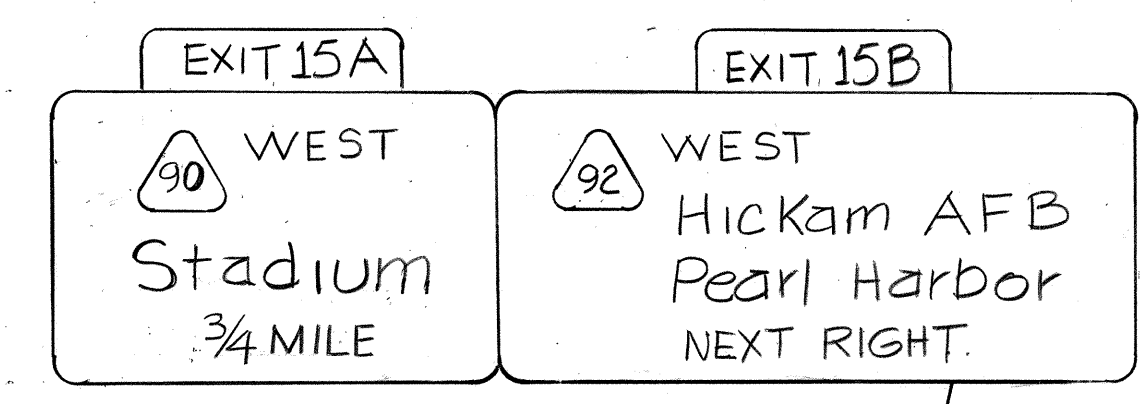
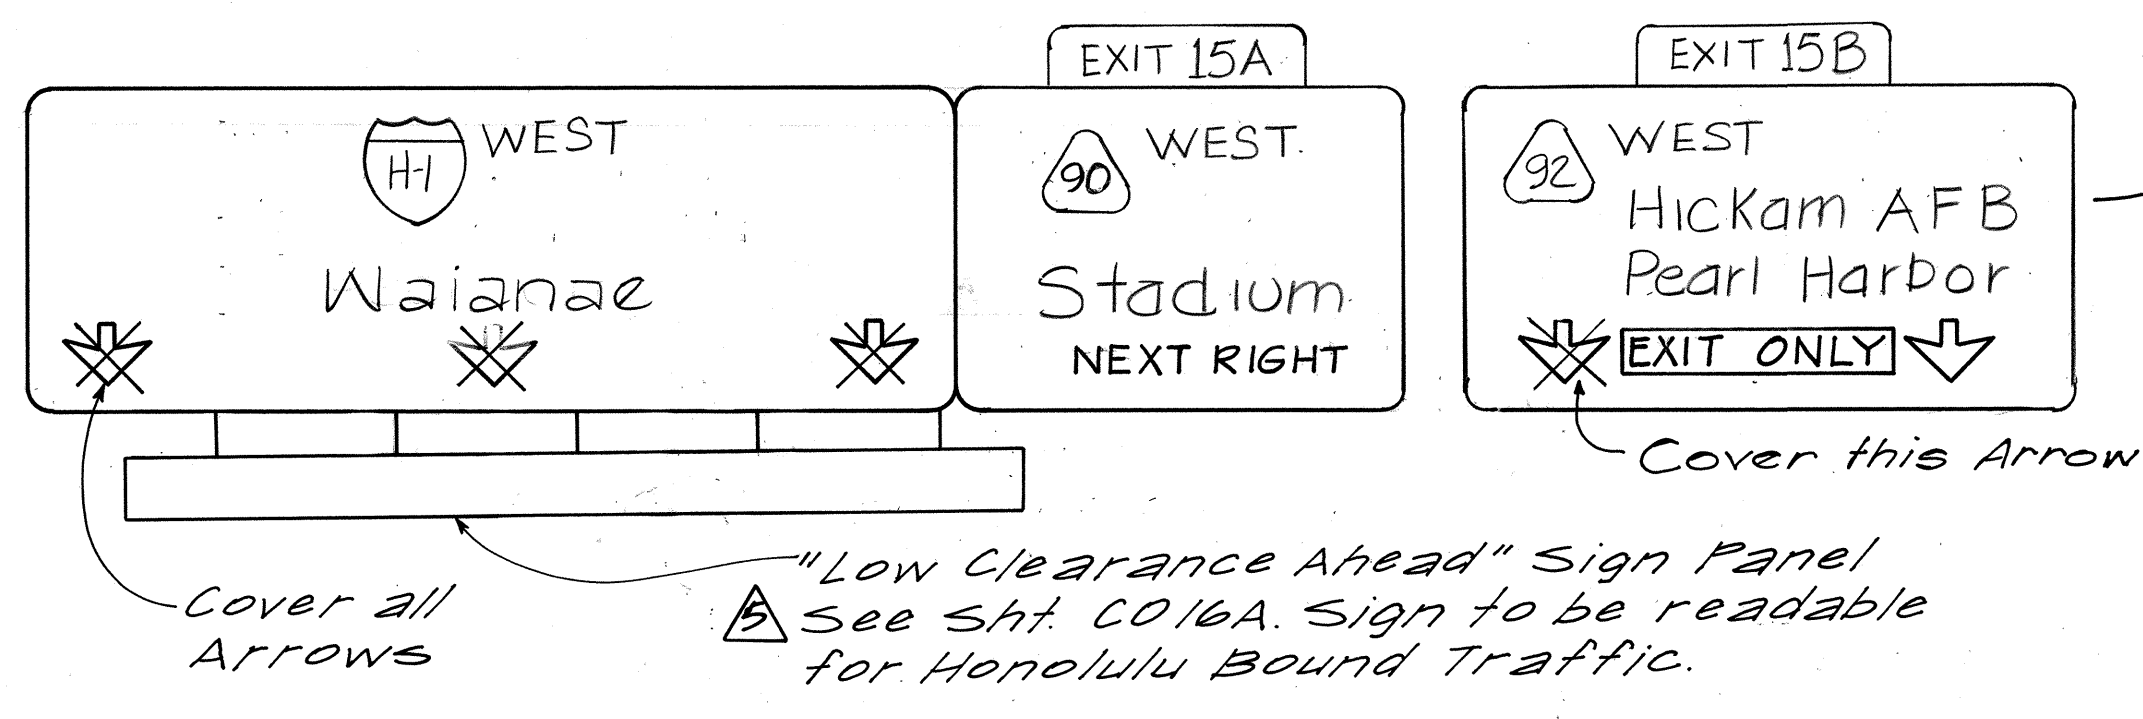
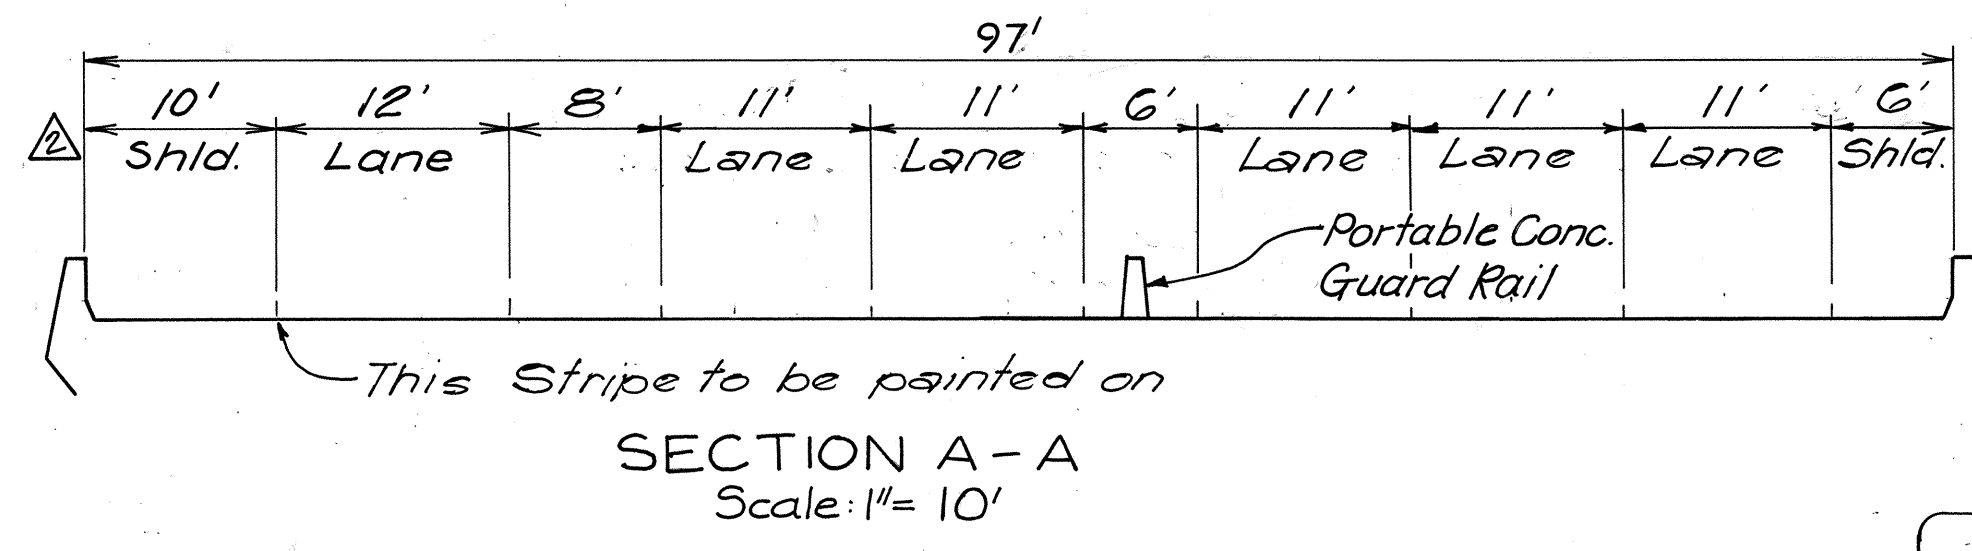


FED. ROAD DIST. NO.	STATE	FED. AID PROJ. NO.	FISCAL YEAR	SHEET NO.	TOTAL SHEETS
HAWAII	HAW.	I-HI-1(120)16	1976	3	173

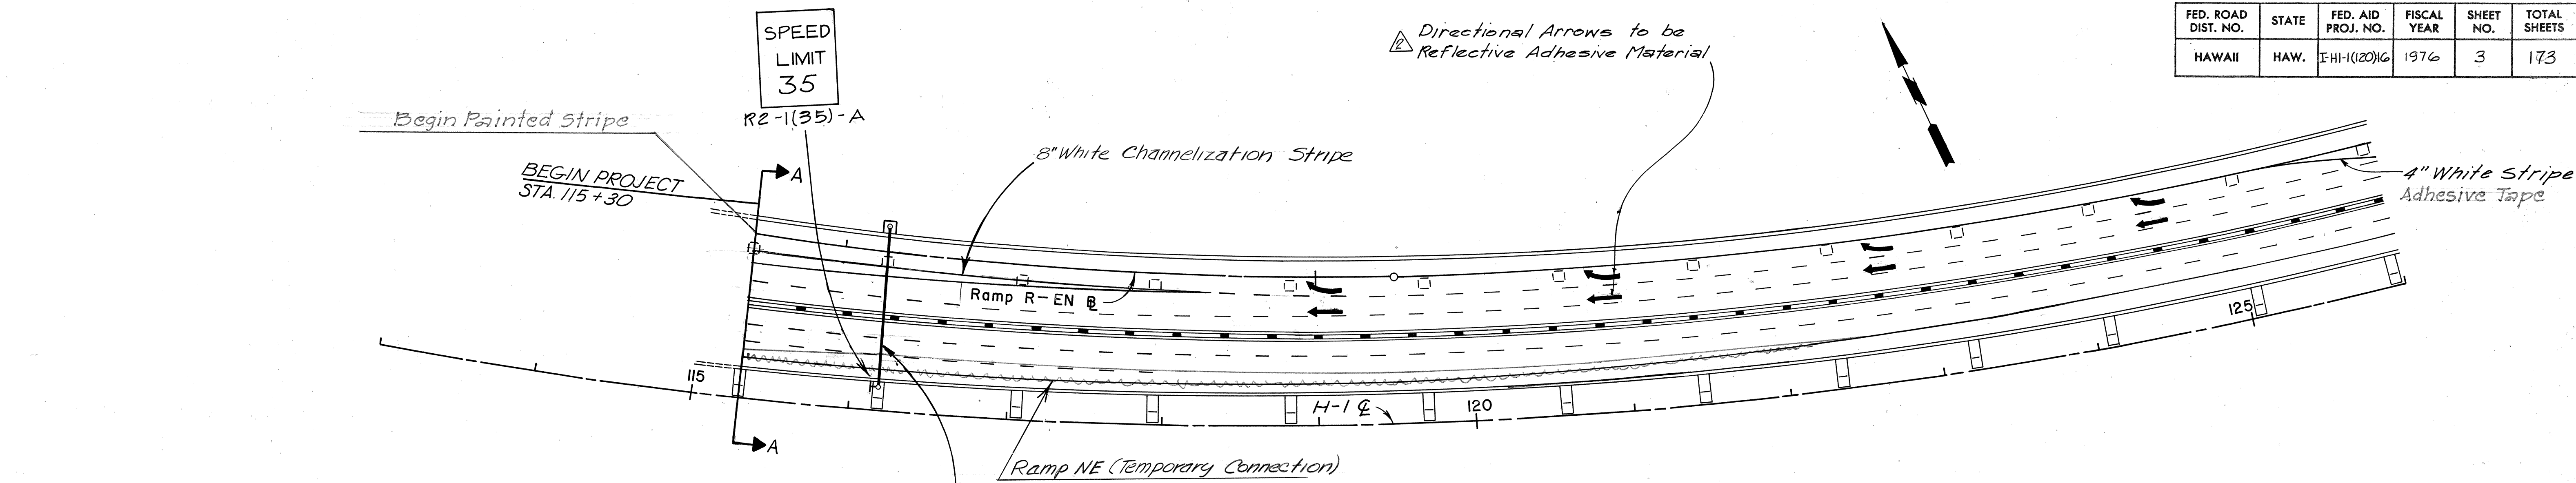


Note: For all Lane, Edge & Channelization Stripes use Reflective Adhesive Striping on Viaduct Deck except as Noted otherwise

Note: Reflective adhesive material shall be installed in accordance with the manufacturer's recommendations and procedures.

LEGEND  
 ◀ Traffic Cones, Tubular at 50' intervals

NO.	DATE	REVISION
1	12-12-78	Added "Low Clearance Ahead" Panels to sign E-1
2	11-15-78	Changed Speed Limit from 35 to 45 mph at sign E-3
3	8-7-78	Added Traffic Cones Sta. 126+50 to Sta. 149+00
4	3-15-78	Revised Material for Directional Arrows. Revised Note & Lane Dimensions for Sections A-A and B-B
5	5-10-76	Changed Guide Signs

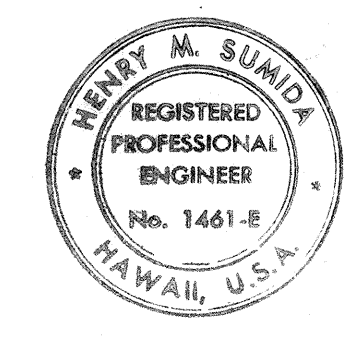

THIS WORK WAS PREPARED BY ME OR UNDER MY SUPERVISION.  
 Henry M. Sumida

STATE OF HAWAII  
 DEPARTMENT OF TRANSPORTATION  
 HIGHWAYS DIVISION

SIGNING & STRIPING  
 VIADUCT

AIRPORT INTERCHANGE  
 F.A.I. PROJ. NO. I-HI-1(120)16

SCALE: AS SHOWN DATE: NOV. 1, 1975

SHEET No. 1 OF 4 SHEETS

SURVEY PLOTTED BY	DATE
DESIGNED BY	
QUANTITIES BY	
CHECKED BY	
ORIGINAL PLAN	
NOTE BOOK	
No.	


CONTRACT CHANGE ORDER NO. 35, 1ST SUPPL.

CO ADD 3









FED. ROAD DIST. NO.	STATE	FED. AID PROJ. NO.	FISCAL YEAR	SHEET NO.	TOTAL SHEETS
HAWAII	HAW.	I-HI-(120)16	1976	5	173


SPEED LIMIT  
45  
R2-1(45)-A

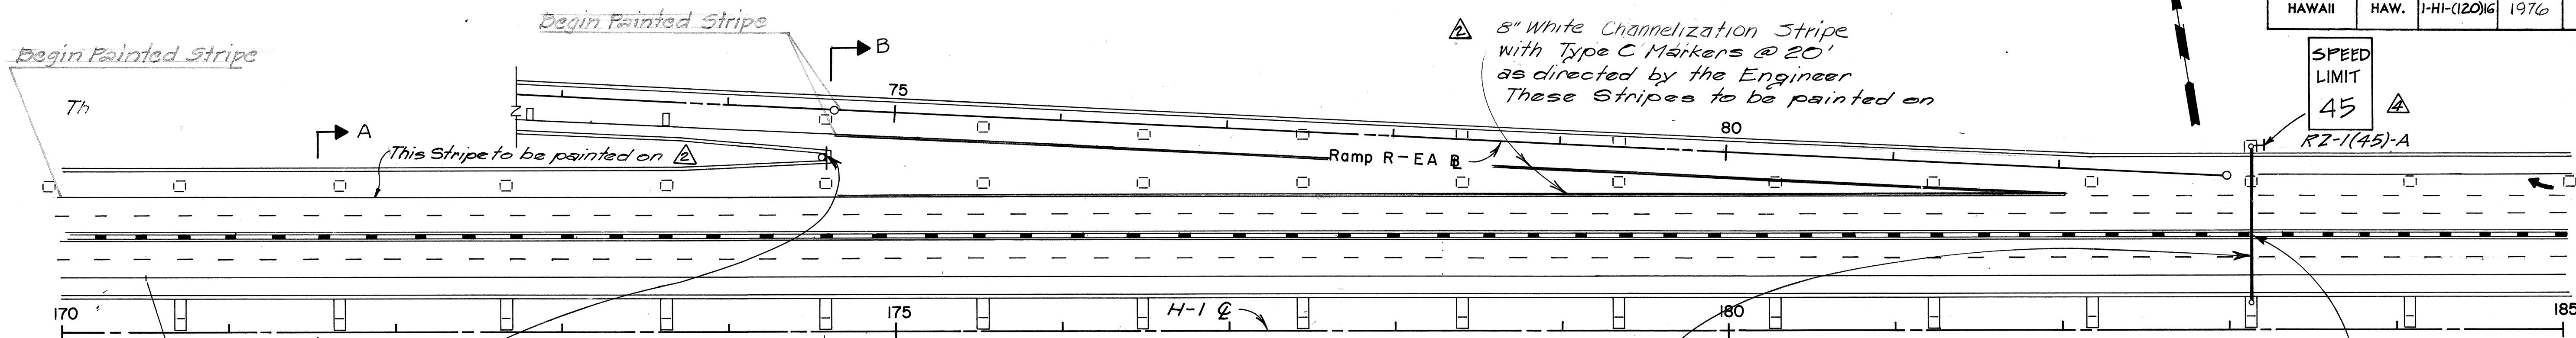




Sta. 170+50±  
End Taper

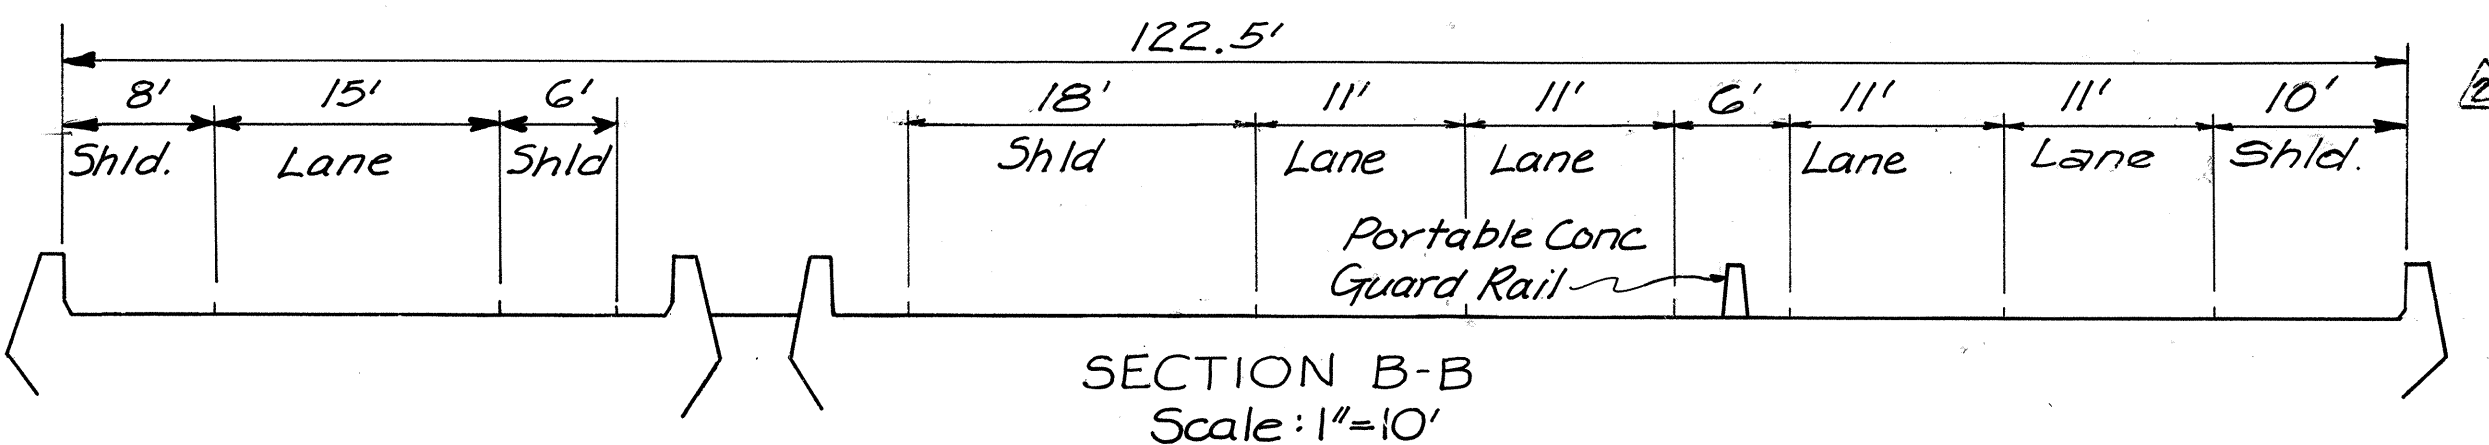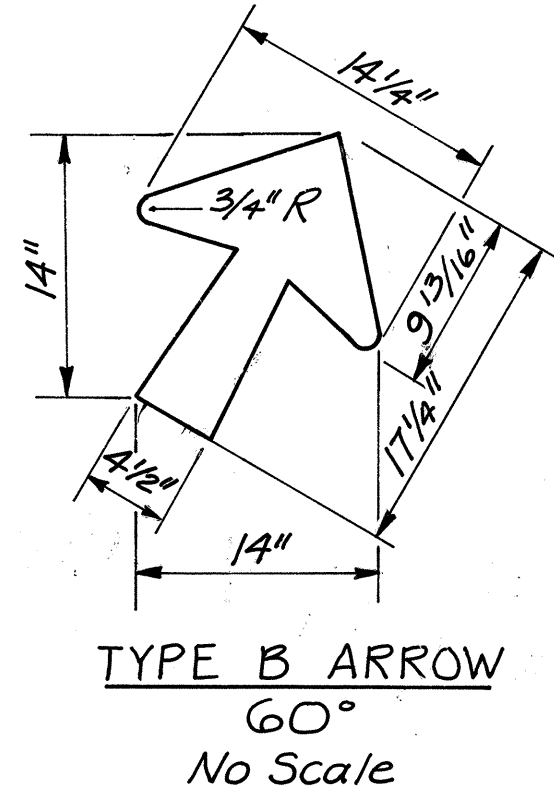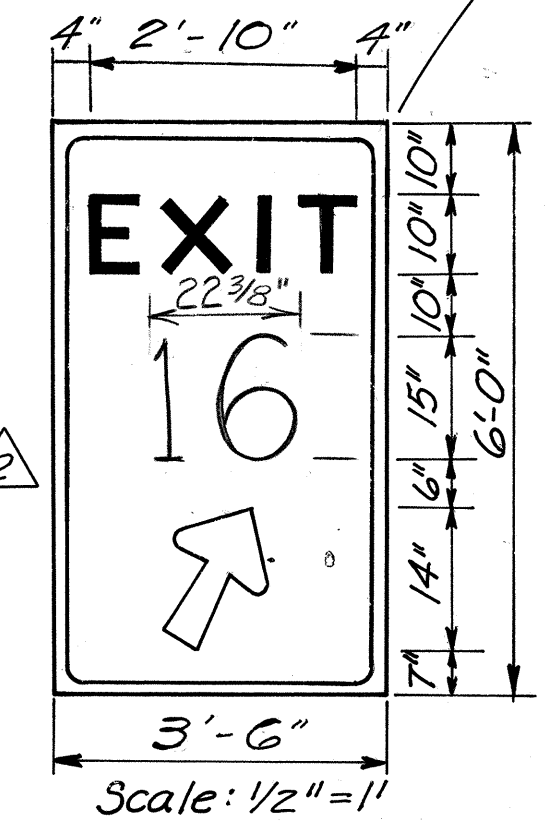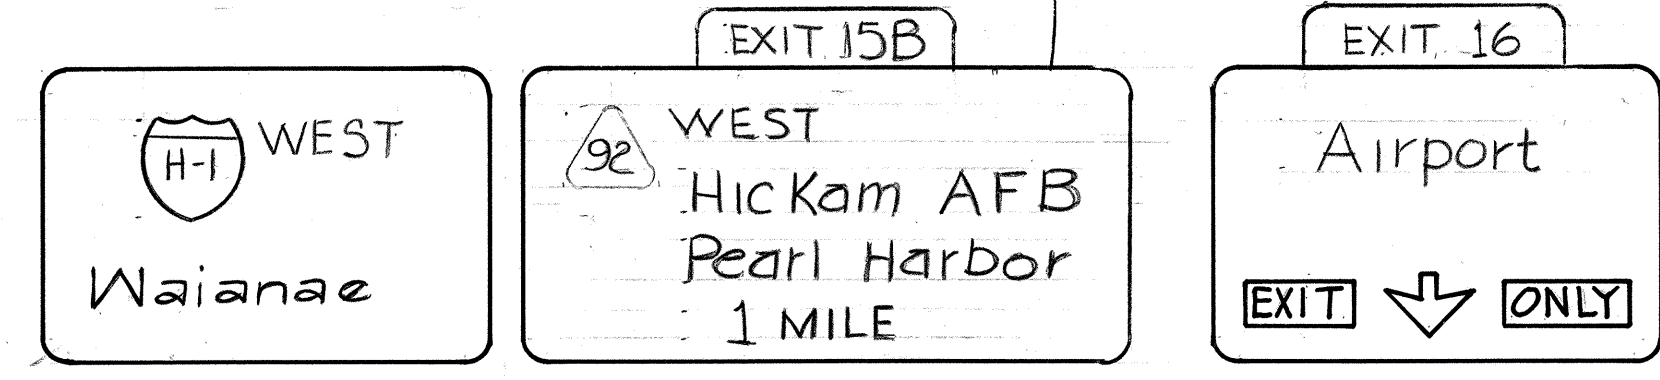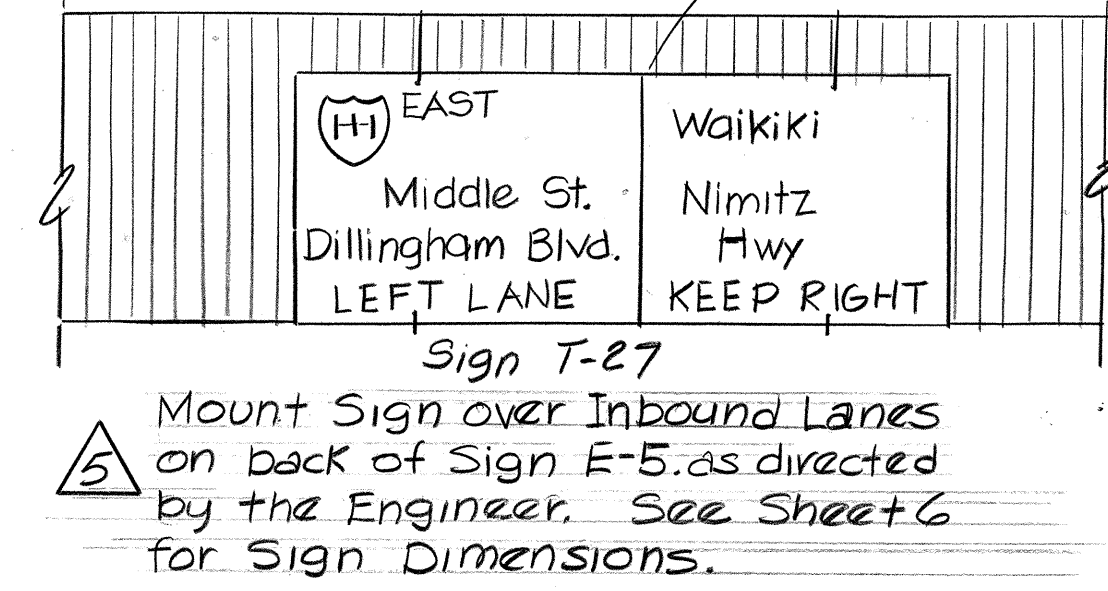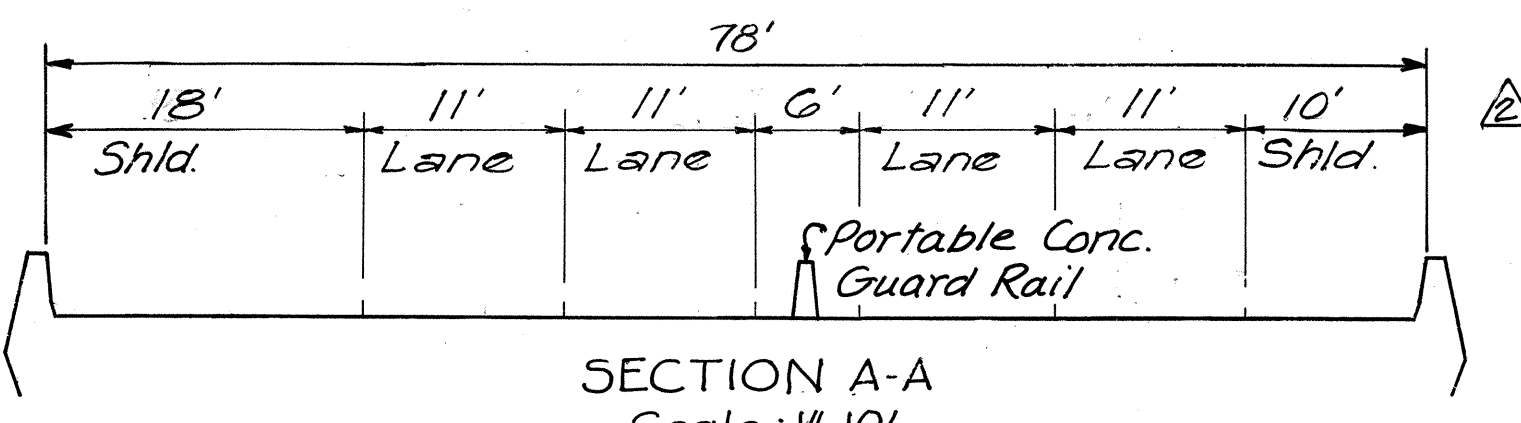

Note: "Airport" signs (E-5 & E-7) shall be covered as directed by the Engineer.

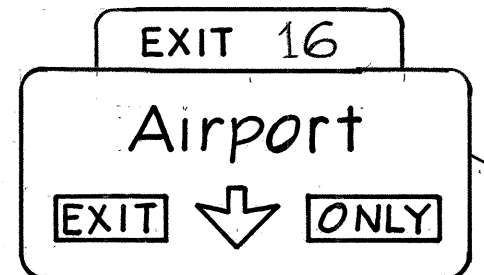


Turn Arrows as directed by Engineer. Use tubular traffic cones @ 25' Min. Interval to Merge Right Lane traffic until Ramp R-EA becomes operational.

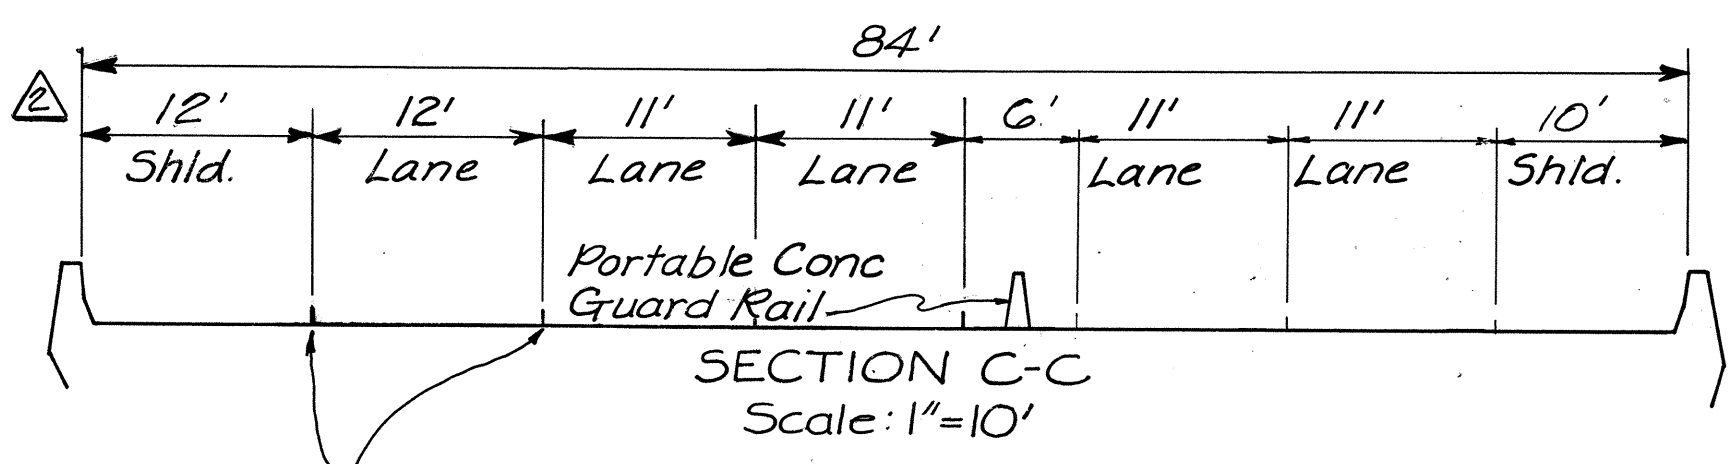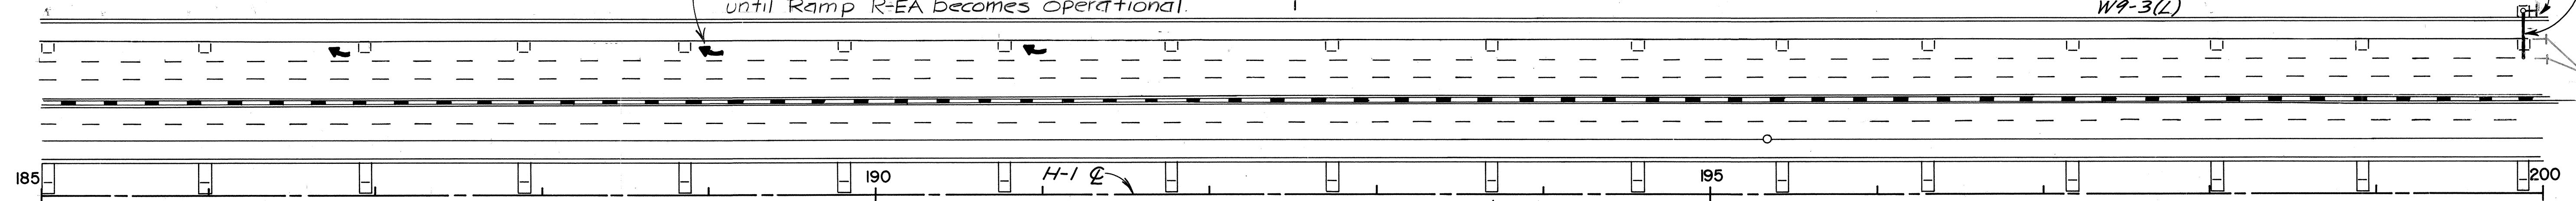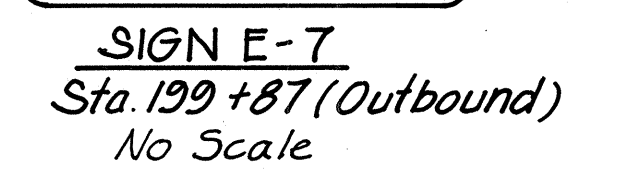

NO.	DATE	REVISION
1	11-15-78	Changed Speed Limit from 35 to 45 mph at Sign E-5
2	8-7-78	Deleted 120' Guard Rail at R-EA Relocated 35 mph Sign to Sta. 183+13. Added "Thru Traffic Merge Left" Sign at Sta 199+87
3	3-15-78	Revised Note for Ramp EA Striping Revised Lane Dimensions for Sect. A-A, B-B and C-C and added Note
4	5-10-76	Changed Guide Signs

NO.	DATE	REVISION
1	2-7-79	Furnish & Install Sign T-27 on back of Sign E-5

DESIGNED BY	DATE
DRAWN BY	
CHECKED BY	
IN CHARGE	
NO. MOOK	
NO.	

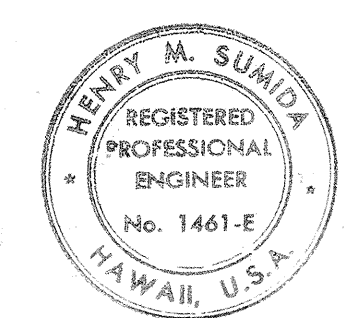

THIS WORK WAS PREPARED BY ME OR UNDER MY SUPERVISION.  
Henry M. Simida

STATE OF HAWAII  
DEPARTMENT OF TRANSPORTATION  
HIGHWAYS DIVISION

SIGNING & STRIPING  
VIADUCT

AIRPORT INTERCHANGE  
F.A.I. PROJ. I-HI-1(120)-16

SCALE: AS SHOWN DATE: NOV. 1, 1976









SHEET No. 3 OF 4 SHEETS

CONTRACT CHANGE ORDER NO. 35, 1ST SUPPL.

CO ADD 5



FED. ROAD DIST. NO.	STATE	FED. AID PROJ. NO.	FISCAL YEAR	SHEET NO.	TOTAL SHEETS
HAWAII	HAW.	I-HI-1(120)16	1976	7	173

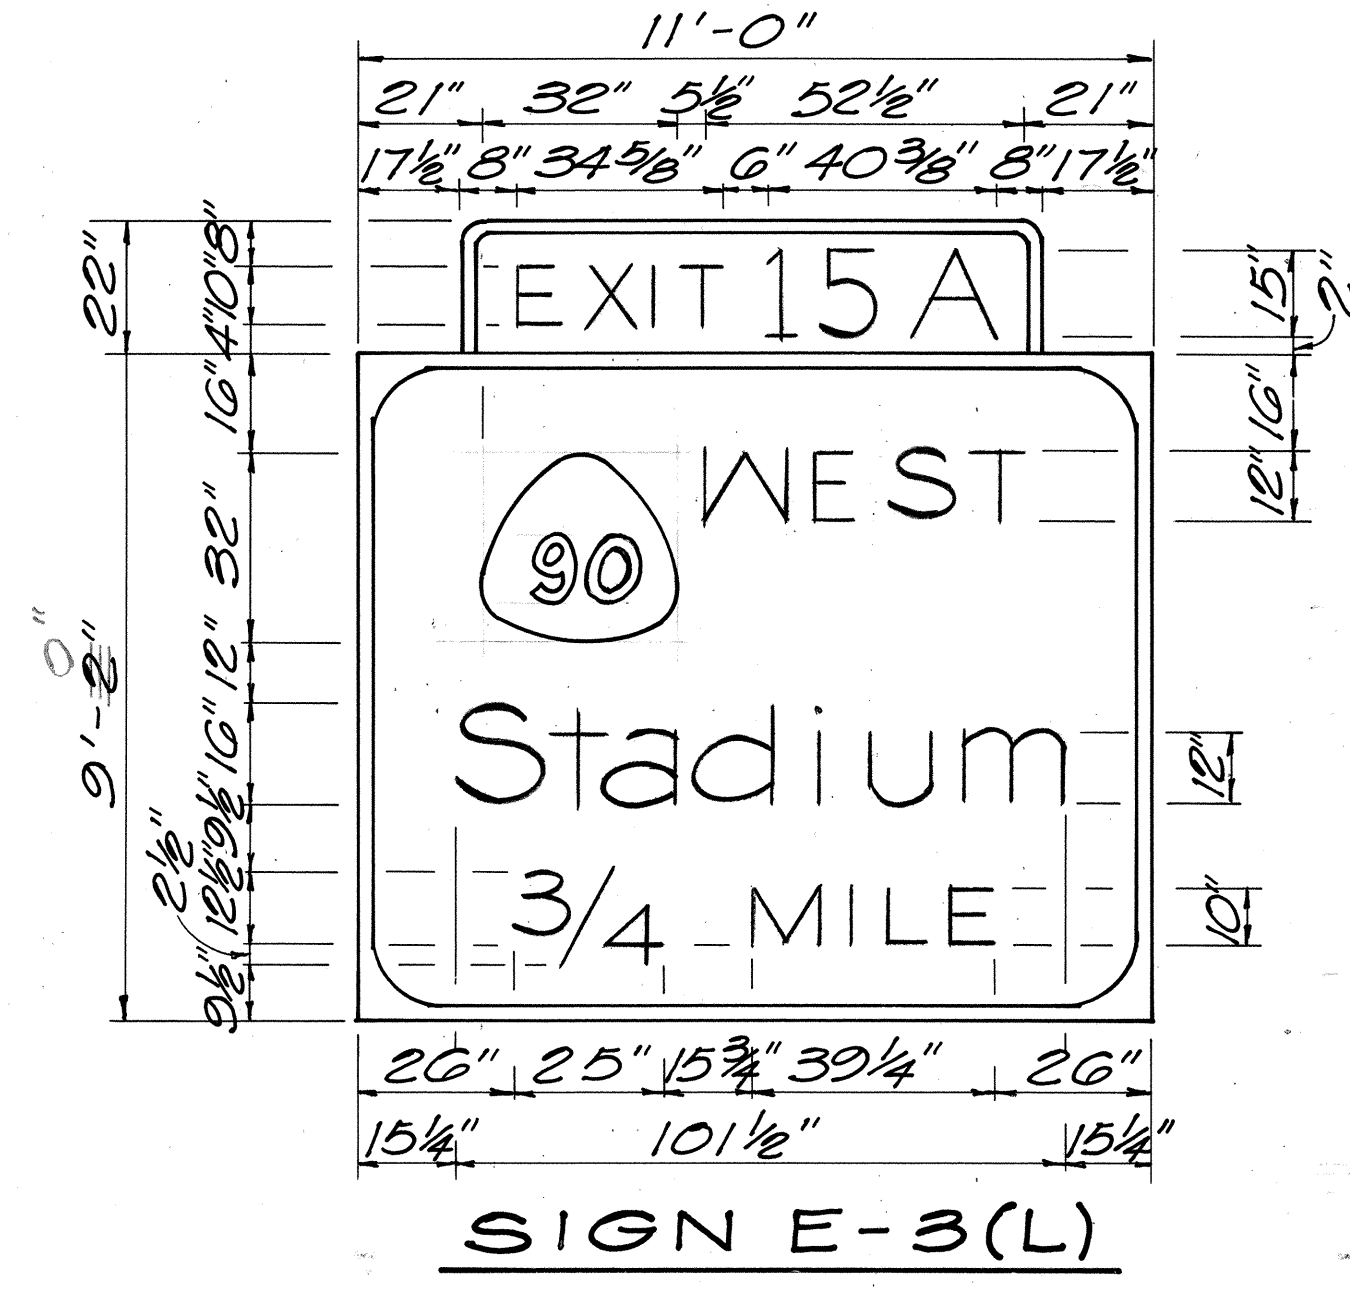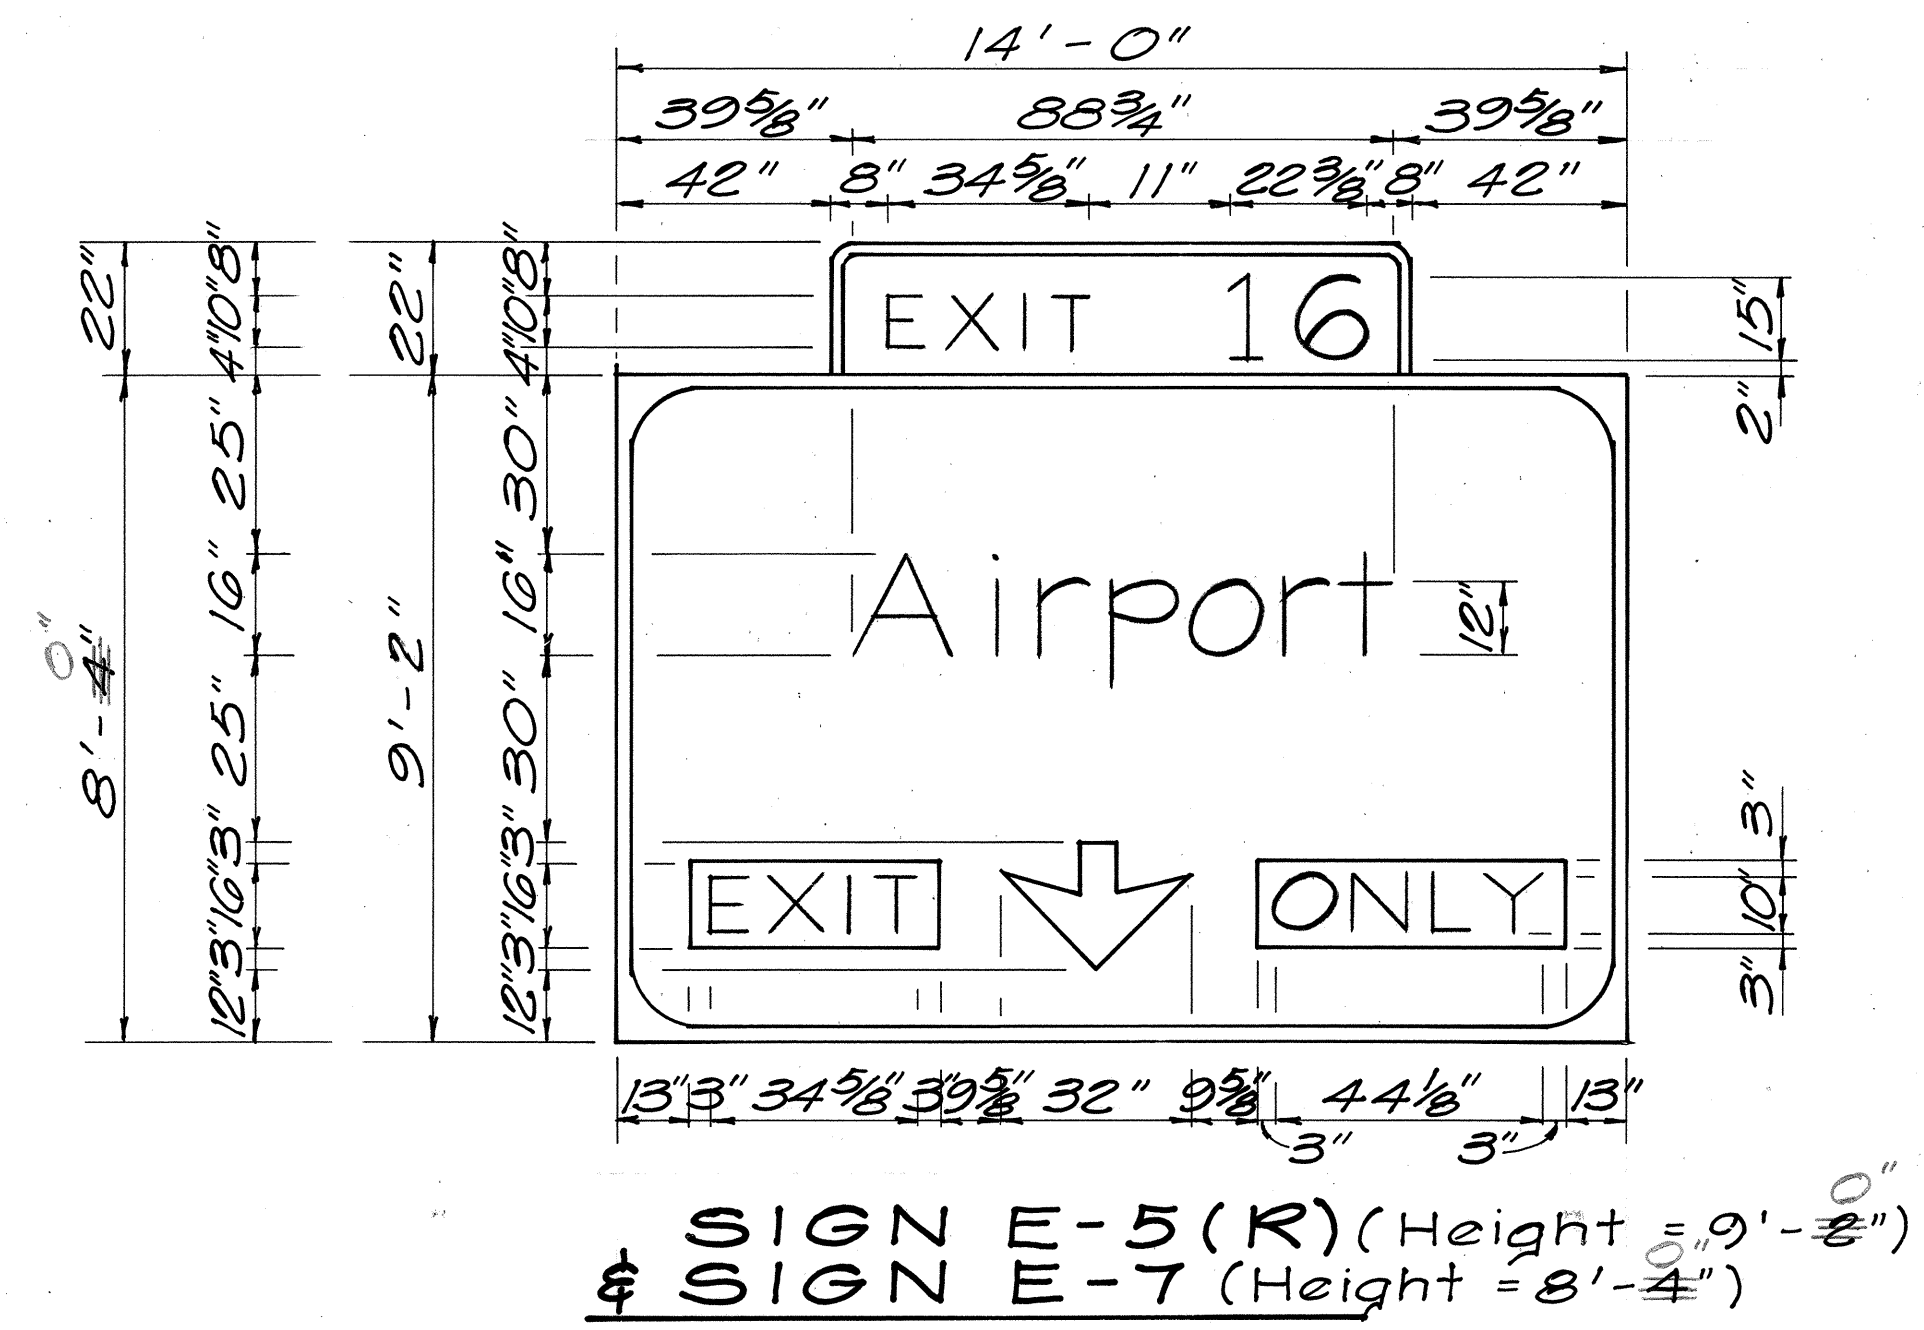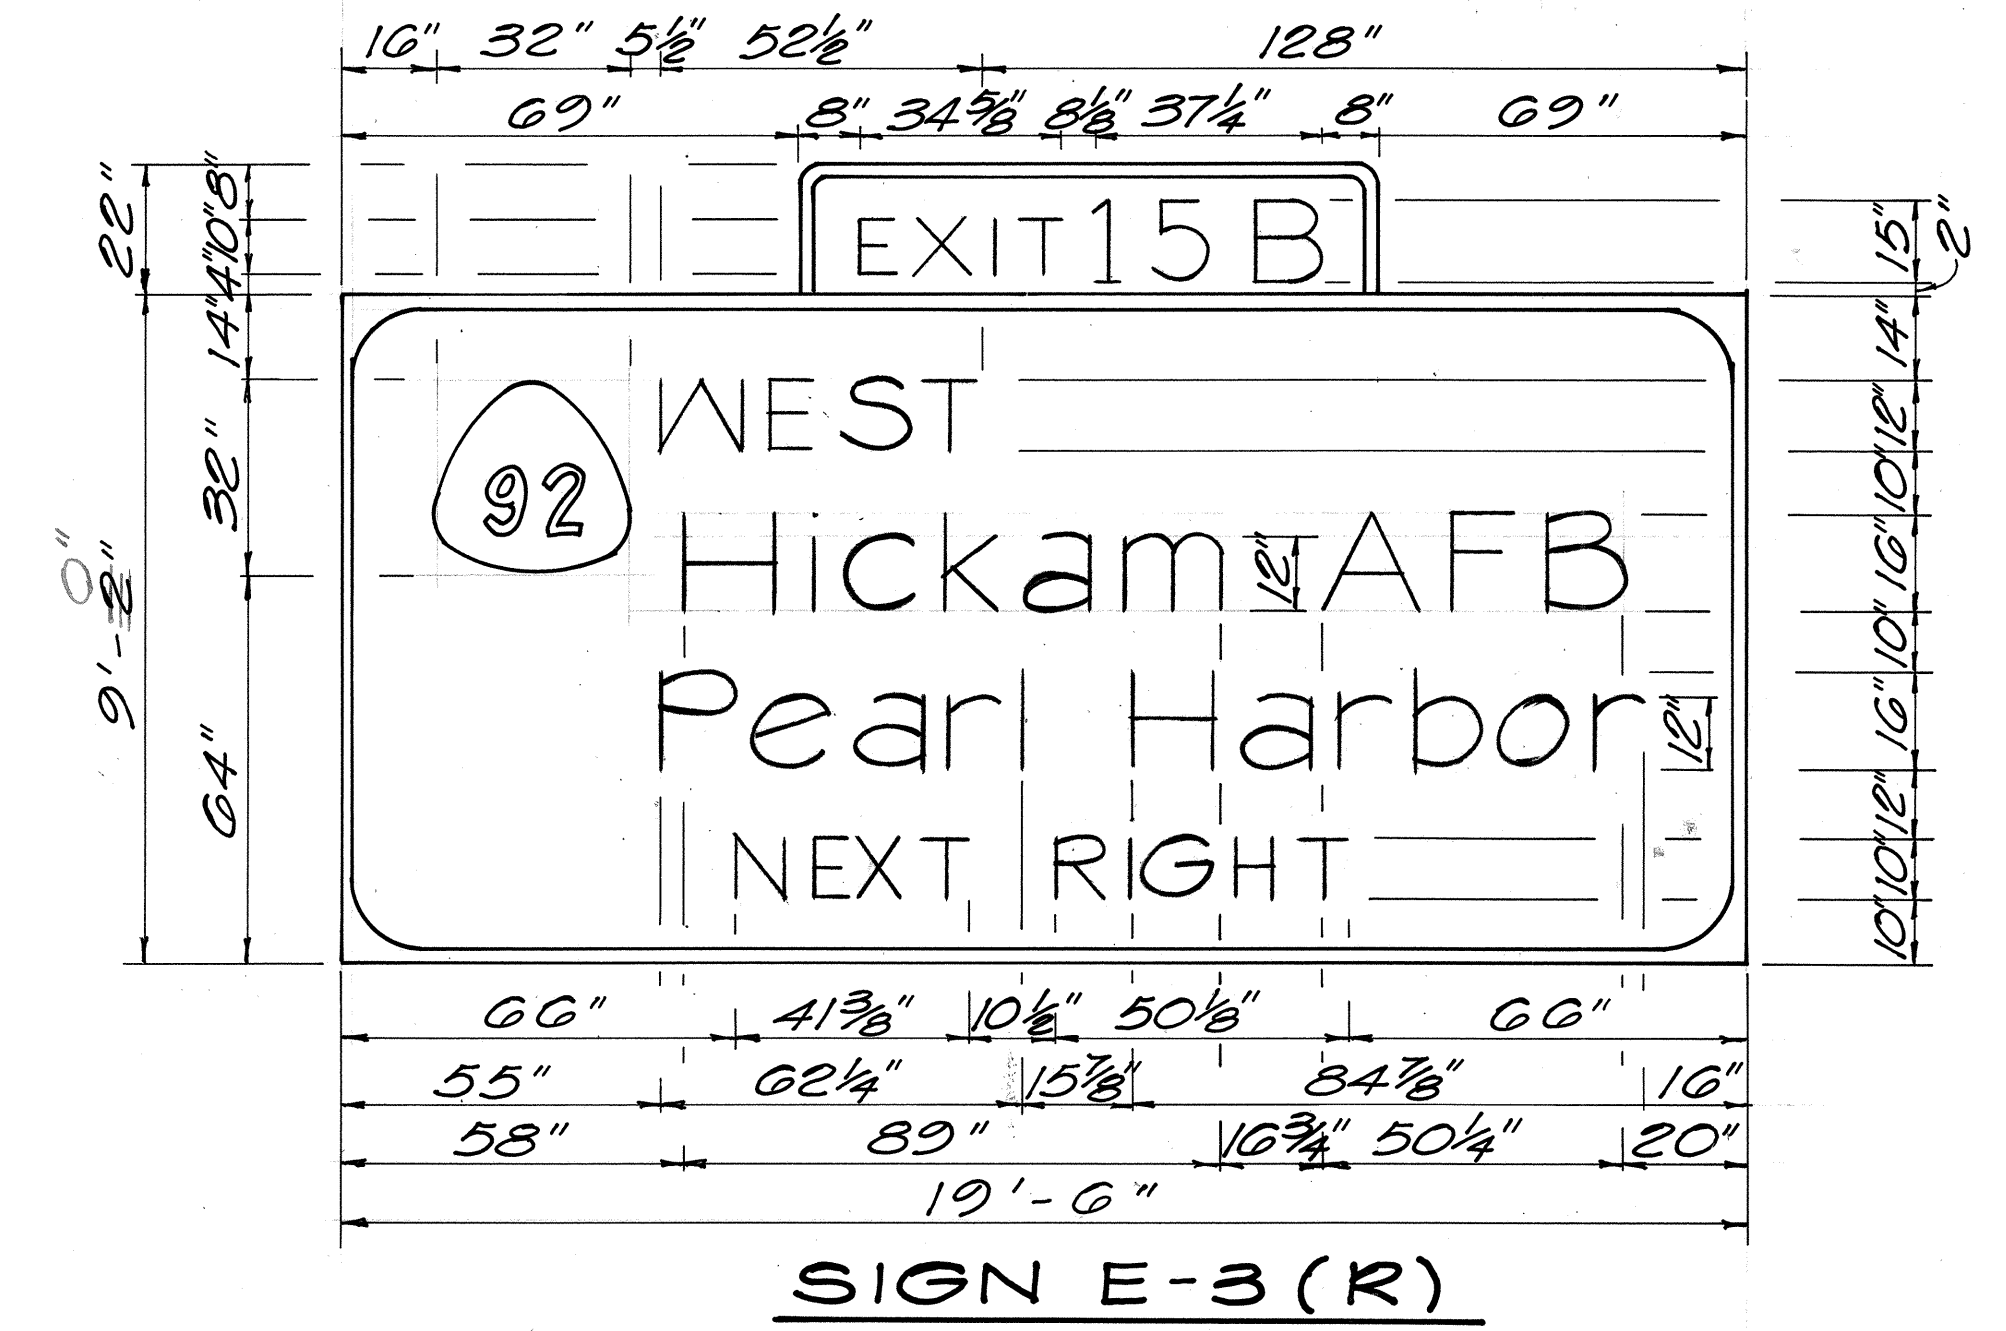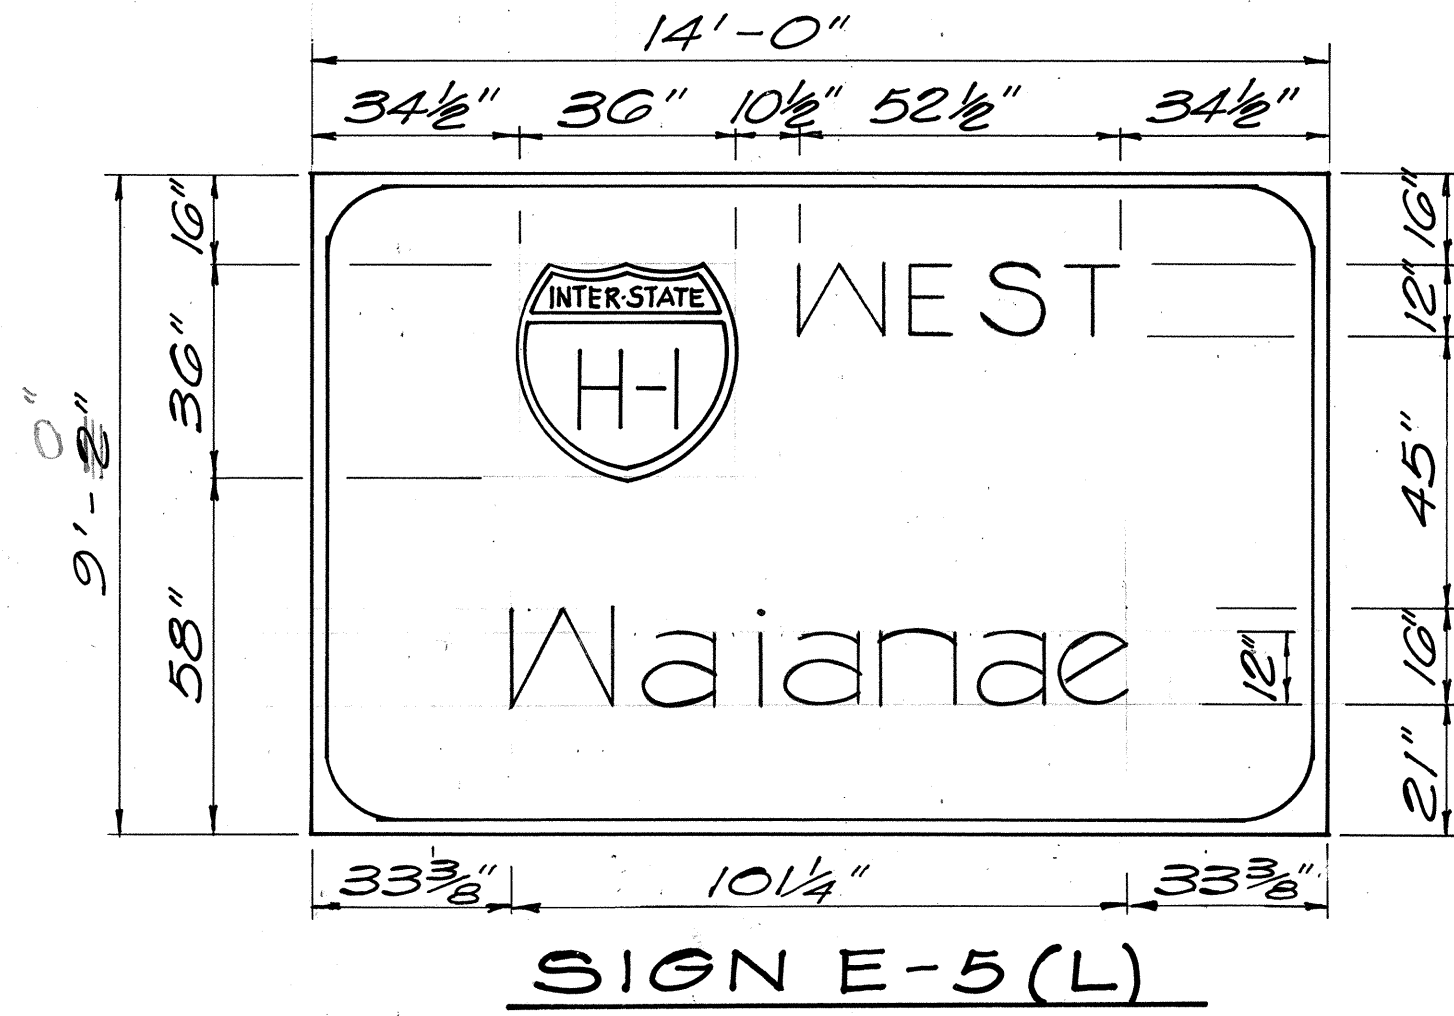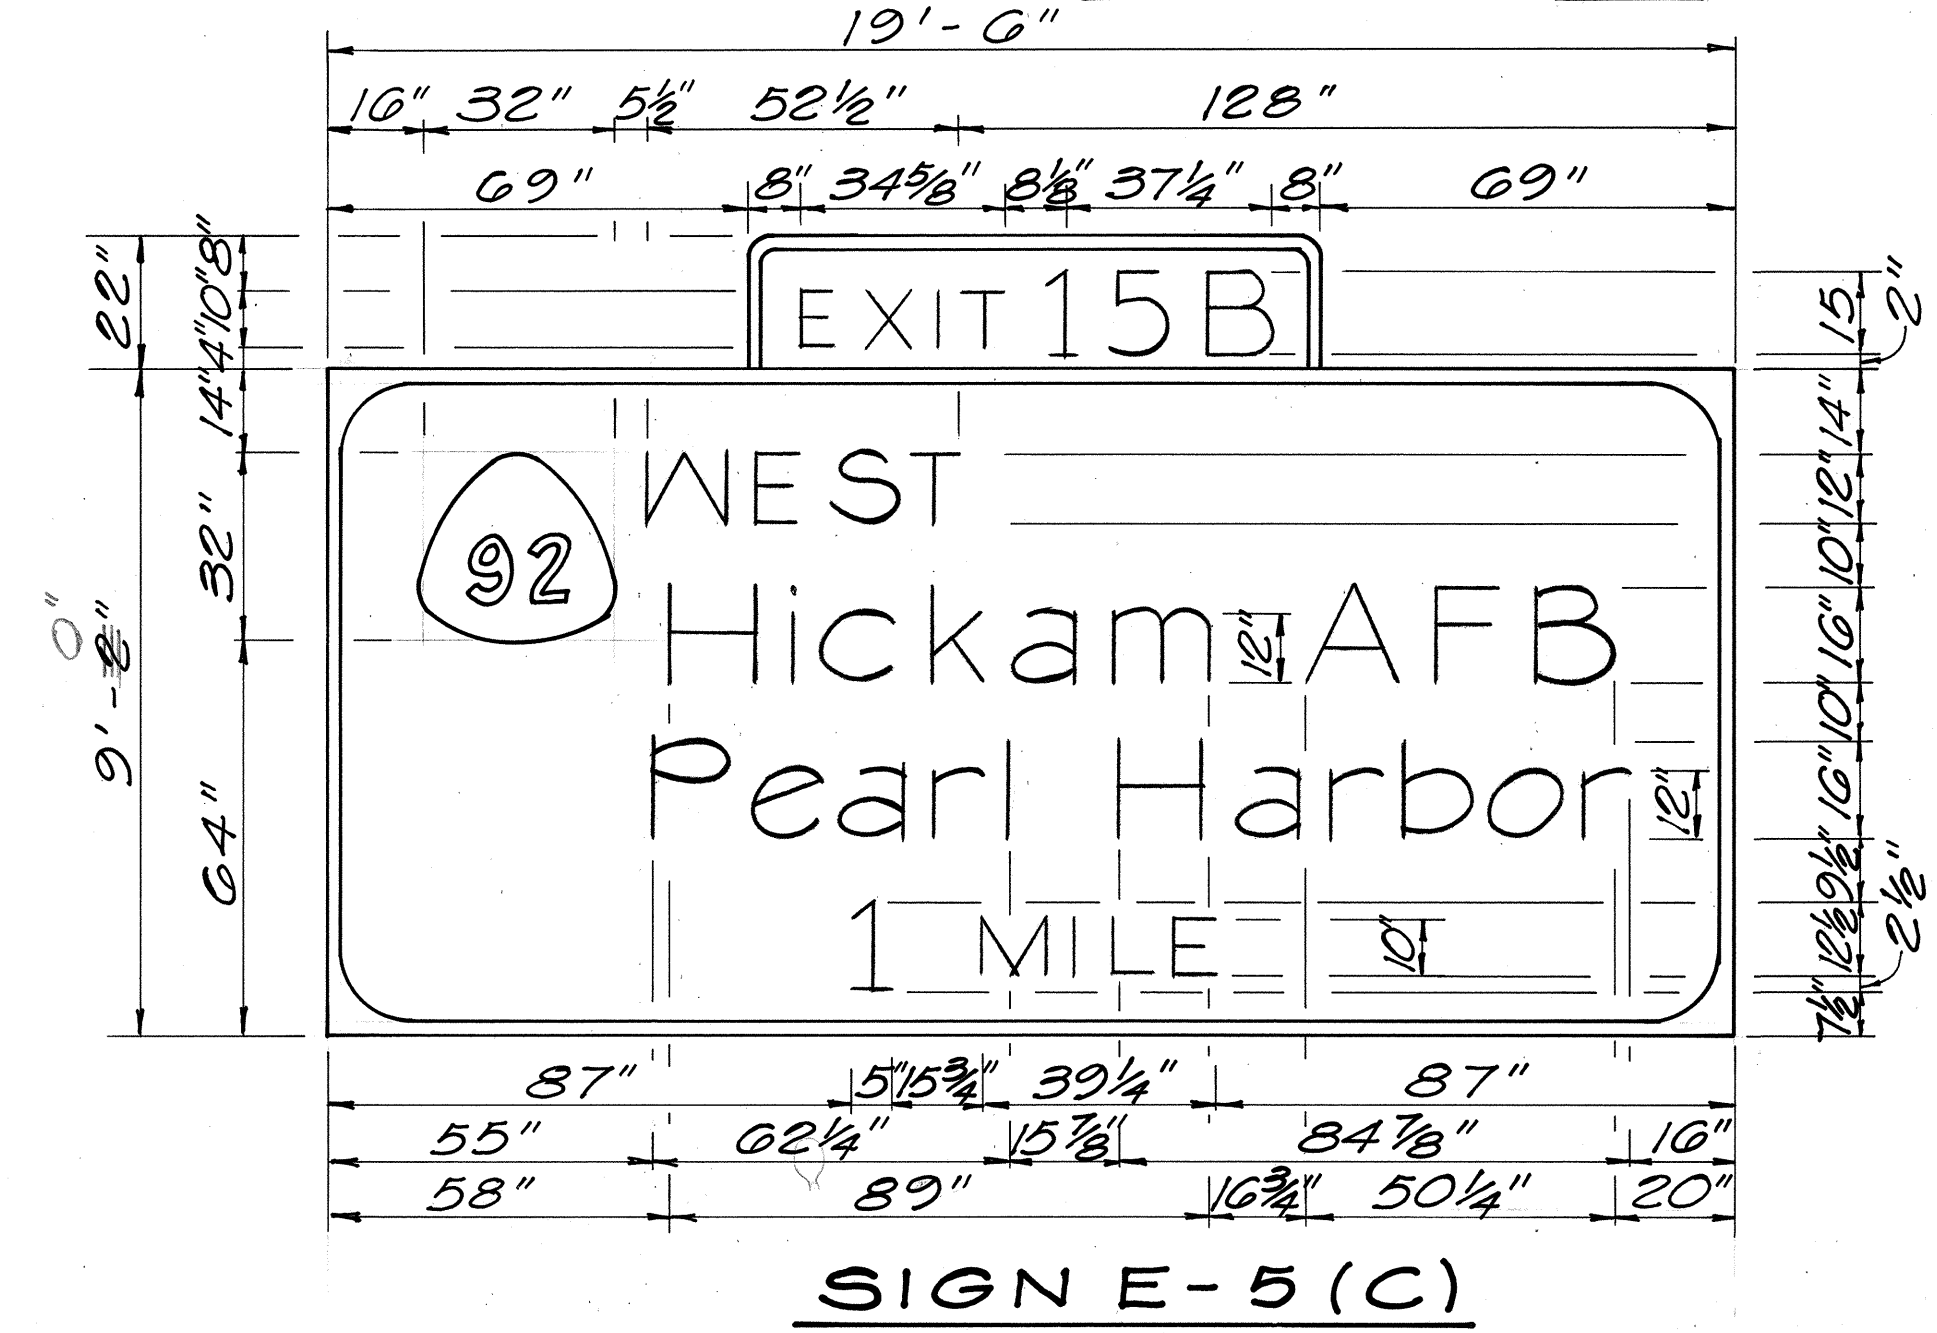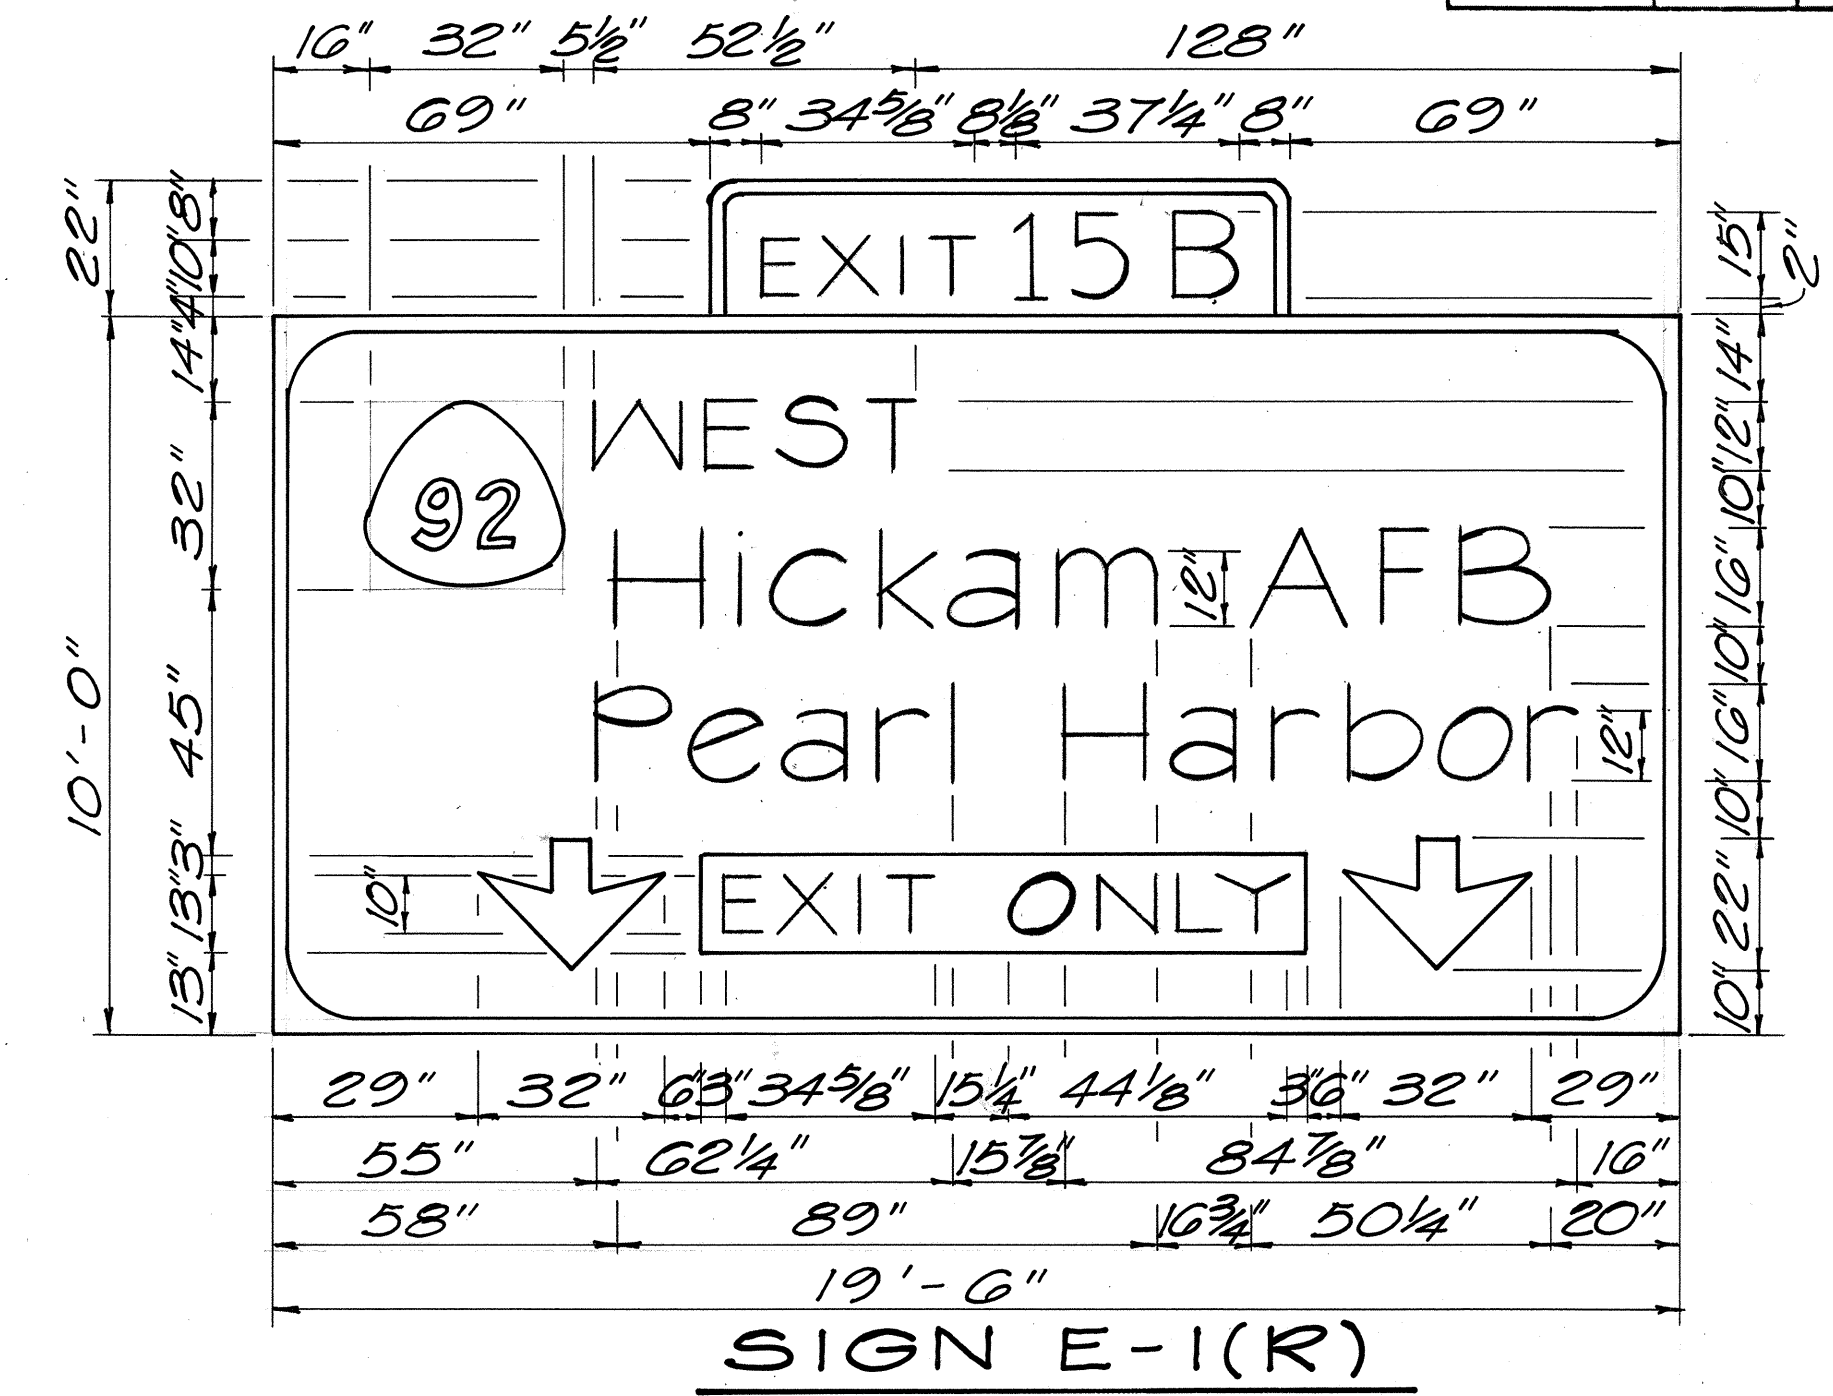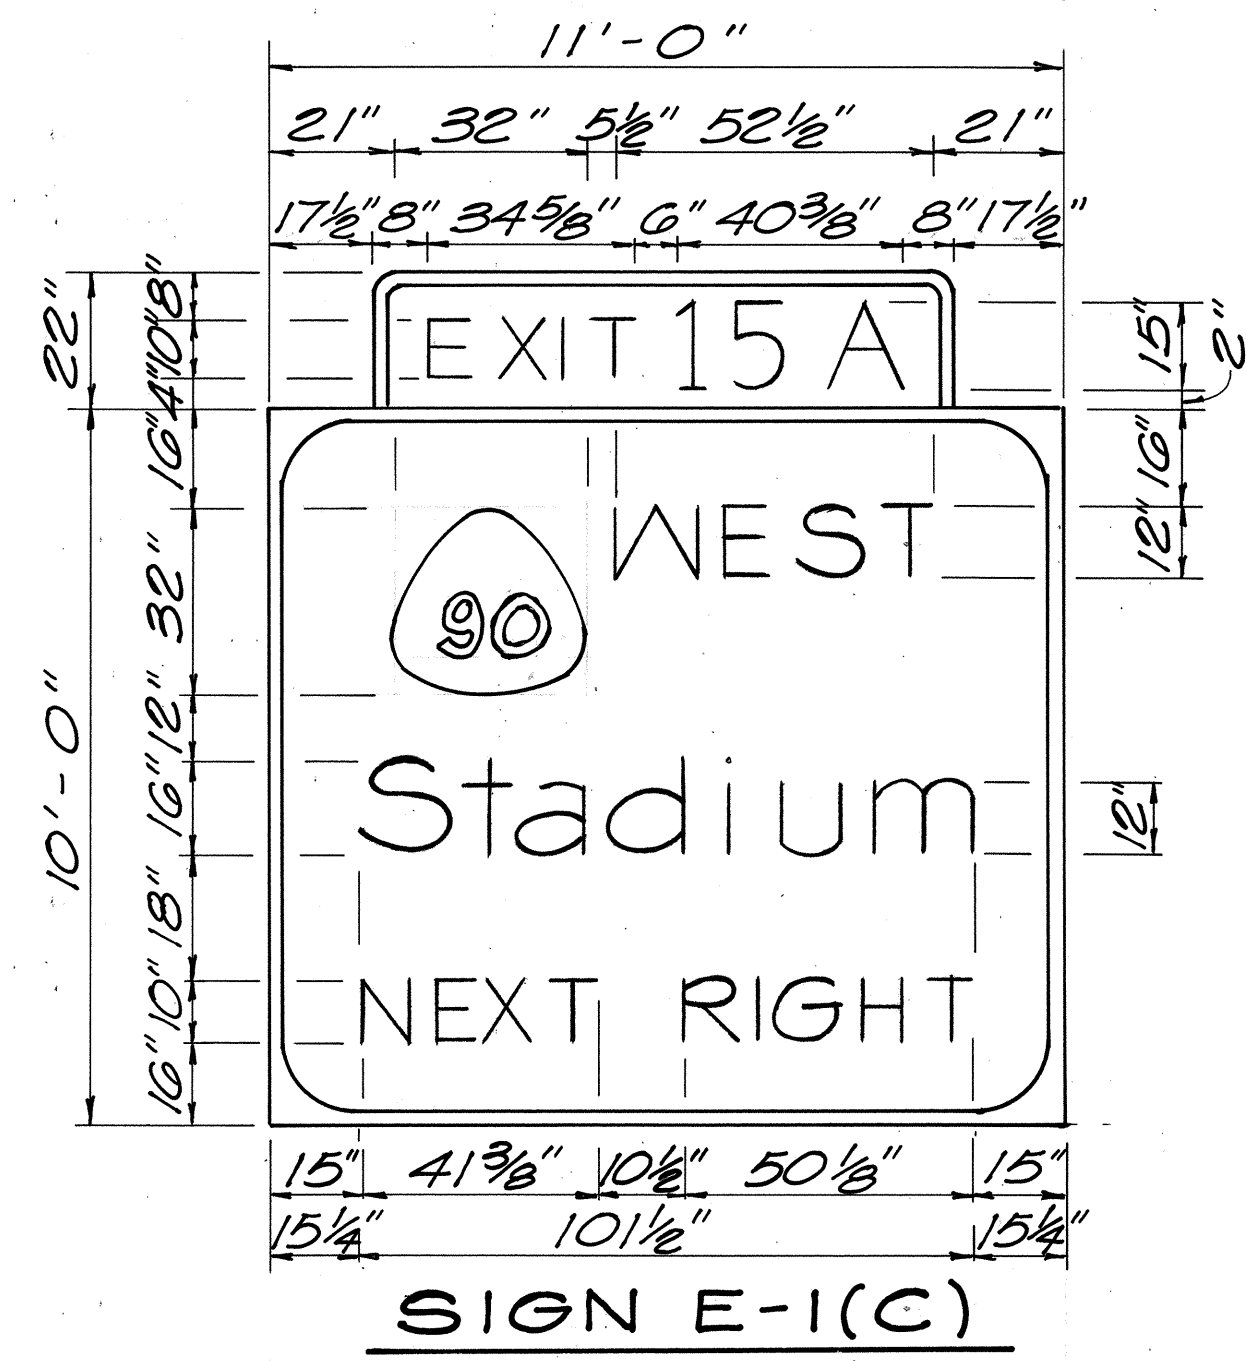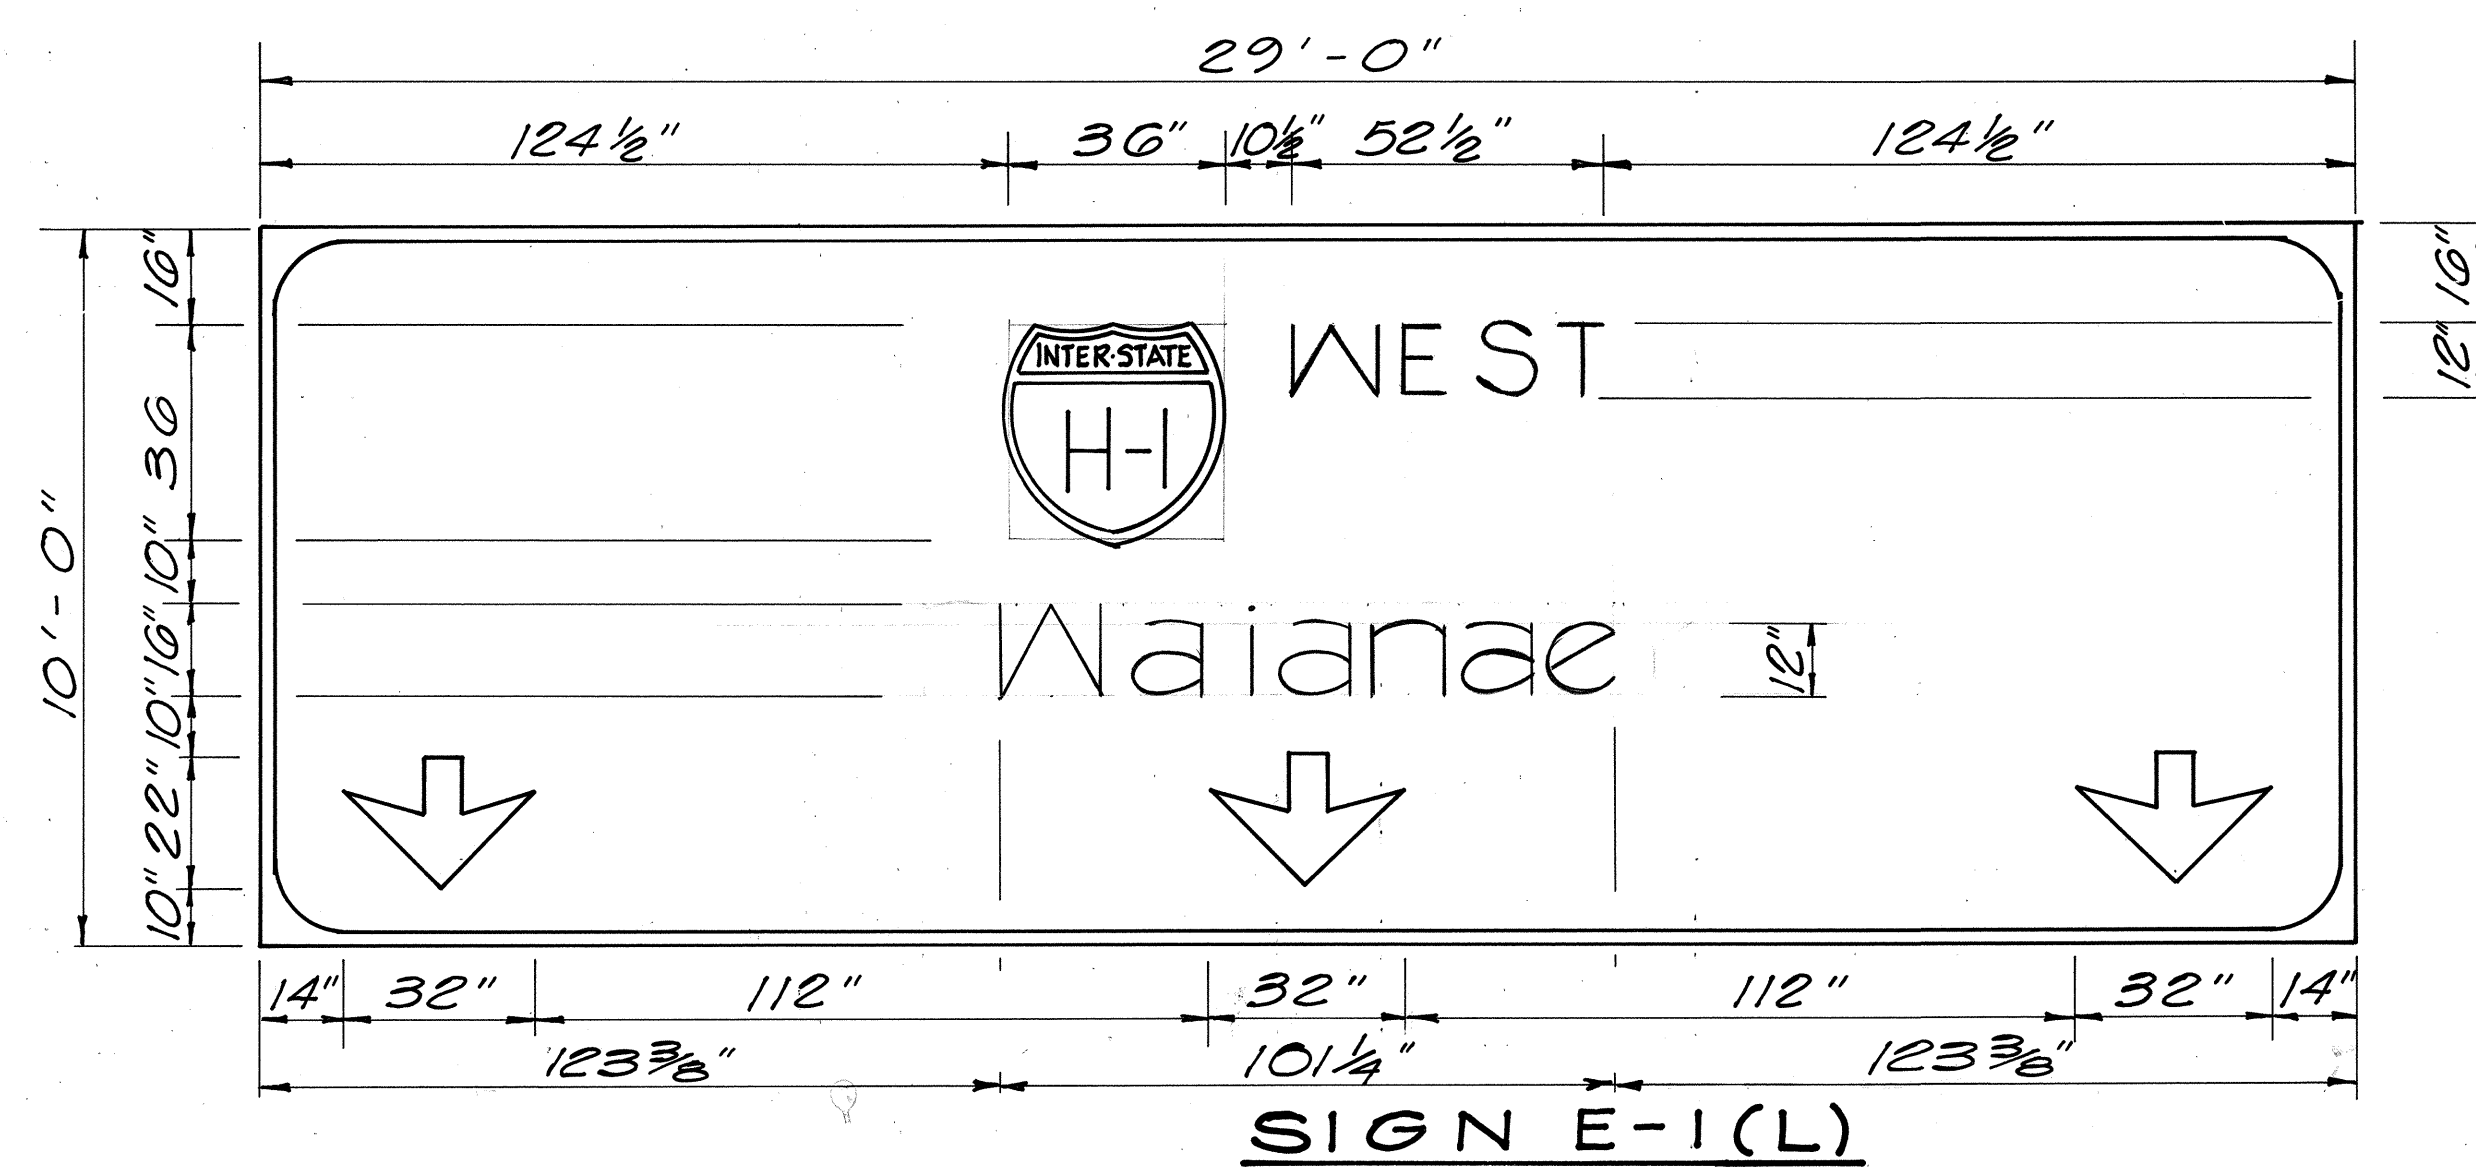


9-12-77	Signs E-1(L) & E-5(L) change destination to 'Waianae'
DATE	REVISION

DESIGNED BY  
 DRAWN BY  
 CHECKED BY  
 DATE: 11-1-76  
 T. J. [Signature]


STATE OF HAWAII  
 DEPARTMENT OF TRANSPORTATION  
 HIGHWAYS DIVISION  
**PANEL LAYOUT  
 VIADUCT**  
 AIRPORT INTERCHANGE  
 F.A.I. PROJ. NO. I-HI-1(120)16  
 SCALE: 3/8" = 1'-0" DATE: NOV. 1, 1975  
 SHEET No. 1 OF 2 SHEETS

PROFILE	SURVEYED	DATE
NOTE BOOK	PLOTTED	
NO.	GRADES CHECKED	
	STRUCTURE NOTATIONS CHECKED	


FED. ROAD DIST. NO.	STATE	FED. AID PROJ. NO.	FISCAL YEAR	SHEET NO.	TOTAL SHEETS
HAWAII	HAW.	I-HI-1(120)16	1976	8	173

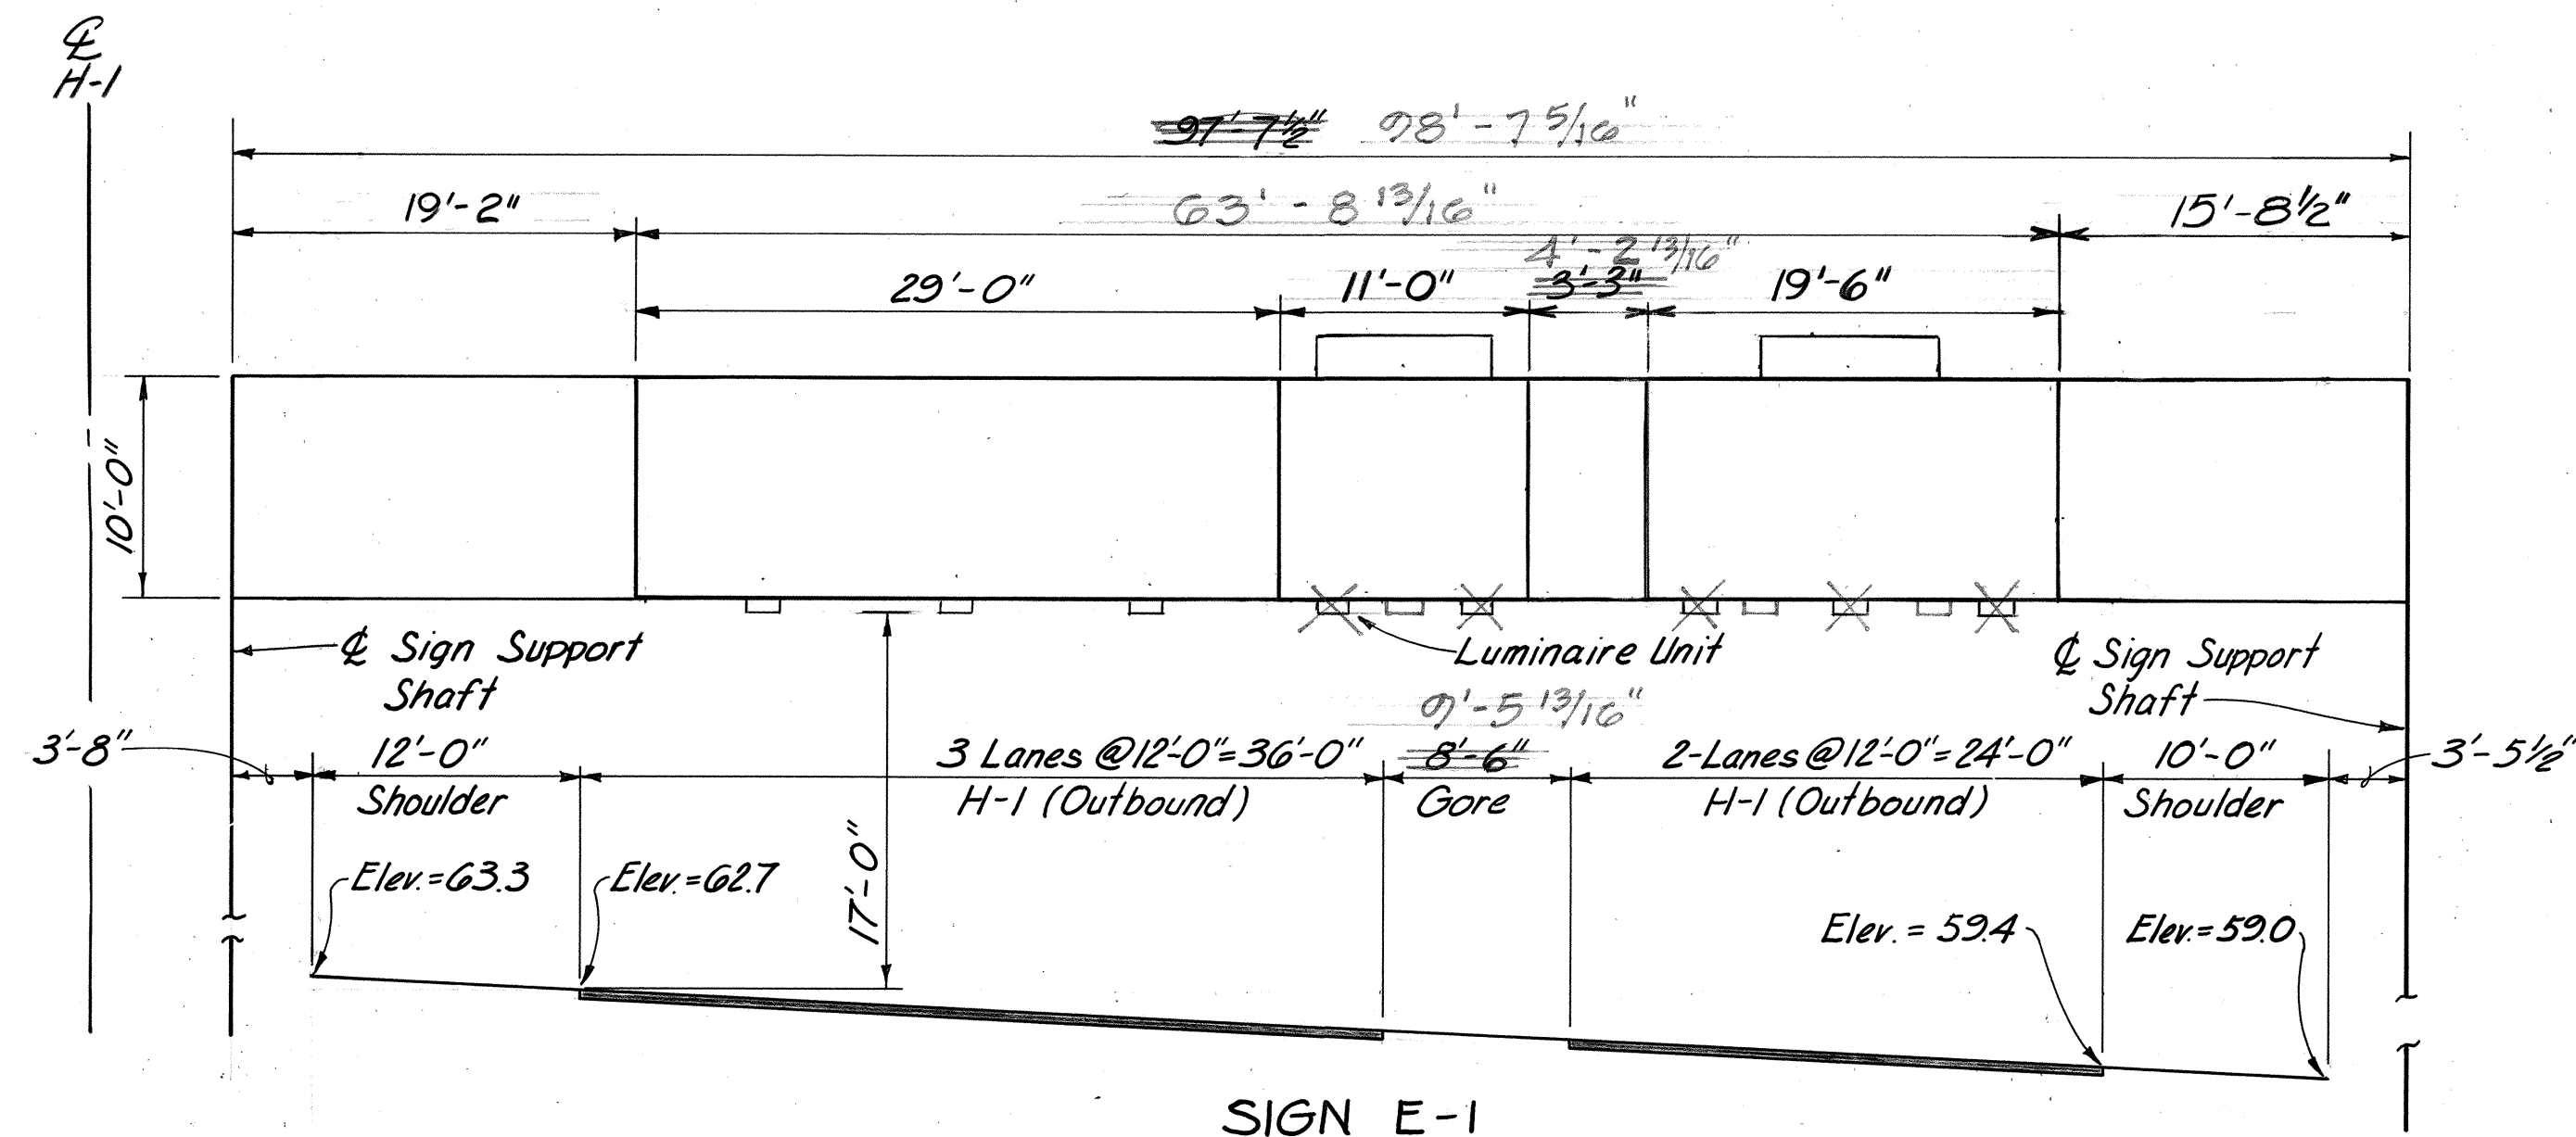


**SIGN E-1**  
Sta. 116 + 18 (Outbound)  
Panel Height - 120"

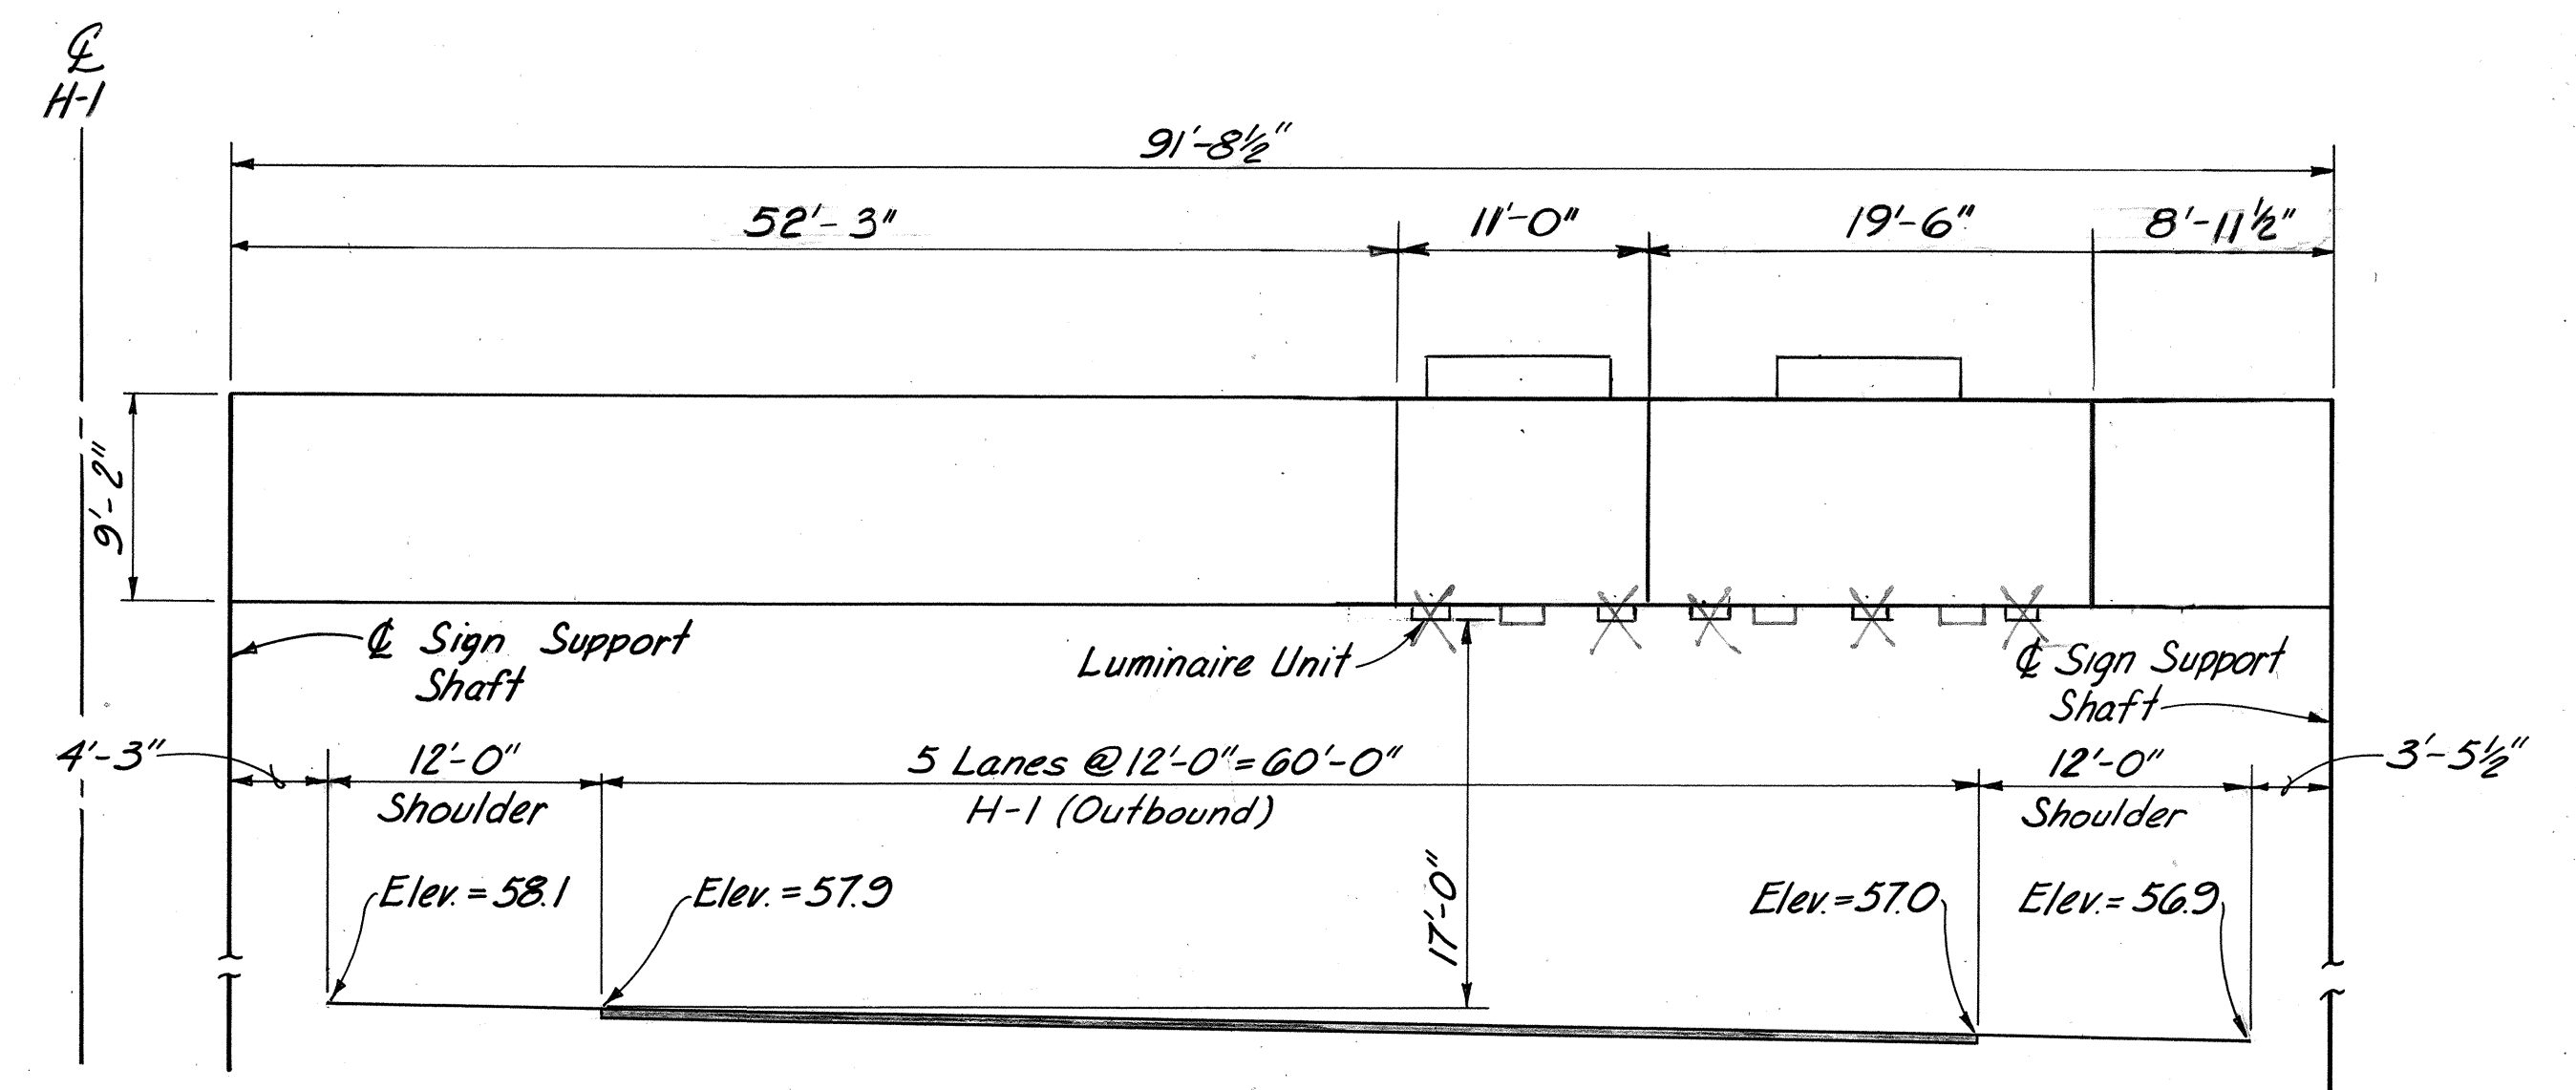

**SIGN E-3**  
Sta. 137 + 30 (Outbound)  
Panel Height - 110"

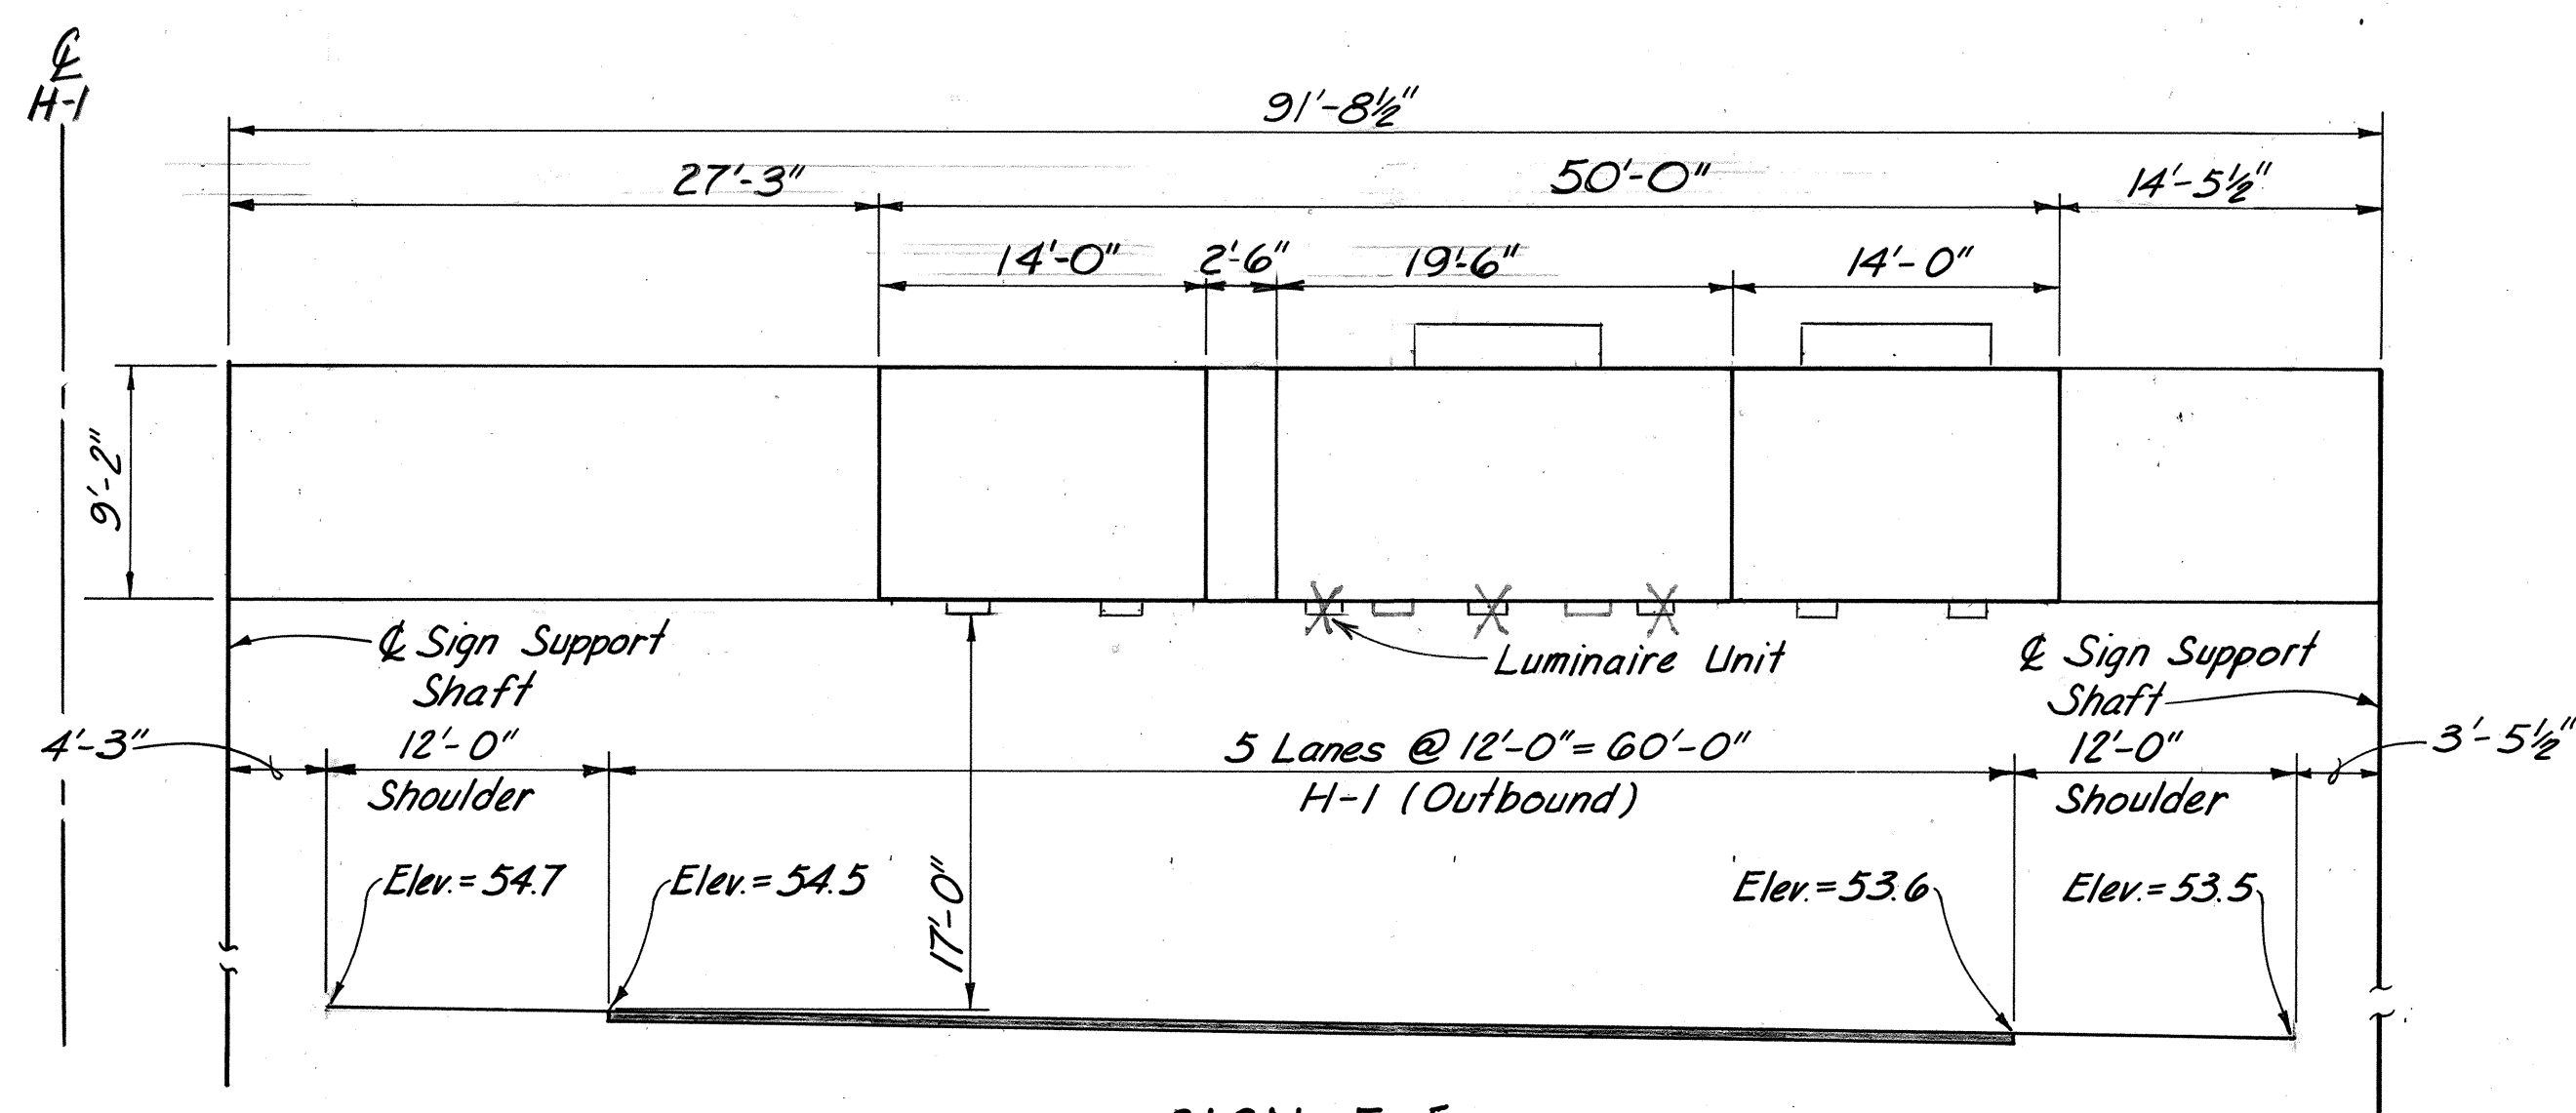


**SIGN E-5**  
Sta. 183 + 13 (Outbound)  
Panel Height - 110"

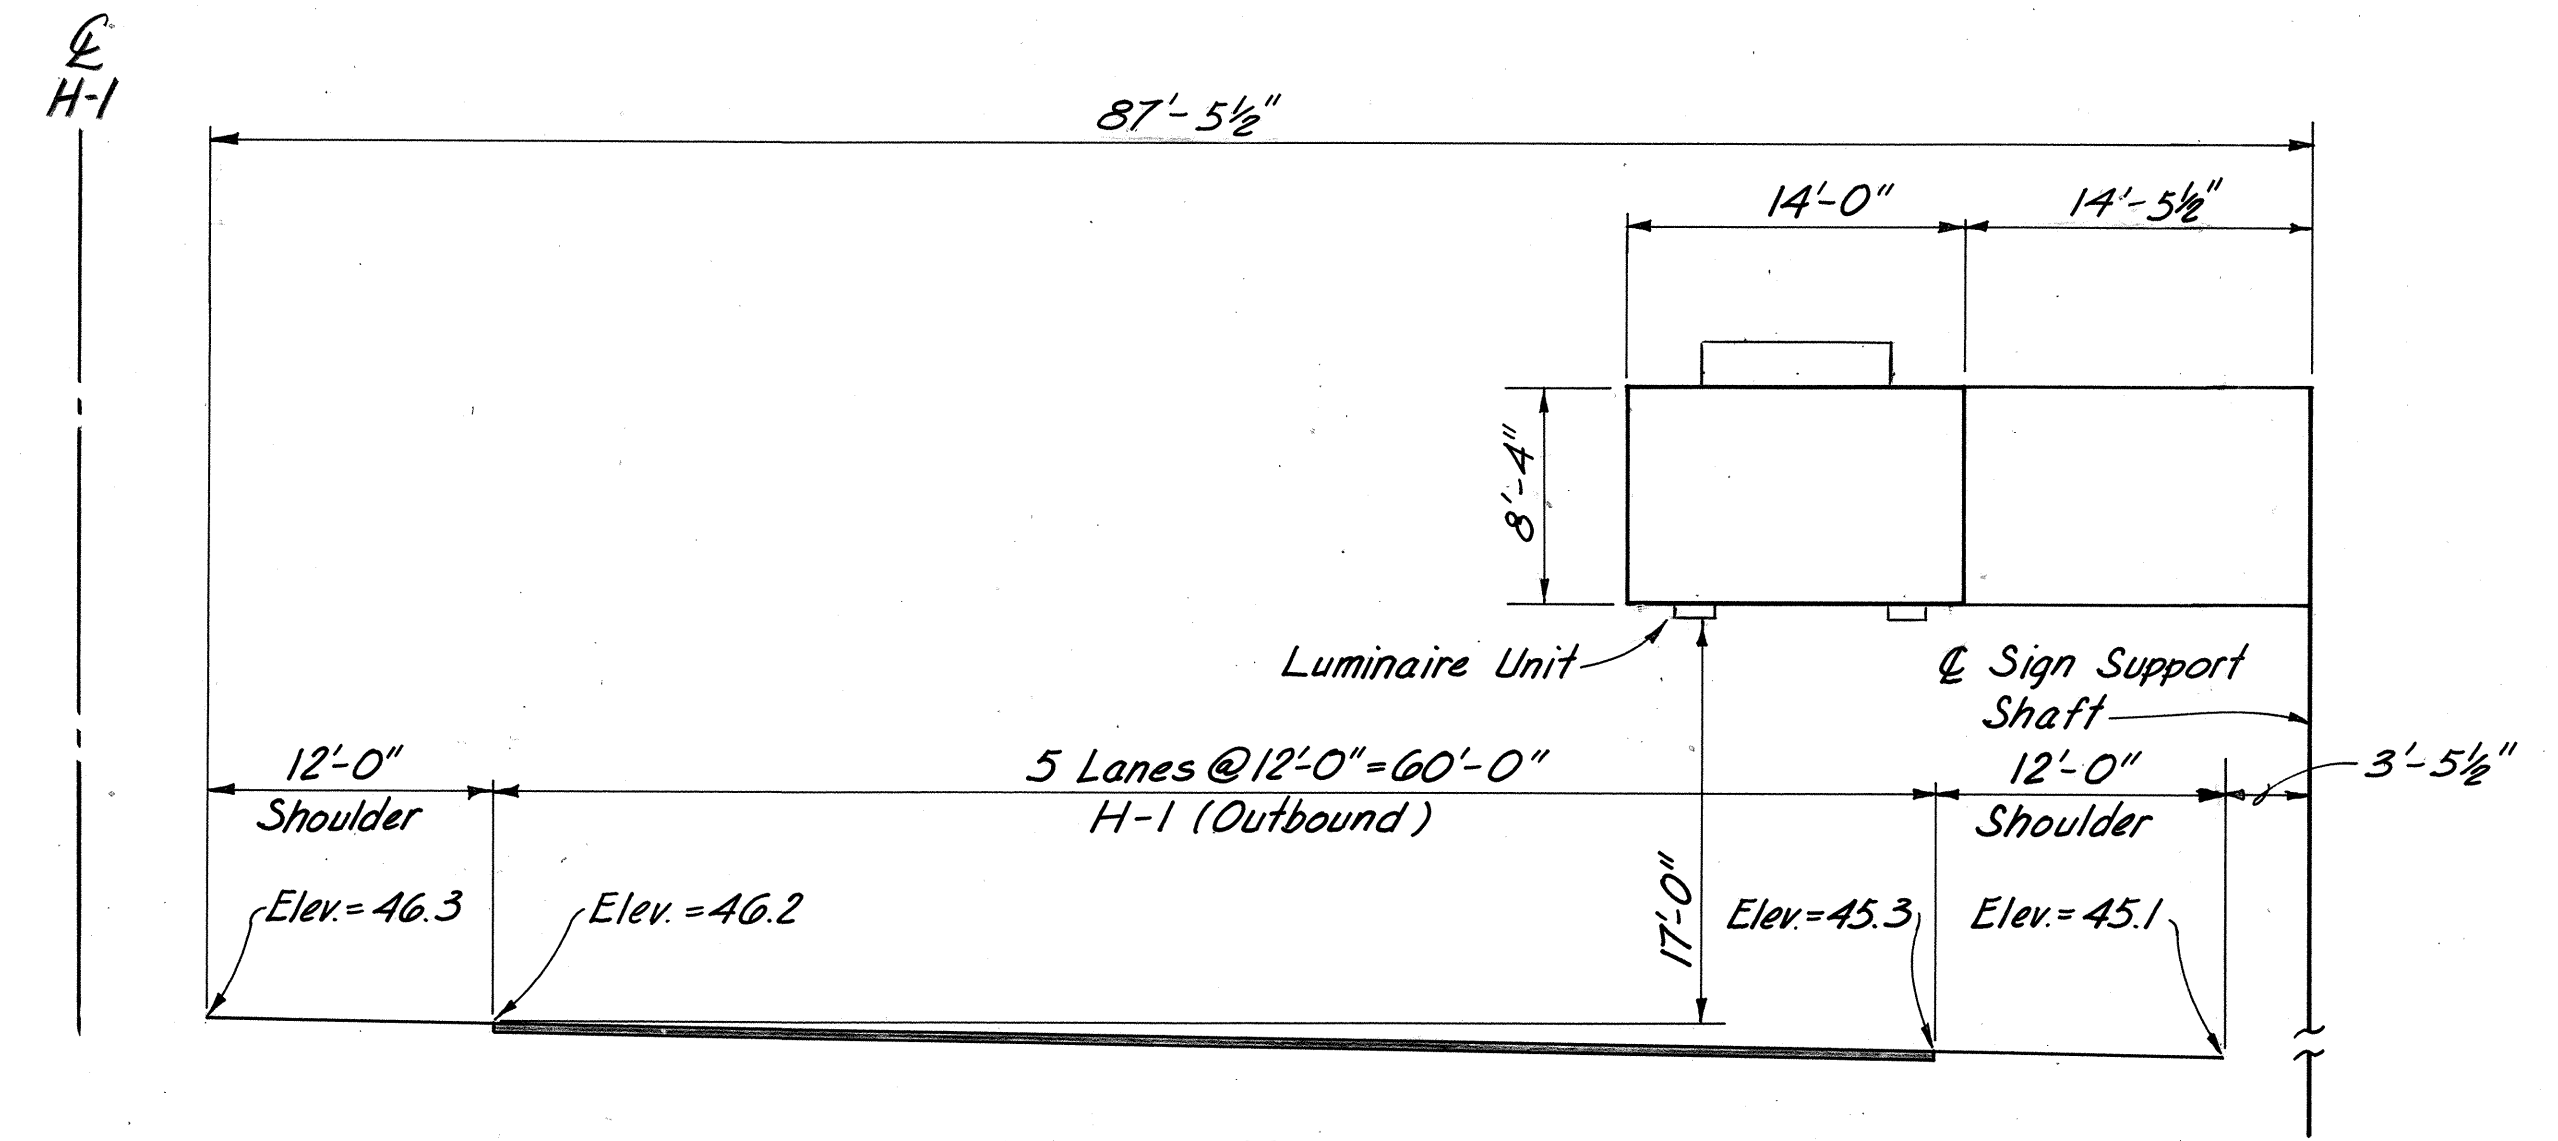

**SIGN E-7**  
Sta. 199 + 87 (Outbound)  
Panel Height - 100"

DESIGNED BY	DATE
DRAWN BY	
CHECKED BY	
QUANTITIES BY	
REVISIONS	

5-10-76	Sign Dimension Changed E-1, E3, E5
DATE	REVISION

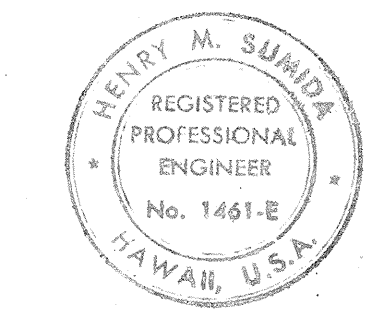

THIS WORK WAS PREPARED BY ME OR UNDER MY SUPERVISION  
*Henry M. Sumida*

STATE OF HAWAII  
DEPARTMENT OF TRANSPORTATION  
HIGHWAYS DIVISION

FRAME LAYOUT  
VIADUCT

AIRPORT INTERCHANGE  
F.A.T. PROJ. NO. I - HI - 1(120)16

SCALE: NO SCALE DATE: NOV. 1, 1975

SHEET No. 2 OF 2 SHEETS