
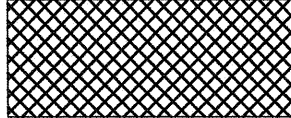



FED. ROAD DIST. NO.	STATE	FED. AID PROJ. NO.	FISCAL YEAR	SHEET NO.	TOTAL SHEETS
HAWAII	HAW.	1M-H1-1(242)	2016	28	354

Legend:

-  Remove Structure
-  Saw Cut, Remove and Dispose Exist. Asphalt Pavement Structure Including Base and Subbase

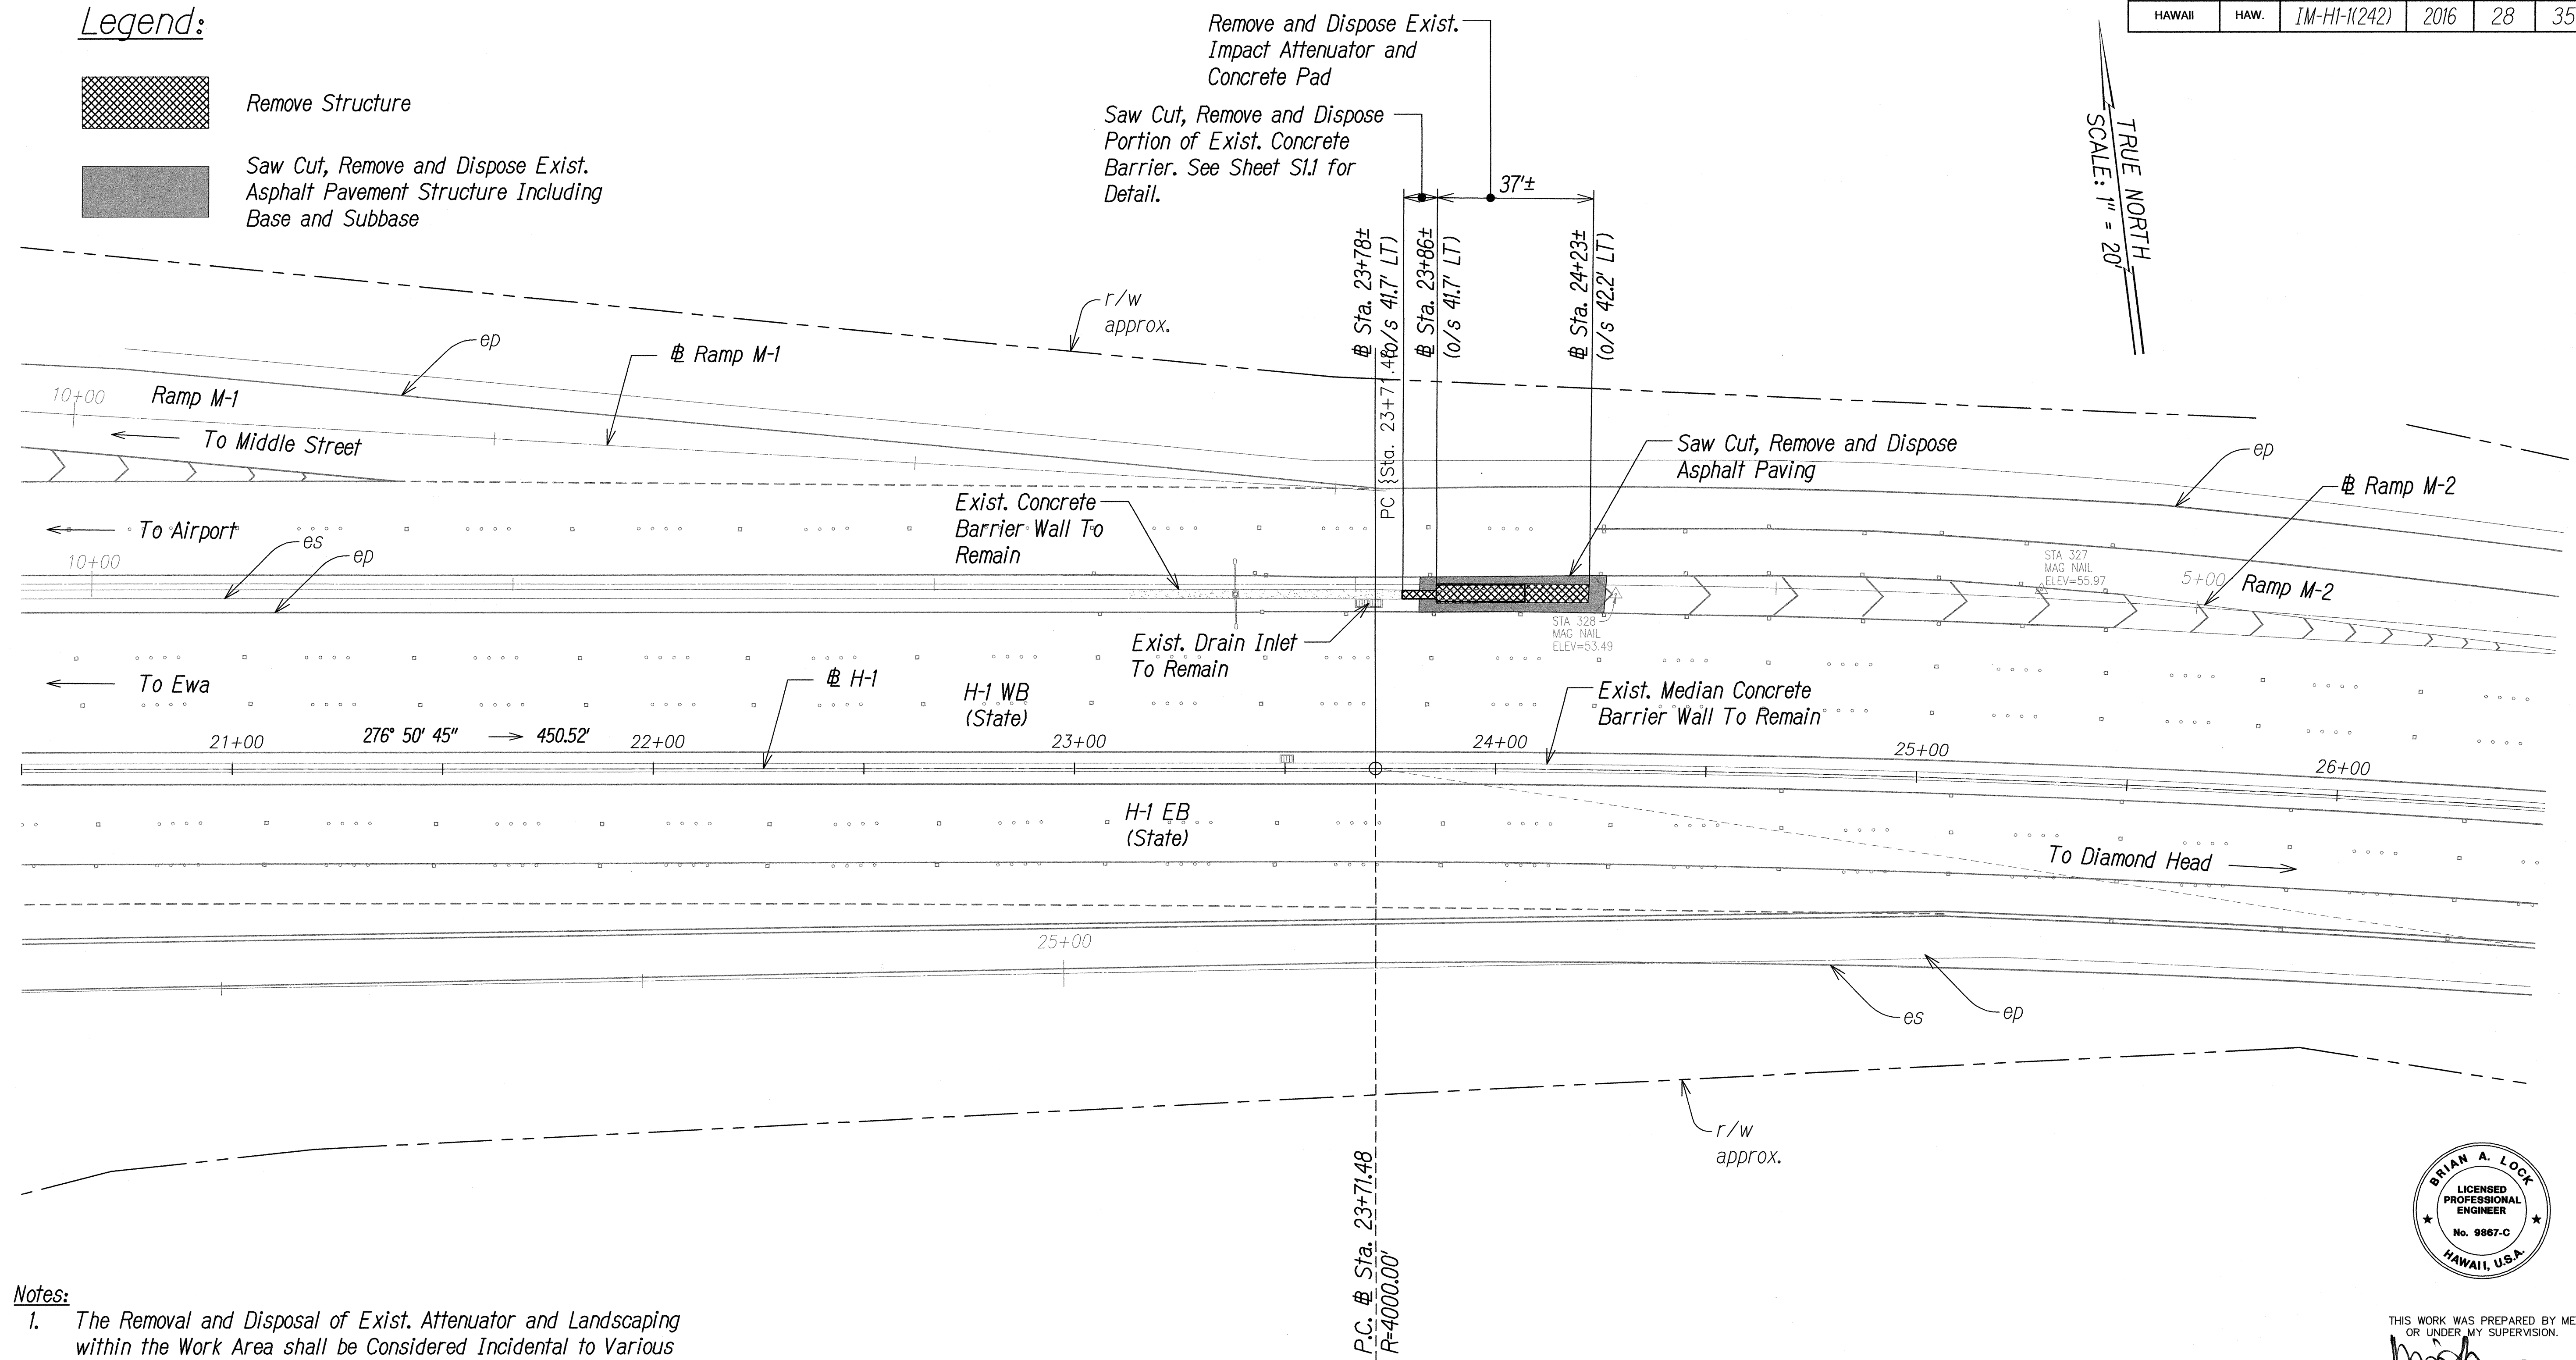


- Notes:**
- The Removal and Disposal of Exist. Attenuator and Landscaping within the Work Area shall be Considered Incidental to Various Contract Items.
 - The Contractor's Attention is Directed to Section 209-Water Pollution Erosion During Construction Operations.
 - All Disturbed Landscaped Area shall be Restored to Exist. Condition or Better.
 - Street Light Standards, Pullboxes and Conduit shall Remain Unless Otherwise Noted.

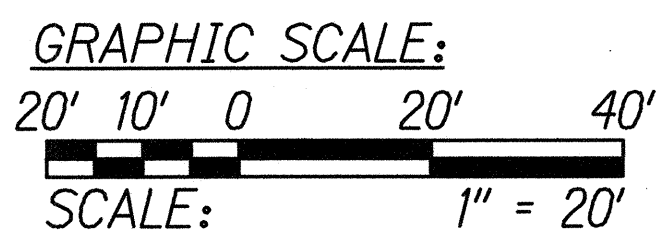

STA. 20+50 TO 26+50 (# H-1)

SURVEY PLOTTED BY	DATE
DRAWN BY	
DESIGNED BY	
CHECKED BY	
ORIGINAL PLAN	No.
NOTE BOOK	

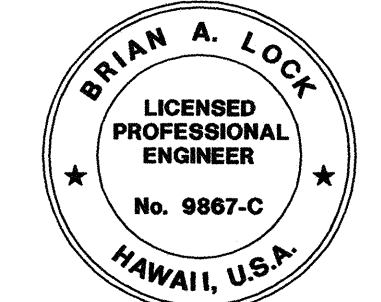


THIS WORK WAS PREPARED BY ME OR UNDER MY SUPERVISION.

mol


APRIL 30, 2018
WILSON OKAMOTO CORPORATION LIC. EXP. DATE

STATE OF HAWAII
DEPARTMENT OF TRANSPORTATION
HIGHWAYS DIVISION
H201 EXIT
DEMOLITION PLAN
INTERSTATE ROUTE H-1
GUARDRAIL AND SHOULDER IMPROVEMENTS
Middle Street to Punchbowl Off-Ramp
Fed. Aid Project No. 1M-H1-1(242)
Scale: 1" = 20' Date: Mar. 2016
SHEET No. DP-1 OF 16 SHEETS


FED. ROAD DIST. NO.	STATE	FED. AID PROJ. NO.	FISCAL YEAR	SHEET NO.	TOTAL SHEETS
HAWAII	HAW.	1M-HI-1(242)	2016	30	354

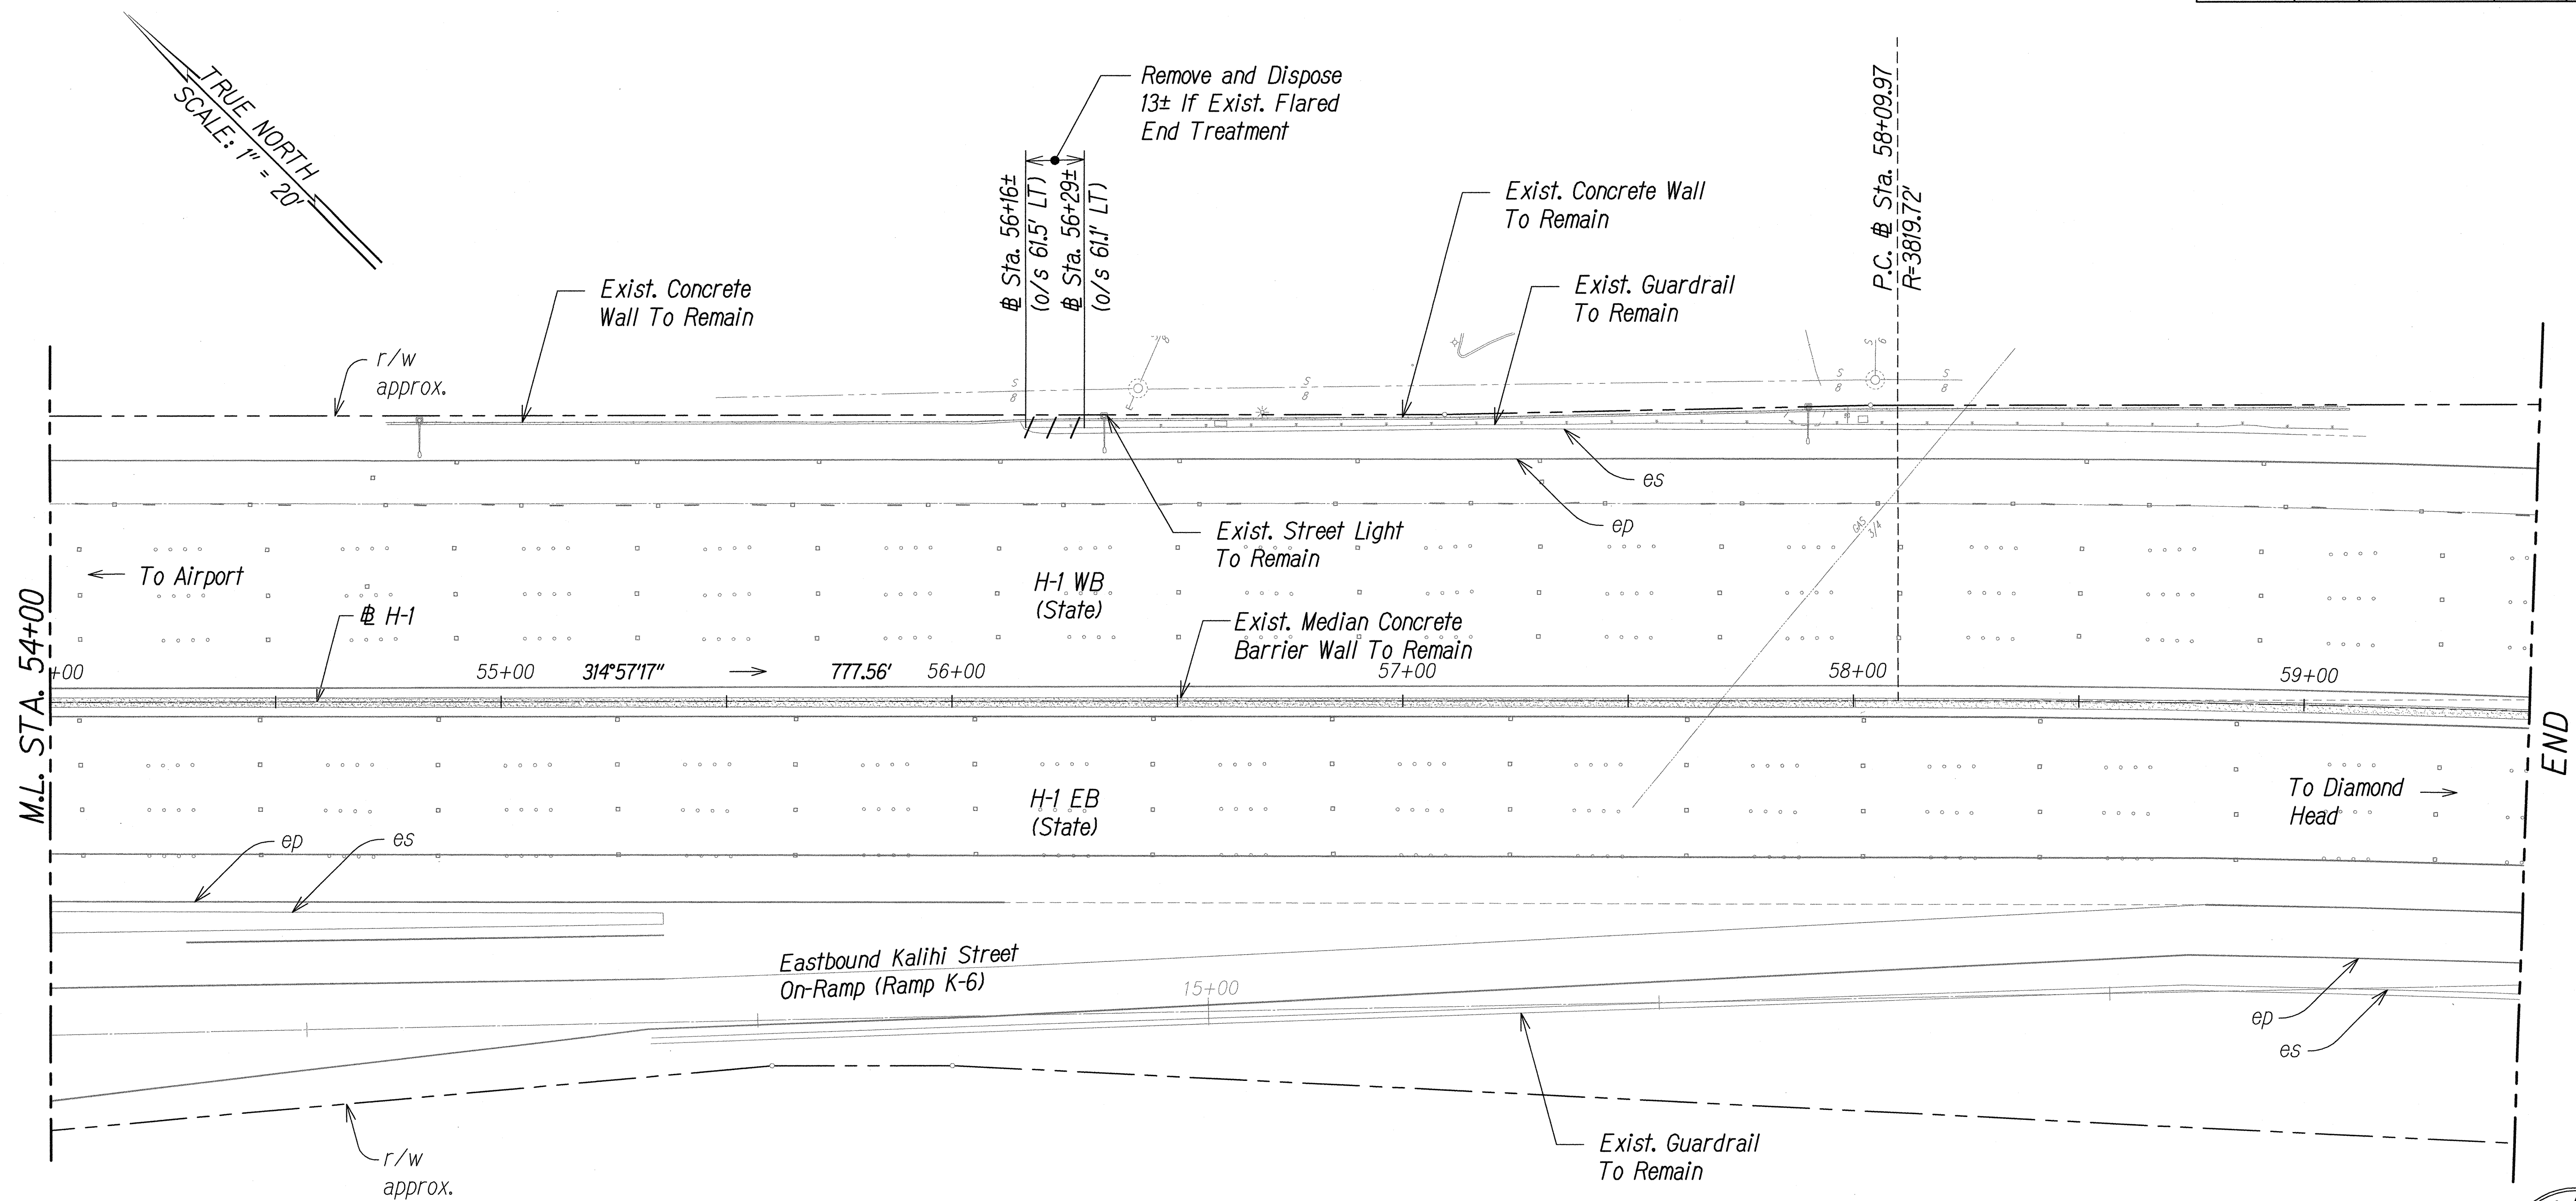

- Notes:**
1. The Contractor's Attention is Directed to Section 209-Water Pollution Erosion During Construction Operations.
 2. All Disturbed Landscaped Area shall be Restored to Exist. Condition or Better.
 3. Street Light Standards, Pullboxes and Conduit shall Remain Unless Otherwise Noted.

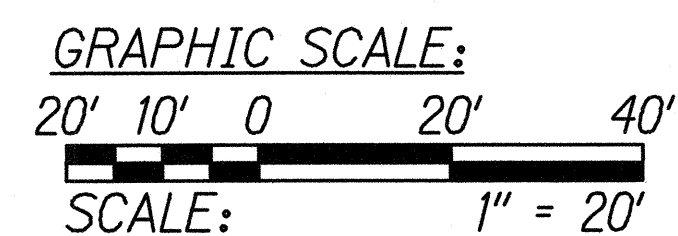

STA. 54+00 TO 59+50 (H-1)

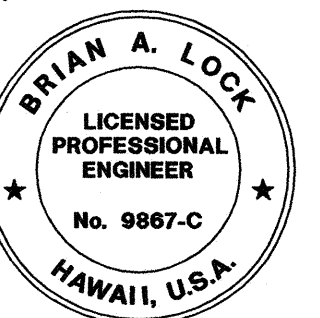


THIS WORK WAS PREPARED BY ME
OR UNDER MY SUPERVISION.
mish
WILSON OKAMOTO CORPORATION LIC. EXP. DATE

STATE OF HAWAII
DEPARTMENT OF TRANSPORTATION
HIGHWAYS DIVISION
KALIHI INTERCHANGE
DEMOLITION PLAN
INTERSTATE ROUTE H-1
GUARDRAIL AND SHOULDER IMPROVEMENTS
Middle Street to Punchbowl Off-Ramp
Fed. Aid Project No. 1M-HI-1(242)
Scale: 1" = 20' Date: Mar. 2016
SHEET No. DP-3 OF 16 SHEETS

ORIGINAL PLAN	SURVEY PLOTTED BY	DATE
NOTE BOOK	DRAWN BY	
No.	DESIGNED BY	
	CHECKED BY	

FED. ROAD DIST. NO.	STATE	FED. AID PROJ. NO.	FISCAL YEAR	SHEET NO.	TOTAL SHEETS
HAWAII	HAW.	1M-H1-1(242)	2016	31	354

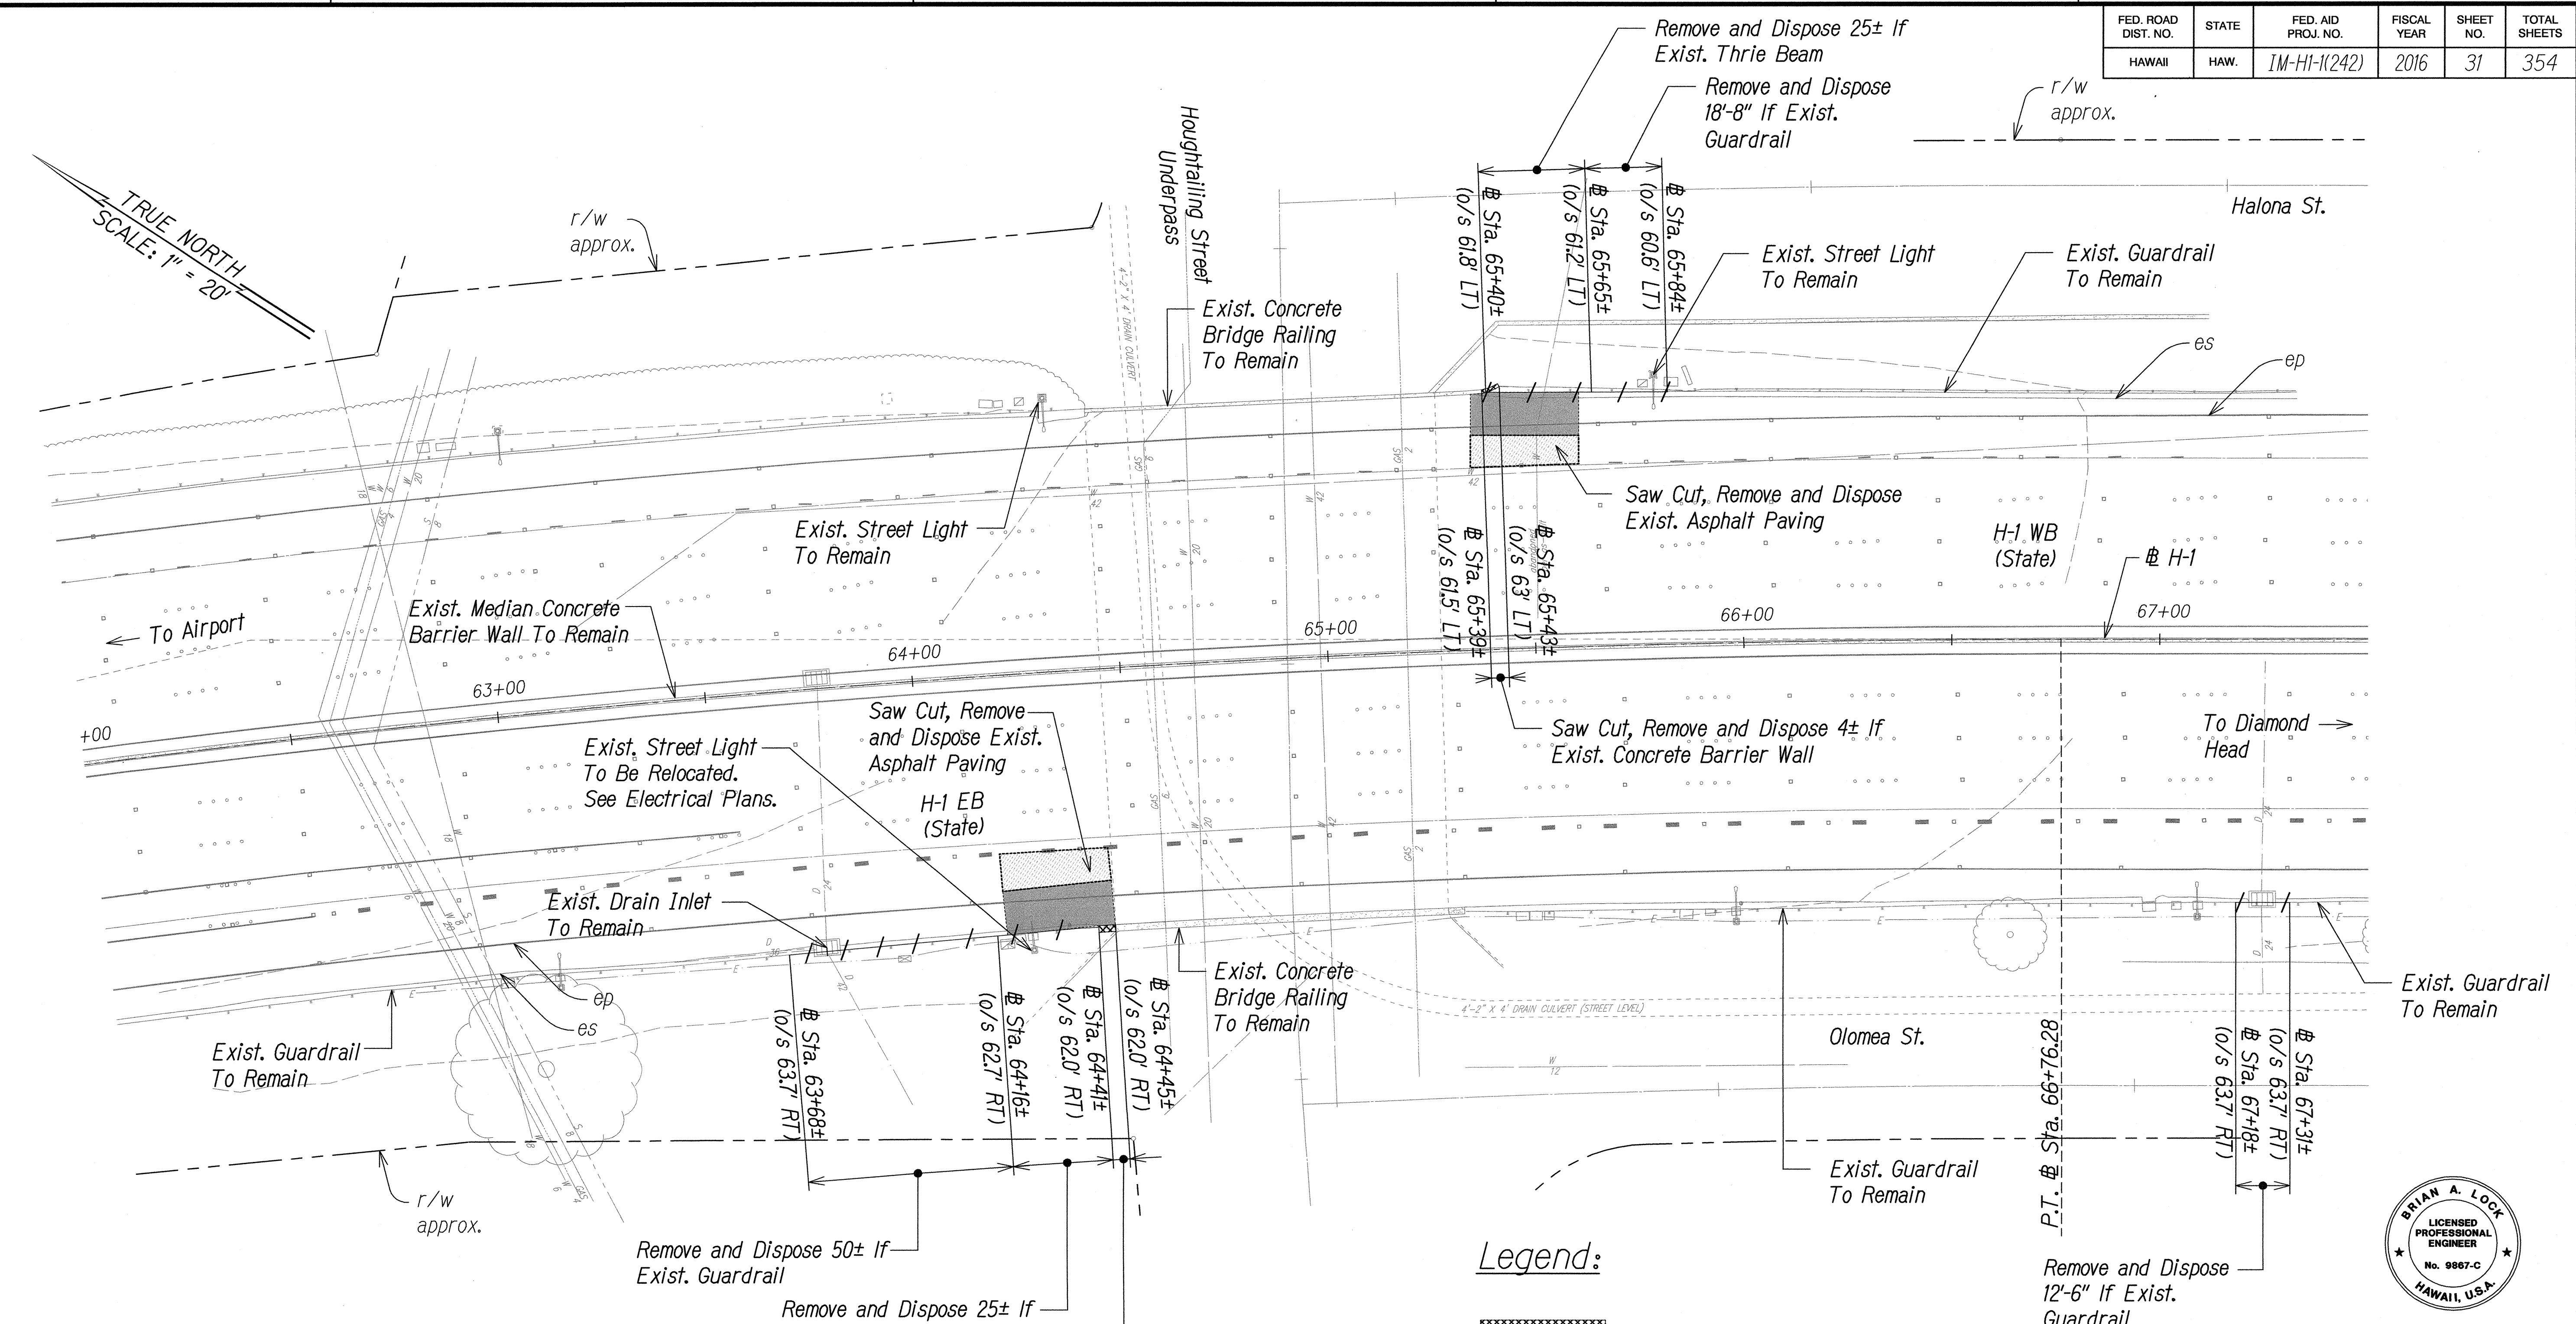


- Notes:**
- The Contractor's Attention is Directed to Section 209-Water Pollution Erosion During Construction Operations.
 - All Disturbed Landscaped Area shall be Restored to Exist. Condition or Better.
 - Street Light Standards, Pullboxes and Conduit shall Remain Unless Otherwise Noted.

Legend:

- Remove Structure
- Saw Cut, Remove and Dispose Exist. Asphalt Pavement Structure Including Base and Subbase
- Cold Plane Exist. A.C. 2" Pavement
- Remove Object

SURVEY PLOTTED BY	DATE
DRAWN BY	
DESIGNED BY	
CHECKED BY	
ORIGINAL PLAN	No.
NOTE BOOK	

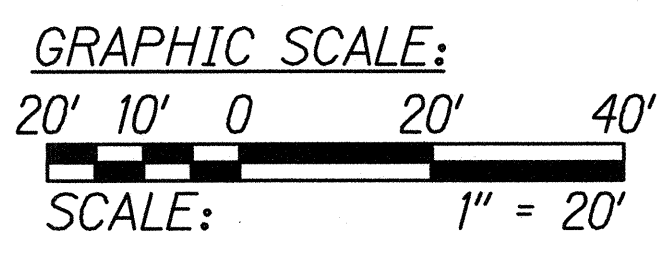

THIS WORK WAS PREPARED BY ME OR UNDER MY SUPERVISION.

msh APRIL 30, 2016
WILSON OKAMOTO CORPORATION LIC. EXP. DATE


STATE OF HAWAII
DEPARTMENT OF TRANSPORTATION
HIGHWAYS DIVISION

**HOUGHTAILING SEPARATION
DEMOLITION PLAN**


INTERSTATE ROUTE H-1
GUARDRAIL AND SHOULDER IMPROVEMENTS
Middle Street to Punchbowl Off-Ramp
Fed. Aid Project No. 1M-H1-1(242)
Scale: 1" = 20' Date: Mar. 2016

SHEET No. DP-4 OF 16 SHEETS

FED. ROAD DIST. NO.	STATE	FED. AID PROJ. NO.	FISCAL YEAR	SHEET NO.	TOTAL SHEETS
HAWAII	HAW.	1M-H1-1(242)	2016	32	354

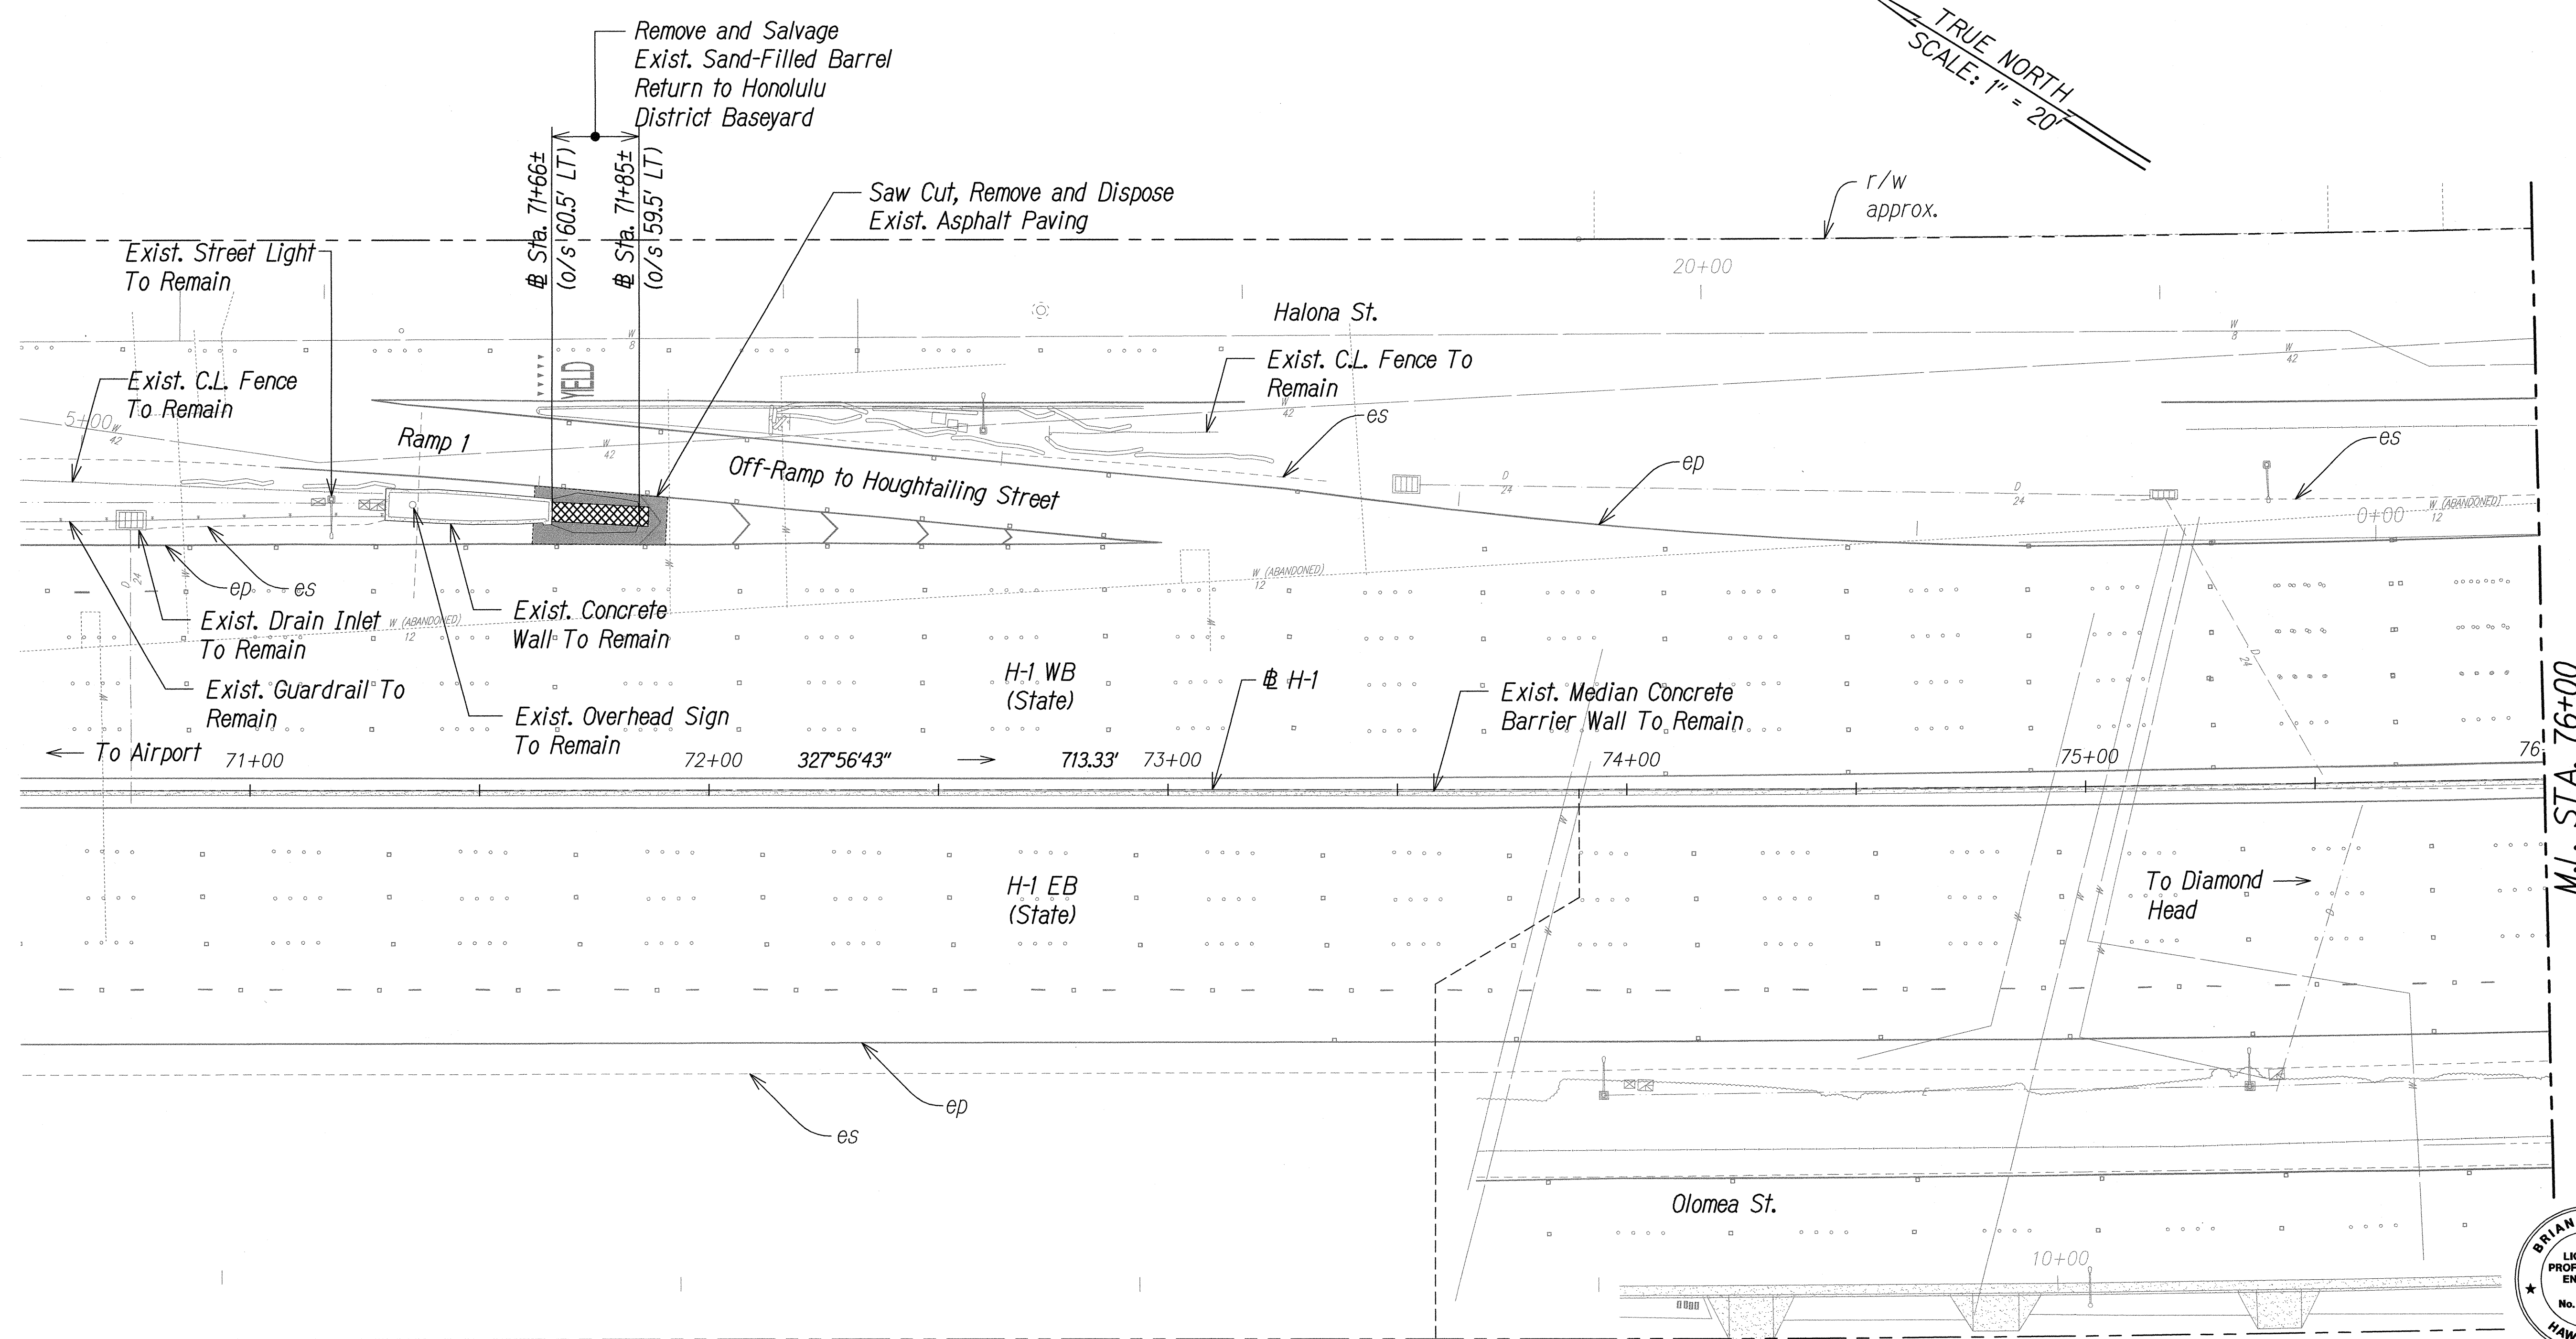


- Notes:**
1. The Contractor's Attention is Directed to Section 209-Water Pollution Erosion During Construction Operations.
 2. All Disturbed Landscaped Area shall be Restored to Exist. Condition or Better.
 3. Street Light Standards, Pullboxes and Conduit shall Remain Unless Otherwise Noted.

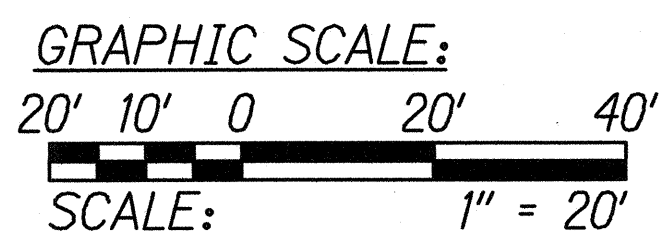

STA. 70+50 TO 76+00 (# H-1)

Legend:

- Remove Structure
- Saw Cut, Remove and Dispose Exist. Asphalt Pavement Structure Including Base and Subbase
- Remove Object

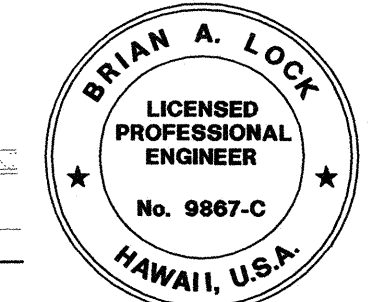

THIS WORK WAS PREPARED BY ME OR UNDER MY SUPERVISION.

ma

WILSON OKAMOTO CORPORATION LIC. EXP. DATE

STATE OF HAWAII
DEPARTMENT OF TRANSPORTATION
HIGHWAYS DIVISION

**HOUGHTAILING SEPARATION
DEMOLITION PLAN**


INTERSTATE ROUTE H-1
GUARDRAIL AND SHOULDER IMPROVEMENTS
Middle Street to Punchbowl Off-Ramp
Fed. Aid Project No. 1M-H1-1(242)

Scale: 1" = 20' Date: Mar. 2016

SHEET No. DP-5 OF 16 SHEETS

FED. ROAD DIST. NO.	STATE	FED. AID PROJ. NO.	FISCAL YEAR	SHEET NO.	TOTAL SHEETS
HAWAII	HAW.	1M-HI-1(242)	2016	33	354


Legend:

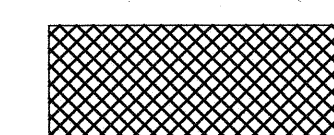

Remove Structure




Saw Cut, Remove and Dispose Exist. Asphalt Pavement Structure Including Base and Subbase

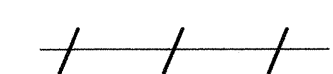

Remove Object




Cold Plane Exist. A.C. 2" Pavement

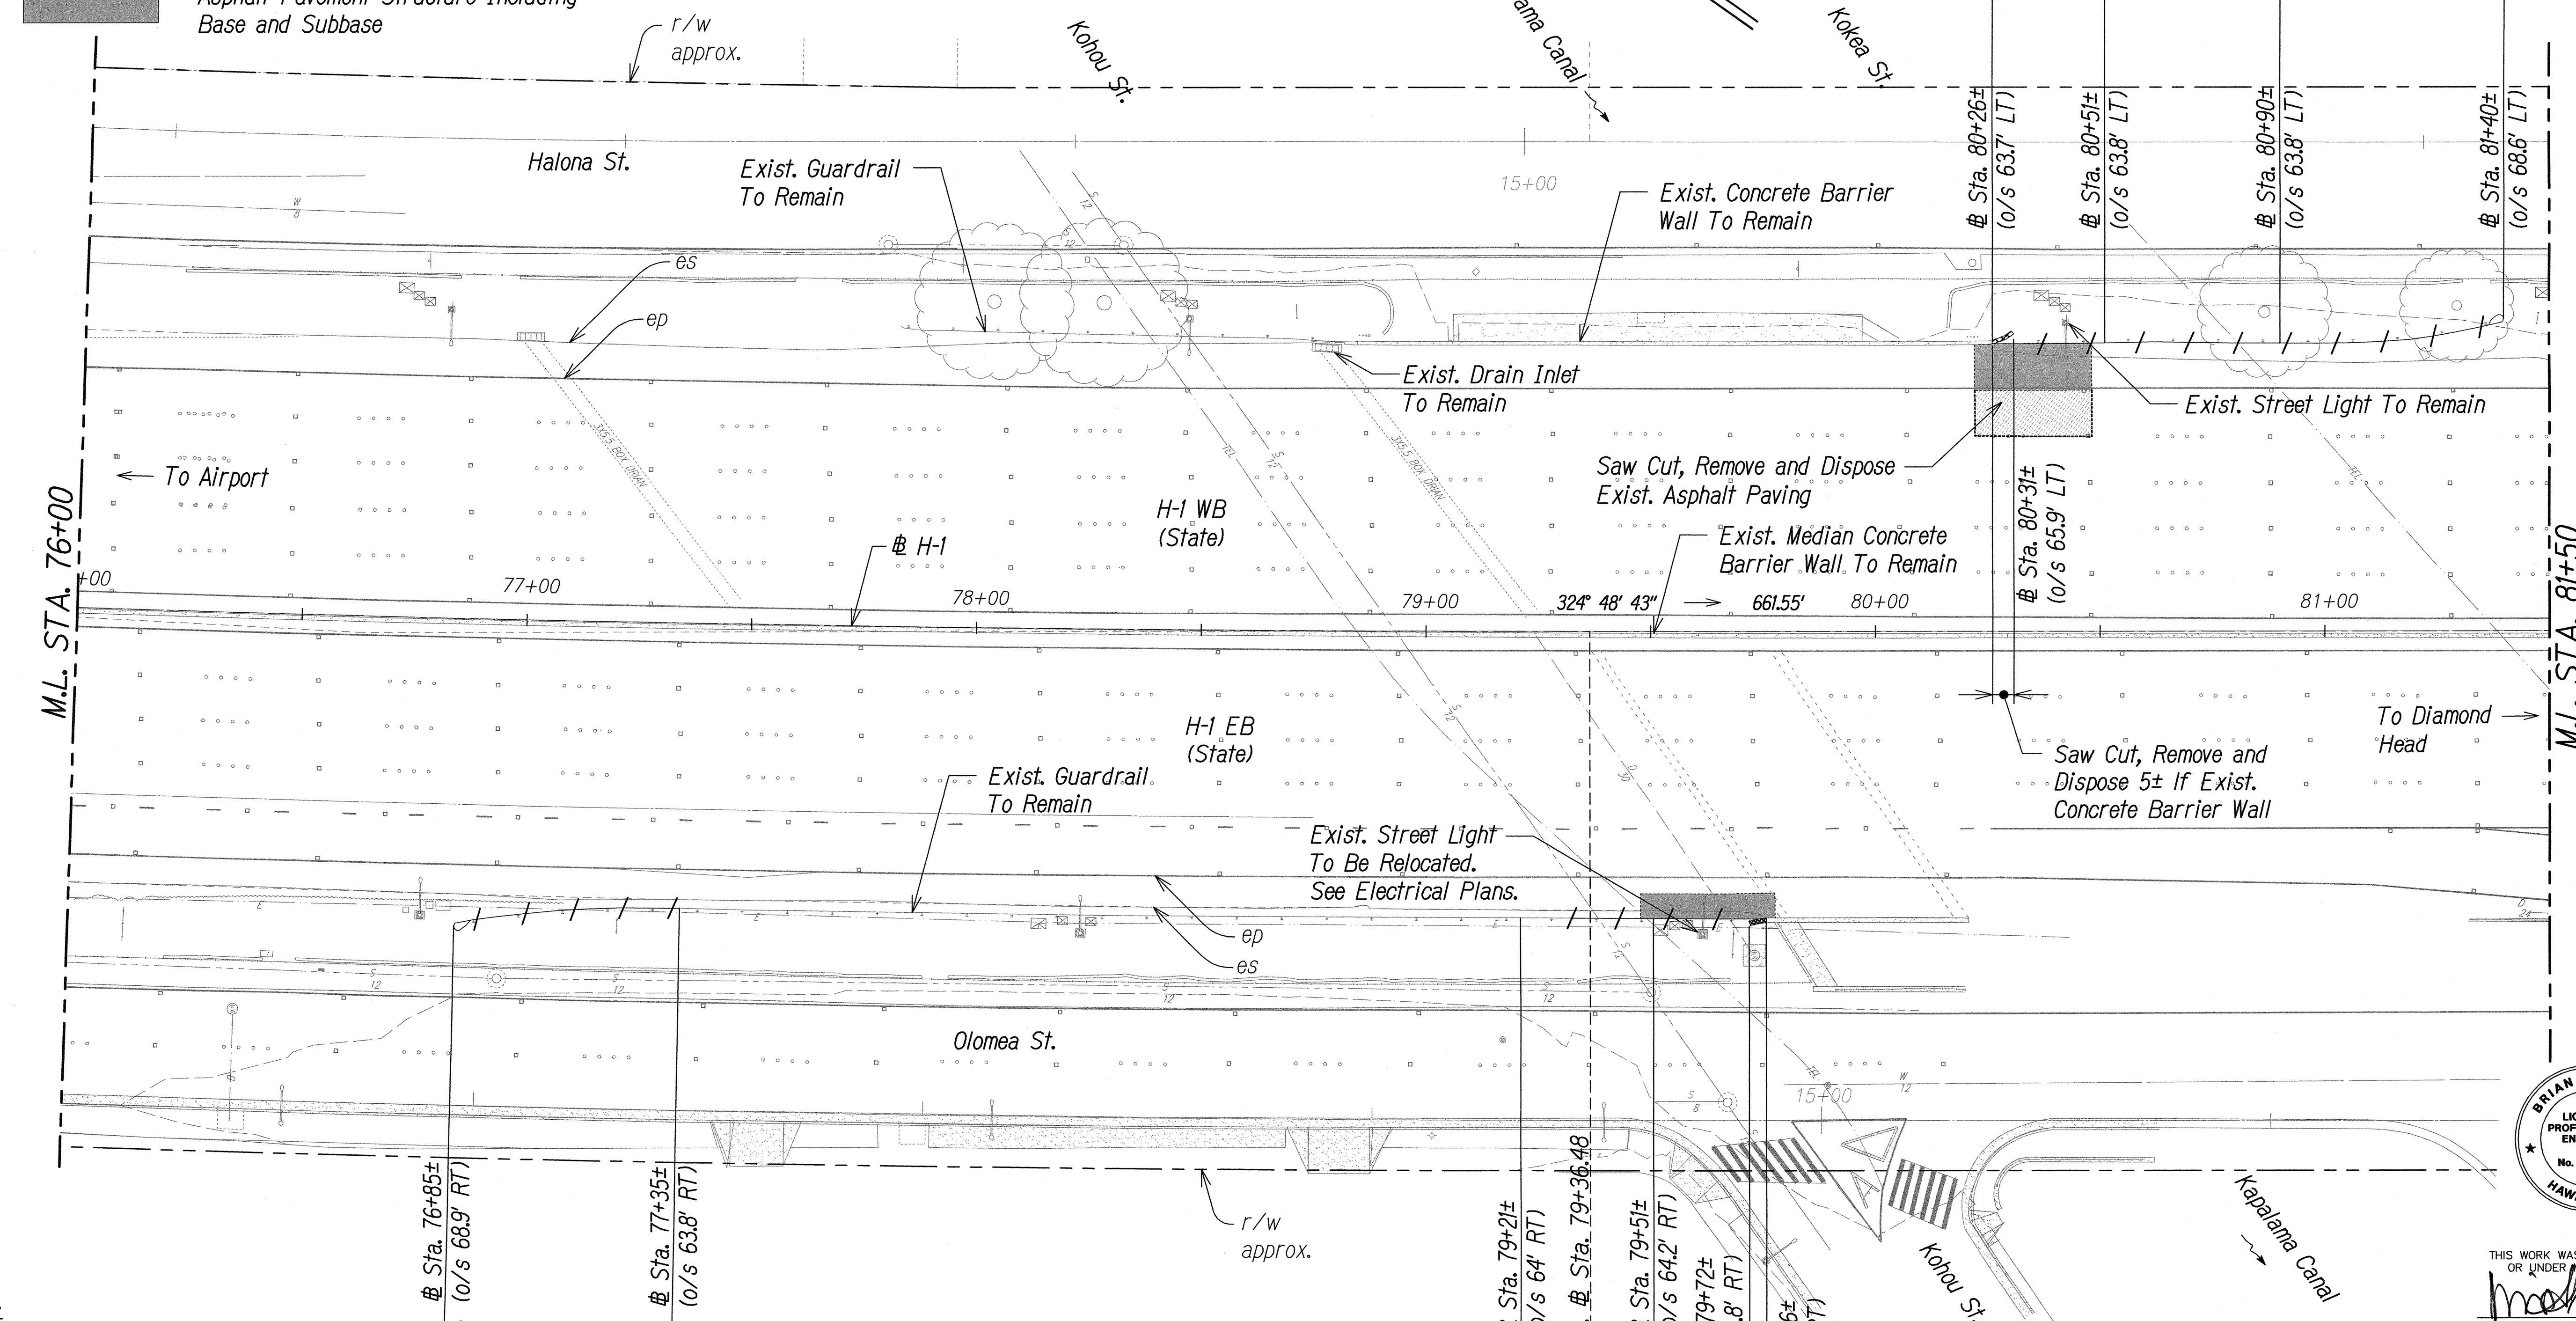


Notes:


1. The Contractor's Attention is Directed to Section 209-Water Pollution Erosion During Construction Operations.
2. All Disturbed Landscaped Area shall be Restored to Exist. Condition or Better.
3. Street Light Standards, Pullboxes and Conduit shall Remain Unless Otherwise Noted.

GRAPHIC SCALE:

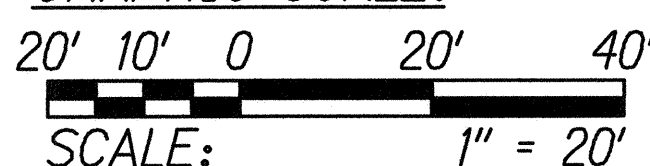

STA. 76+00 TO 81+50 (# H-1)

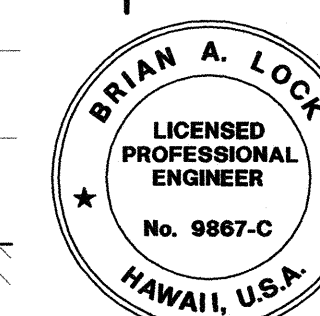

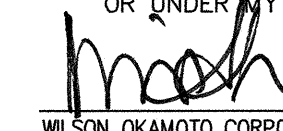THIS WORK WAS PREPARED BY ME OR UNDER MY SUPERVISION.

 APRIL 30, 2018
 WILSON OKAMOTO CORPORATION LIC. EXP. DATE

STATE OF HAWAII
DEPARTMENT OF TRANSPORTATION
HIGHWAYS DIVISION

KAPALAMA CANAL
DEMOLITION PLAN
INTERSTATE ROUTE H-1
GUARDRAIL AND SHOULDER IMPROVEMENTS
Middle Street to Punchbowl Off-Ramp
Fed. Aid Project No. 1M-HI-1(242)
Scale: 1" = 20' Date: Mar. 2016


SHEET No. DP-6 OF 16 SHEETS

SURVEY PLOTTED BY	DATE
DRAWN BY	
DESIGNED BY	
NOTED BY	
CHECKED BY	
ORIGINAL PLAN	No.
NOTE BOOK	

FED. ROAD DIST. NO.	STATE	FED. AID PROJ. NO.	FISCAL YEAR	SHEET NO.	TOTAL SHEETS
HAWAII	HAW.	1M-H1-1(242)	2016	34	354


Legend:

- Remove Structure
- Saw Cut, Remove and Dispose
Exist. Asphalt Pavement Structure
Including Base and Subbase
- Remove Object

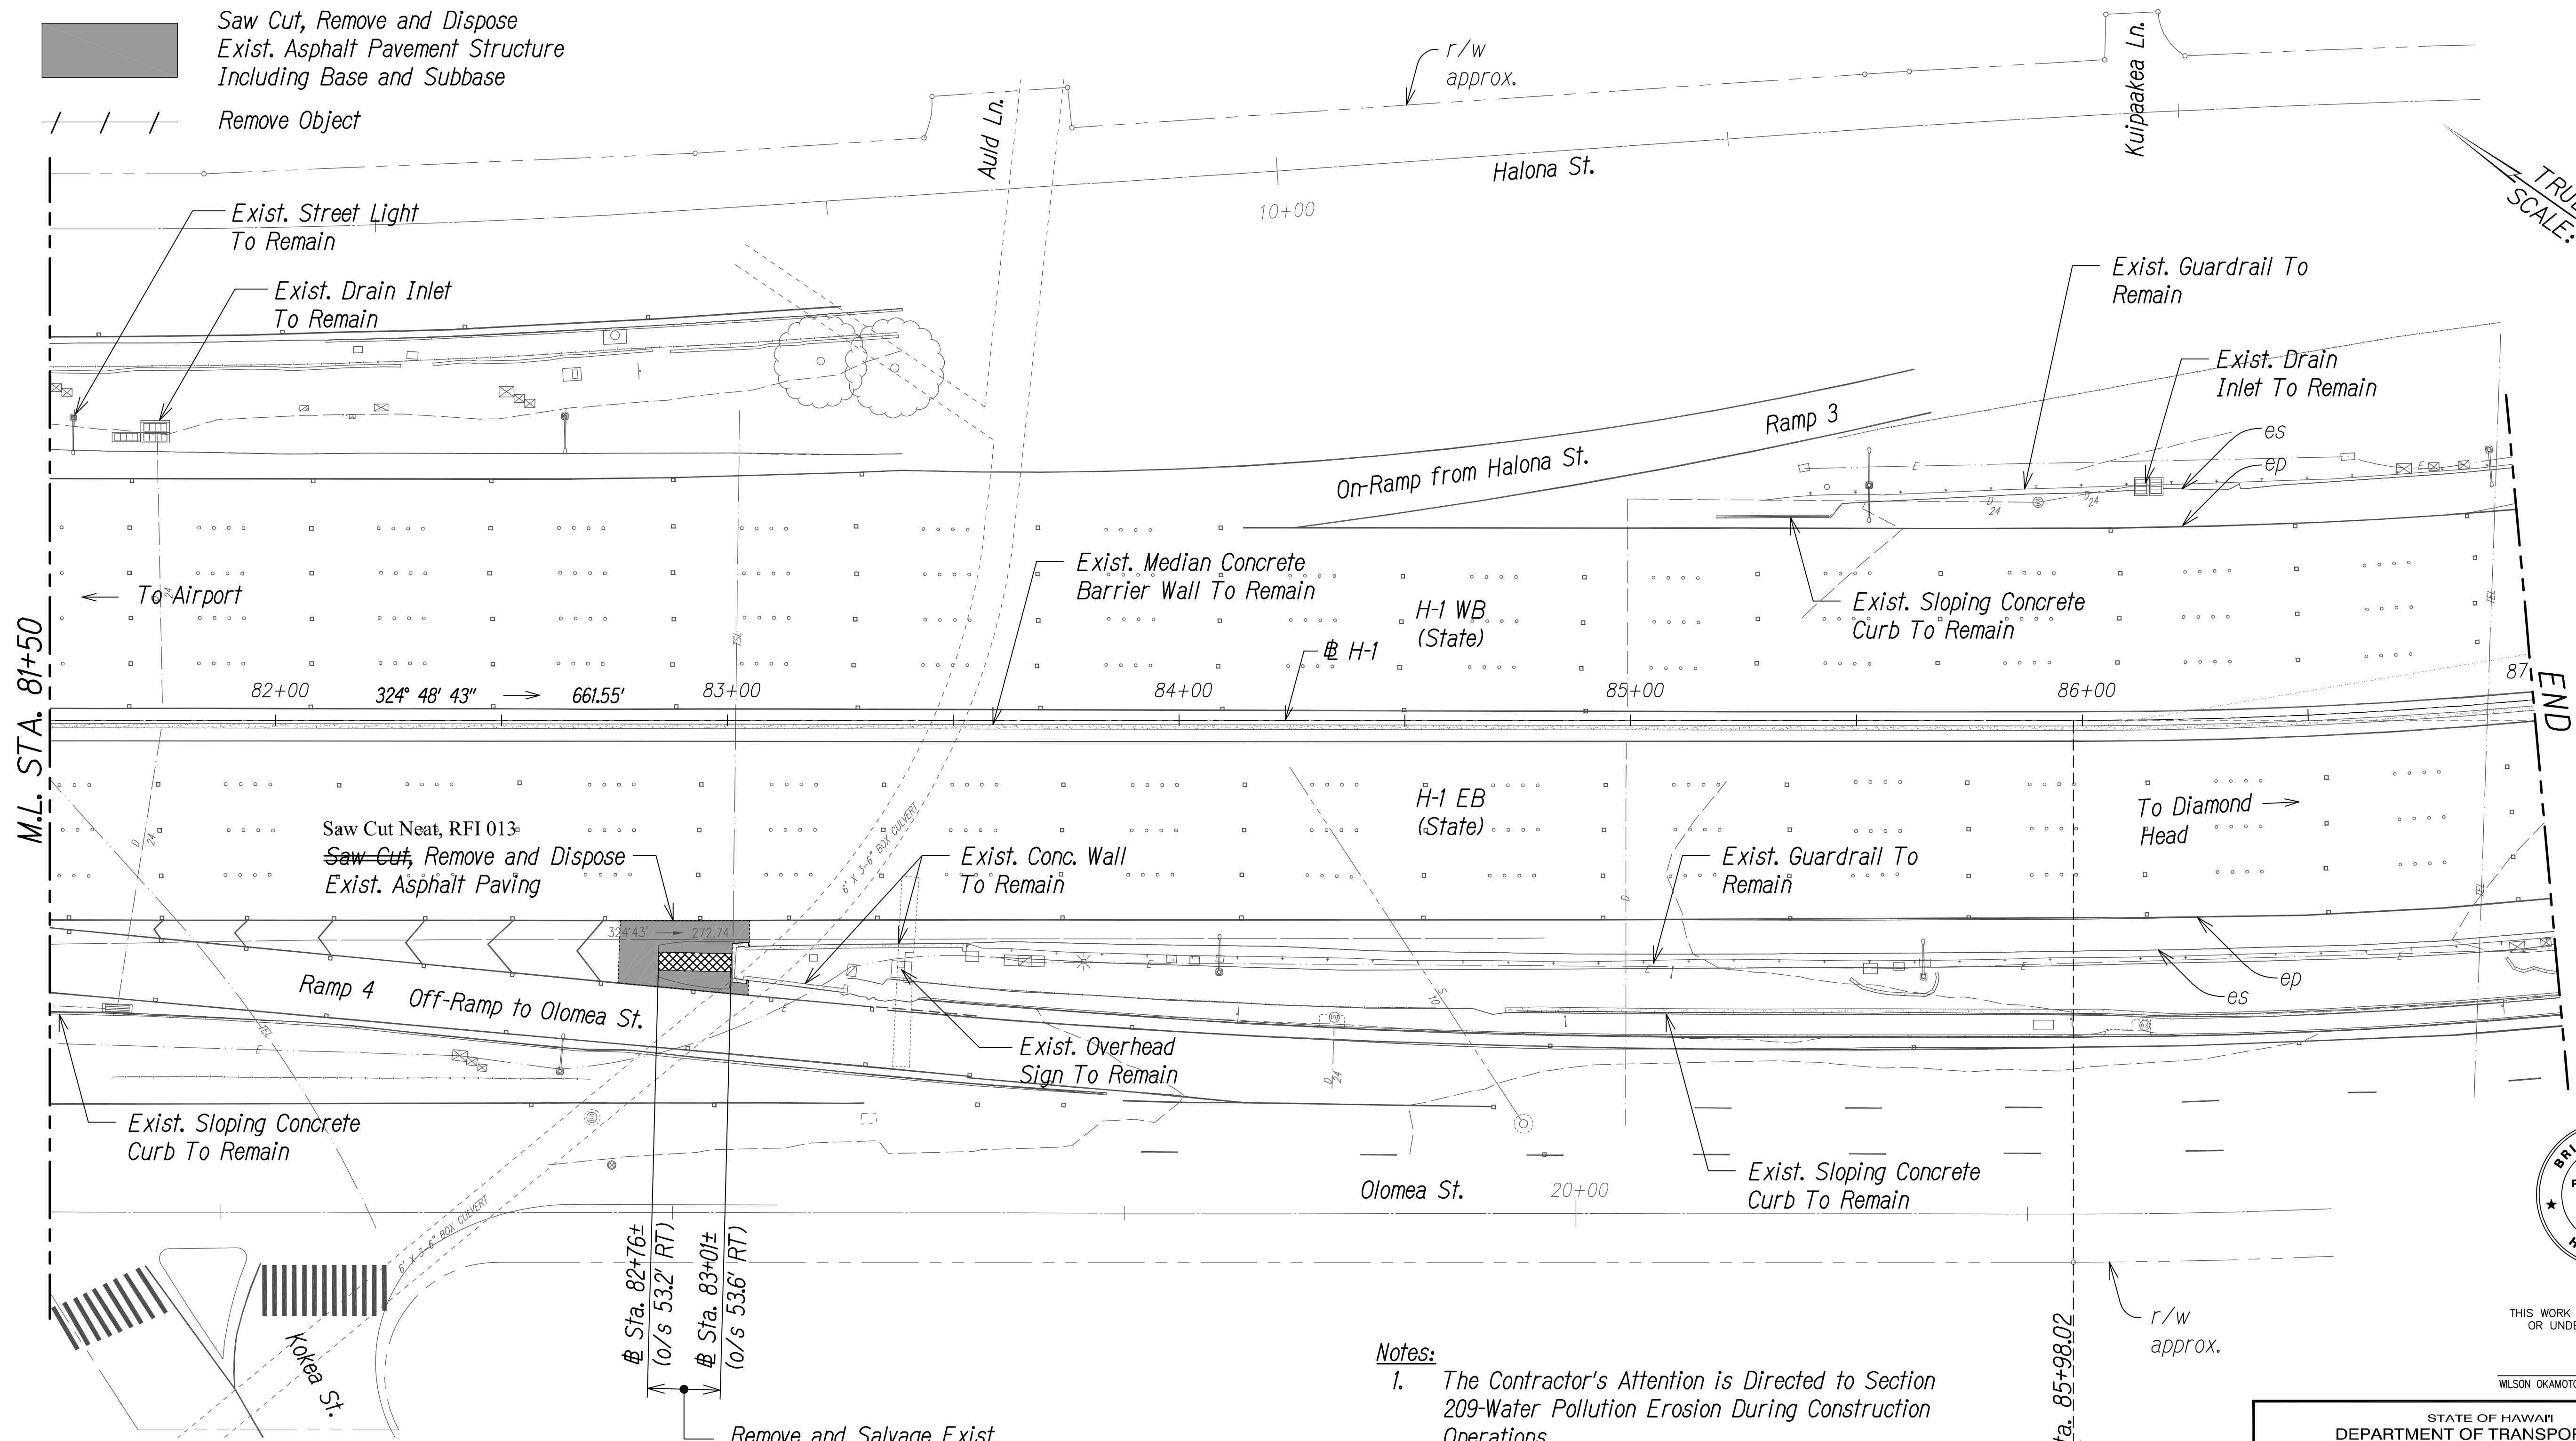

SURVEY PLOTTED BY	DATE
DESIGNED BY	
NOTED BY	
QUANTITIES BY	
CHECKED BY	

ORIGINAL PLAN	No.
NOTE BOOK	

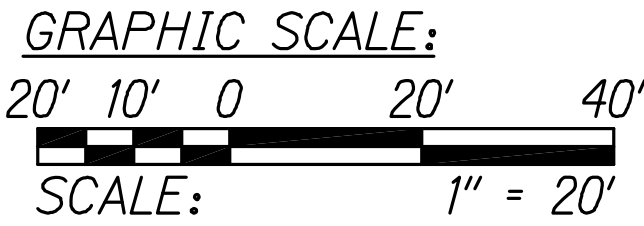


LEGEND FOR AS-BUILT POSTINGS	
	Squiggly line for as-built deletion
	Double line for as-built deletion
	Text for as-built posting

Remove and Salvage Exist.
Sand Barrels Return to
Honolulu District
Baseyard

STA. 81+50 TO 87+00 (# H-1)

- Notes:
- The Contractor's Attention is Directed to Section 209-Water Pollution Erosion During Construction Operations.
 - All Disturbed Landscaped Area shall be Restored to Exist. Condition or Better.
 - Street Light Standards, Pullboxes and Conduit shall Remain Unless Otherwise Noted.

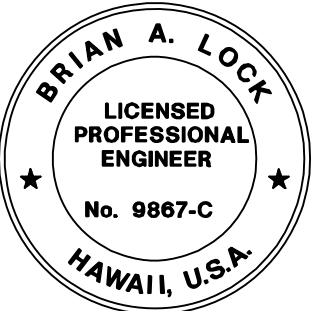


THIS WORK WAS PREPARED BY ME
OR UNDER MY SUPERVISION.

APRIL 30, 2020
WILSON OKAMOTO CORPORATION LIC. EXP. DATE

STATE OF HAWAII
DEPARTMENT OF TRANSPORTATION
HIGHWAYS DIVISION
**KAPALAMA CANAL
DEMOLITION PLAN**
INTERSTATE ROUTE H-1
GUARDRAIL AND SHOULDER IMPROVEMENTS
Middle Street to Punchbowl Off-Ramp
Fed. Aid Project No. 1M-H1-1(242)
Scale: 1" = 20' Date: Mar. 2016

SHEET No. DP-7 OF 16 SHEETS

FED. ROAD DIST. NO.	STATE	FED. AID PROJ. NO.	FISCAL YEAR	SHEET NO.	TOTAL SHEETS
HAWAII	HAW.	1M-H1-1(242)	2016	36	354

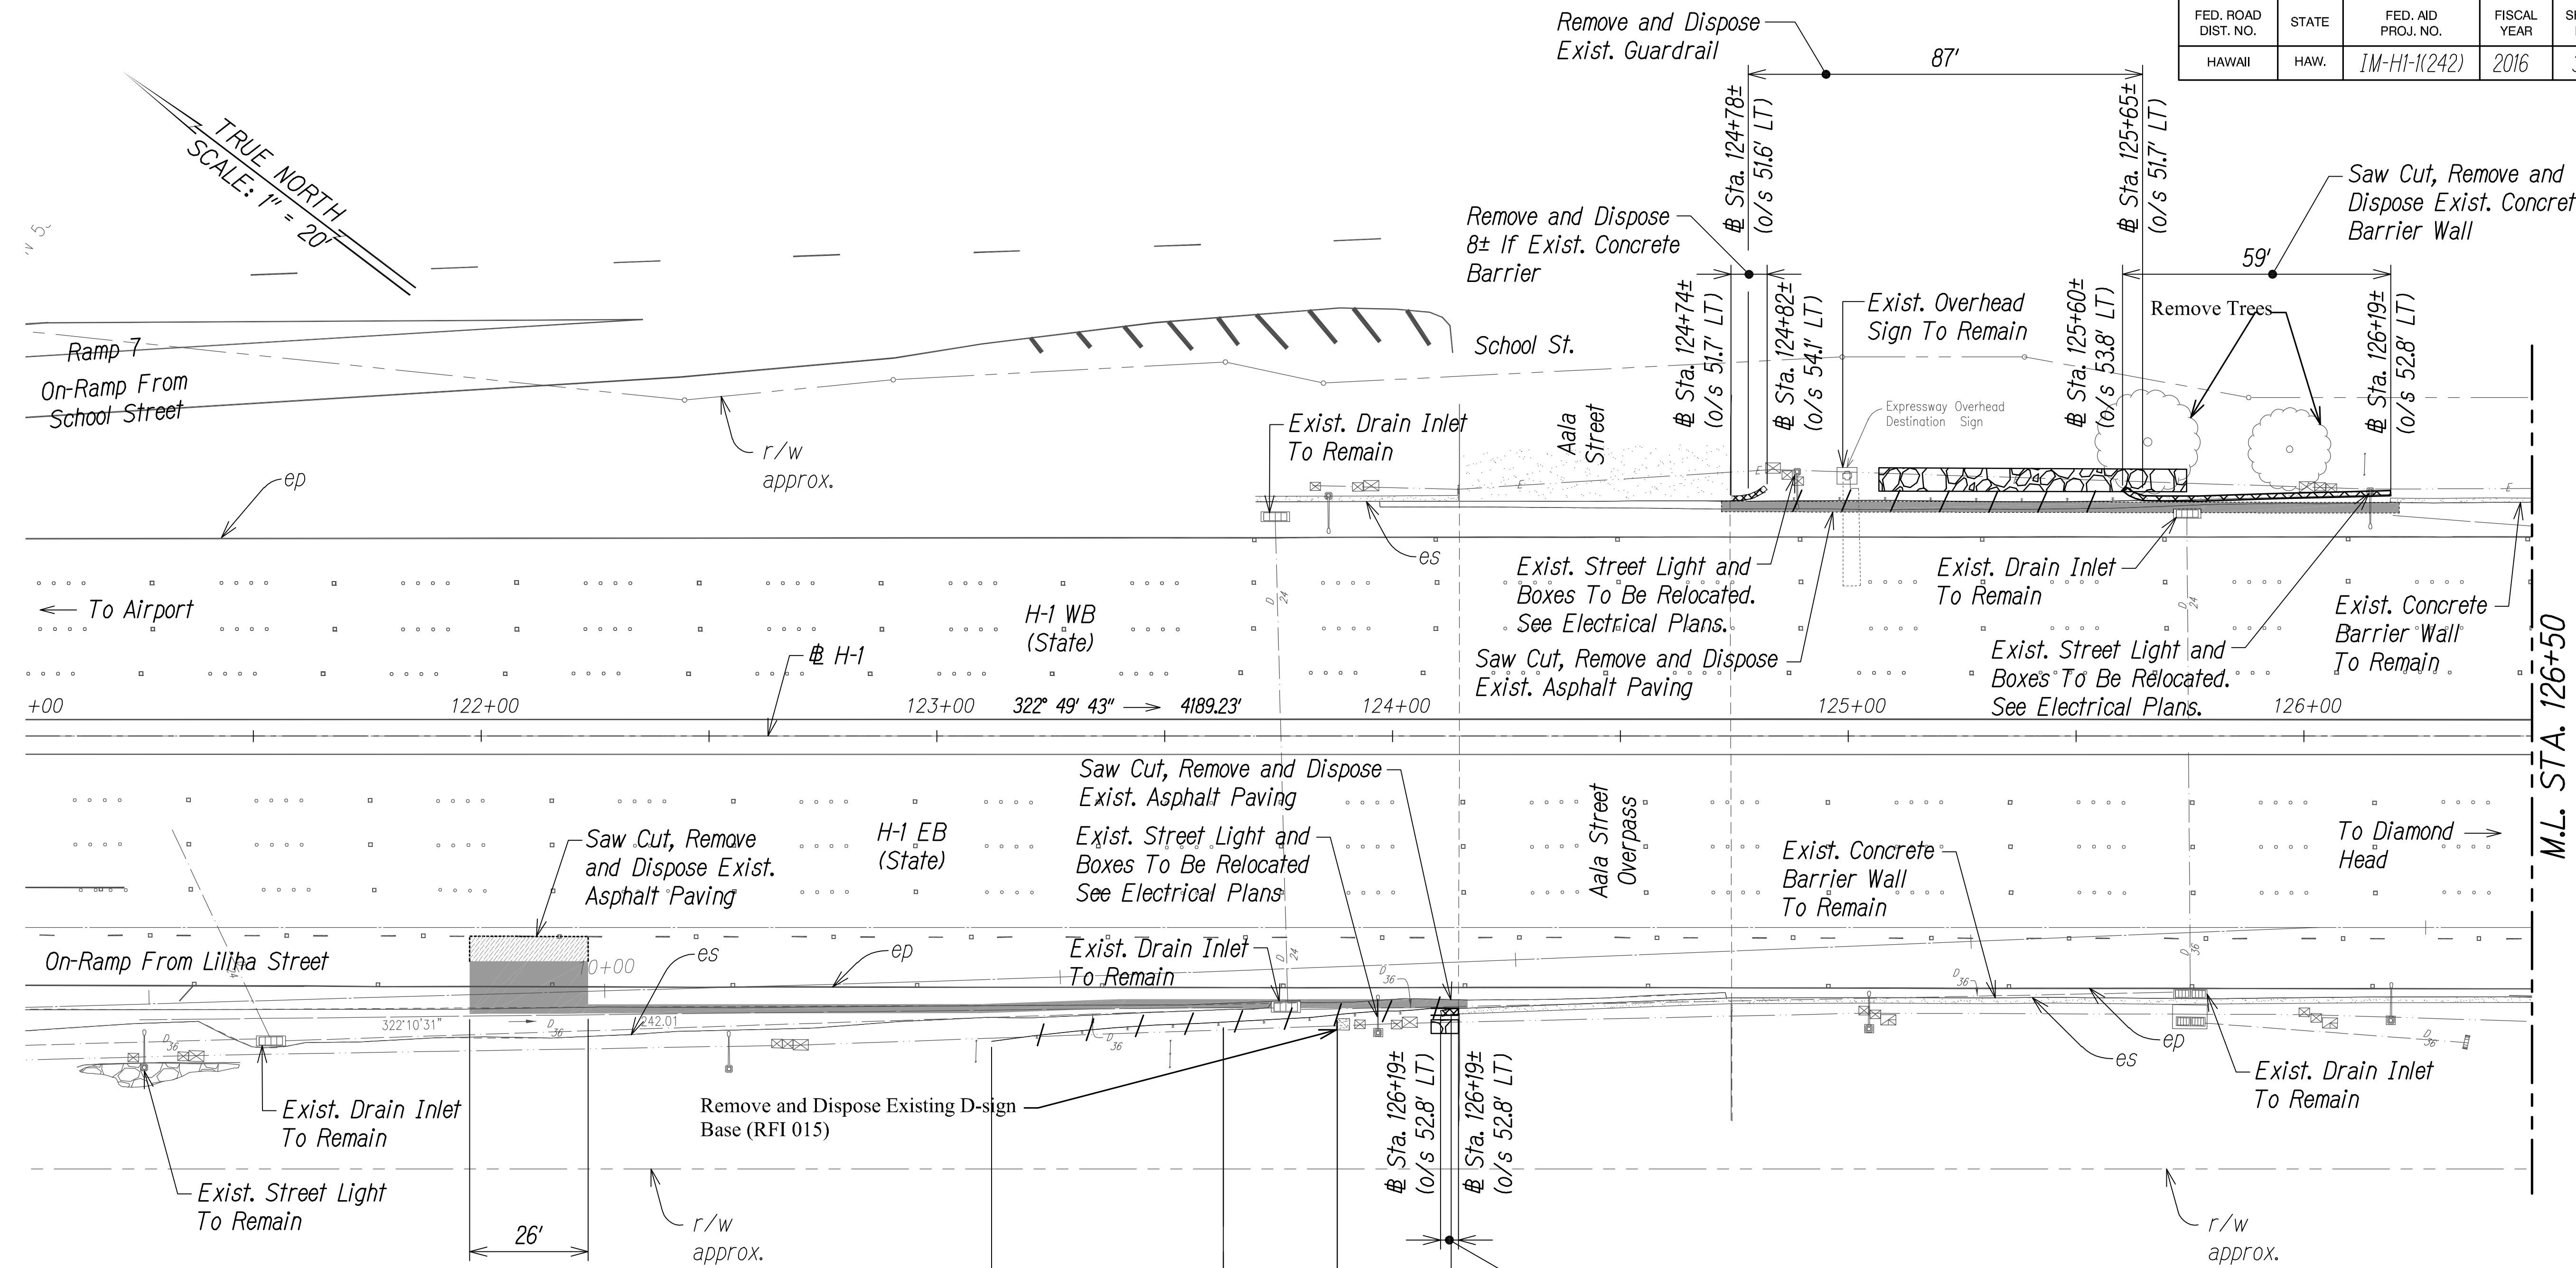


Legend:

- | | | | |
|--|--|--|------------------------------------|
| | Remove Structure | | Cold Plane Exist. A.C. 2" Pavement |
| | Saw Cut, Remove and Dispose Exist. Asphalt Pavement Structure Including Base and Subbase | | Remove Object |


Notes:

- The Contractor's Attention is Directed to Section 209-Water Pollution Erosion During Construction Operations.
- All Disturbed Landscaped Area shall be Restored to Exist. Condition or Better.
- Street Light Standards, Pullboxes and Conduit shall Remain Unless Otherwise Noted.

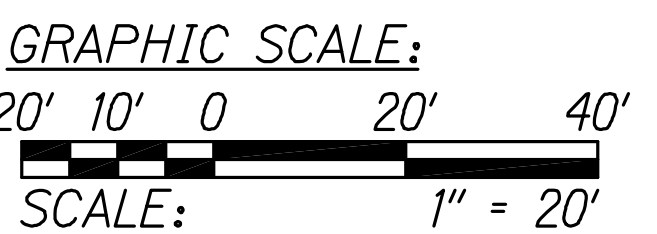

LEGEND FOR AS-BUILT POSTINGS

	Squiggly line for as-built deletion
	Double line for as-built deletion
Roadway	Text for as-built posting

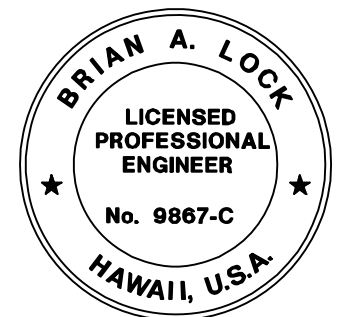

THIS WORK WAS PREPARED BY ME OR UNDER MY SUPERVISION.

APRIL 30, 2020
WILSON OKAMOTO CORPORATION LIC. EXP. DATE

STATE OF HAWAII
DEPARTMENT OF TRANSPORTATION
HIGHWAYS DIVISION

**AALA STREET & NUUANU STREAM
DEMOLITION PLAN**

INTERSTATE ROUTE H-1
GUARDRAIL AND SHOULDER IMPROVEMENTS
Middle Street to Punchbowl Off-Ramp
Fed. Aid Project No. 1M-H1-1(242)
Scale: 1" = 20' Date: Mar. 2016


SHEET No. DP-9 OF 16 SHEETS

STA. 121+00 TO 126+50 (# H-1)


FED. ROAD DIST. NO.	STATE	FED. AID PROJ. NO.	FISCAL YEAR	SHEET NO.	TOTAL SHEETS
HAWAII	HAW.	IM-H1-1(242)	2016	C.O. 35	354

Legend:

- Remove Structure
- Saw Cut, Remove and Dispose Exist. Asphalt Pavement Structure Including Base and Subbase
- Remove Object

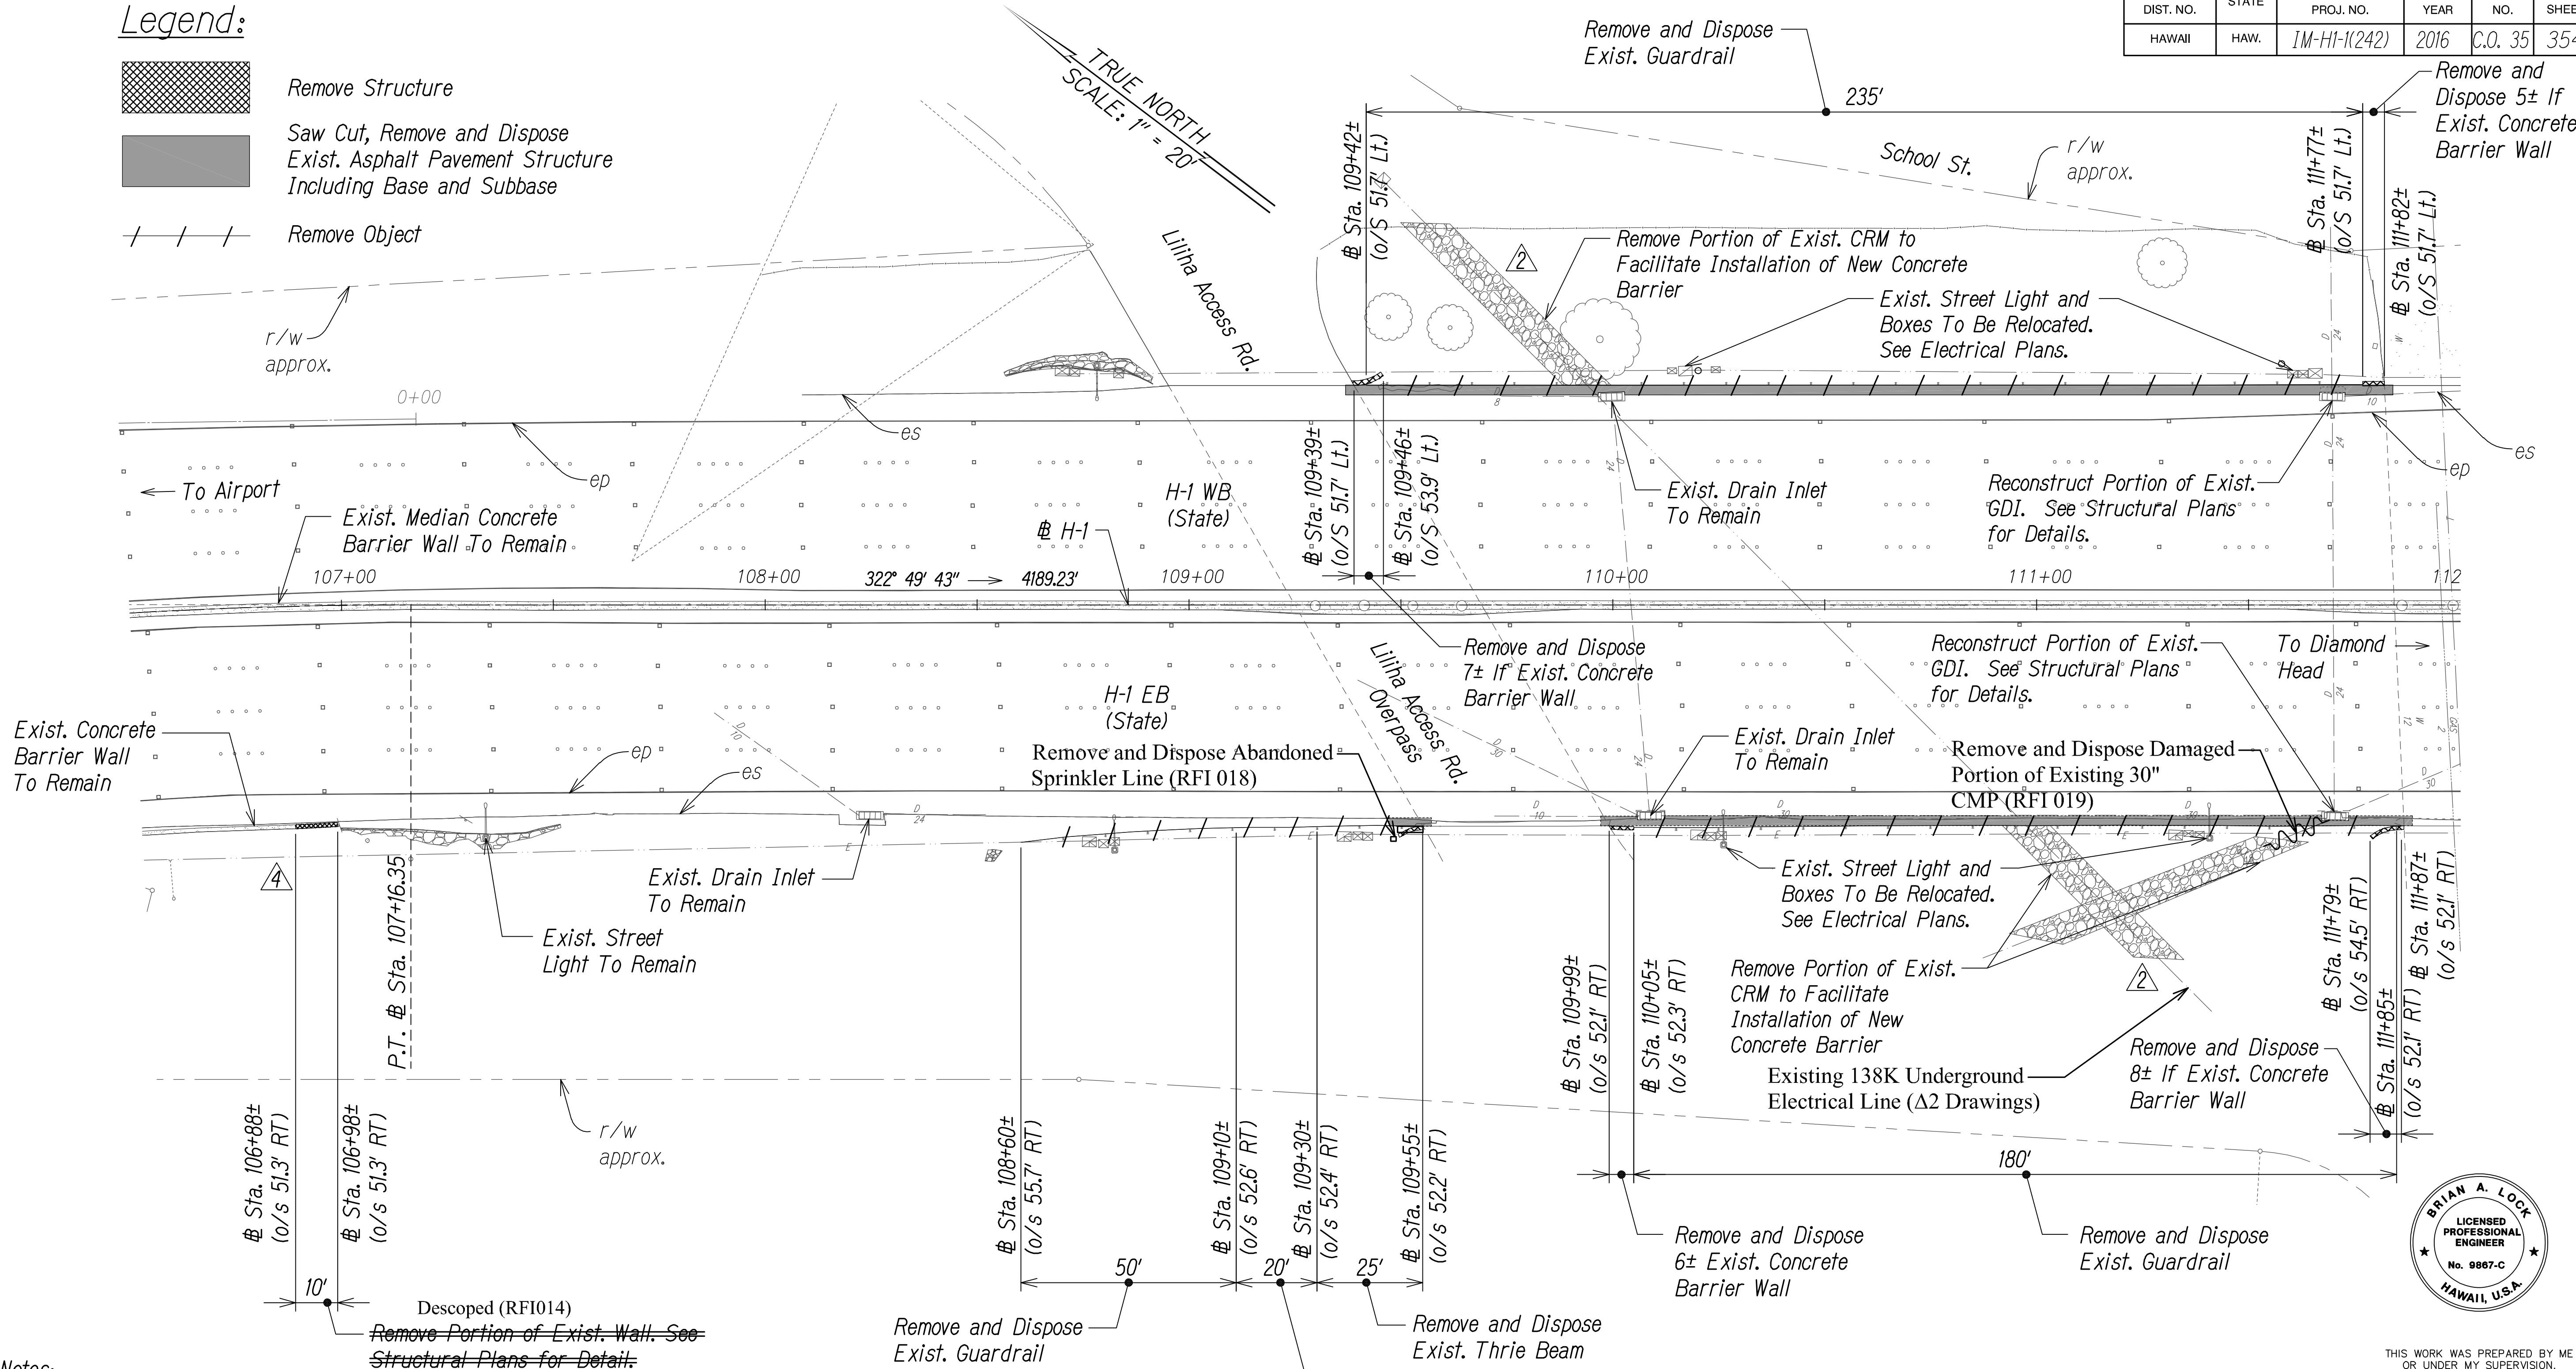

- Notes:
- The Contractor's Attention is Directed to Section 209-Water Pollution Erosion During Construction Operations.
 - All Disturbed Landscaped Area shall be Restored to Exist. Condition or Better.
 - Street Light Standards, Pullboxes and Conduit shall Remain Unless Otherwise Noted.

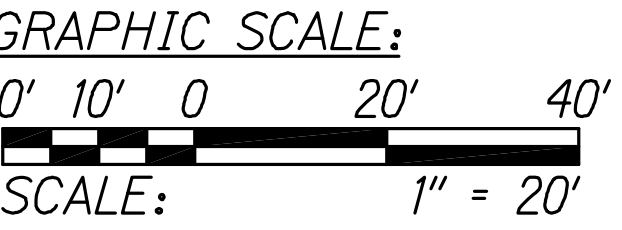


LEGEND FOR AS-BUILT POSTINGS	
	Squiggly line for as-built deletion
	Double line for as-built deletion
Roadway	Text for as-built posting

STA. 106+50 TO 112+00 (# H-1)

DATE	REVISION
r8/15/17	4 REVISED DEMO LIMITS
r12/15/16	2 REVISED EXIST. ELEC. LINE

STATE OF HAWAII
DEPARTMENT OF TRANSPORTATION
HIGHWAYS DIVISION
LILIHA STREET OVERPASS
DEMOLITION PLAN
INTERSTATE ROUTE H-1
GUARDRAIL AND SHOULDER IMPROVEMENTS
Middle Street to Punchbowl Off-Ramp
Fed. Aid Project No. IM-H1-1(242)
Scale: 1" = 20' Date: Mar. 2016
SHEET No. DP-8 OF 16 SHEETS



SURVEY PLOTTED BY	DATE
DESIGNED BY	
QUANTITIES BY	
CHECKED BY	
NOTE BOOK	
No.	

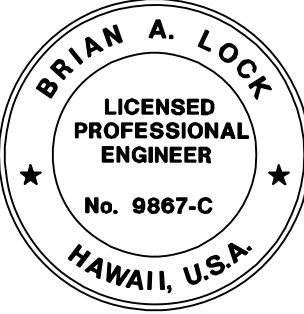


THIS WORK WAS PREPARED BY ME OR UNDER MY SUPERVISION.
APRIL 30, 2020
WILSON OKAMOTO CORPORATION LIC. EXP. DATE


FED. ROAD DIST. NO.	STATE	FED. AID PROJ. NO.	FISCAL YEAR	SHEET NO.	TOTAL SHEETS
HAWAII	HAW.	1M-H1-1(242)	2016	C.O. 36	354

Legend:

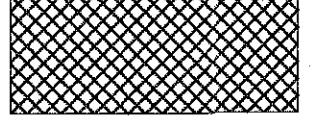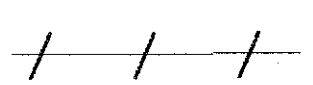
-  Remove Structure
-  Saw Cut, Remove and Dispose Exist. Asphalt Pavement Structure Including Base and Subbase
-  Remove Object

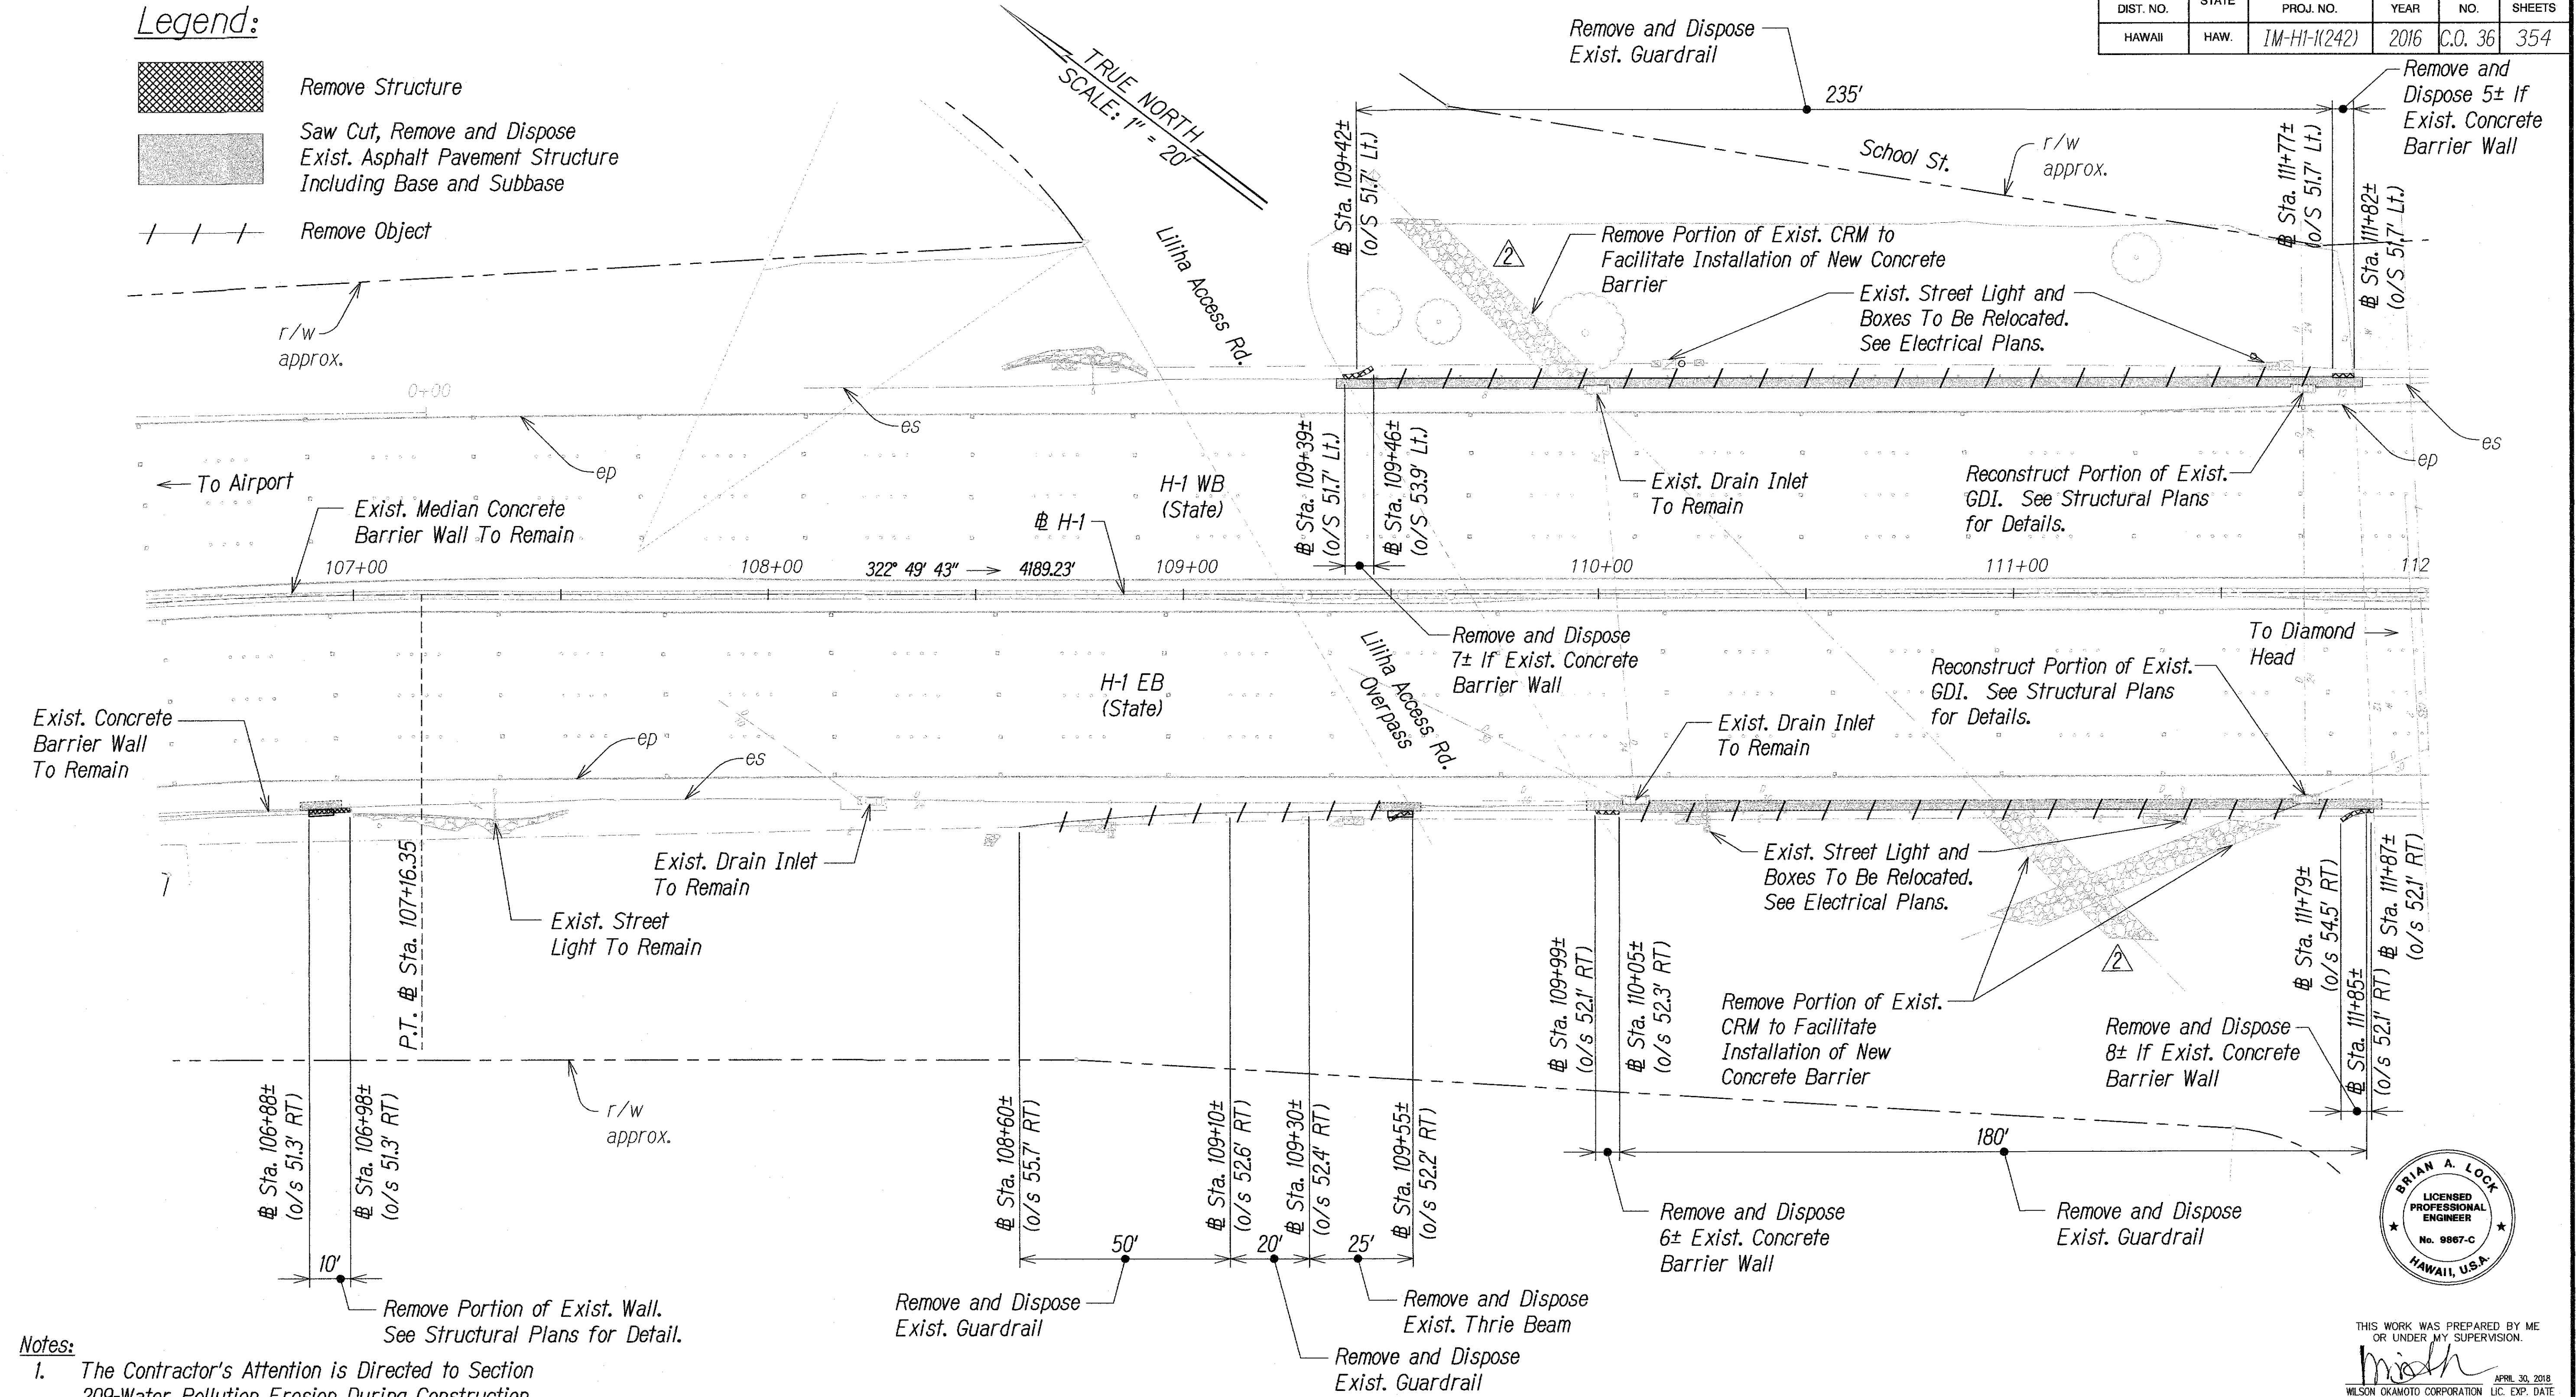

- Notes:**
- The Contractor's Attention is Directed to Section 209-Water Pollution Erosion During Construction Operations.
 - All Disturbed Landscaped Area shall be Restored to Exist. Condition or Better.
 - Street Light Standards, Pullboxes and Conduit shall Remain Unless Otherwise Noted.

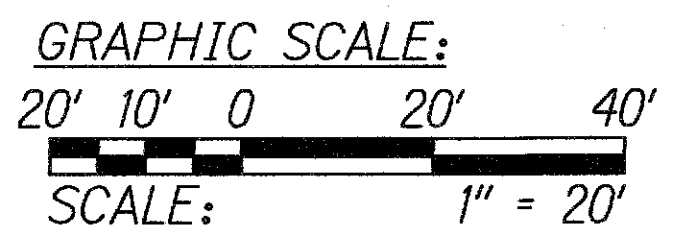

STA. 106+50 TO 112+00 (# H-1)

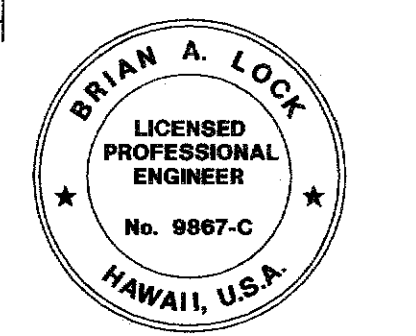


THIS WORK WAS PREPARED BY ME OR UNDER MY SUPERVISION.
miha
 WILSON OKAMOTO CORPORATION LIC. EXP. DATE: APRIL 30, 2018


STATE OF HAWAII
 DEPARTMENT OF TRANSPORTATION
 HIGHWAYS DIVISION
LILIHA STREET OVERPASS
DEMOLITION PLAN
 INTERSTATE ROUTE H-1
 GUARDRAIL AND SHOULDER IMPROVEMENTS
 Middle Street to Punchbowl Off-Ramp
 Fed. Aid Project No. 1M-H1-1(242)
 Scale: 1" = 20' Date: Mar. 2016
 SHEET No. DP-8 OF 16 SHEETS

r12/15/16	2	REVISED EXIST. ELEC. LINE
DATE		REVISION


FED. ROAD DIST. NO.	STATE	FED. AID PROJ. NO.	FISCAL YEAR	SHEET NO.	TOTAL SHEETS
HAWAII	HAW.	IM-H1-1(242)	2016	38	354

Legend:

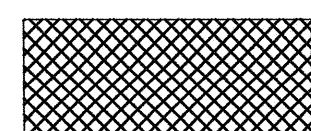-  Remove Structure
-  Saw Cut, Remove and Dispose Exist. Asphalt Pavement Structure Including Base and Subbase

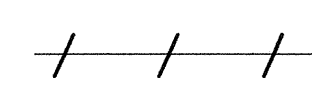 Remove Object


TRUE NORTH
SCALE: 1" = 20'

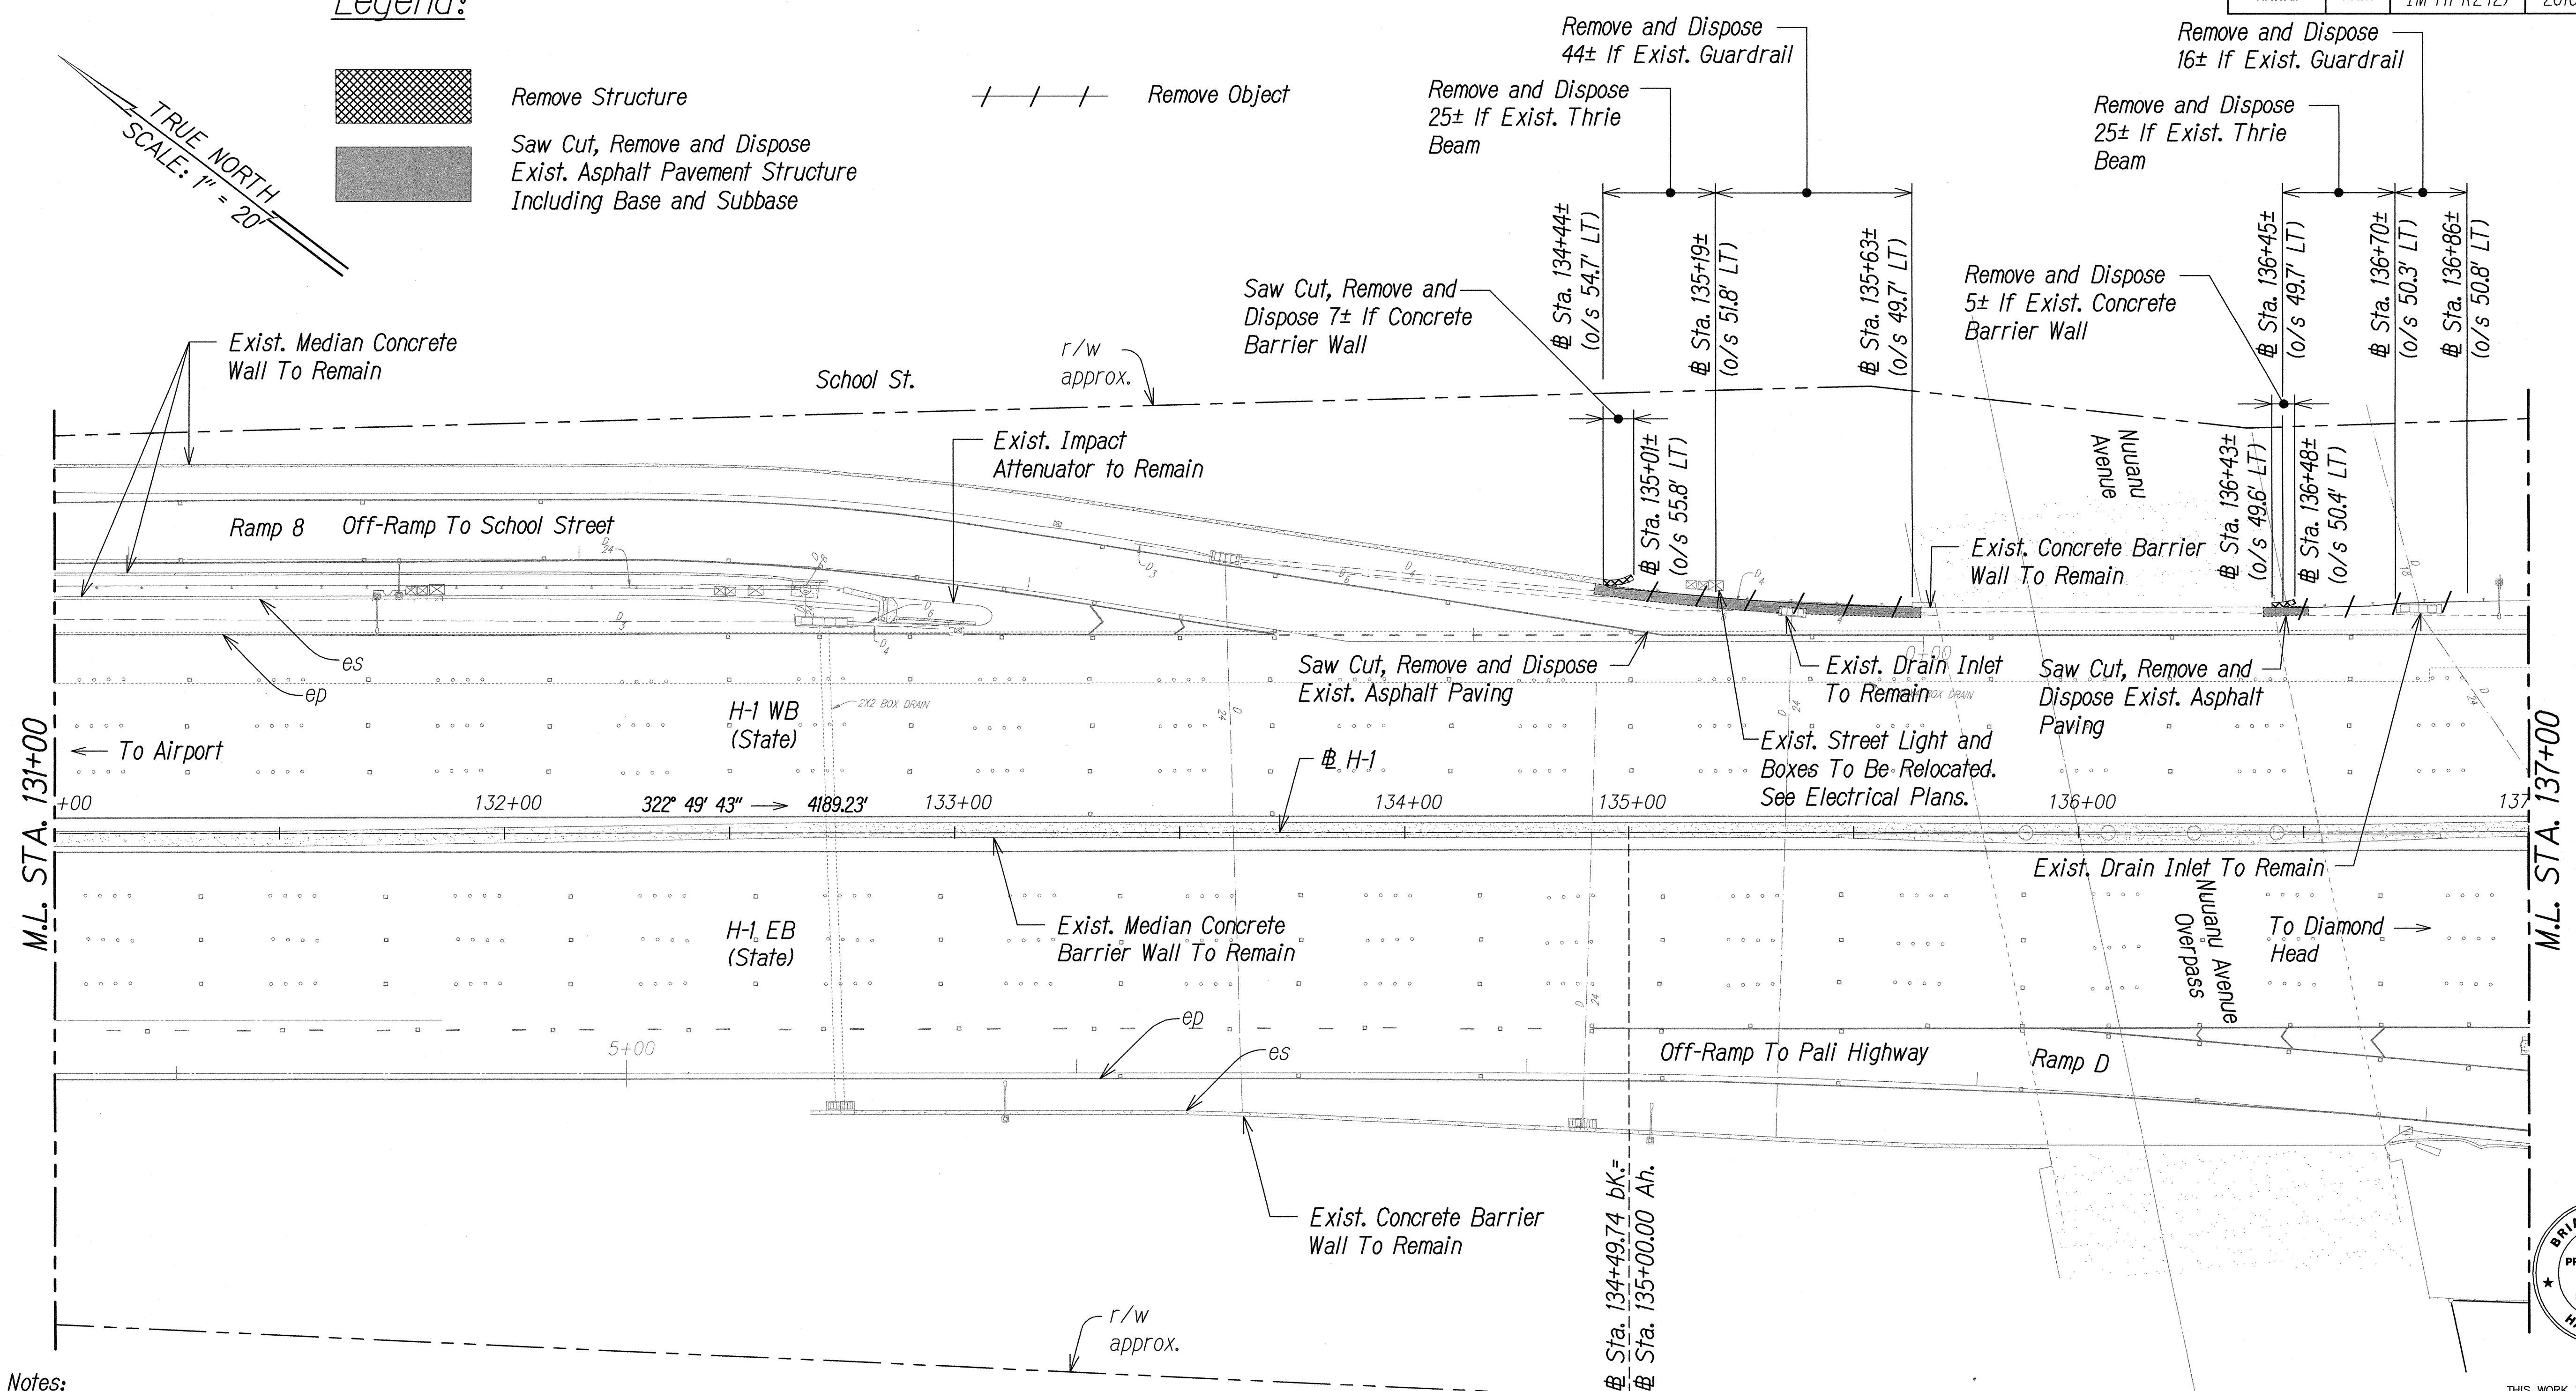


Notes:

- The Contractor's Attention is Directed to Section 209-Water Pollution Erosion During Construction Operations.
- All Disturbed Landscaped Area shall be Restored to Exist. Condition or Better.
- Street Light Standards, Pullboxes and Conduit shall Remain Unless Otherwise Noted.

STA. 131+00 TO 137+00 (# H-1)

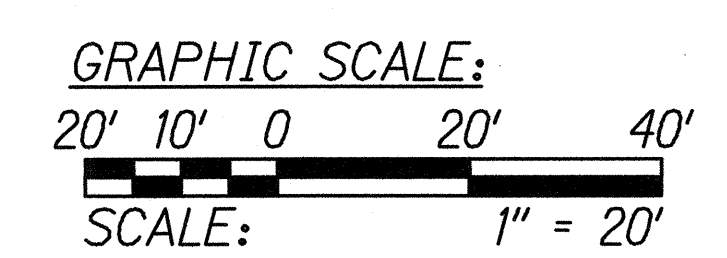

SURVEY PLOTTED BY	DATE
DRAWN BY	
DESIGNED BY	
QUANTITIES BY	
CHECKED BY	
ORIGINAL PLAN	
NOTE BOOK	
No.	

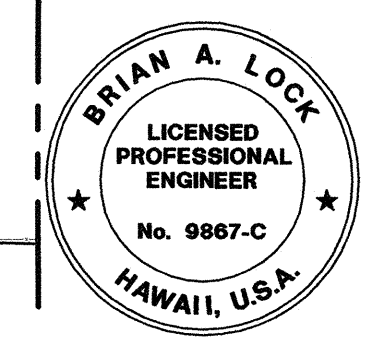

THIS WORK WAS PREPARED BY ME OR UNDER MY SUPERVISION.
mis
WILSON OKAMOTO CORPORATION LIC. EXP. DATE


STATE OF HAWAII
DEPARTMENT OF TRANSPORTATION
HIGHWAYS DIVISION

NUUANU AVENUE
DEMOLITION PLAN


INTERSTATE ROUTE H-1
GUARDRAIL AND SHOULDER IMPROVEMENTS
Middle Street to Punchbowl Off-Ramp
Fed. Aid Project No. IM-H1-1(242)
Scale: 1" = 20' Date: Mar. 2016

SHEET No. DP-11 OF 16 SHEETS

FED. ROAD DIST. NO.	STATE	FED. AID PROJ. NO.	FISCAL YEAR	SHEET NO.	TOTAL SHEETS
HAWAII	HAW.	IM-H1-1(242)	2016	39	354

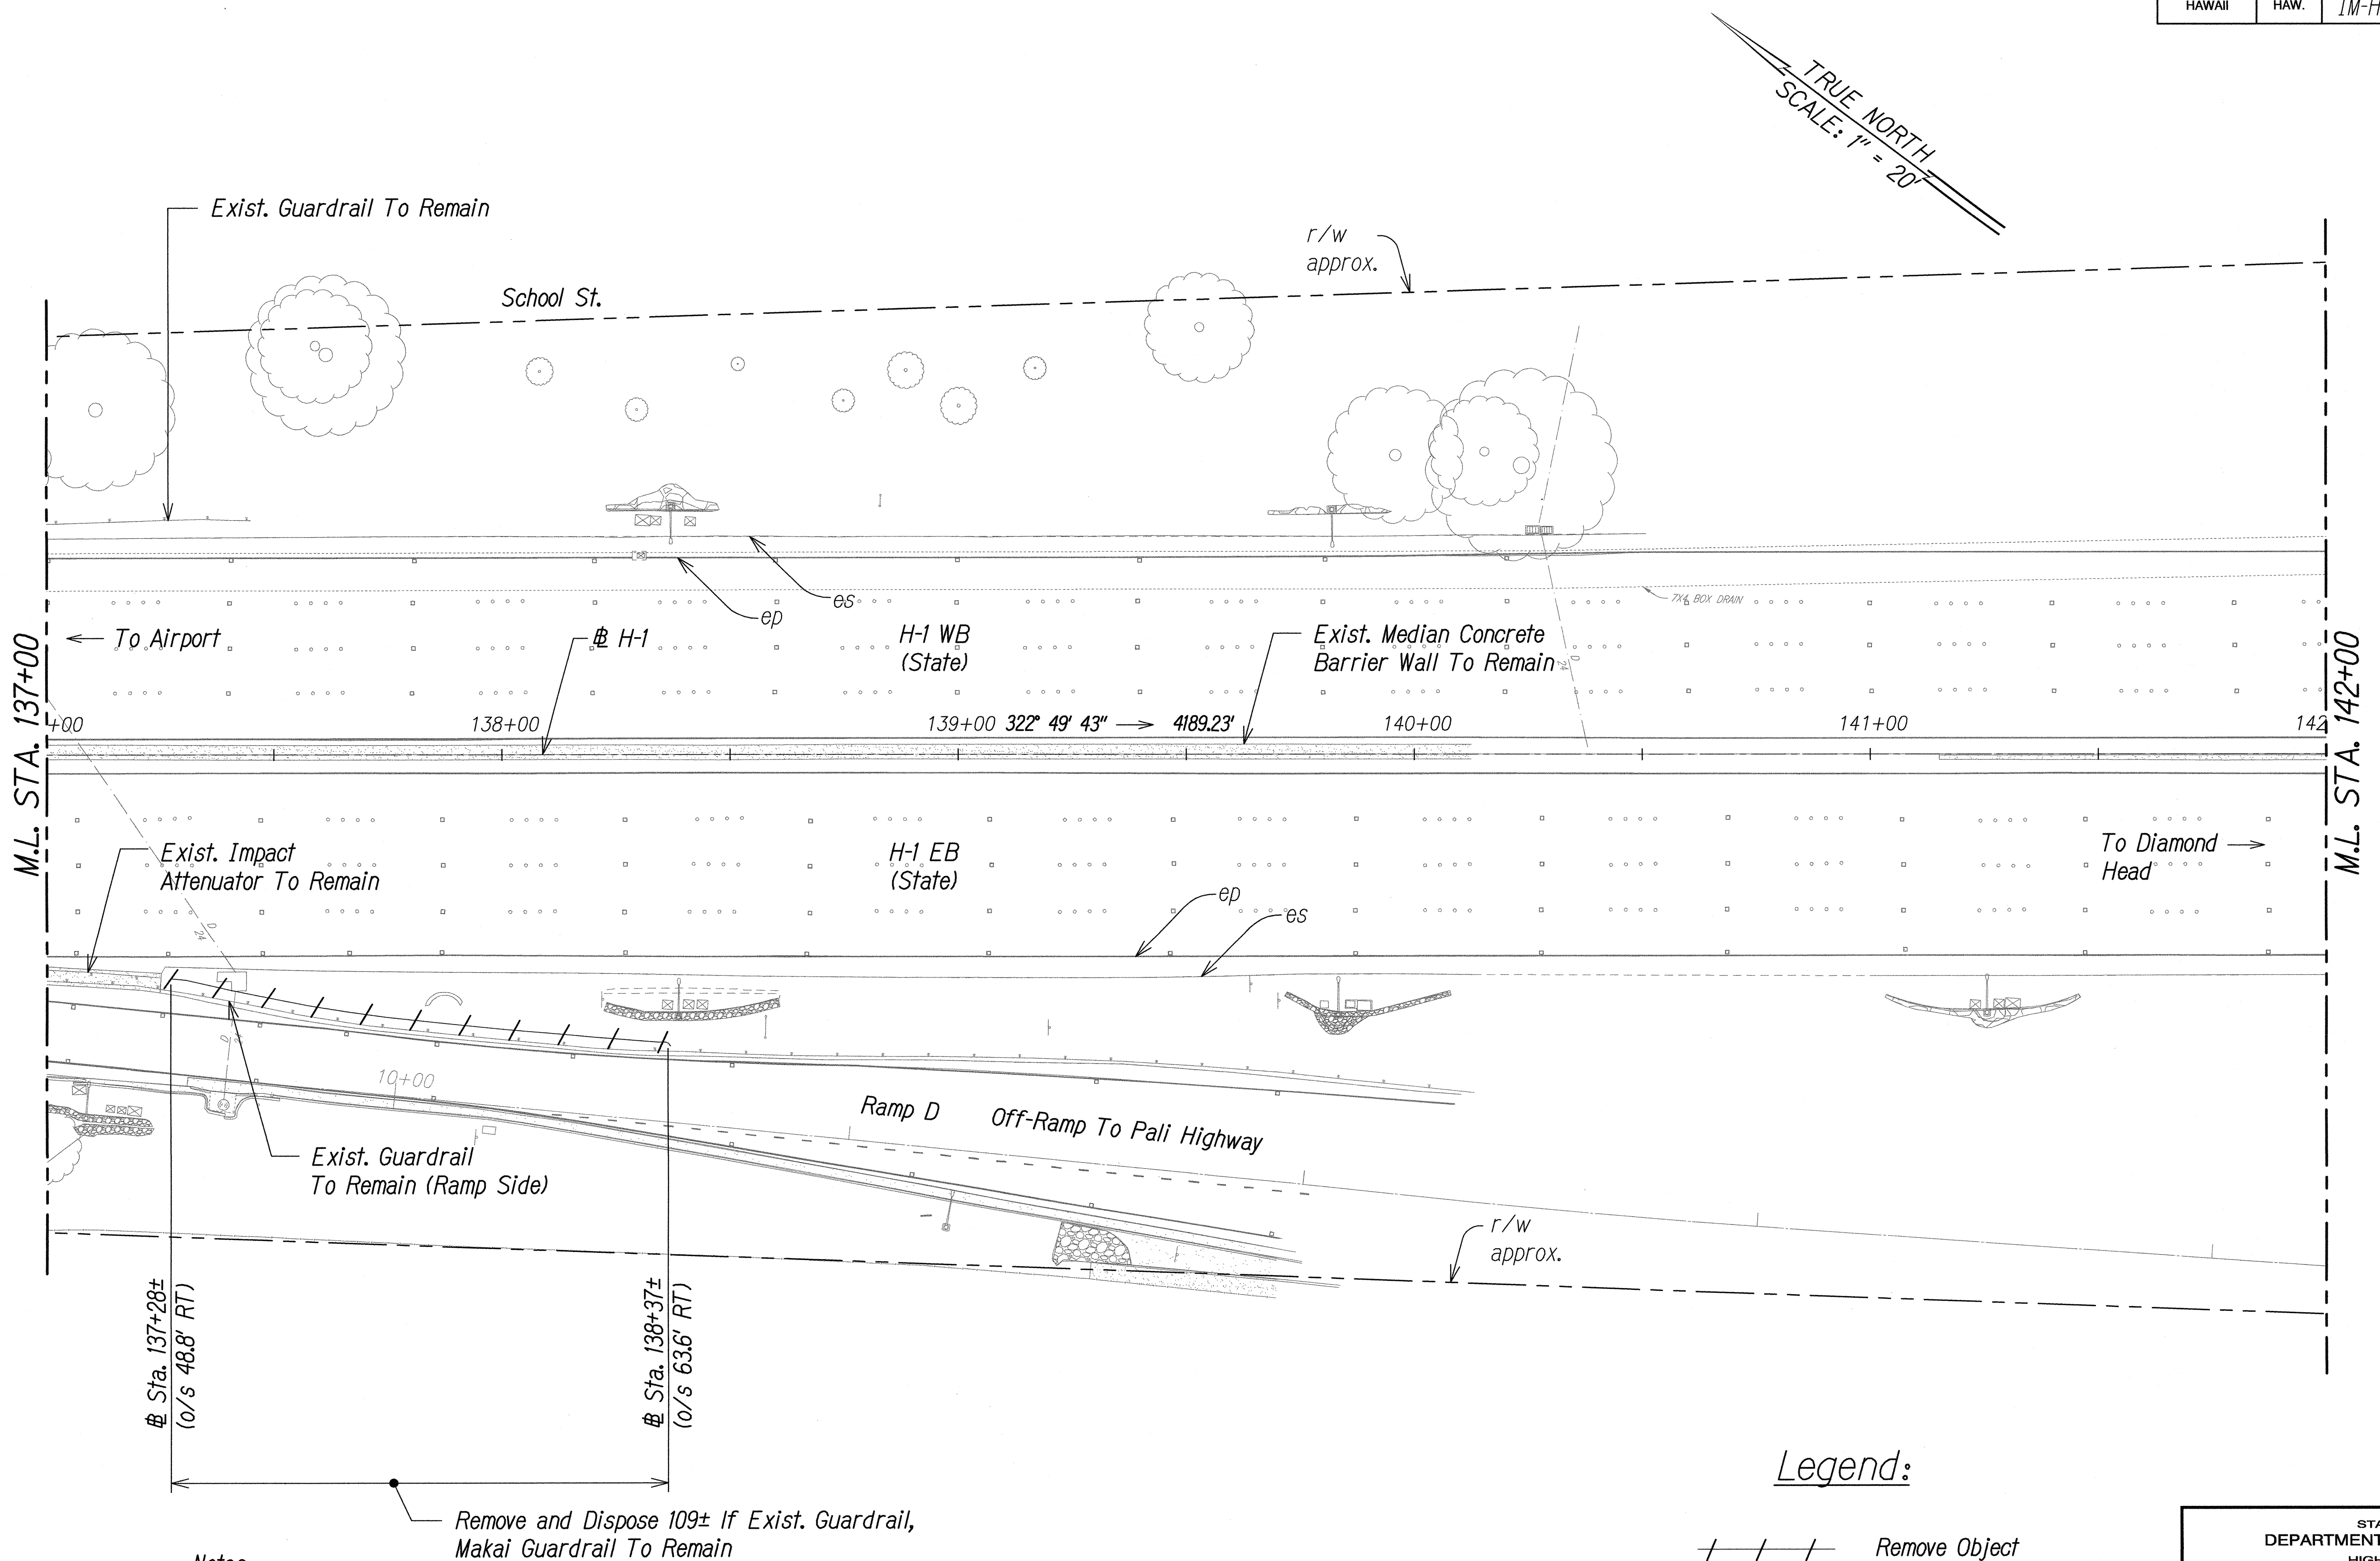

TRUE NORTH
SCALE: 1" = 20'

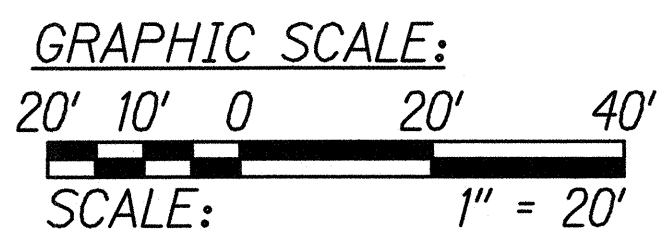

- Notes:
1. The Contractor's Attention is Directed to Section 209-Water Pollution Erosion During Construction Operations.
 2. All Disturbed Landscaped Area shall be Restored to Exist. Condition or Better.
 3. Street Light Standards, Pullboxes and Conduit shall Remain Unless Otherwise Noted.

STA. 137+00 TO 142+00 (H-1)

Legend:

--- Remove Object







THIS WORK WAS PREPARED BY ME OR UNDER MY SUPERVISION.
hick
APRIL 30, 2018
WILSON OKAMOTO CORPORATION LIC. EXP. DATE

STATE OF HAWAII
DEPARTMENT OF TRANSPORTATION
HIGHWAYS DIVISION
NUUANU AVENUE
DEMOLITION PLAN
INTERSTATE ROUTE H-1
GUARDRAIL AND SHOULDER IMPROVEMENTS
Middle Street to Punchbowl Off-Ramp
Fed. Aid Project No. IM-H1-1(242)
Scale: 1" = 20' Date: Mar. 2016
SHEET No. DP-12 OF 16 SHEETS


FED. ROAD DIST. NO.	STATE	FED. AID PROJ. NO.	FISCAL YEAR	SHEET NO.	TOTAL SHEETS
HAWAII	HAW.	1M-H1-1(242)	2016	40	354



Legend:

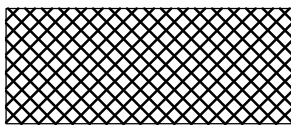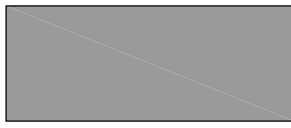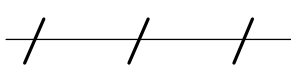-  Remove Structure
-  Saw Cut, Remove and Dispose Exist. Asphalt Pavement Structure Including Base and Subbase
-  Remove Object

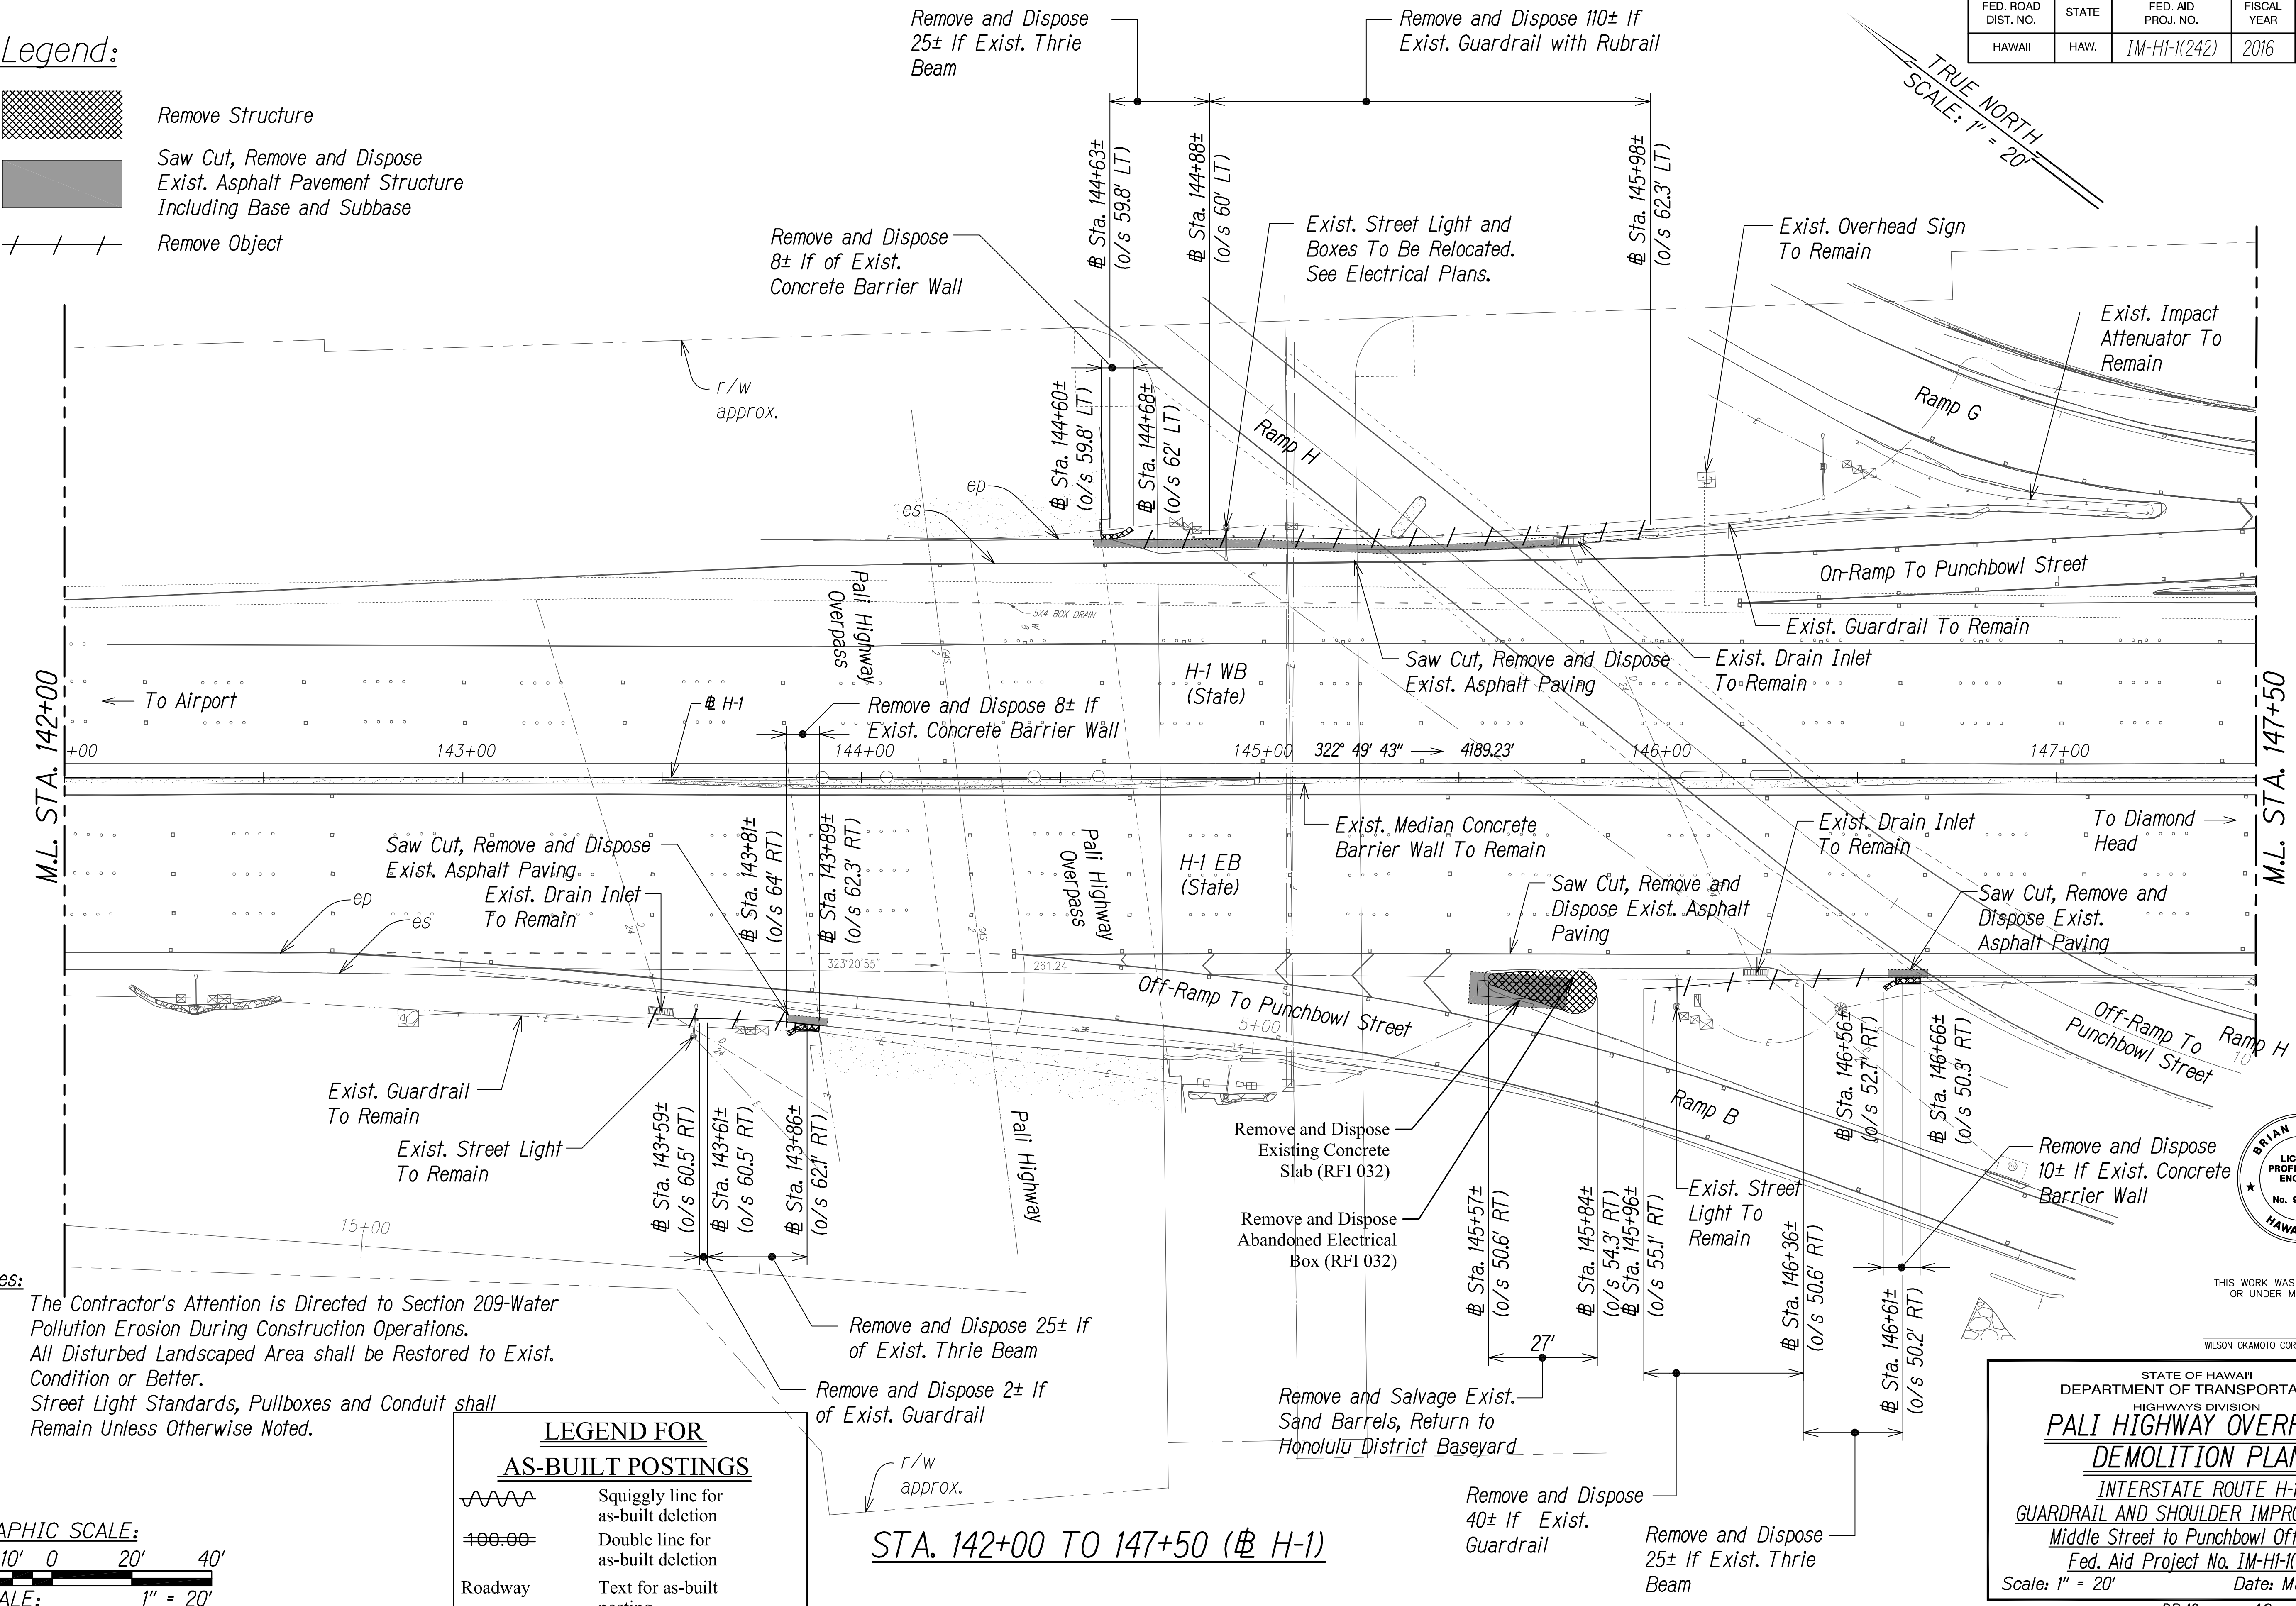

- Notes:
- The Contractor's Attention is Directed to Section 209-Water Pollution Erosion During Construction Operations.
 - All Disturbed Landscaped Area shall be Restored to Exist. Condition or Better.
 - Street Light Standards, Pullboxes and Conduit shall Remain Unless Otherwise Noted.

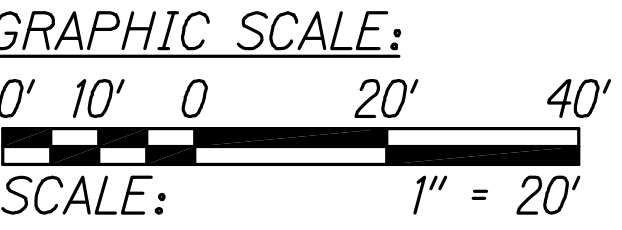

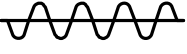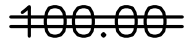
LEGEND FOR AS-BUILT POSTINGS	
	Squiggly line for as-built deletion
	Double line for as-built deletion
	Text for as-built posting

STATE OF HAWAII
DEPARTMENT OF TRANSPORTATION
HIGHWAYS DIVISION
**PALI HIGHWAY OVERPASS
DEMOLITION PLAN**
INTERSTATE ROUTE H-1
GUARDRAIL AND SHOULDER IMPROVEMENTS
Middle Street to Punchbowl Off-Ramp
Fed. Aid Project No. 1M-H1-1(242)
Scale: 1" = 20' Date: Mar. 2016


SHEET No. DP-13 OF 16 SHEETS

FED. ROAD DIST. NO.	STATE	FED. AID PROJ. NO.	FISCAL YEAR	SHEET NO.	TOTAL SHEETS
HAWAII	HAW.	1M-H1-1(242)	2016	41	354


Legend:

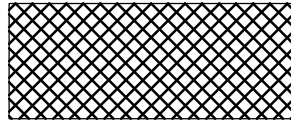


Remove Structure

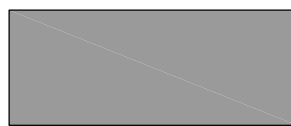

Saw Cut, Remove and Dispose Exist. Asphalt Pavement Structure Including Base and Subbase

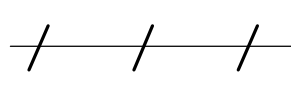


Remove Object

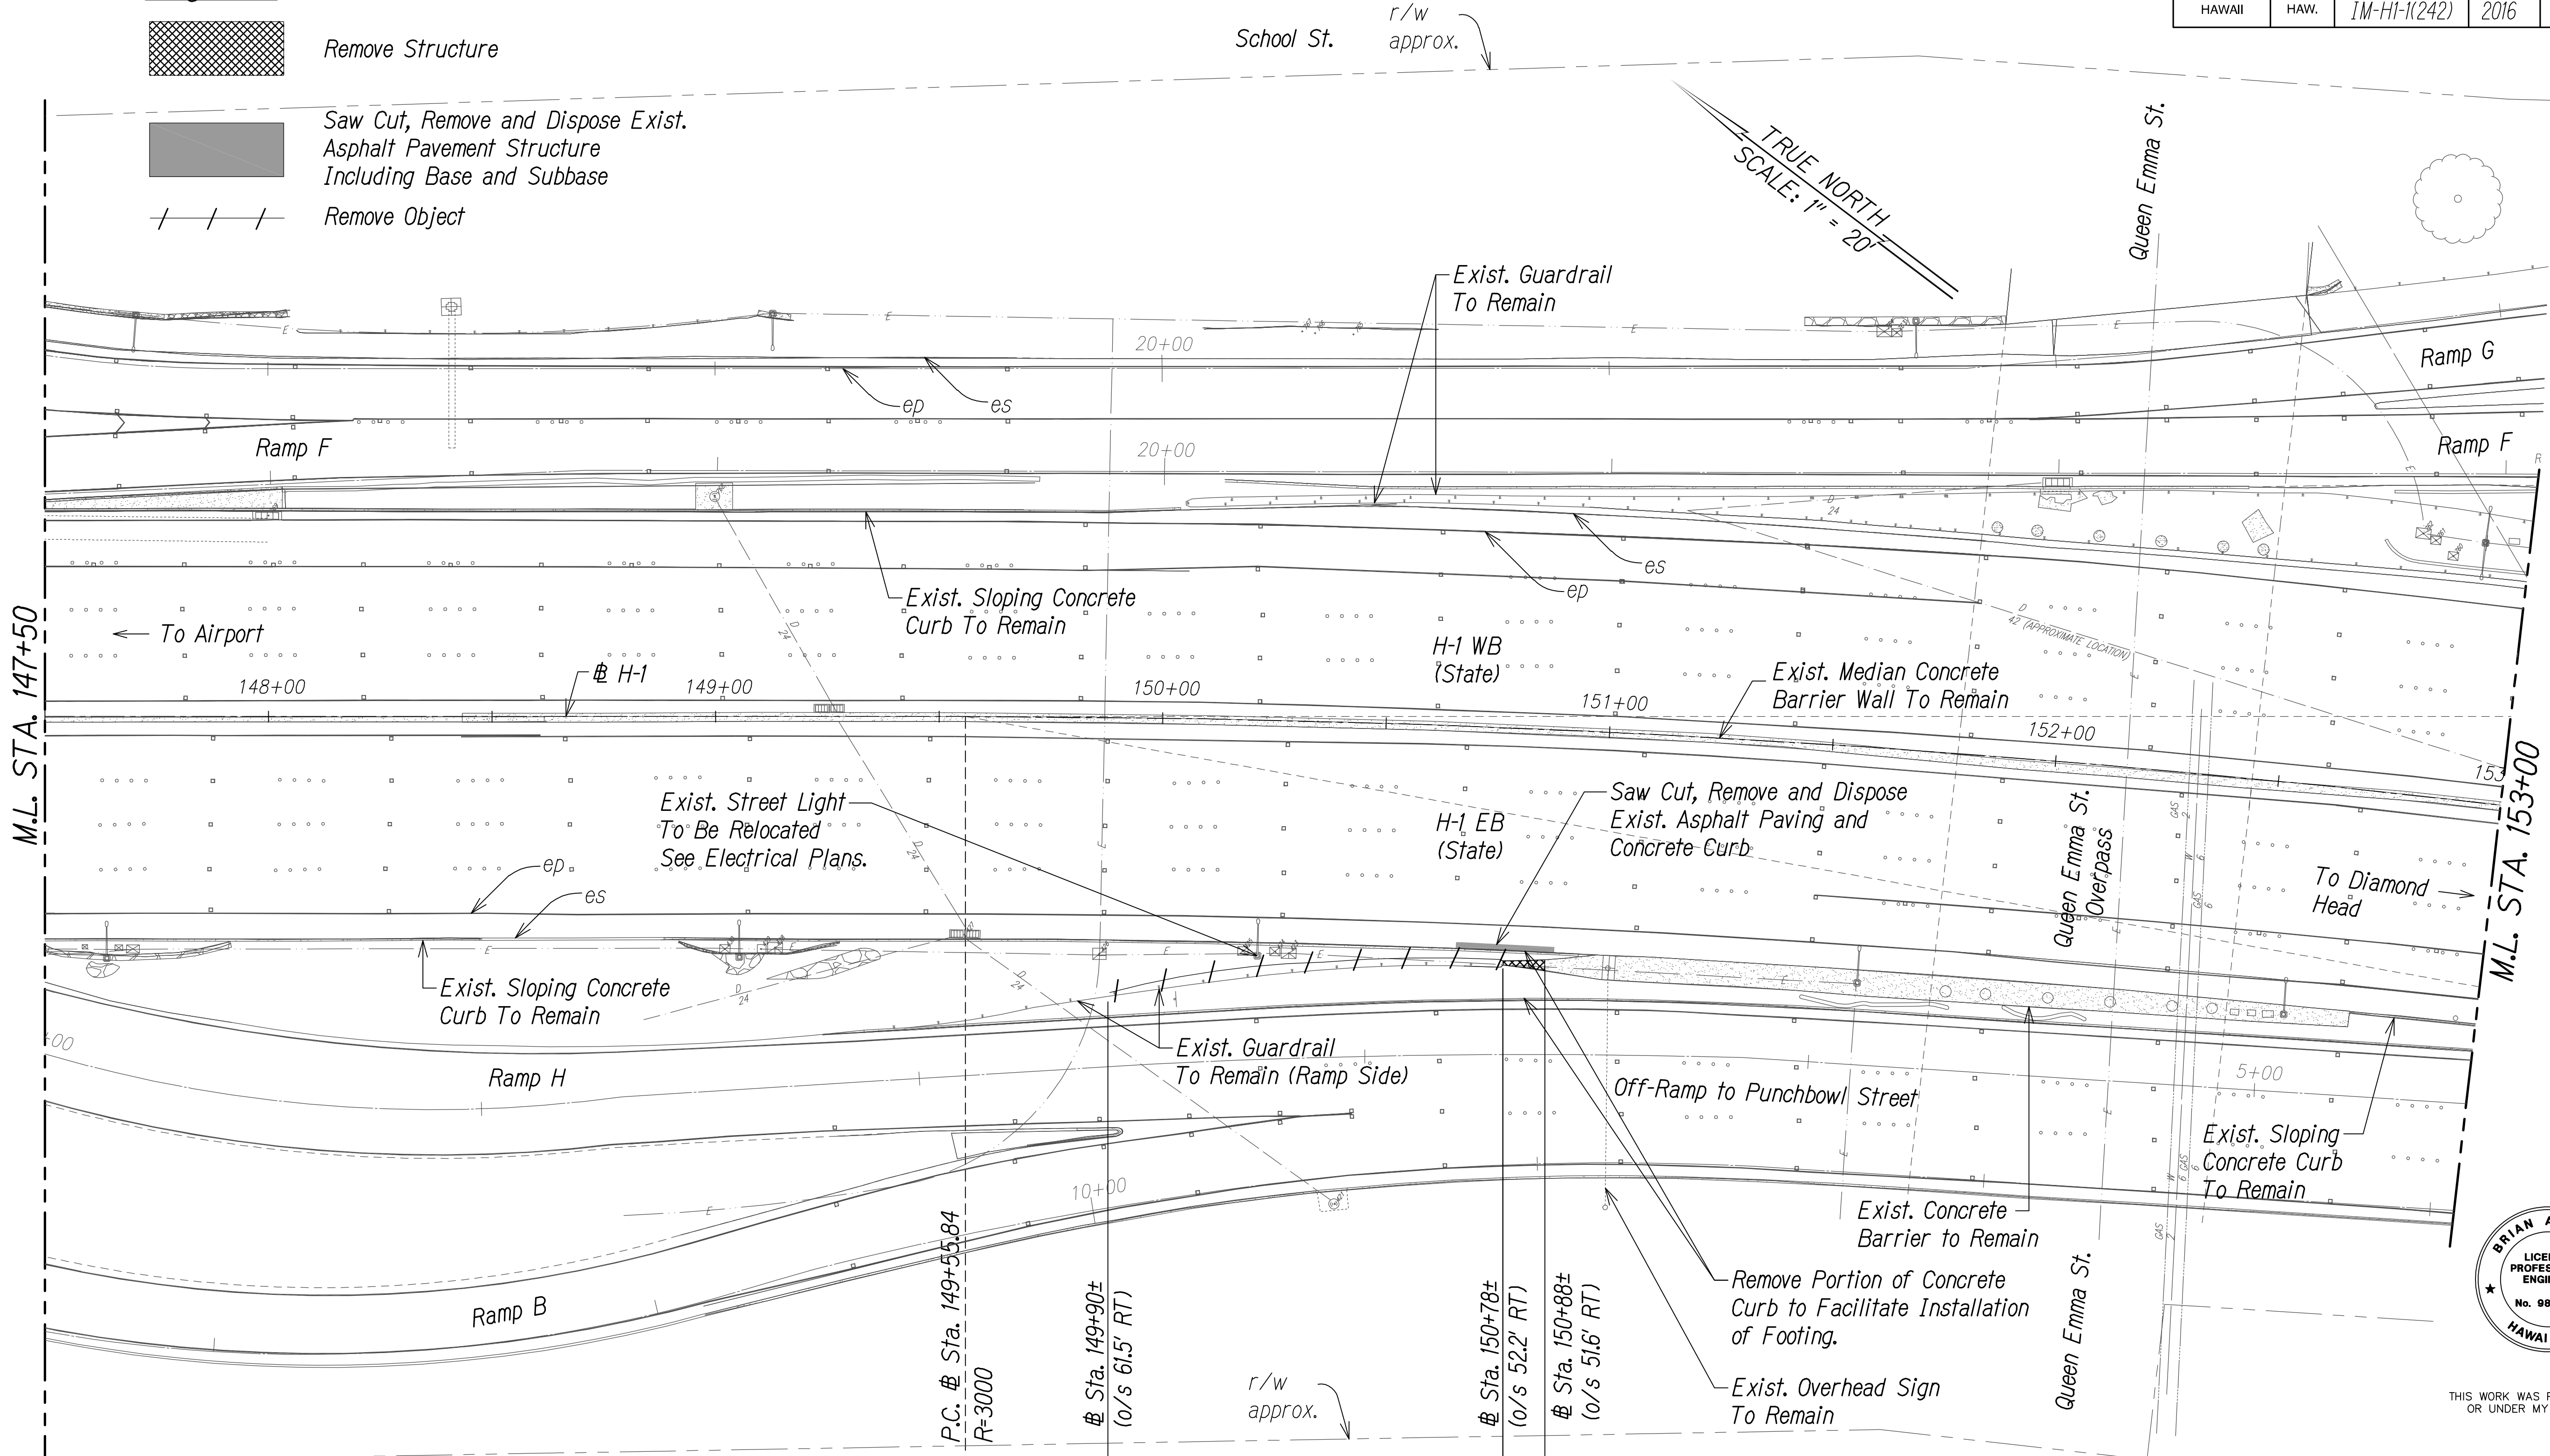

Notes:

- The Contractor's Attention is Directed to Section 209-Water Pollution Erosion During Construction Operations.
- All Disturbed Landscaped Area shall be Restored to Exist. Condition or Better.
- Street Light Standards, Pullboxes and Conduit shall Remain Unless Otherwise Noted.

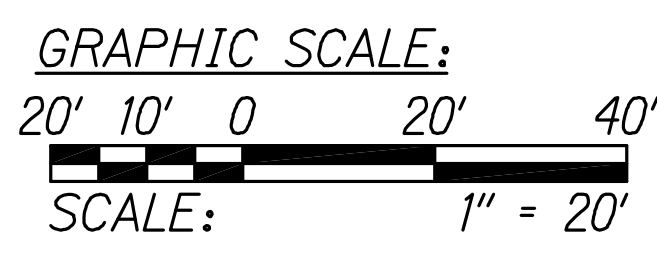

Remove and Dispose 88 LF of Existing Mauka Guardrail.
Remove and dispose 25 LF of Existing Makai Guardrail to Facilitate Installation of New Guardrail. (RFI 030)

LEGEND FOR AS-BUILT POSTINGS

Squiggly line for as-built deletion


Double line for as-built deletion

Roadway Text for as-built posting

STA. 147+50 TO 153+00 (# H-1)

~~Remove and Dispose 88 LF of Exist. Guardrail, Makai Guardrail To Remain~~

Remove and Dispose 21 LF of Exist Concrete Barrier (Portion). See Structural Plans for Detail. (RFI 030)

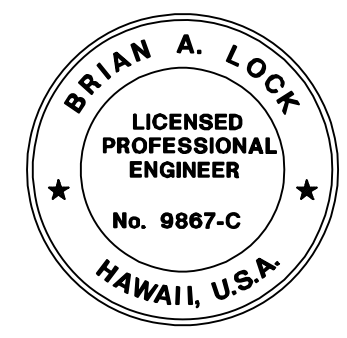


THIS WORK WAS PREPARED BY ME OR UNDER MY SUPERVISION.

APRIL 30, 2020
WILSON OKAMOTO CORPORATION LIC. EXP. DATE

STATE OF HAWAII
DEPARTMENT OF TRANSPORTATION
HIGHWAYS DIVISION
PALI HIGHWAY OVERPASS
DEMOLITION PLAN
INTERSTATE ROUTE H-1
GUARDRAIL AND SHOULDER IMPROVEMENTS
Middle Street to Punchbowl Off-Ramp
Fed. Aid Project No. 1M-H1-1(242)
Scale: 1" = 20' Date: Mar. 2016
SHEET No. DP-14 OF 16 SHEETS

"AS-BUILT"

FED. ROAD DIST. NO.	STATE	FED. AID PROJ. NO.	FISCAL YEAR	SHEET NO.	TOTAL SHEETS
HAWAII	HAW.	1M-H1-1(242)	2016	42	354

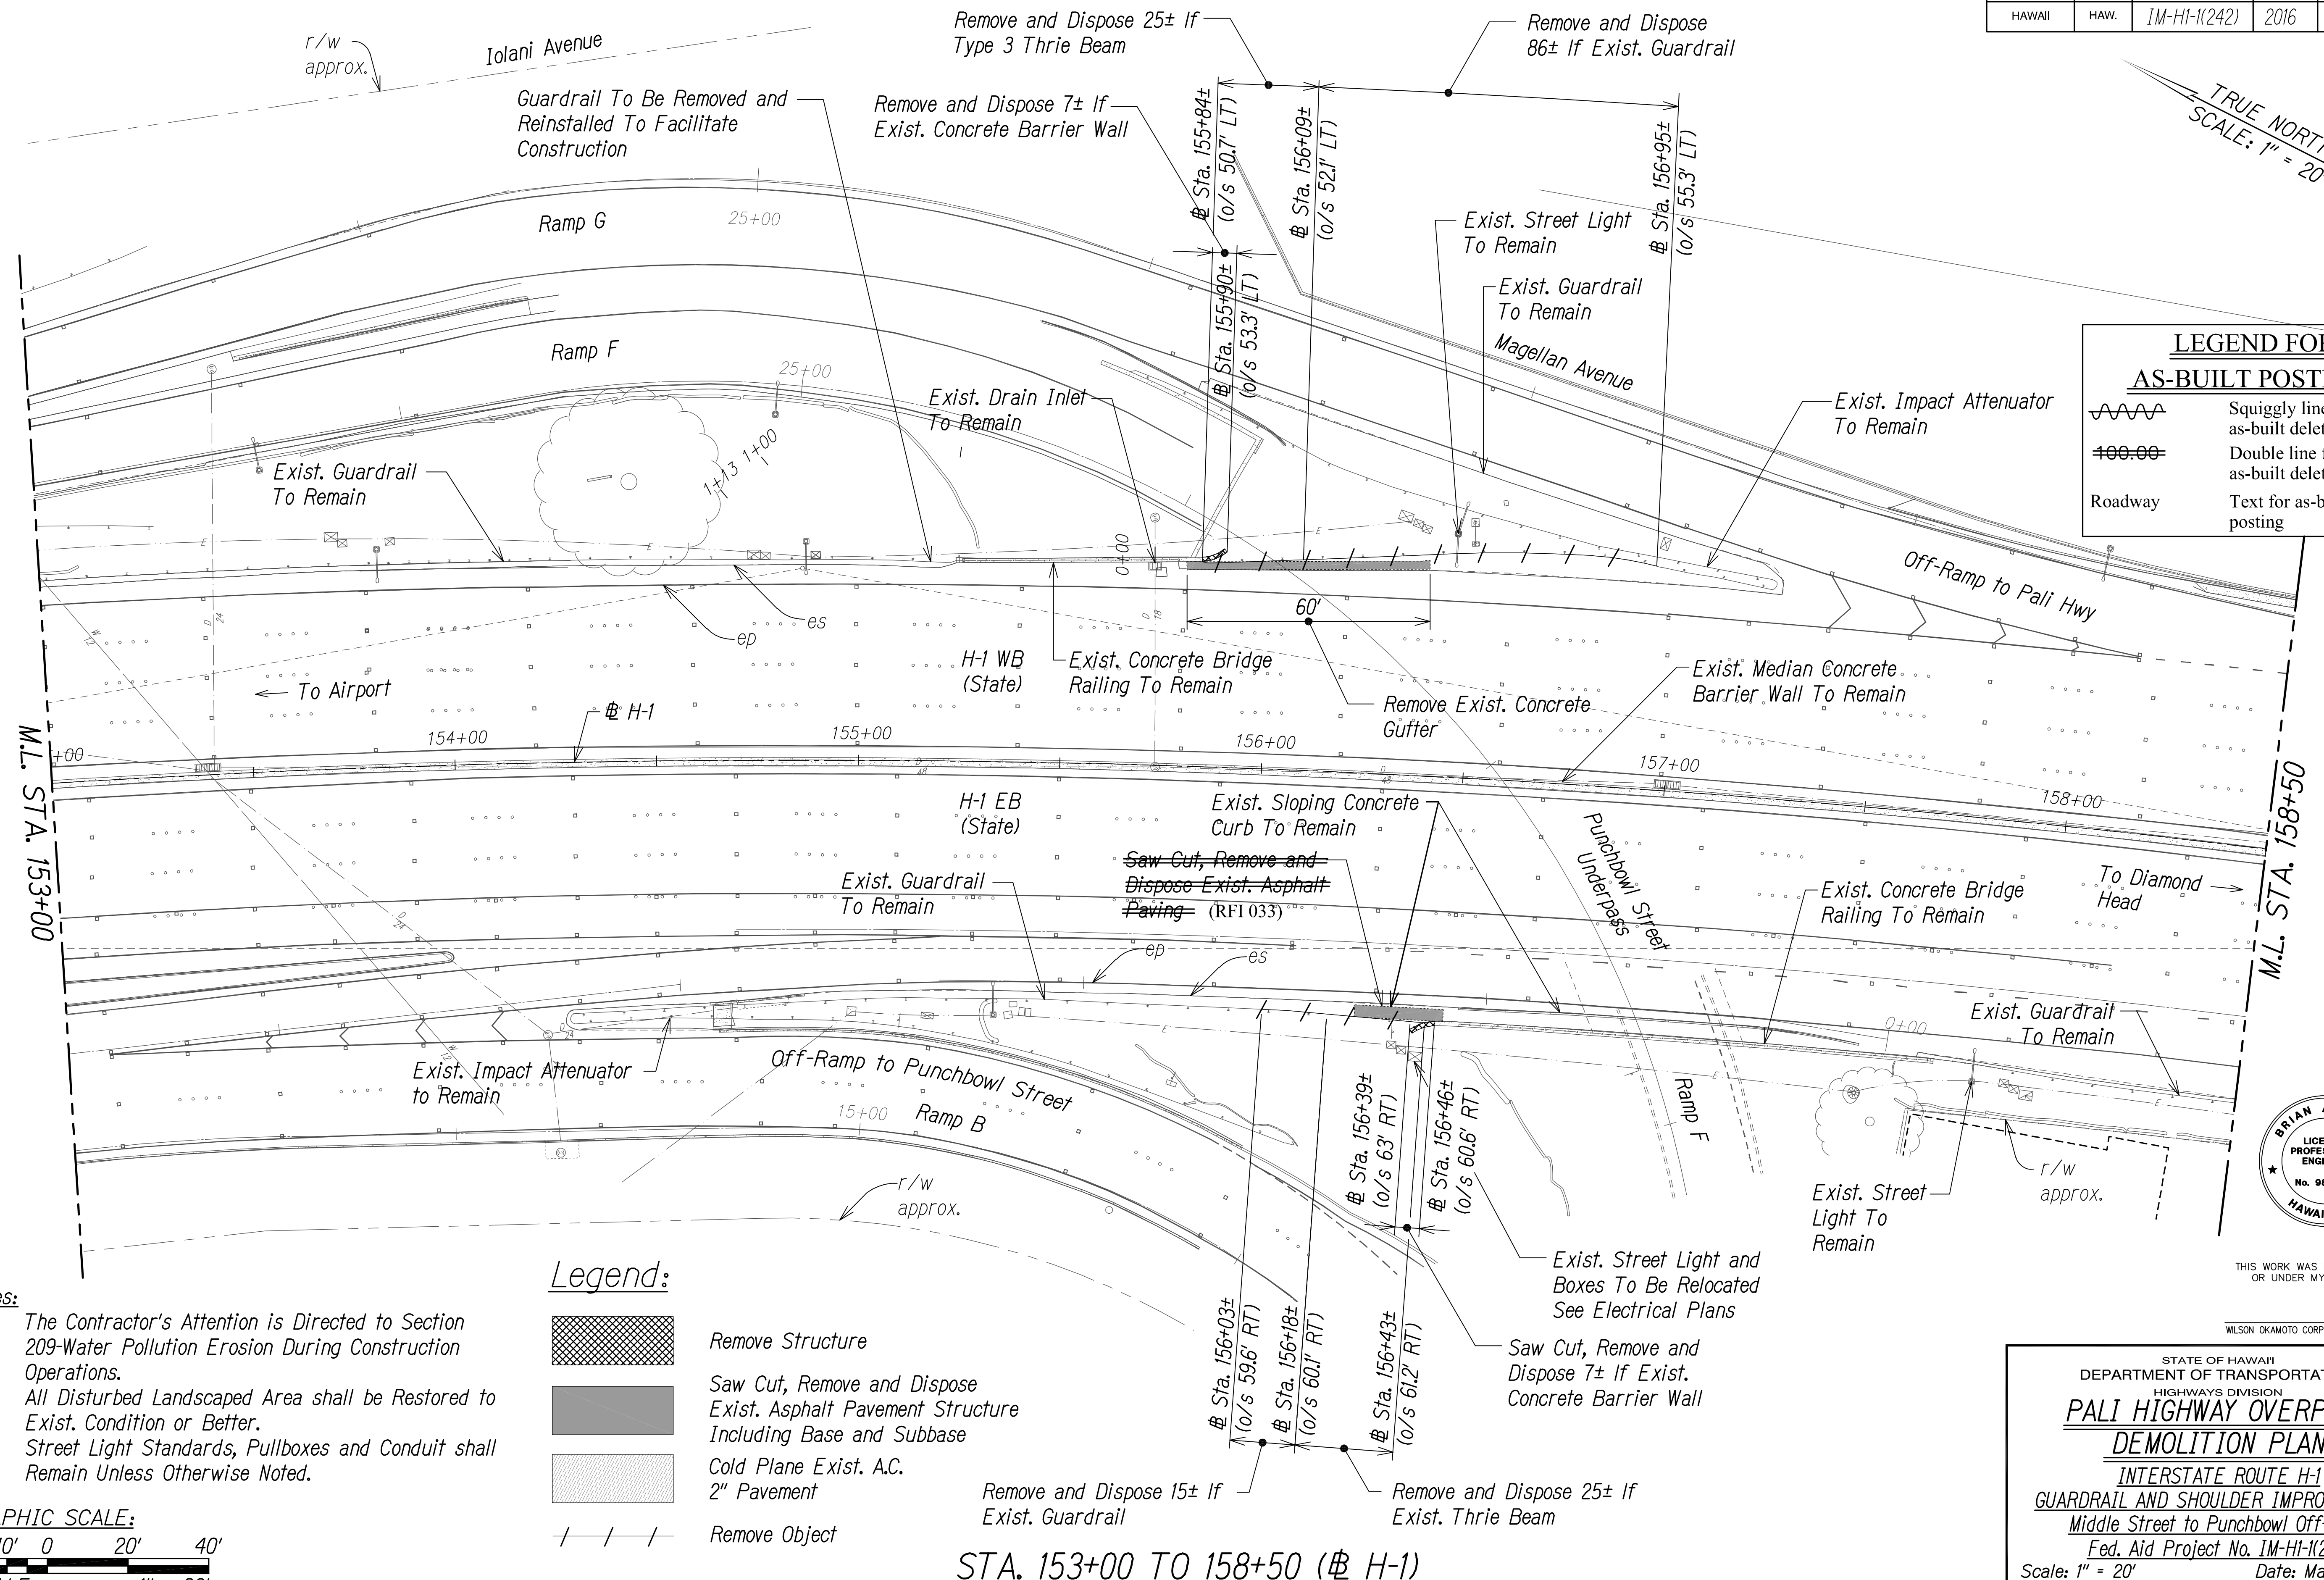


LEGEND FOR AS-BUILT POSTINGS

	Squiggly line for as-built deletion
	Double line for as-built deletion
Roadway	Text for as-built posting

Notes:


- The Contractor's Attention is Directed to Section 209-Water Pollution Erosion During Construction Operations.
- All Disturbed Landscaped Area shall be Restored to Exist. Condition or Better.
- Street Light Standards, Pullboxes and Conduit shall Remain Unless Otherwise Noted.

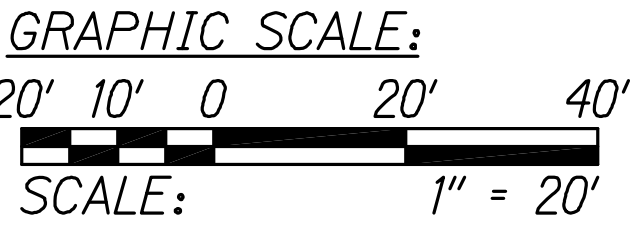

Legend:

- | | |
|--|--|
| | Remove Structure |
| | Saw Cut, Remove and Dispose Exist. Asphalt Pavement Structure Including Base and Subbase |
| | Cold Plane Exist. A.C. 2" Pavement |
| | Remove Object |

STA. 153+00 TO 158+50 (H-1)

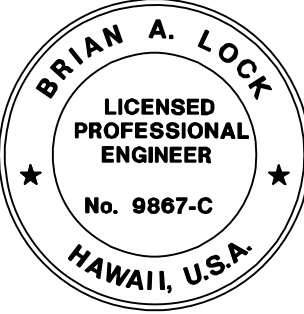


THIS WORK WAS PREPARED BY ME OR UNDER MY SUPERVISION.

APRIL 30, 2020
WILSON OKAMOTO CORPORATION LIC. EXP. DATE

STATE OF HAWAII
DEPARTMENT OF TRANSPORTATION
HIGHWAYS DIVISION
PALI HIGHWAY OVERPASS
DEMOLITION PLAN
INTERSTATE ROUTE H-1
GUARDRAIL AND SHOULDER IMPROVEMENTS
Middle Street to Punchbowl Off-Ramp
Fed. Aid Project No. 1M-H1-1(242)
Scale: 1" = 20' Date: Mar. 2016
SHEET No. DP-15 OF 16 SHEETS


SURVEY PLOTTED BY	DATE
DRAWN BY	
DESIGNED BY	
QUANTITIES BY	
CHECKED BY	
ORIGINAL PLAN	
NOTE BOOK	
No.	

FED. ROAD DIST. NO.	STATE	FED. AID PROJ. NO.	FISCAL YEAR	SHEET NO.	TOTAL SHEETS
HAWAII	HAW.	IM-HI-1(242)	2016	43	354

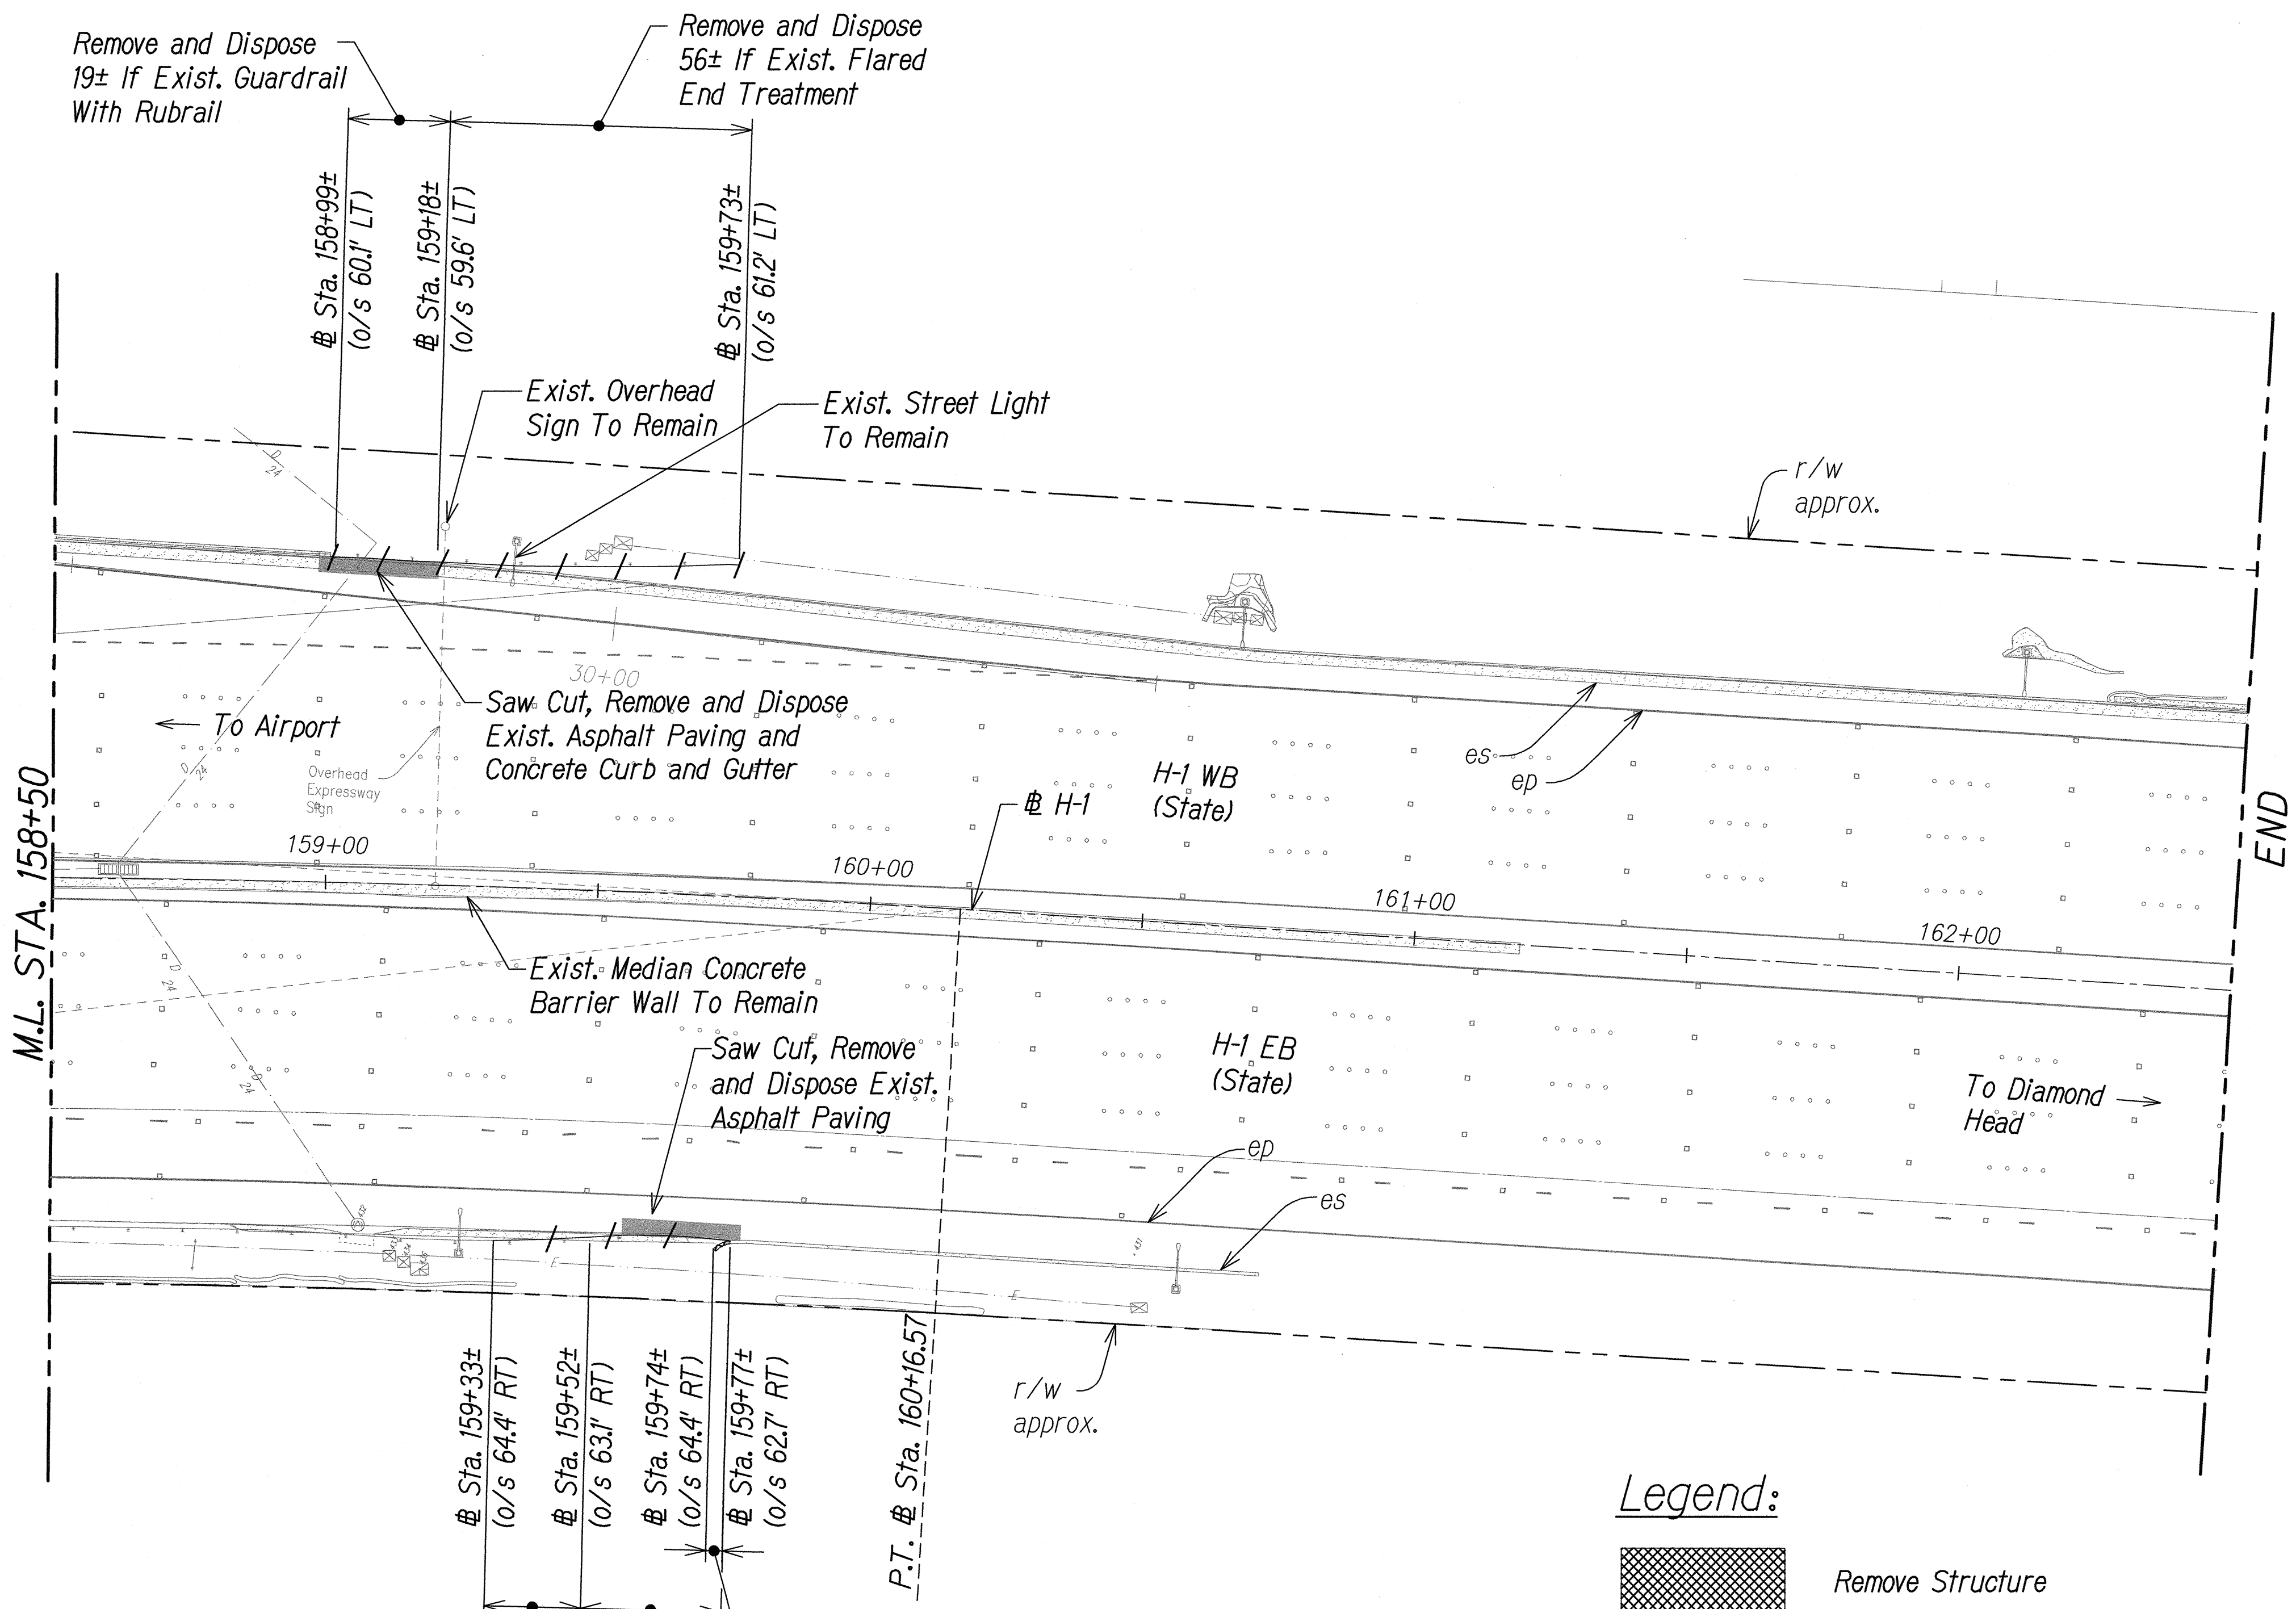


TRUE NORTH
SCALE: 1" = 20'

- Notes:**
1. The Contractor's Attention is Directed to Section 209-Water Pollution Erosion During Construction Operations.
 2. All Disturbed Landscaped Area shall be Restored to Exist. Condition or Better.
 3. Street Light Standards, Pullboxes and Conduit shall Remain Unless Otherwise Noted.

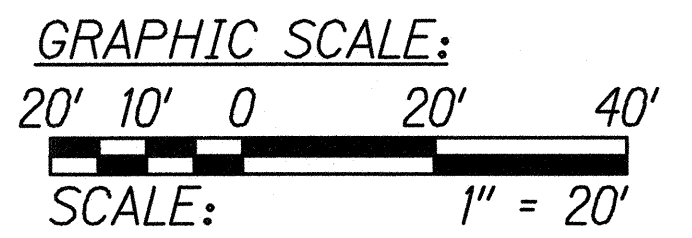

Legend:

- Remove Structure
- Saw Cut, Remove and Dispose Exist. Asphalt Pavement Structure Including Base and Subbase
- Cold Plane Exist. A.C. 2" Pavement
- Remove Object

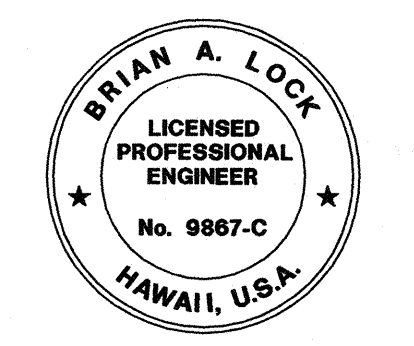

THIS WORK WAS PREPARED BY ME OR UNDER MY SUPERVISION.
[Signature]
APRIL 30, 2016
WILSON OKAMOTO CORPORATION LIC. EXP. DATE

STATE OF HAWAII
DEPARTMENT OF TRANSPORTATION
HIGHWAYS DIVISION
**PALI HIGHWAY OVERPASS
DEMOLITION PLAN**
INTERSTATE ROUTE H-1
GUARDRAIL AND SHOULDER IMPROVEMENTS
Middle Street to Punchbowl Off-Ramp
Fed. Aid Project No. IM-HI-1(242)
Scale: 1" = 20' Date: Mar. 2016
SHEET No. DP-16 OF 16 SHEETS

STA. 158+50 TO 162+50 (# H-1)