
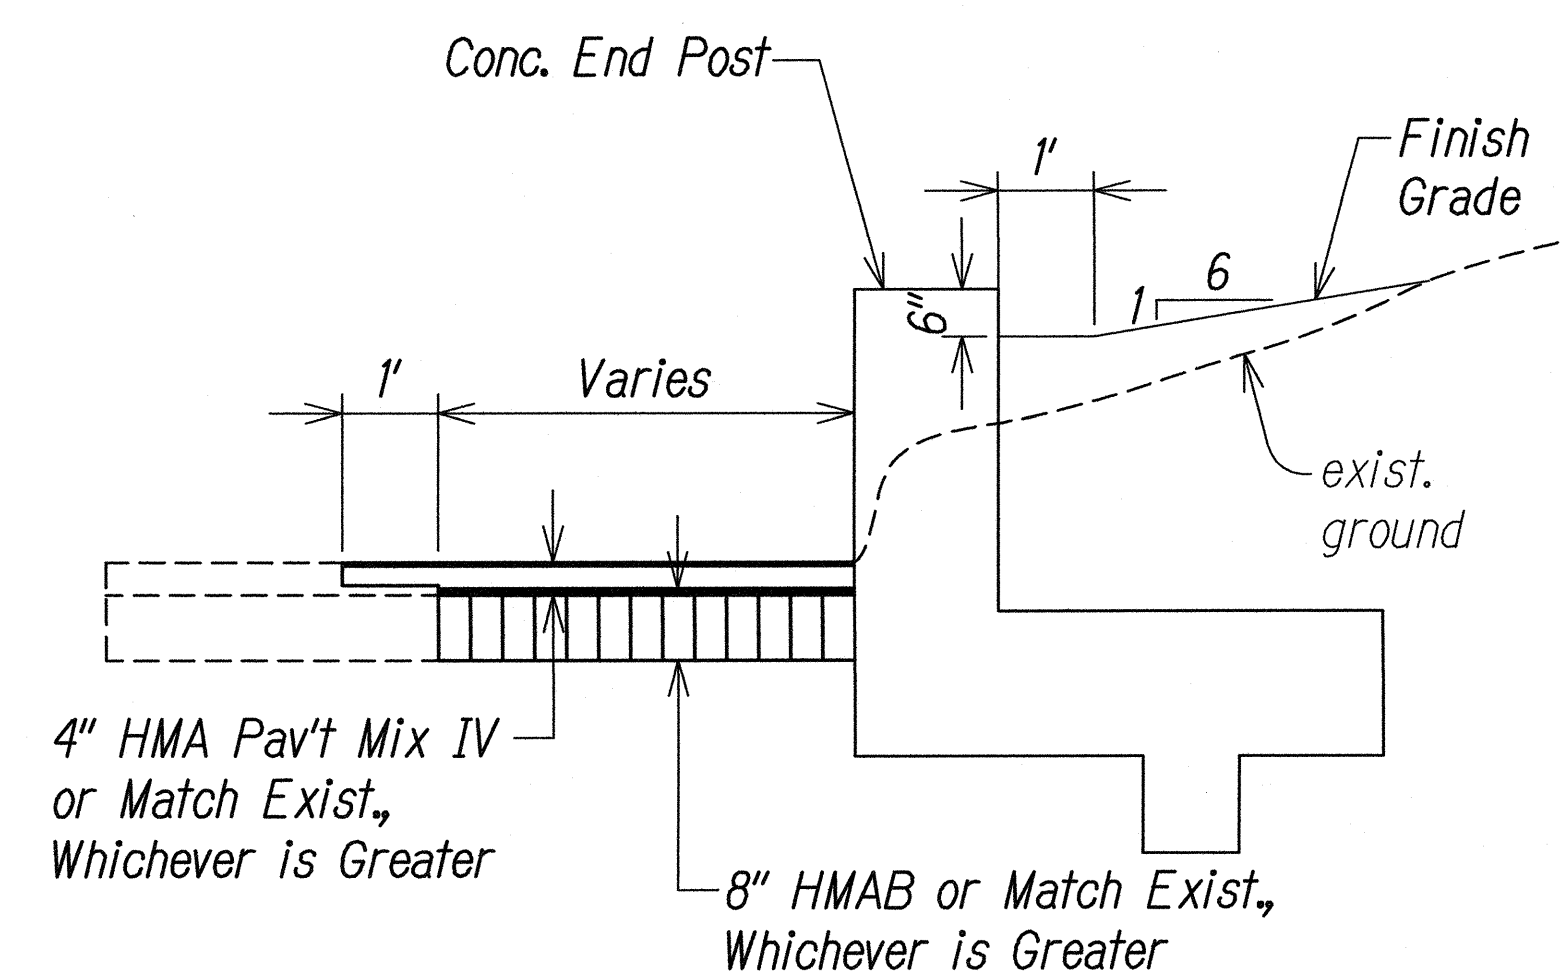


| FED. ROAD DIST. NO. | STATE | FED. AID PROJ. NO. | FISCAL YEAR | SHEET NO. | TOTAL SHEETS |
|---------------------|-------|--------------------|-------------|-----------|--------------|
| HAWAII              | HAW.  | IM-HI-1(242)       | 2016        | 60        | 354          |

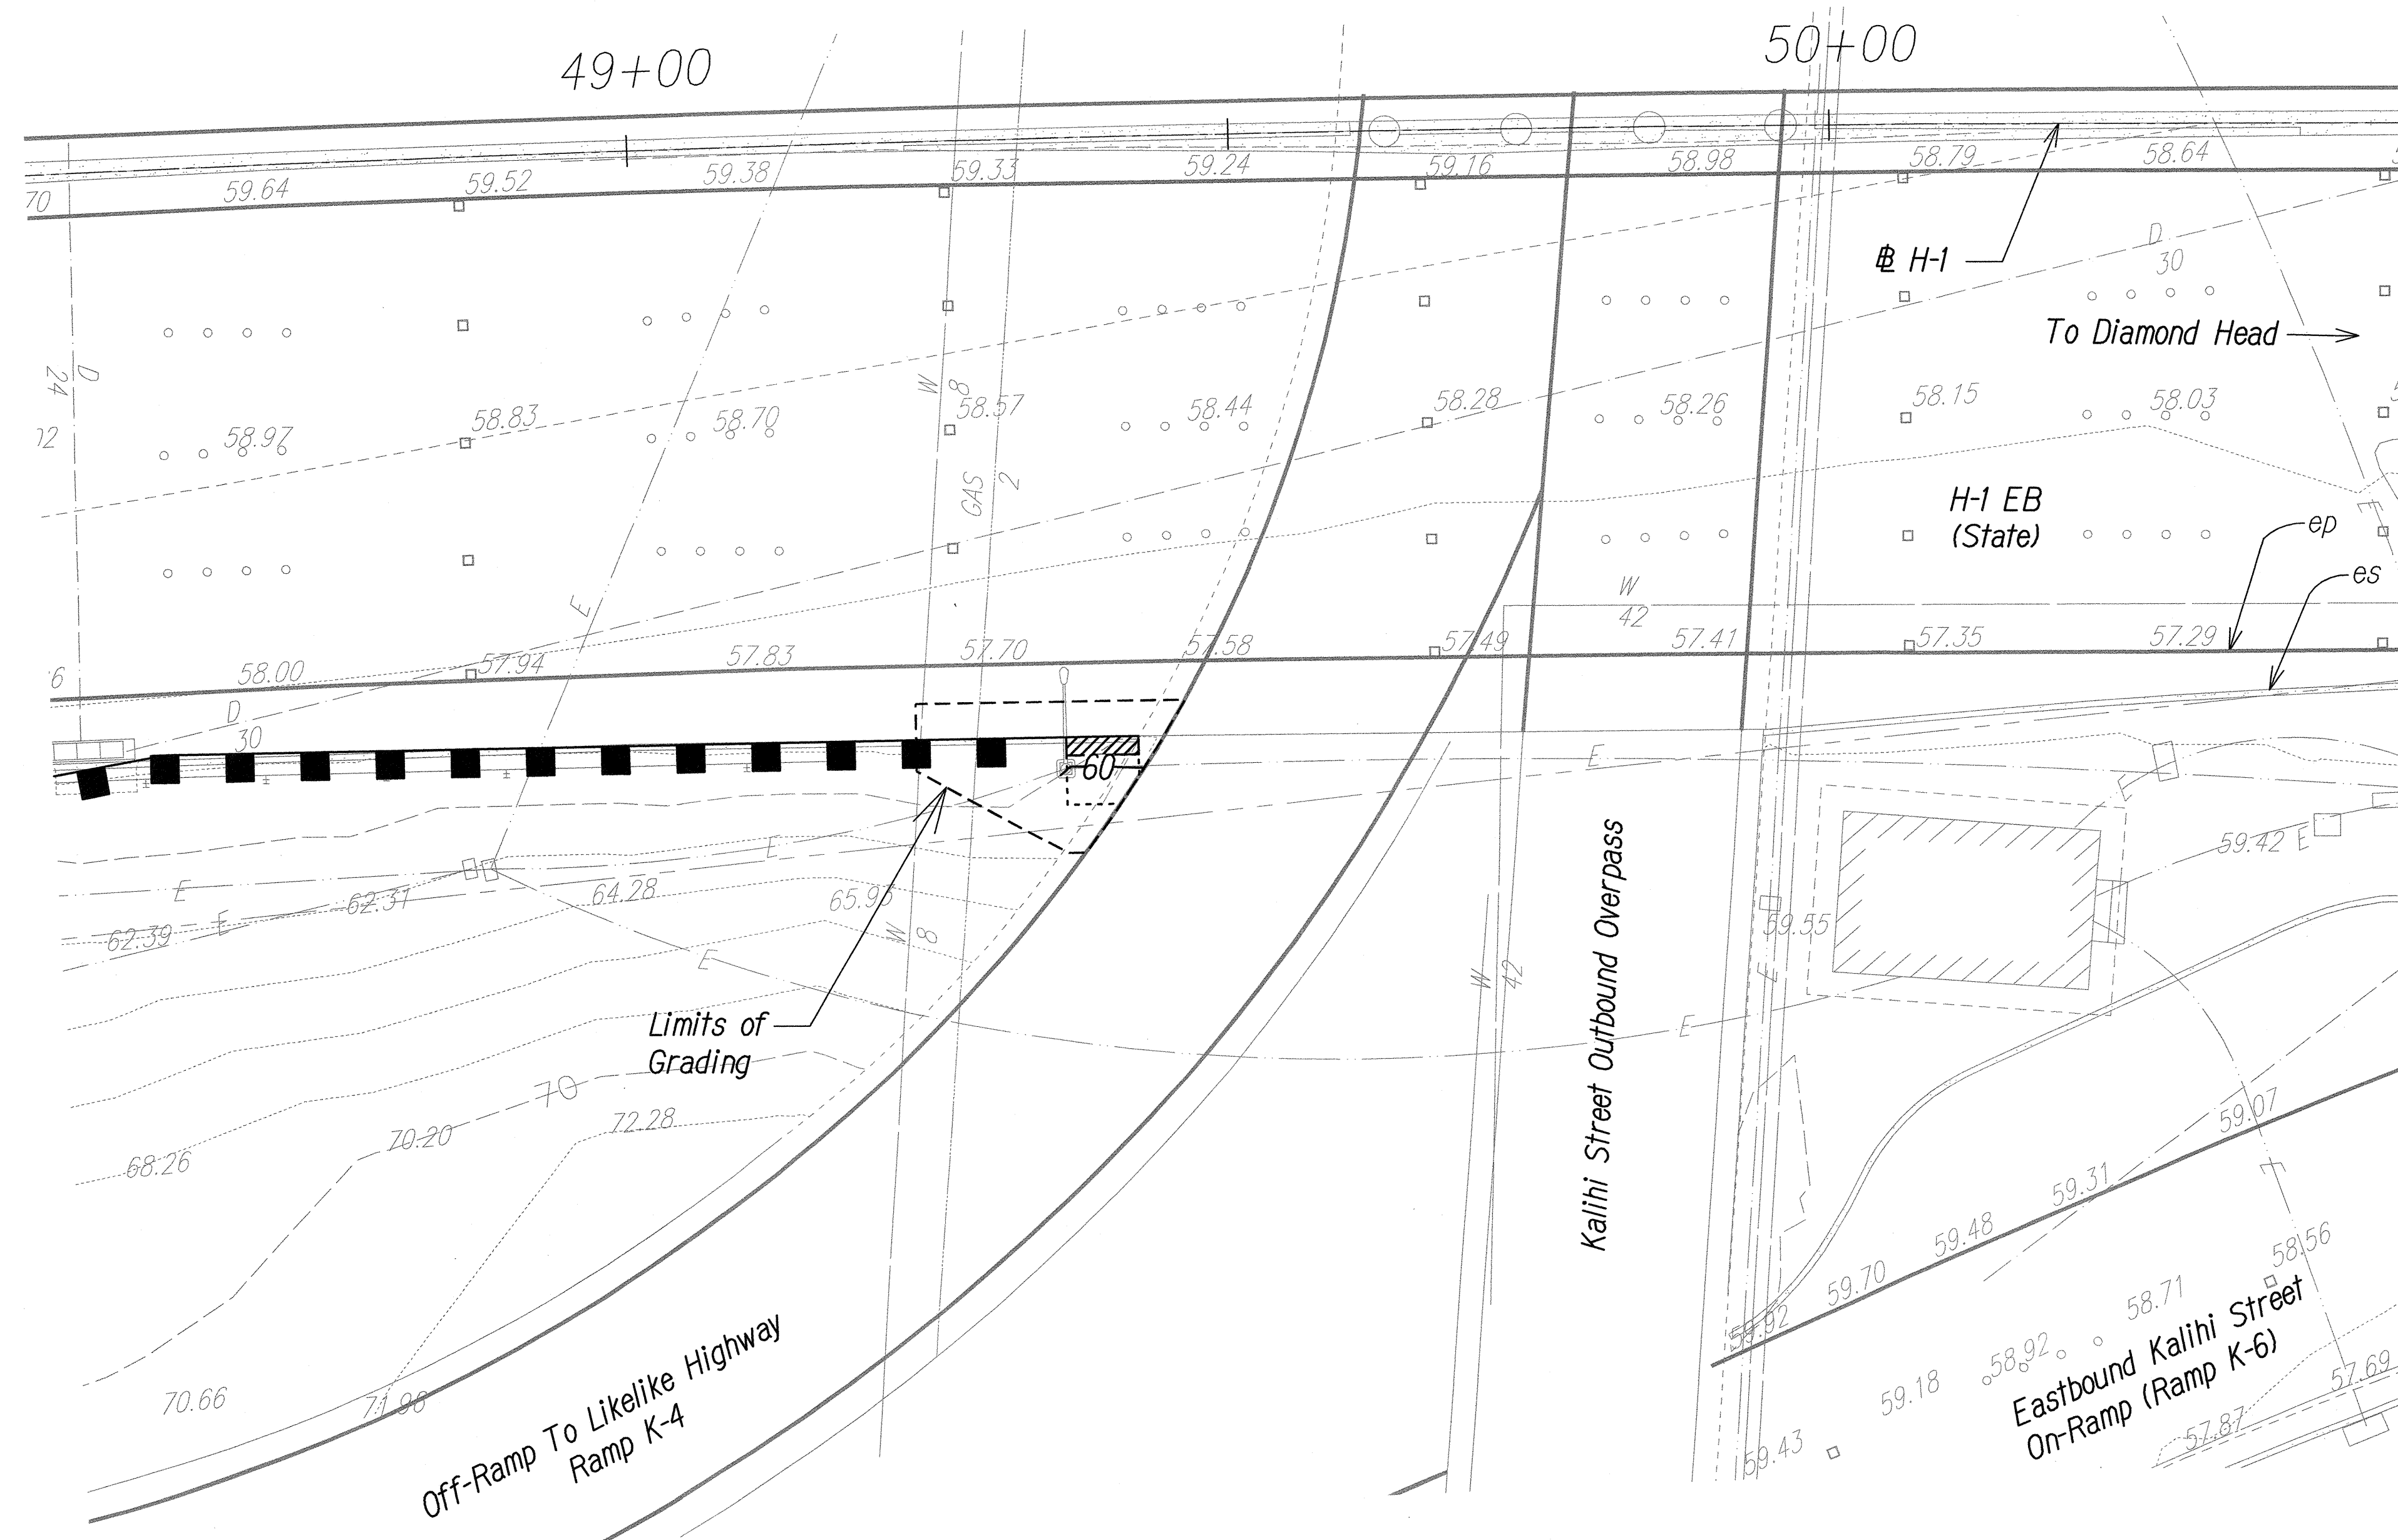



**TYPICAL SECTION**  
STA. 49+35 TO STA. 49+41 (EB)

**STA. 48+50 TO 50+50 (# H-1)**

**Note:**

1. For Roadway Cross Section, See RS-1 to RS-16.

**GRAPHIC SCALE:**

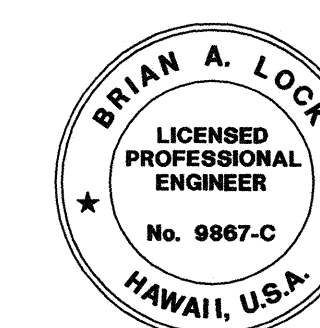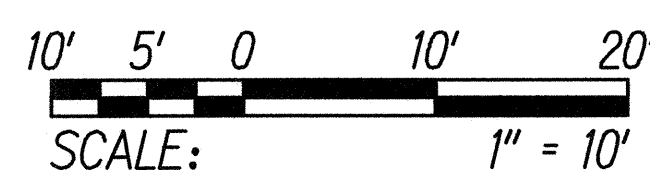

THIS WORK WAS PREPARED BY ME  
OR UNDER MY SUPERVISION.  
*Wilson Okamoto*  
WILSON OKAMOTO CORPORATION LIC. EXP. DATE

STATE OF HAWAII  
DEPARTMENT OF TRANSPORTATION  
HIGHWAYS DIVISION

**KALIHI INTERCHANGE**  
**GRADING PLAN**



INTERSTATE ROUTE H-1  
GUARDRAIL AND SHOULDER IMPROVEMENTS  
Middle Street to Punchbowl Off-Ramp  
Fed. Aid Project No. IM-HI-1(242)

Scale: 1" = 10'      Date: Mar. 2016

SHEET No. GP-1 OF 16 SHEETS



| FED. ROAD DIST. NO. | STATE | FED. AID PROJ. NO. | FISCAL YEAR | SHEET NO. | TOTAL SHEETS |
|---------------------|-------|--------------------|-------------|-----------|--------------|
| HAWAII              | HAW.  | 1M-H1-1(242)       | 2016        | 61        | 354          |

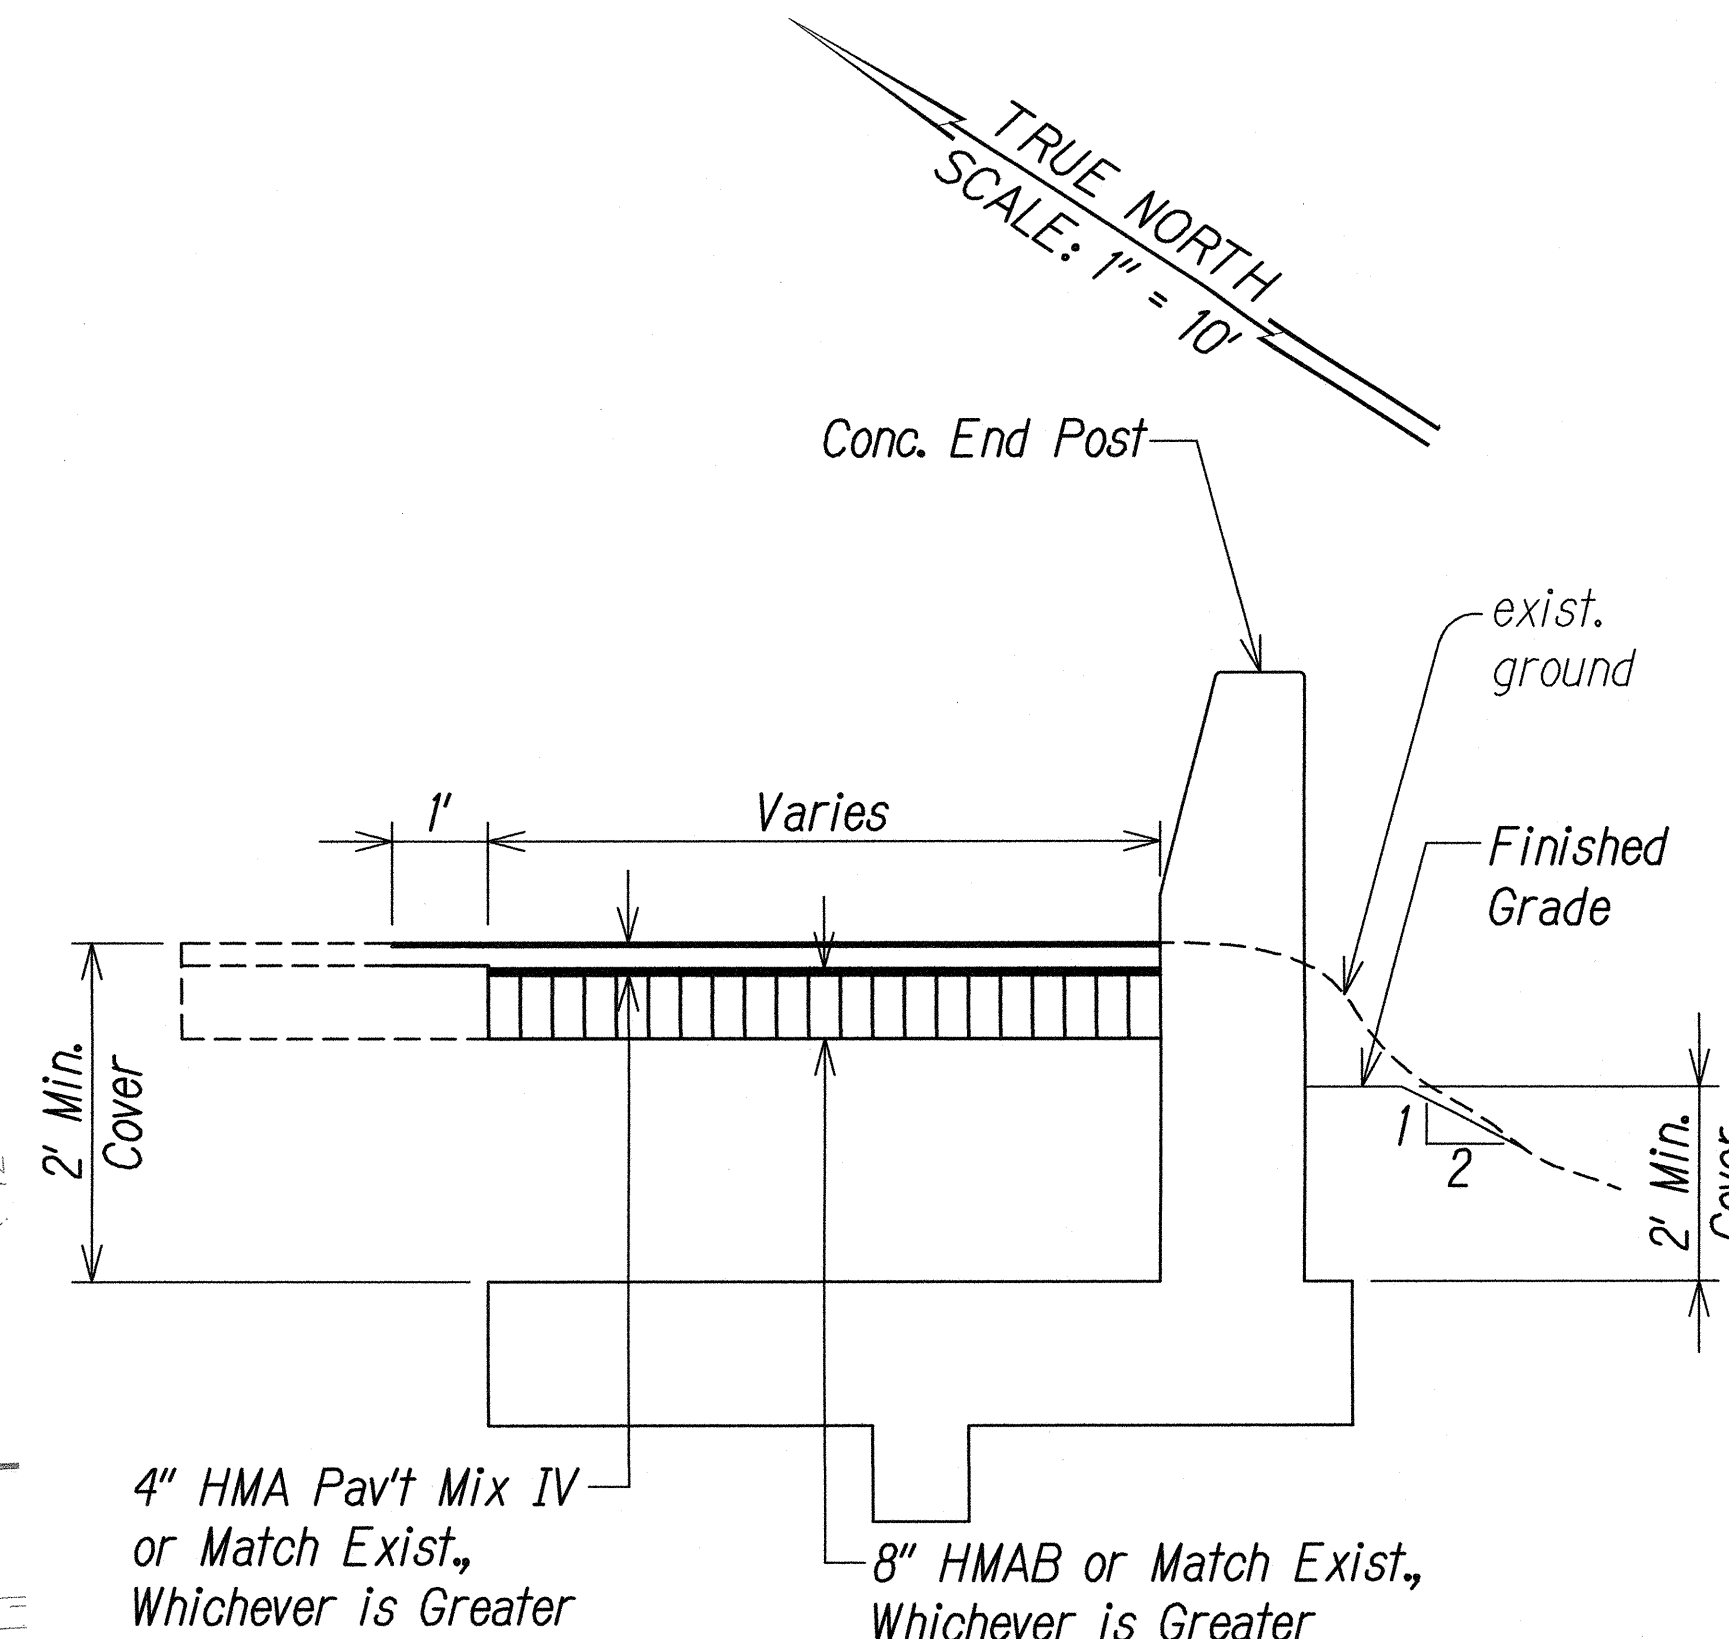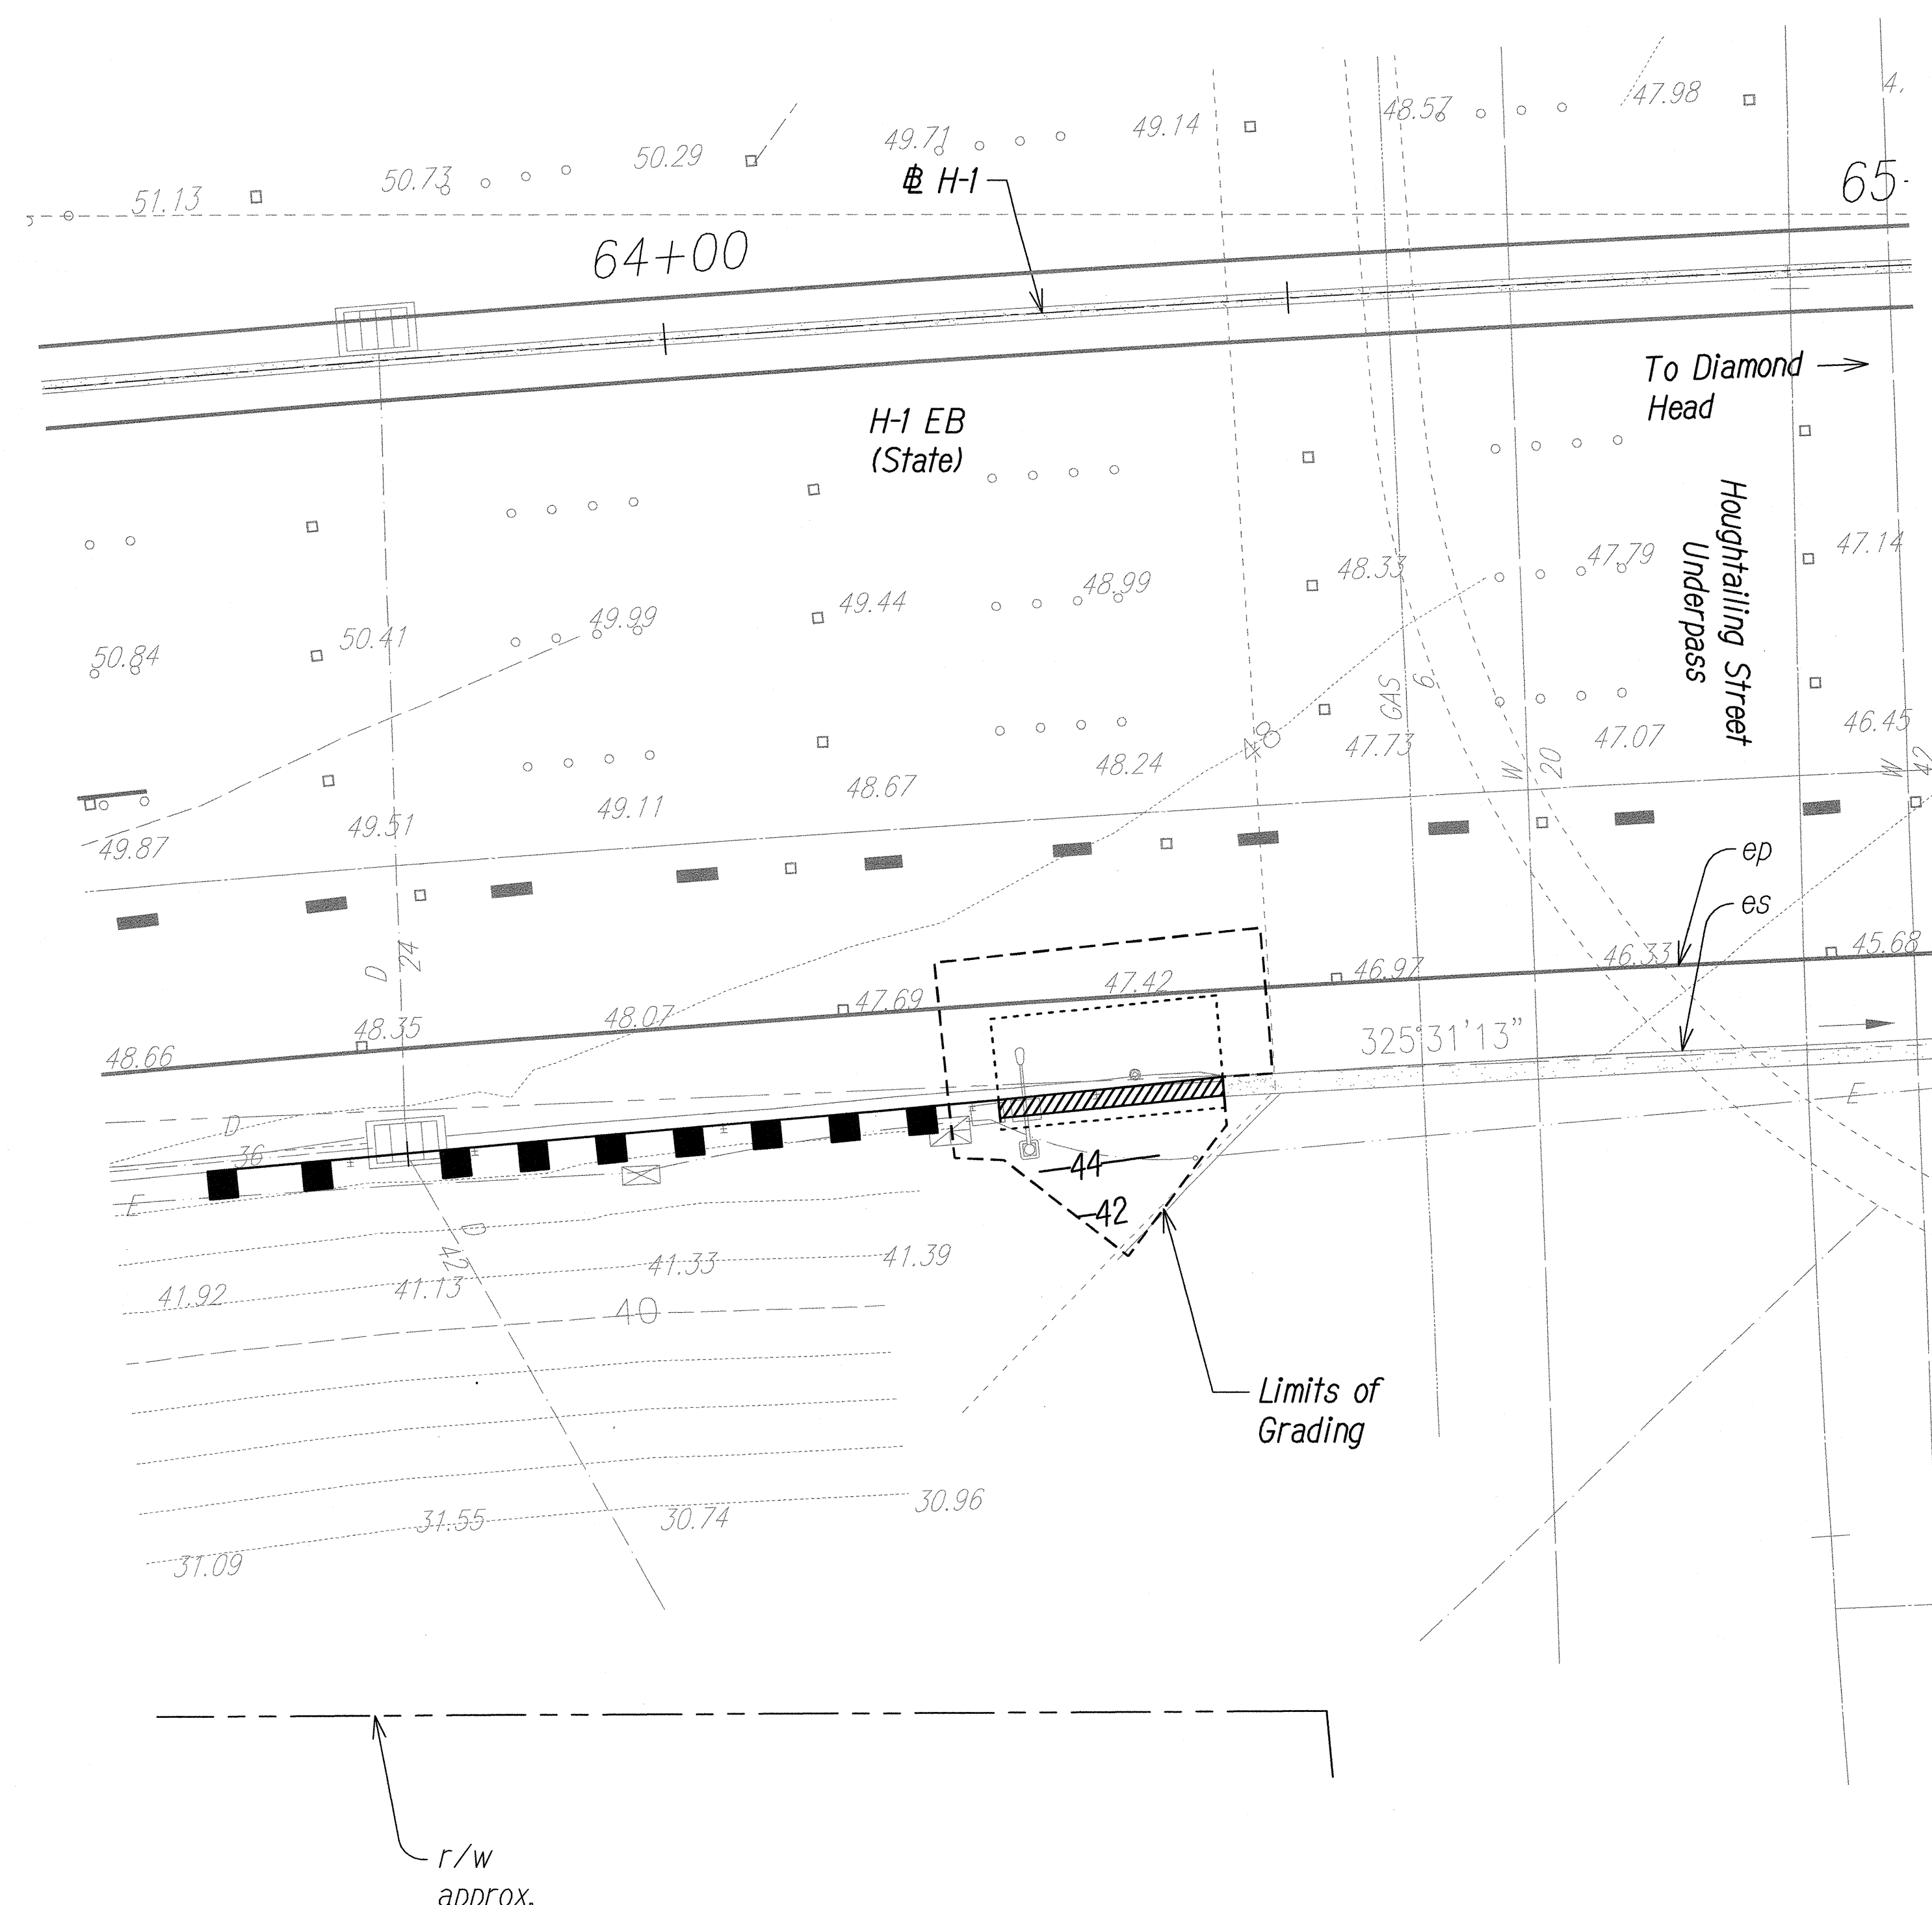


TYPICAL SECTION  
STA. 64+22 TO STA. 64+41 (EB)

STA. 63+50 TO 65+00 (H-1)

**Note:**  
1. For Roadway Cross Section, See RS-1 to RS-16.

**GRAPHIC SCALE:**  
10' 5' 0 10' 20'  
SCALE: 1" = 10'

|                   |      |
|-------------------|------|
| SURVEY PLOTTED BY | DATE |
| DRAWN BY          |      |
| DESIGNED BY       |      |
| QUANTITIES BY     |      |
| CHECKED BY        |      |
| ORIGINAL PLAN     | No.  |
| NOTE BOOK         |      |

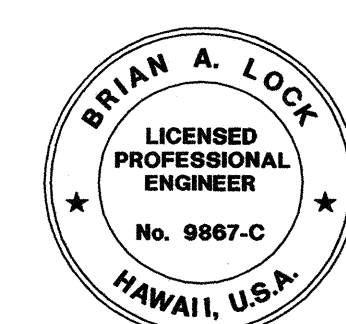


THIS WORK WAS PREPARED BY ME OR UNDER MY SUPERVISION.  
*mi*  
APRIL 30, 2018  
WILSON OKAMOTO CORPORATION LIC. EXP. DATE

STATE OF HAWAII  
DEPARTMENT OF TRANSPORTATION  
HIGHWAYS DIVISION  
**HOUGHTAILING SEPARATION**  
**GRADING PLAN**  
INTERSTATE ROUTE H-1  
GUARDRAIL AND SHOULDER IMPROVEMENTS  
Middle Street to Punchbowl Off-Ramp  
Fed. Aid Project No. 1M-H1-1(242)  
Scale: 1" = 10' Date: Mar. 2016  
SHEET No. GP-2 OF 16 SHEETS



| FED. ROAD DIST. NO. | STATE | FED. AID PROJ. NO. | FISCAL YEAR | SHEET NO. | TOTAL SHEETS |
|---------------------|-------|--------------------|-------------|-----------|--------------|
| HAWAII              | HAW.  | IM-H1-1(242)       | 2016        | 62        | 354          |

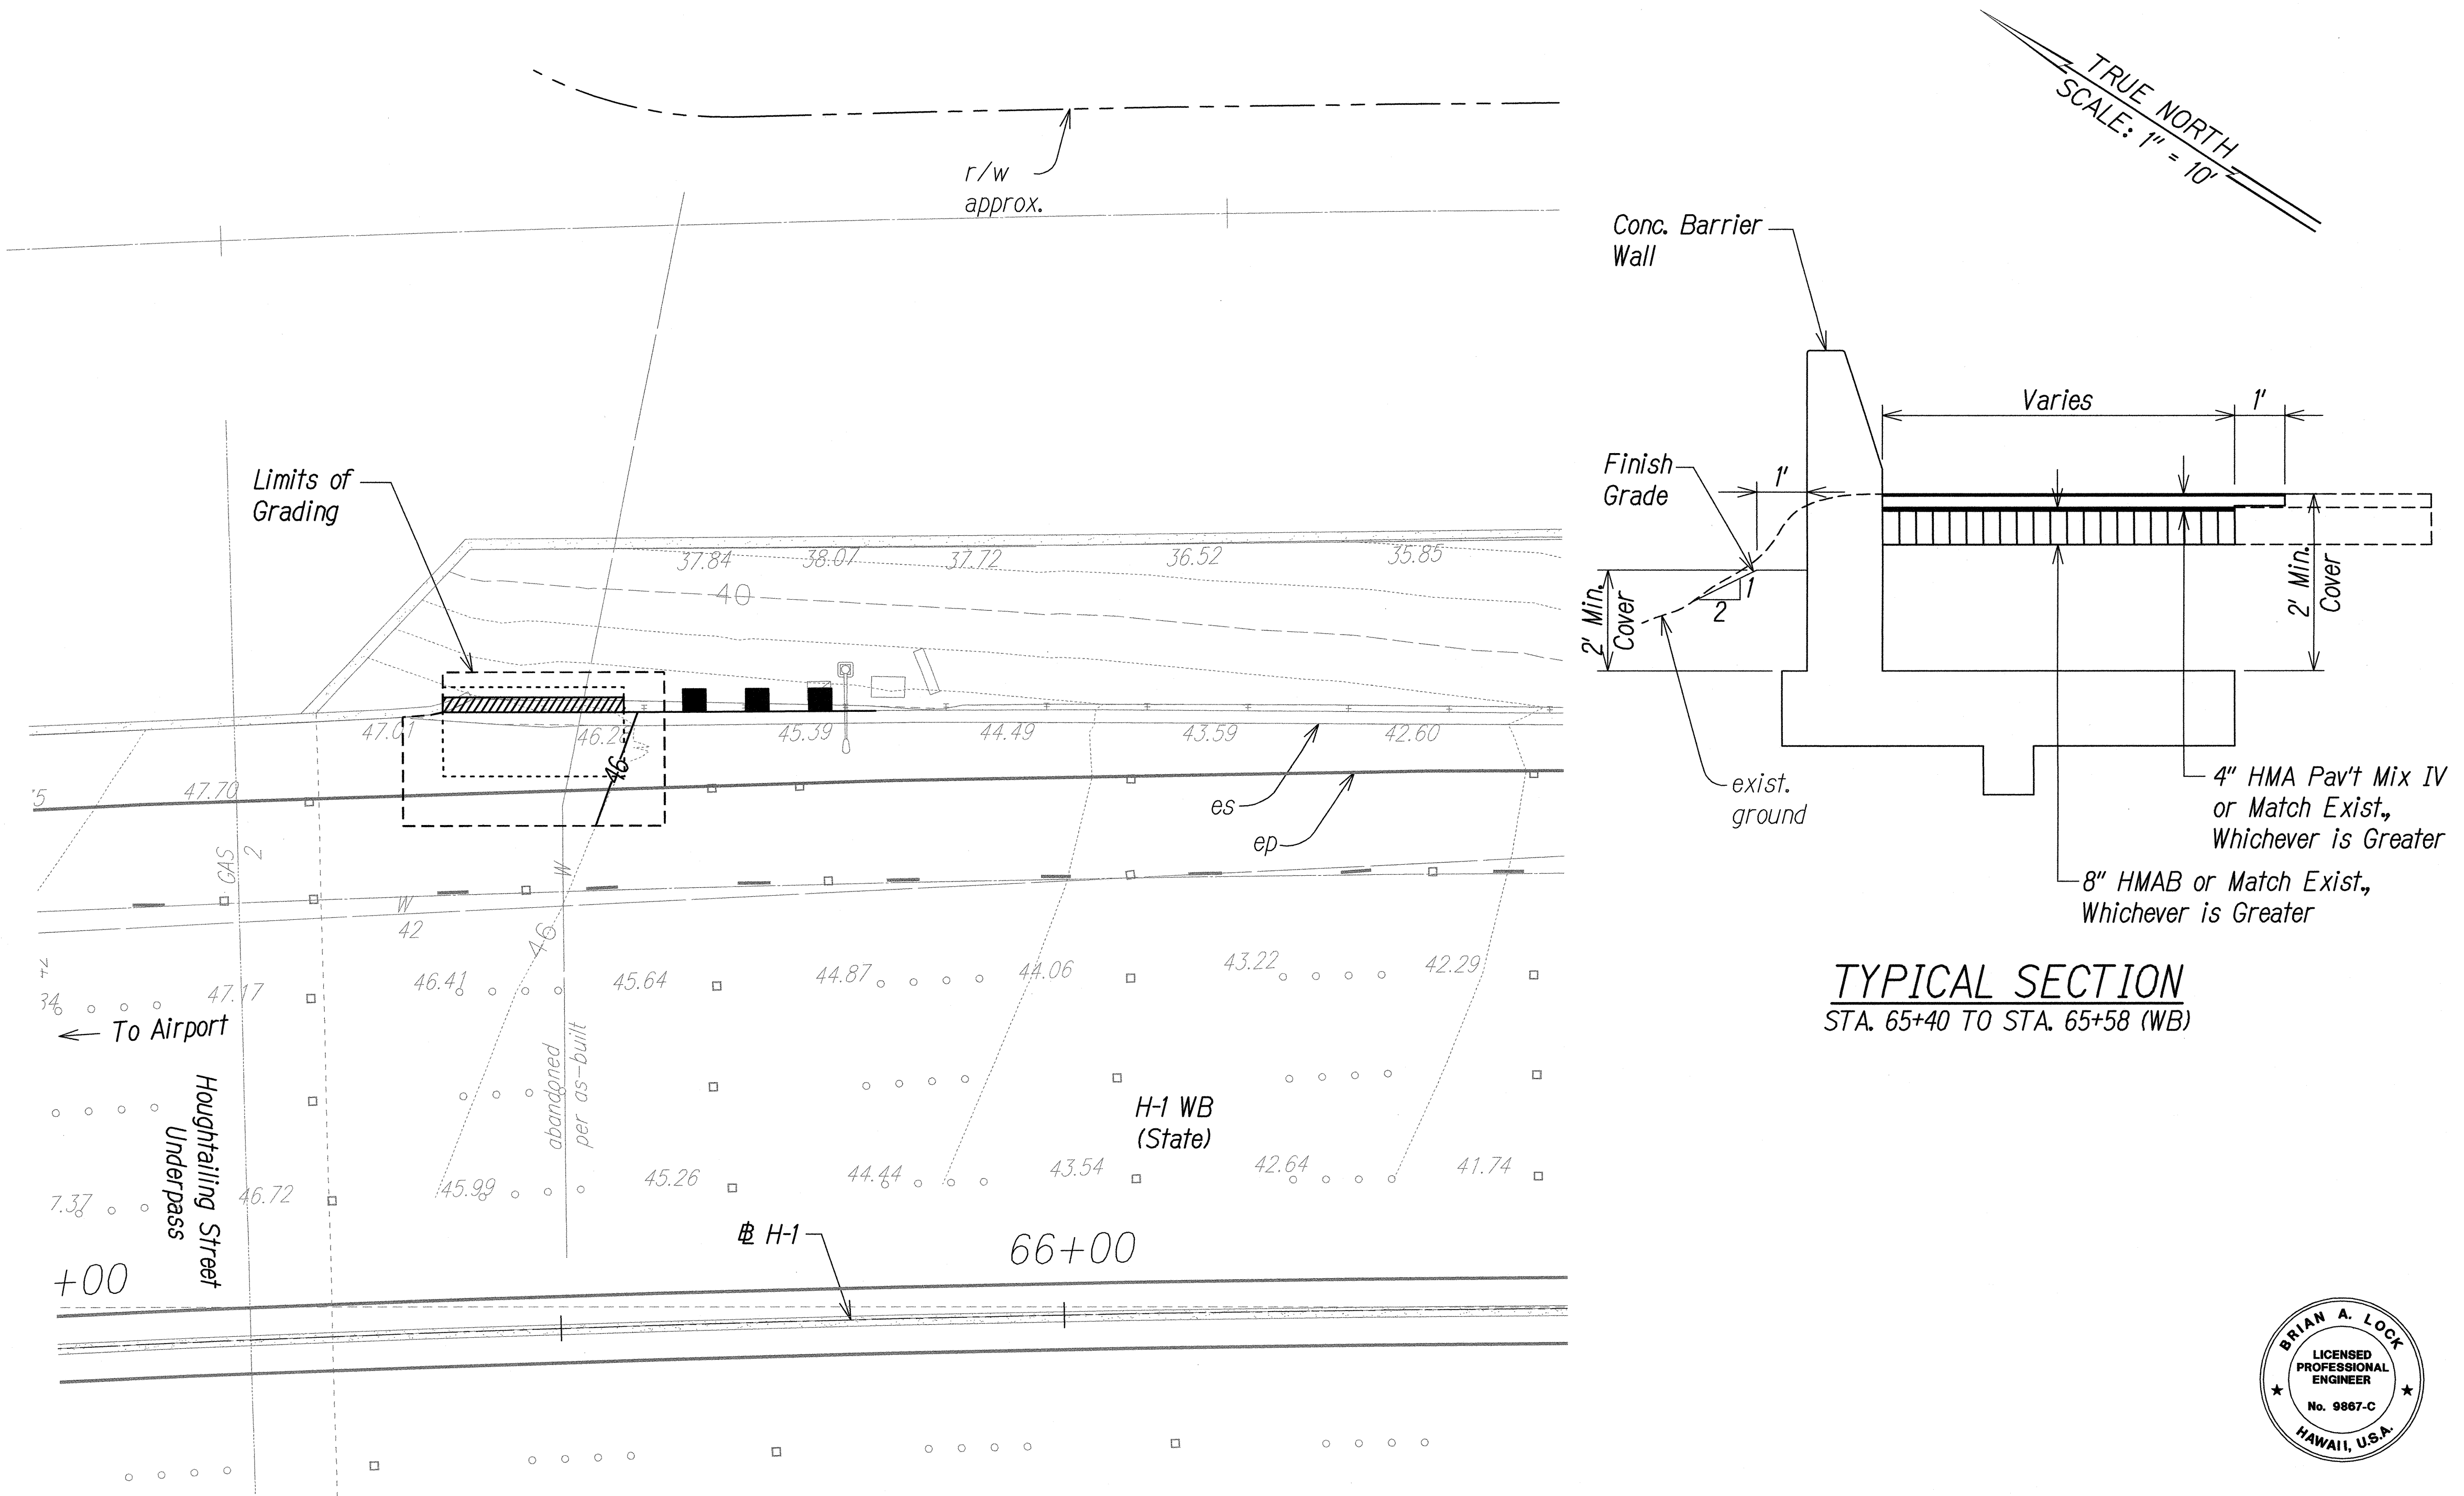

STA. 65+00 TO 66+50 (# H-1)

**Note:**


1. For Roadway Cross Section, See RS-1 to RS-16.

**GRAPHIC SCALE:**

10' 5' 0 10' 20'

SCALE: 1" = 10'

|                   |      |
|-------------------|------|
| SURVEY PLOTTED BY | DATE |
| DRAWN BY          |      |
| DESIGNED BY       |      |
| QUANTITIES BY     |      |
| CHECKED BY        |      |
| ORIGINAL PLAN     |      |
| NOTE BOOK         |      |
| No.               |      |

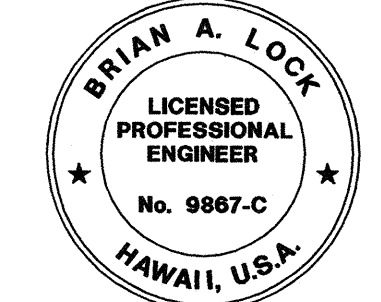

THIS WORK WAS PREPARED BY ME OR UNDER MY SUPERVISION.

*ms*

APRIL 30, 2018

WILSON OKAMOTO CORPORATION LIC. EXP. DATE

STATE OF HAWAII  
DEPARTMENT OF TRANSPORTATION  
HIGHWAYS DIVISION




**HOUGHTAILING SEPARATION  
GRADING PLAN**

INTERSTATE ROUTE H-1  
GUARDRAIL AND SHOULDER IMPROVEMENTS  
Middle Street to Punchbowl Off-Ramp  
Fed. Aid Project No. IM-H1-1(242)  
Scale: 1" = 10' Date: Mar. 2016


SHEET No. GP-3 OF 16 SHEETS



| FED. ROAD DIST. NO. | STATE | FED. AID PROJ. NO. | FISCAL YEAR | SHEET NO. | TOTAL SHEETS |
|---------------------|-------|--------------------|-------------|-----------|--------------|
| HAWAII              | HAW.  | 1M-H1-1(242)       | 2016        | 63        | 354          |

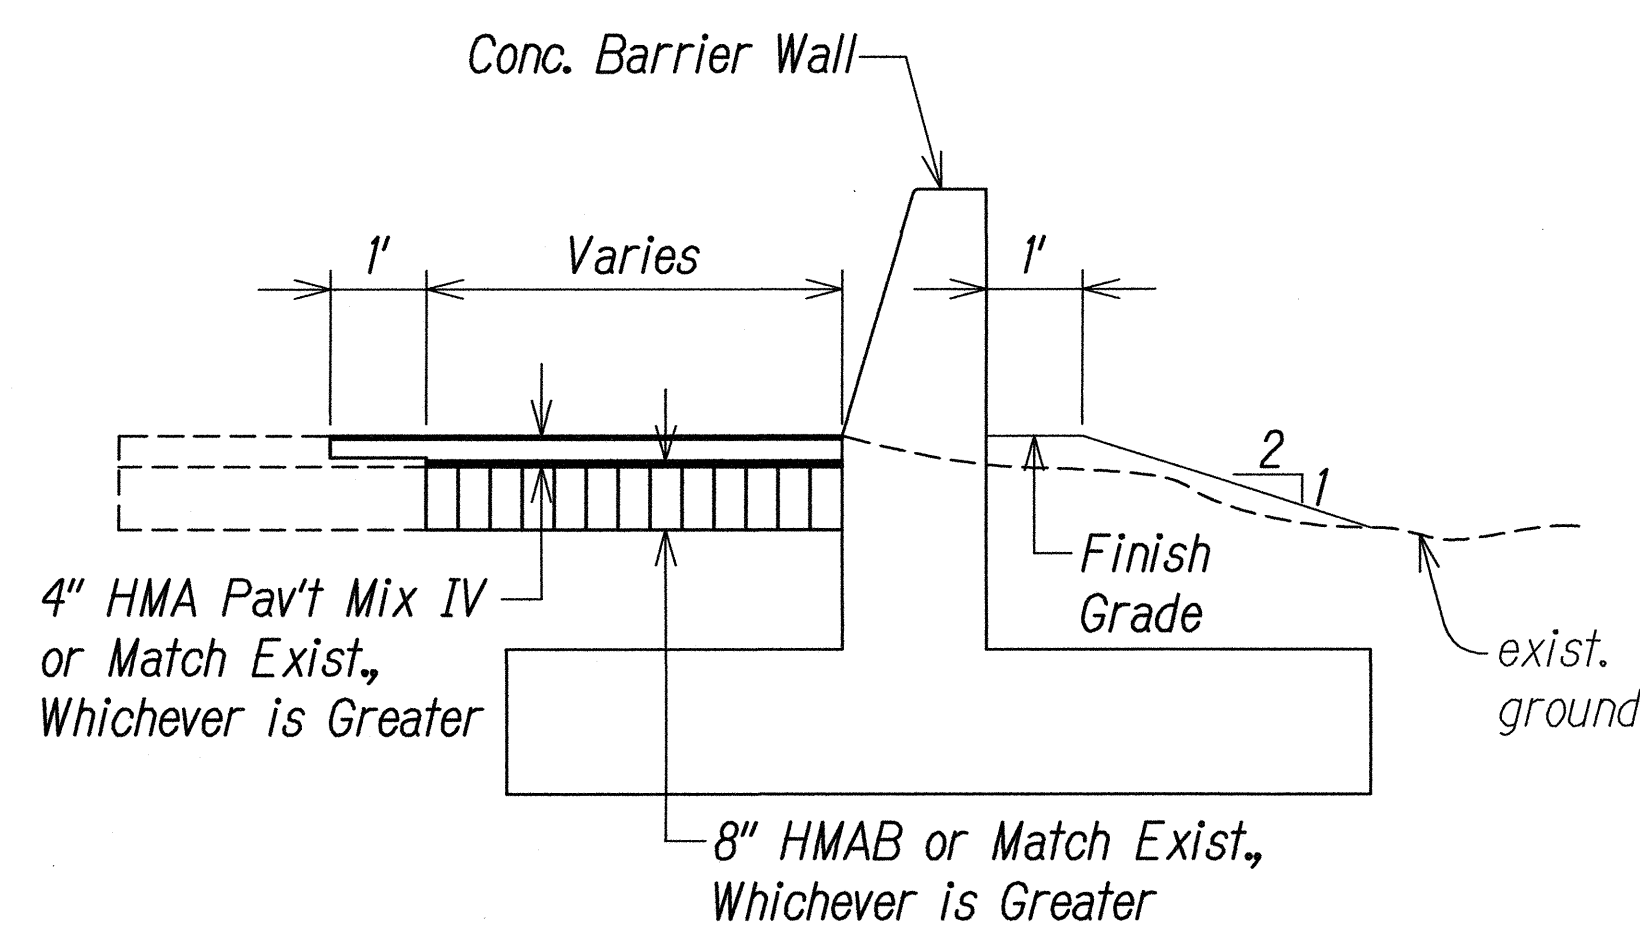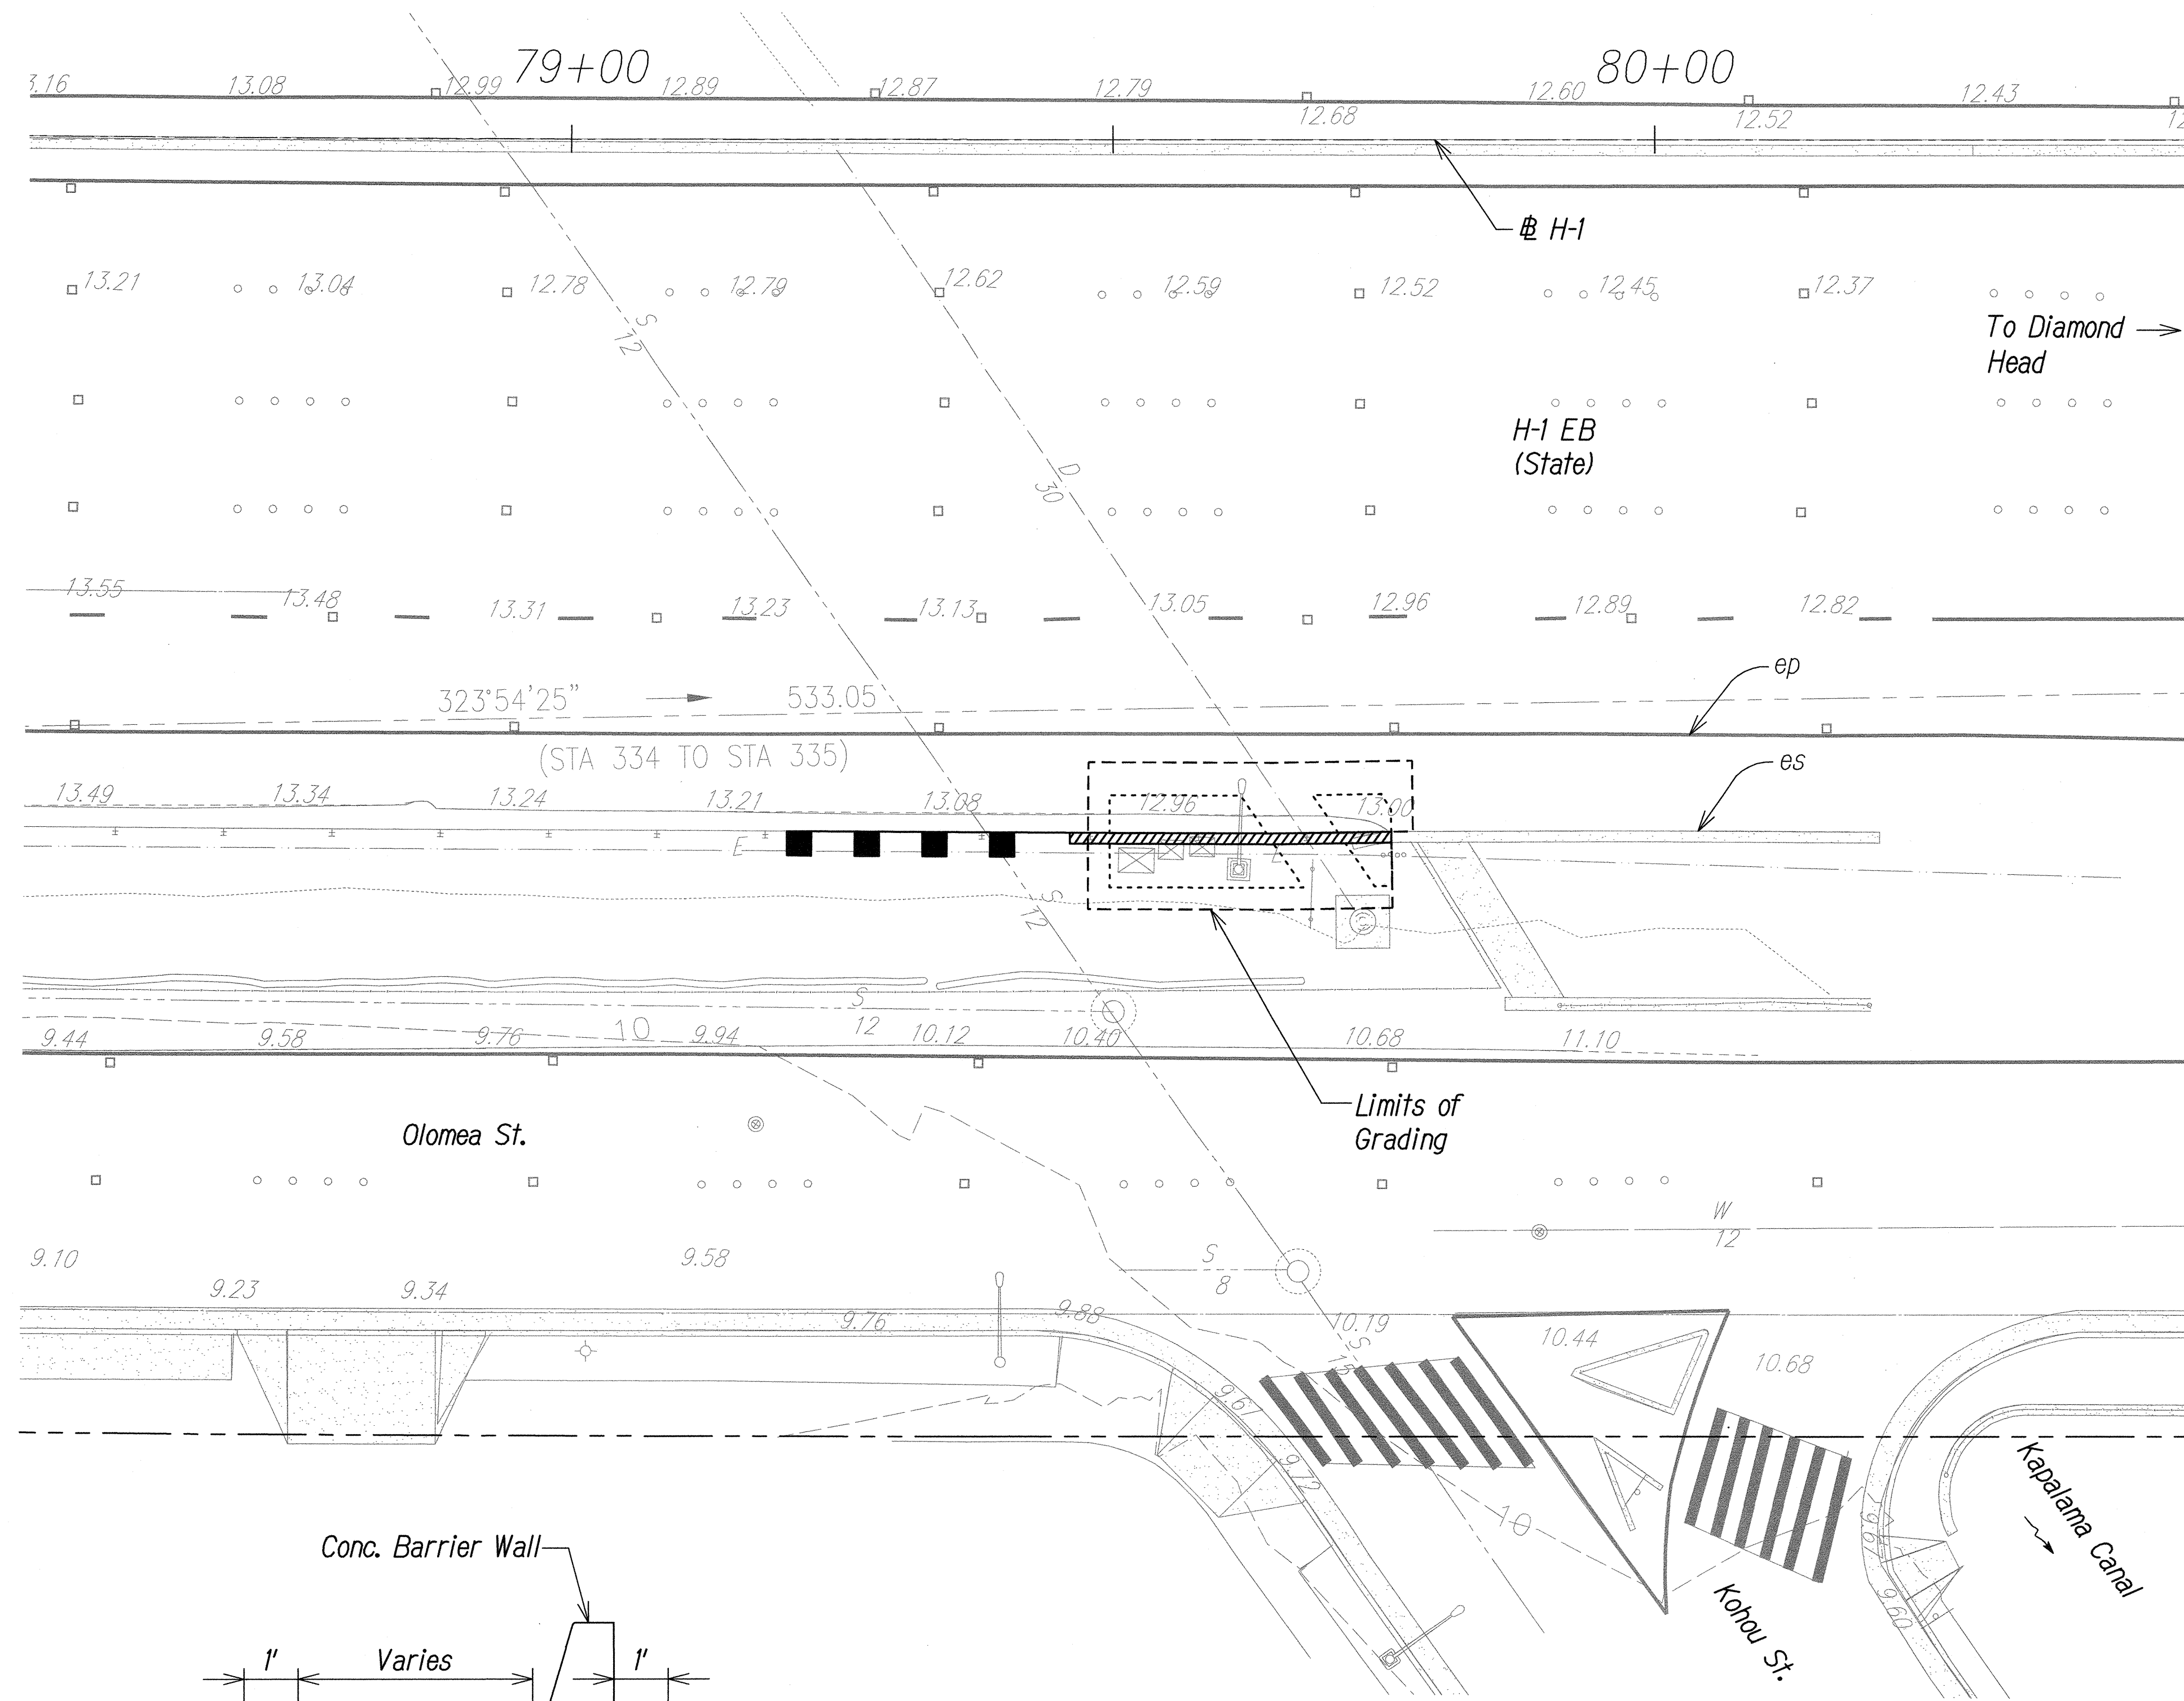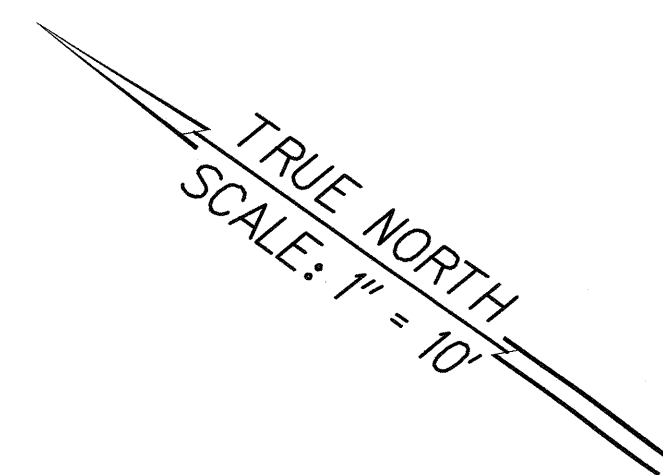

**Note:**  
1. For Roadway Cross Section, See RS-1 to RS-16.

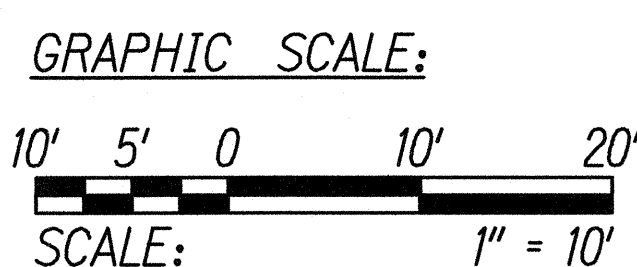

**TYPICAL SECTION**  
STA. 79+50 TO STA. 79+76 (EB)      STA. 78+50 TO 80+50 (H-1)

|               |                   |      |
|---------------|-------------------|------|
| ORIGINAL PLAN | SURVEY PLOTTED BY | DATE |
|               | DRAWN BY          |      |
|               | DESIGNED BY       |      |
|               | CHECKED BY        |      |
| NOTE BOOK     | No.               |      |
|               |                   |      |






THIS WORK WAS PREPARED BY ME  
OR UNDER MY SUPERVISION.  
*[Signature]*  
WILSON OKAMOTO CORPORATION LIC. EXP. DATE

STATE OF HAWAII  
DEPARTMENT OF TRANSPORTATION  
HIGHWAYS DIVISION  
**KAPALAMA CANAL**  
**GRADING PLAN**  
INTERSTATE ROUTE H-1  
GUARDRAIL AND SHOULDER IMPROVEMENTS  
Middle Street to Punchbowl Off-Ramp  
Fed. Aid Project No. 1M-H1-1(242)  
Scale: 1" = 10'      Date: Mar. 2016  
SHEET No. GP-4 OF 16 SHEETS



| FED. ROAD DIST. NO. | STATE | FED. AID PROJ. NO. | FISCAL YEAR | SHEET NO. | TOTAL SHEETS |
|---------------------|-------|--------------------|-------------|-----------|--------------|
| HAWAII              | HAW.  | IM-H1-1(242)       | 2016        | C.O. 64   | 354          |

TRUE NORTH  
SCALE: 1" = 10'

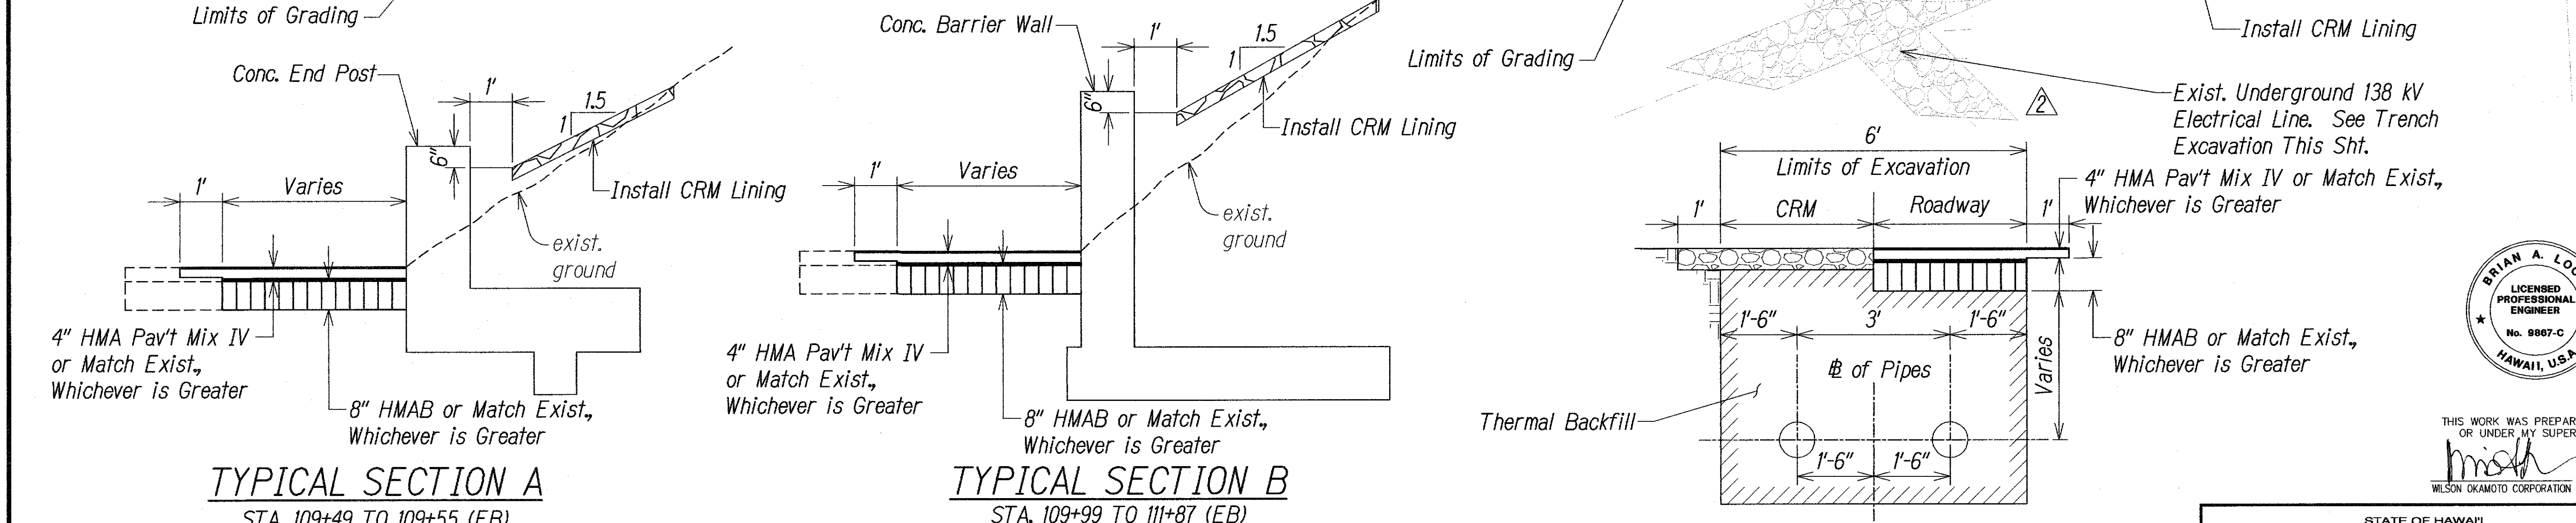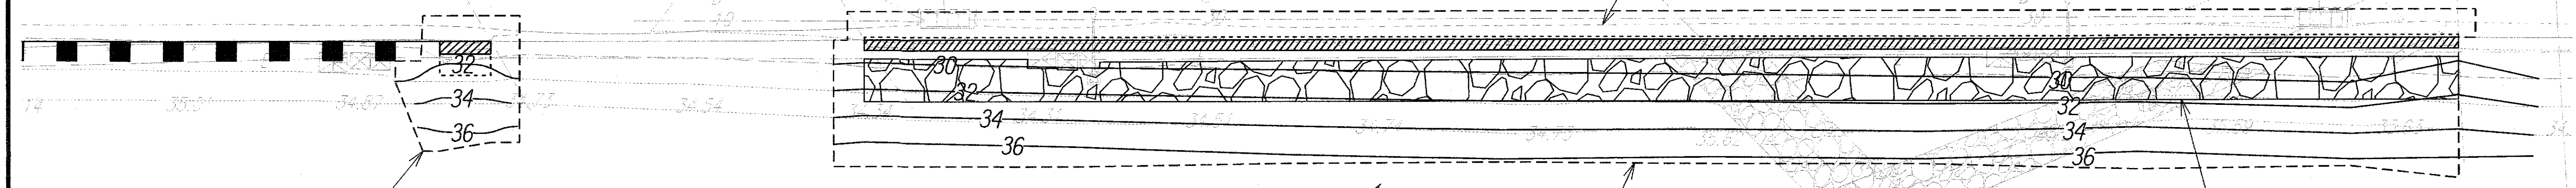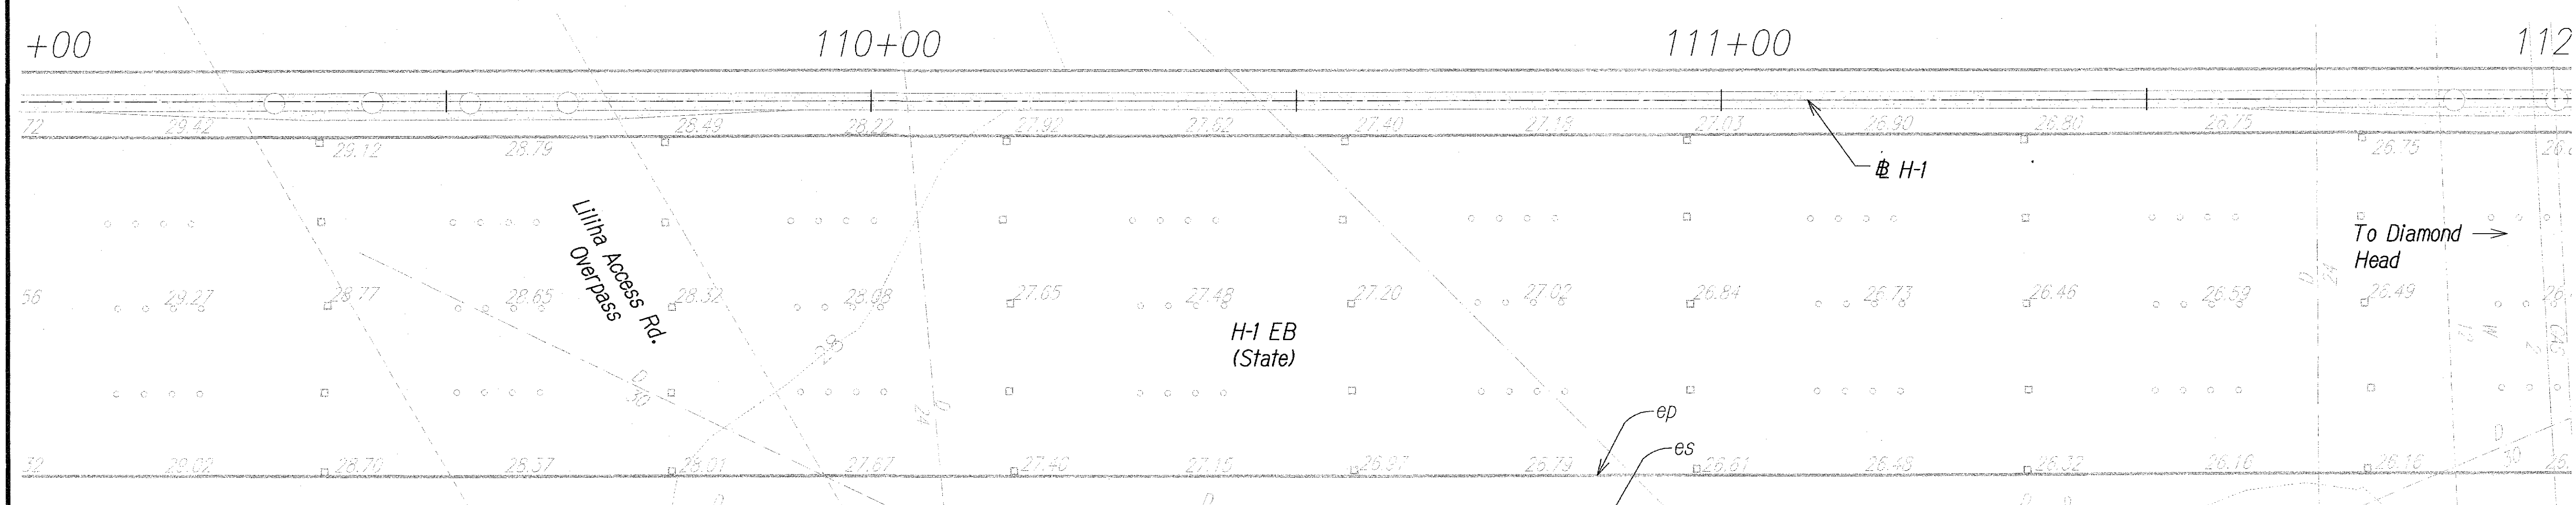

**TYPICAL SECTION A**  
STA. 109+49 TO 109+55 (EB)

**TYPICAL SECTION B**  
STA. 109+99 TO 111+87 (EB)

**STA. 109+00 TO 112+00 (# H-1)**

**ELECTRICAL TRENCH EXCAVATION**

**NOTE:**

1. For Roadway Cross Section, See RS-1 to RS-16.

**GRAPHIC SCALE:**

10' 5' 0 20'

SCALE: 1" = 10'

**REVISION**

r12/15/16 2 REVISED EXIST. ELEC. LINE



**STATE OF HAWAII**  
**DEPARTMENT OF TRANSPORTATION**  
**HIGHWAYS DIVISION**  
**LILIHA STREET OVERPASS**  
**GRADING PLAN**  
**INTERSTATE ROUTE H-1**  
**GUARDRAIL AND SHOULDER IMPROVEMENTS**  
**Middle Street to Punchbowl Off-Ramp**  
**Fed. Aid Project No. IM-H1-1(242)**  
**Scale: 1" = 10' Date: Mar. 2016**

**SHEET No. GP-5 OF 16 SHEETS**

**C.O. 64**



| FED. ROAD DIST. NO. | STATE | FED. AID PROJ. NO. | FISCAL YEAR | SHEET NO. | TOTAL SHEETS |
|---------------------|-------|--------------------|-------------|-----------|--------------|
| HAWAII              | HAW.  | 1M-H1-1(242)       | 2016        | C.O. 65   | 354          |

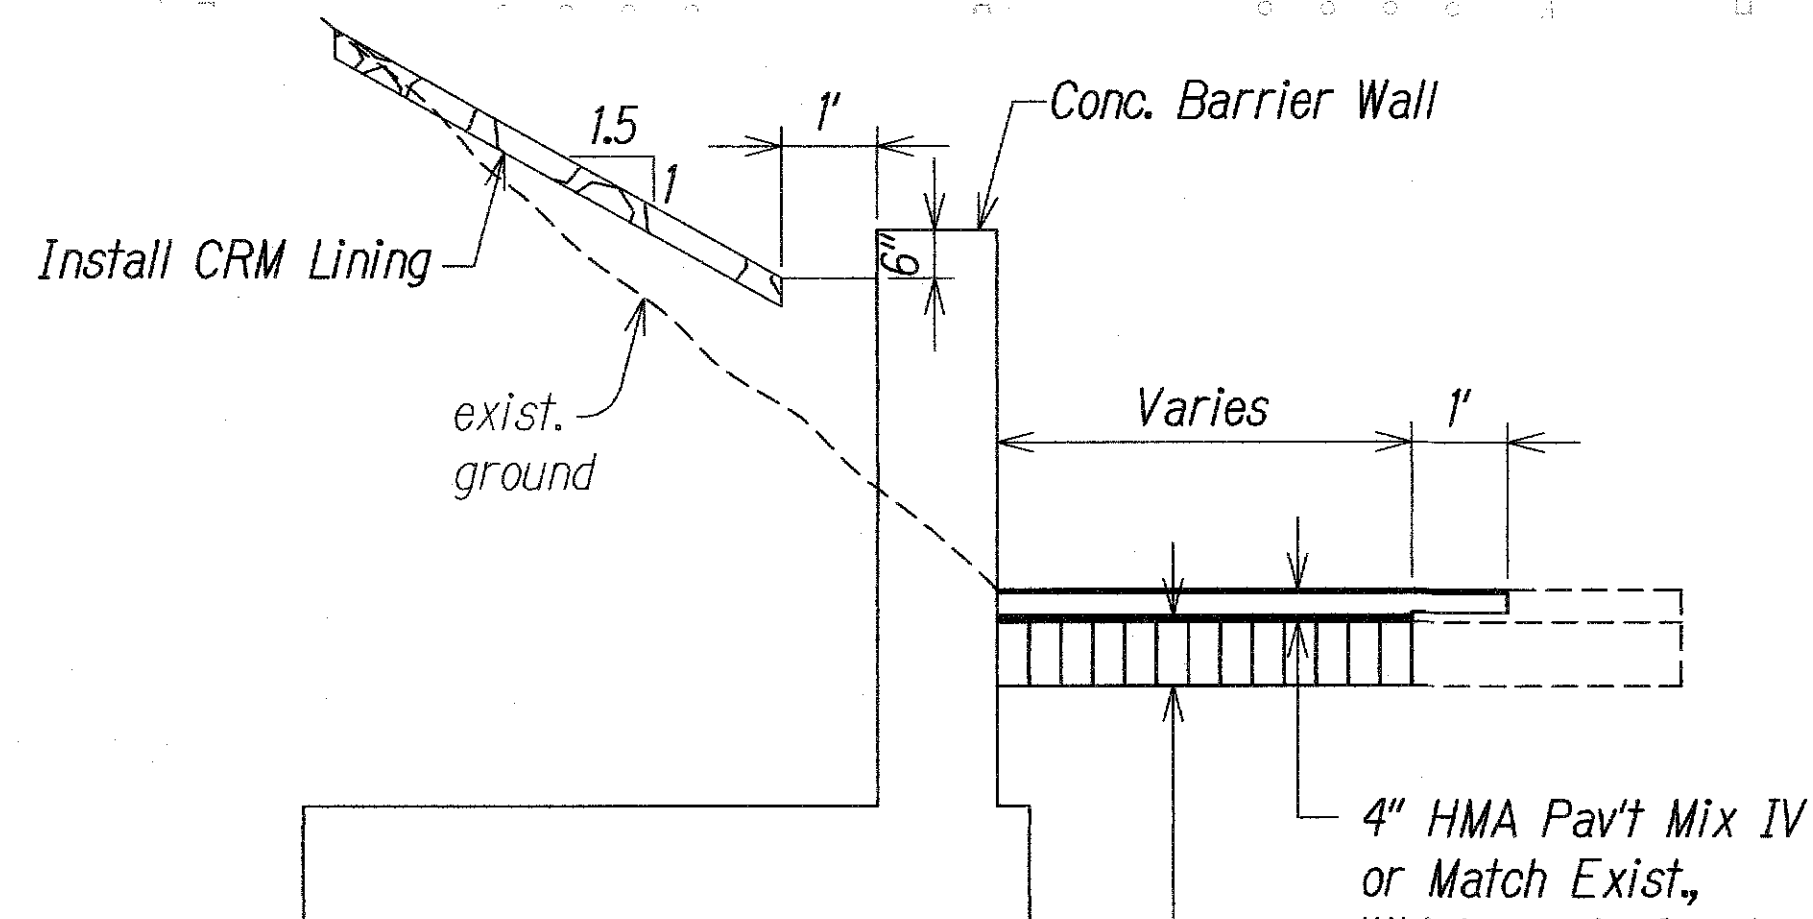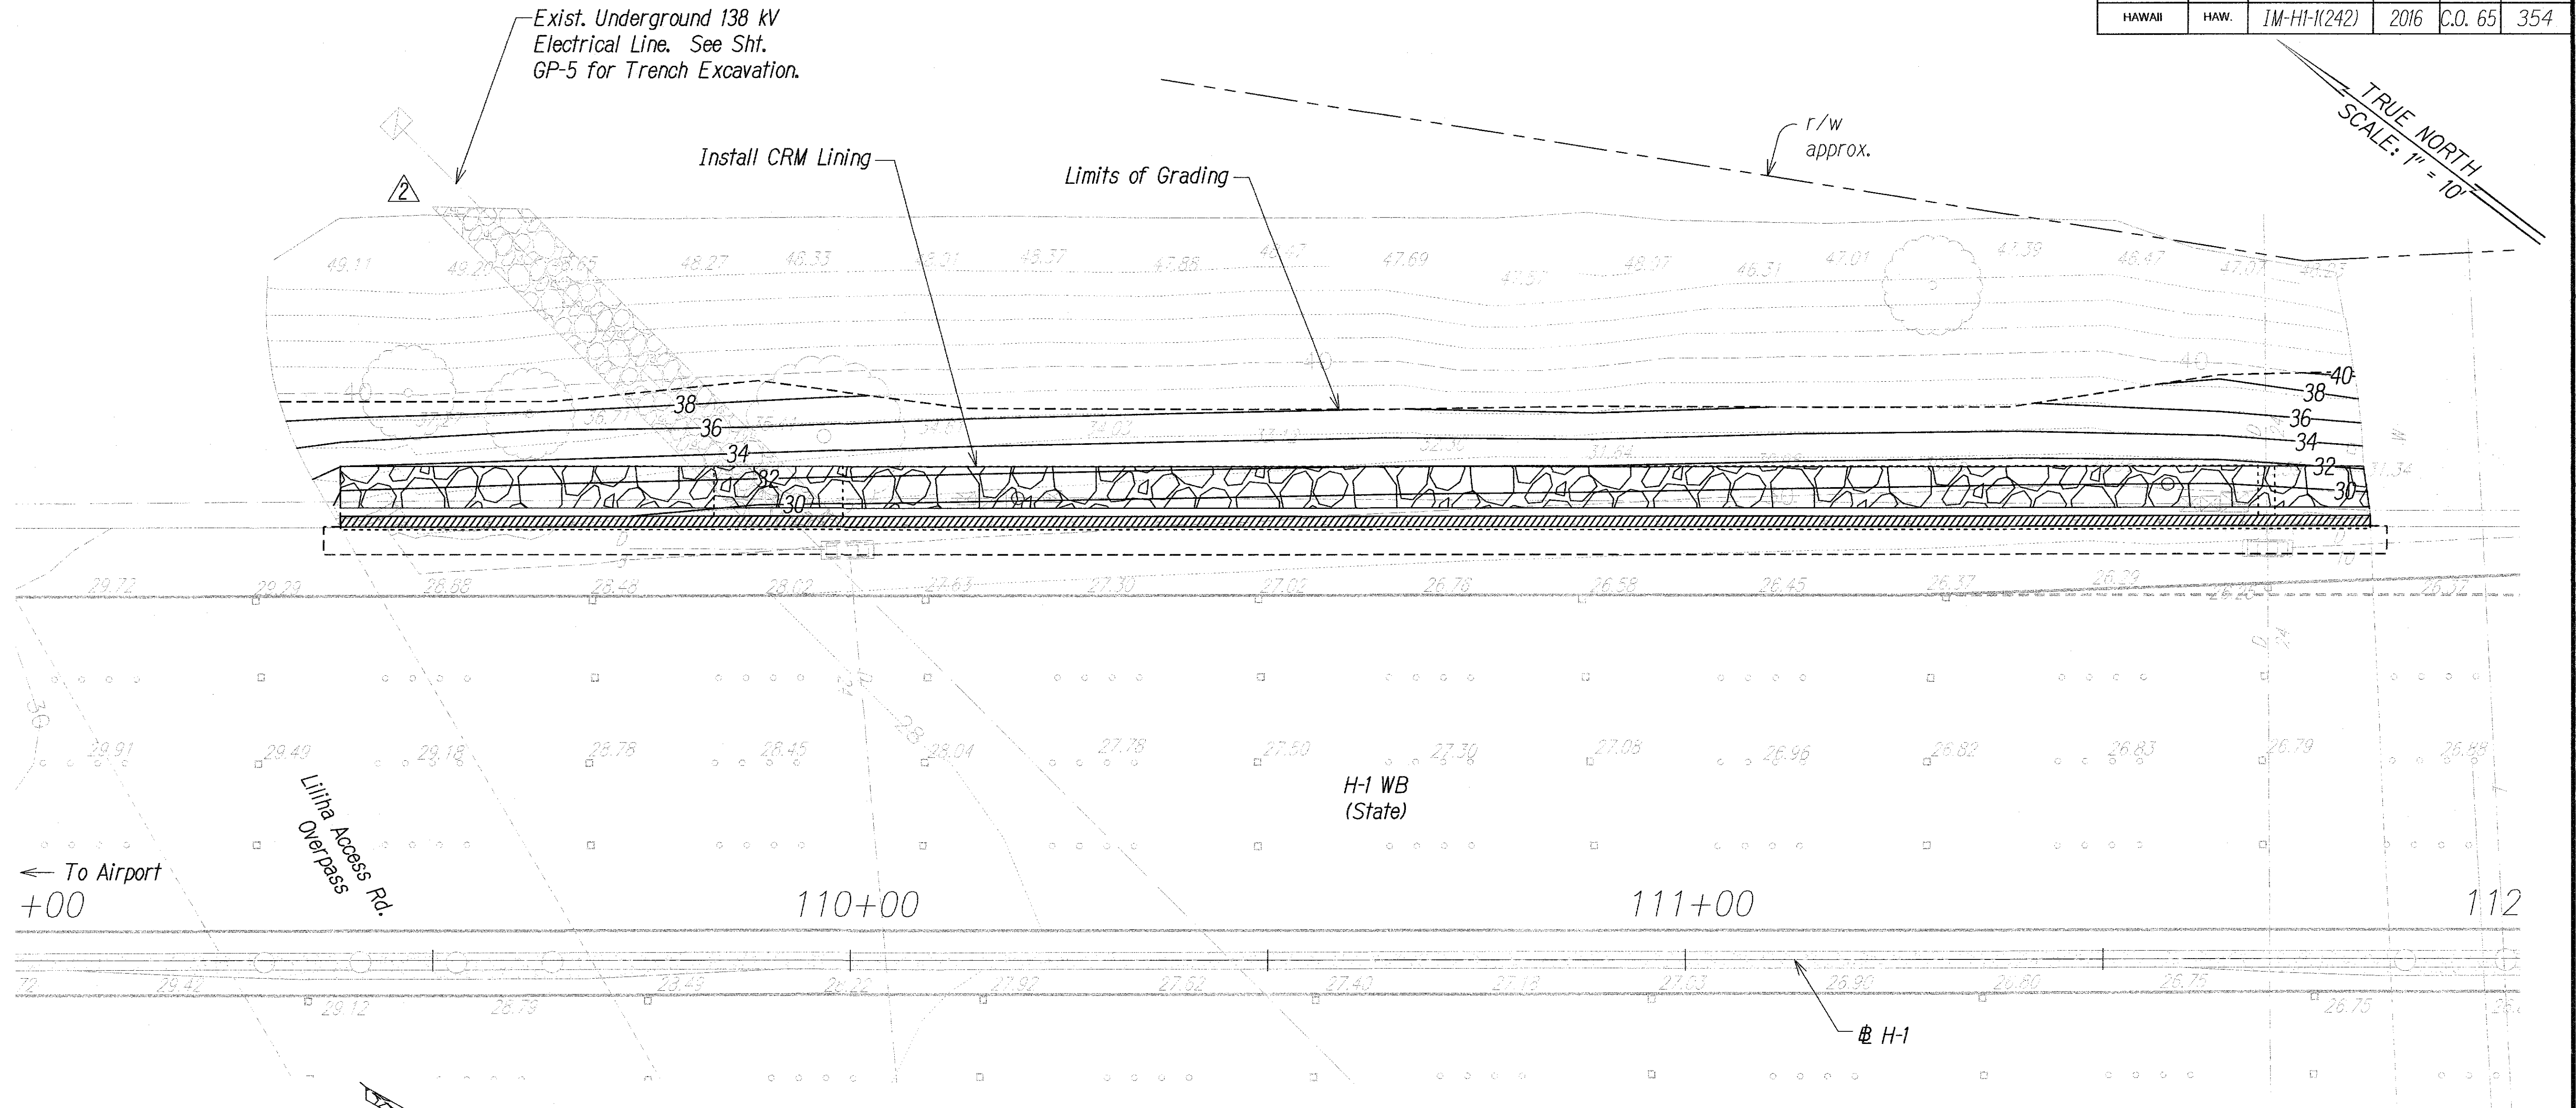


**TYPICAL SECTION**  
STA. 109+39 TO 111+82 (WB)

STA. 109+00 TO 112+00 (# H-1)

**Note:**  
1. For Roadway Cross Section, See RS-1 to RS-16.

**GRAPHIC SCALE:**  
10' 5' 0' 10' 20'  
SCALE: 1" = 10'

|                   |      |
|-------------------|------|
| SURVEY PLOTTED BY | DATE |
| DRAWN BY          |      |
| DESIGNED BY       |      |
| QUANTITIES BY     |      |
| CHECKED BY        |      |
| ORIGINAL PLAN     |      |
| NOTE BOOK         |      |
| No.               |      |

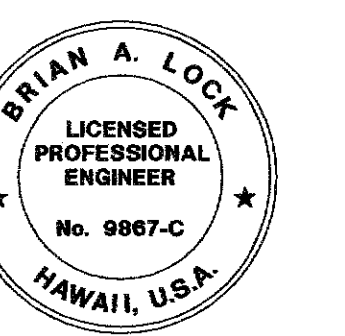


THIS WORK WAS PREPARED BY ME OR UNDER MY SUPERVISION.  
*msh*  
WILSON OKAMOTO CORPORATION LIC. EXP. DATE

STATE OF HAWAII  
DEPARTMENT OF TRANSPORTATION  
HIGHWAYS DIVISION  
**LILIHA STREET OVERPASS**  
**GRADING PLAN**  
INTERSTATE ROUTE H-1  
GUARDRAIL AND SHOULDER IMPROVEMENTS  
Middle Street to Punchbowl Off-Ramp  
Fed. Aid Project No. 1M-H1-1(242)  
Scale: 1" = 10' Date: Mar. 2016  
SHEET No. 6P-6 OF 16 SHEETS


| DATE     | REVISION                    |
|----------|-----------------------------|
| 12/15/16 | 2 REVISED EXIST. ELEC. LINE |




| FED. ROAD DIST. NO. | STATE | FED. AID PROJ. NO. | FISCAL YEAR | SHEET NO. | TOTAL SHEETS |
|---------------------|-------|--------------------|-------------|-----------|--------------|
| HAWAII              | HAW.  | IM-H1-1(242)       | 2016        | 66        | 354          |

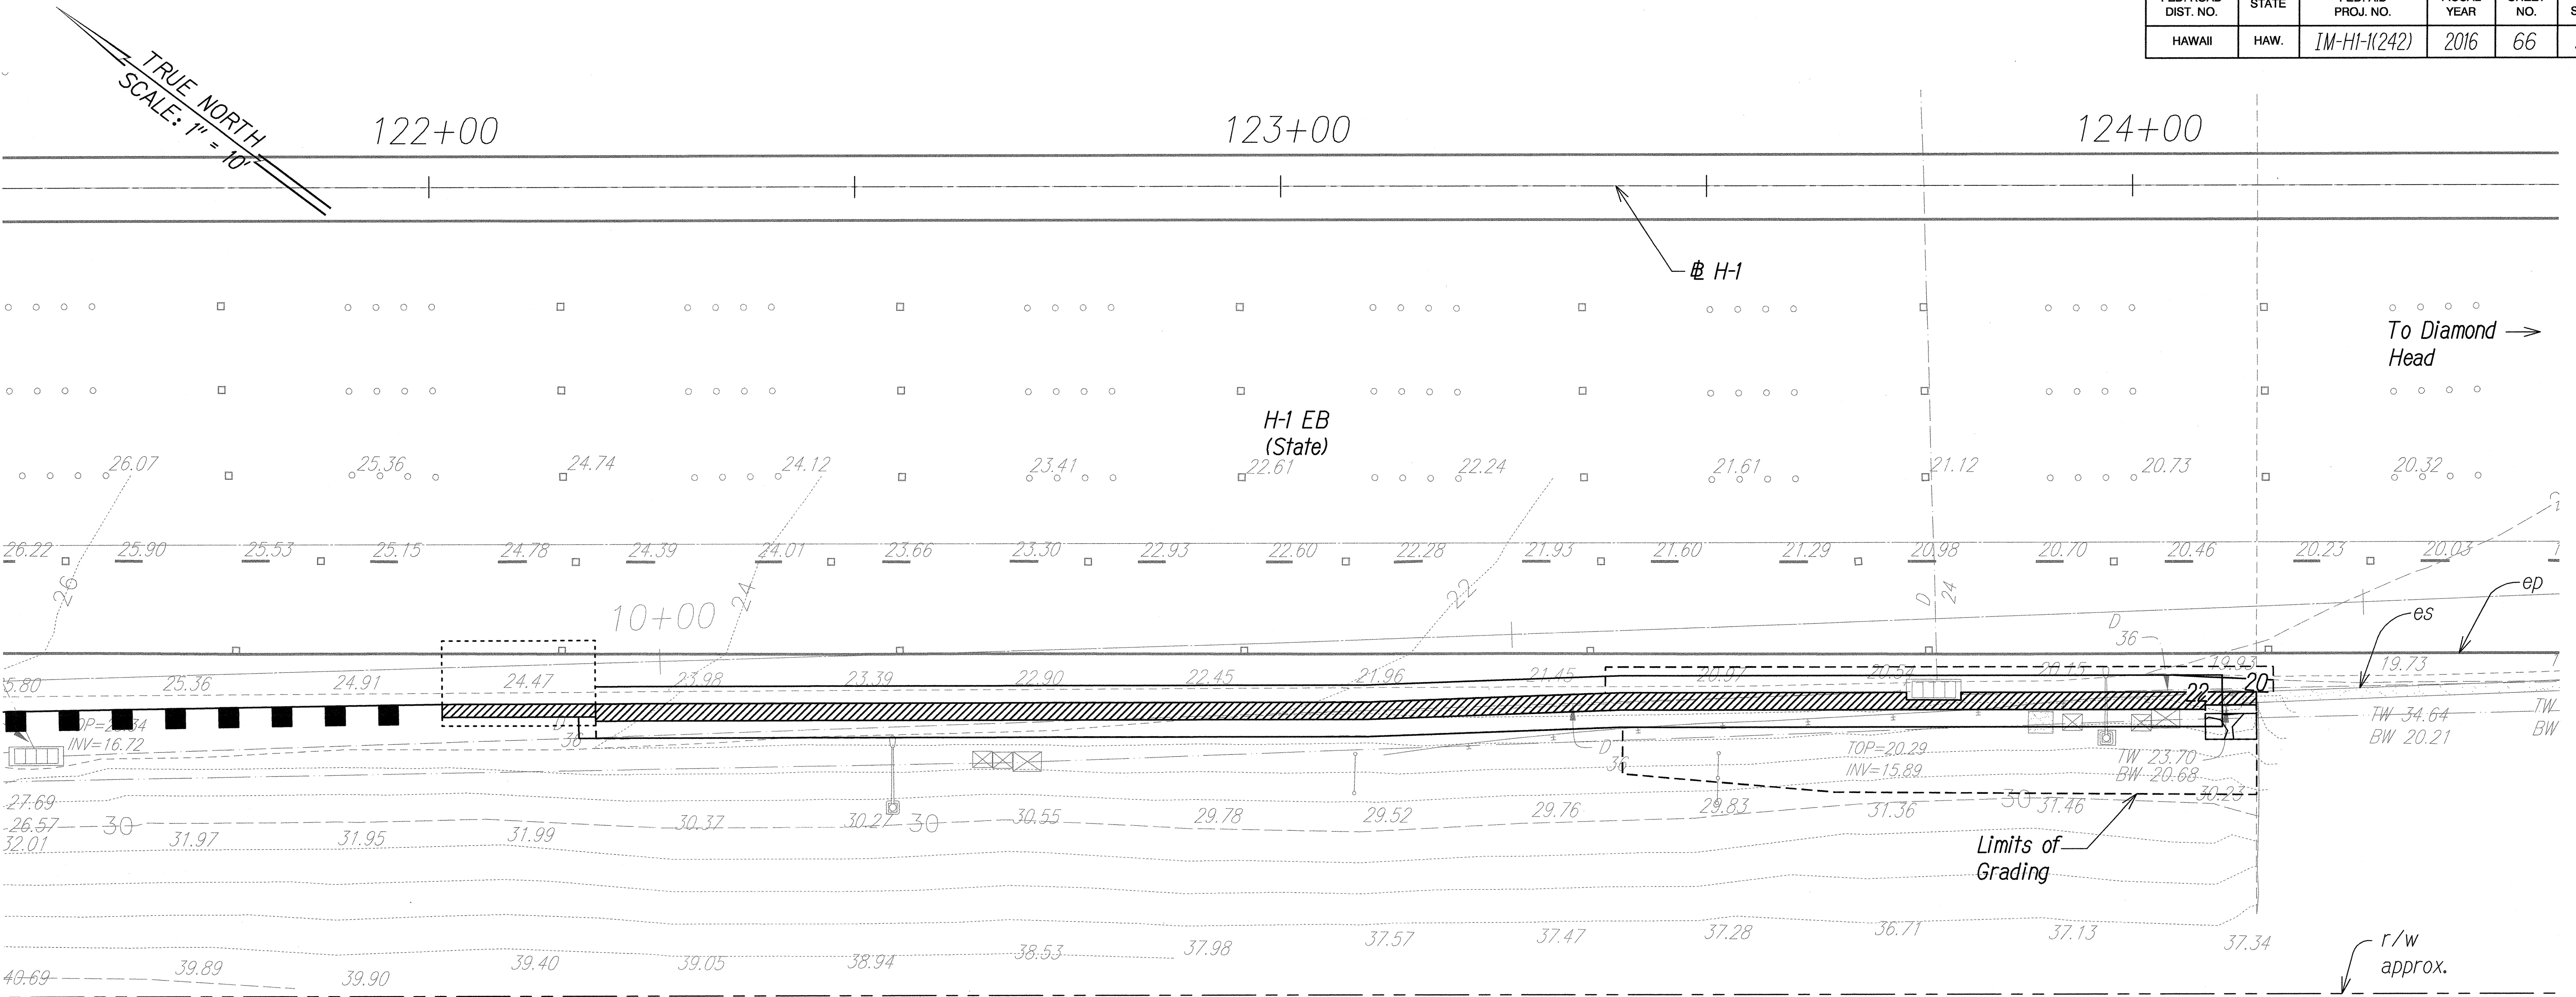


STA. 121+50 TO 124+50 (# H-1)

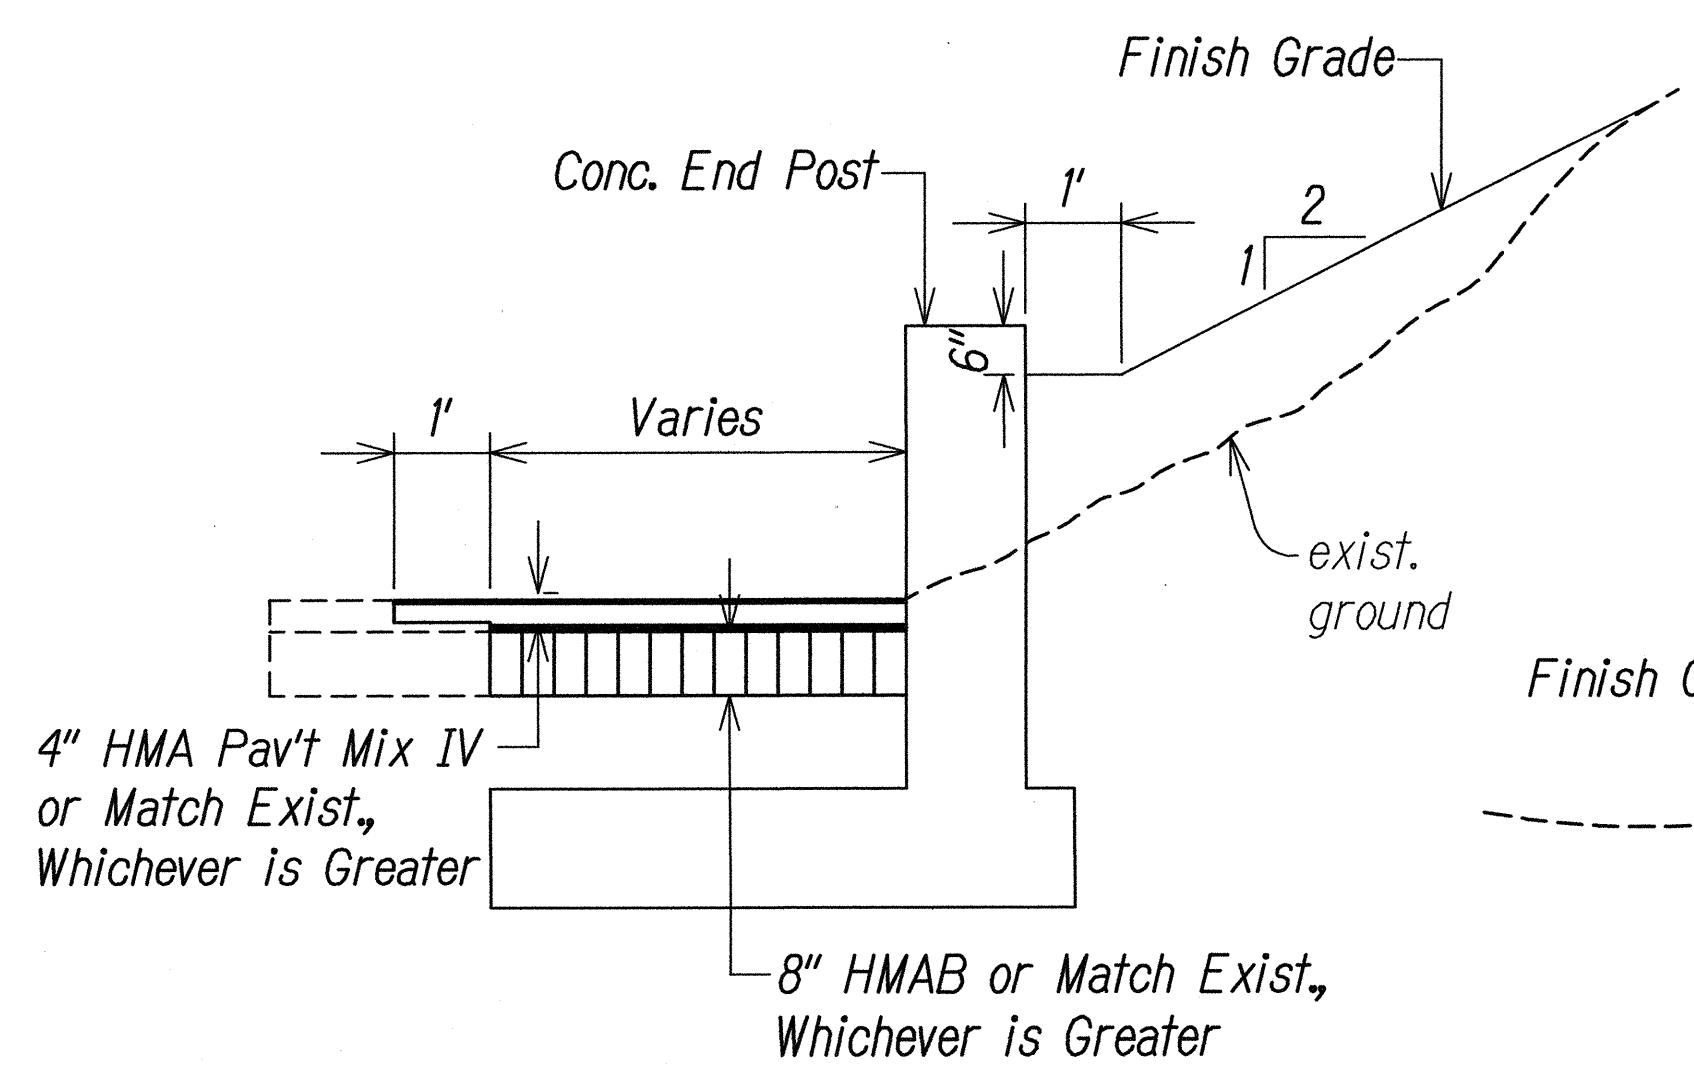

TYPICAL SECTION A  
STA. 122+01 TO STA. 122+20 (EB)

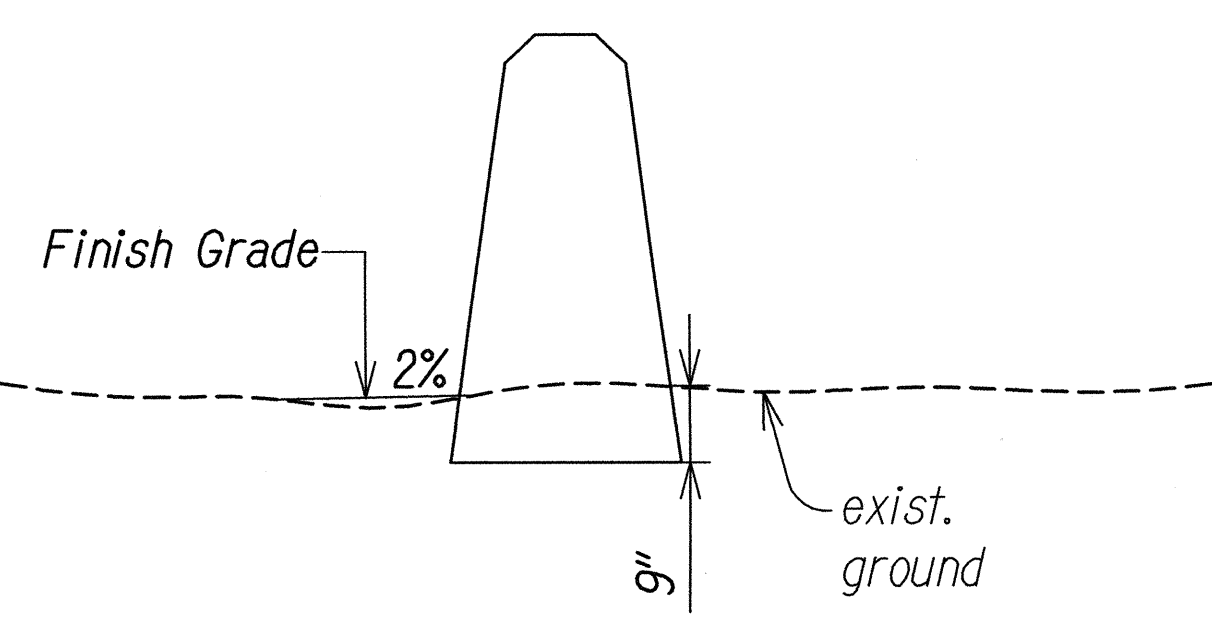

TYPICAL SECTION B  
STA. 122+20 TO STA. 124+08 (EB)

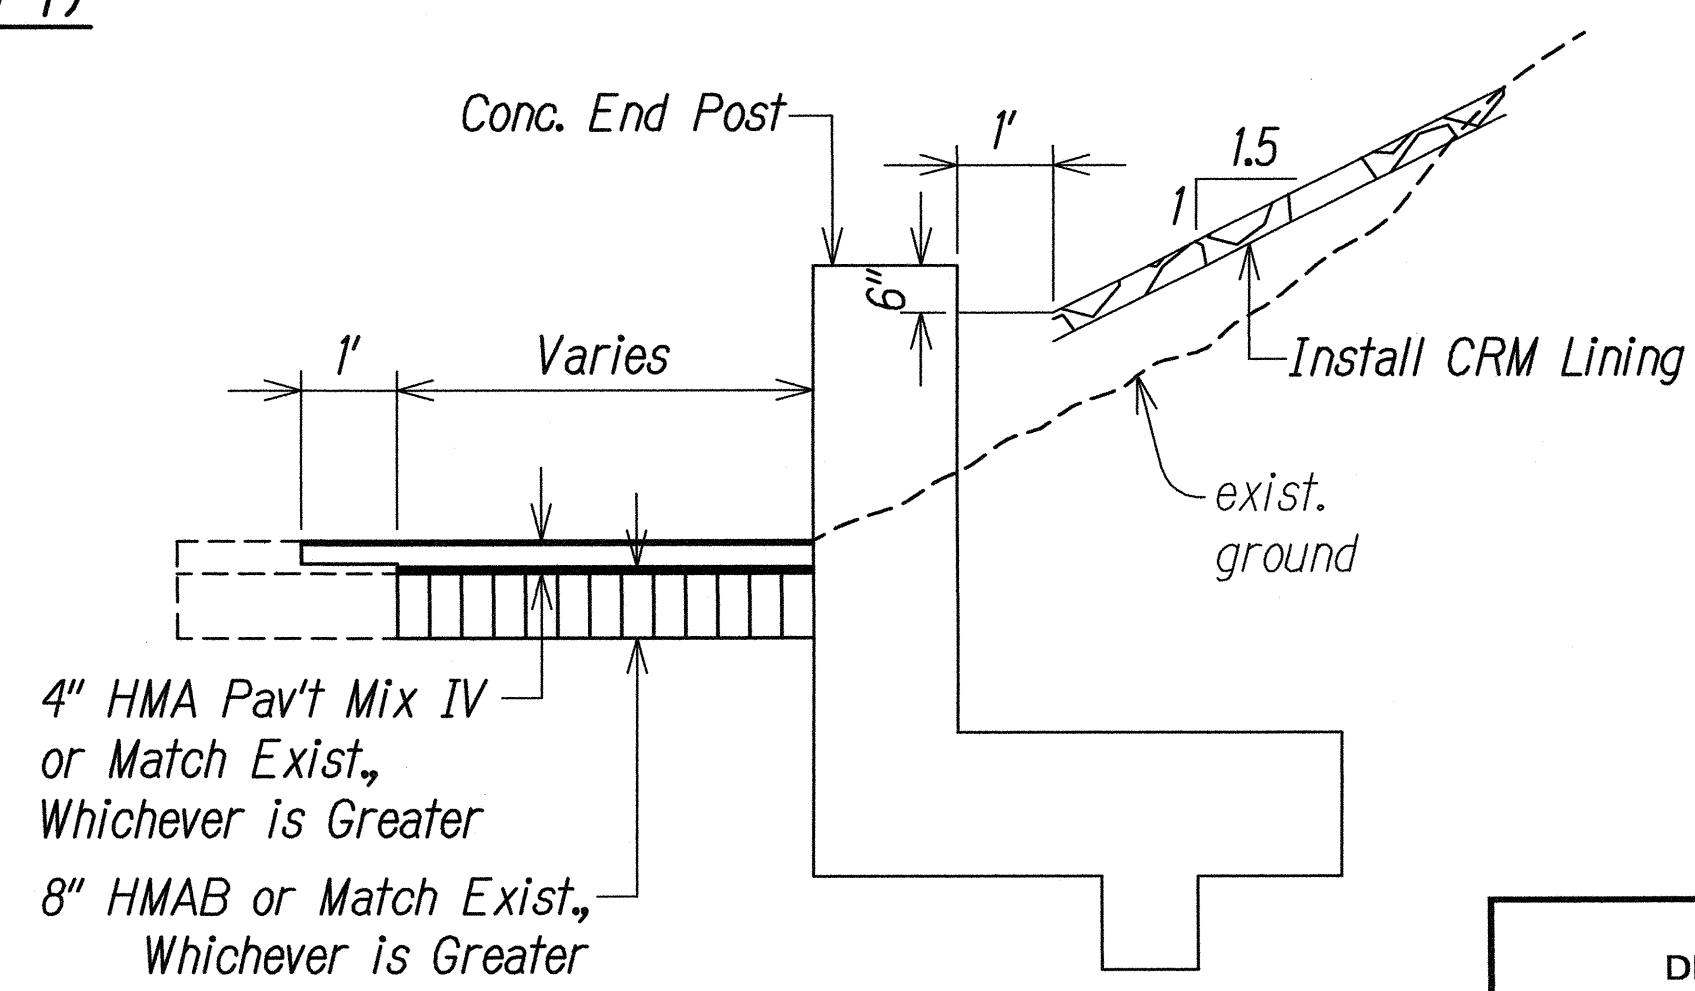


TYPICAL SECTION C  
STA. 124+08 TO STA. 124+14 (EB)

**Note:**  
1. For Roadway Cross Section, See RS-1 to RS-16.

**GRAPHIC SCALE:**  
10' 5' 0' 10' 20'  
SCALE: 1" = 10'

|               |                   |      |
|---------------|-------------------|------|
| ORIGINAL PLAN | SURVEY PLOTTED BY | DATE |
| NOTE BOOK     | DRAWN BY          |      |
|               | DESIGNED BY       |      |
|               | CHECKED BY        |      |
|               | NO.               |      |

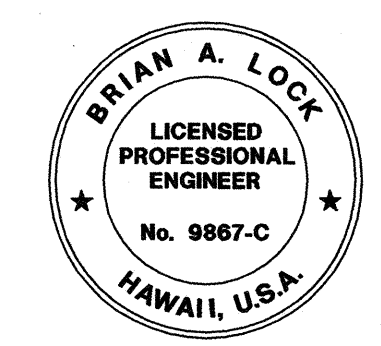


THIS WORK WAS PREPARED BY ME OR UNDER MY SUPERVISION.  
*mell*  
WILSON OKAMOTO CORPORATION L.C. EXP. DATE APRIL 30, 2018

STATE OF HAWAII  
DEPARTMENT OF TRANSPORTATION  
HIGHWAYS DIVISION


**AALA STREET & NUUANU STREAM**  
**GRADING PLAN**  
INTERSTATE ROUTE H-1  
GUARDRAIL AND SHOULDER IMPROVEMENTS  
Middle Street to Punchbowl Off-Ramp  
Fed. Aid Project No. IM-H1-1(242)  
Scale: 1" = 10' Date: Mar. 2016  
SHEET No. 66-7 OF 16 SHEETS




| FED. ROAD DIST. NO. | STATE | FED. AID PROJ. NO. | FISCAL YEAR | SHEET NO. | TOTAL SHEETS |
|---------------------|-------|--------------------|-------------|-----------|--------------|
| HAWAII              | HAW.  | 1M-H1-1(242)       | 2016        | 67        | 354          |

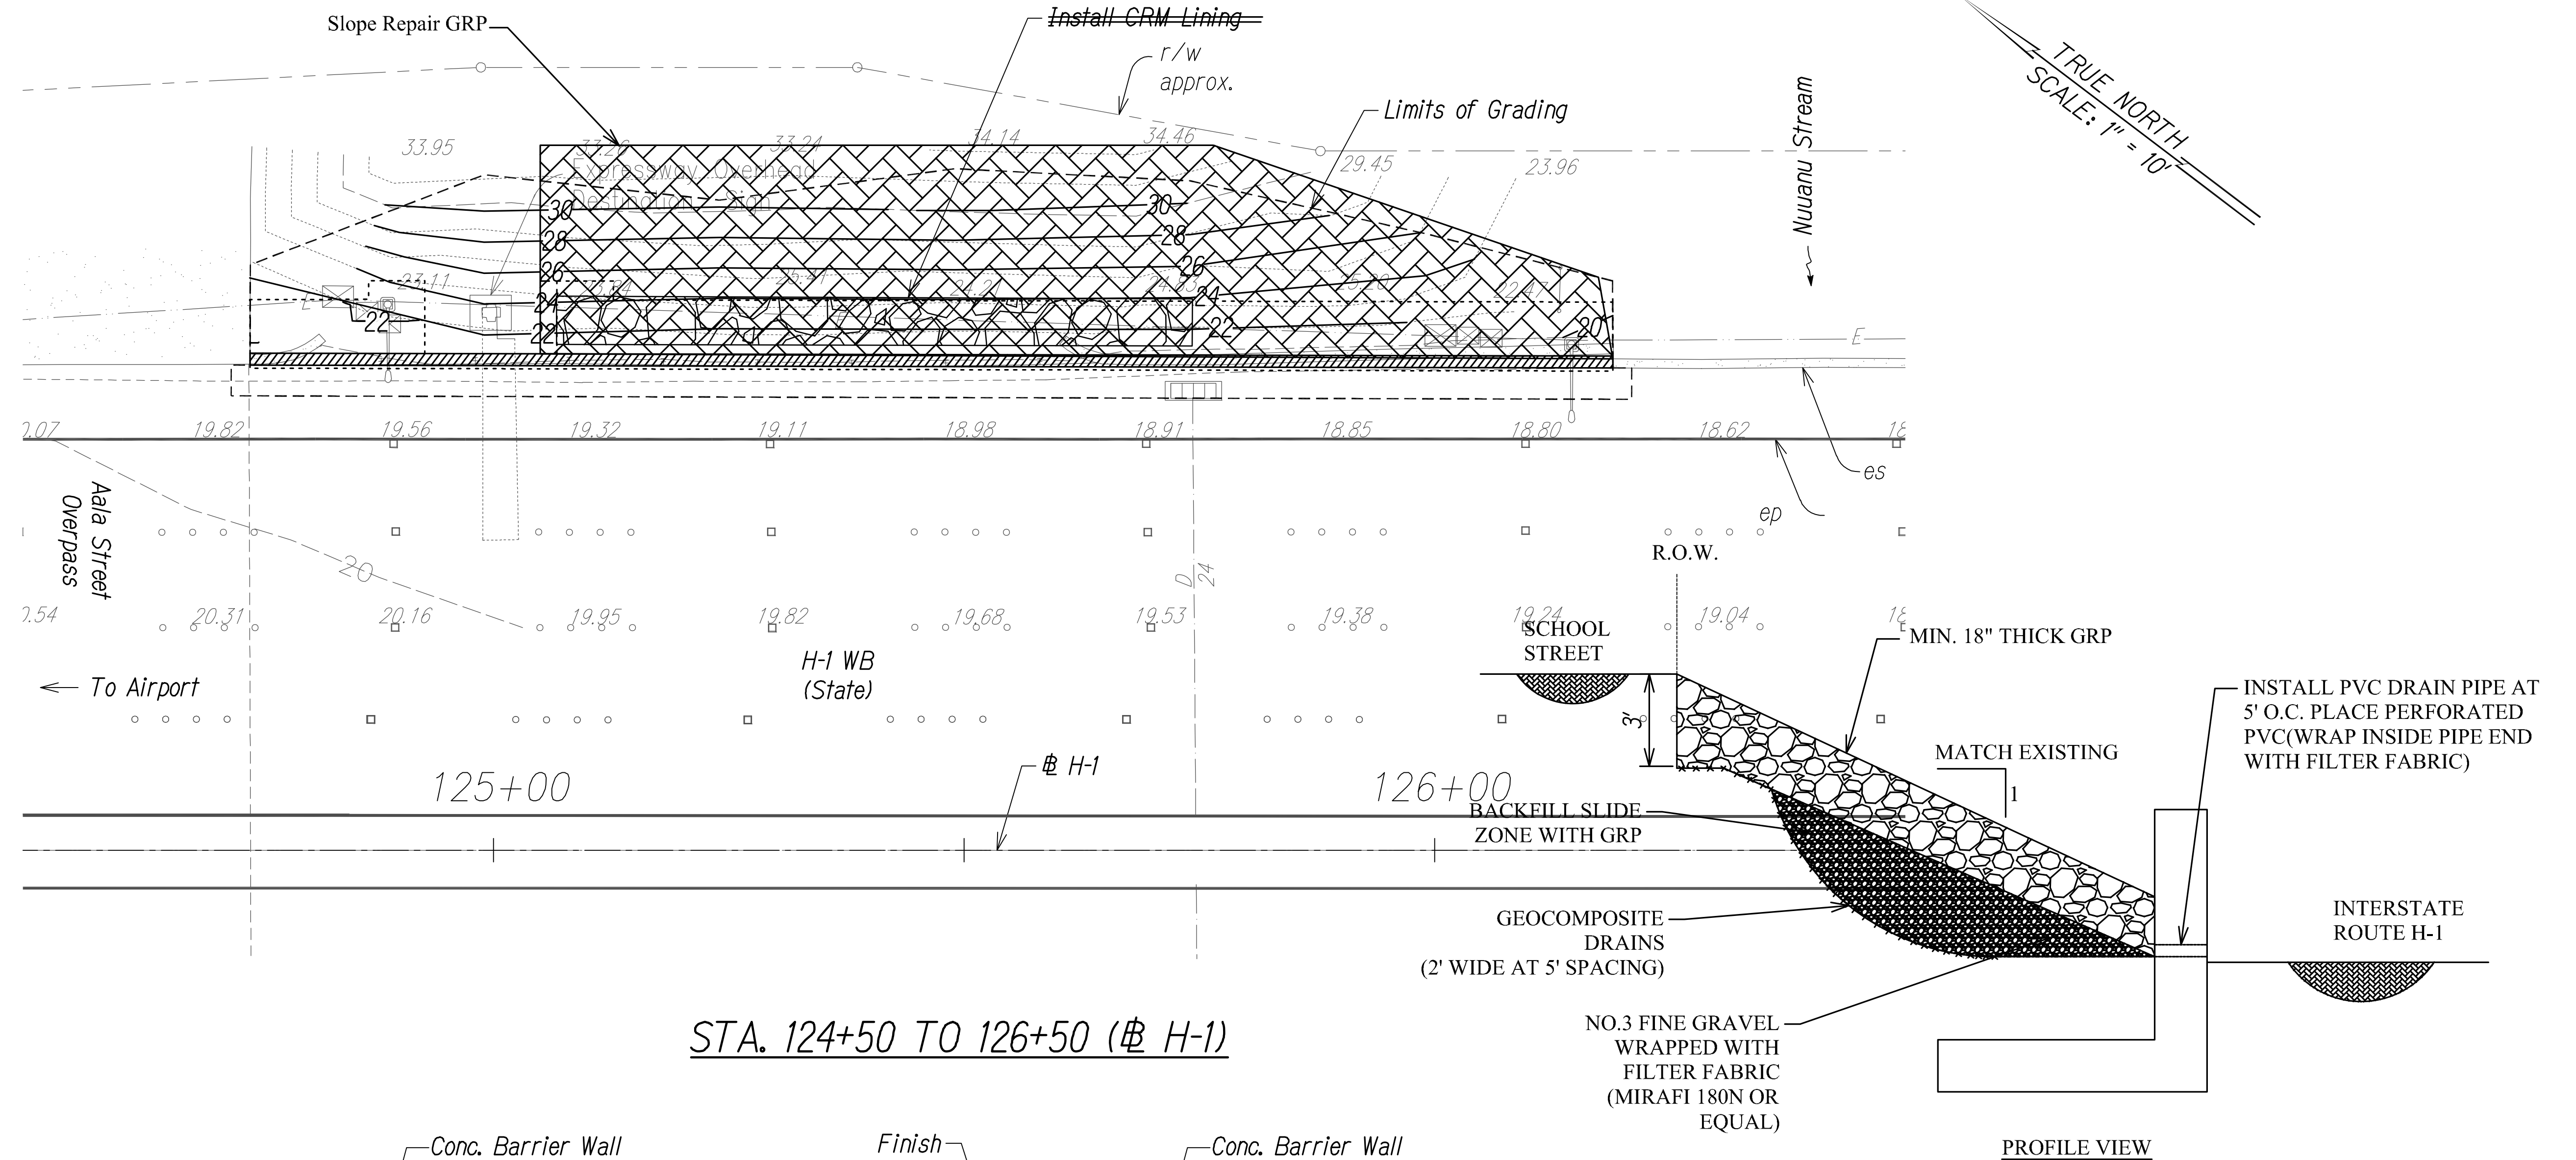

STA. 124+50 TO 126+50 (# H-1)

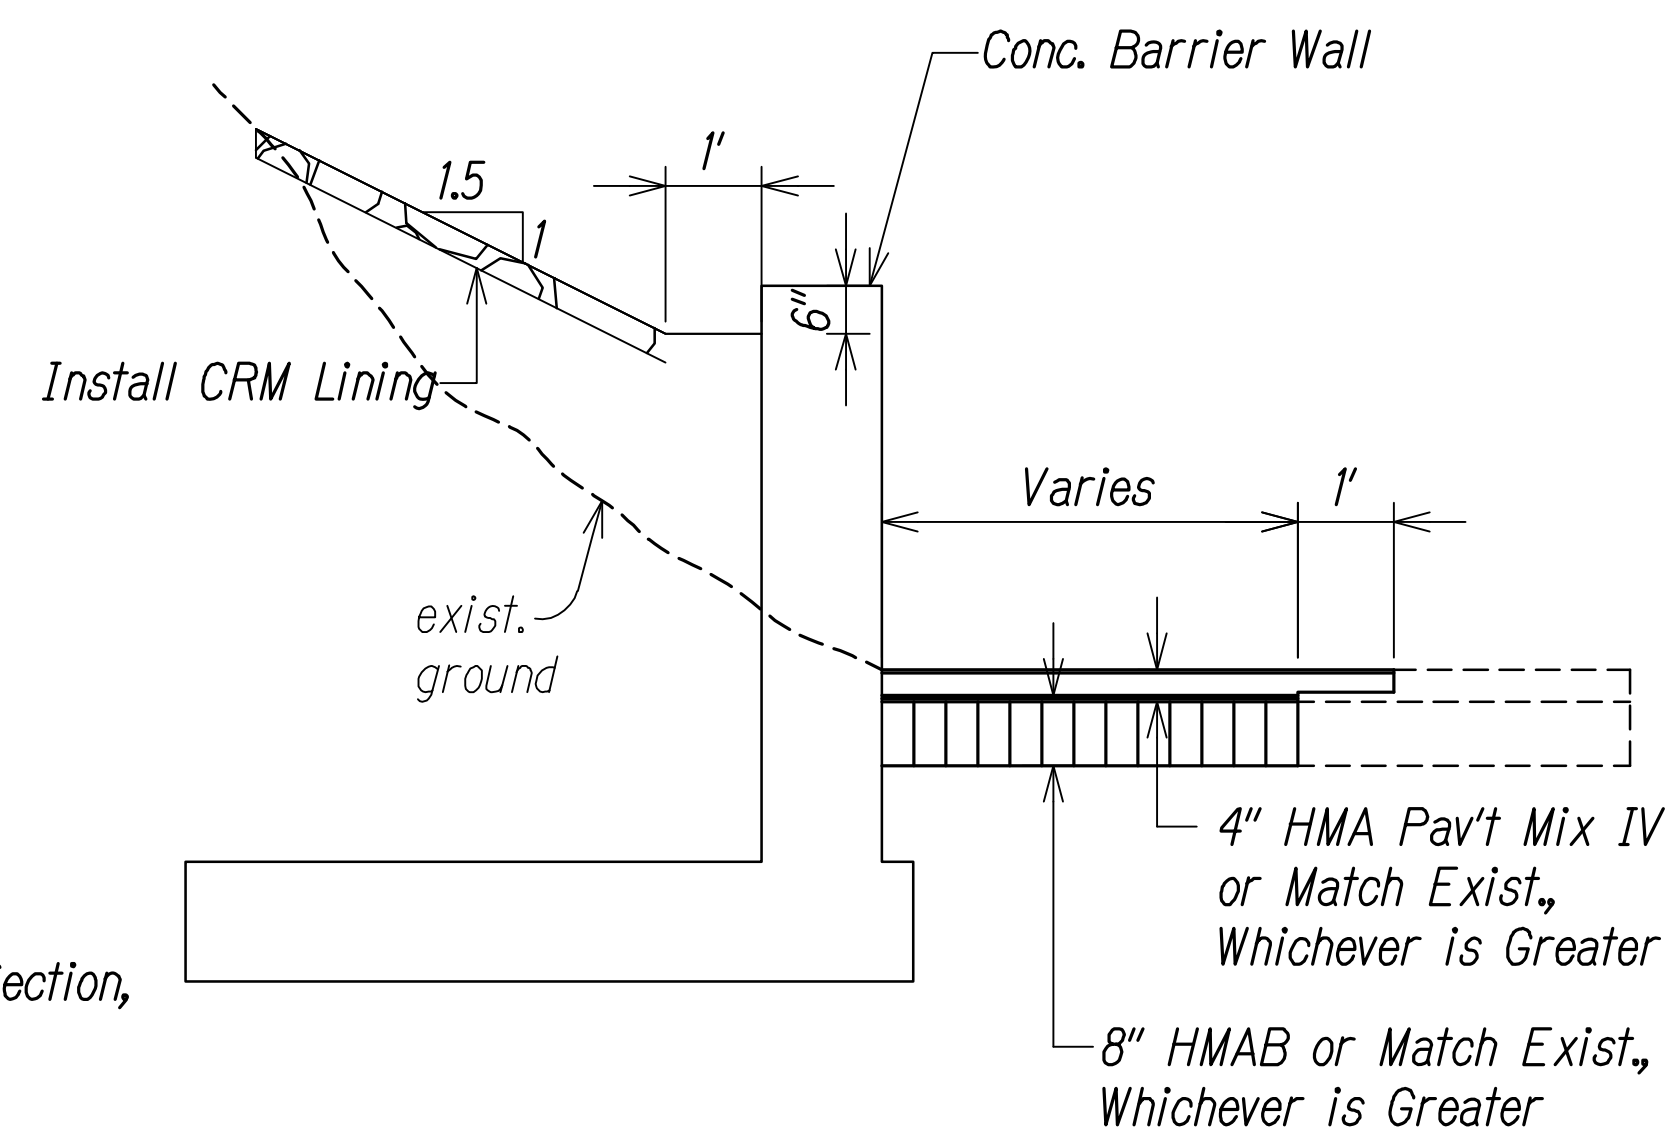

**TYPICAL SECTION**  
STA. 125+07 TO STA. 125+74 (WB)

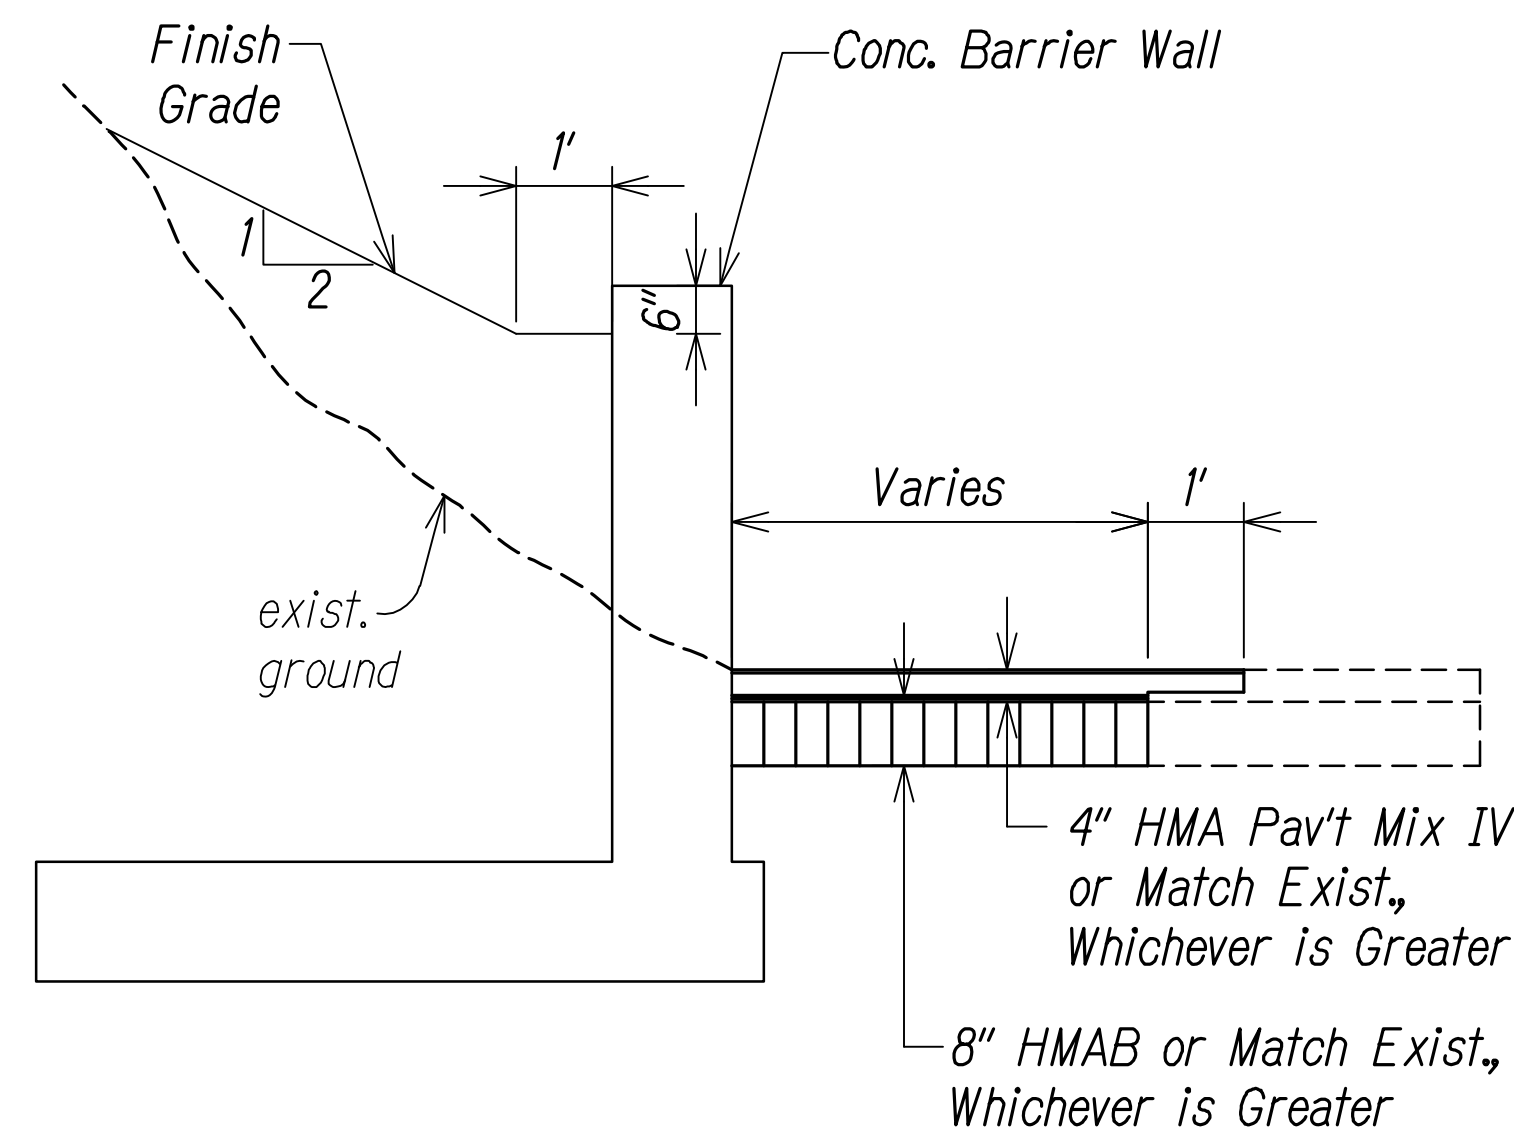

**TYPICAL SECTION**  
STA. 124+74 TO STA. 125+07 (WB)  
STA. 125+74 TO STA. 126+19 (WB)

**LEGEND FOR AS-BUILT POSTINGS**

Squiggly line for as-built deletion

Double line for as-built deletion

Text for as-built posting



THIS WORK WAS PREPARED BY ME OR UNDER MY SUPERVISION.

APRIL 30, 2020  
WILSON OKAMOTO CORPORATION LIC. EXP. DATE


STATE OF HAWAII  
DEPARTMENT OF TRANSPORTATION  
HIGHWAYS DIVISION  
**AALA STREET & NUUANU STREAM**  
**GRADING PLAN**  
**INTERSTATE ROUTE H-1**  
**GUARDRAIL AND SHOULDER IMPROVEMENTS**  
**Middle Street to Punchbowl Off-Ramp**  
**Fed. Aid Project No. 1M-H1-1(242)**  
Scale: 1" = 10' Date: Mar. 2016

SHEET No. GP-8 OF 16 SHEETS


"AS-BUILT"



| FED. ROAD DIST. NO. | STATE | FED. AID PROJ. NO. | FISCAL YEAR | SHEET NO. | TOTAL SHEETS |
|---------------------|-------|--------------------|-------------|-----------|--------------|
| HAWAII              | HAW.  | IM-H1-1(242)       | 2016        | 68        | 354          |

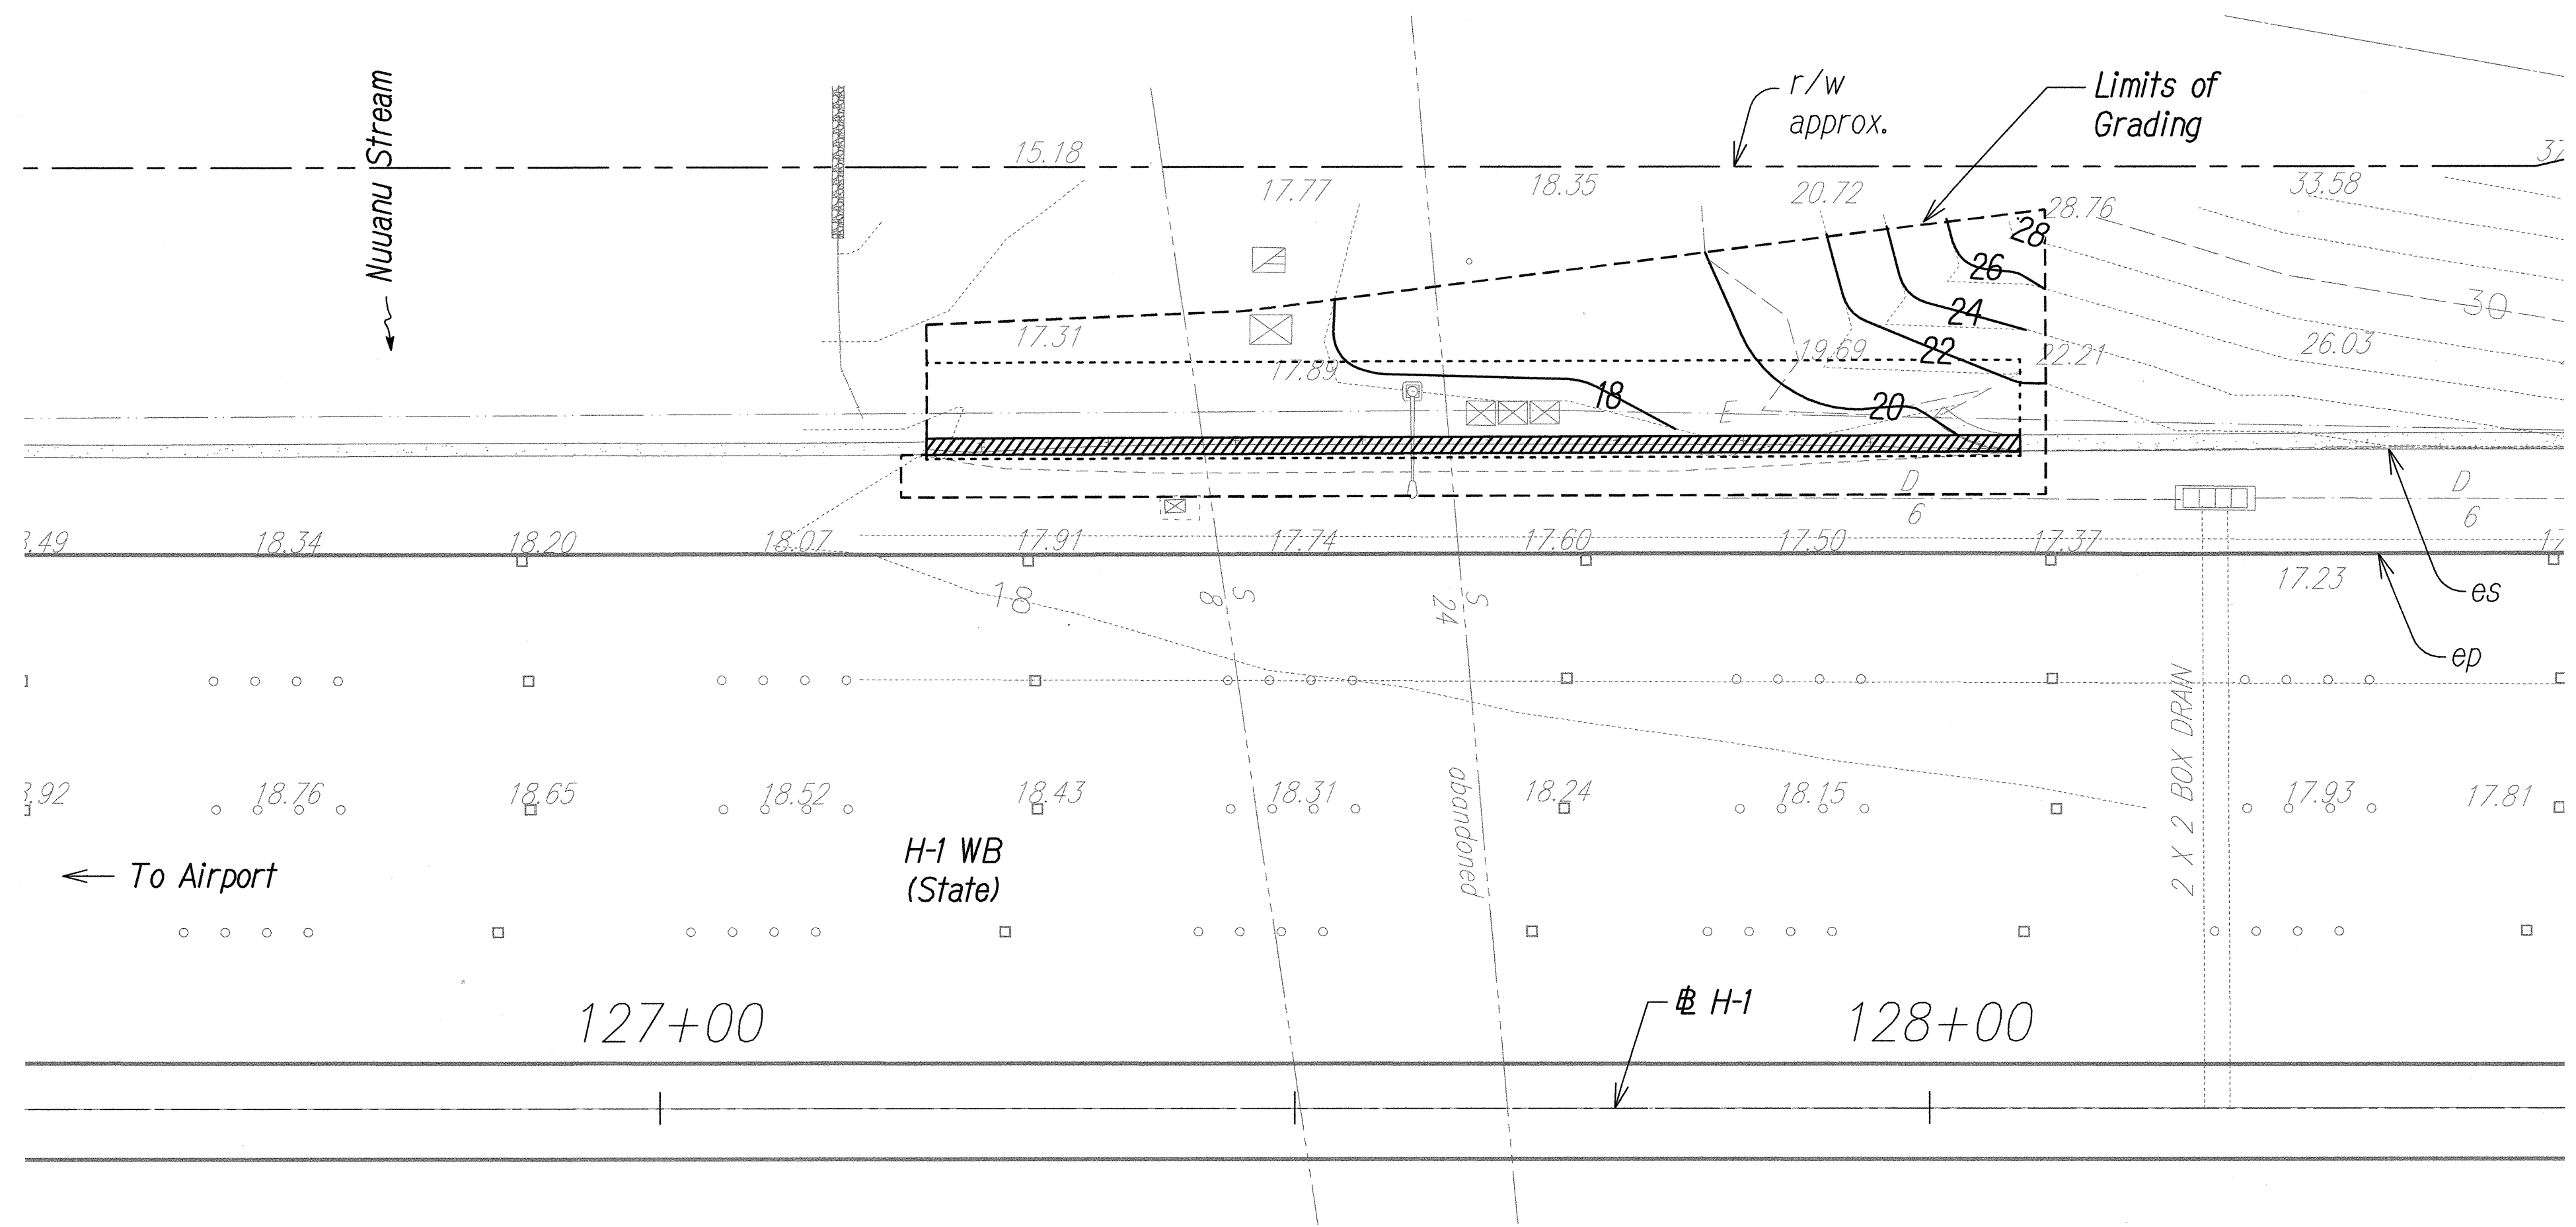

STA. 126+50 TO 128+50 (# H-1)

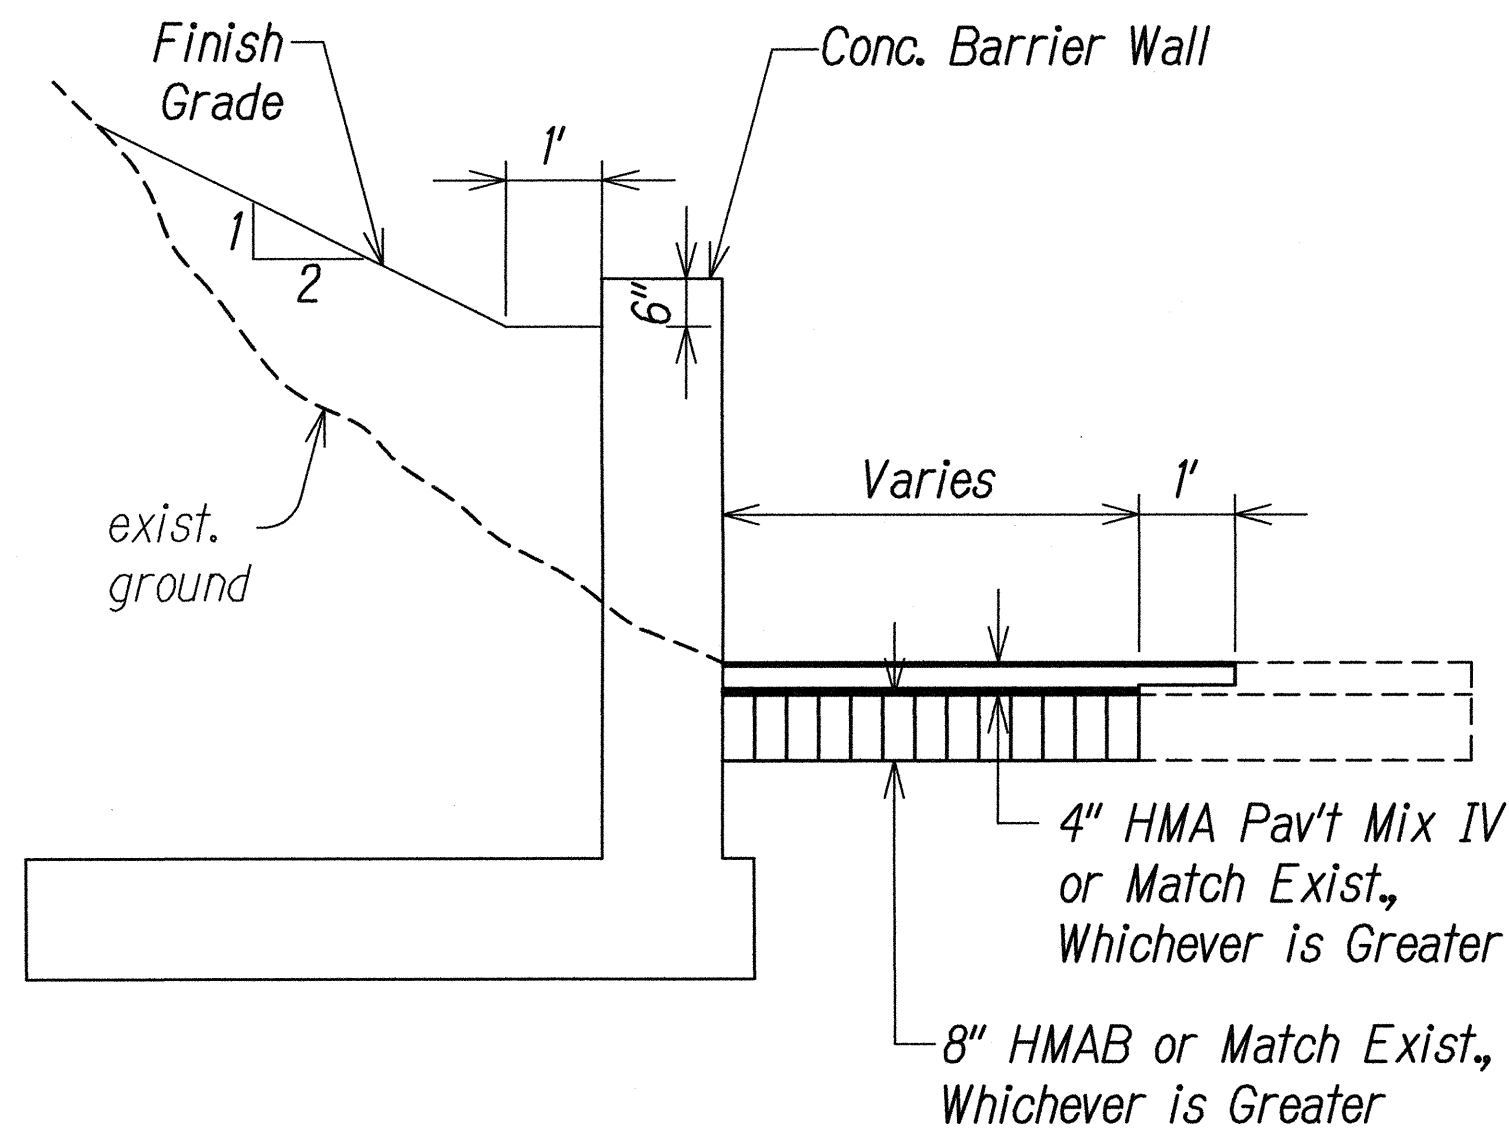


TYPICAL SECTION  
STA. 127+21 TO STA. 128+07 (WB)

Note:  
1. For Roadway Cross Section,  
See RS-1 to RS-16.

GRAPHIC SCALE:  
10' 5' 0 10' 20'  
SCALE: 1" = 10'

|               |                   |      |
|---------------|-------------------|------|
| ORIGINAL PLAN | SURVEY PLOTTED BY | DATE |
| NOTE BOOK     | DRAWN BY          |      |
|               | DESIGNED BY       |      |
|               | QUANTITIES BY     |      |
|               | CHECKED BY        |      |

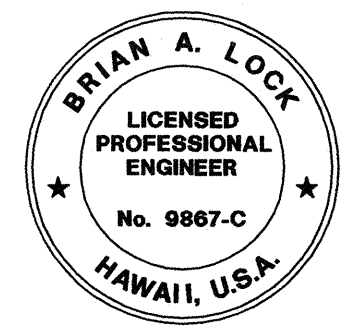


THIS WORK WAS PREPARED BY ME  
OR UNDER MY SUPERVISION.  
*WILSON OKAMOTO CORPORATION* APRIL 30, 2018  
LIC. EXP. DATE


STATE OF HAWAII  
DEPARTMENT OF TRANSPORTATION  
HIGHWAYS DIVISION  
**AALA STREET & NUUANU STREAM**  
**GRADING PLAN**  
INTERSTATE ROUTE H-1  
GUARDRAIL AND SHOULDER IMPROVEMENTS  
Middle Street to Punchbowl Off-Ramp  
Fed. Aid Project No. IM-H1-1(242)  
Scale: 1" = 10' Date: Mar. 2016  
SHEET No. GP-9 OF 16 SHEETS




| FED. ROAD DIST. NO. | STATE | FED. AID PROJ. NO. | FISCAL YEAR | SHEET NO. | TOTAL SHEETS |
|---------------------|-------|--------------------|-------------|-----------|--------------|
| HAWAII              | HAW.  | IM-HI-1(242)       | 2016        | 69        | 354          |

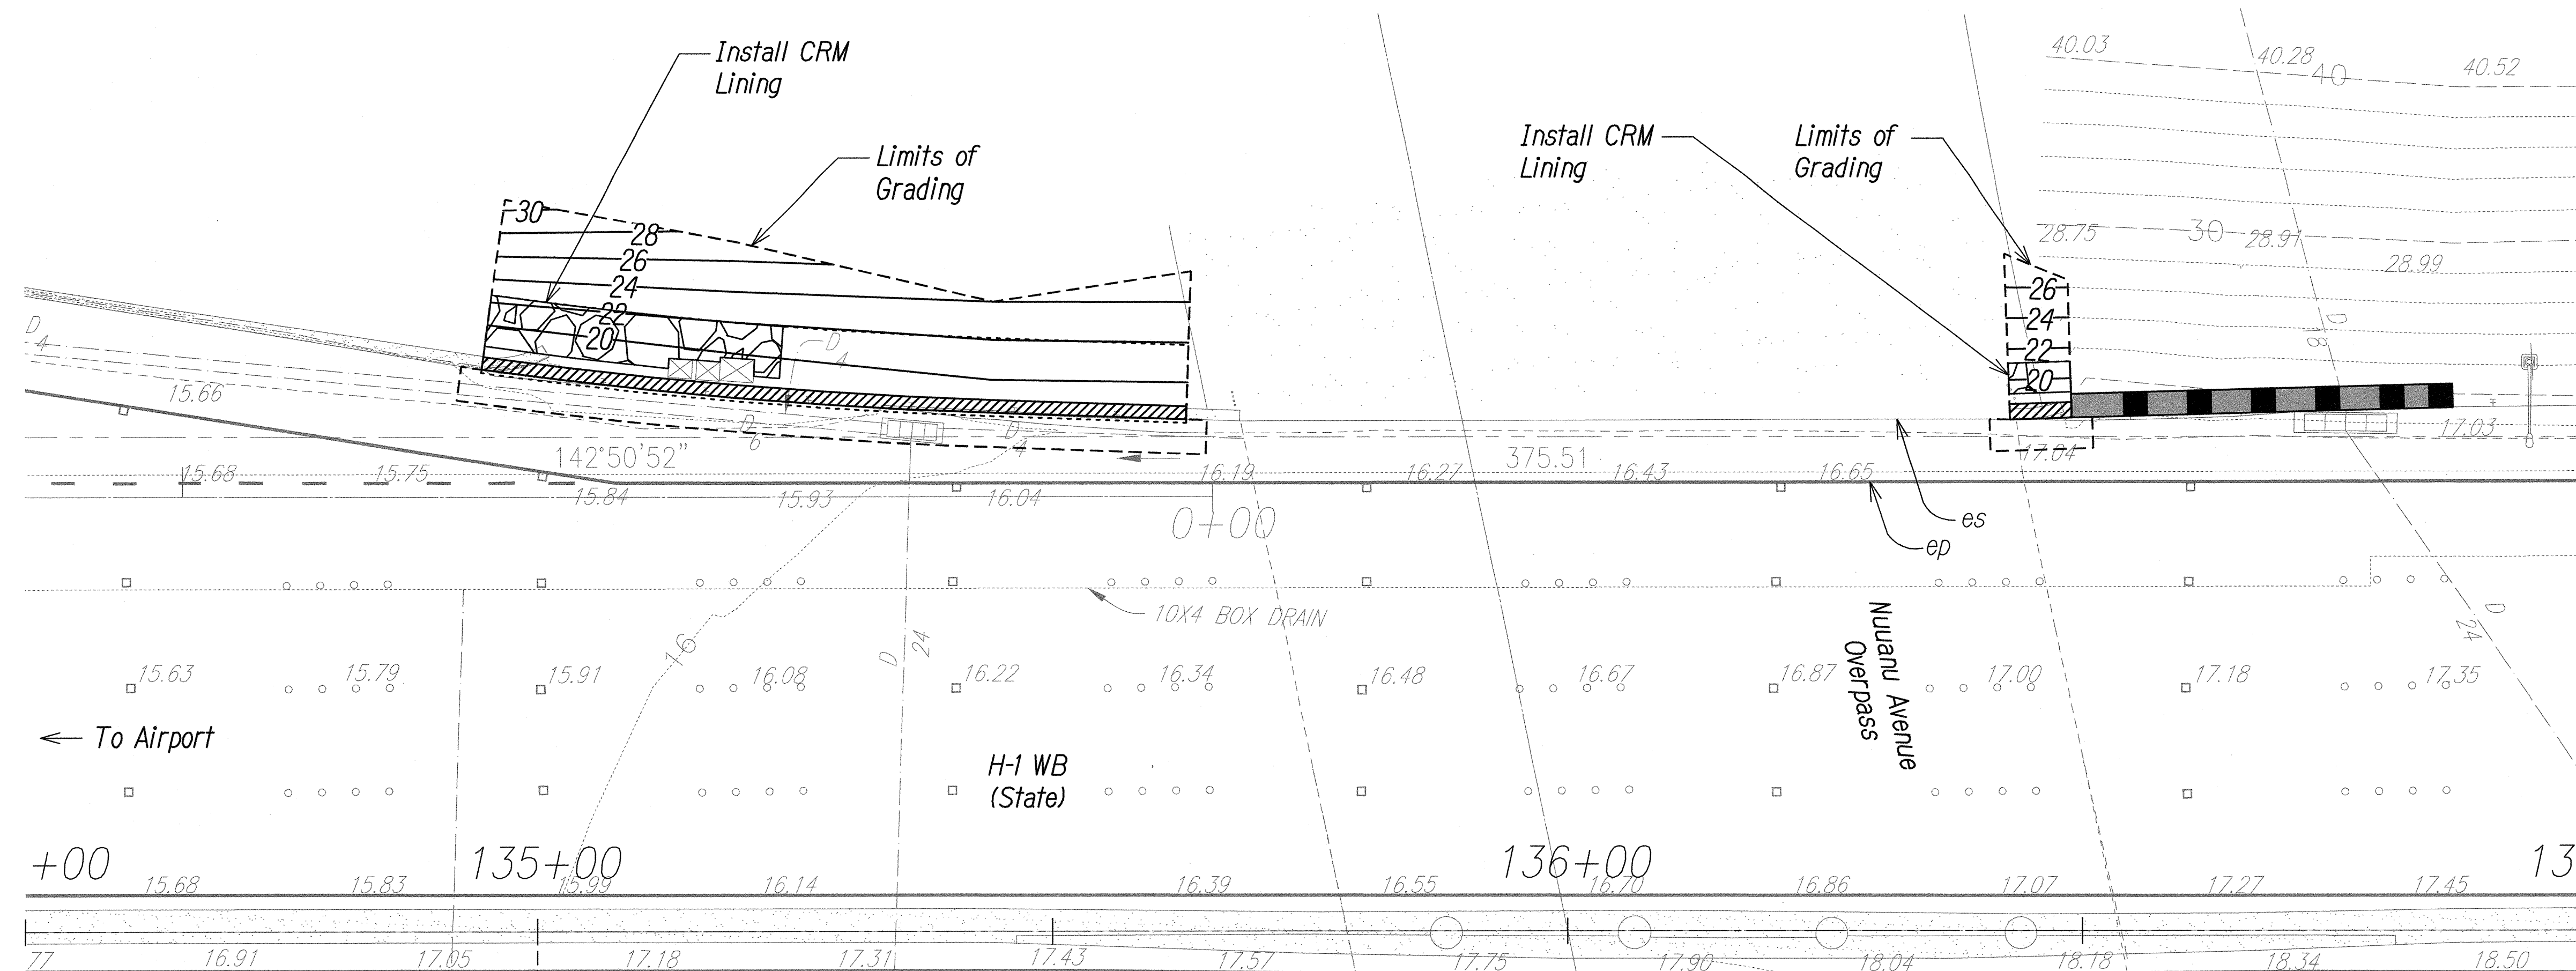


STA. 134+50 TO 137+00 (H-1)

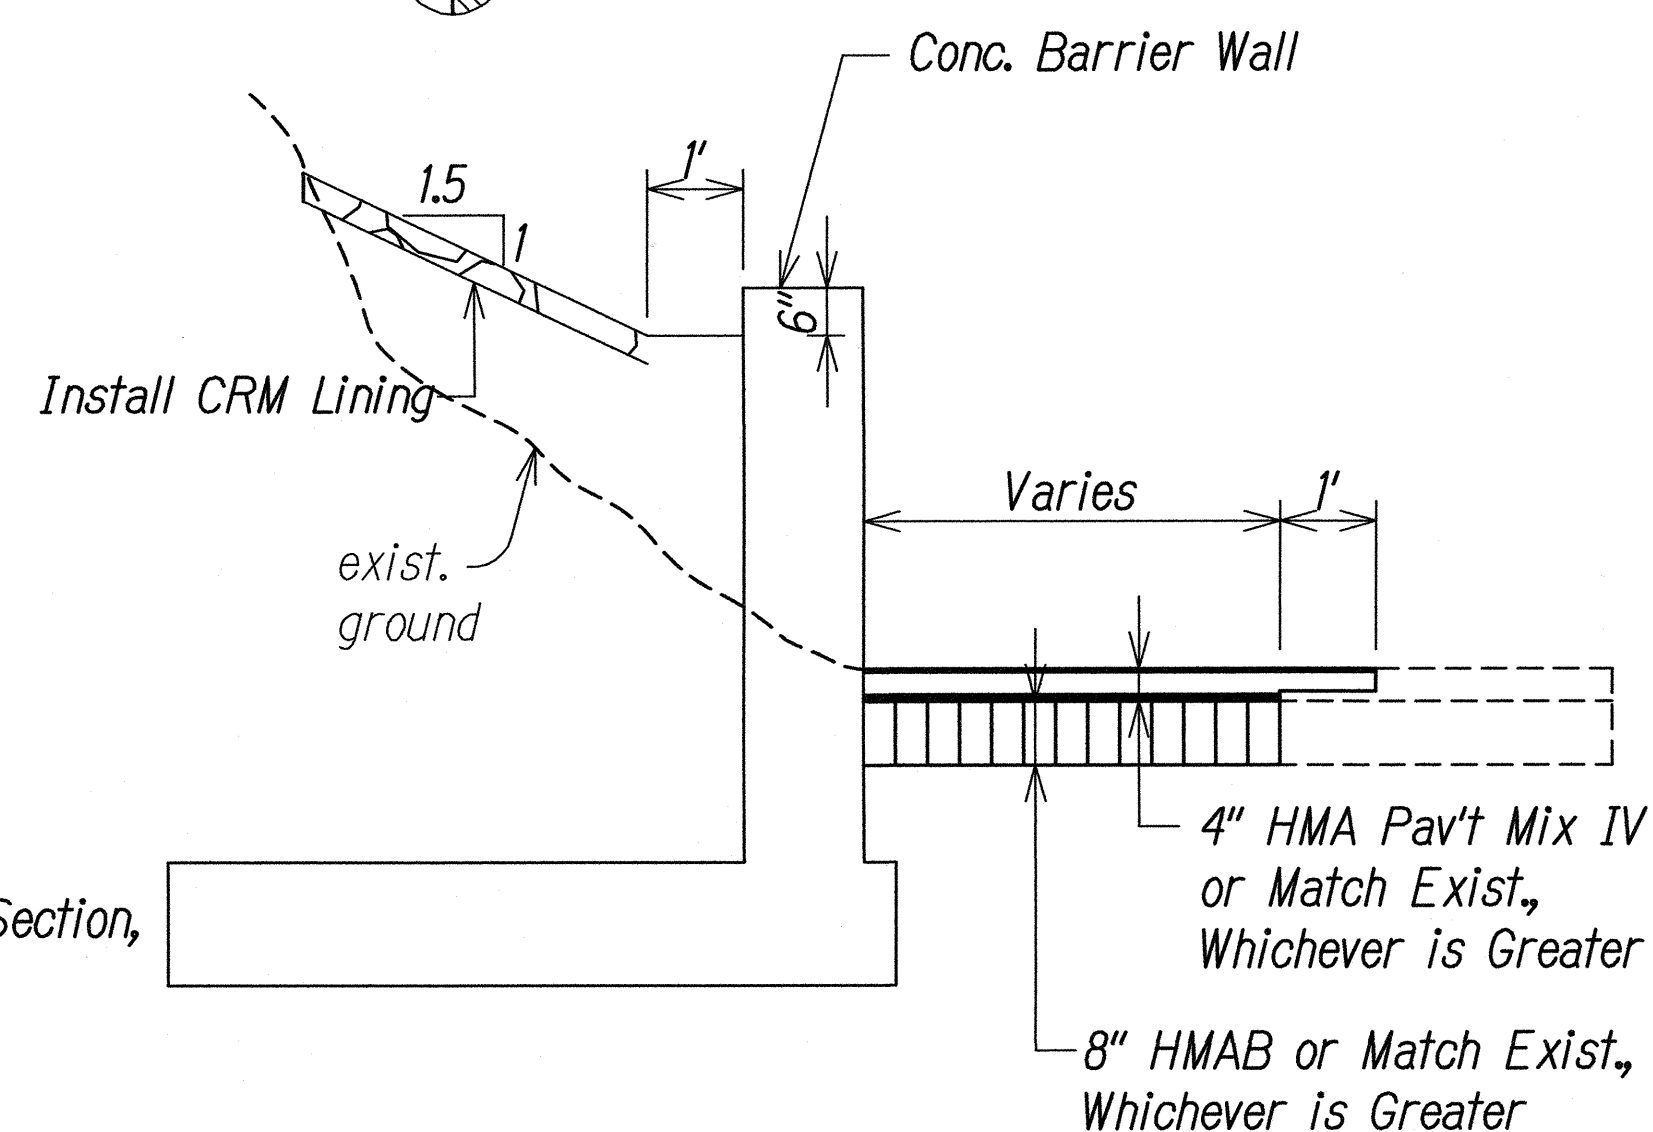

TYPICAL SECTION A  
STA. 134+95 TO STA. 135+24 (WB)

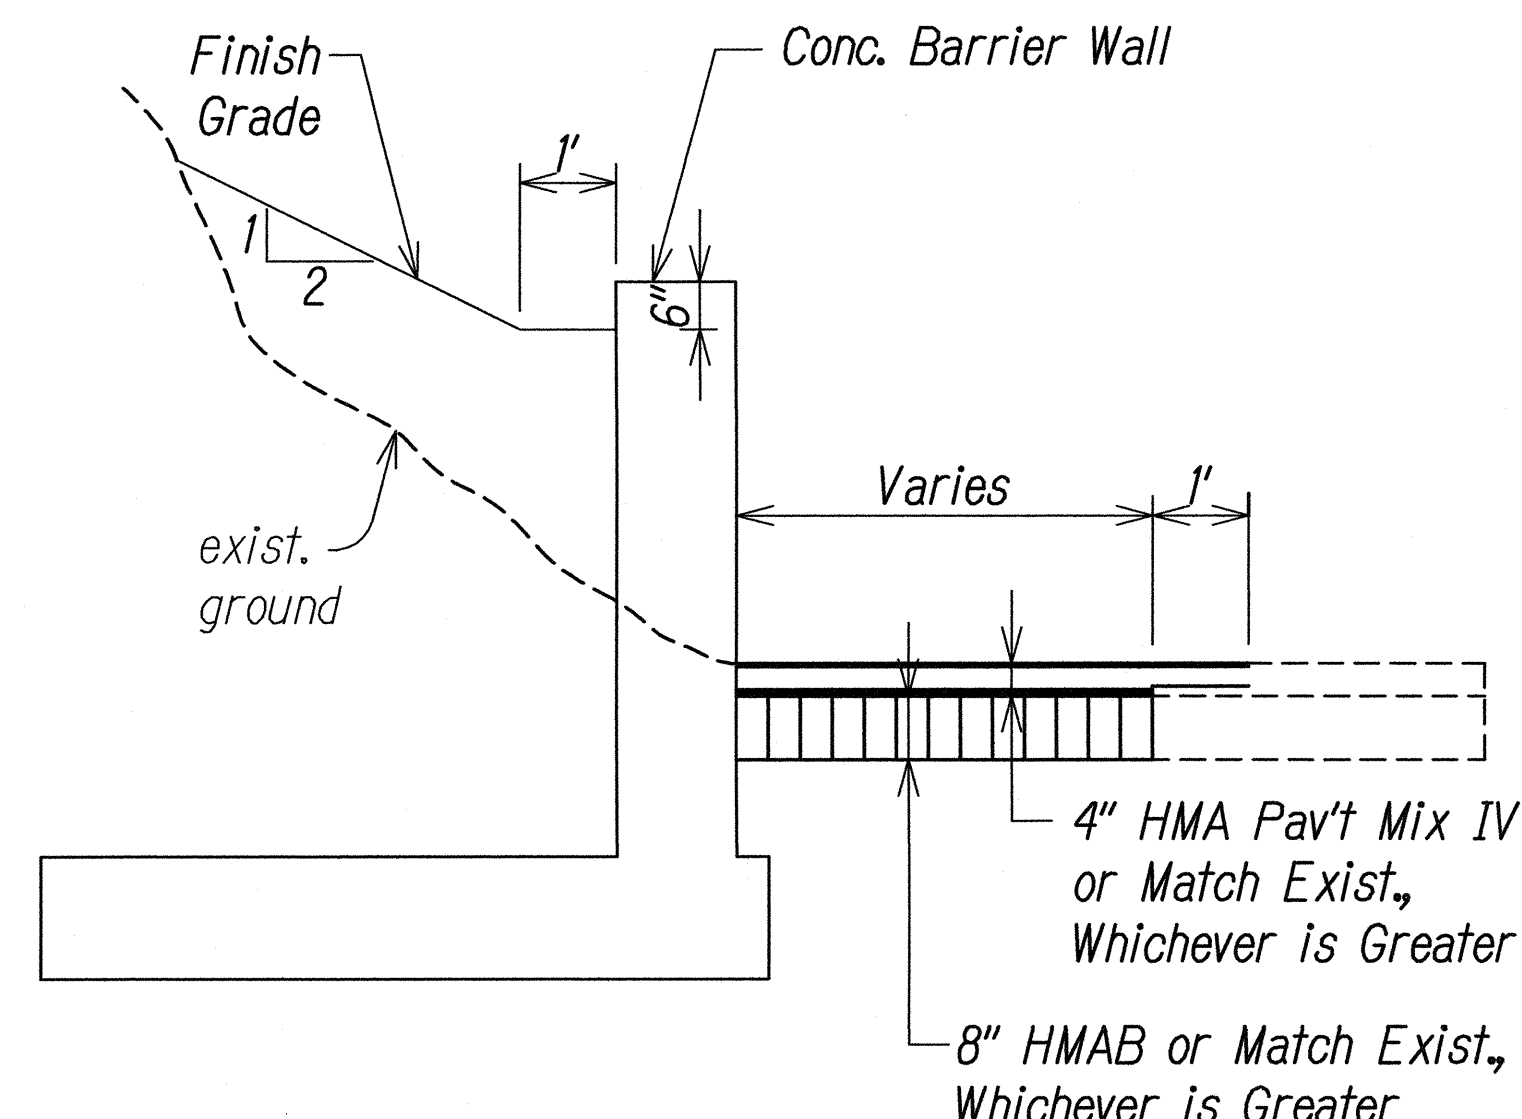

TYPICAL SECTION B  
STA. 135+24 TO STA. 135+63 (WB)

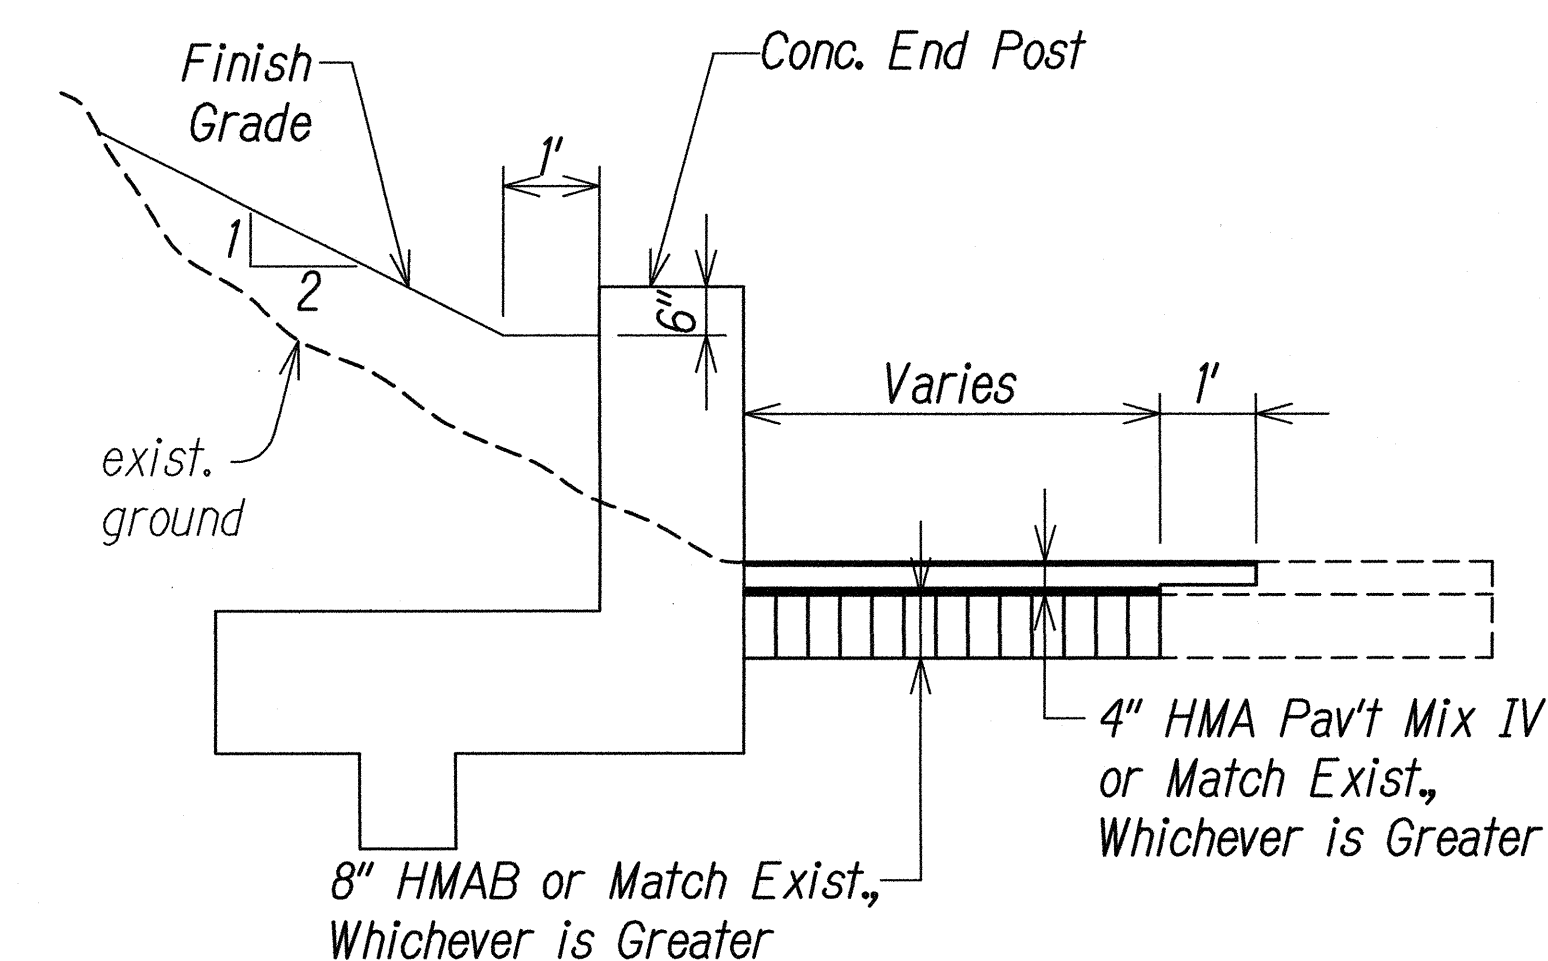

TYPICAL SECTION C  
STA. 136+43 TO STA. 136+49 (WB)

Note:  
1. For Roadway Cross Section,  
See RS-1 to RS-16.

GRAPHIC SCALE:  
10' 5' 0' 20'  
SCALE: 1" = 10'

|               |                   |      |
|---------------|-------------------|------|
| ORIGINAL PLAN | SURVEY PLOTTED BY | DATE |
| DESIGNED BY   | DRAWN BY          |      |
| CHECKED BY    | NOTED BY          |      |
| No.           |                   |      |



THIS WORK WAS PREPARED BY ME  
OR UNDER MY SUPERVISION.  
*Wilson Okamoto*  
WILSON OKAMOTO CORPORATION LIC. EXP. DATE

STATE OF HAWAII  
DEPARTMENT OF TRANSPORTATION  
HIGHWAYS DIVISION

NUUANU AVENUE

GRADING PLAN

INTERSTATE ROUTE H-1

GUARDRAIL AND SHOULDER IMPROVEMENTS

Middle Street to Punchbowl Off-Ramp

Fed. Aid Project No. IM-HI-1(242)

Scale: 1" = 10'      Date: Mar. 2016


SHEET No. GP-10 OF 16 SHEETS

69



| FED. ROAD DIST. NO. | STATE | FED. AID PROJ. NO. | FISCAL YEAR | SHEET NO. | TOTAL SHEETS |
|---------------------|-------|--------------------|-------------|-----------|--------------|
| HAWAII              | HAW.  | IM-H1-1(242)       | 2016        | 70        | 354          |

TRUE NORTH  
SCALE: 1" = 10'

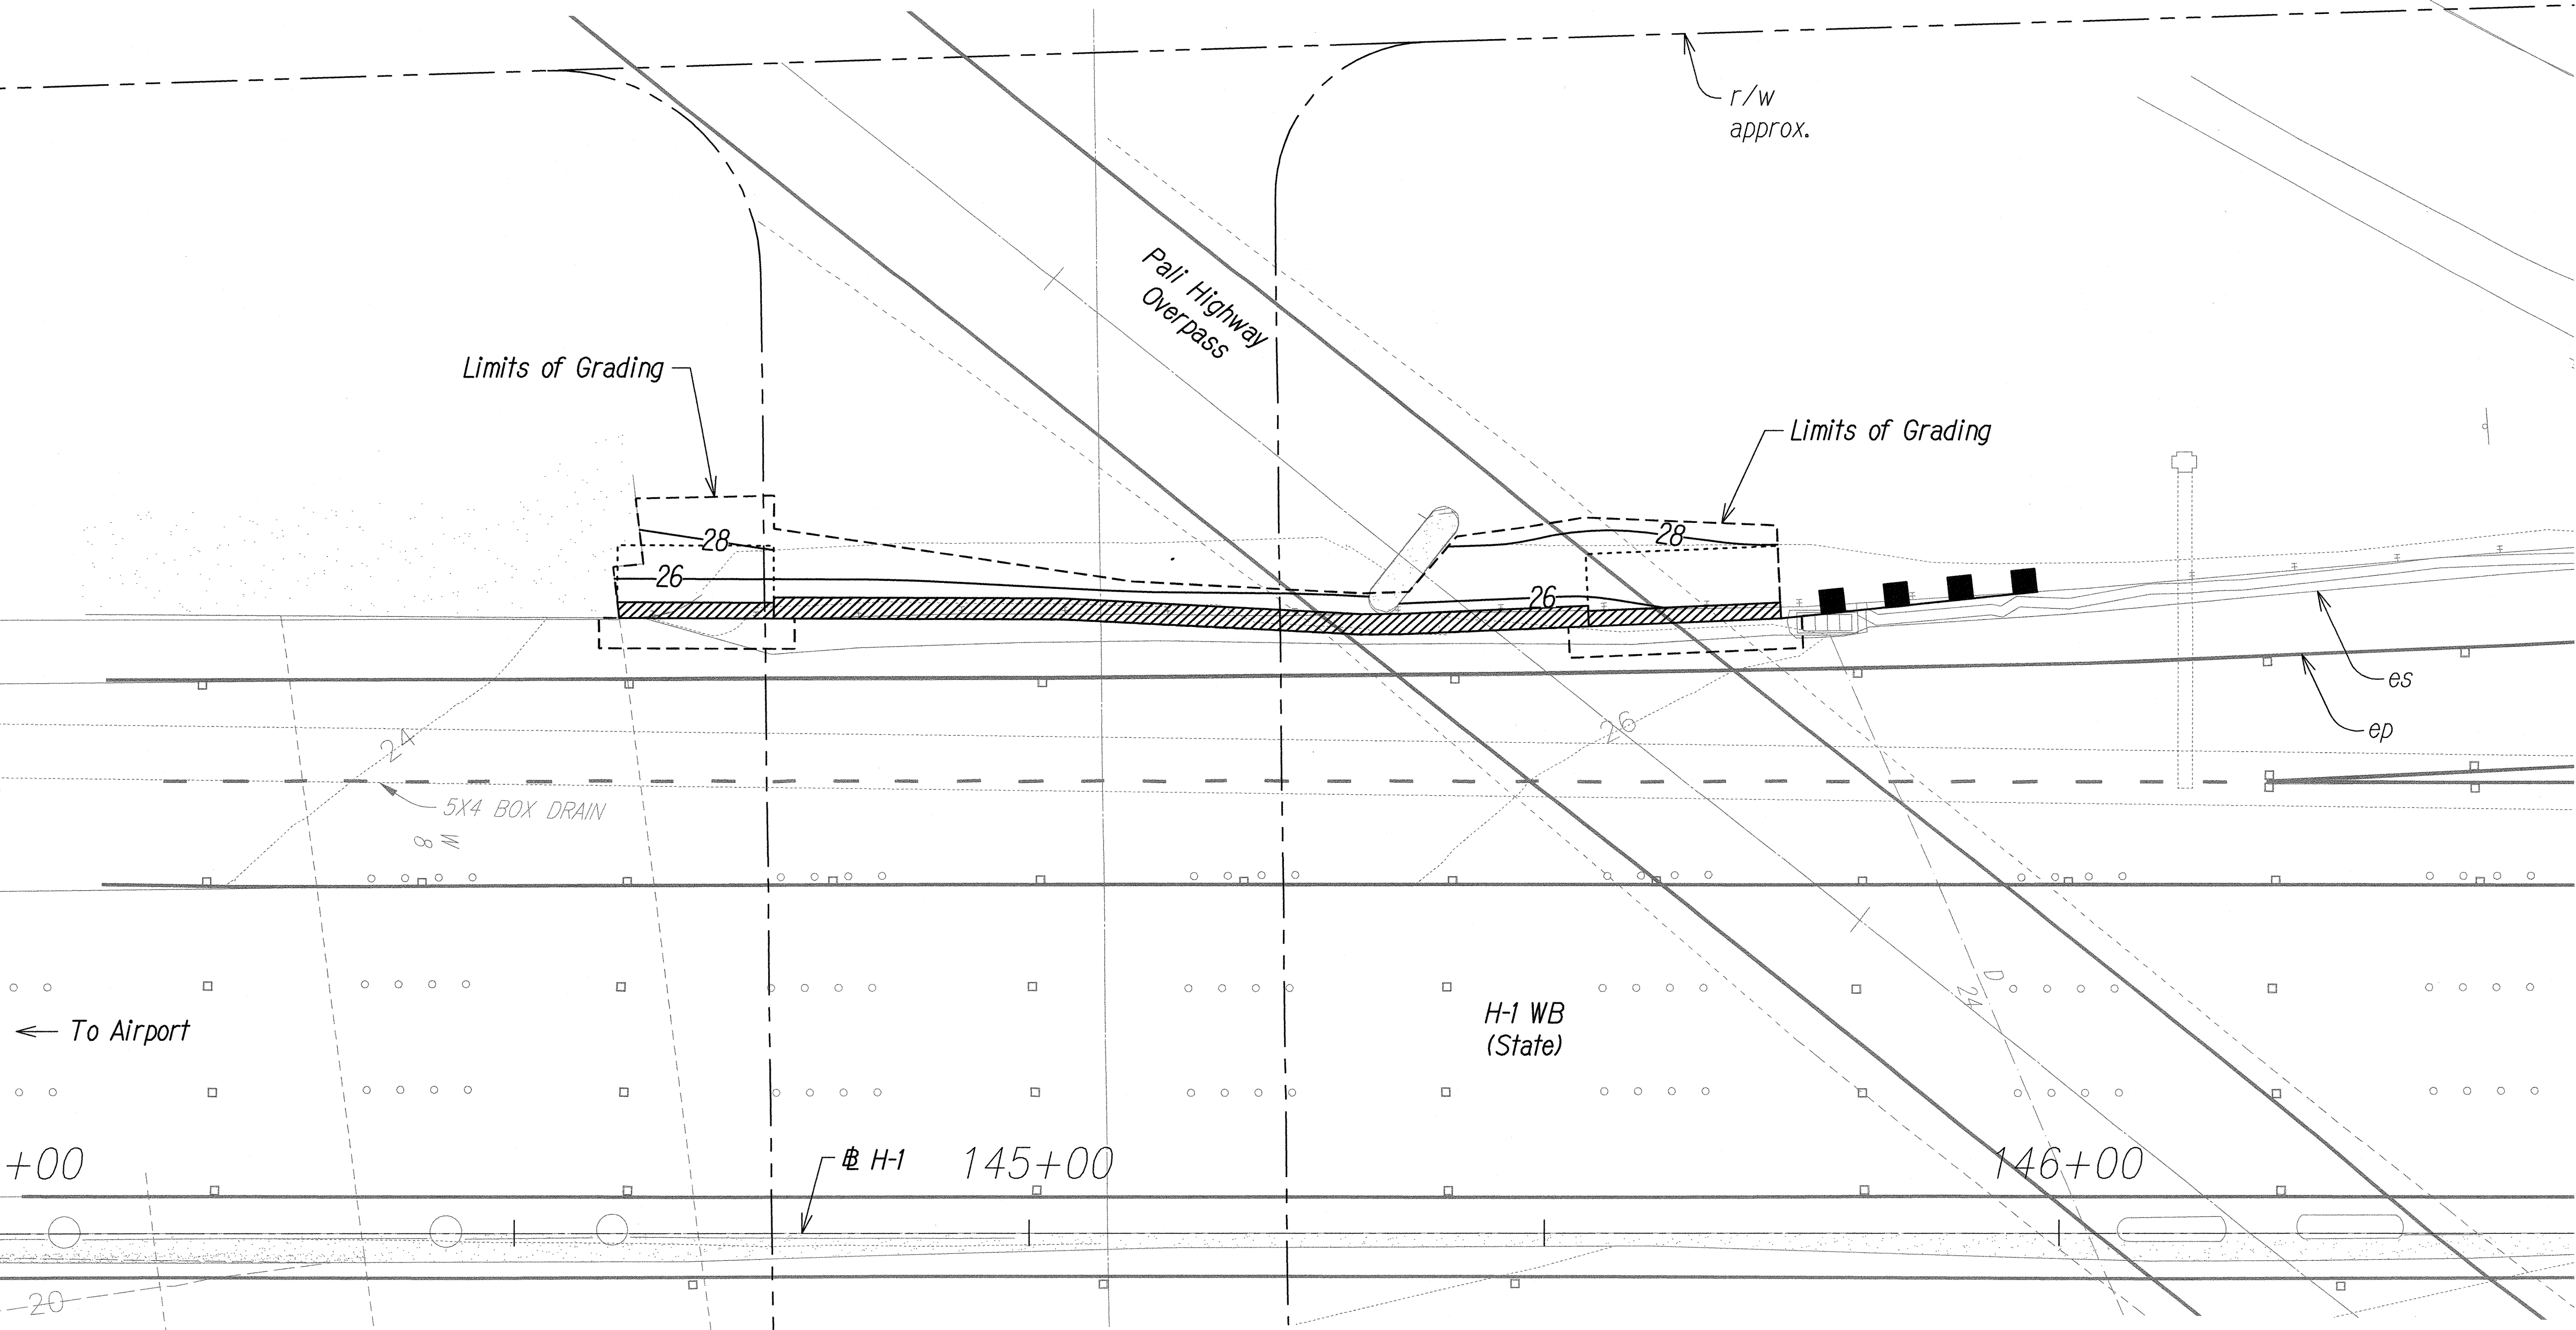

← To Airport


+00

-20

# H-1 145+00

146+00

H-1 WB  
(State)


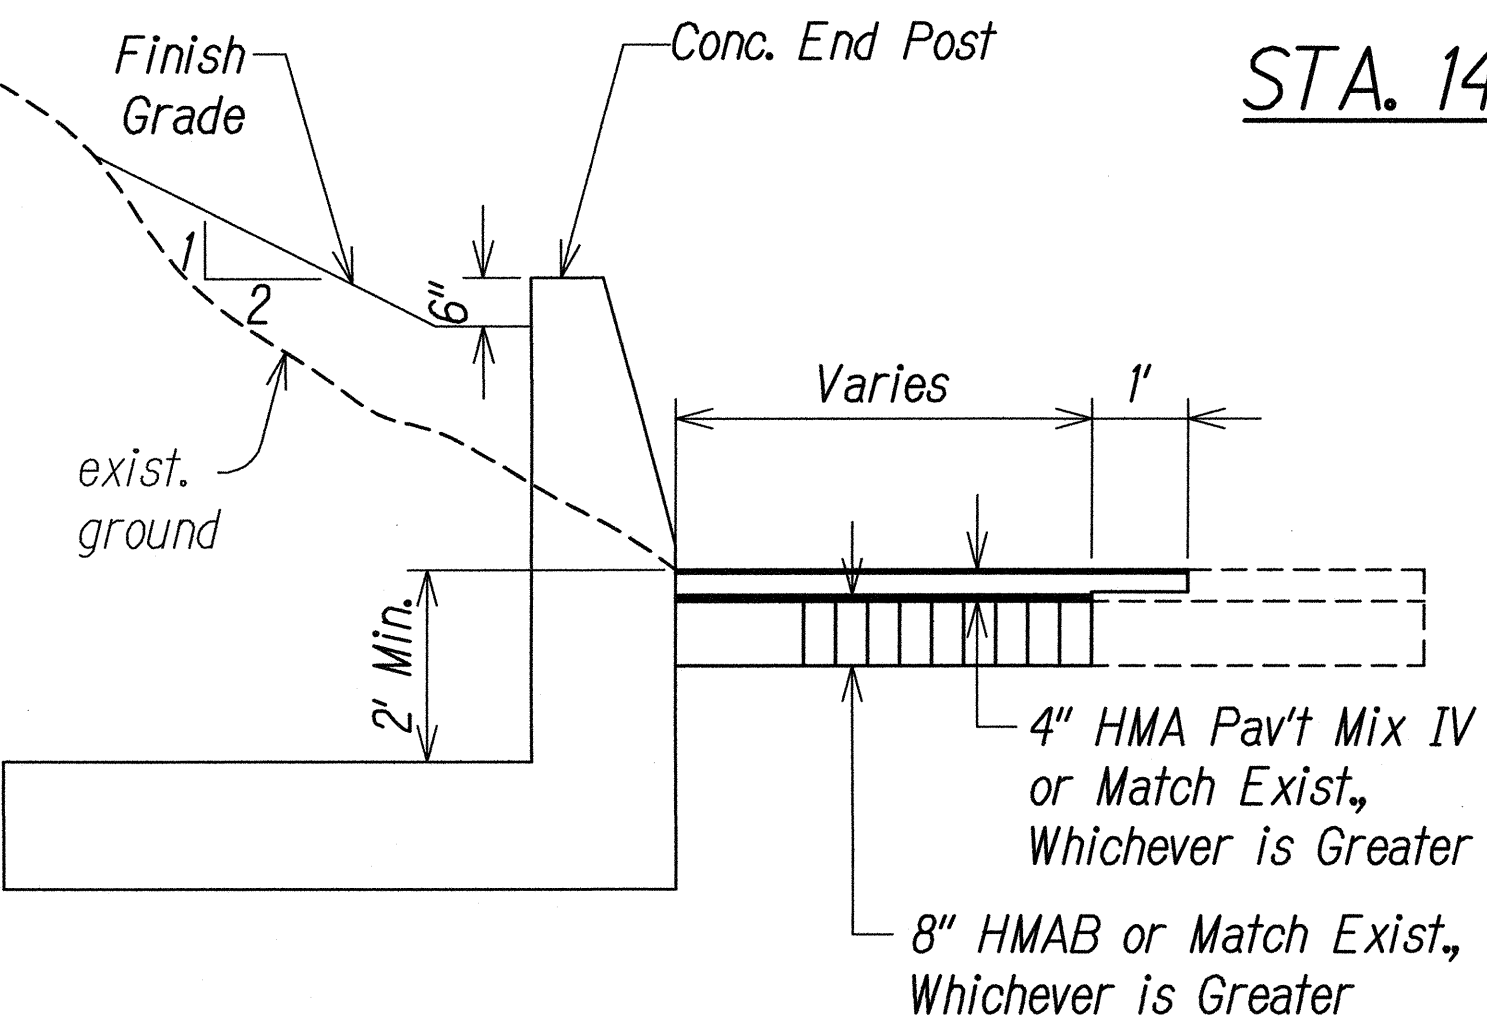


STA. 144+00 TO 146+50 (# H-1)

TYPICAL SECTION

STA. 144+60 TO STA. 144+75 (WB)  
STA. 145+54 TO STA. 145+73 (WB)

Note:  
1. For Roadway Cross Section, See RS-1 to RS-16.

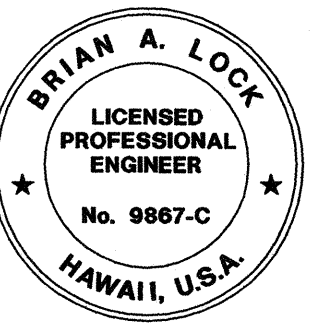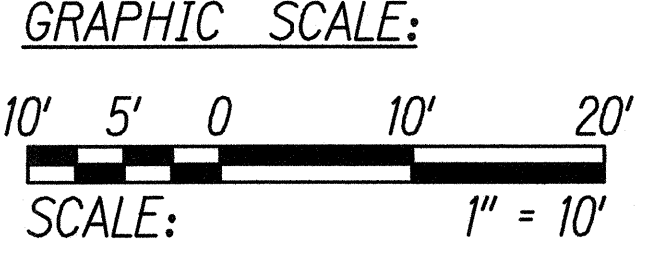

THIS WORK WAS PREPARED BY ME  
OR UNDER MY SUPERVISION.  
*ma*  
WILSON OKAMOTO CORPORATION LIC. EXP. DATE

STATE OF HAWAII  
DEPARTMENT OF TRANSPORTATION  
HIGHWAYS DIVISION

PALI HIGHWAY OVERPASS  
GRADING PLAN

INTERSTATE ROUTE H-1  
GUARDRAIL AND SHOULDER IMPROVEMENTS  
Middle Street to Punchbowl Off-Ramp  
Fed. Aid Project No. IM-H1-1(242)

Scale: 1" = 10'      Date: Mar. 2016

SHEET No. GP-11 OF 16 SHEETS


|                   |      |
|-------------------|------|
| SURVEY PLOTTED BY | DATE |
| DRAWN BY          |      |
| DESIGNED BY       |      |
| NOTED BY          |      |
| CHECKED BY        |      |
| ORIGINAL PLAN     |      |
| NOTE BOOK         |      |
| No.               |      |








| FED. ROAD DIST. NO. | STATE | FED. AID PROJ. NO. | FISCAL YEAR | SHEET NO. | TOTAL SHEETS |
|---------------------|-------|--------------------|-------------|-----------|--------------|
| HAWAII              | HAW.  | IM-H1-1(242)       | 2016        | 72        | 354          |

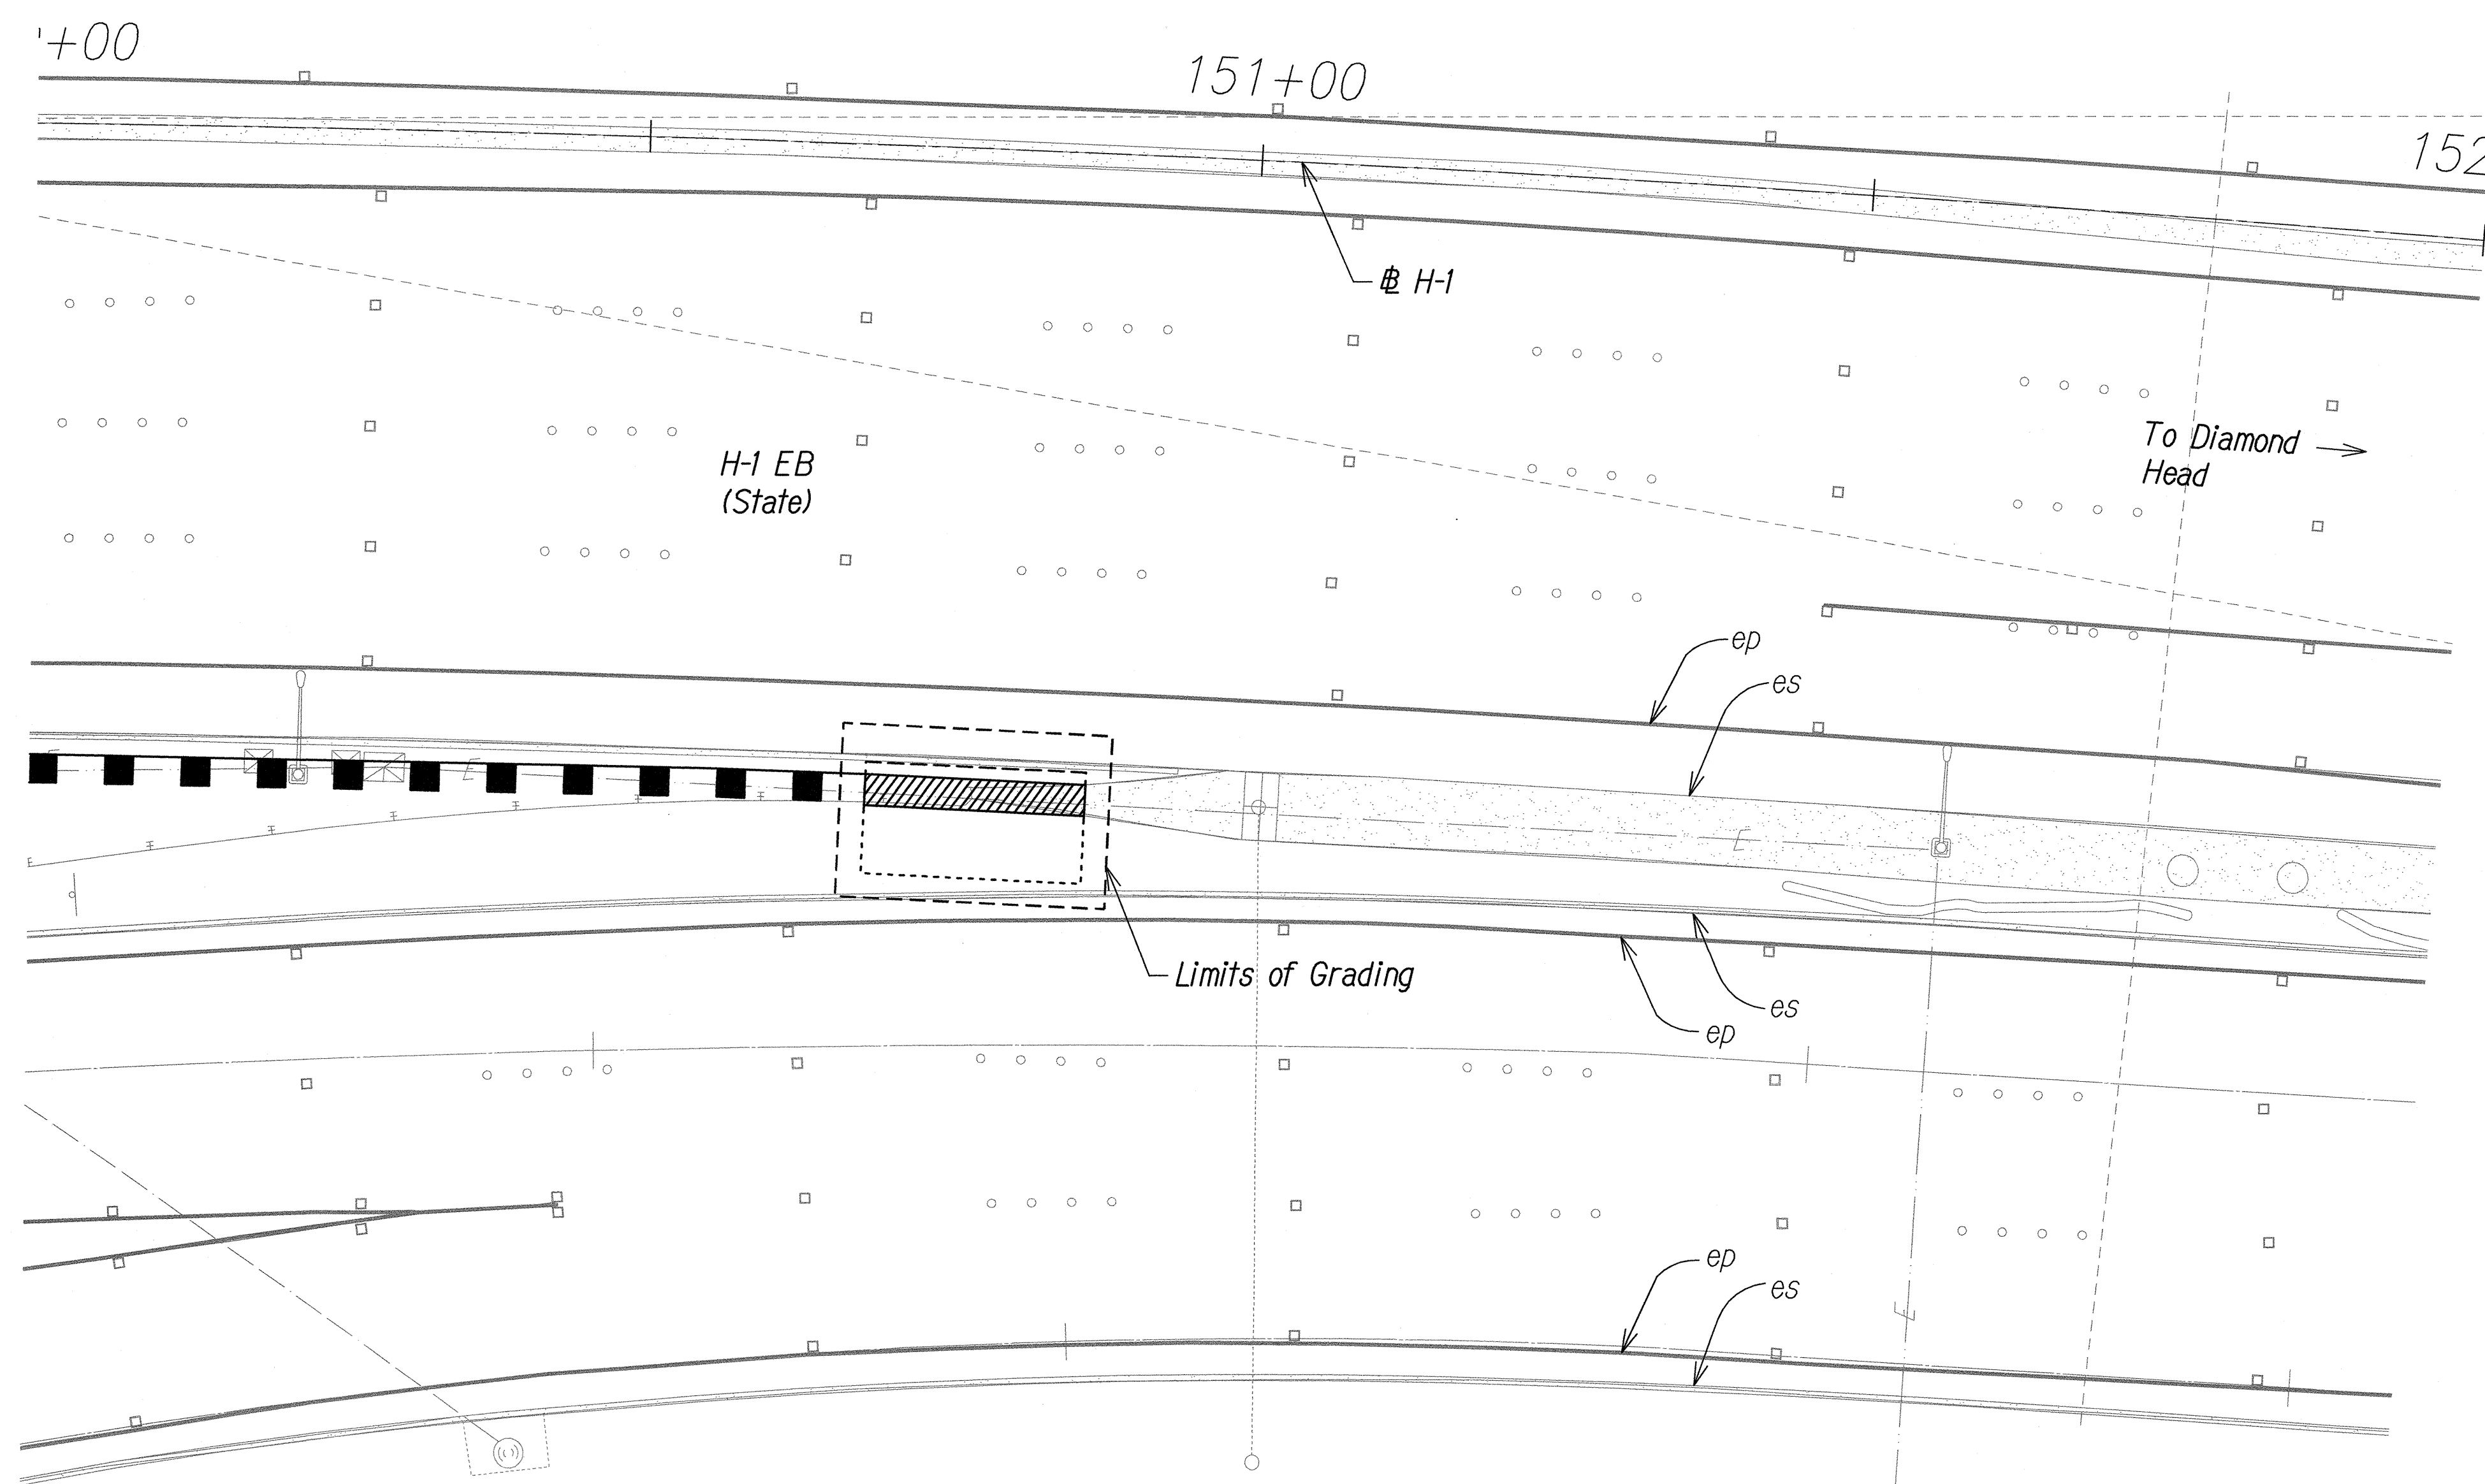

TRUE NORTH  
SCALE: 1" = 20'

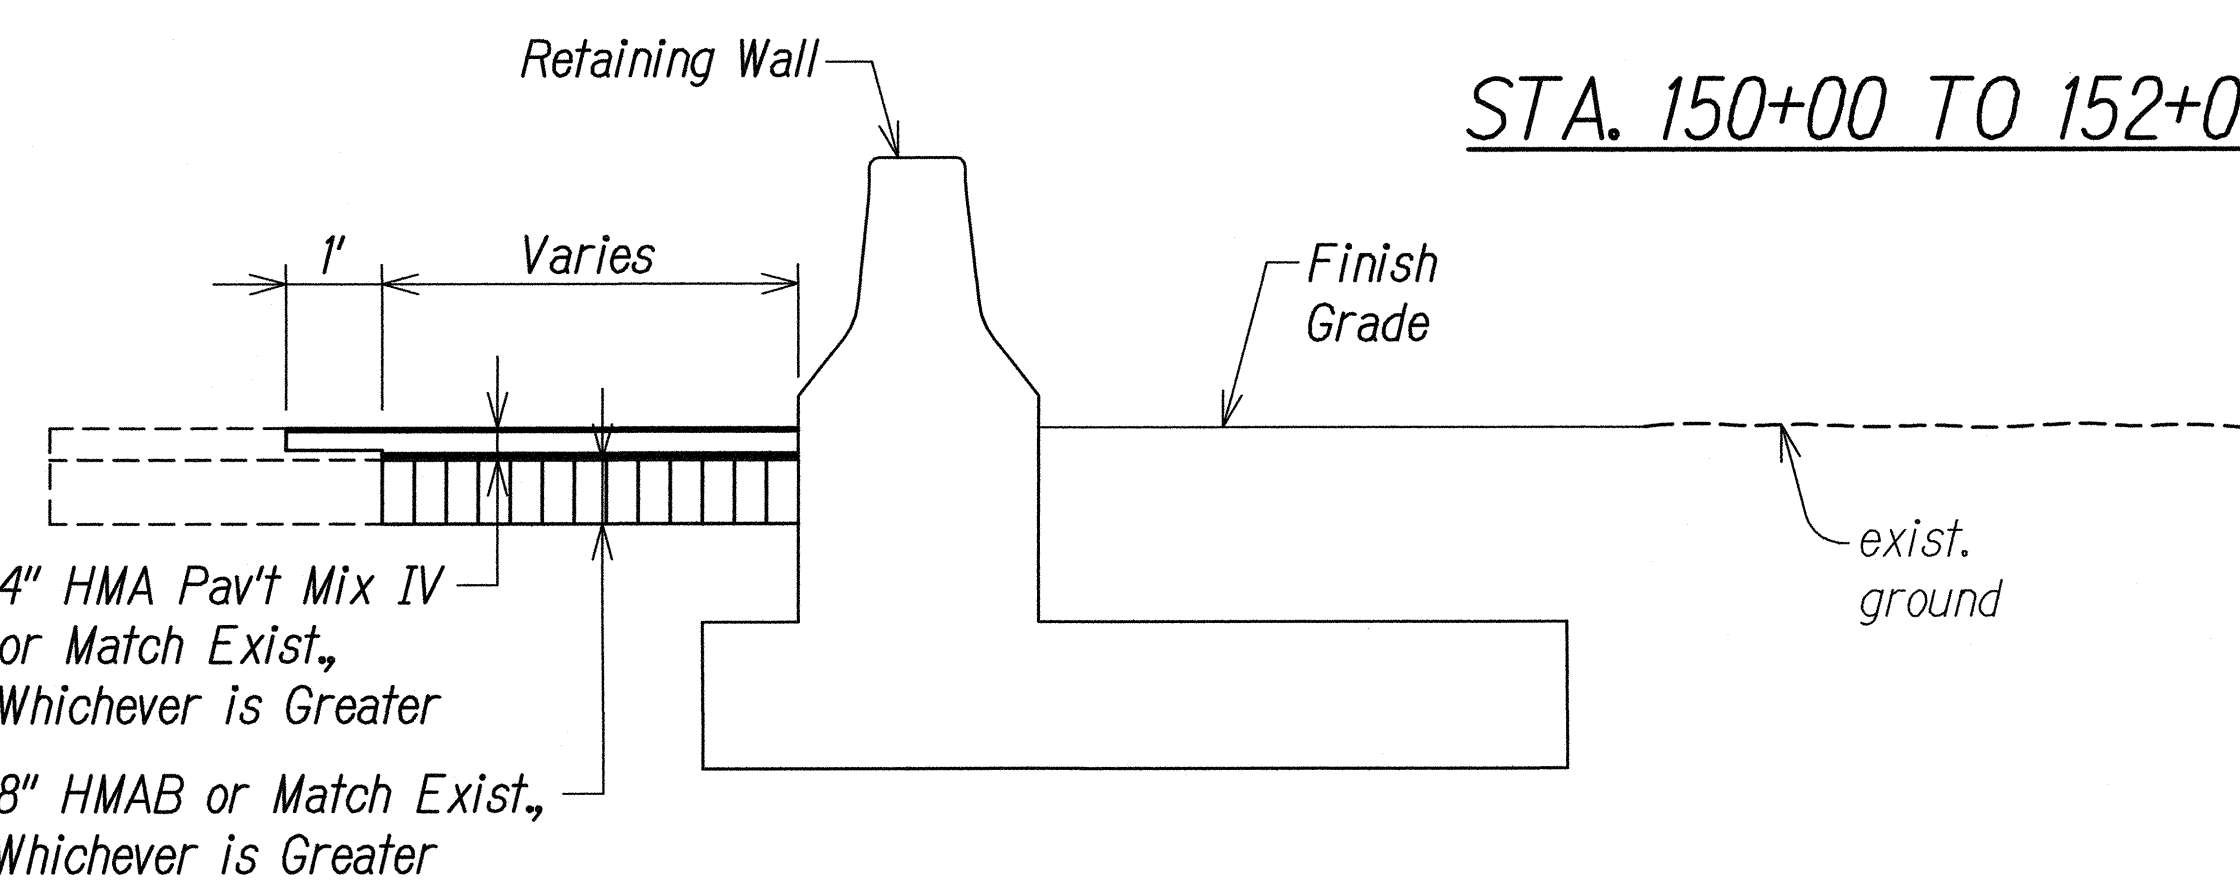


**Note:**  
1. For Roadway Cross Section, See RS-1 to RS-16.

**GRAPHIC SCALE:**  
10' 5' 0 10' 20'  
SCALE: 1" = 10'

**TYPICAL SECTION**  
STA. 150+69 TO STA. 150+88 (EB)

STA. 150+00 TO 152+00 (# H-1)

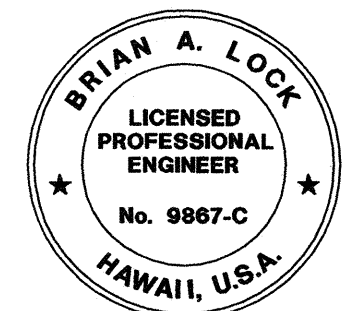




THIS WORK WAS PREPARED BY ME OR UNDER MY SUPERVISION.  
*Mich*  
WILSON OKAMOTO CORPORATION LIC. EXP. DATE APRIL 30, 2018

STATE OF HAWAII  
DEPARTMENT OF TRANSPORTATION  
HIGHWAYS DIVISION  
**PALI HIGHWAY OVERPASS**  
**GRADING PLAN**  
INTERSTATE ROUTE H-1  
GUARDRAIL AND SHOULDER IMPROVEMENTS  
Middle Street to Punchbowl Off-Ramp  
Fed. Aid Project No. IM-H1-1(242)  
Scale: 1" = 20'      Date: Mar. 2016  
SHEET No. GP-13 OF 16 SHEETS

|                   |      |
|-------------------|------|
| SURVEY PLOTTED BY | DATE |
| DRAWN BY          |      |
| DESIGNED BY       |      |
| QUANTITIES BY     |      |
| CHECKED BY        |      |
| ORIGINAL PLAN     | No.  |
| NOTE BOOK         |      |



| FED. ROAD DIST. NO. | STATE | FED. AID PROJ. NO. | FISCAL YEAR | SHEET NO. | TOTAL SHEETS |
|---------------------|-------|--------------------|-------------|-----------|--------------|
| HAWAII              | HAW.  | 1M-H1-1(242)       | 2016        | 73        | 354          |

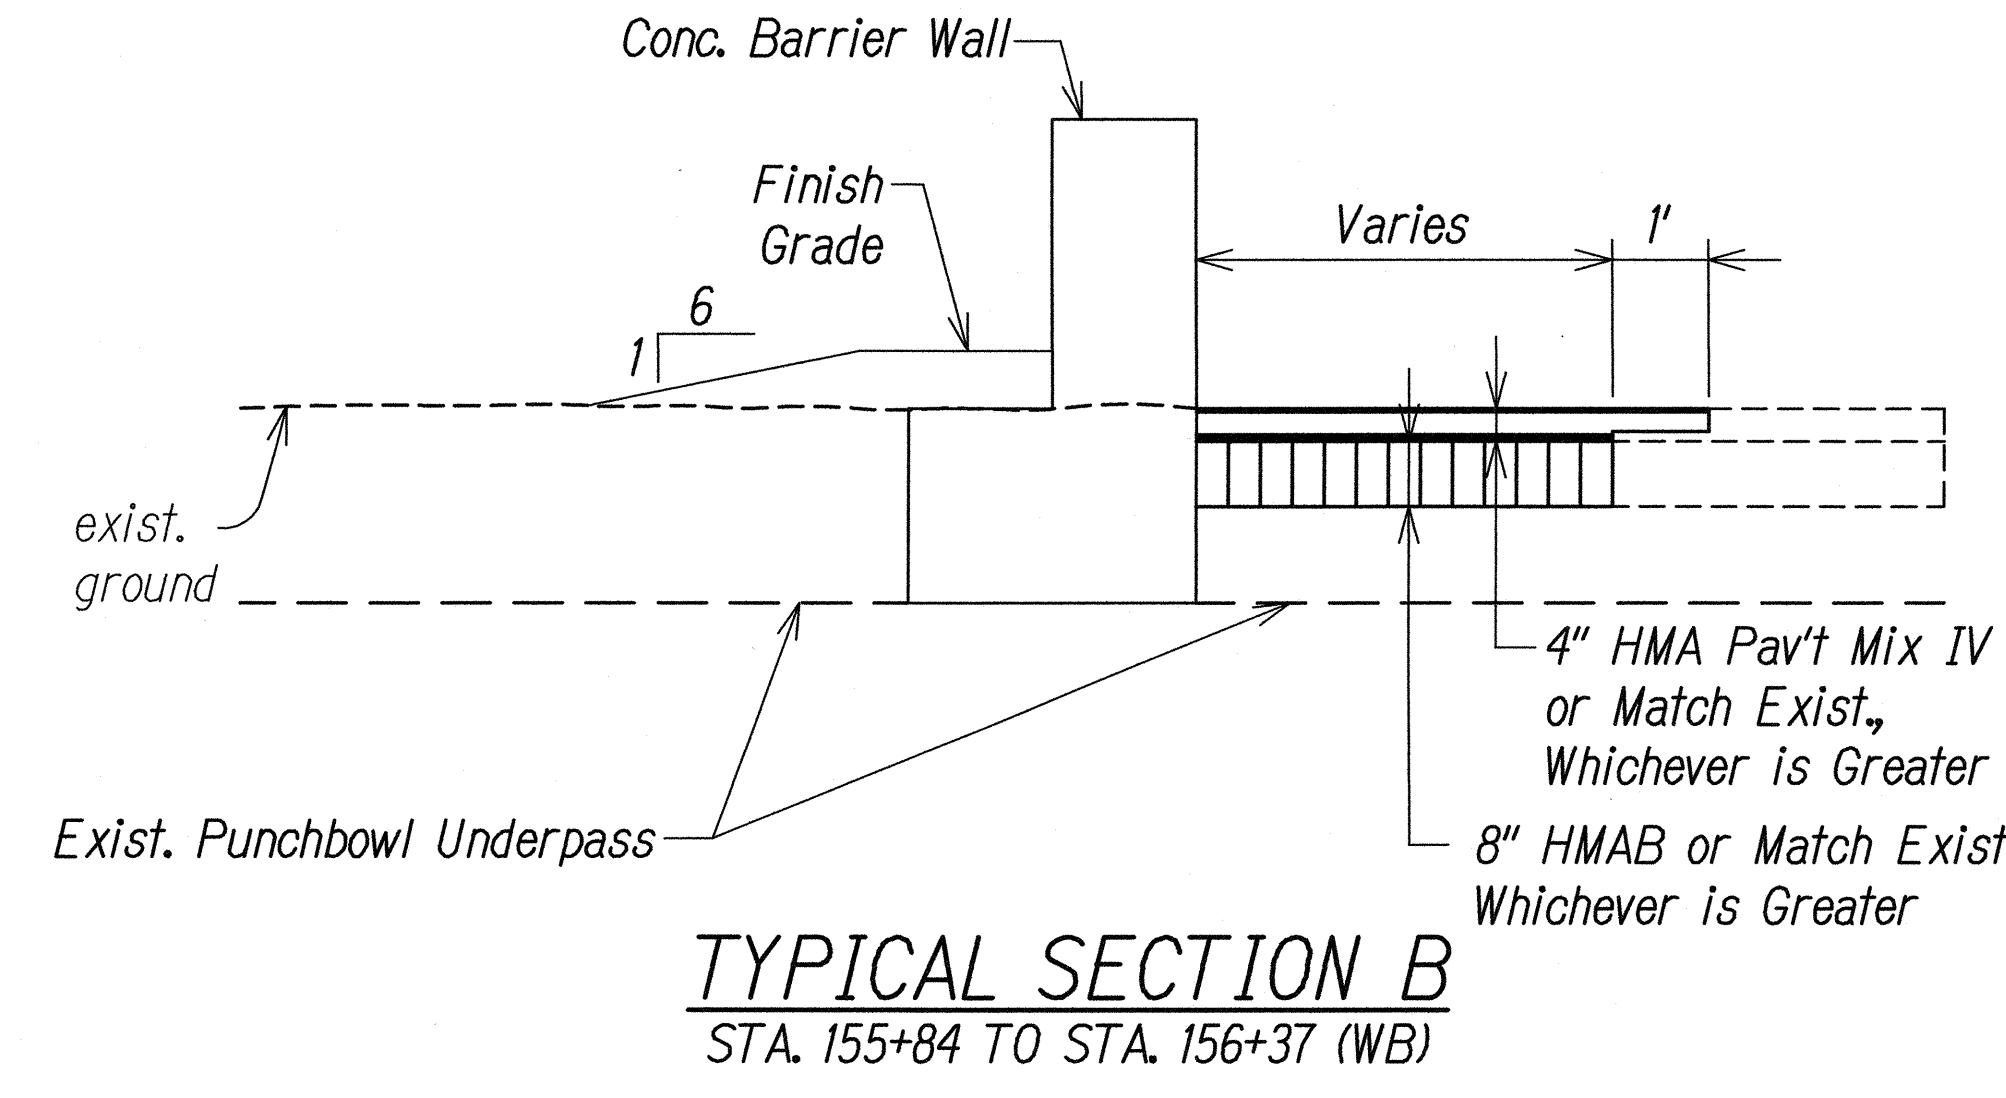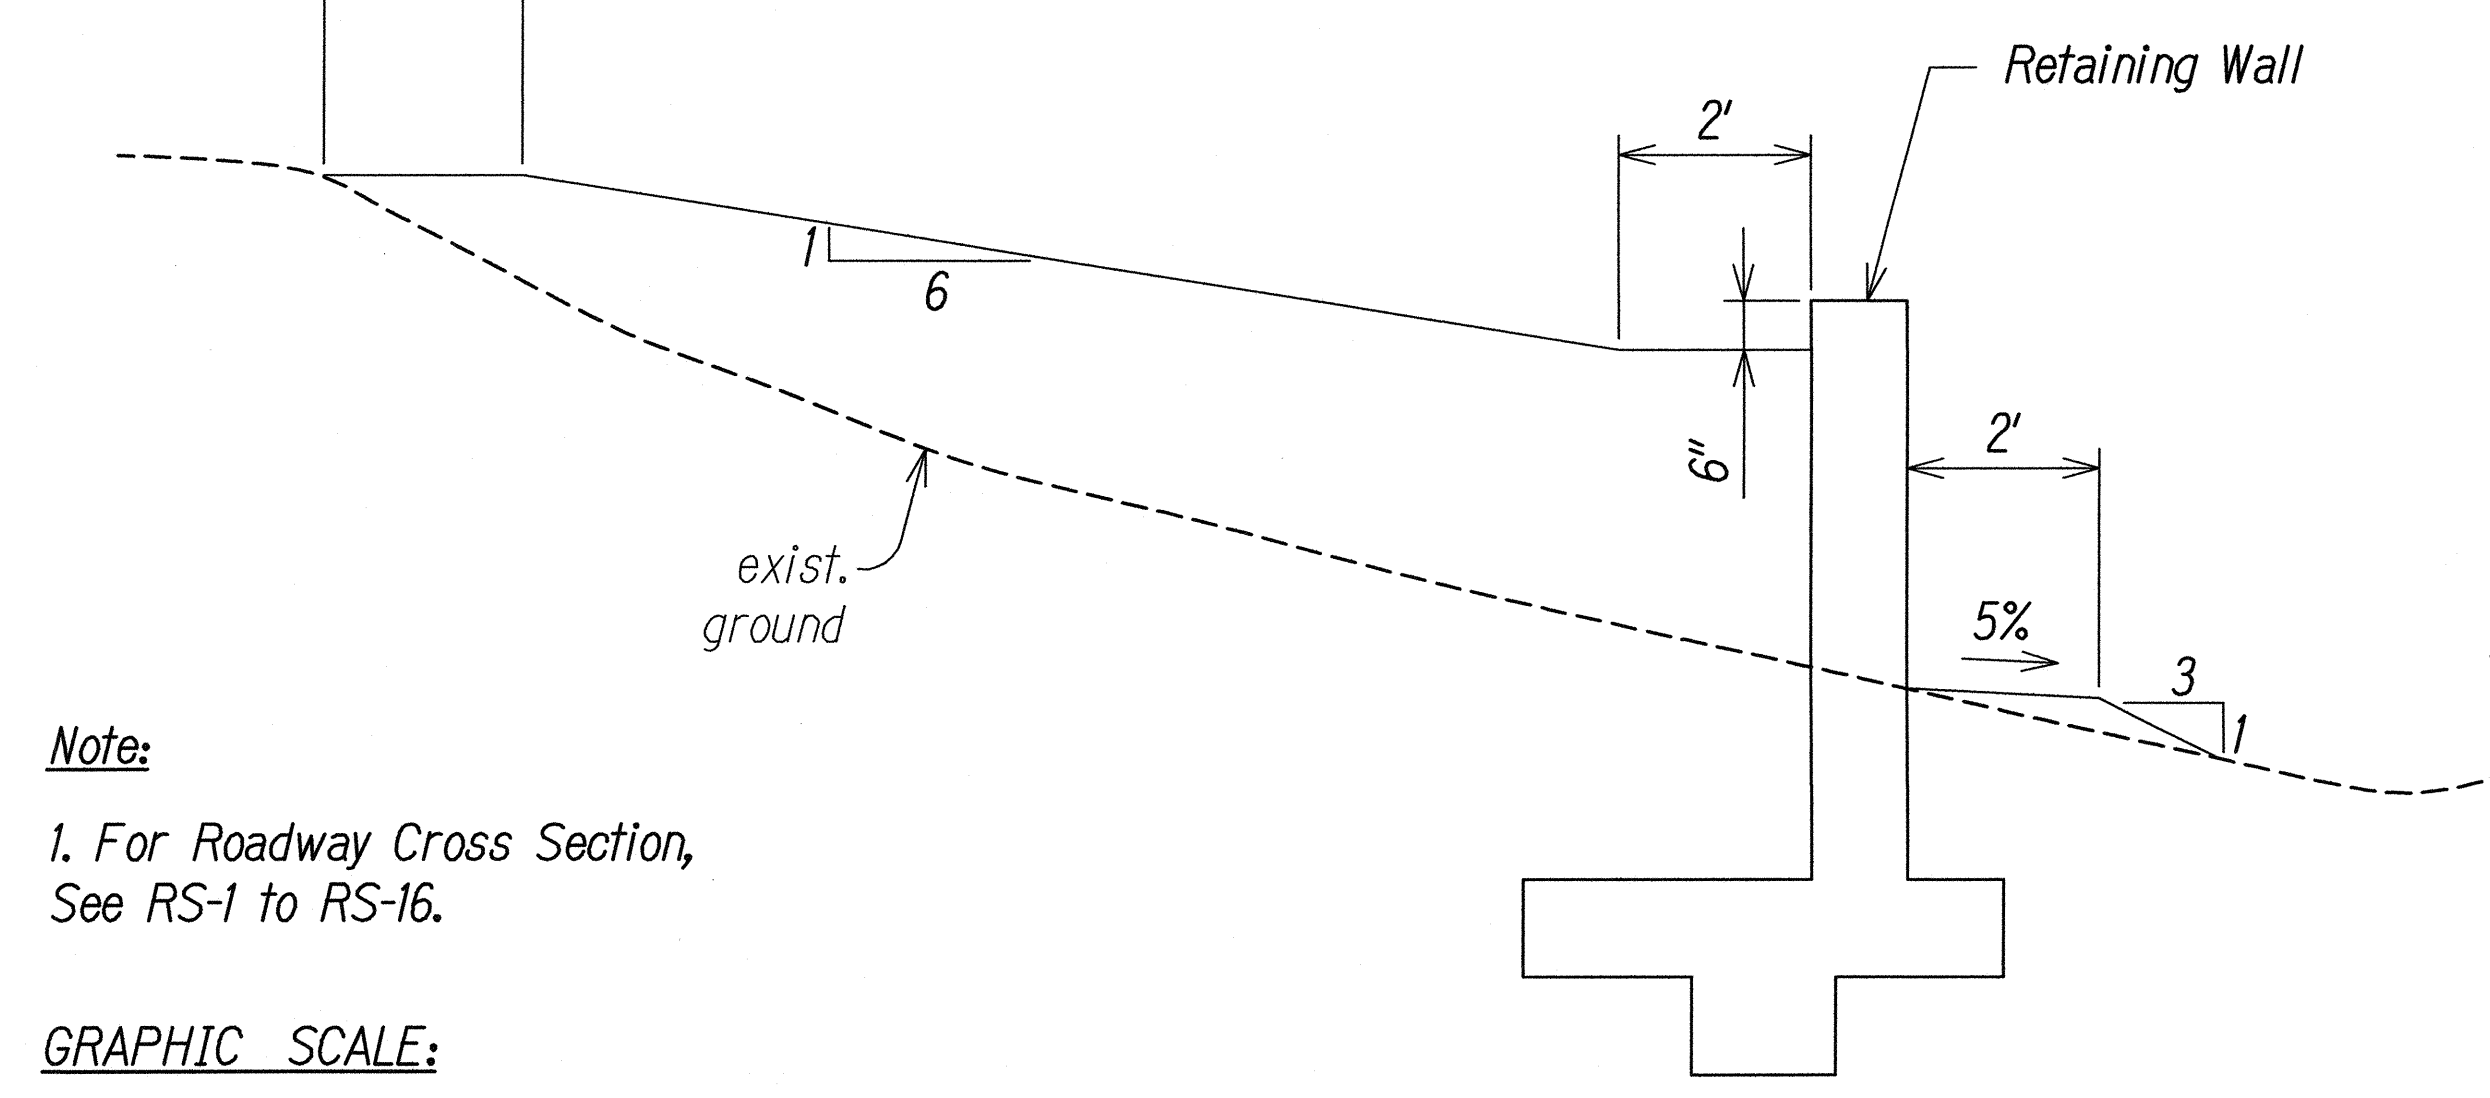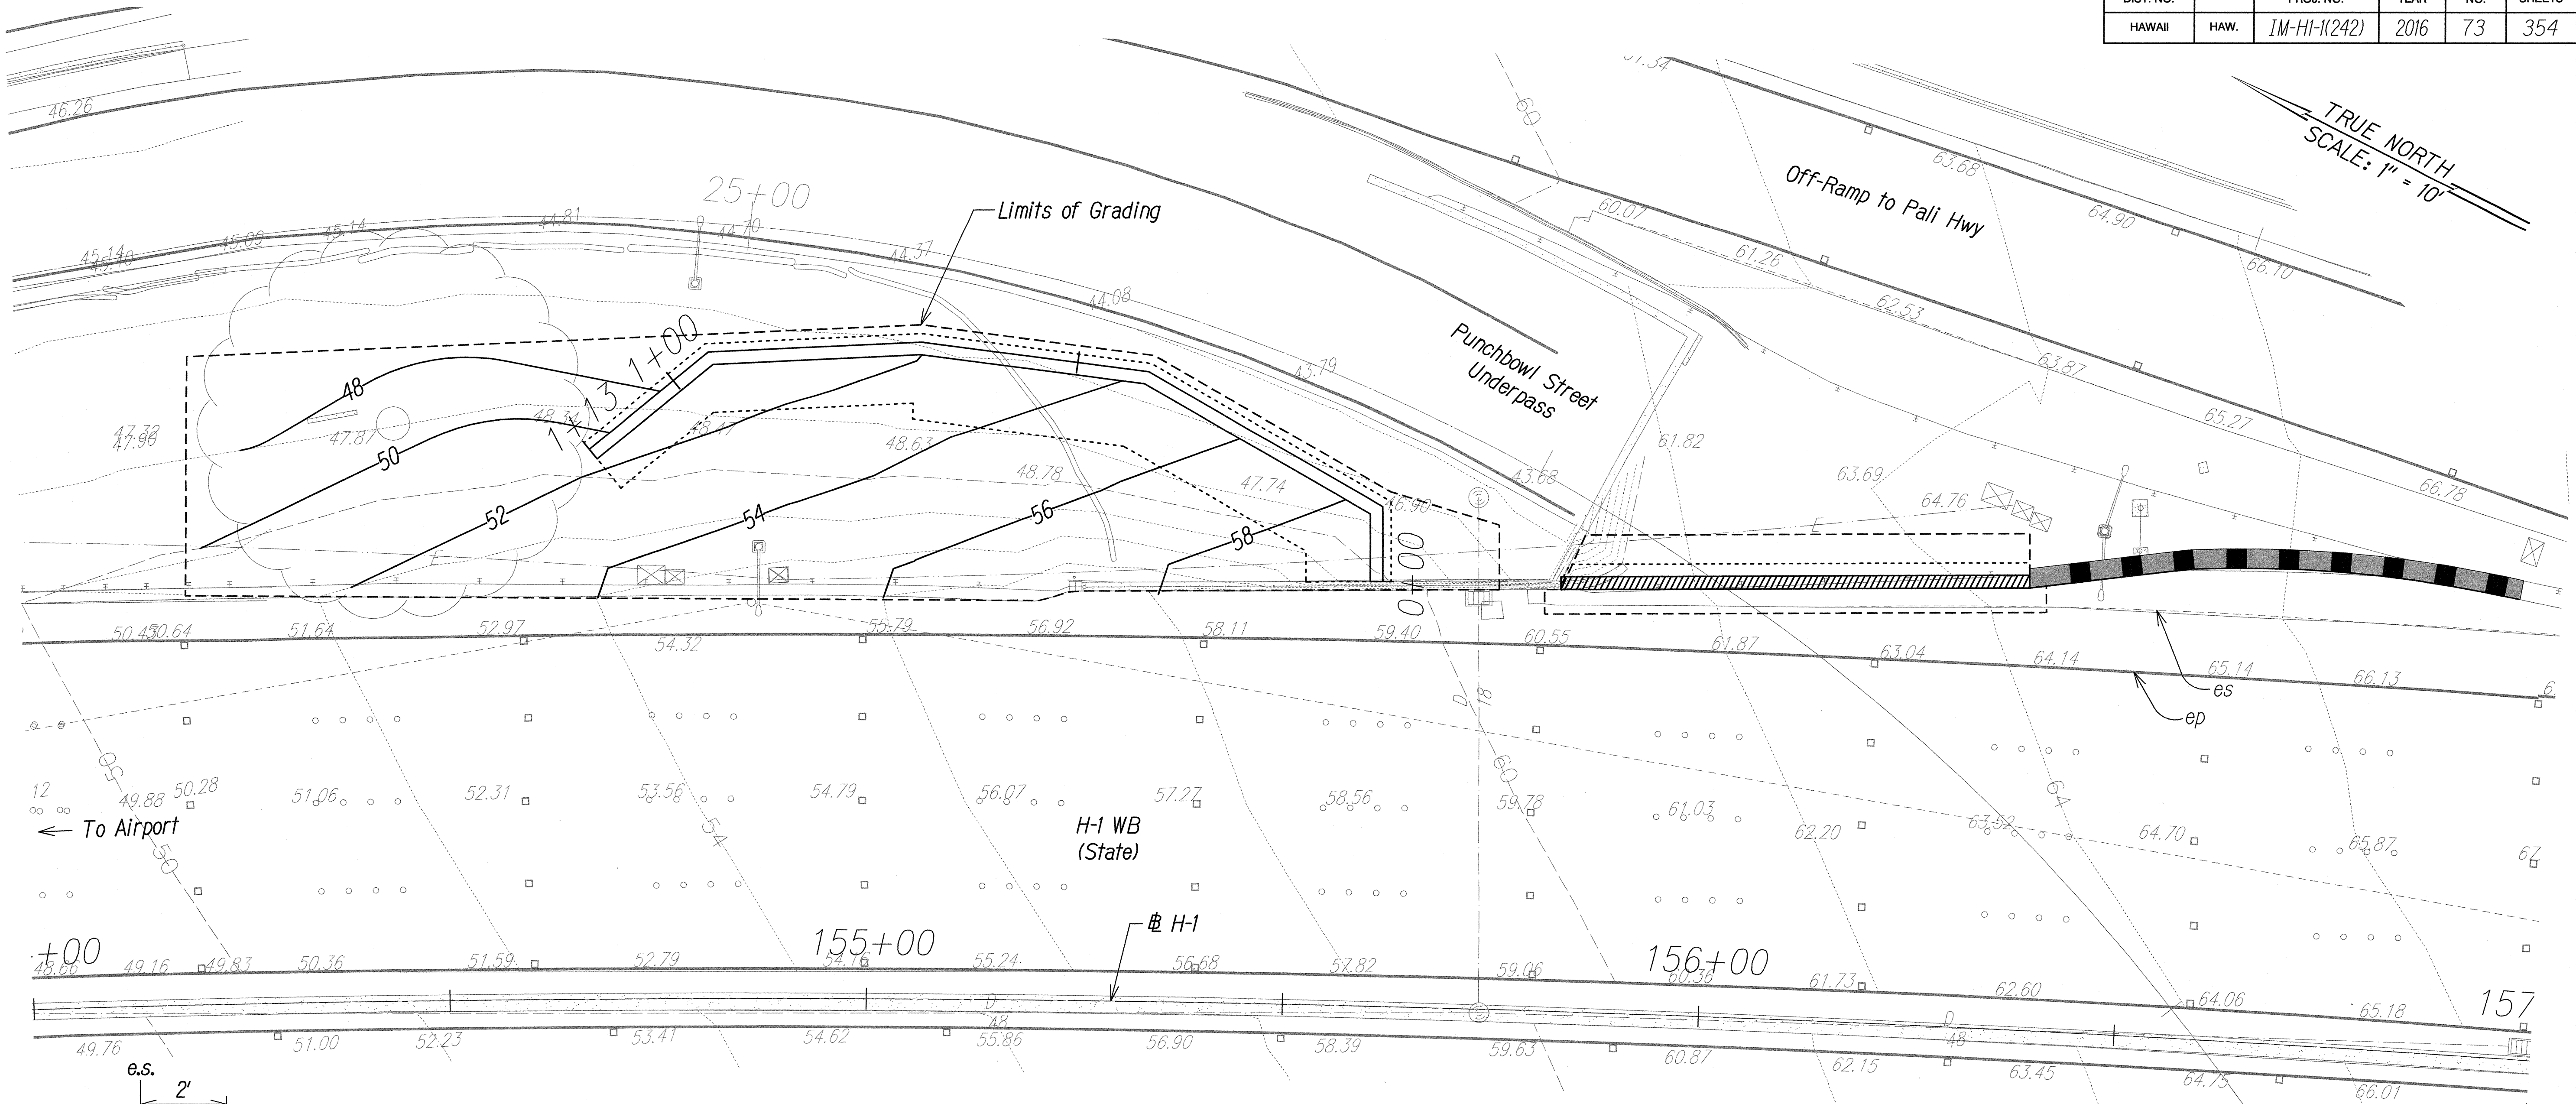

**Note:**  
1. For Roadway Cross Section, See RS-1 to RS-16.

**GRAPHIC SCALE:**  
10' 5' 0 10' 20'  
SCALE: 1" = 10'

**TYPICAL SECTION A**  
STA. 154+75 TO STA. 155+50 (WB)

**TYPICAL SECTION B**  
STA. 155+84 TO STA. 156+37 (WB)





THIS WORK WAS PREPARED BY ME OR UNDER MY SUPERVISION.  
*msk*  
WILSON OKAMOTO CORPORATION LIC. EXP. DATE

STATE OF HAWAII  
DEPARTMENT OF TRANSPORTATION  
HIGHWAYS DIVISION  
**PALI HIGHWAY OVERPASS**  
**GRADING PLAN**  
INTERSTATE ROUTE H-1  
GUARDRAIL AND SHOULDER IMPROVEMENTS  
Middle Street to Punchbowl Off-Ramp  
Fed. Aid Project No. 1M-H1-1(242)  
Scale: 1" = 10' Date: Mar. 2016  
SHEET No. GP-14 OF 16 SHEETS



| FED. ROAD DIST. NO. | STATE | FED. AID PROJ. NO. | FISCAL YEAR | SHEET NO. | TOTAL SHEETS |
|---------------------|-------|--------------------|-------------|-----------|--------------|
| HAWAII              | HAW.  | 1M-HI-1(242)       | 2016        | 74        | 354          |

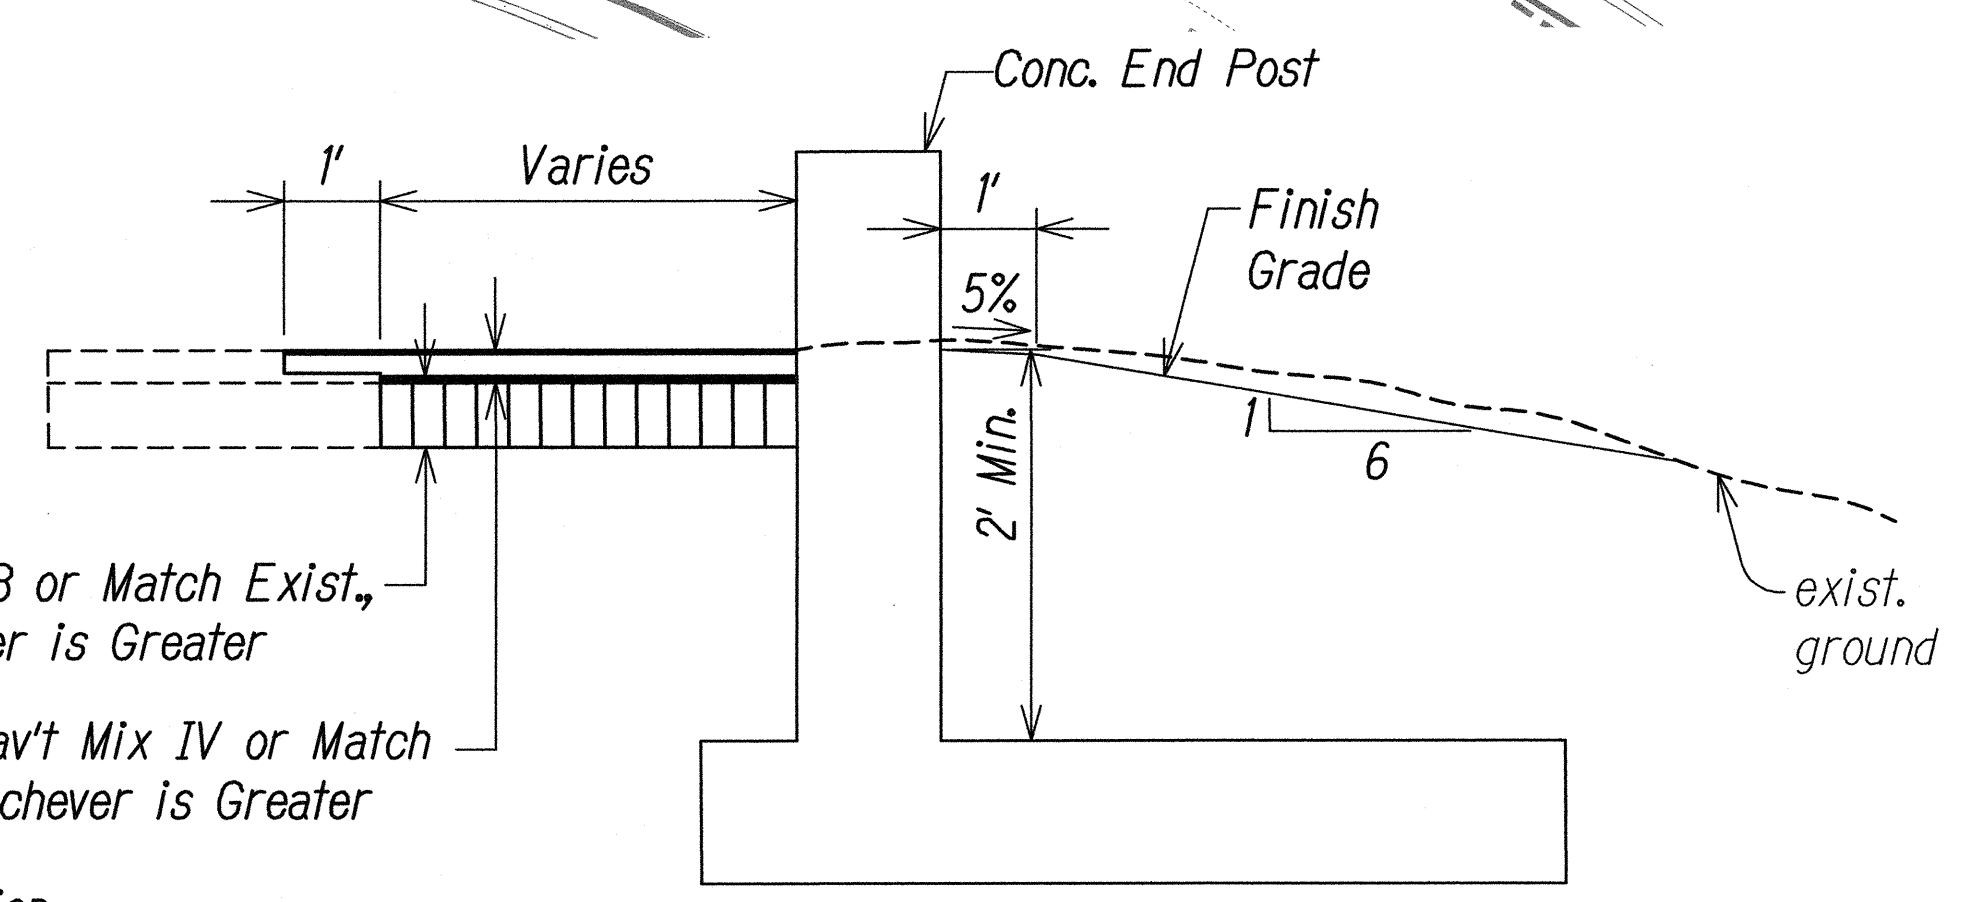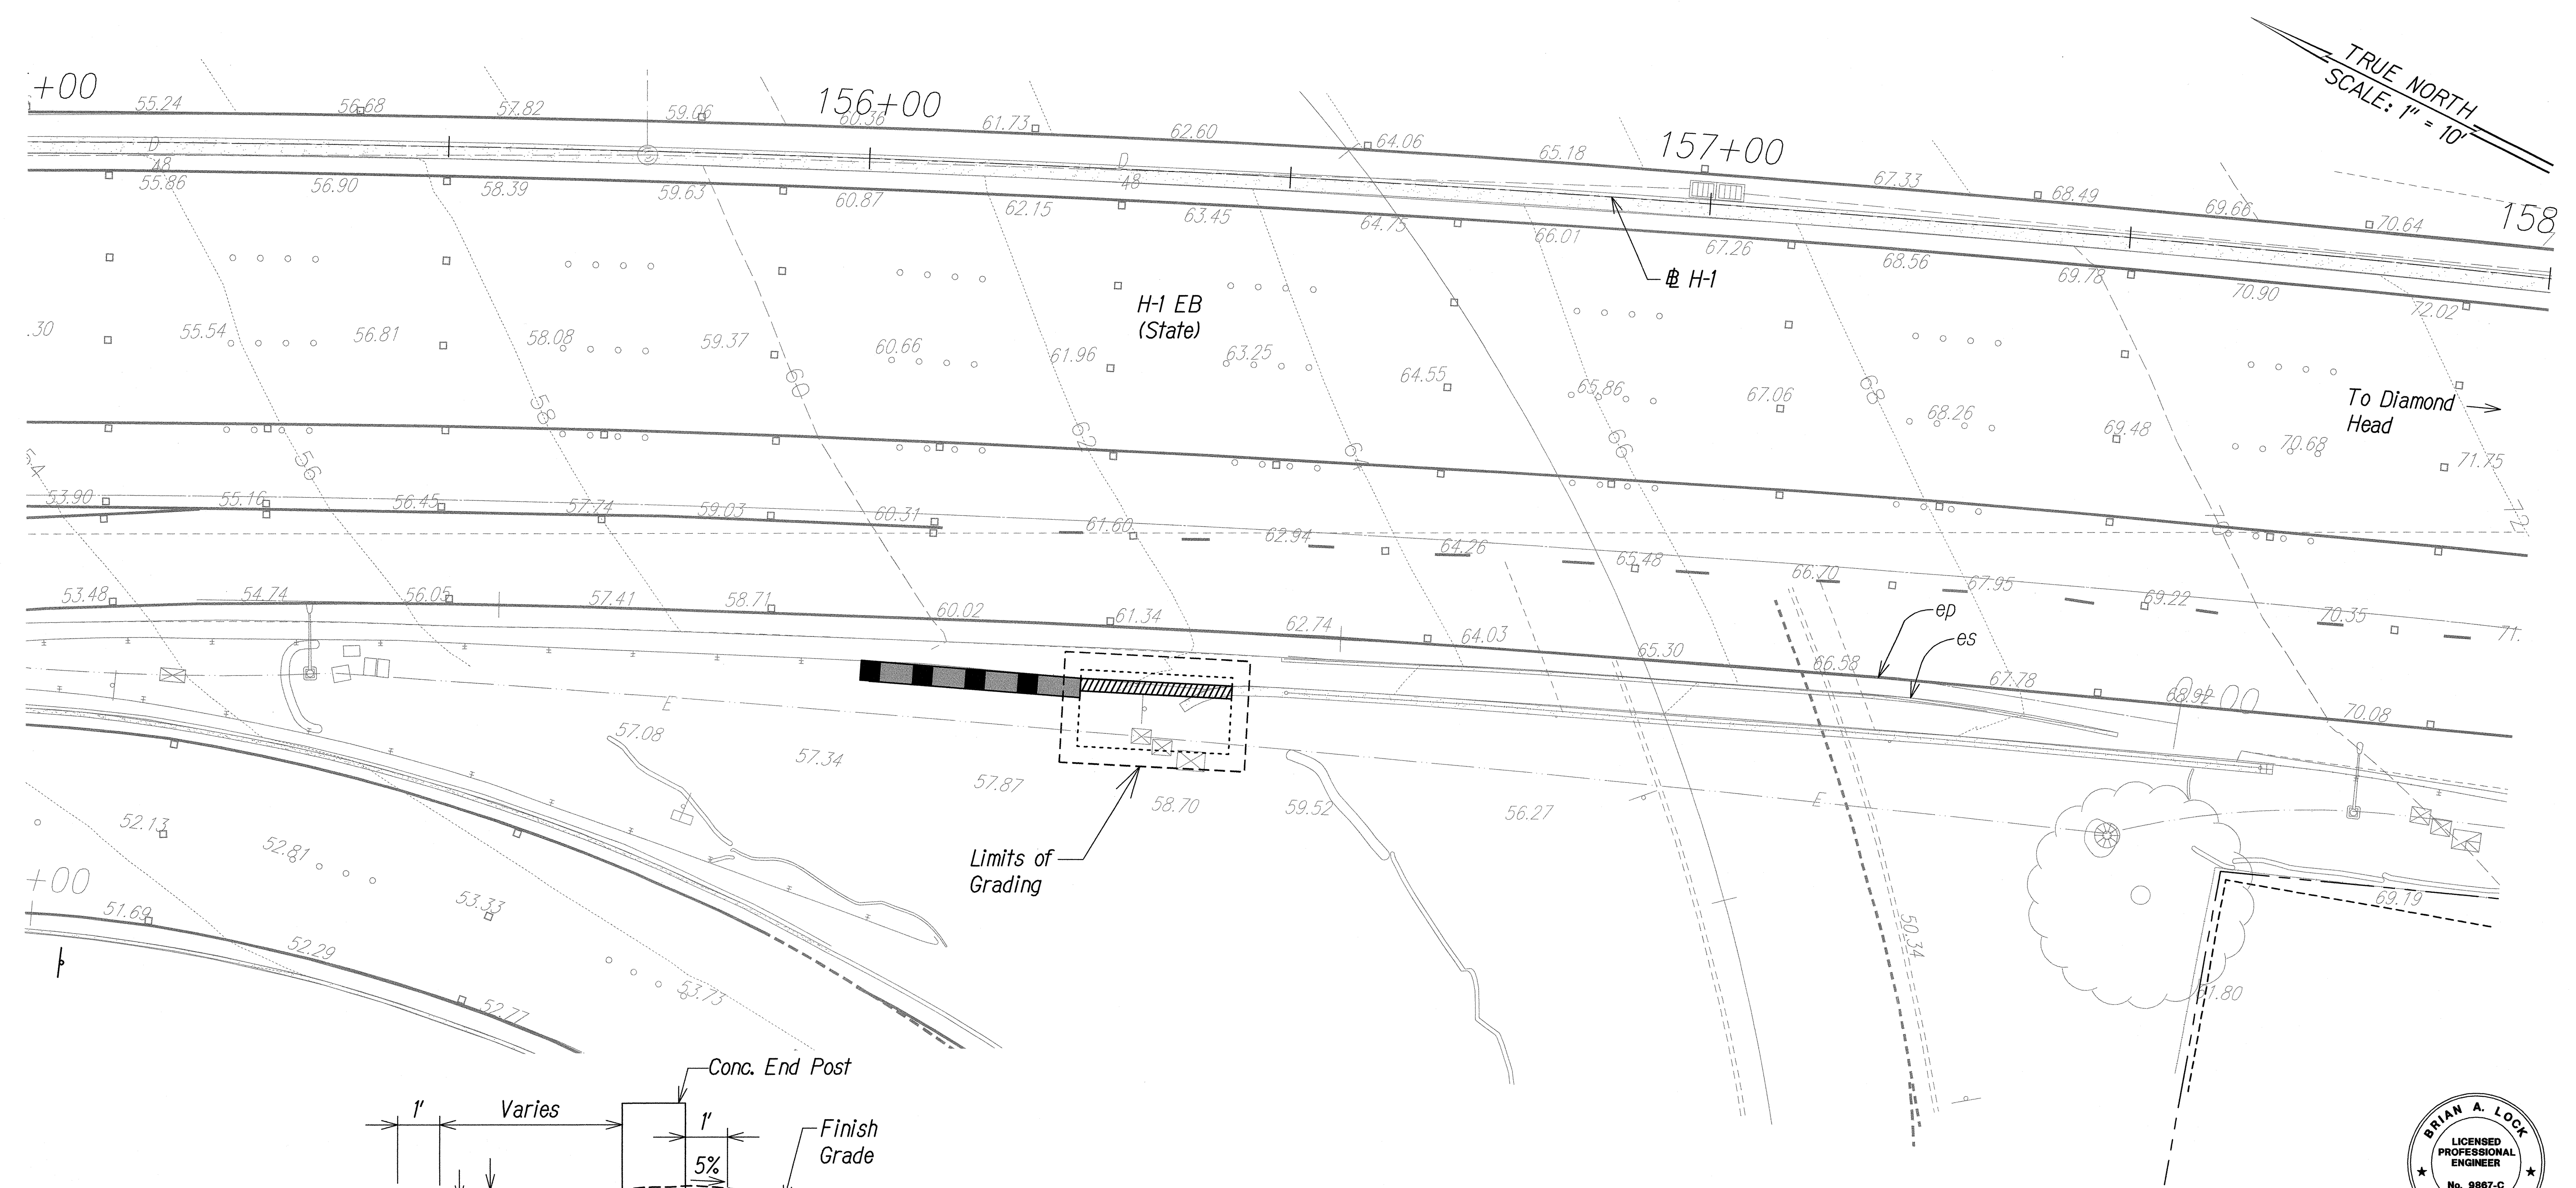


**Note:**  
 1. For Roadway Cross Section,  
 See RS-1 to RS-16.

**GRAPHIC SCALE:**  
 10' 5' 0 10' 20'  
 SCALE: 1" = 10'

**TYPICAL SECTION**  
 STA. 156+27 TO STA. 156+46 (EB)

**STA. 155+00 TO 158+00 (# H-1)**

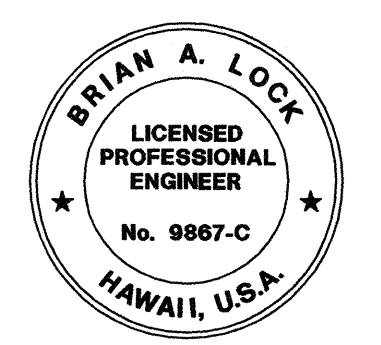




THIS WORK WAS PREPARED BY ME  
 OR UNDER MY SUPERVISION.  
*Wilson Okamoto*  
 WILSON OKAMOTO CORPORATION LIC. EXP. DATE

STATE OF HAWAII  
 DEPARTMENT OF TRANSPORTATION  
 HIGHWAYS DIVISION  
**PALI HIGHWAY OVERPASS**  
**GRADING PLAN**  
 INTERSTATE ROUTE H-1  
 GUARDRAIL AND SHOULDER IMPROVEMENTS  
 Middle Street to Punchbowl Off-Ramp  
 Fed. Aid Project No. 1M-HI-1(242)  
 Scale: 1" = 10' Date: Mar. 2016  
 SHEET No. GP-15 OF 16 SHEETS

|                  |                   |      |
|------------------|-------------------|------|
| ORIGINAL<br>PLAN | SURVEY PLOTTED BY | DATE |
|                  | DRAWN BY          |      |
|                  | DESIGNED BY       |      |
|                  | CHECKED BY        |      |
| NOTE BOOK<br>No. | QUANTITIES BY     |      |
|                  | CHECKED BY        |      |



| FED. ROAD DIST. NO. | STATE | FED. AID PROJ. NO. | FISCAL YEAR | SHEET NO. | TOTAL SHEETS |
|---------------------|-------|--------------------|-------------|-----------|--------------|
| HAWAII              | HAW.  | IM-HI-1(242)       | 2016        | 75        | 354          |

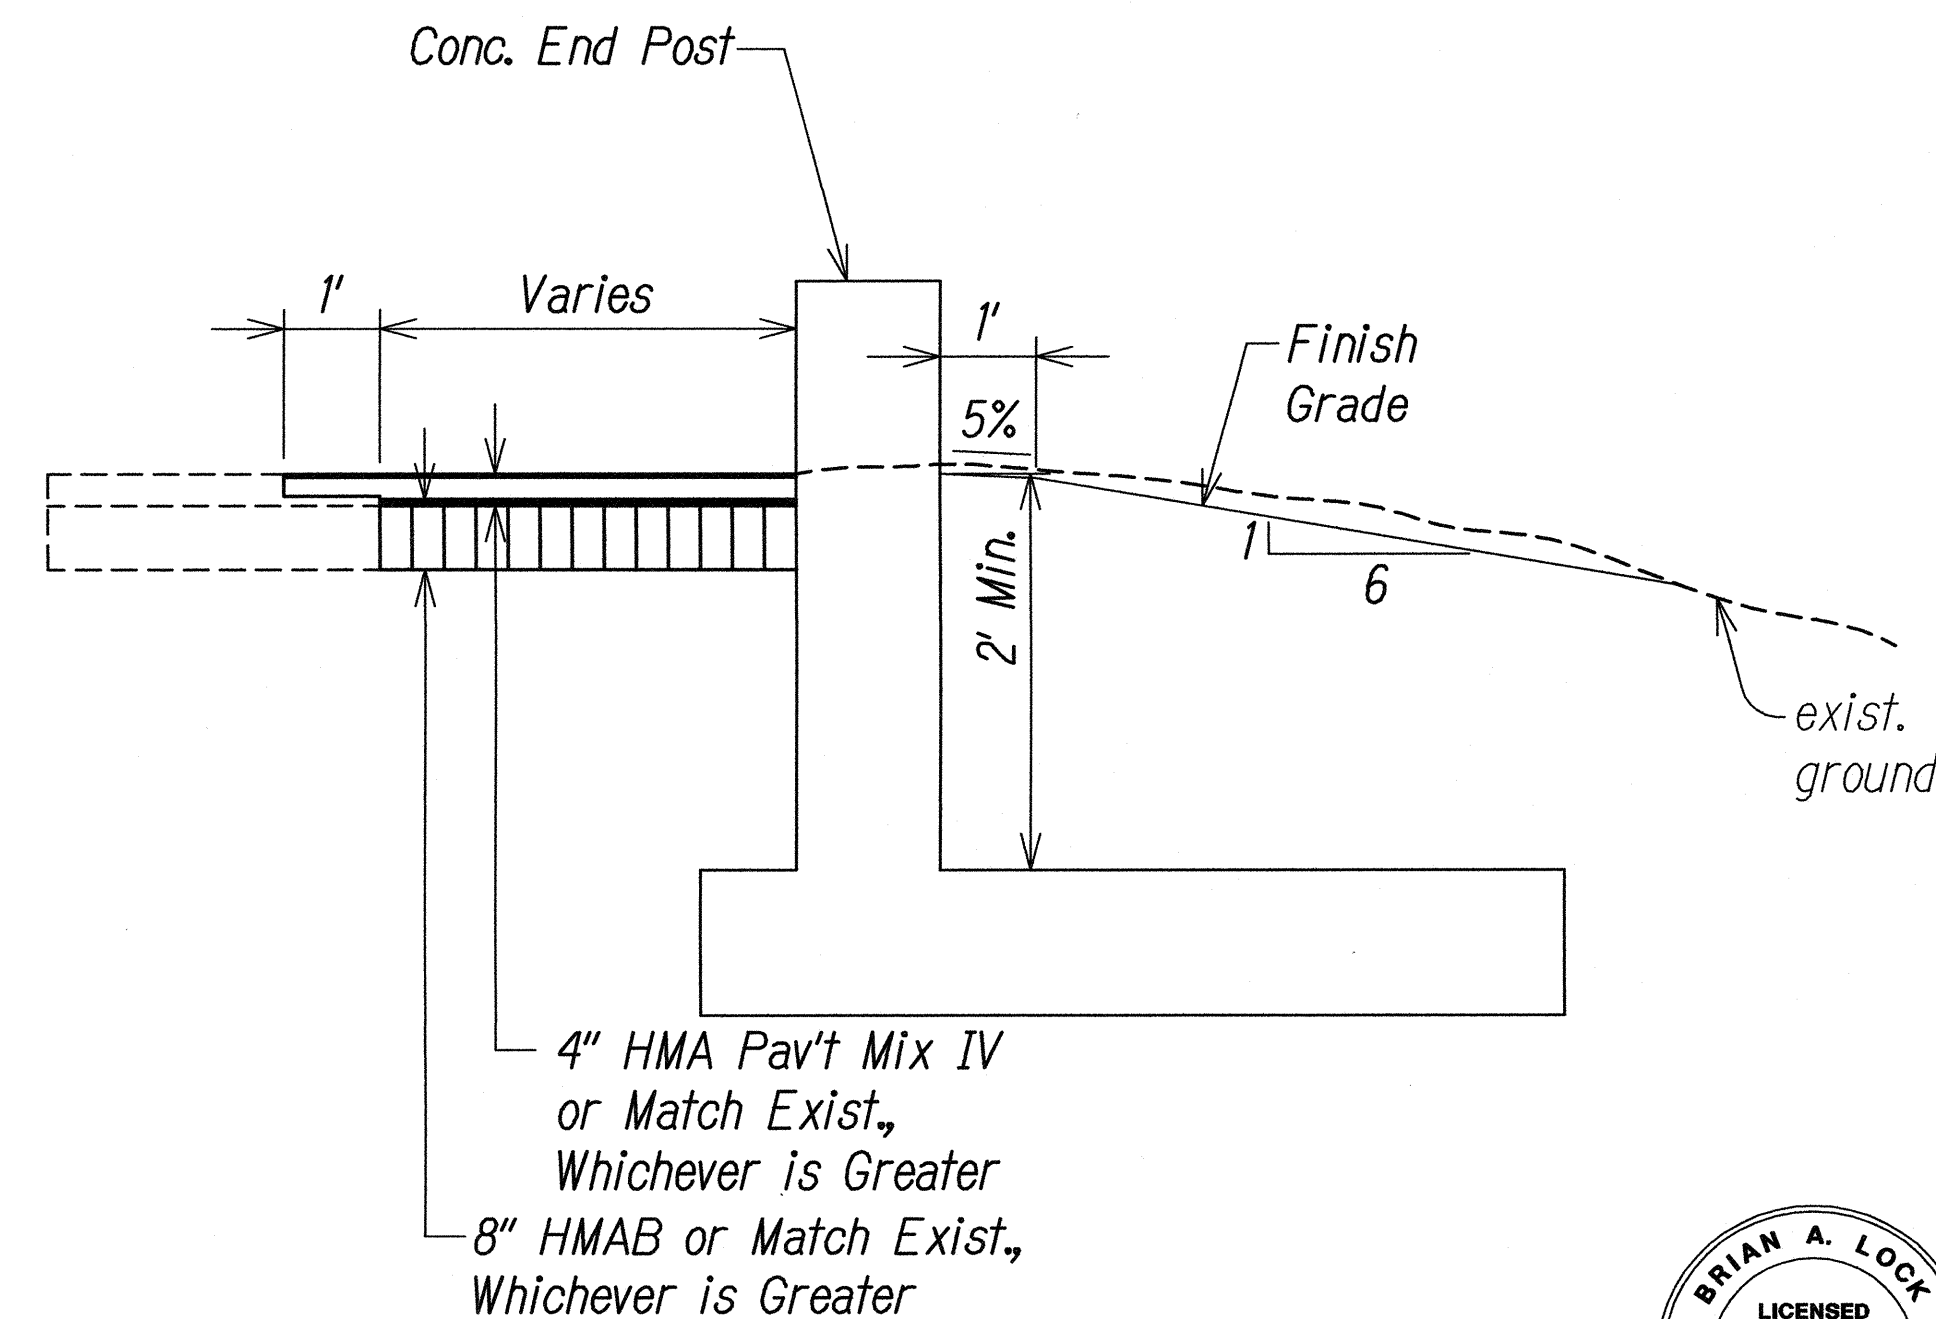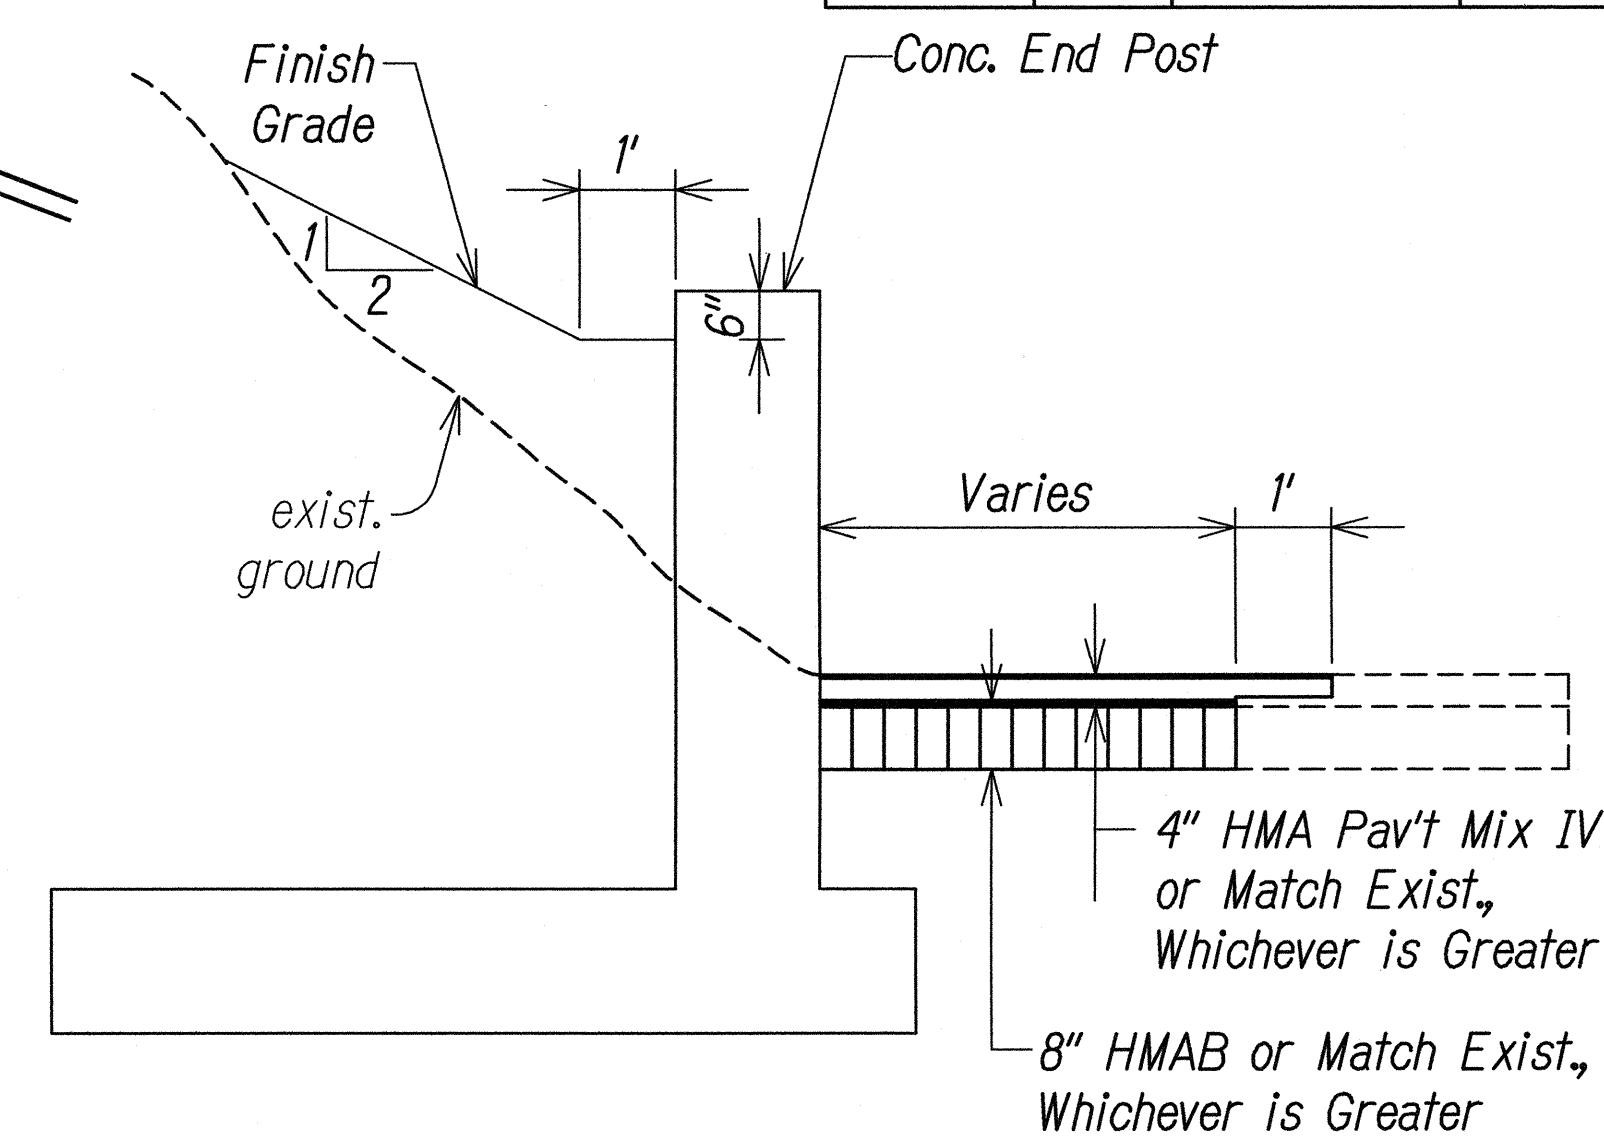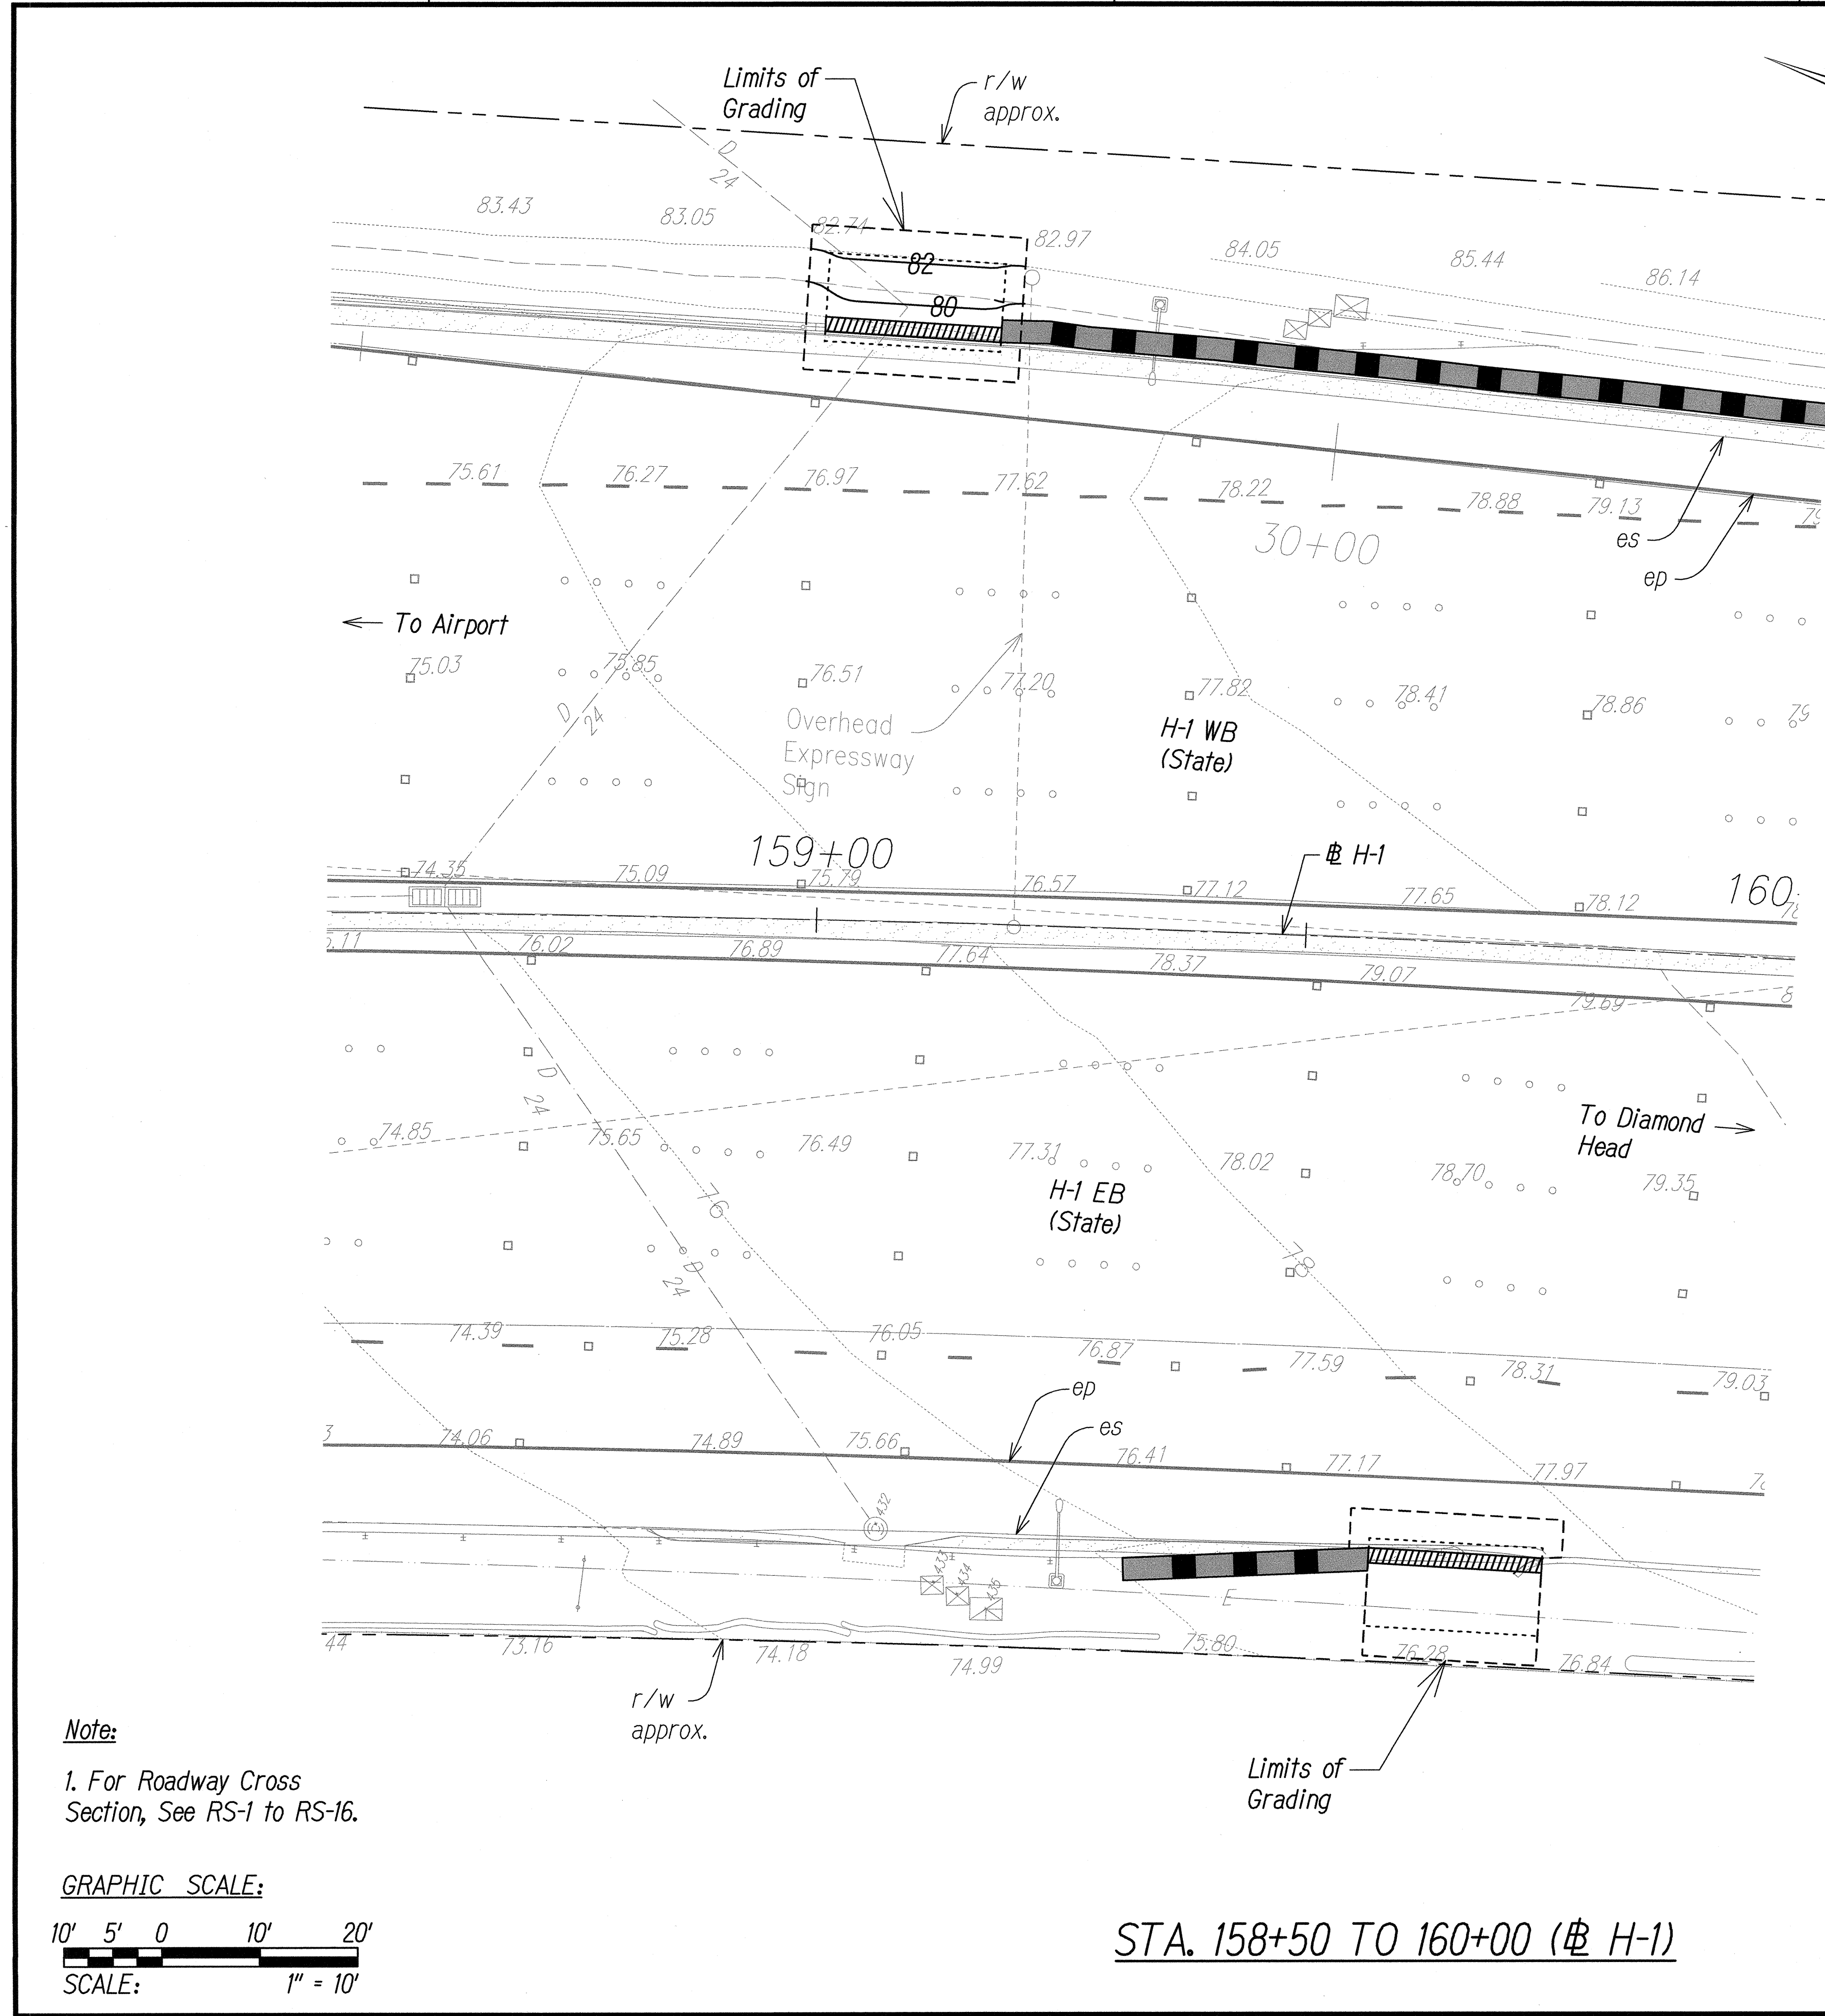

THIS WORK WAS PREPARED BY ME OR UNDER MY SUPERVISION.  
*mch*  
WILSON OKAMOTO CORPORATION LIC. EXP. DATE APRIL 30, 2018

STATE OF HAWAII  
DEPARTMENT OF TRANSPORTATION  
HIGHWAYS DIVISION  
**PALI HIGHWAY OVERPASS**  
**GRADING PLAN**  
INTERSTATE ROUTE H-1  
GUARDRAIL AND SHOULDER IMPROVEMENTS  
Middle Street to Punchbowl Off-Ramp  
Fed. Aid Project No. IM-HI-1(242)  
Scale: 1" = 10'      Date: Mar. 2016  
SHEET No. GP-16 OF 16 SHEETS