



FED. ROAD DIST. NO.	STATE	FED. AID PROJ. NO.	FISCAL YEAR	SHEET NO.	TOTAL SHEETS
HAWAII	HAW.	1M-H1-1(242)	2016	93	354

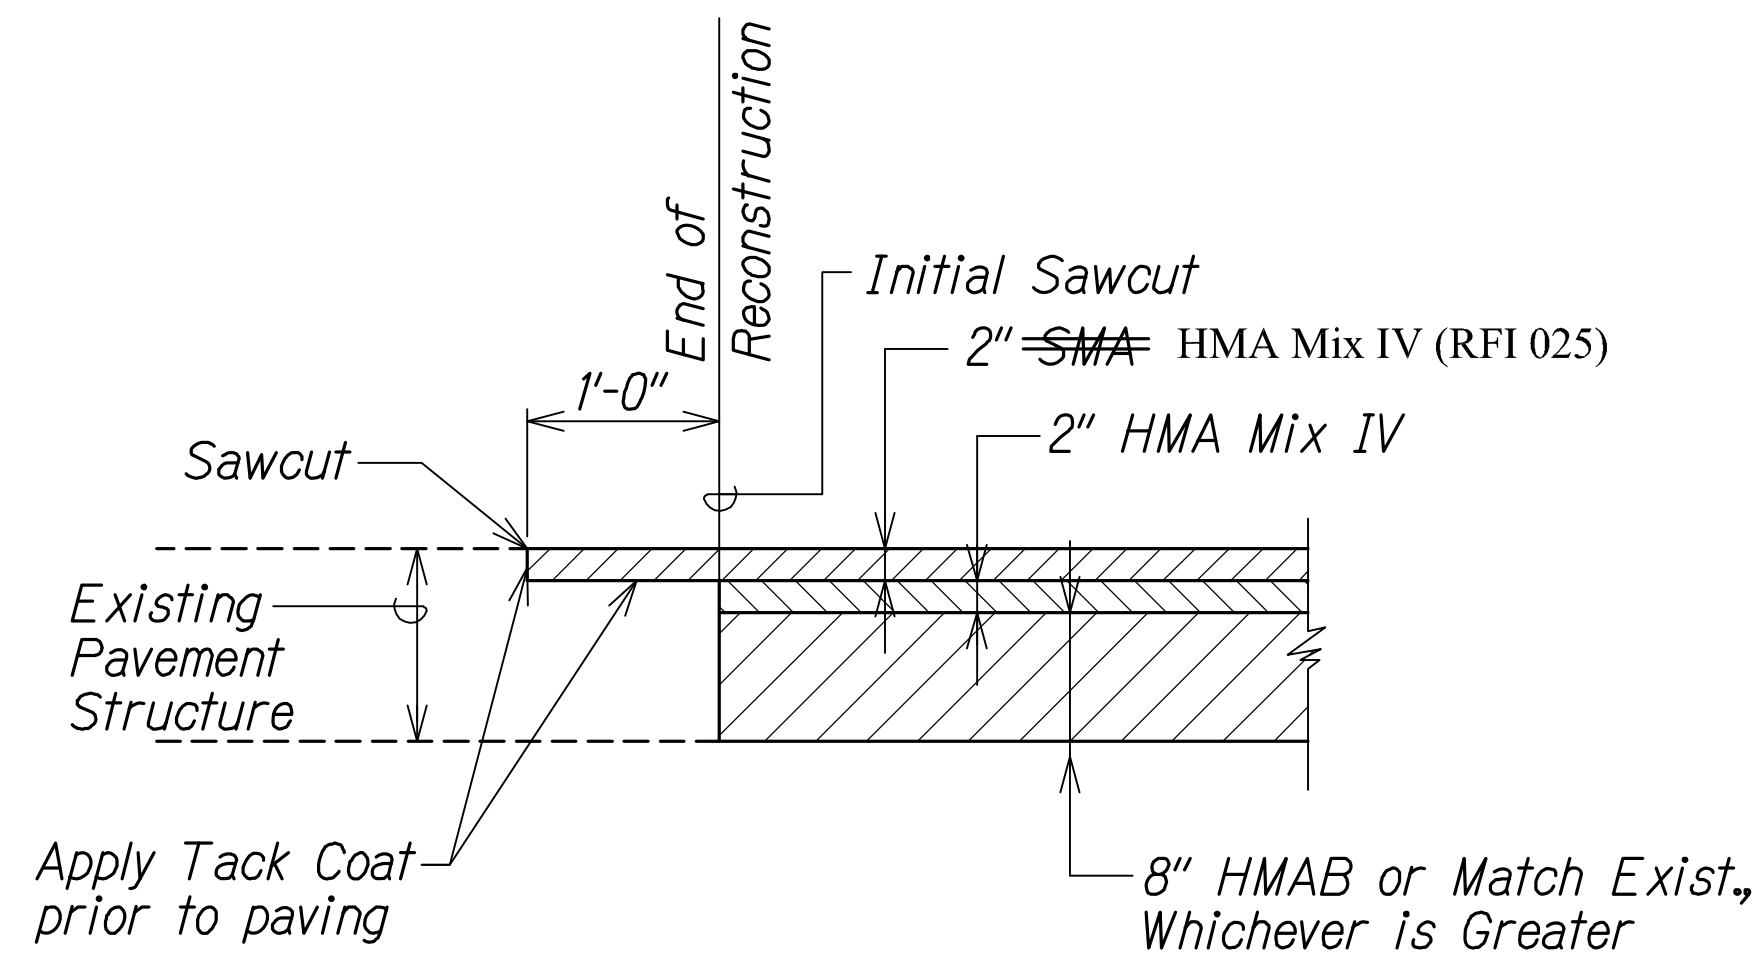

Note:
1. Provide Smooth & Flush Connection to Existing Pavements.


PAVEMENT RESTORATION DETAIL

Scale: 1" = 1'

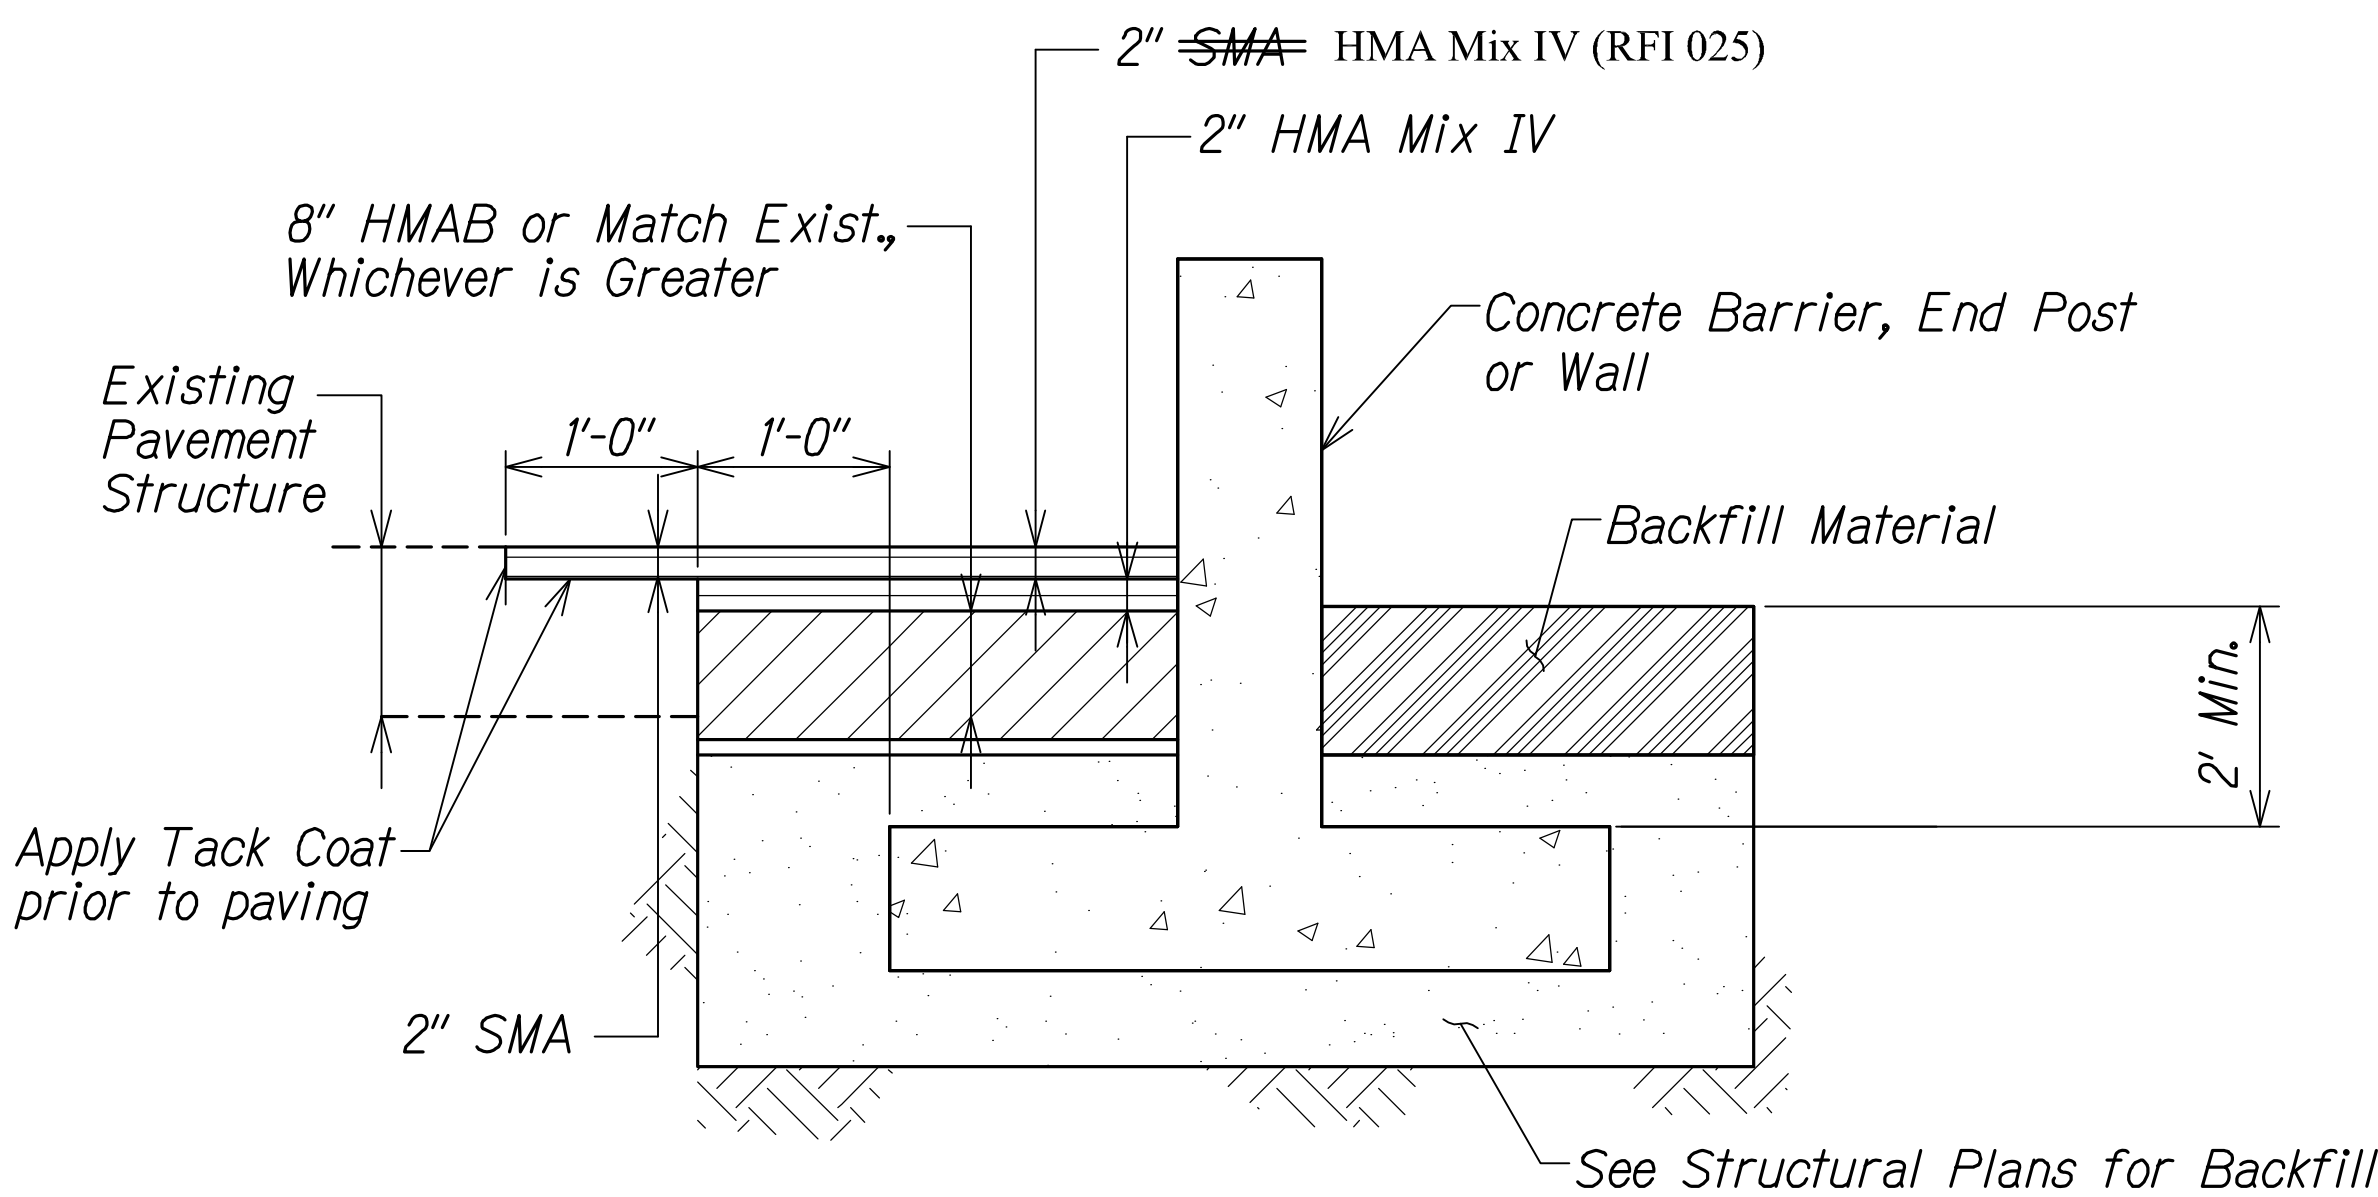


PAVEMENT RESTORATION ADJACENT TO CONCRETE ENDPOST/BARRIER WALL

Scale: 1" = 1'

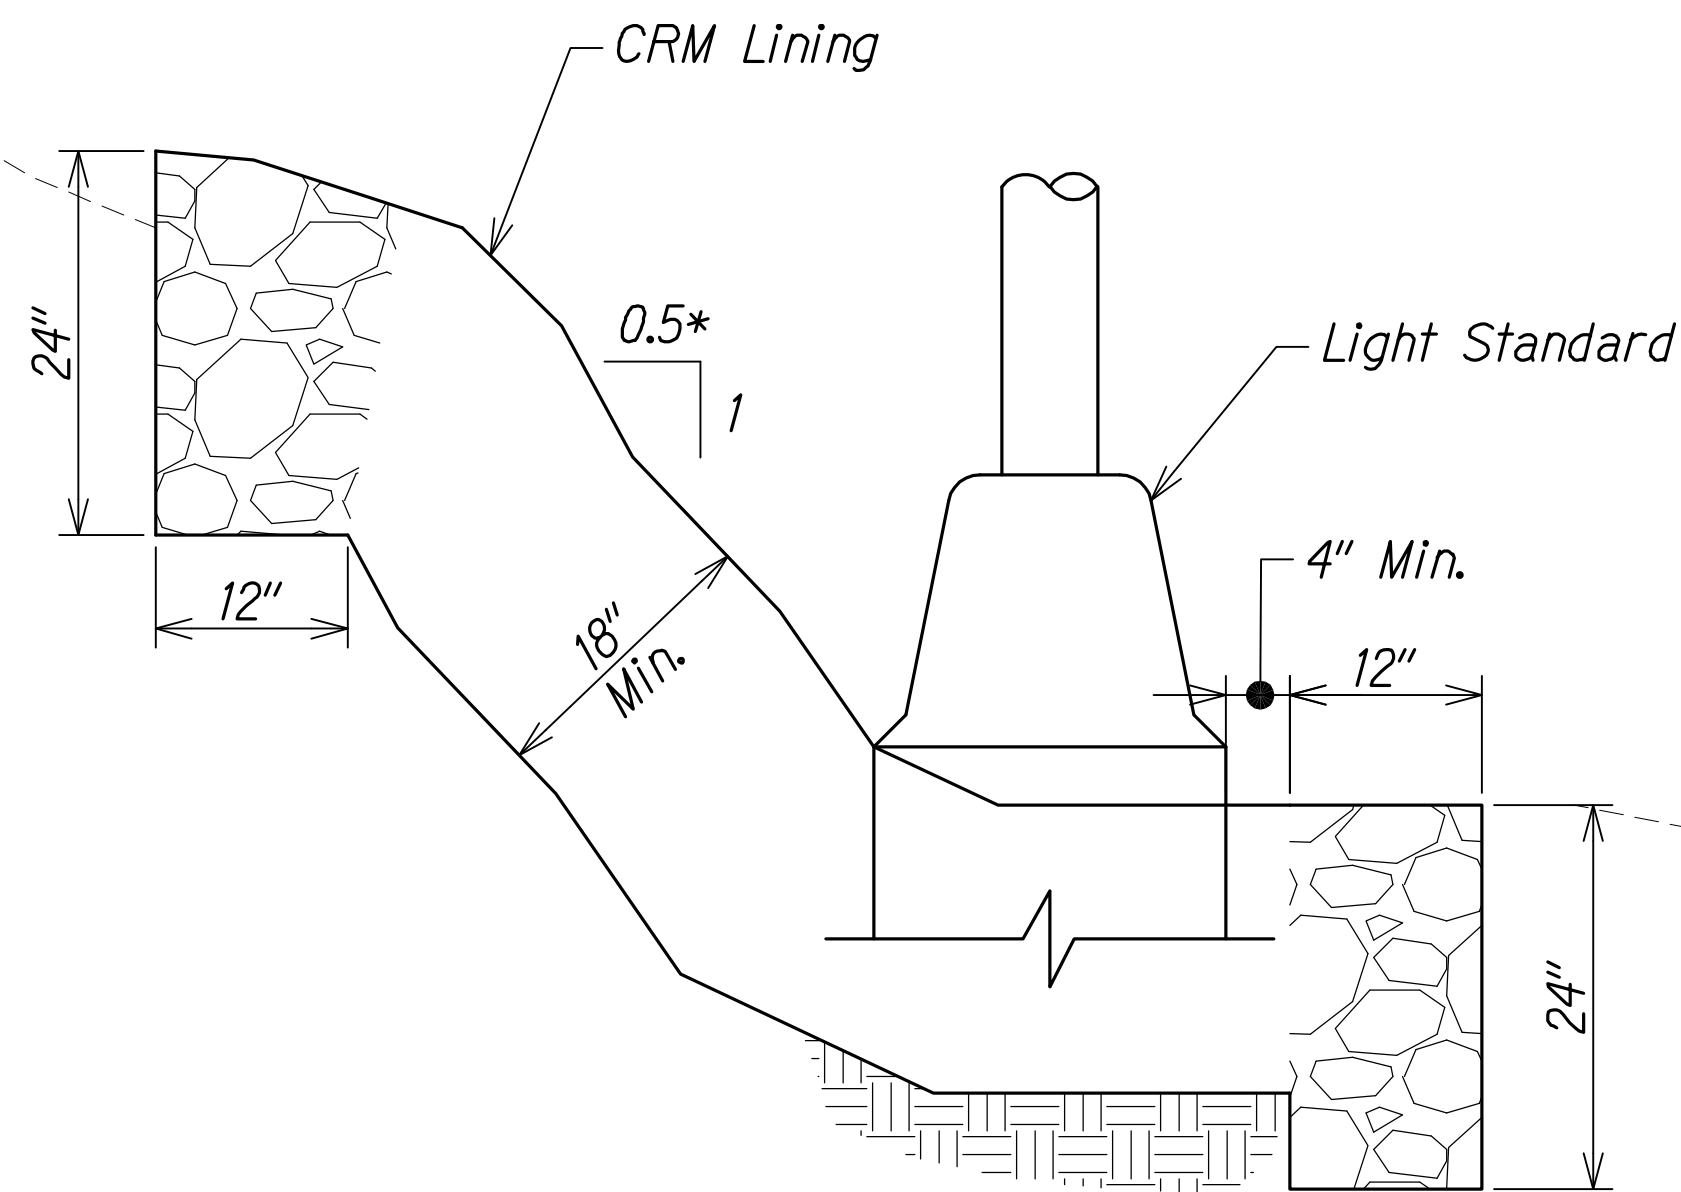

CRM LINING NEAR LIGHT STANDARD PEDESTAL

Scale: NTS

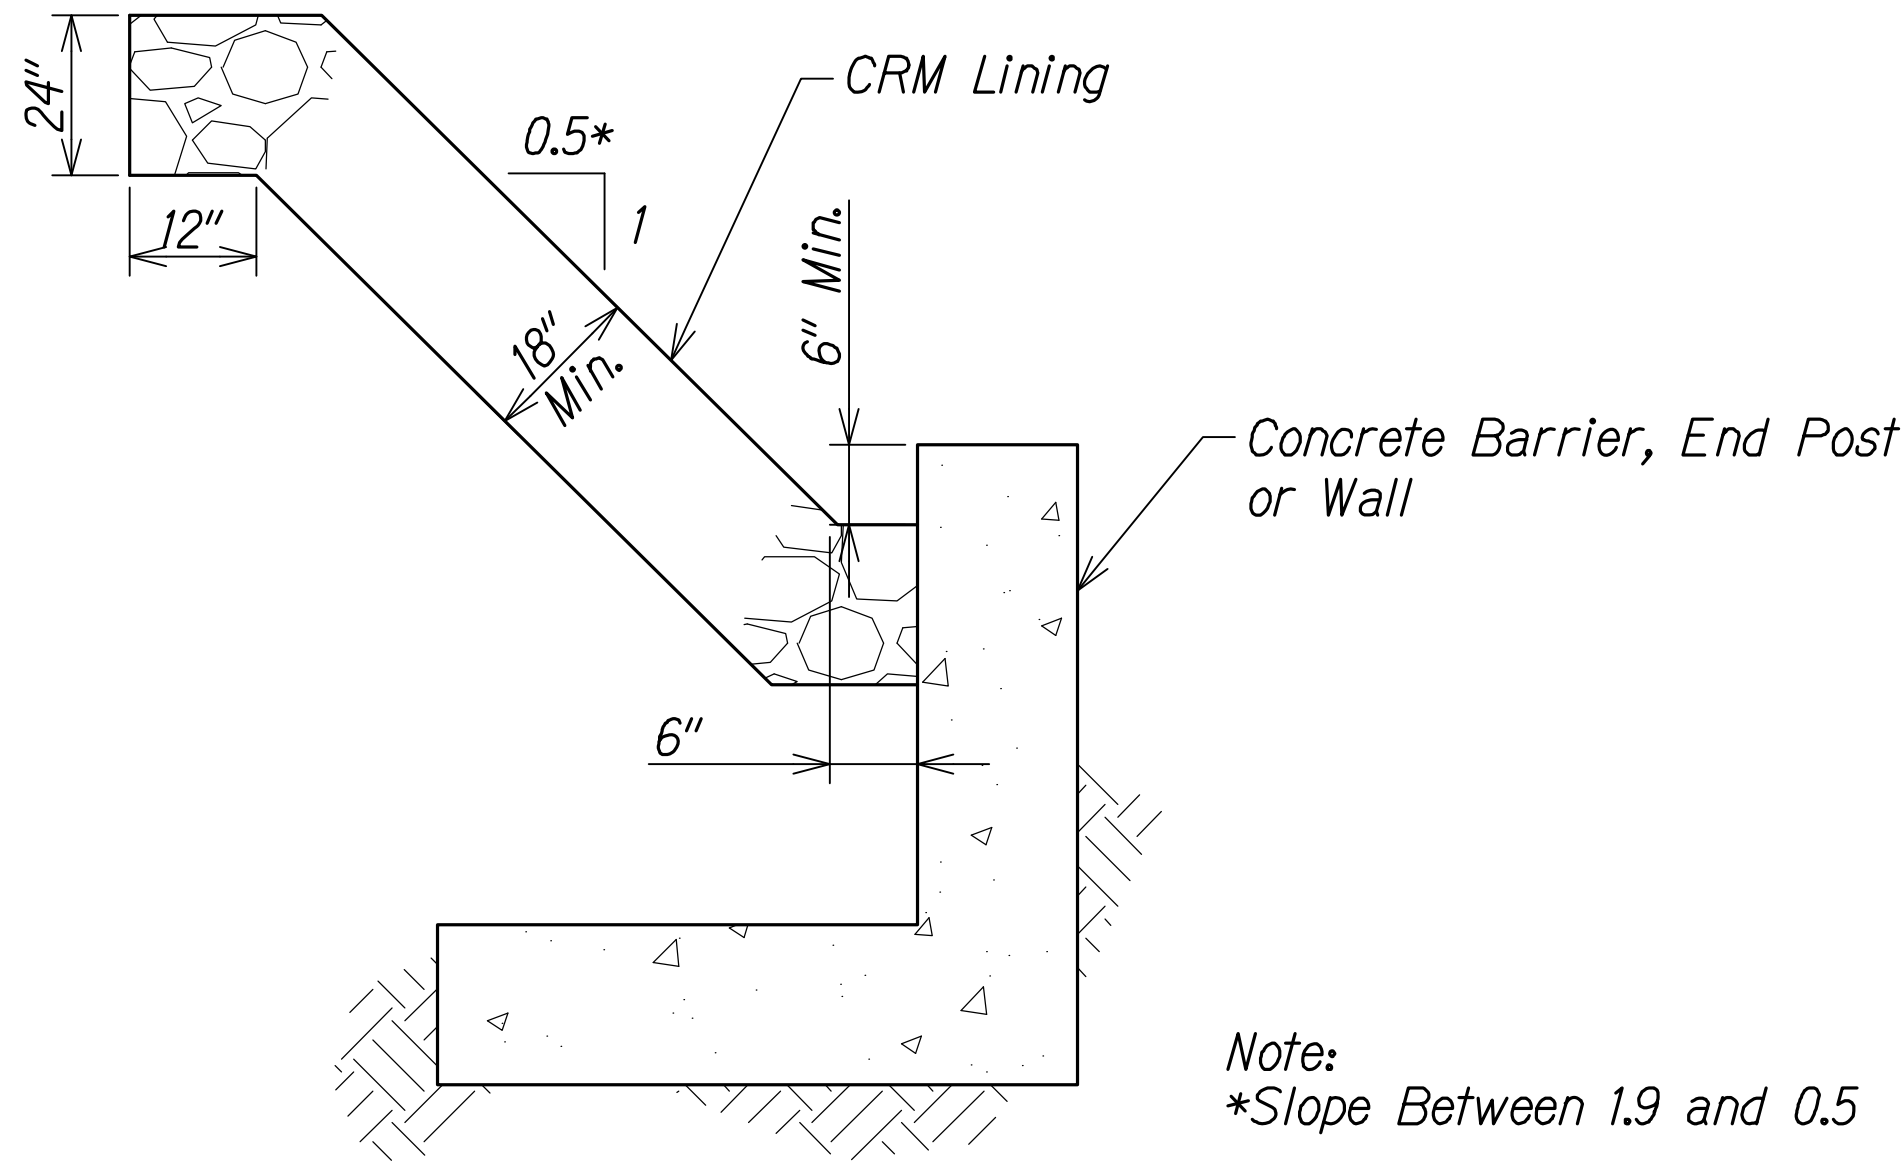

CRM LINING NEAR CONCRETE BARRIER


Scale: NTS

LEGEND FOR AS-BUILT POSTINGS

Squiggly line for as-built deletion

Double line for as-built deletion

Roadway Text for as-built posting

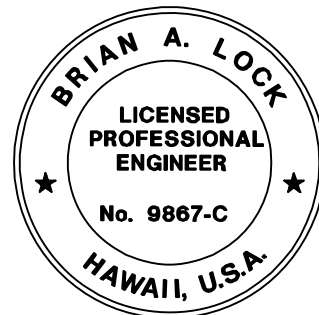

THIS WORK WAS PREPARED BY ME OR UNDER MY SUPERVISION.

WILSON OKAMOTO CORPORATION APRIL 30, 2020 LIC. EXP. DATE

STATE OF HAWAII
DEPARTMENT OF TRANSPORTATION
HIGHWAYS DIVISION

MISCELLANEOUS DETAILS

INTERSTATE ROUTE H-1
GUARDRAIL AND SHOULDER IMPROVEMENTS
Middle Street to Punchbowl Off-Ramp
Fed. Aid Project No. 1M-H1-1(242)
Scale: As Shown Date: Mar. 2016

SHEET No. DET-10F 1 SHEETS

SURVEY PLOTTED BY	DATE
DRAWN BY	
DESIGNED BY	
QUANTITIES BY	
CHECKED BY	

ORIGINAL PLAN	NOTE BOOK
No.	