

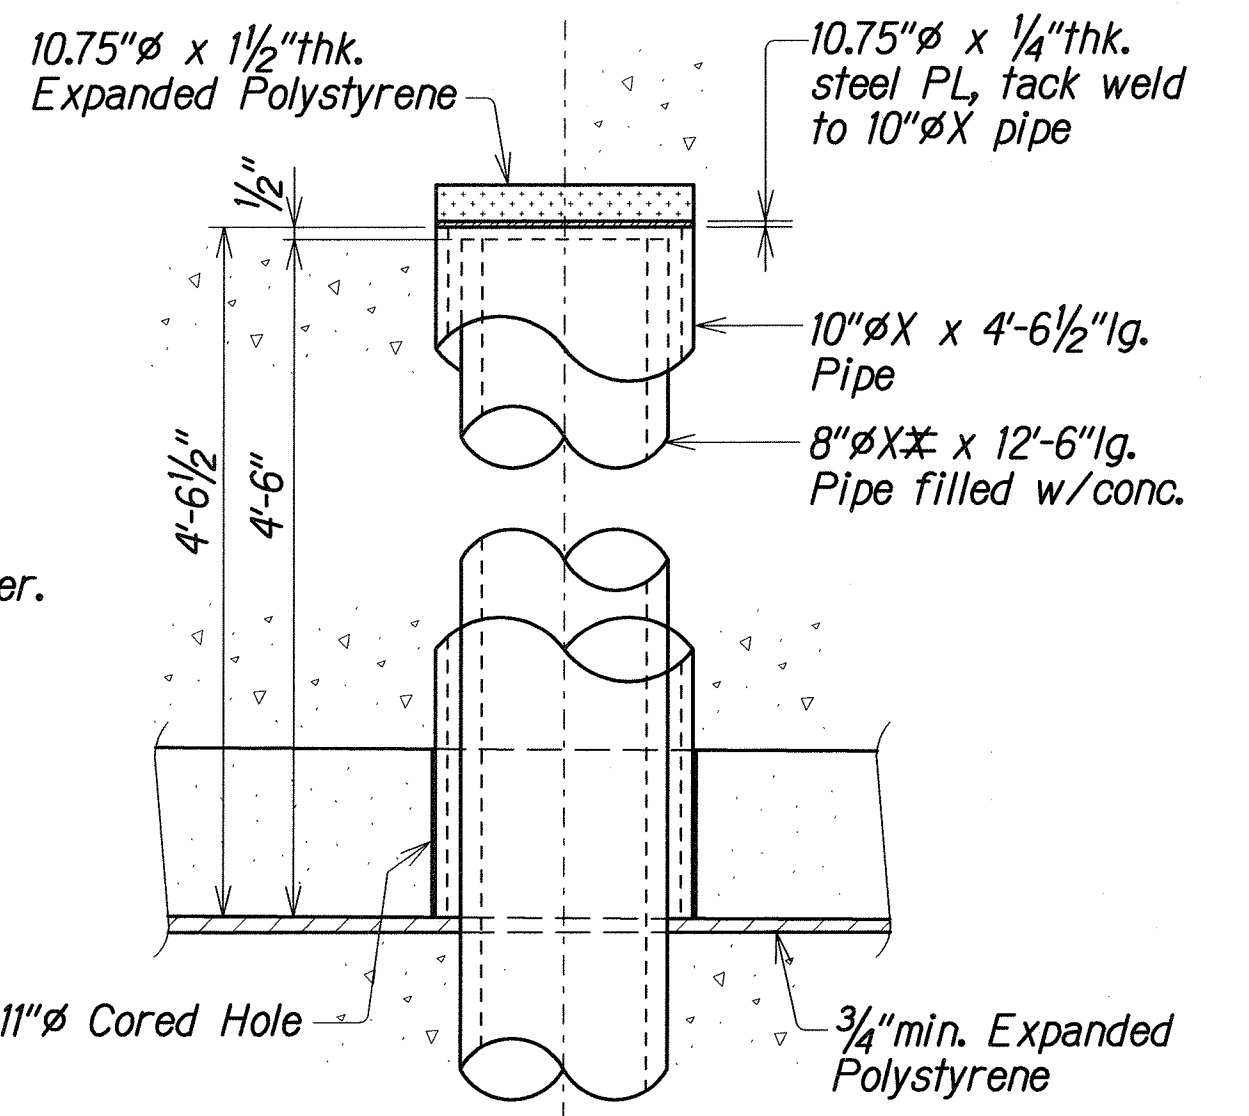


FED. ROAD DIST. NO.	STATE	FED. AID PROJ. NO.	FISCAL YEAR	SHEET NO.	TOTAL SHEETS
HAWAII	HAW.	BR-HI-1(251)	2007	12	13

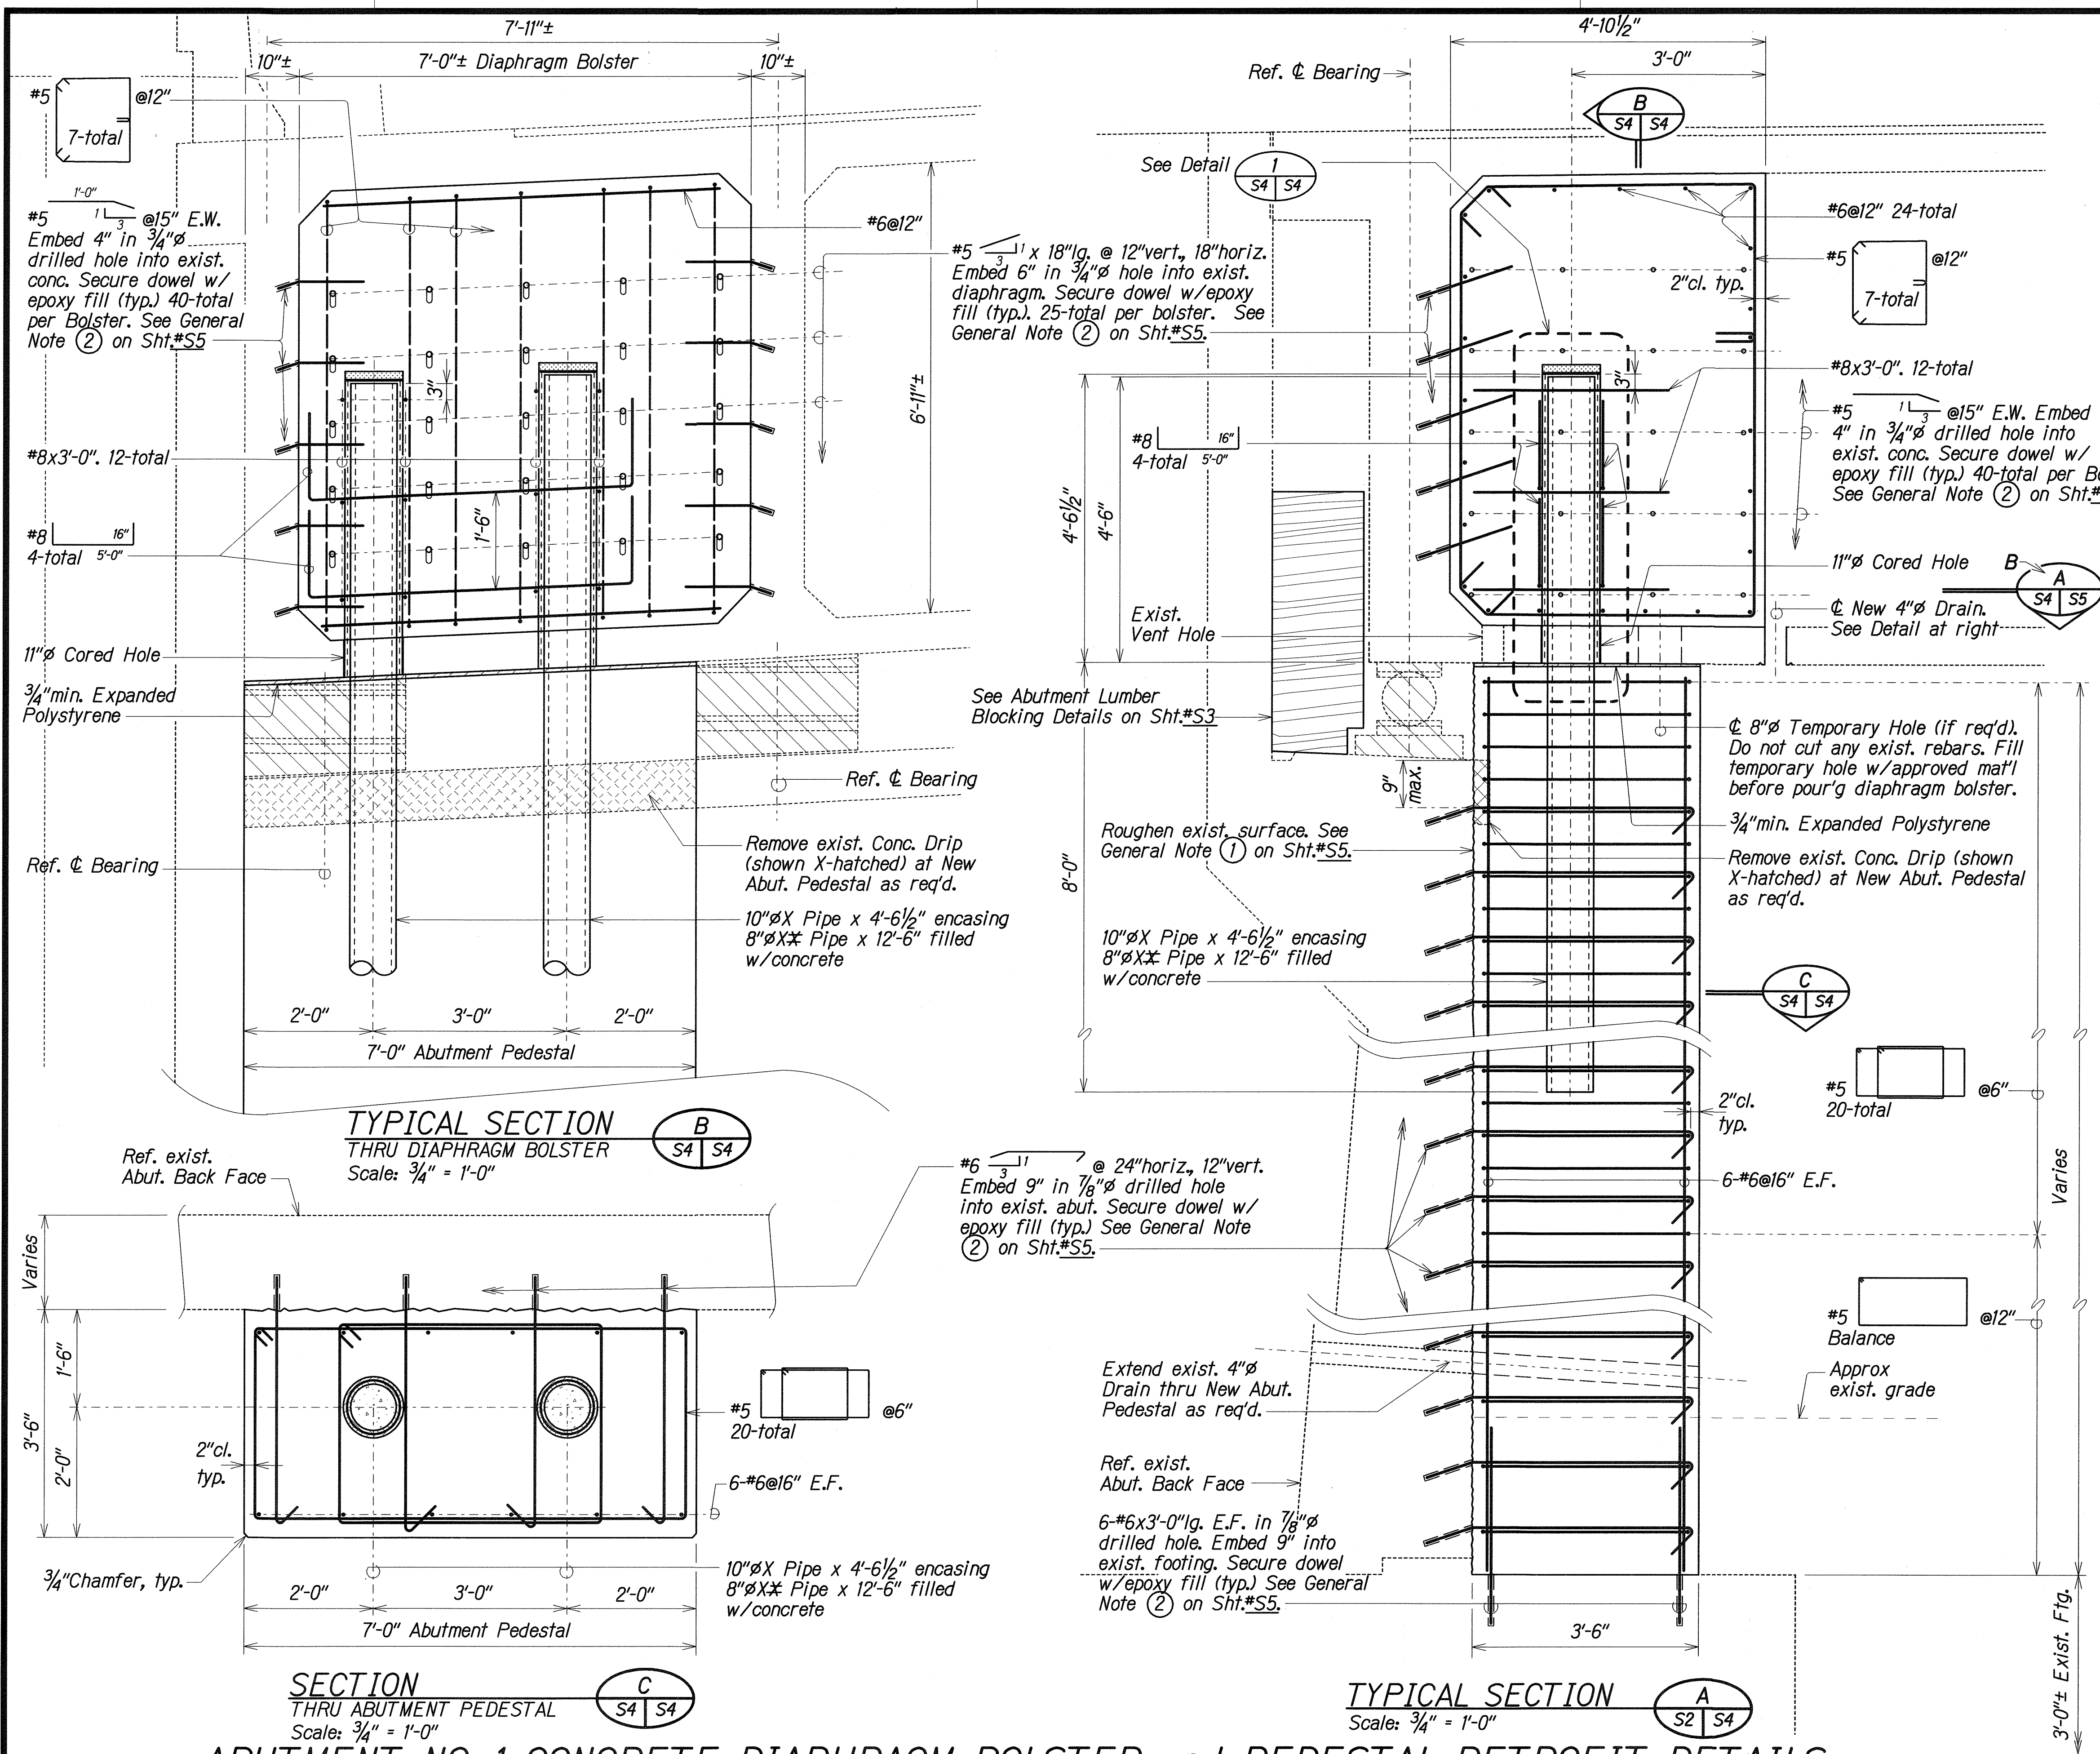

DETAIL 1
Scale: 1 1/2" = 1'-0"

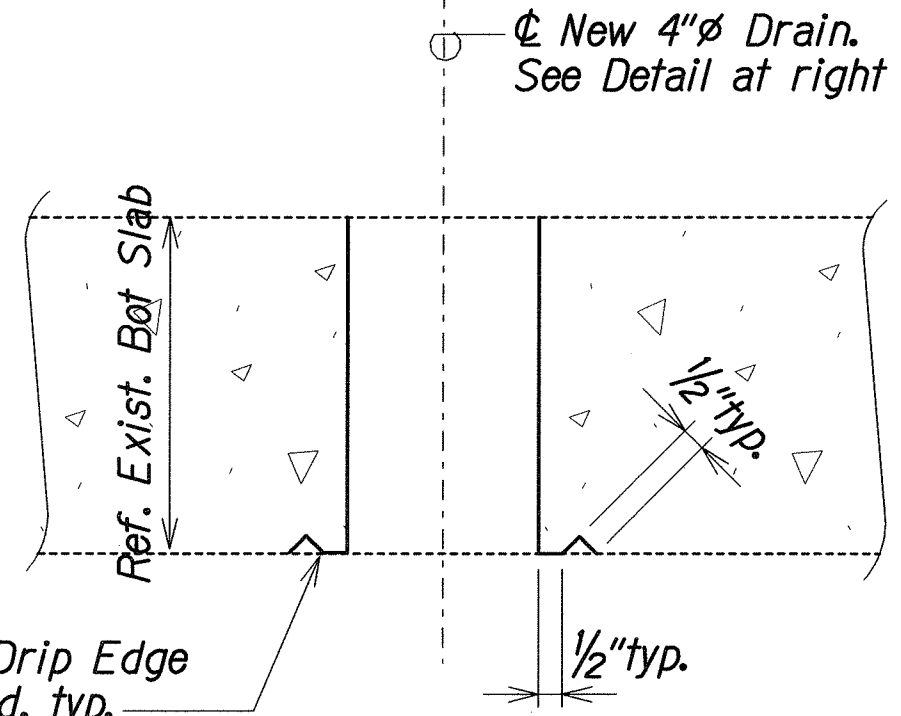

4" DRAIN DRIP EDGE DETAIL
Not to Scale

LEGEND FOR AS-BUILT POSTINGS	
~~~~~	Squiggly line for as-built deletion
==	Double line for as-built deletion
Roadway	Text for as-built posting

STATE OF HAWAII  
DEPARTMENT OF TRANSPORTATION  
HIGHWAYS DIVISION

**ABUTMENT NO. 1 CONCRETE DIAPHRAGM BOLSTER & PEDESTAL RETROFIT DETAILS**

Lunalilo-Vineyard On-Ramp  
F.A.P. No. BR-HI-1(251)

Scale: As Noted Date: Aug. 2006

SHEET No. S4 OF 5 SHEETS

DESIGNED BY	DATE
NOTED BY	AUG 2006
QUANTITIES BY	AUG 2006
CHECKED BY	AUG 2006
APPROVED BY	AUG 2006

**ABUTMENT NO. 1 CONCRETE DIAPHRAGM BOLSTER and PEDESTAL RETROFIT DETAILS**

"AS-BUILT"