




FED. ROAD DIST. NO.	STATE	FED. AID PROJ. NO.	FISCAL YEAR	SHEET NO.	TOTAL SHEETS
HAWAII	HAW.	BR-HI-1(251)	2007	10	13

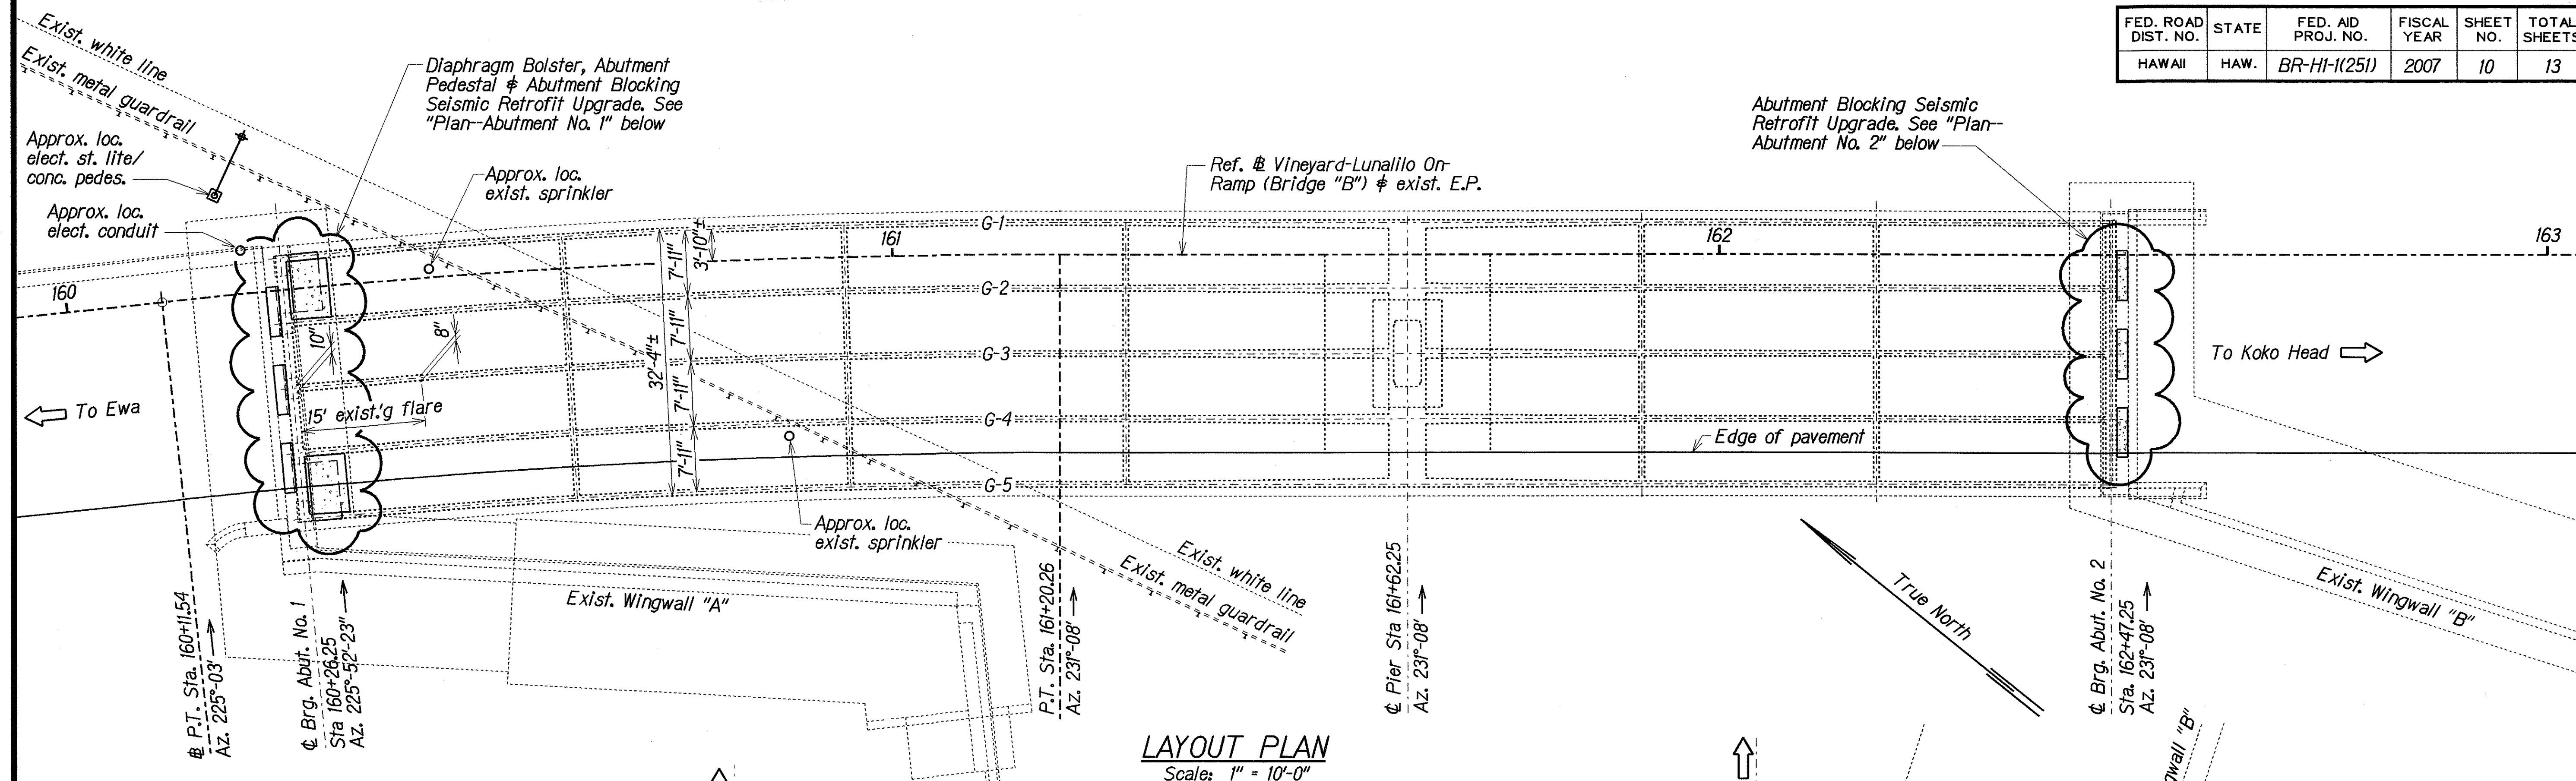

LAYOUT PLAN
Scale: 1" = 10'-0"

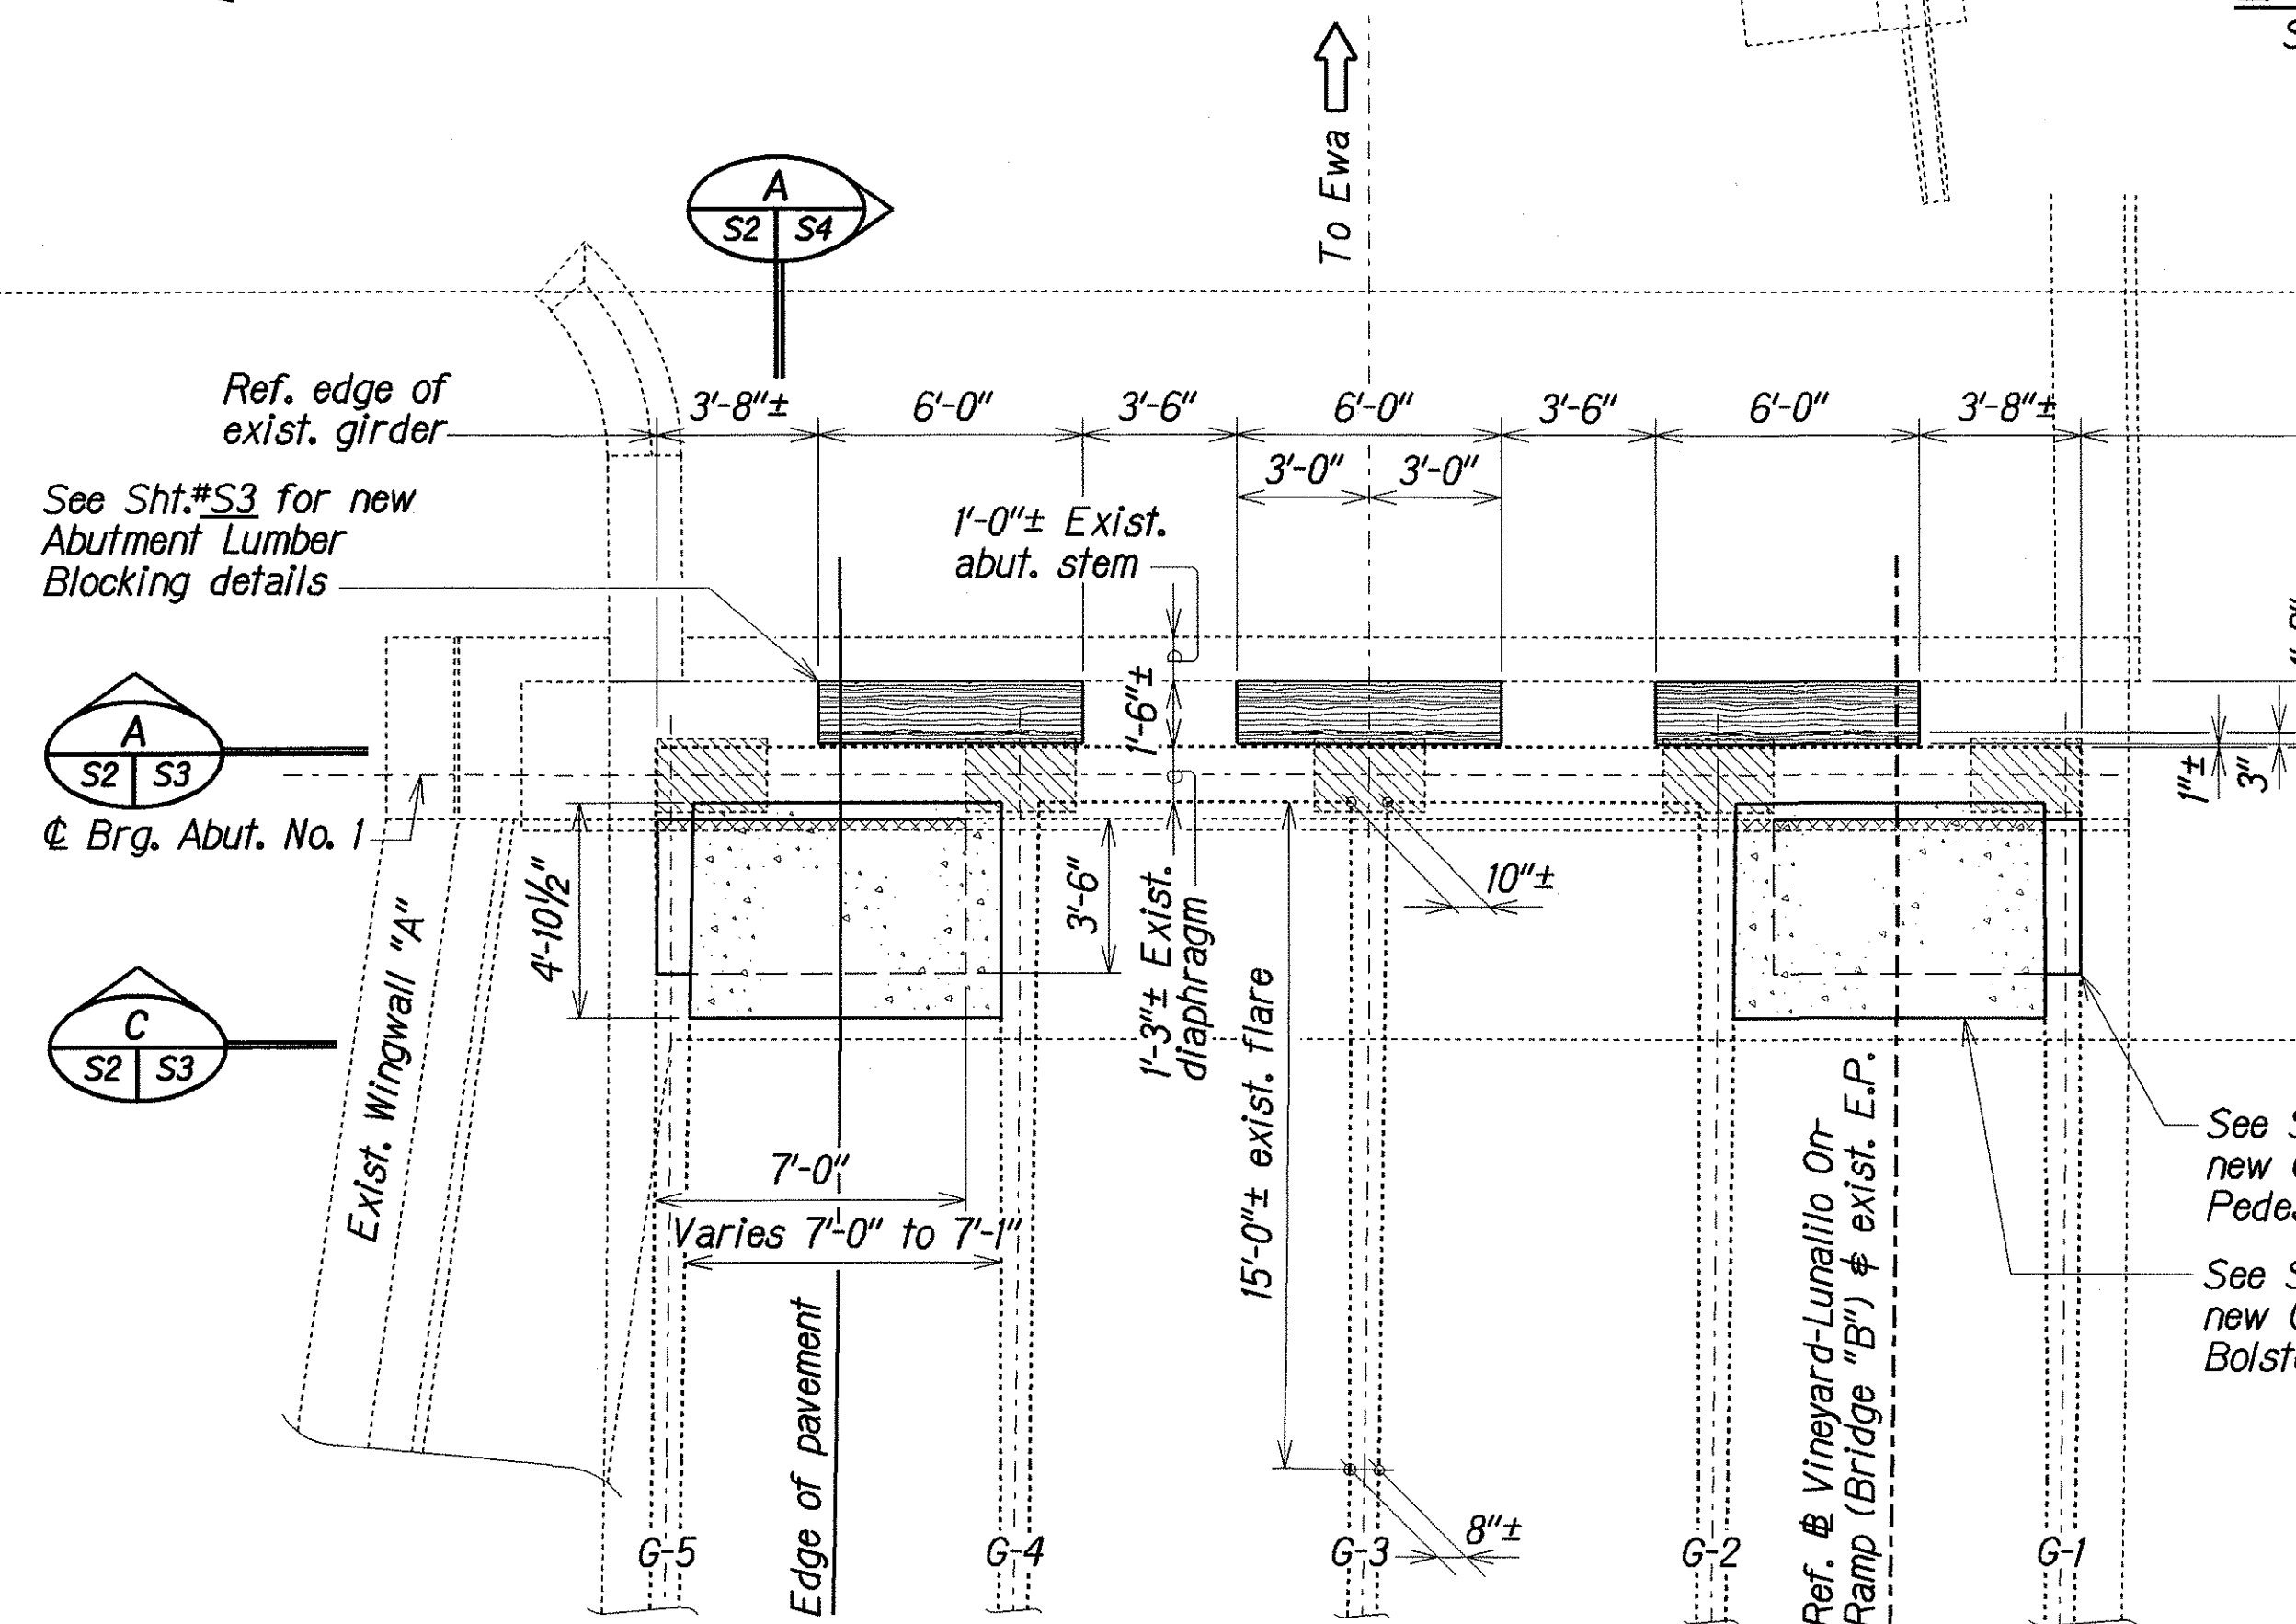

PLAN--ABUTMENT NO. 1
Scale: 1/4" = 1'-0"

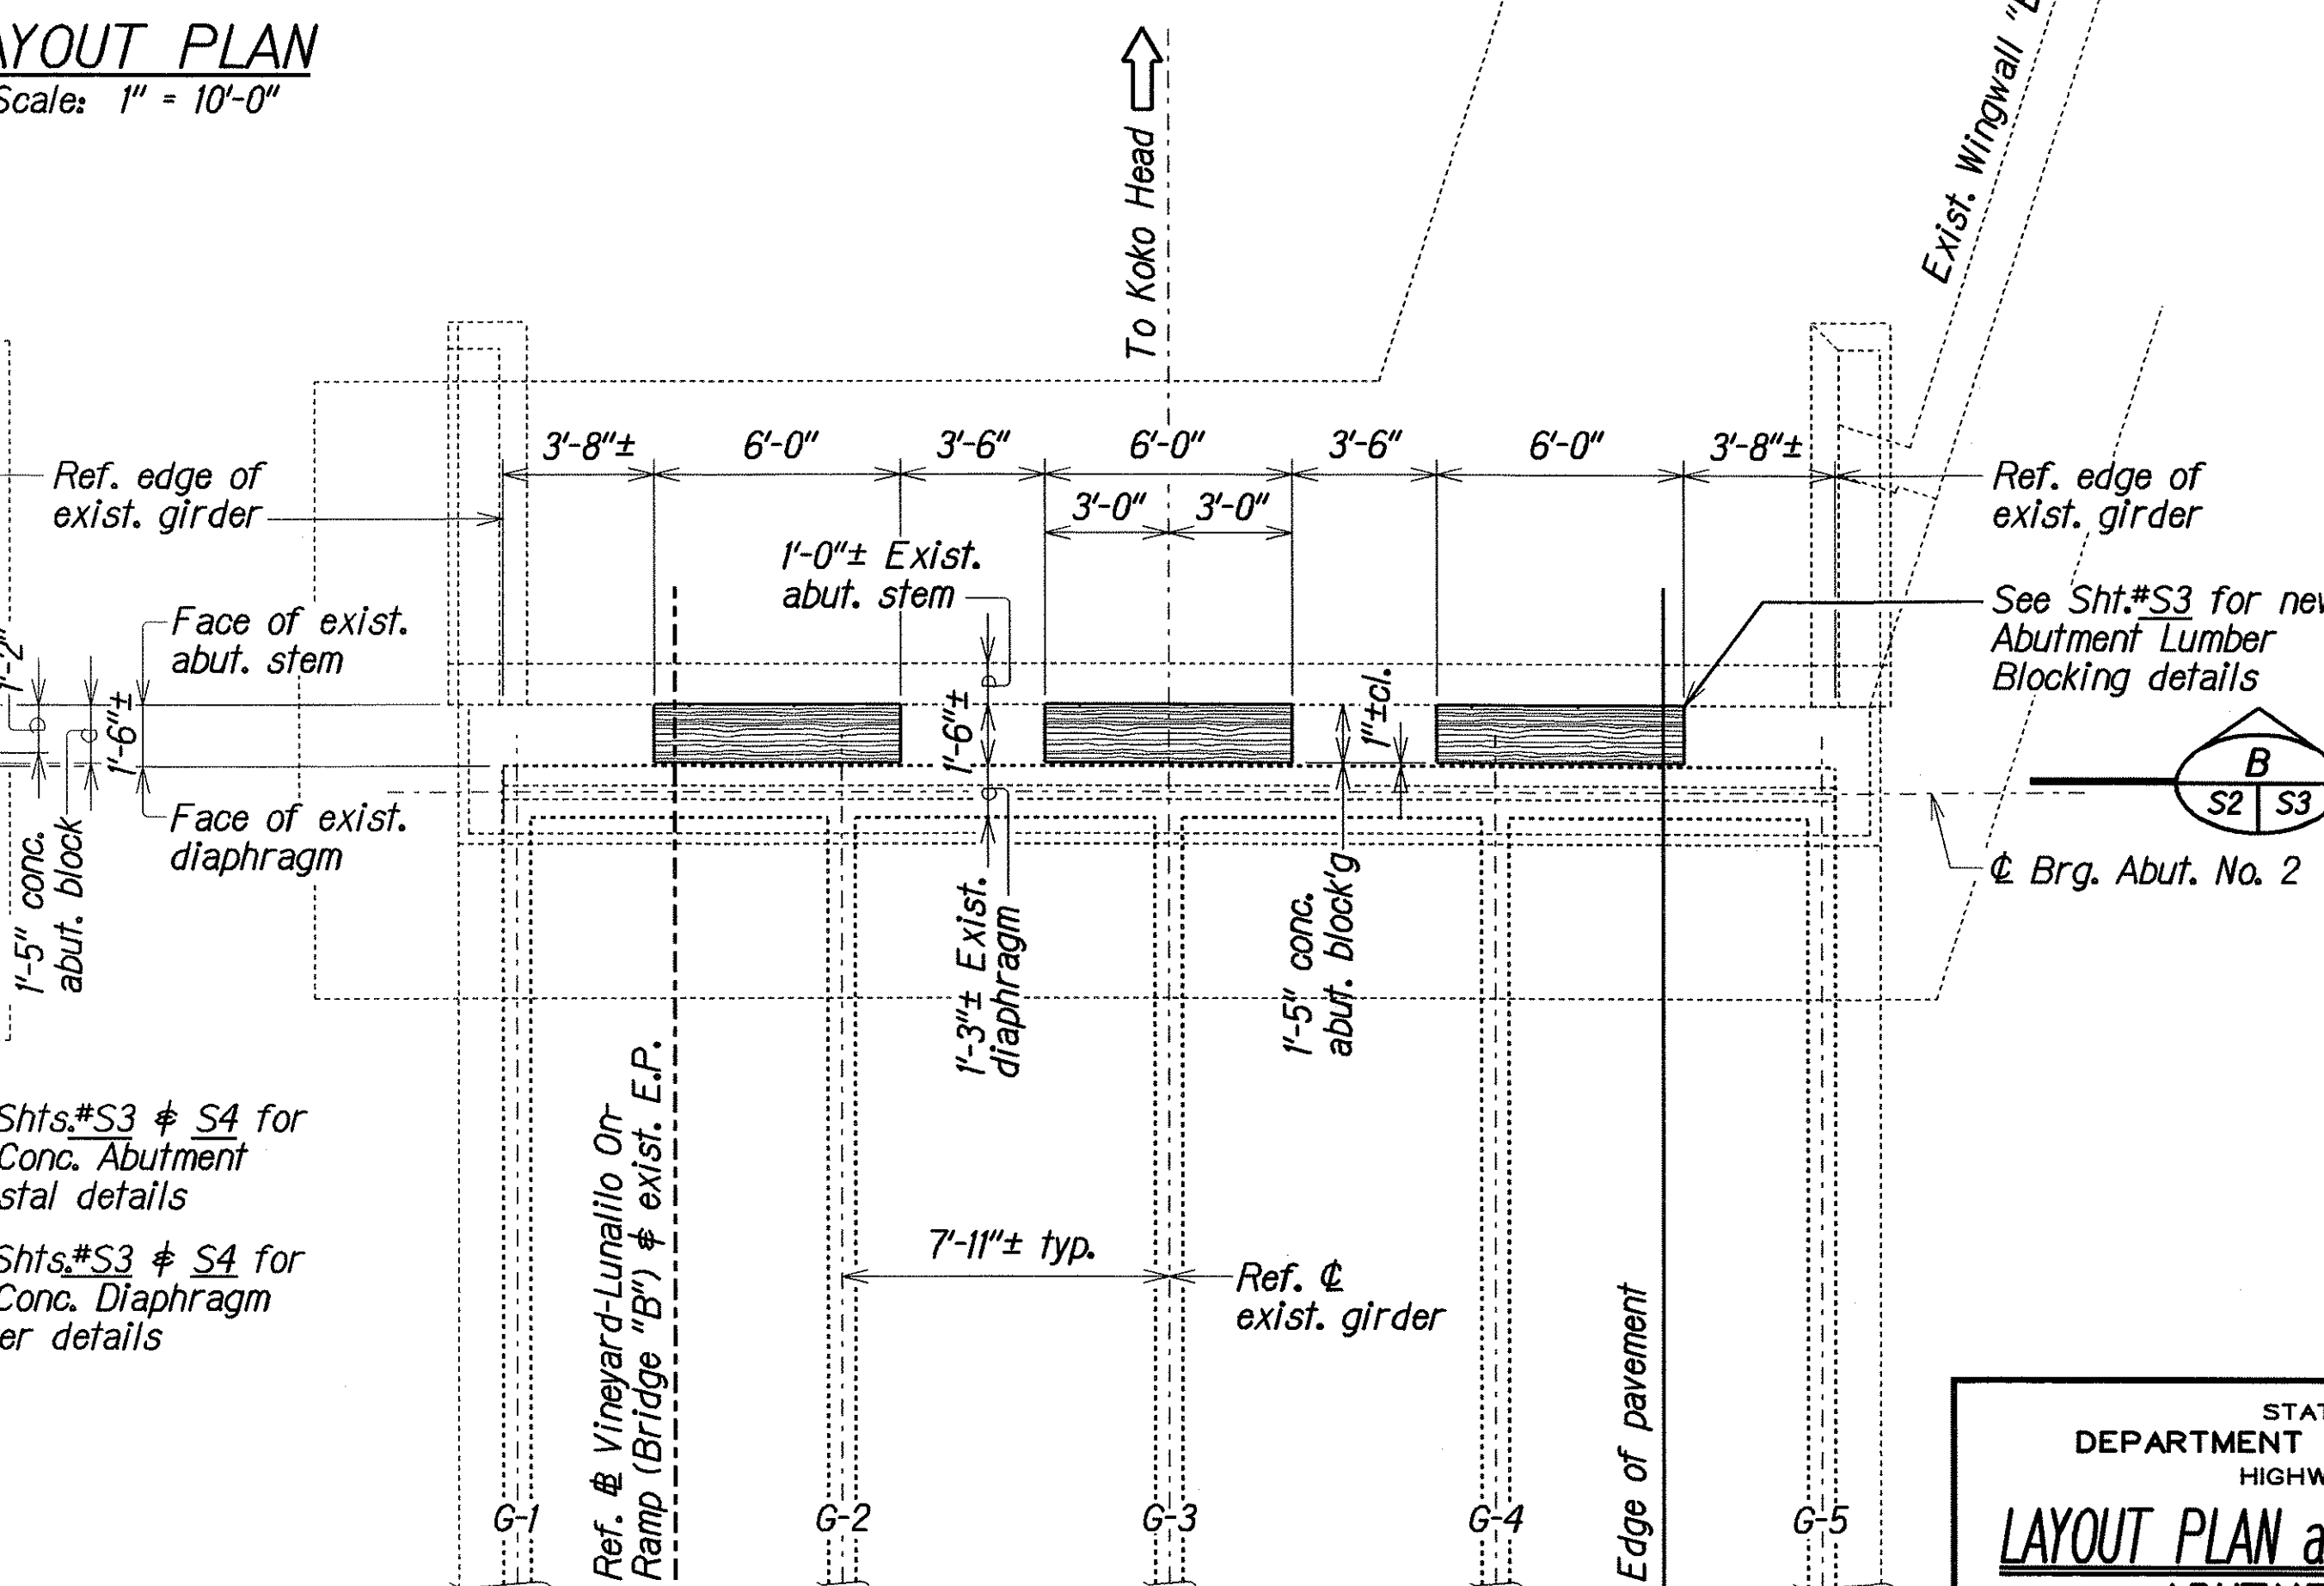

PLAN--ABUTMENT NO. 2
Scale: 1/4" = 1'-0"

STATE OF HAWAII
DEPARTMENT OF TRANSPORTATION
HIGHWAYS DIVISION
LAYOUT PLAN and ABUTMENT PLANS
ABUTMENT NOS. 1 & 2
INTERSTATE ROUTE H-1 SEISMIC RETROFIT
Lunalilo-Vineyard On-Ramp
F.A.T.P. No. BR-HI-1(251)

Scale: As Noted Date: Aug. 2006

SHEET No. S2 OF 5 SHEETS