




FED. ROAD DIST. NO.	STATE	FED. AID PROJ. NO.	FISCAL YEAR	SHEET NO.	TOTAL SHEETS
HAWAII	HAW.	I-HI-1(35)	1970	30	99

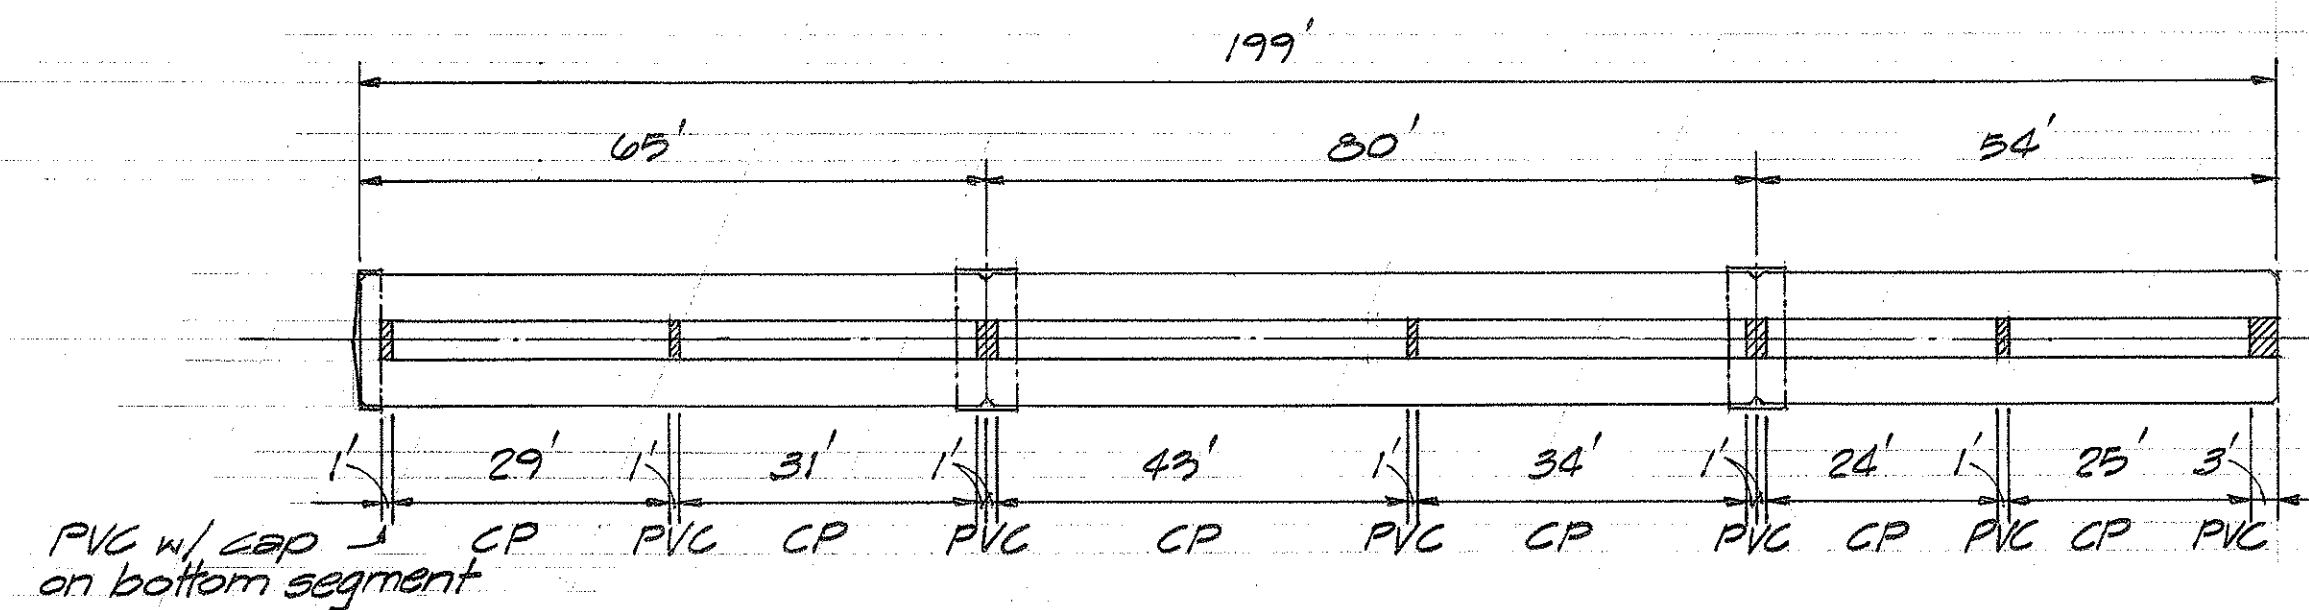


PILE 1
SCALE: 1"=20' PILE LENGTH
1/2"=1' PILE WIDTH

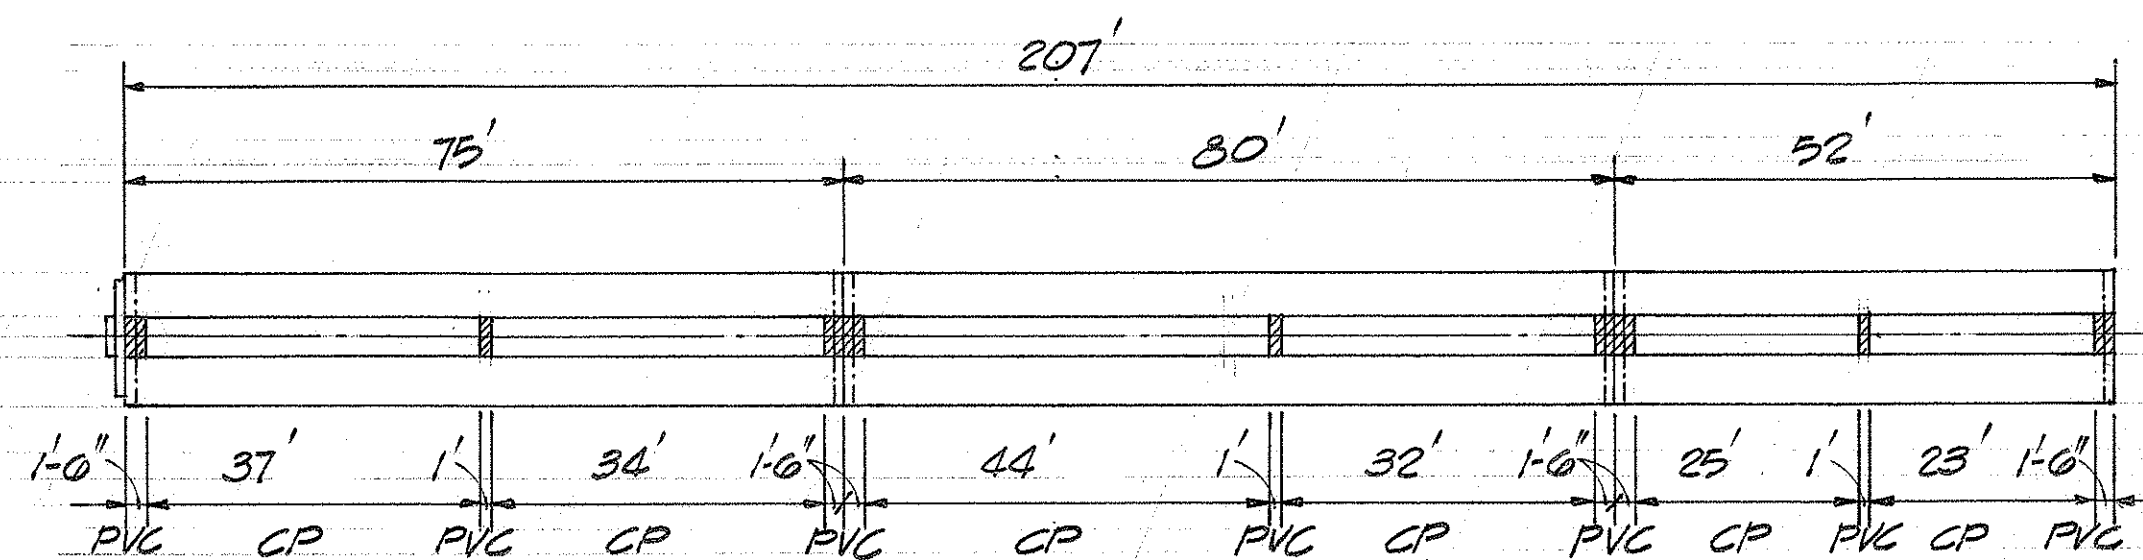

PILES 2 AND 4
SCALE: 1"=20' PILE LENGTH
1/2"=1' PILE WIDTH

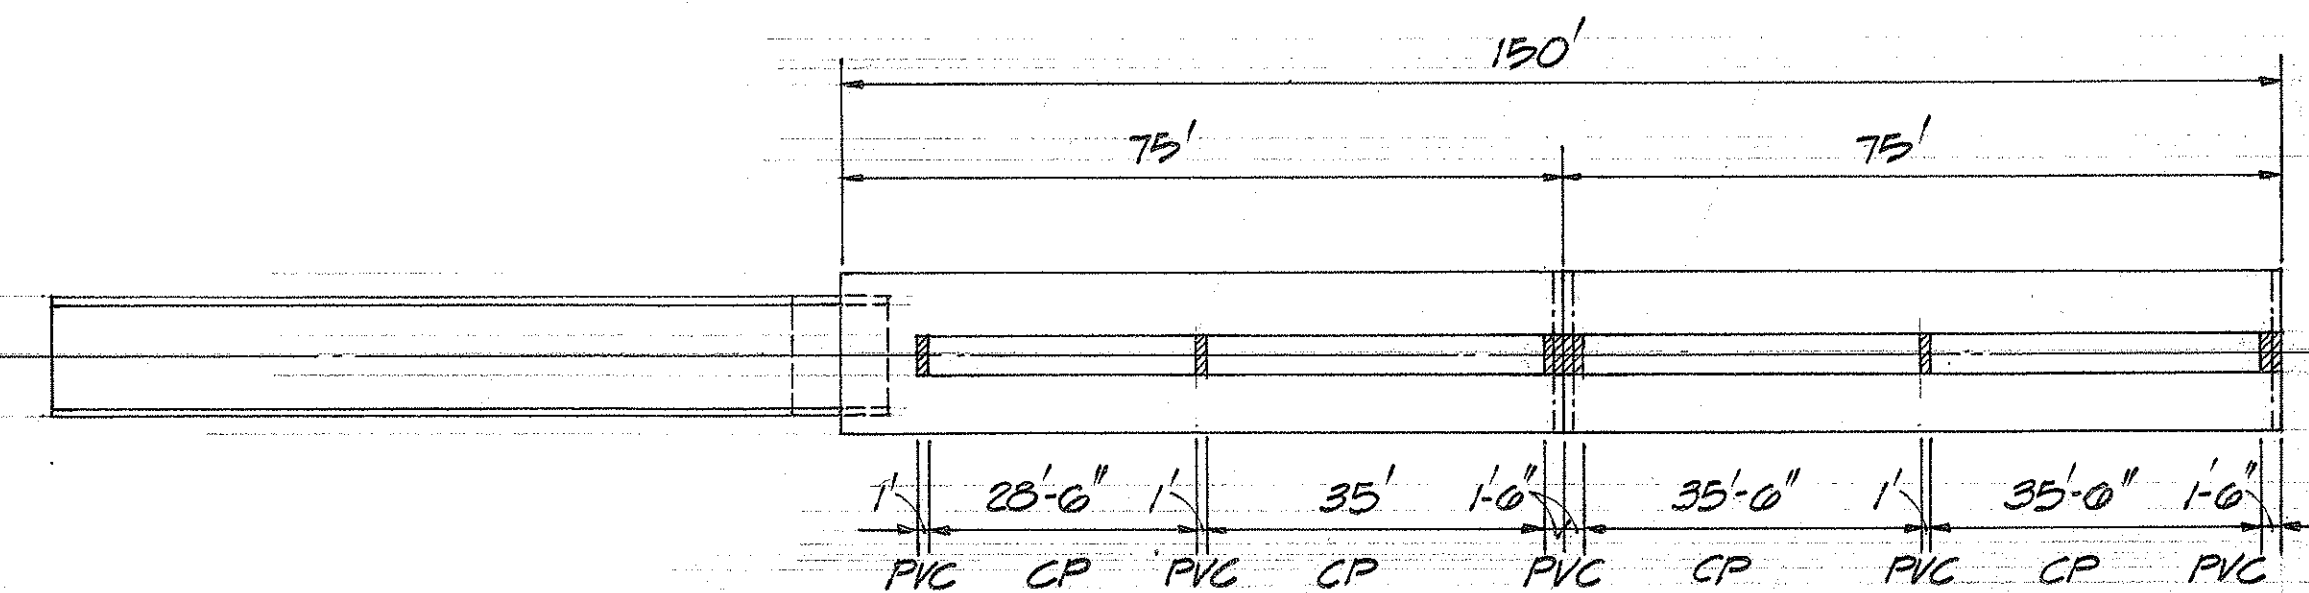


PILE 3
SCALE: 1"=20' PILE LENGTH
1/2"=1' PILE WIDTH

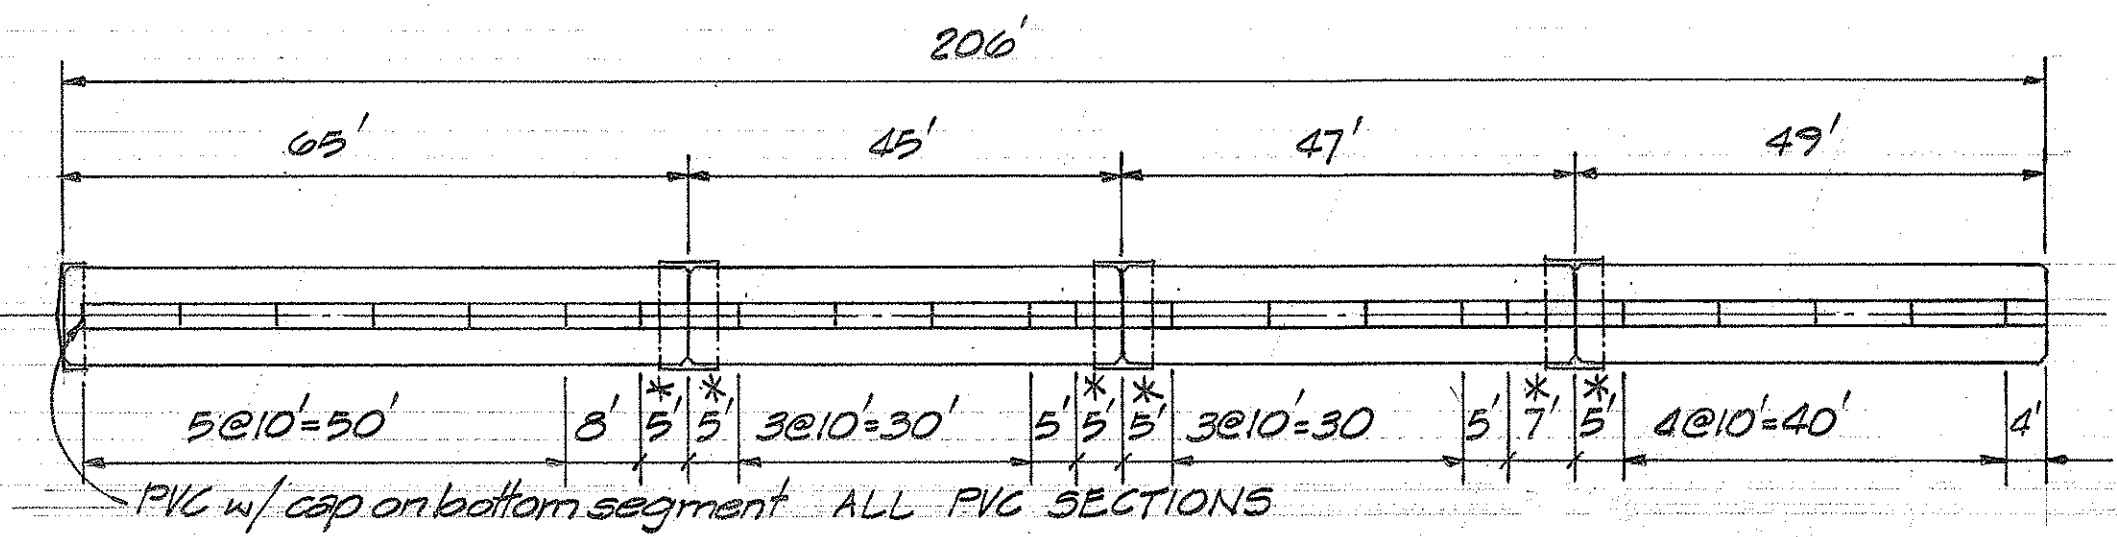

PILE 5
SCALE: 1"=20' PILE LENGTH
1/2"=1' PILE WIDTH

* - SEGMENTS TO BE GREASED AND JOINTED WITHOUT CEMENT FOR EASY REMOVAL DURING SPLICING.

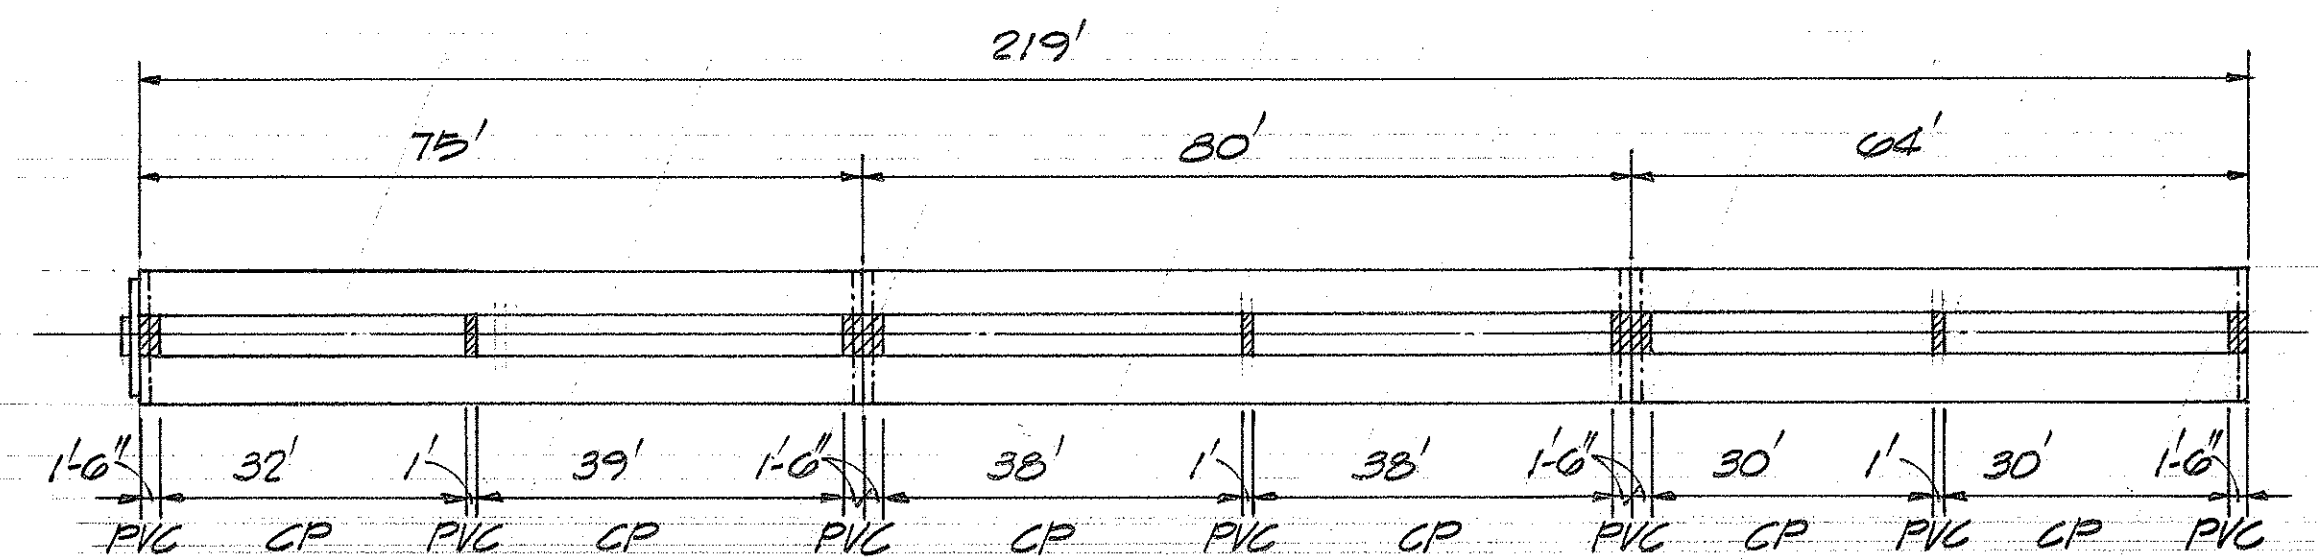

PILES 6 THRU 9
SCALE: 1"=20' PILE LENGTH
1/2"=1' PILE WIDTH

NOTES:

- ALL PILE SEGMENTS SHOWN ARE CAST LENGTHS.
- PVC - POLYVINYLCHLORIDE PIPE
CP - CORRUGATED PLASTIC PIPE
THE REASON FOR THE PVC SECTIONS AT THE ENDS AND APPROXIMATE CENTERS OF THE PILE SEGMENTS IS FOR THE INSTALLATION OF THE TWIST STUDS.
- CONTRACTOR TO PROVIDE METHOD OF ESTABLISHING AND MAINTAINING CONCENTRICITY OF PVC AND CORRUGATED PIPE FOR ENGINEERS APPROVAL PRIOR TO CASTING.

3/1/77 Entire sheet added to delineate location of 5" PVC and 5" Corrugated Plastic Pipe.

STATE OF HAWAII
DEPARTMENT OF TRANSPORTATION
HIGHWAYS DIVISION
KEEHI INTERCHANGE
FIELD TESTING PROGRAM
CASTING OF CENTRAL
HOLE FOR PILES 1-9

INTERSTATE ROUTE H-1
PROJECT NO. I-HI-1(35)
SCALE: AS SHOWN DATE: 24 FEB 77

SHEET NO. 35 OF 35 SHEETS

SURVEY PLOTTED BY	DATE
DRAWN BY	
DESIGNED BY	
QUANTITIES BY	
CHECKED BY	
ORIGINAL PLAN	
NOTE BOOK	
NO.	