



FED. ROAD DIST. NO.	STATE	FED. AID PROJ. NO.	FISCAL YEAR	SHEET NO.	TOTAL SHEETS
HAWAII	HAW.	I-H-1 (85)	1970	14	35

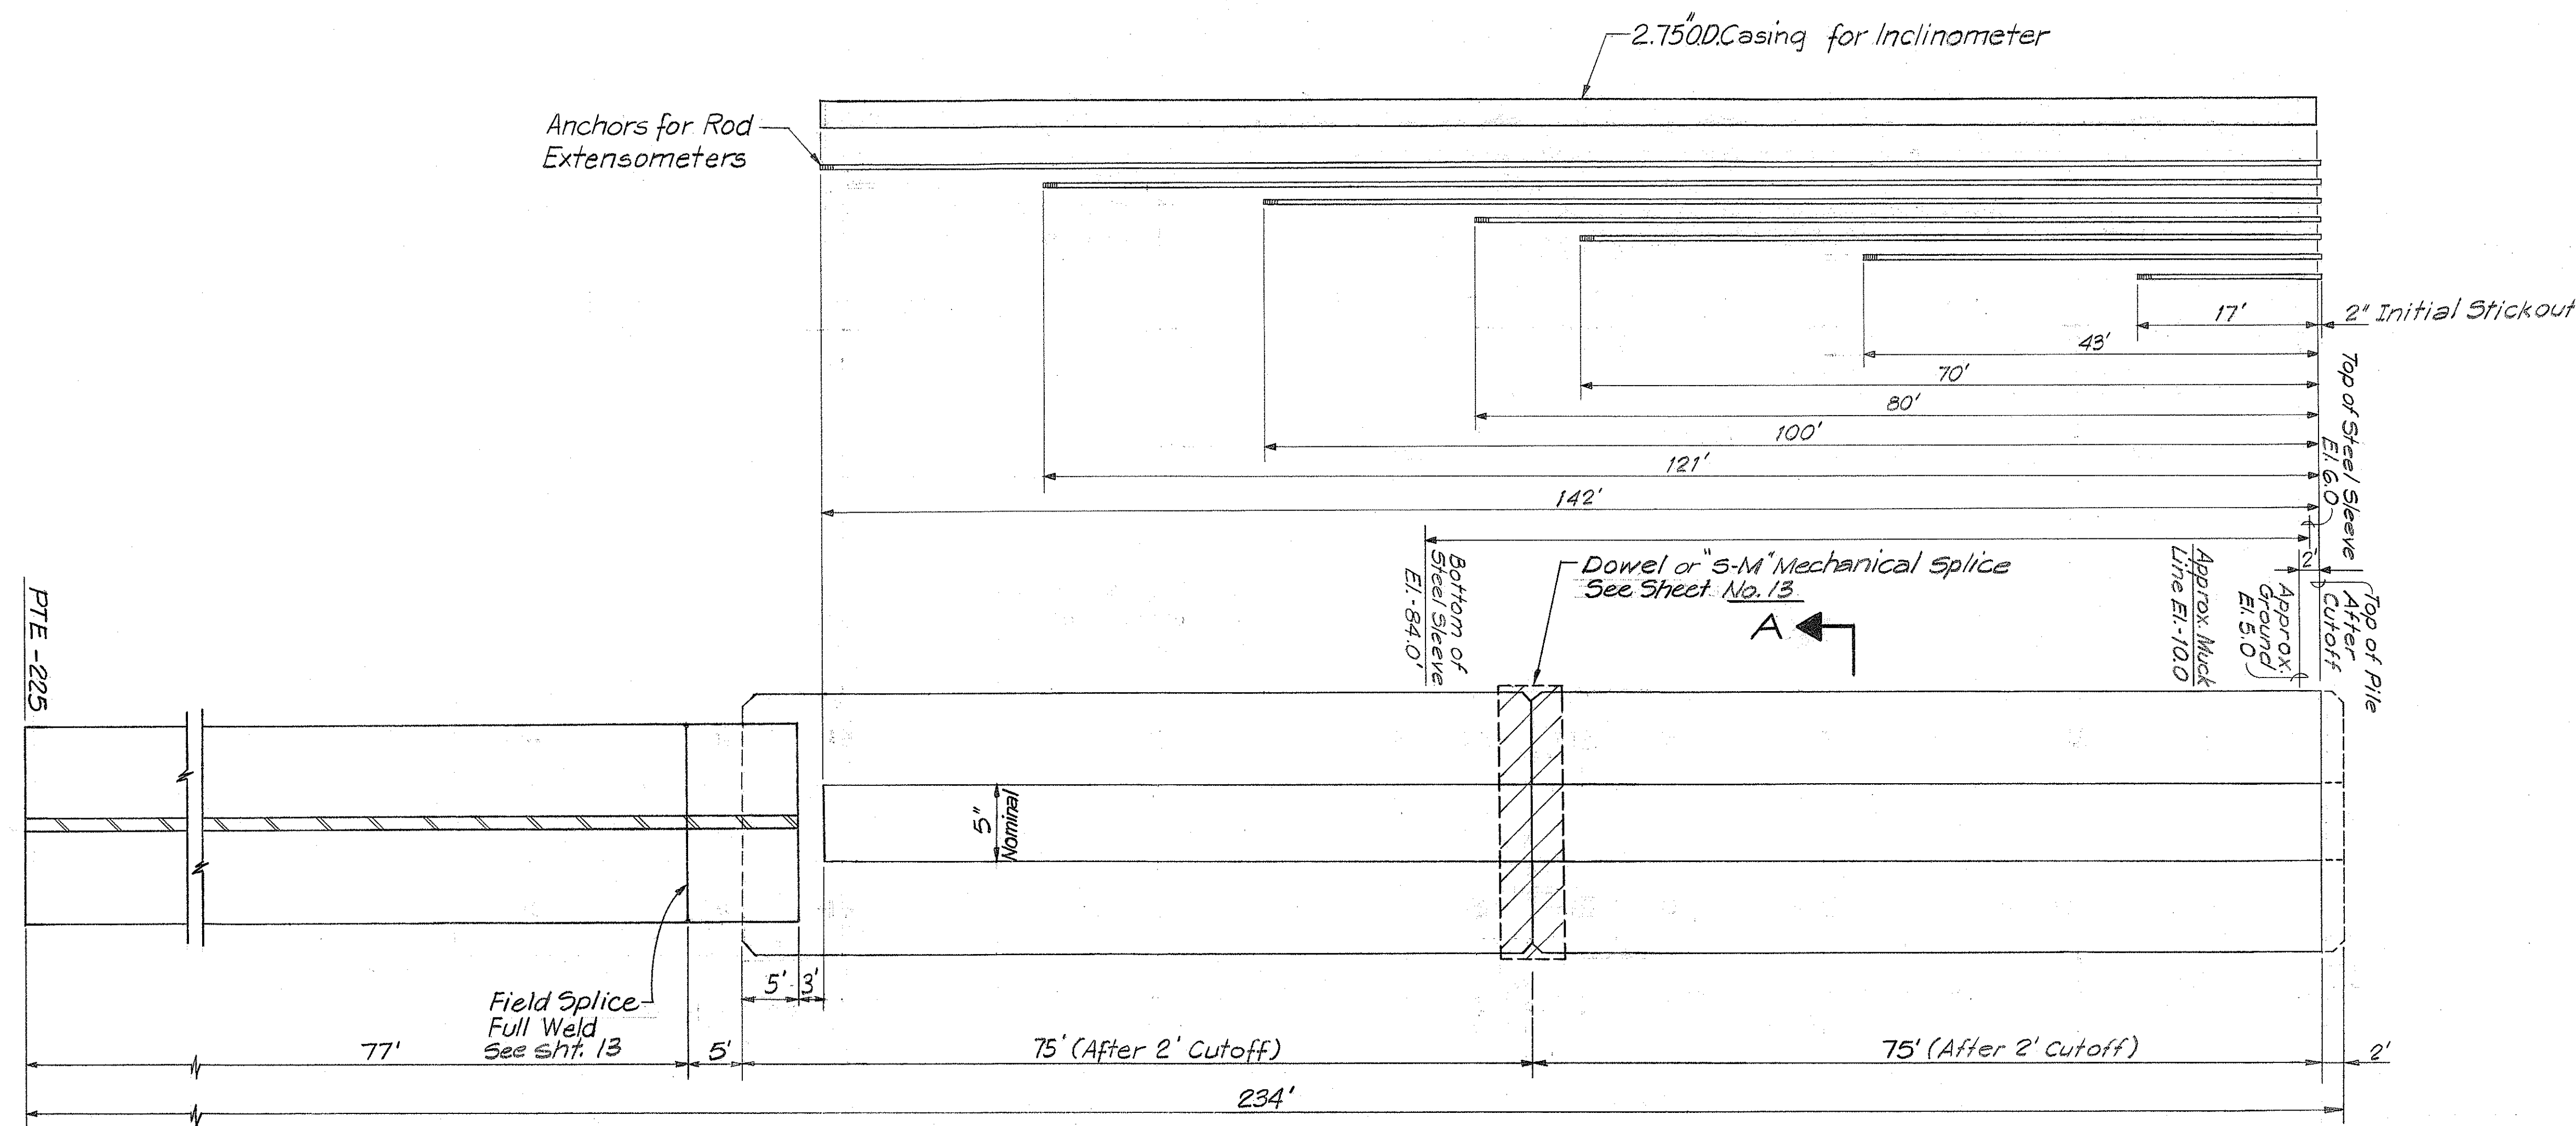


INSTRUMENTATION FOR PILE 3 IN TEST AREA 1A

SCALE: HORIZ. 1" = 10' (Pile Length)
VERT. 1 1/2" = 1'-0" (Pile Width)

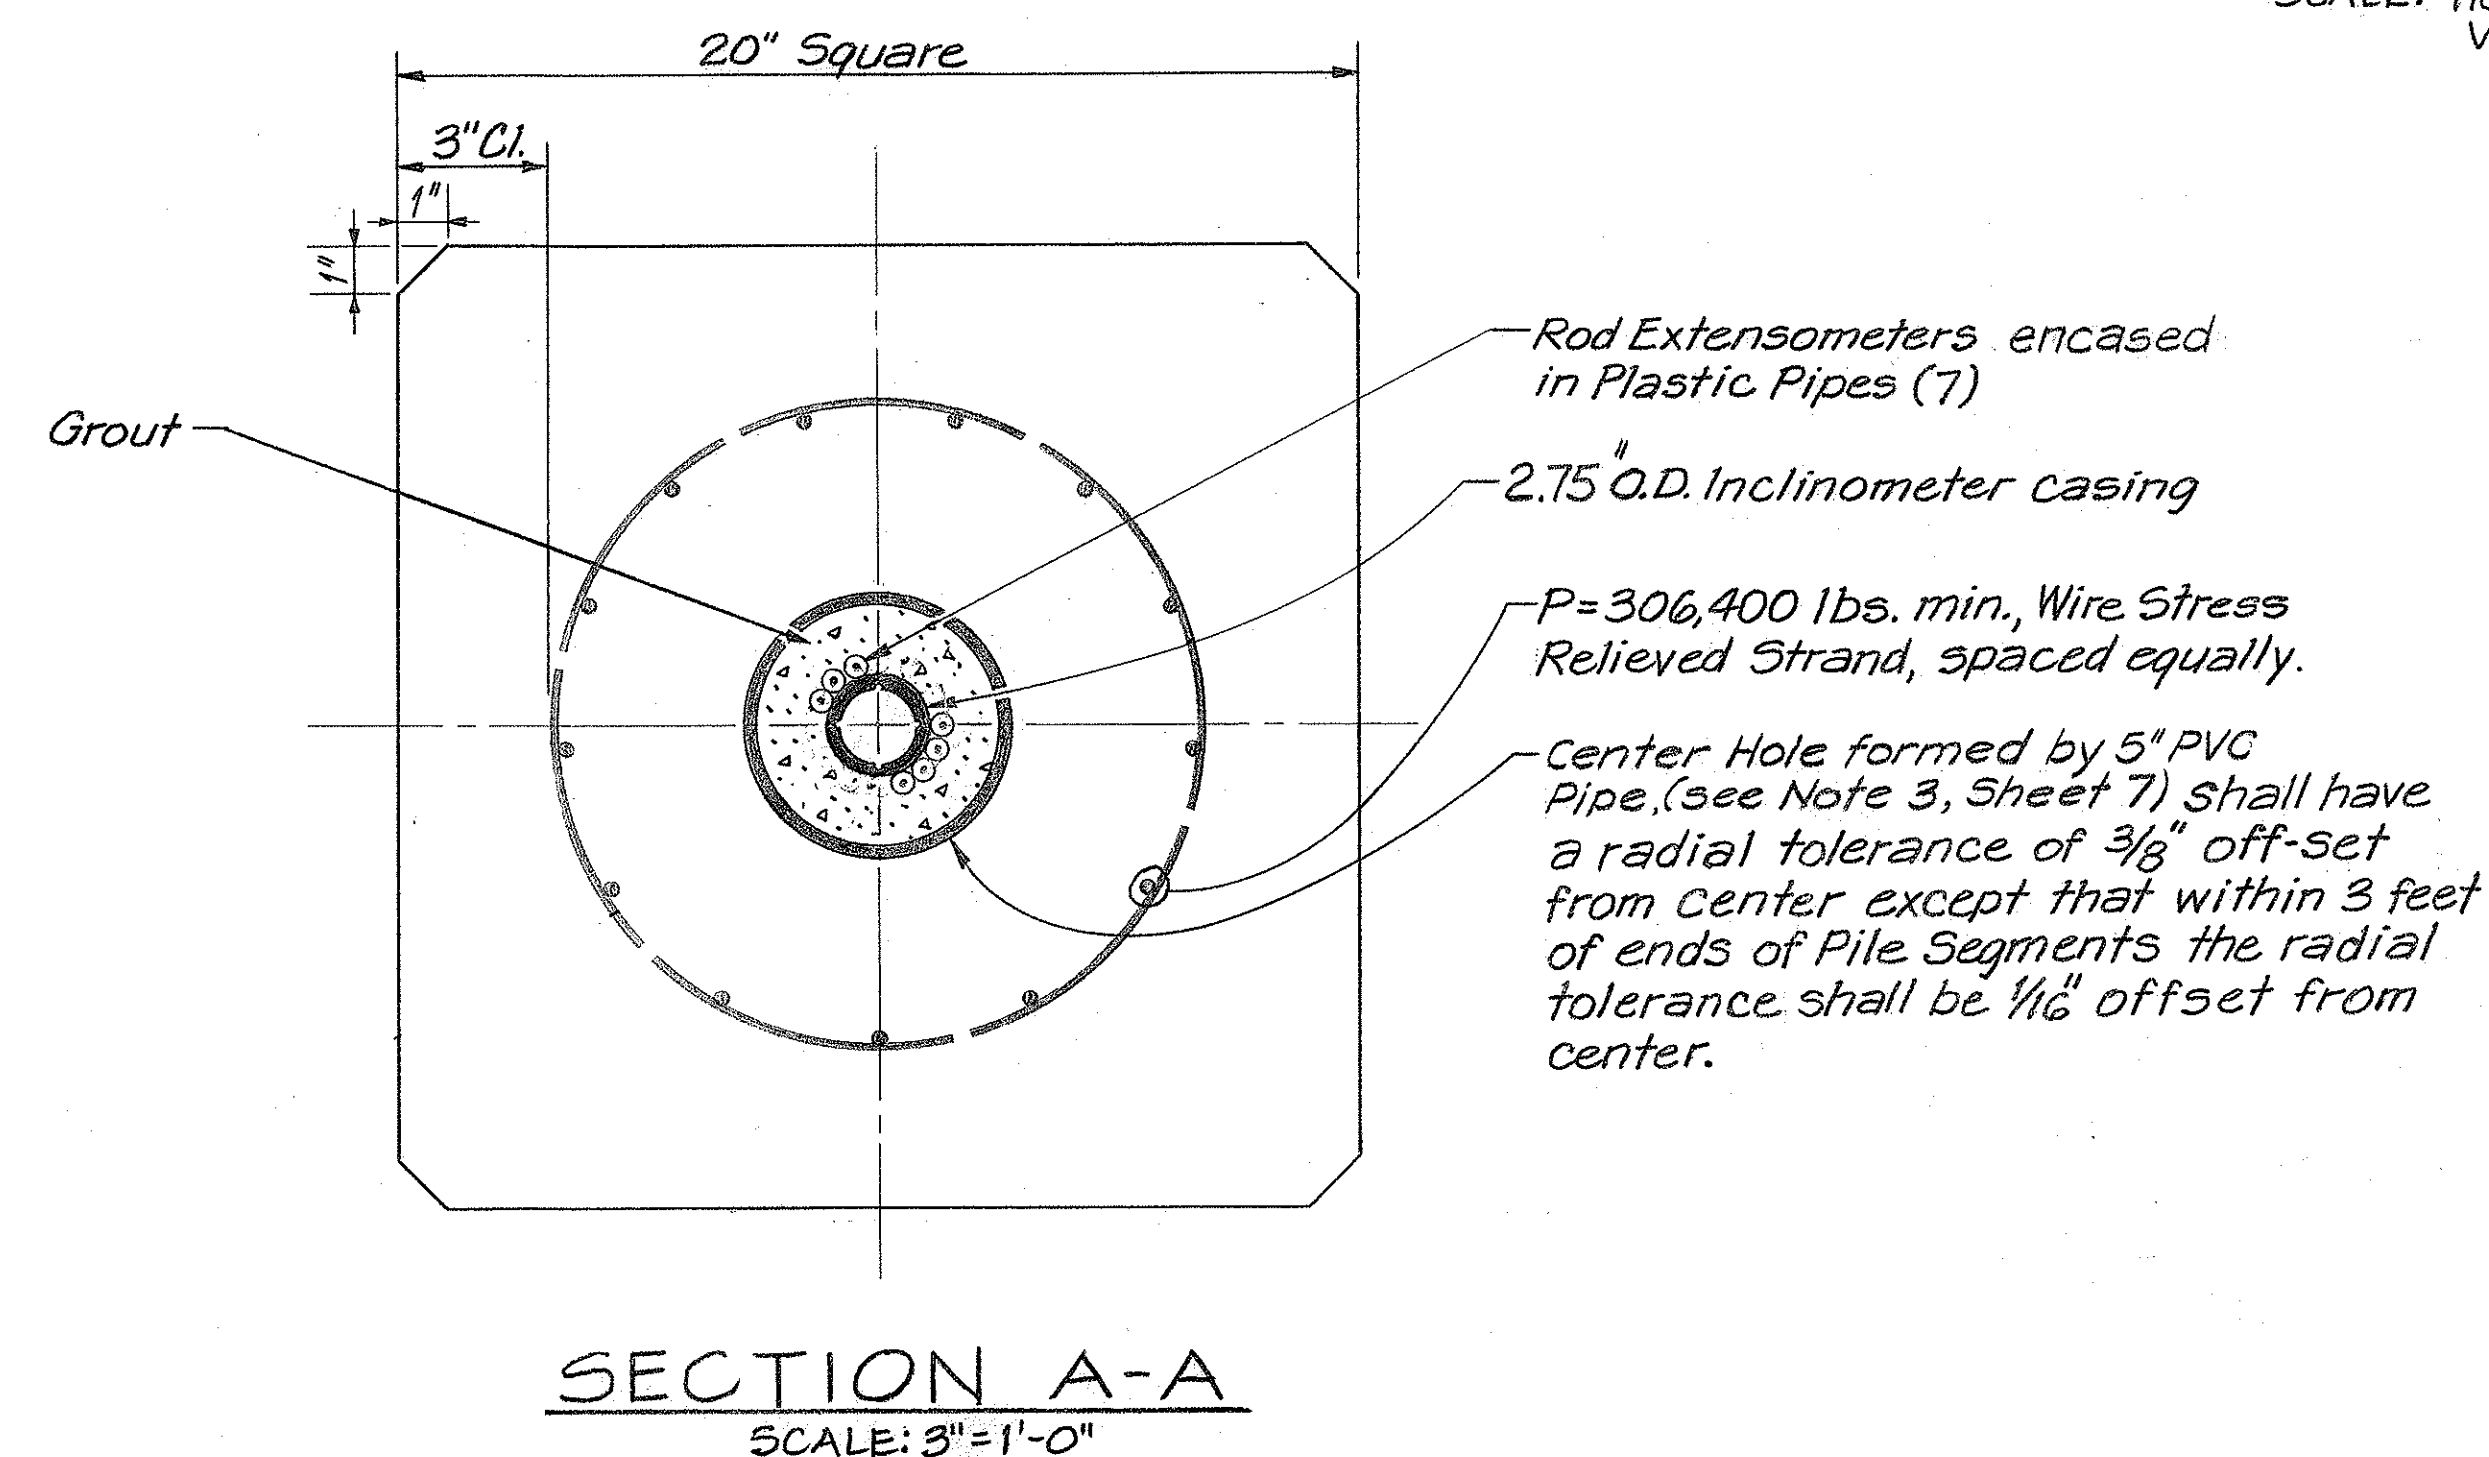

Instruments Installed After Driving of Pile : Inclinator Casing
Rod Extensometers

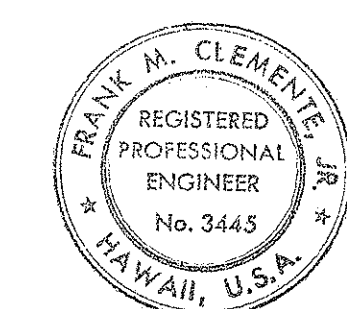


THIS WORK WAS PREPARED BY
ME OR UNDER MY SUPERVISION.
Frank M. Clemente

STATE OF HAWAII
DEPARTMENT OF TRANSPORTATION
HIGHWAYS DIVISION
KEEHI INTERCHANGE
FIELD TESTING PROGRAM
PILE INSTRUMENTATION
PILE 3
INTERSTATE ROUTE H-1
PROJECT NO. I-H-1 (85)
SCALE: AS SHOWN DATE: 3/31/70
SHEET NO. 14 OF 35 SHEETS


SURVEY PLOTTED BY	DATE
DRAWN BY	
DESIGNED BY	
CHECKED BY	
ORIGINAL PLAN	
NOTE BOOK	
NO.	

FED. ROAD DIST. NO.	STATE	FED. AID PROJ. NO.	FISCAL YEAR	SHEET NO.	TOTAL SHEETS
HAWAII	HAW.	I-H1-1(85)	1976	14	29

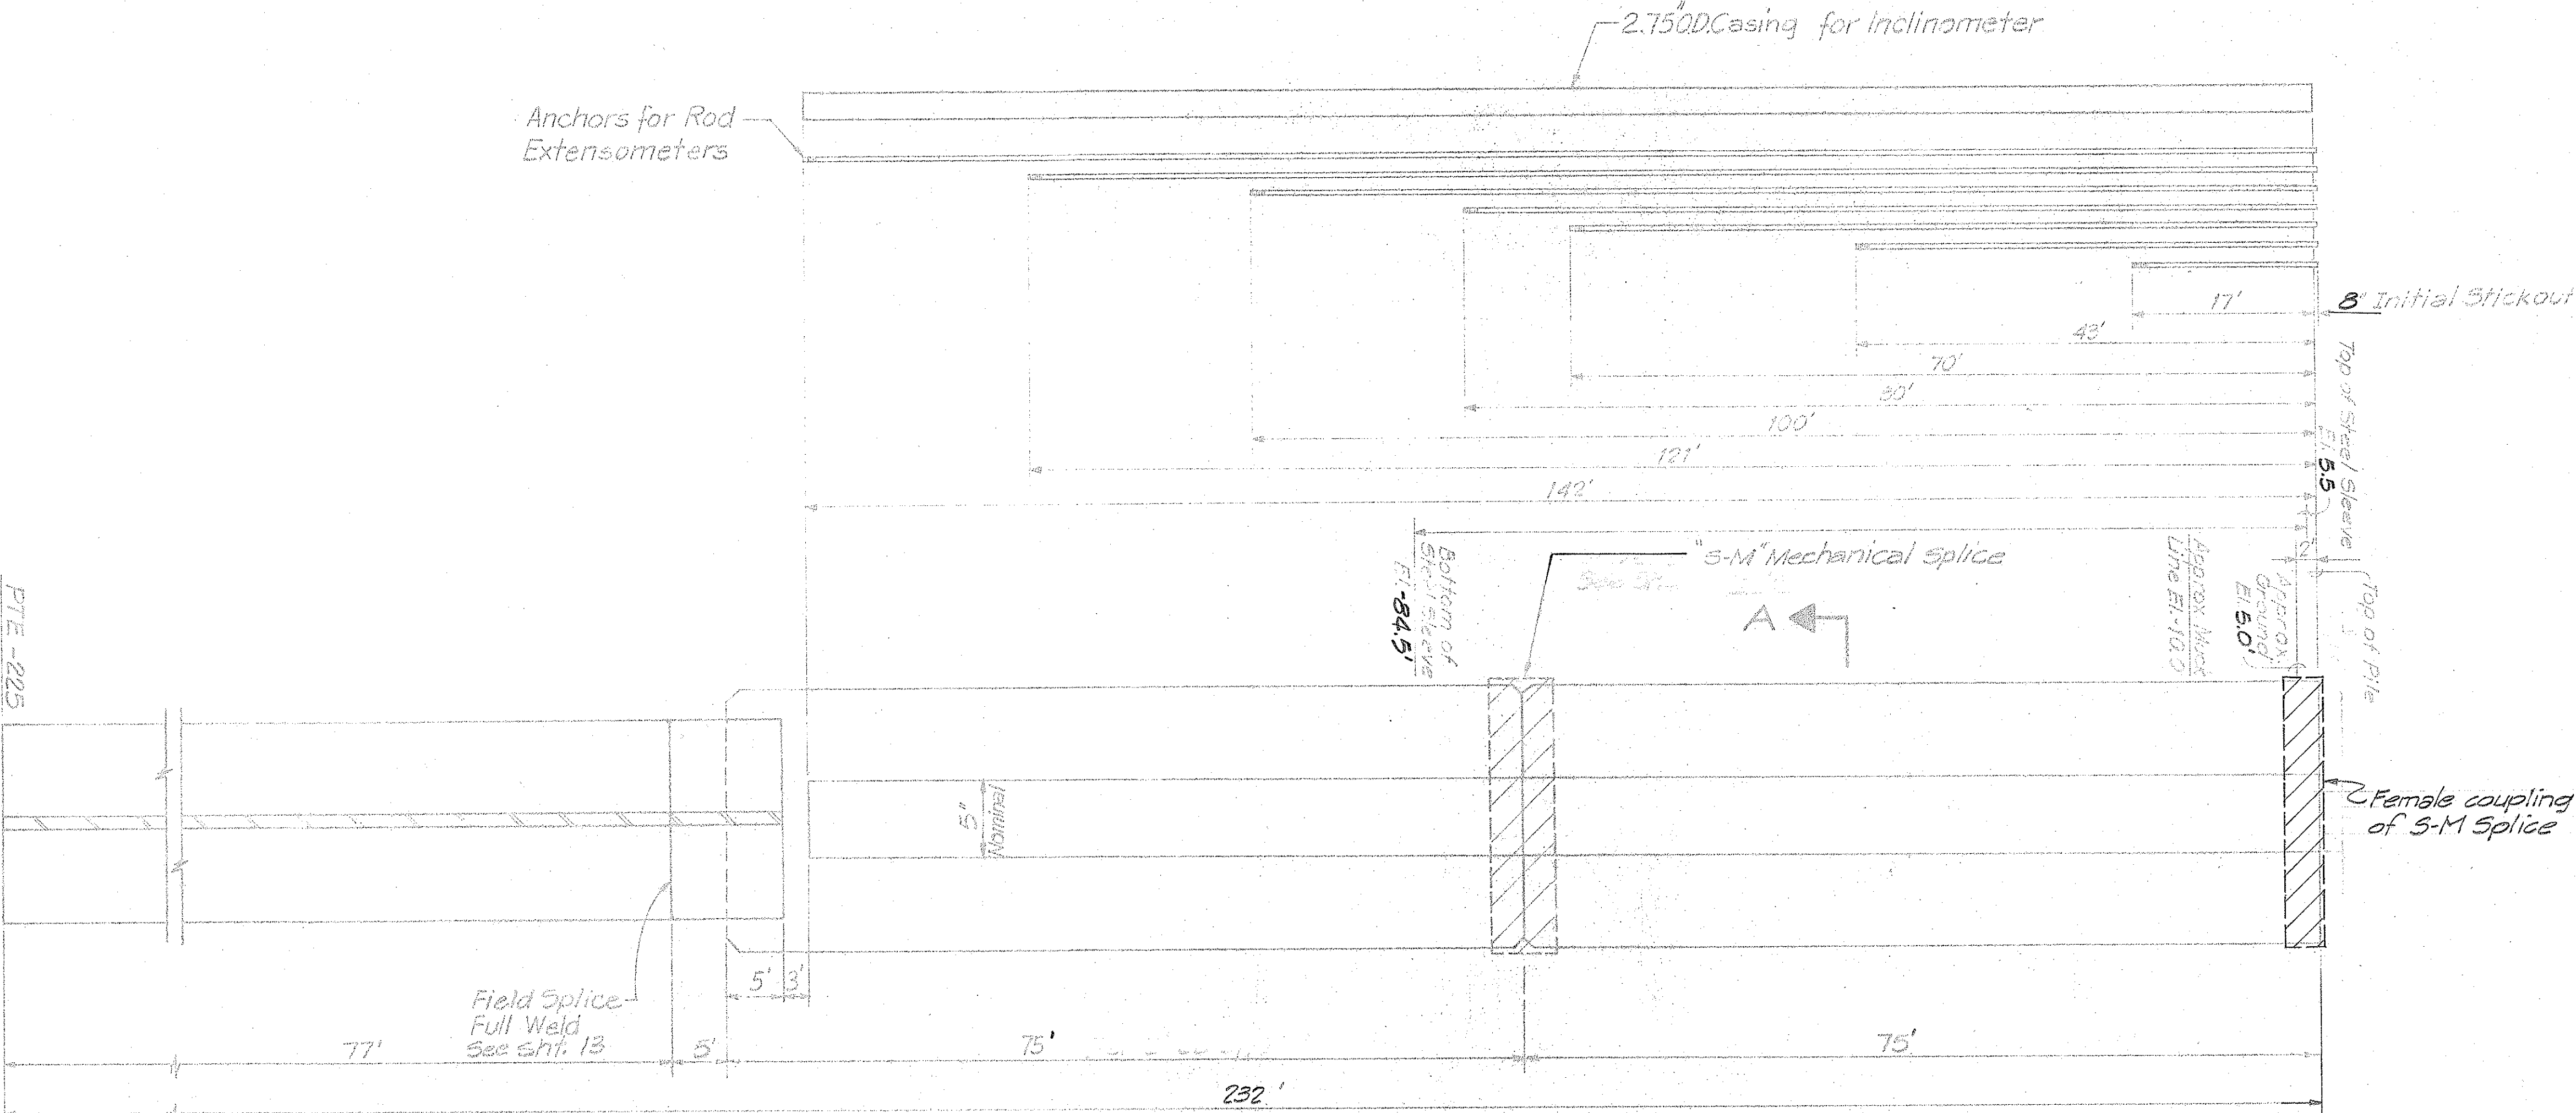

INSTRUMENTATION FOR PILE 3 IN TEST AREA 1A


SCALE: HORIZ. 1"=10' (Pile Length)
VERT. 1 1/2"=1'-0" (Pile Width)

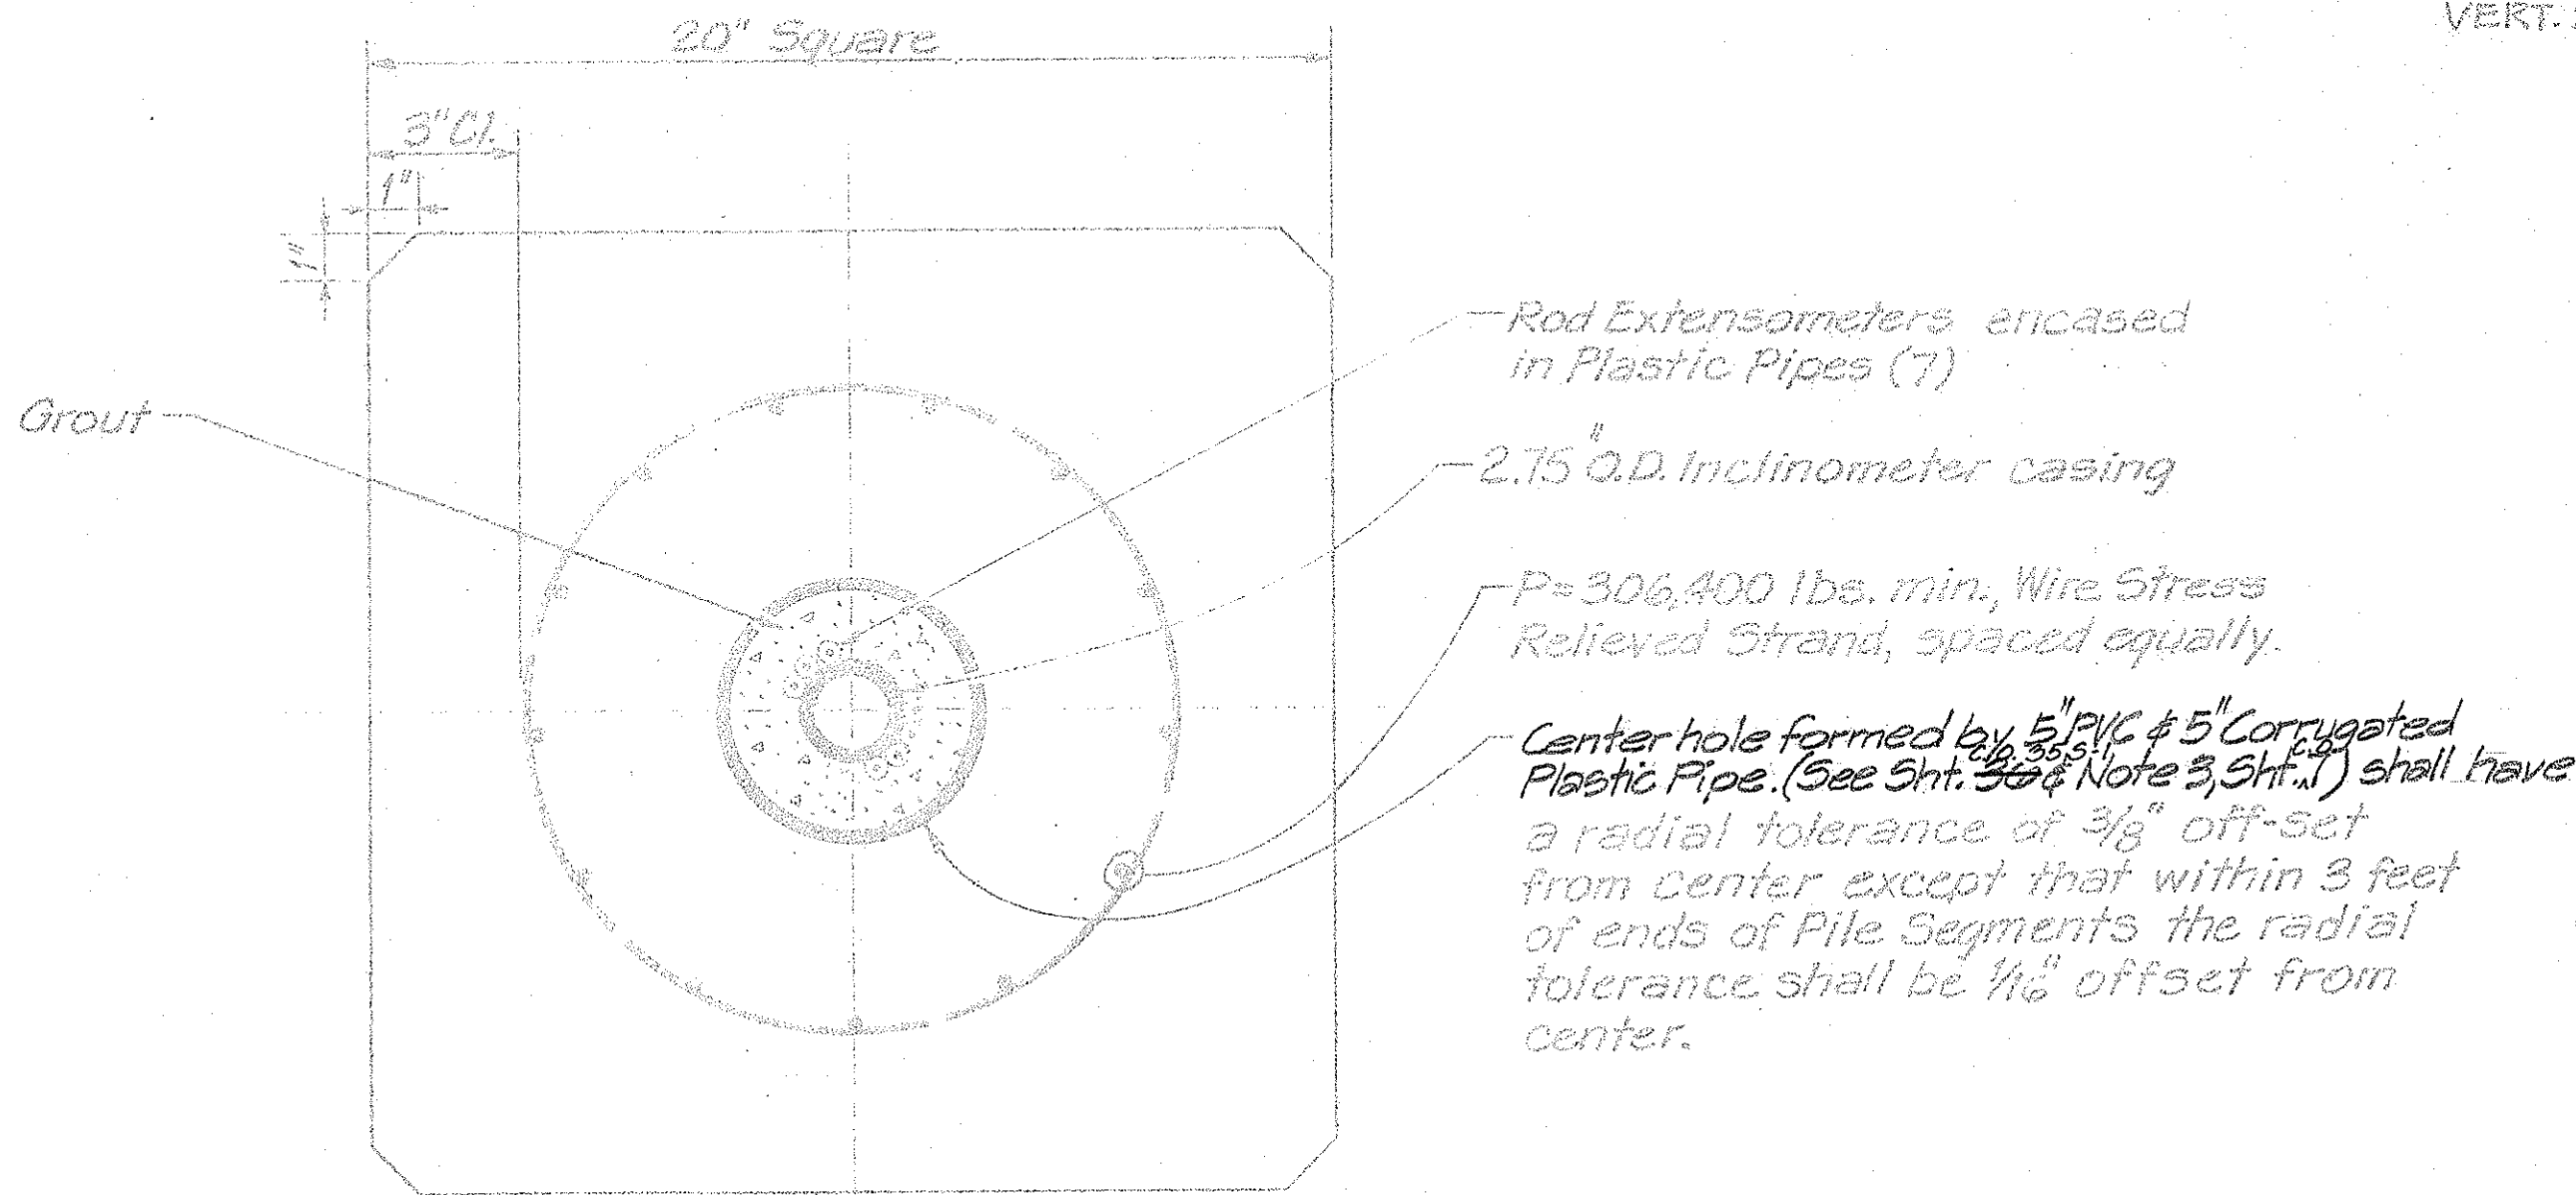

SECTION A-A
SCALE: 1"=1'-0"

Instruments Installed After Driving of Pile : Inclinator Casing
Rod-Extensometers

3/1/77	Splice type chosen and steel sleeve lowered.
Date	Revision

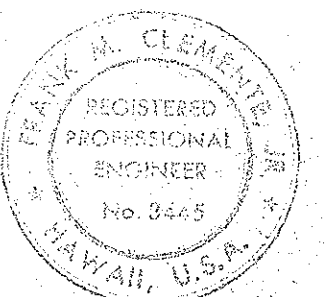

THIS WORK WAS PREPARED BY ME OR UNDER MY SUPERVISION.
Frank M. Clemente

STATE OF HAWAII
DEPARTMENT OF TRANSPORTATION
HIGHWAYS DIVISION
KEEHI INTERCHANGE
FIELD TESTING PROGRAM
PILE INSTRUMENTATION
PILE 3
INTERSTATE ROUTE H-1
PROJECT NO. I-H1-1(85)
SCALE: AS SHOWN DATE: 3/31/77
SHEET NO. 14 OF 36 SHEETS