


FED. ROAD DIST. NO.	STATE	FED. AID PROJ. NO.	FISCAL YEAR	SHEET NO.	TOTAL SHEETS
HAWAII	HAW.	I-H-1(85)	1970	5	39

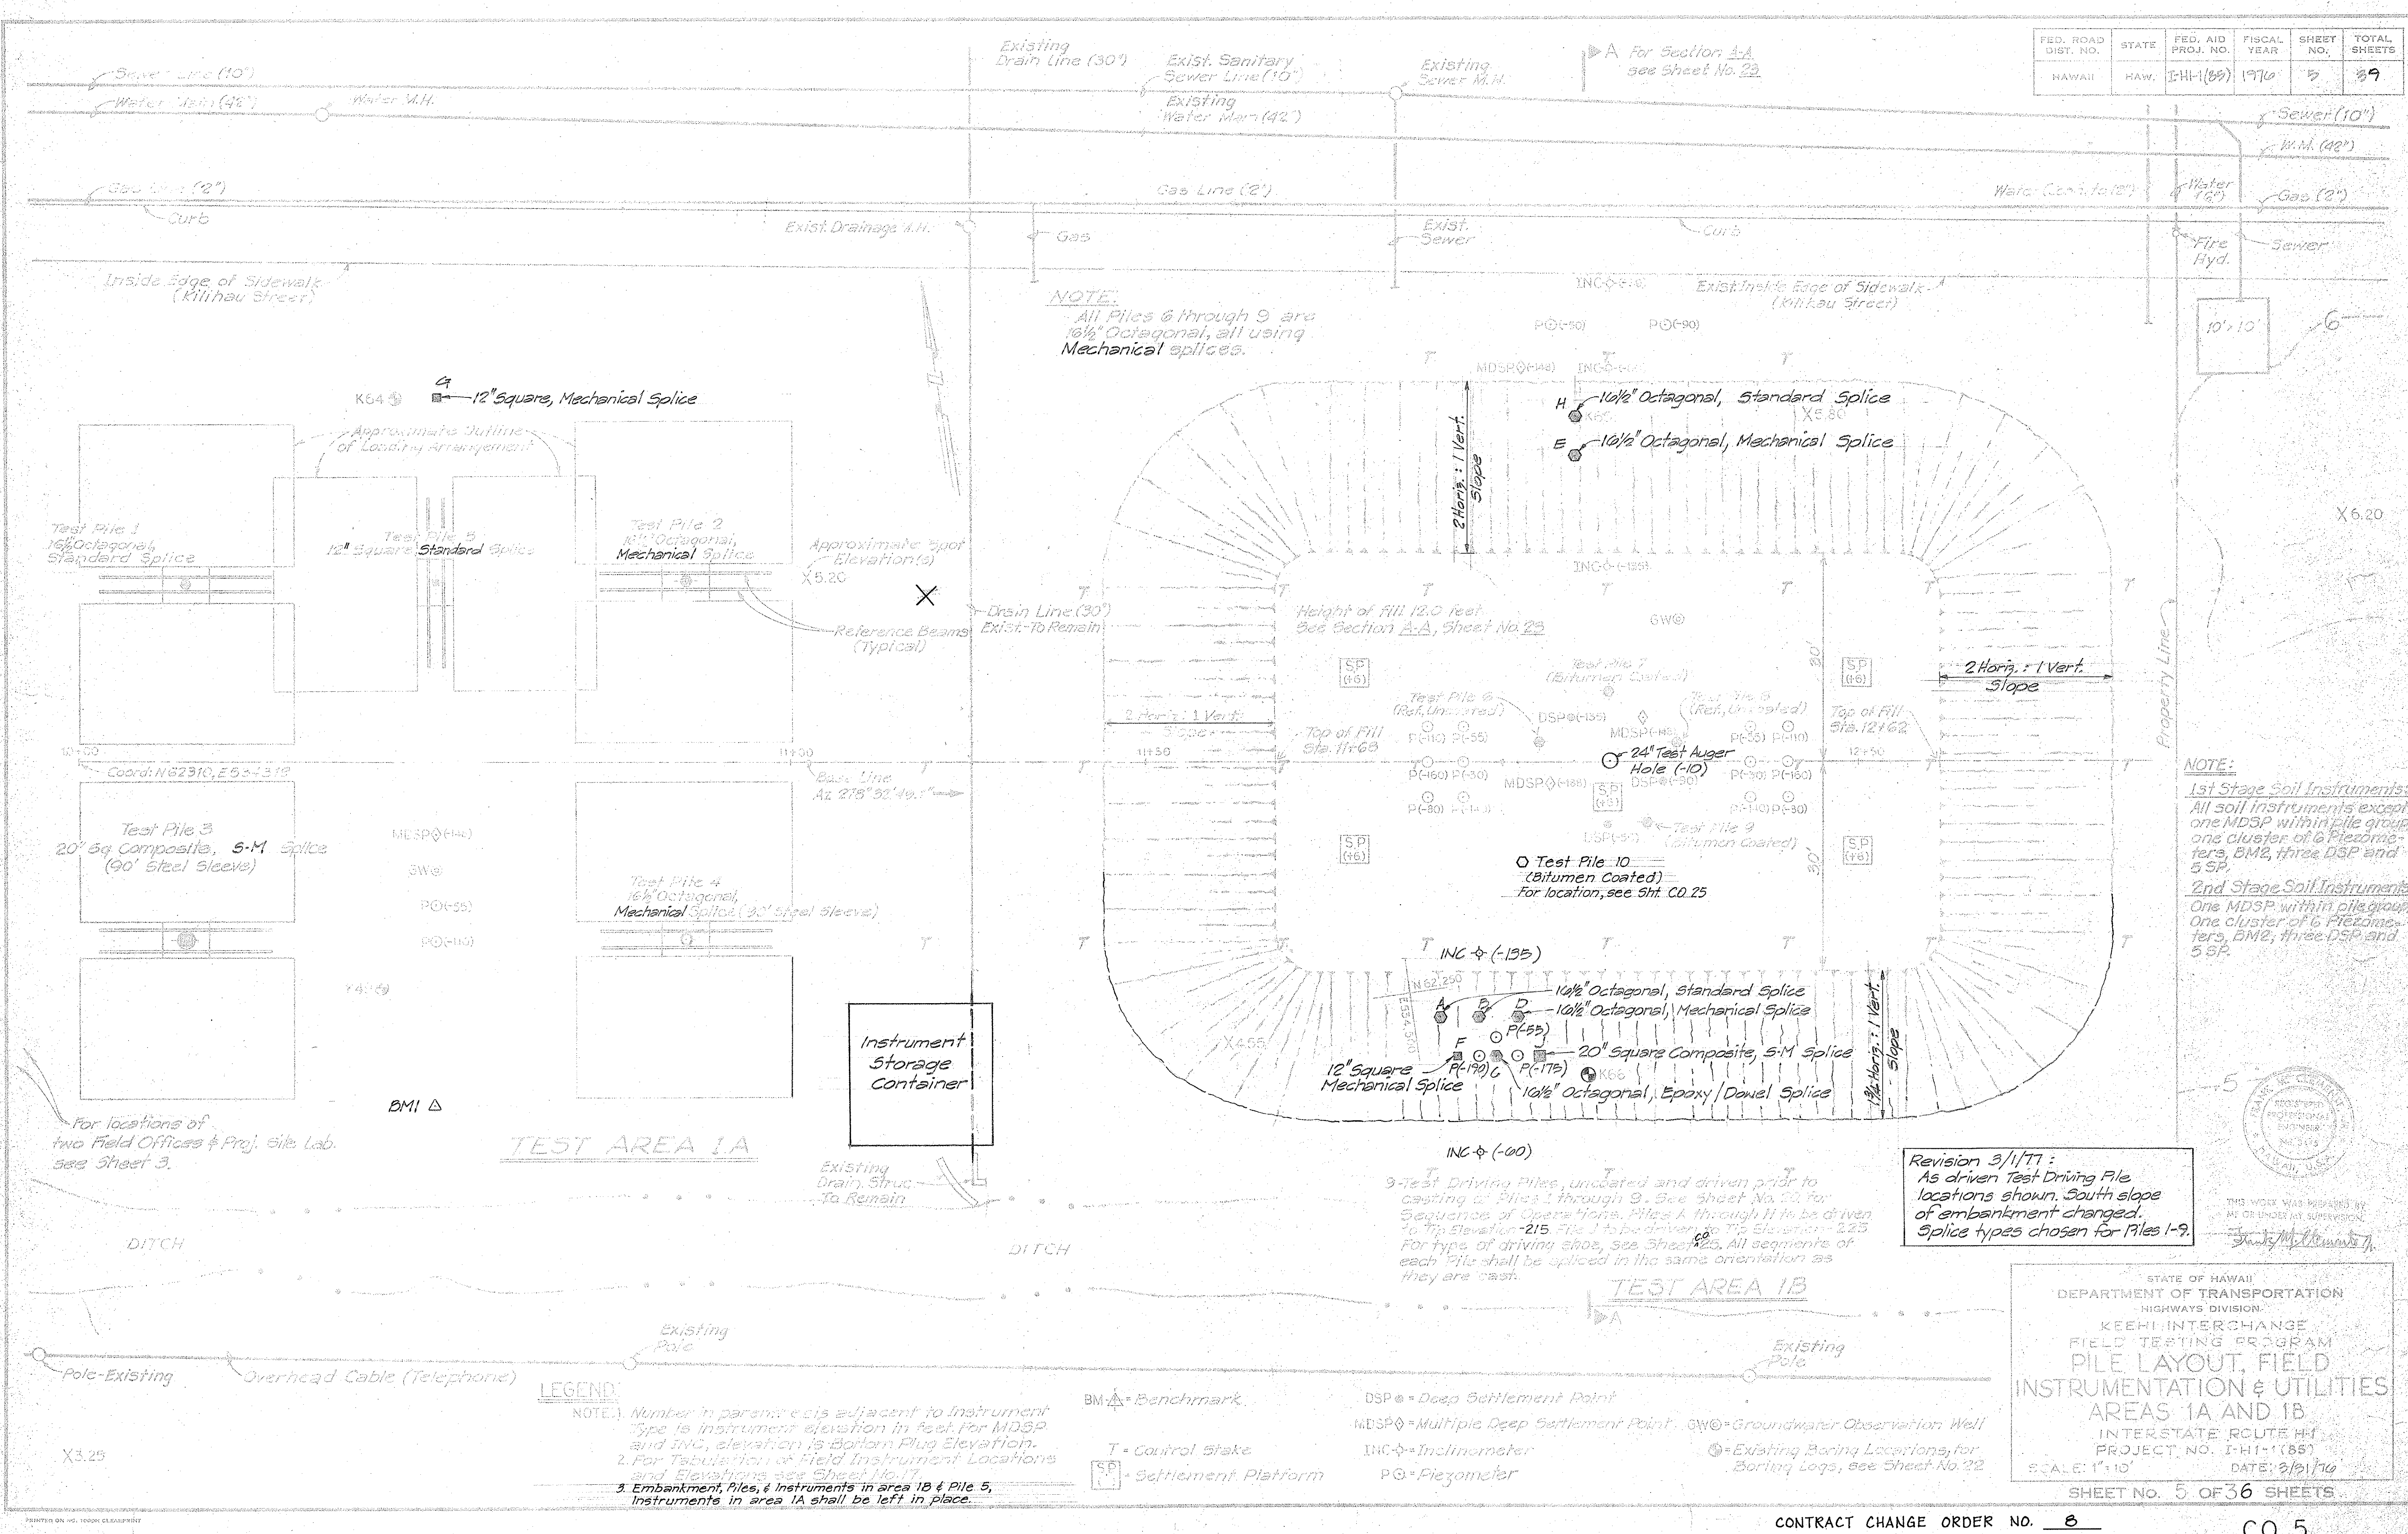

NOTE:
1st Stage Soil Instruments:
 All soil instruments except one MDSP within pile group, one cluster of 6 Piezometers, BM2, three DSP and 5SP.
2nd Stage Soil Instruments:
 One MDSP within pile group, one cluster of 6 Piezometers, BM2, three DSP and 5SP.

Revision 3/1/77:
 As driven Test Driving Pile locations shown. South slope of embankment changed. Splice types chosen for Piles 1-9.

STATE OF HAWAII

DEPARTMENT OF TRANSPORTATION

HIGHWAYS DIVISION

KEEOHI INTERCHANGE

FIELD TESTING PROGRAM

PILE LAYOUT, FIELD

INSTRUMENTATION & UTILITIES

AREAS 1A AND 1B

INTERSTATE ROUTE H-1


PROJECT NO. I-H-1(85)

SCALE: 1" = 10'

DATE: 3/31/70

SHEET NO. 5 OF 36 SHEETS

FED. ROAD DIST. NO.	STATE	FED. AID PROJ. NO.	FISCAL YEAR	SHEET NO.	TOTAL SHEETS
HAWAII	HAW.	I-H-1(85)	1970	5	35

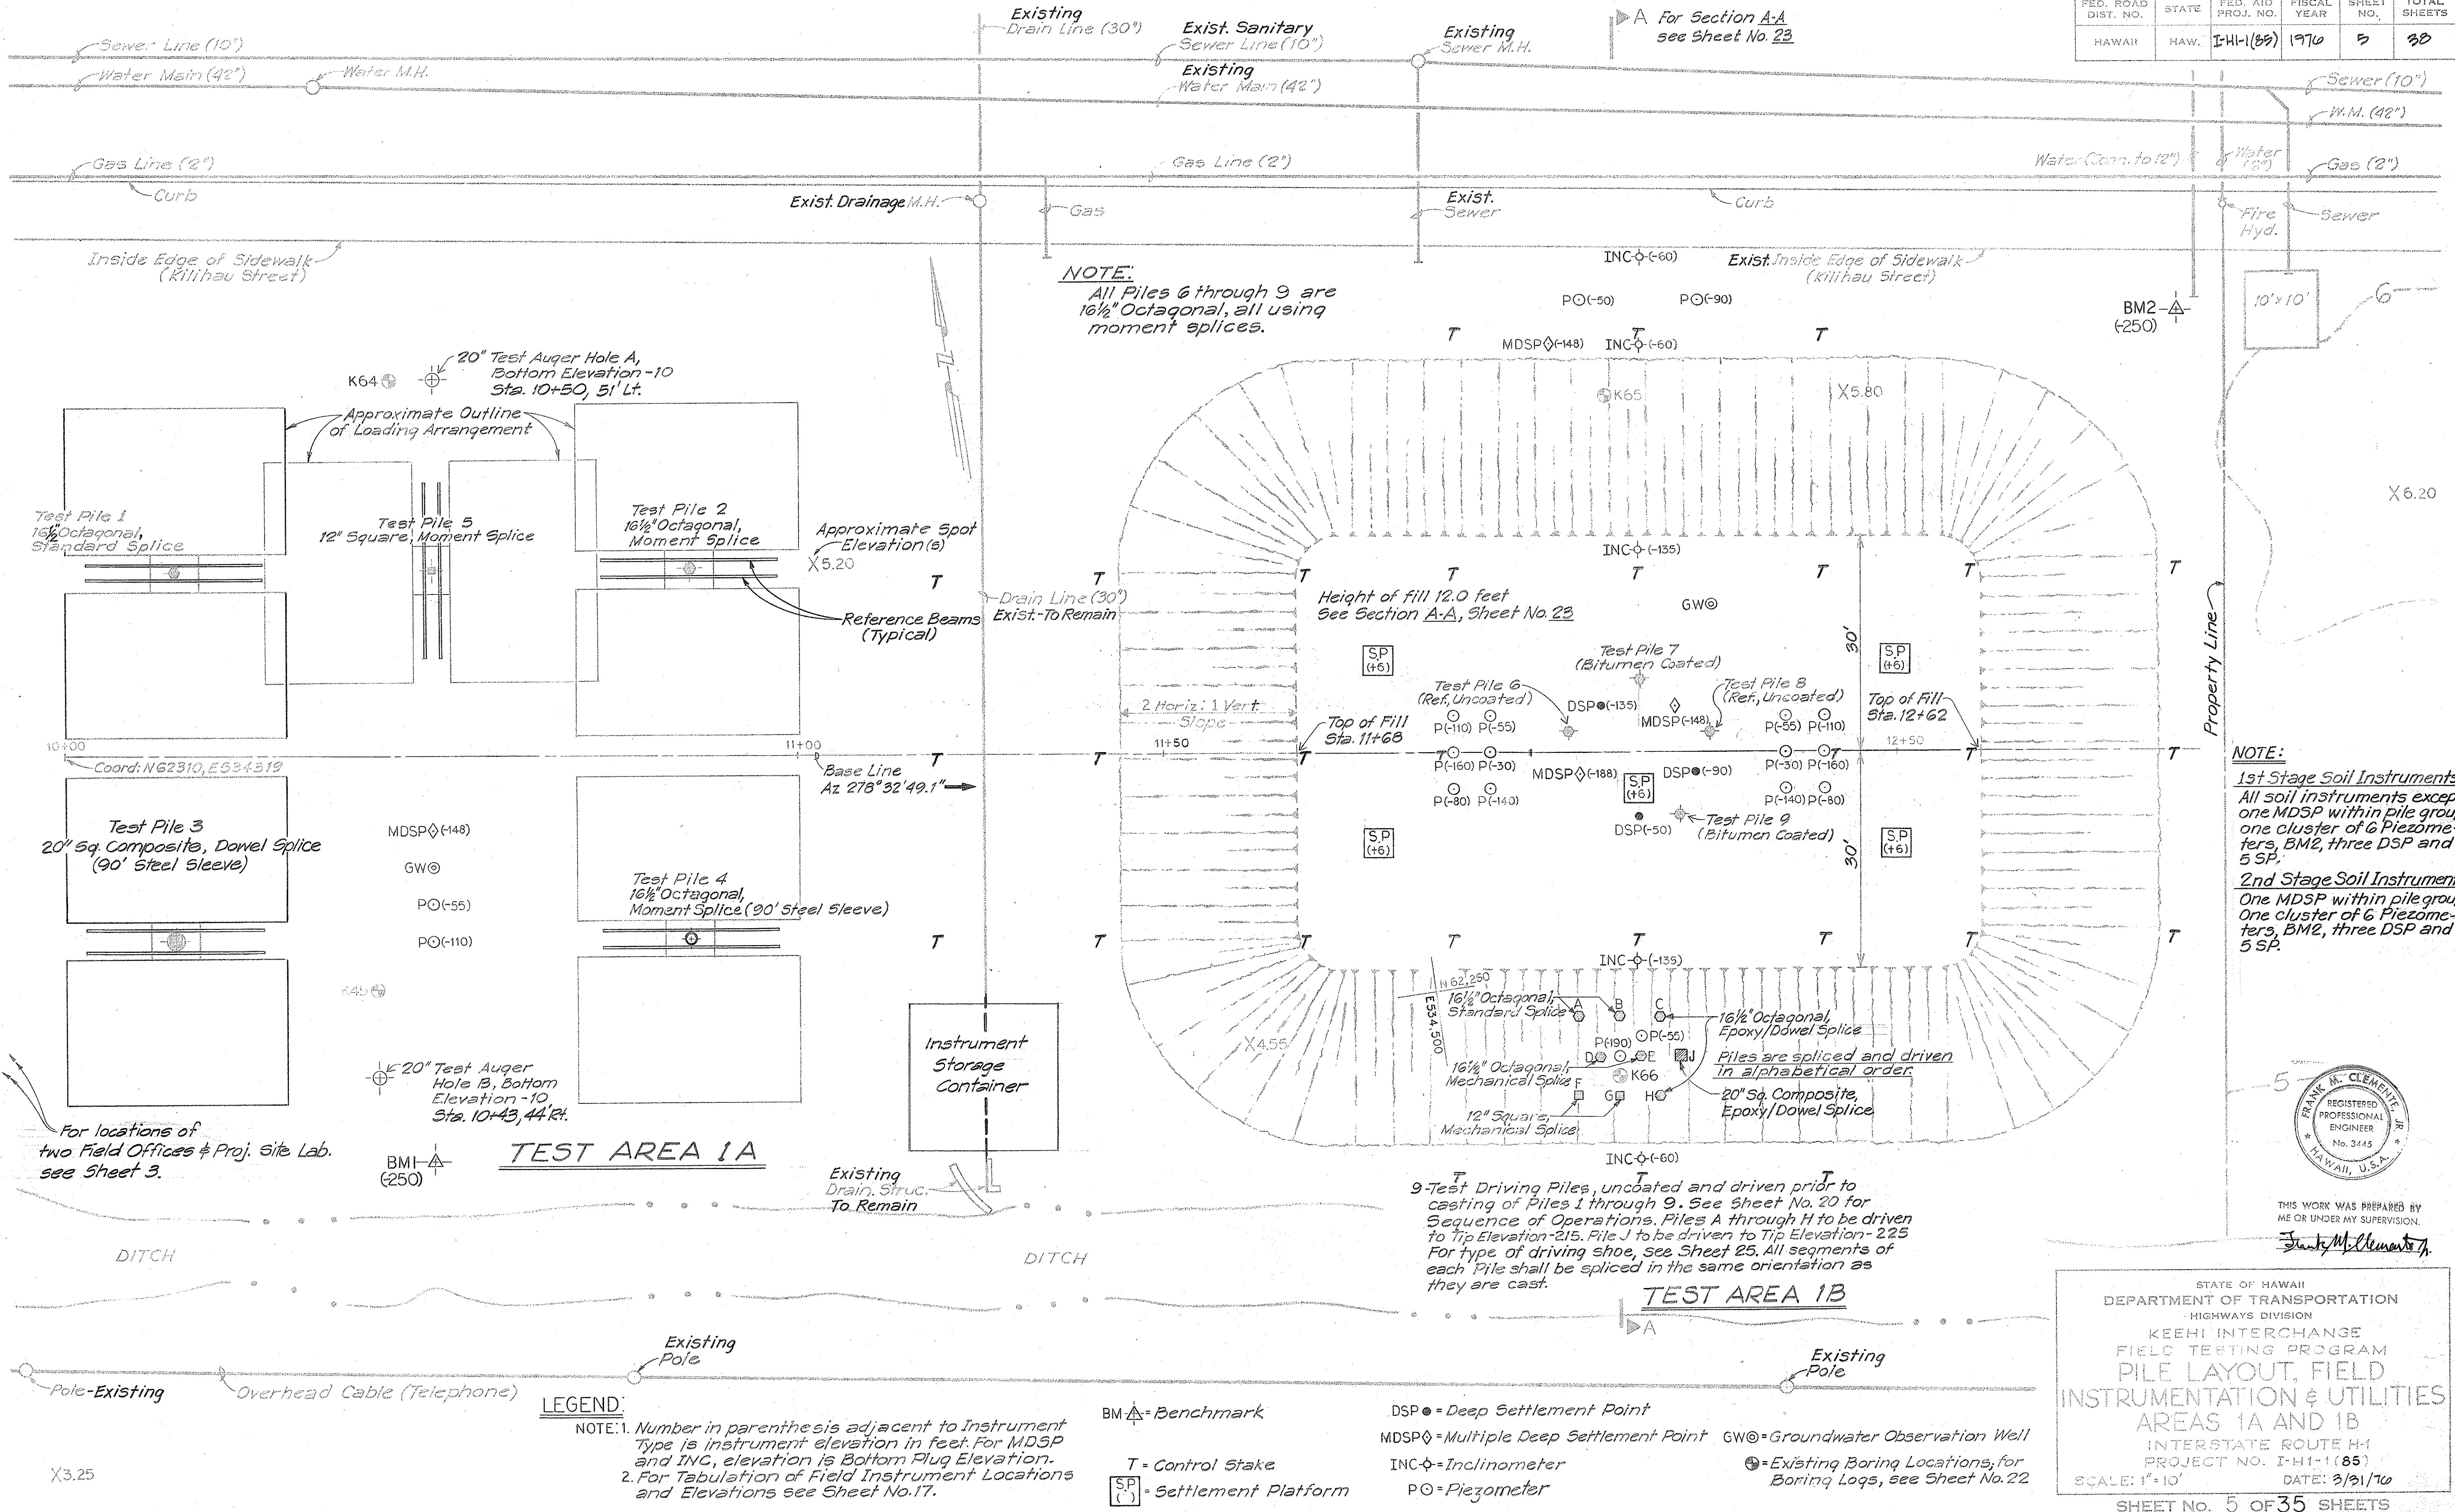

THIS WORK WAS PREPARED BY ME OR UNDER MY SUPERVISION.
Frank M. Clemente, Jr.

STATE OF HAWAII
DEPARTMENT OF TRANSPORTATION
HIGHWAYS DIVISION
KEEHI INTERCHANGE
FIELD TESTING PROGRAM
PILE LAYOUT, FIELD
INSTRUMENTATION & UTILITIES
AREAS 1A AND 1B
INTERSTATE ROUTE H-1
PROJECT NO. I-H-1(85)
SCALE: 1"=10'
DATE: 3/31/70
SHEET NO. 5 OF 35 SHEETS

SURVEY PLOTTED BY	DATE
PLAN	
TRACED BY	
DESIGNED BY	
QUANTITIES BY	
CHECKED BY	
ORIGINAL	
NOTE BOOK	
NO.	

X3.25