



FED. ROAD DIST. NO.	STATE	FED. AID PROJ. NO.	FISCAL YEAR	SHEET NO.	TOTAL SHEETS
HAWAII	HAW.	I-H-1(85)	1970	6	35

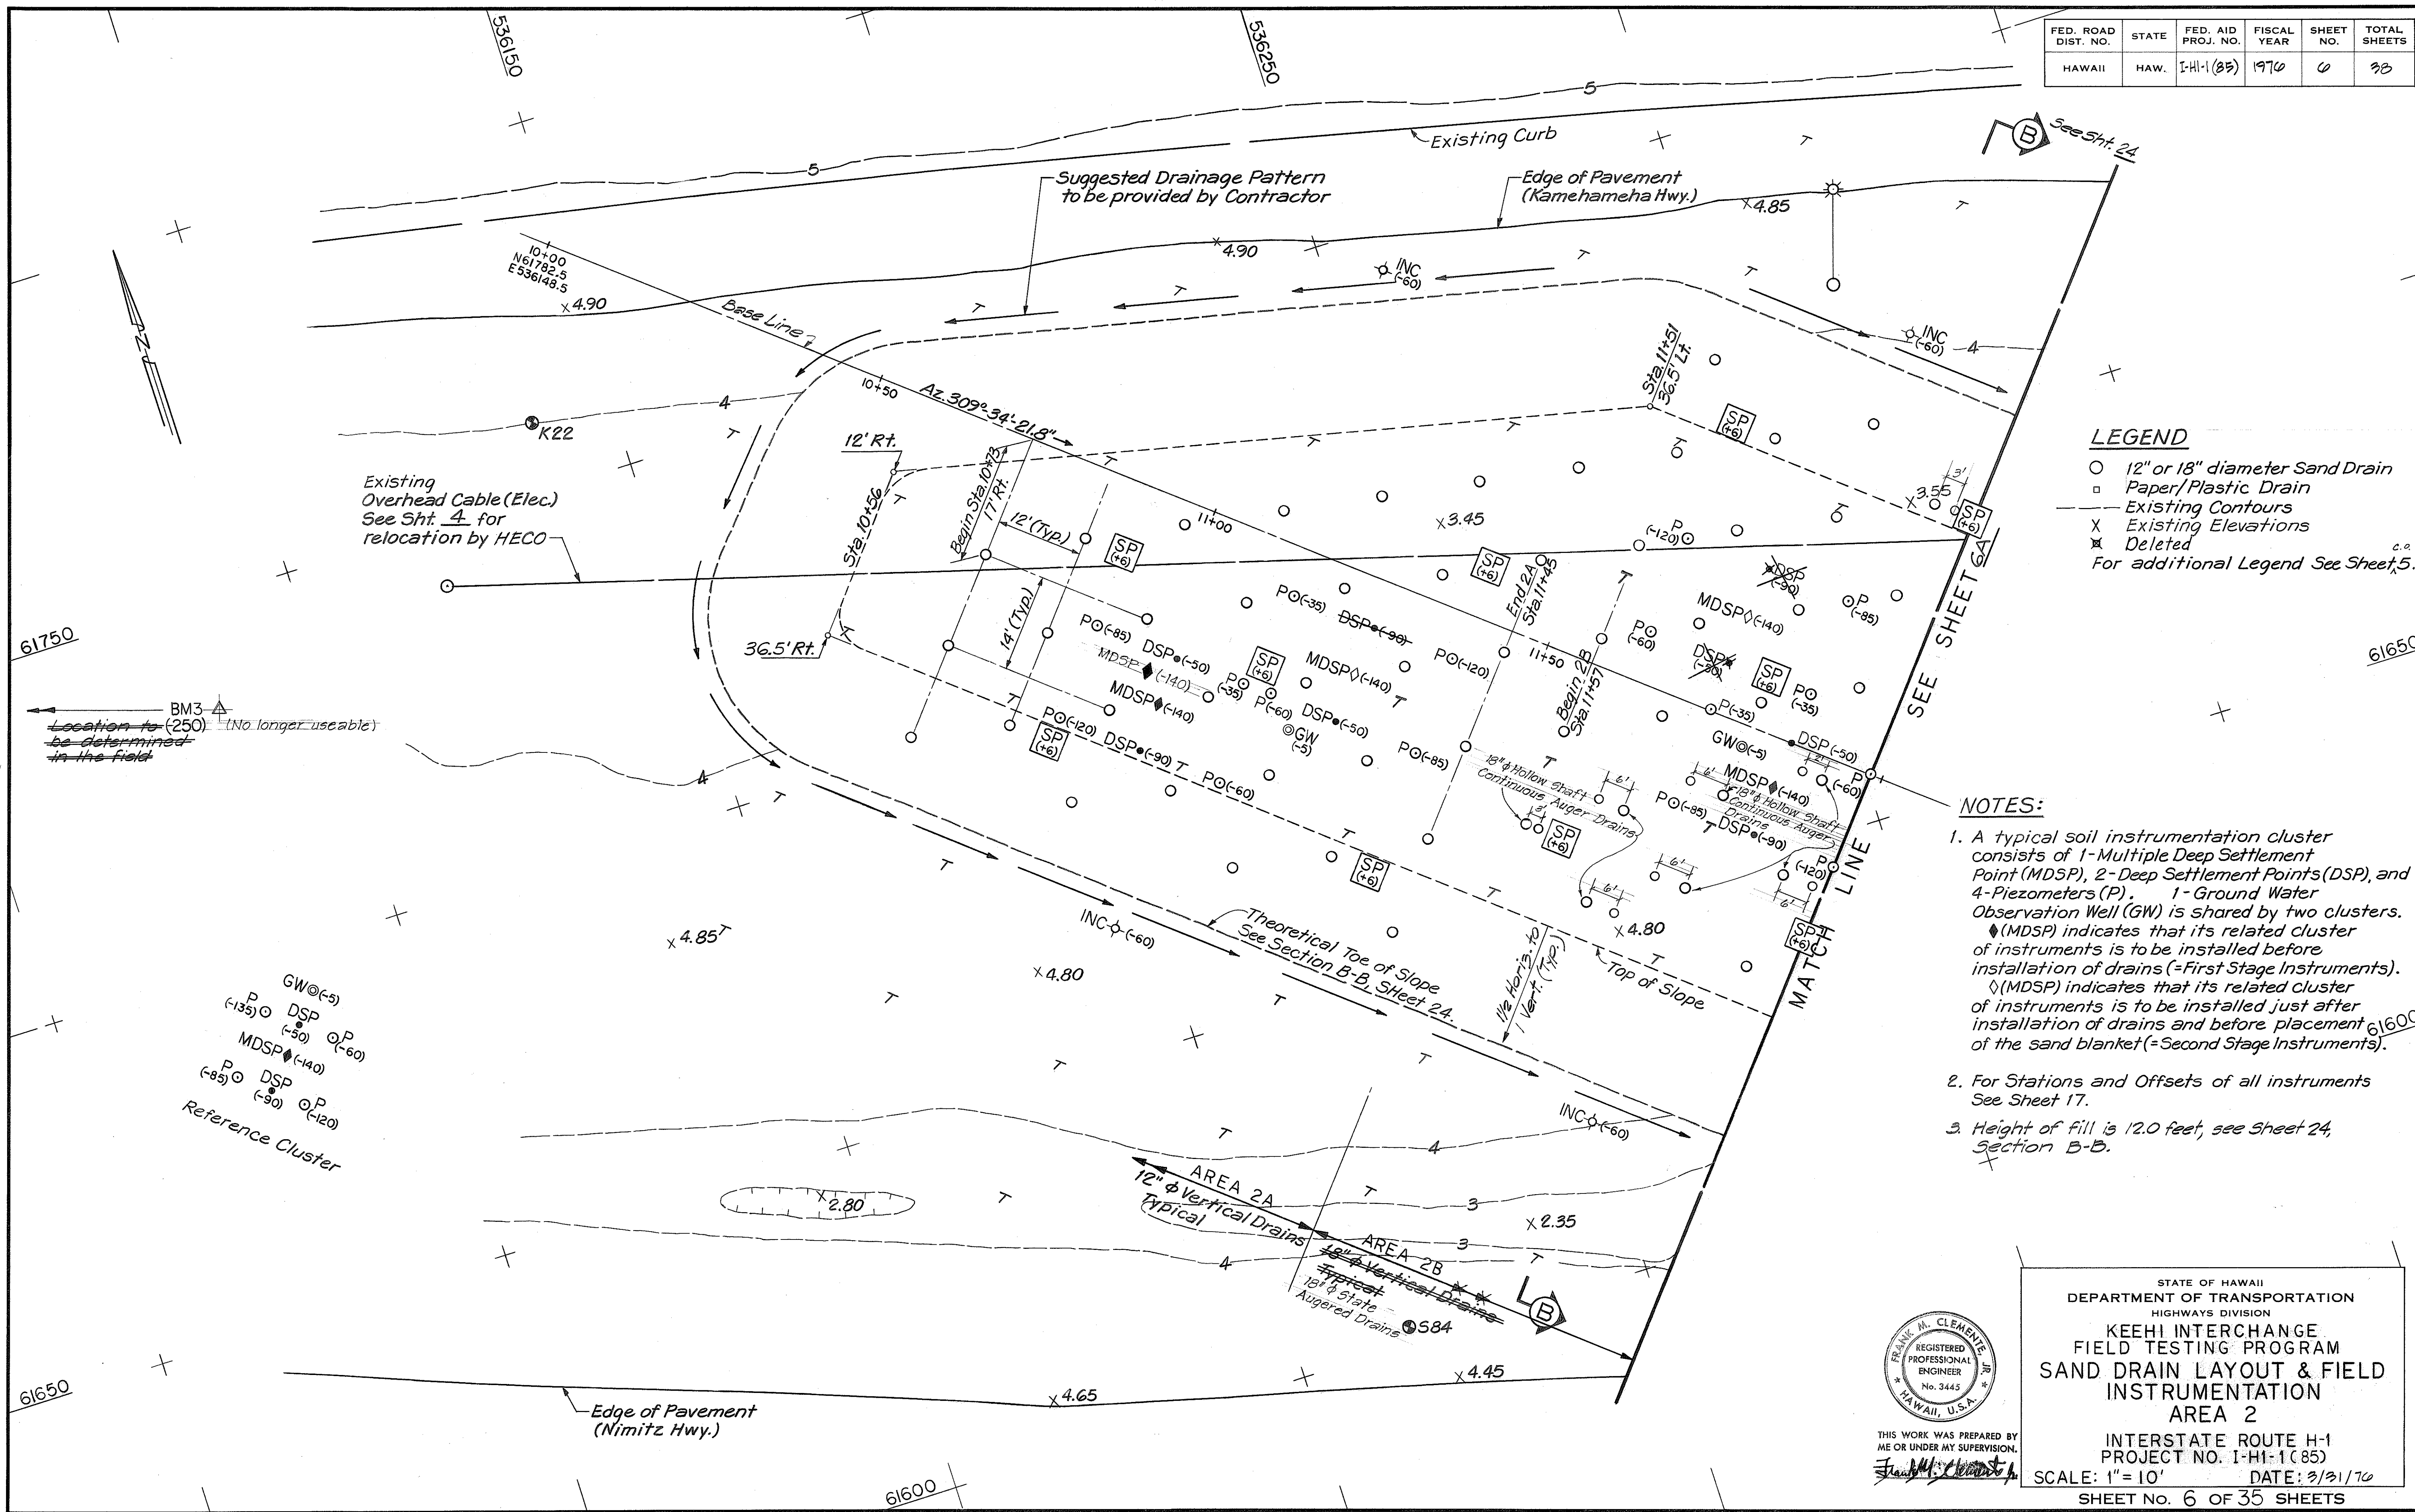

DATE	_____
SURVEY PLOTTED BY	_____
DRAWN BY	_____
DESIGNED BY	_____
CHECKED BY	_____
NOTE BOOK	_____
NO.	_____

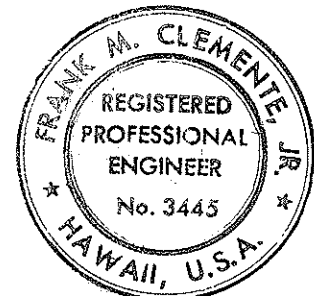

THIS WORK WAS PREPARED BY
ME OR UNDER MY SUPERVISION.
Frank M. Clemente

STATE OF HAWAII
DEPARTMENT OF TRANSPORTATION
HIGHWAYS DIVISION
KEEHI INTERCHANGE
FIELD TESTING PROGRAM
SAND DRAIN LAYOUT & FIELD
INSTRUMENTATION
AREA 2

INTERSTATE ROUTE H-1
PROJECT NO. I-H-1(85)
SCALE: 1" = 10'
DATE: 3/31/70
SHEET NO. 6 OF 35 SHEETS

