

FED. ROAD DIST. NO.	STATE	FED. AID PROJ. NO.	FISCAL YEAR	SHEET NO.	TOTAL SHEETS
HAWAII	HAW.	I-H-1 (85)	1976	17	33

CONTROL STAKES T			
STATION	NO.	OFFSET	AREA
11+19	23	25'R, 0, 25'L	1B
11+42	3	25'R, 0, 25'L	1B
11+70	3	25'R, 0, 25'L	1B
11+90	5	58'R, 25'R, 0, 25'L, 58'L	1B
12+15	4	58'R, 25'R, 25'L, 58'L	1B
12+40	5	58'R, 25'R, 0, 25'L, 58'L	1B
12+60	3	25'R, 0, 25'L	1B
12+88	3	25'R, 0, 25'L	1B
10+35	1	14'R	2A
10+60	5	14'L, 14'R, 34'R, 59'R, 79'R	2A
10+85	5	27'L, 2'L, 34'R, 59'R, 79'R	2A
11+10	4	14'L, 34'R, 79'R, 99'R	2A
11+35	6	53'L, 27'L, 14'R, 34'R, 59'R, 79'R	2A
11+55	3	79'L, 59'L, 34'L, 14'L, 14'R, 34'R, 59'R, 79'R	2B
11+80	5	79'L, 34'L, 14'R, 34'R, 79'R	2B
12+01	3	79'L, 59'L, 34'L, 14'L, 14'R, 34'R, 59'R, 79'R	2B
12+17	3	79'L, 59'L, 34'L, 14'L, 14'R, 34'R, 59'R, 79'R	2B
12+38	5	99'L, 79'L, 34'L, 14'R, 34'R	2B
12+63	6	79'L, 59'L, 34'L, 14'L, 28'R, 53'R	2B
12+88	5	79'L, 59'L, 34'L, 21'R, 46'R	2C
13+13	4	99'L, 79'L, 34'L, 15'R	2C
13+38	5	79'L, 59'L, 34'L, 8'R, 33'R	2C
13+58	1	14'L	2C
13+8313	1	14'L	2C

N.I.C.

GROUND ELEVATION STAKES +			
STATION	NO.	OFFSET	AREA
11+90	1	0	1B
12+40	1	0	1B
11+35	1	14'R	2A
11+55	2	14'L, 14'R	2B
11+80	1	14'R	2B
12+01	2	14'L, 14'R	2B
12+17	2	14'L, 14'R	2B
12+38	1	14'R	2B
12+63	1	14'L	2B

SETTLEMENT PLATFORMS SB			
STATION	NO.	OFFSET	AREA
11+80	2	12'R, 12'L	1B
12+15	1	5'R	1B
12+50	2	12'R, 12'L	1B
10+91	2	10'R, 38'R	2A
11+15	1	17'R	2A
11+39	2	7'L, 38'R	2B
11+62	2	38'L, 24'R	2B
11+80	1	8'L	2B
11+98	2	38'L, 24'R	2B
12+25	2	38'L, 24'R	2B
12+38	1	7'L	2B
12+50	2	38'L, 24'R	2B
12+88	2	38'L, 10'R	2C
13+13	1	17'L	2C
13+3813	2	38'L, 34'R	2C

GROUND WATER OBSERVATION WELL GW				
STATION	NO.	OFFSET	ELEVATION (WELL POINT)	AREA
10+50	1	15'R	-5	1A
12+25	1	20'L	-5	1B
10+10	1	110'R	-5	2A
11+21	1	24'R	-5	2A
11+80	1	3'R	-5	2B
12+33	1	7'L	-5	2B
13+04	1	15'L	-5	2C

INSTRUMENTS SUPPLIED BY CONTRACTOR

PIEZOMETER * P					
STATION	NO.	OFFSET	TYPE	ELEVATION	AREA
10+50	2	20'R, 25'R		-55, -110	1A
11+90	3	5'L, 0, 5'R		-110, -160, -80	1B
11+95	3	5'L, 0, 5'R		-55, -30, -140	1B
12+07	1	62'L		-50	1B
12+11+97	1	42'R		-190	1B
12+1500	1	38'R		-55	1B
12+23	1	62'L		-90	1B
12+35	3	5'L, 0, 5'R		-55, -30, -140	1B
12+40	3	5'L, 0, 5'R		-110, -160, -80	1B
12+03	1	42'R		-175	1B
10+05	2	115'R, 125'R		-35, -85	2A
10+15	2	115'R, 125'R		-60, -120	2A
10+91	2	21'R, 35'R		-85, -120	2A
11+13	1	21'R		-35	2A
11+15	2	7'R, 35'R		-35, -60	2A
11+17	1	21'R		-60	2A
11+39	2	7'R, 21'R		-120, -85	2A
11+62	2	21'L, 7'L		-120, -60	2B
11+74	2	0, 14'R		-35, -85	2B
11+86	2	21'L, 7'L		-85, -35	2B
11+98	2	0, 14'R		-60, -120	2B
12+32	4	19'L, 12'L, 2'L, 5'R		-120, -60, -35, -85	2B
12+44	4	19'L, 12'L, 2'L, 5'R		-85, -35, -60, -120	2B
12+86	2	19'L, 12'L		-120, -60	2C
12+93	2	19'L, 12'L		-85, -35	2C
13+12+1238	2	8.5' 42'L, 54' 22.5'L		-35, -85	2C
13+22-1286	2	8.5' 42'L, 54' 22.5'L		-60, -120	2C

* To be salvaged when directed by the Engineer.

INCLINOMETER INC.				
STATION	NO.	OFFSET	ELEVATION (BOTTOM PLUG)	AREA
12+15	5	67'L, 55'L, 27'L, 27'R, 55'R	-60, -60, -135, -135, -60	1B
11+10	2	40'L, 59'R	-60, -60	2A
11+80	2	59'L, 59'R	-60, -60	2B
12+38	2	59'L, 59'R	-60, -60	2B
13+13	2	59'L, 40'R	-60, -60	2C

DEEP SETTLEMENT POINT DSP				
STATION	NO.	OFFSET	ELEVATION	AREA
12+10	1	7'L	-135	1B
12+15	1	9'R	-50	1B
12+23	1	3'R	-90	1B
10+10	2	115'R, 125'R	-50, -90	2A
11+03	2	21'R, 35'R	-50, -90	2A
11+27	12	7'R, 21'R	-90, -50	2A
11+74	2	21'L, 7'L	-90, -50	2B
11+86	2	0, 14'R	-50, -90	2B
12+38	34	19'L, 12'L, 2'L, 5'R	-50, -90, -90, -50	2B
12+92	2	19'L, 12'L	-90, -50	2C
13+16	2	12'L, 5'L	-50, -90	2C

* Indicates DSP installed but no longer in use.

MULTI-DEEP SETTLEMENT POINT MDSP				
STATION	NO.	OFFSET	ELEVATION (BOTTOM PLUG)	AREA
10+50	1	10'R	-148	1A
12+03	1	56'L	-148	1B
12+07	1	3'R	-188	1B
12+20	1	6'L	-148	1B
10+10	1	120'R	-140	2A
11+03	1	27'R*	-140	2A
11+27	1	14'R*	-140	2A
11+2475	1	15' 14'L	-140	2B
11+86	1	7'R*	-140	2B
12+38	2	16'L, 2'R	-140, -140	2B
12+92	1	16'L*	-140	2C
13+16	1	9'L	-140	2C
11+00	1	24'R	-140	2A
12+38	1	24'L	-140	2B

* Indicates MDSP installed but no longer in use.

BENCHMARKS			
STATION	NO.	OFFSET	ELEVATION
10+50	BM1	55'R	-250
12+88	BM2	60'L	-250
*See Below	BM3		-250
13+22.78	BM4	144.5L	-250

* Location to be determined in the field because of excessive settlement, BM3 is no longer useable.




THIS WORK WAS PREPARED BY ME OR UNDER MY SUPERVISION.
Frank M. Clemente


STATE OF HAWAII
DEPARTMENT OF TRANSPORTATION
HIGHWAYS DIVISION
KEEHI INTERCHANGE
FIELD TESTING PROGRAM
TABULATION OF FIELD
INSTRUMENT LOCATIONS
AND ELEVATIONS
INTERSTATE ROUTE H-1
PROJECT NO. I-H-1 (85)
DATE: 3/31/76
SHEET NO. 17 OF 35 SHEETS

DATE: _____
SURVEY PLOTTED BY: _____
DRAWN BY: _____
DESIGNED BY: _____
CHECKED BY: _____
NOTE BOOK NO. _____

FED. ROAD DIST. NO.	STATE	FED. AID PROJ. NO.	FISCAL YEAR	SHEET NO.	TOTAL SHEETS
HAWAII	HAW.	I-HI-1(85)	1976	18	38

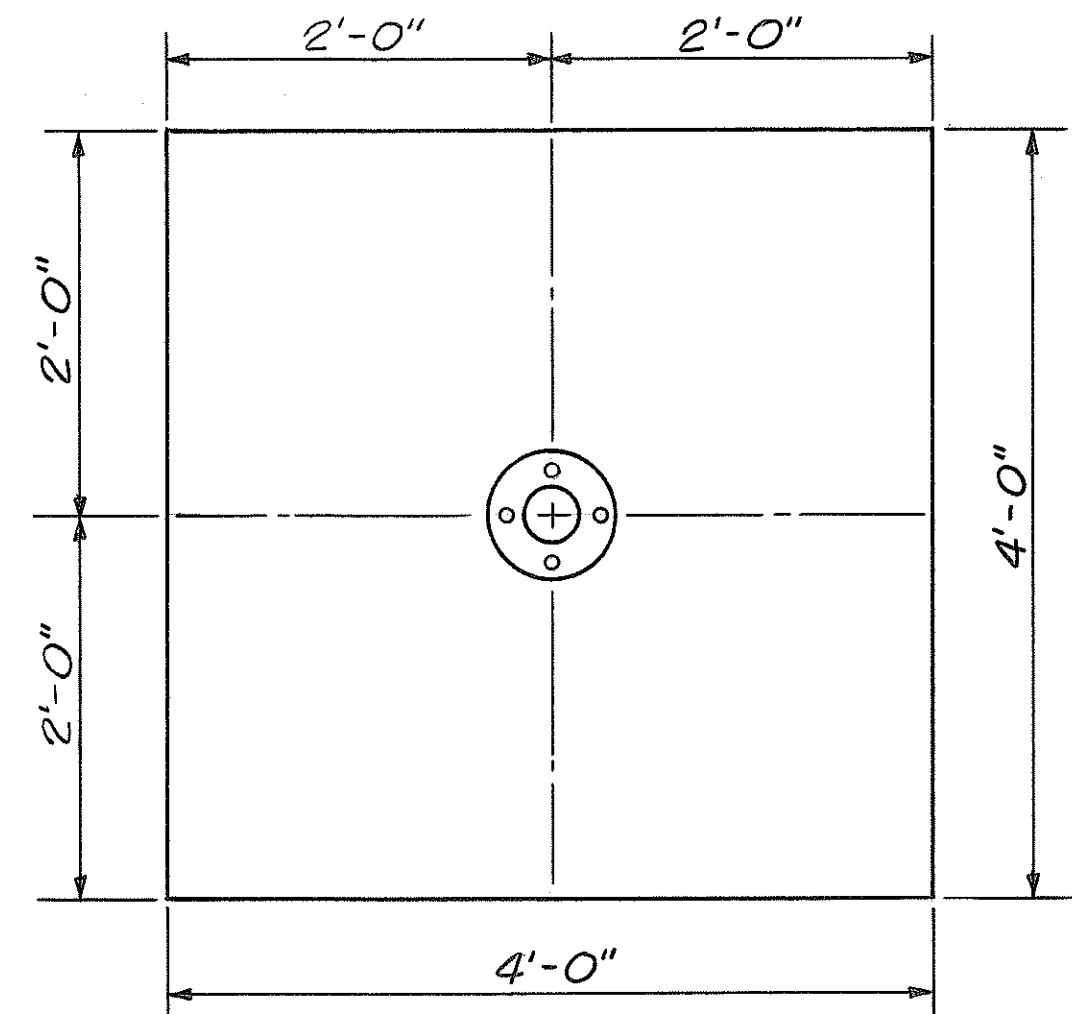


PLAN

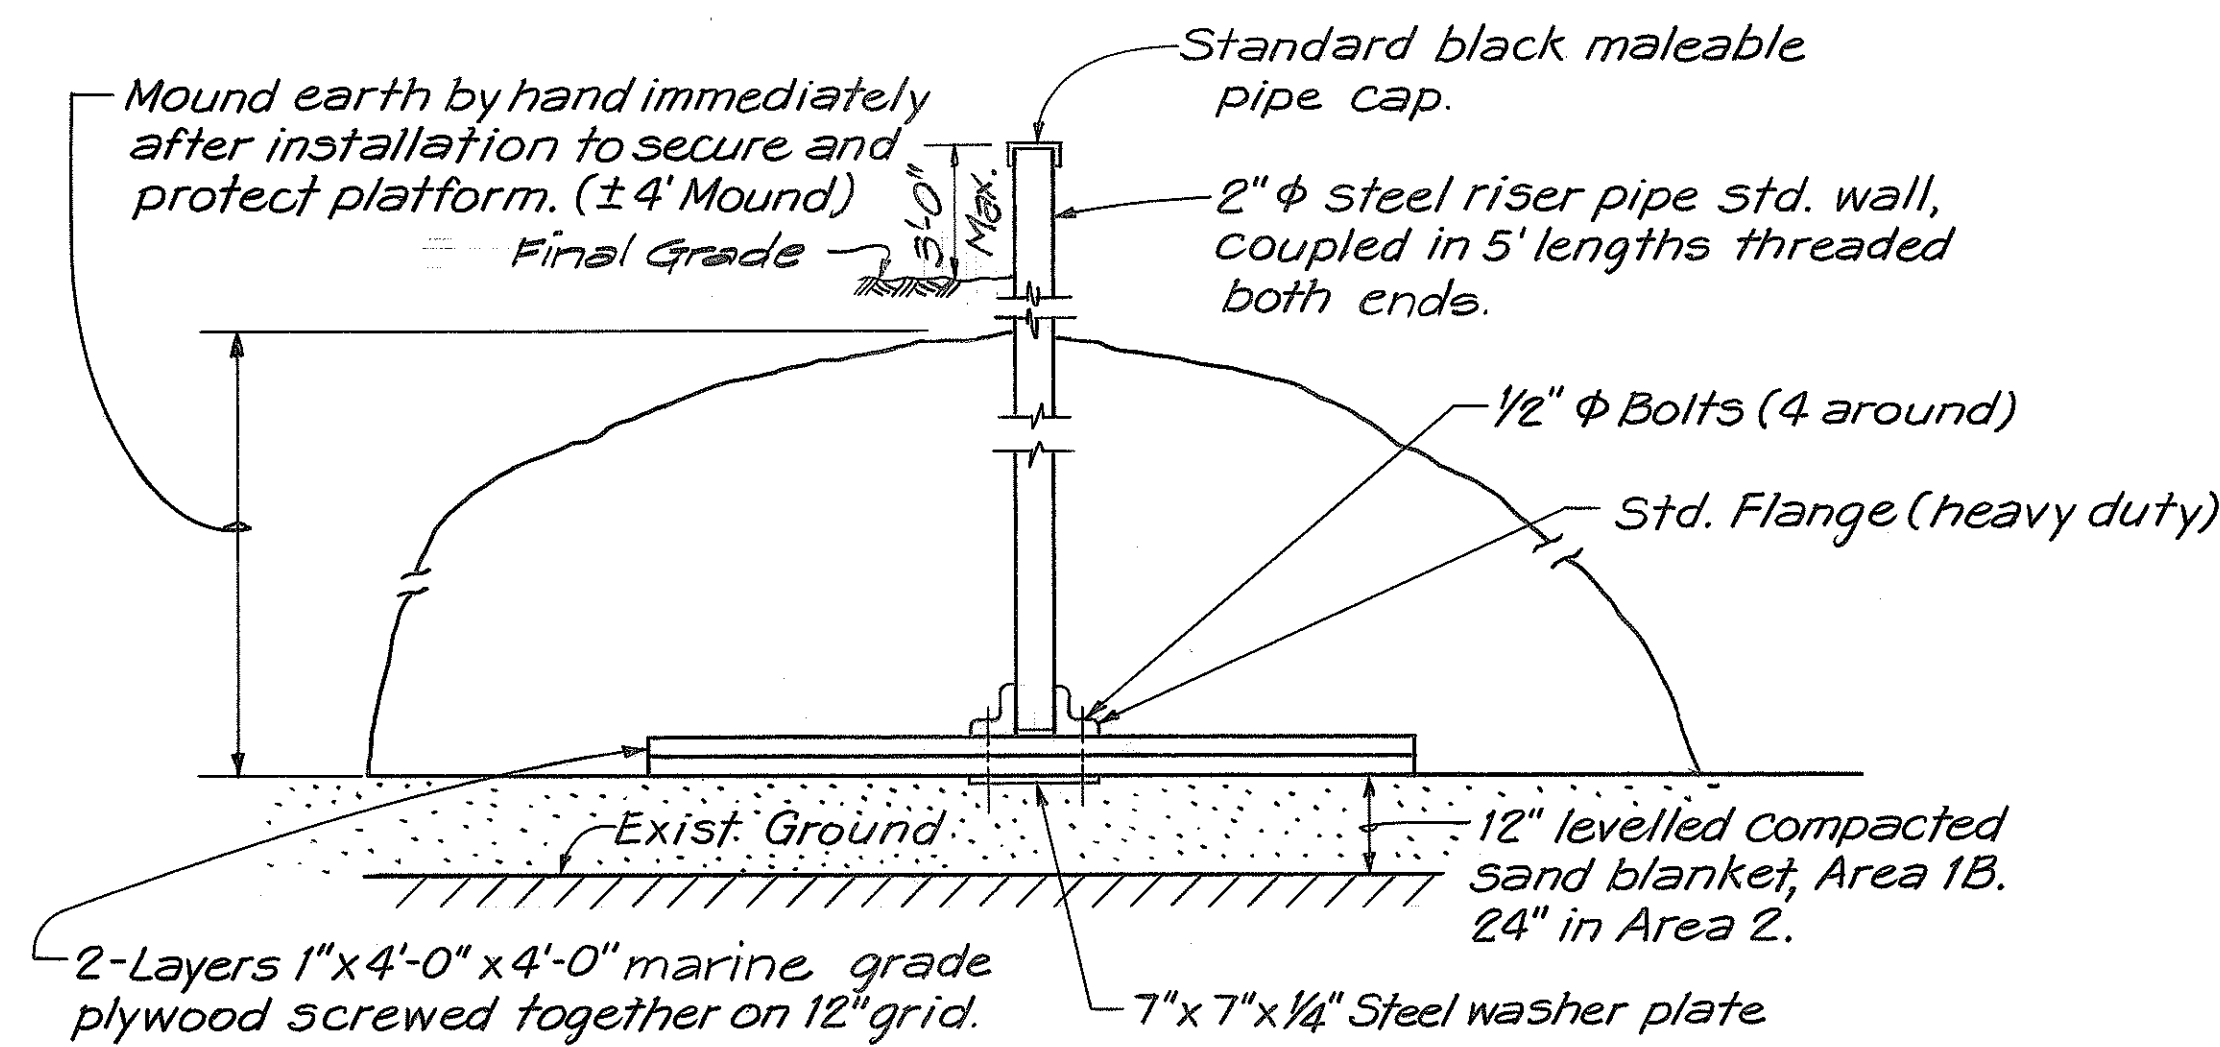


SETTLEMENT PLATFORM DETAIL
Scale: 1"=1'-0"

NOTES:

1. Contractor to furnish material and labor to extend pipe up through fill.
2. All vertical pipes of Settlement Platforms shall be accurately and consecutively numbered in one foot intervals measured from the bottom of the Settlement Platform base. The numbering and graduations shall be marked on the vertical pipe using file cuts and durable yellow paint by the contractor, under the supervision of the Engineer, immediately after each section of pipe is added.

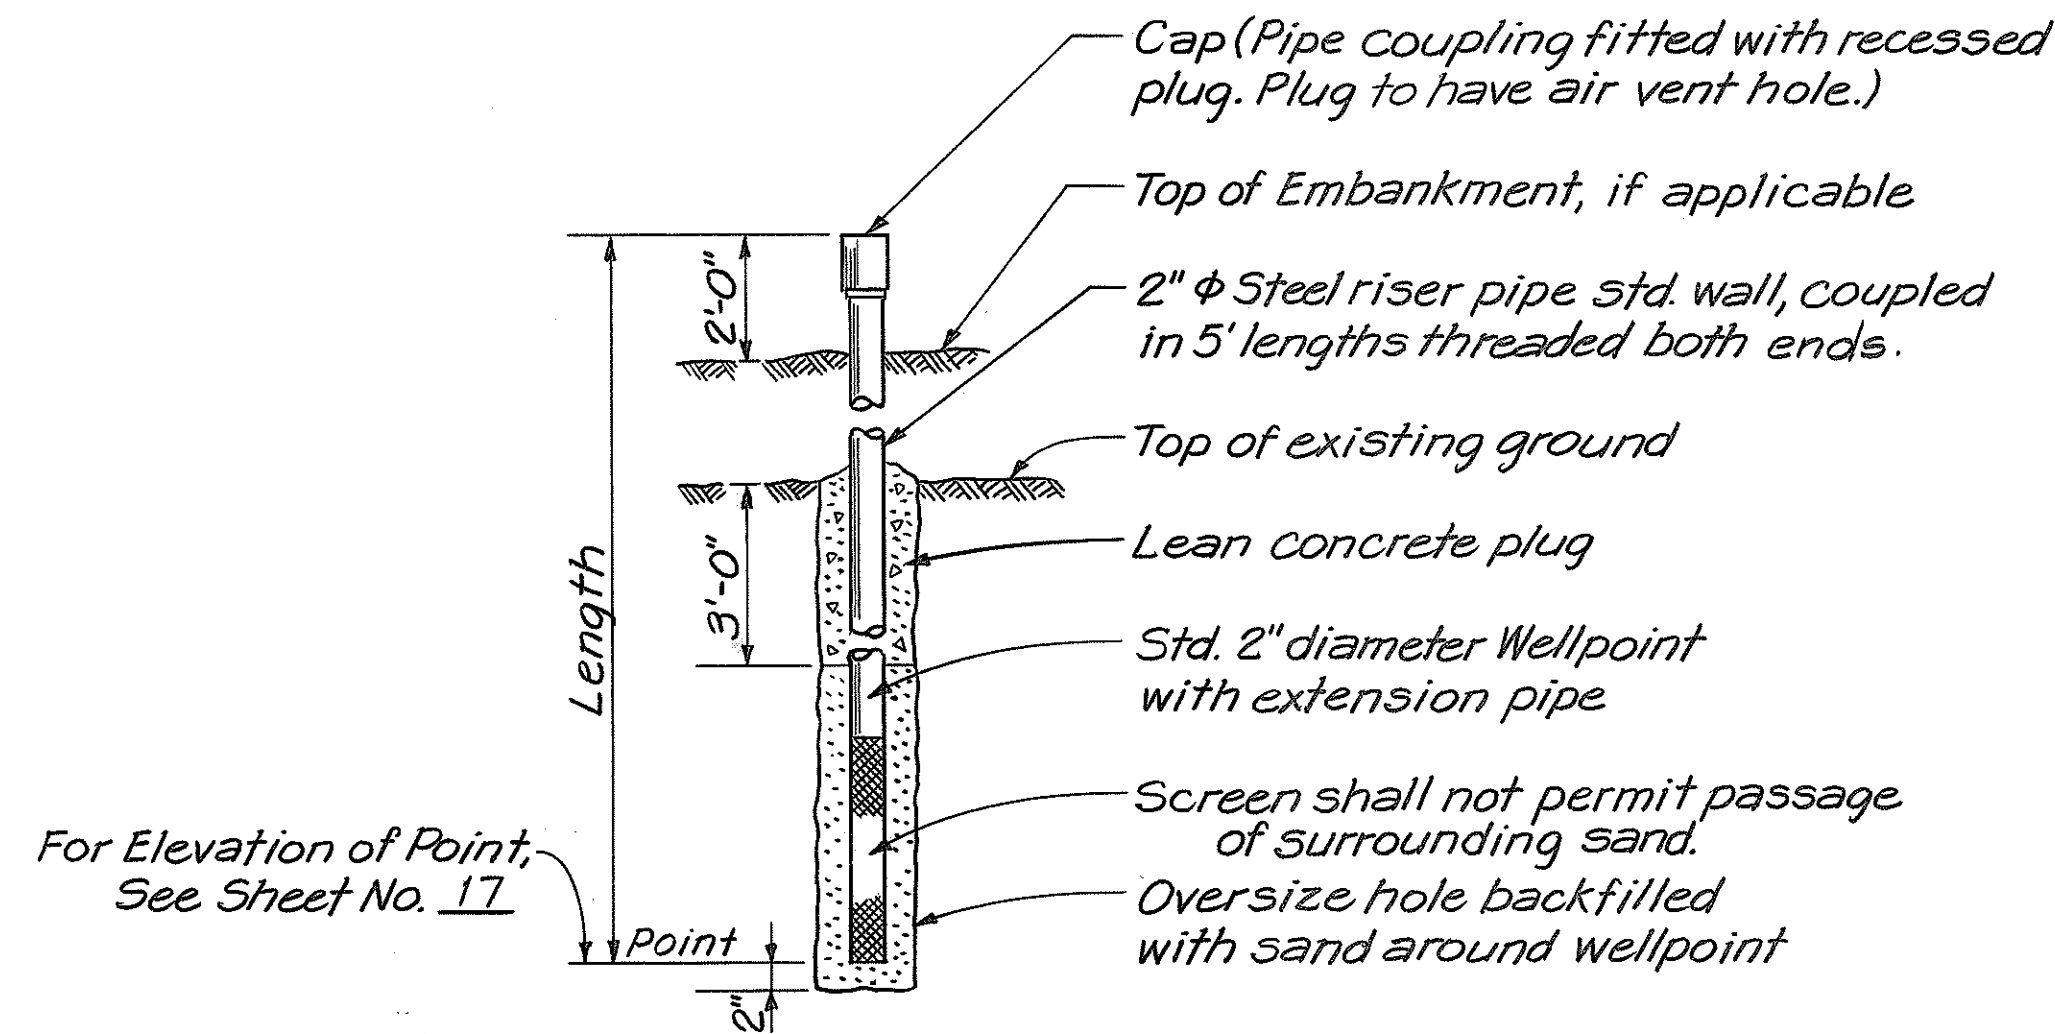


GROUND WATER
OBSERVATION WELL DETAIL
No Scale


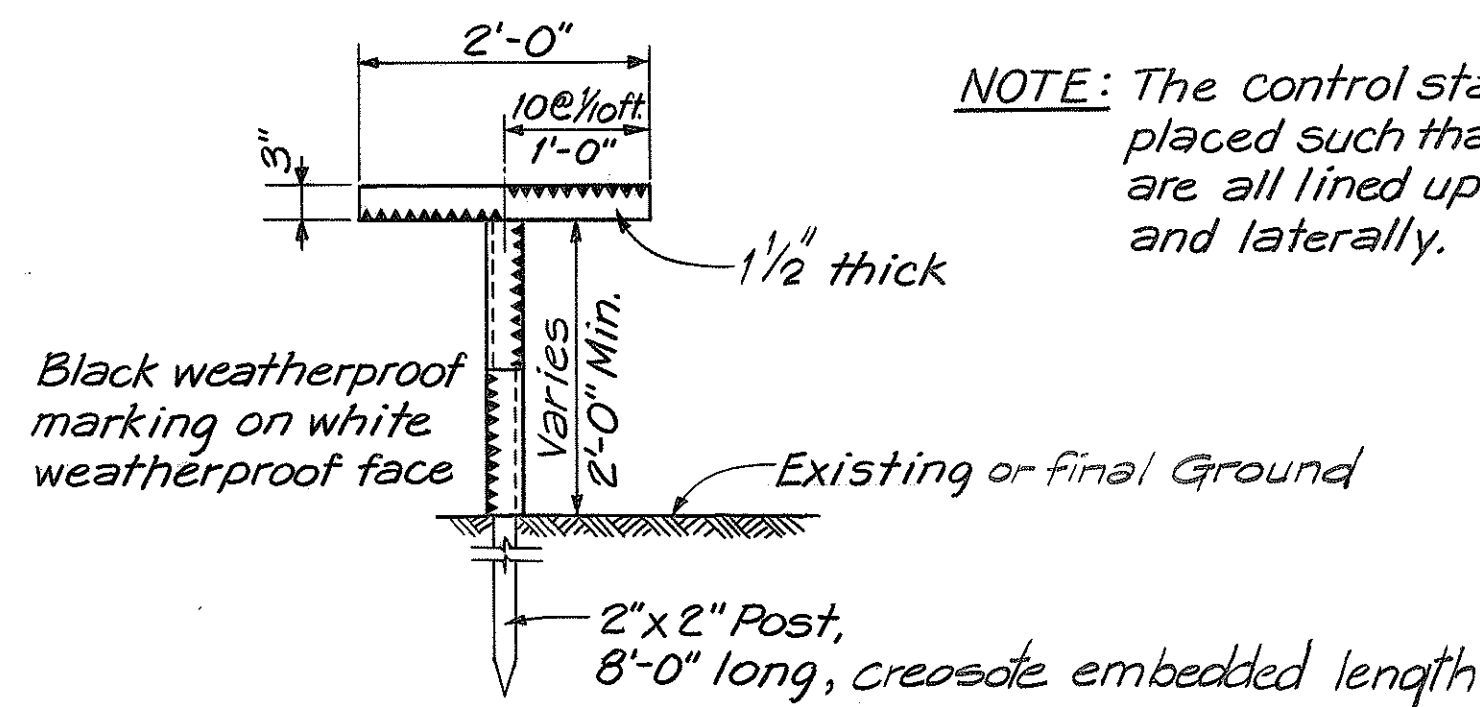


CONTROL STAKE DETAIL
No Scale

NOTE: ~~NIC~~
Contractor to furnish and install Ground Elevation Stakes on and around the fill at Test Areas 1B and 2 as shown on Sheet No's 5, 6, 8A & 17. Each ground elevation stake shall consist of a 3' length of 1" Φ steel bar, 1" std. black pipe, or 3"x2" lumber with stake tack at top. Stakes shall be driven to stick up 6", and numbered with paint as directed by the Engineer.

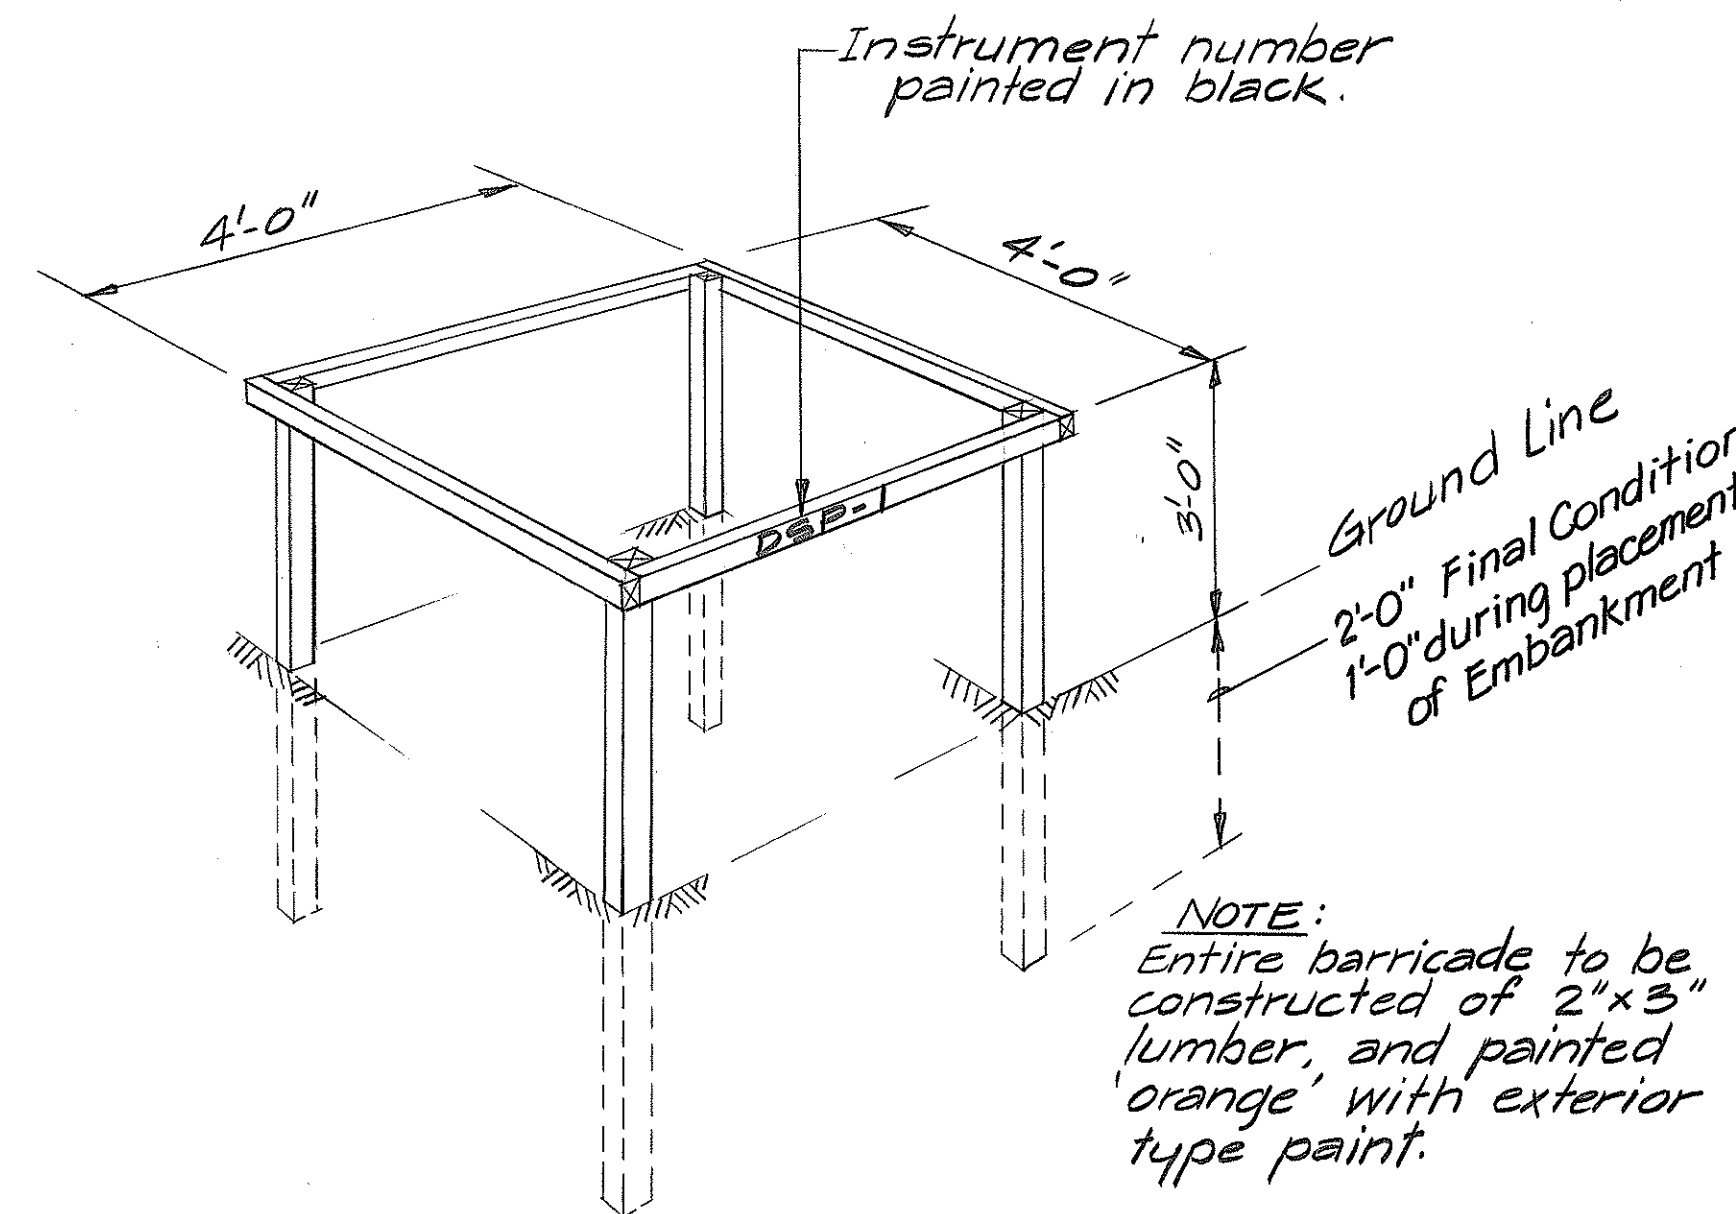


PROTECTIVE BARRICADE FOR
INSTRUMENTS AND PILES
No Scale

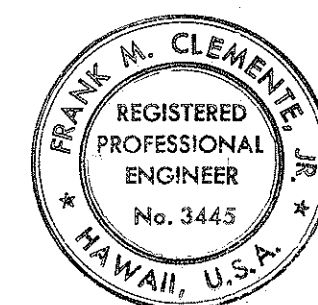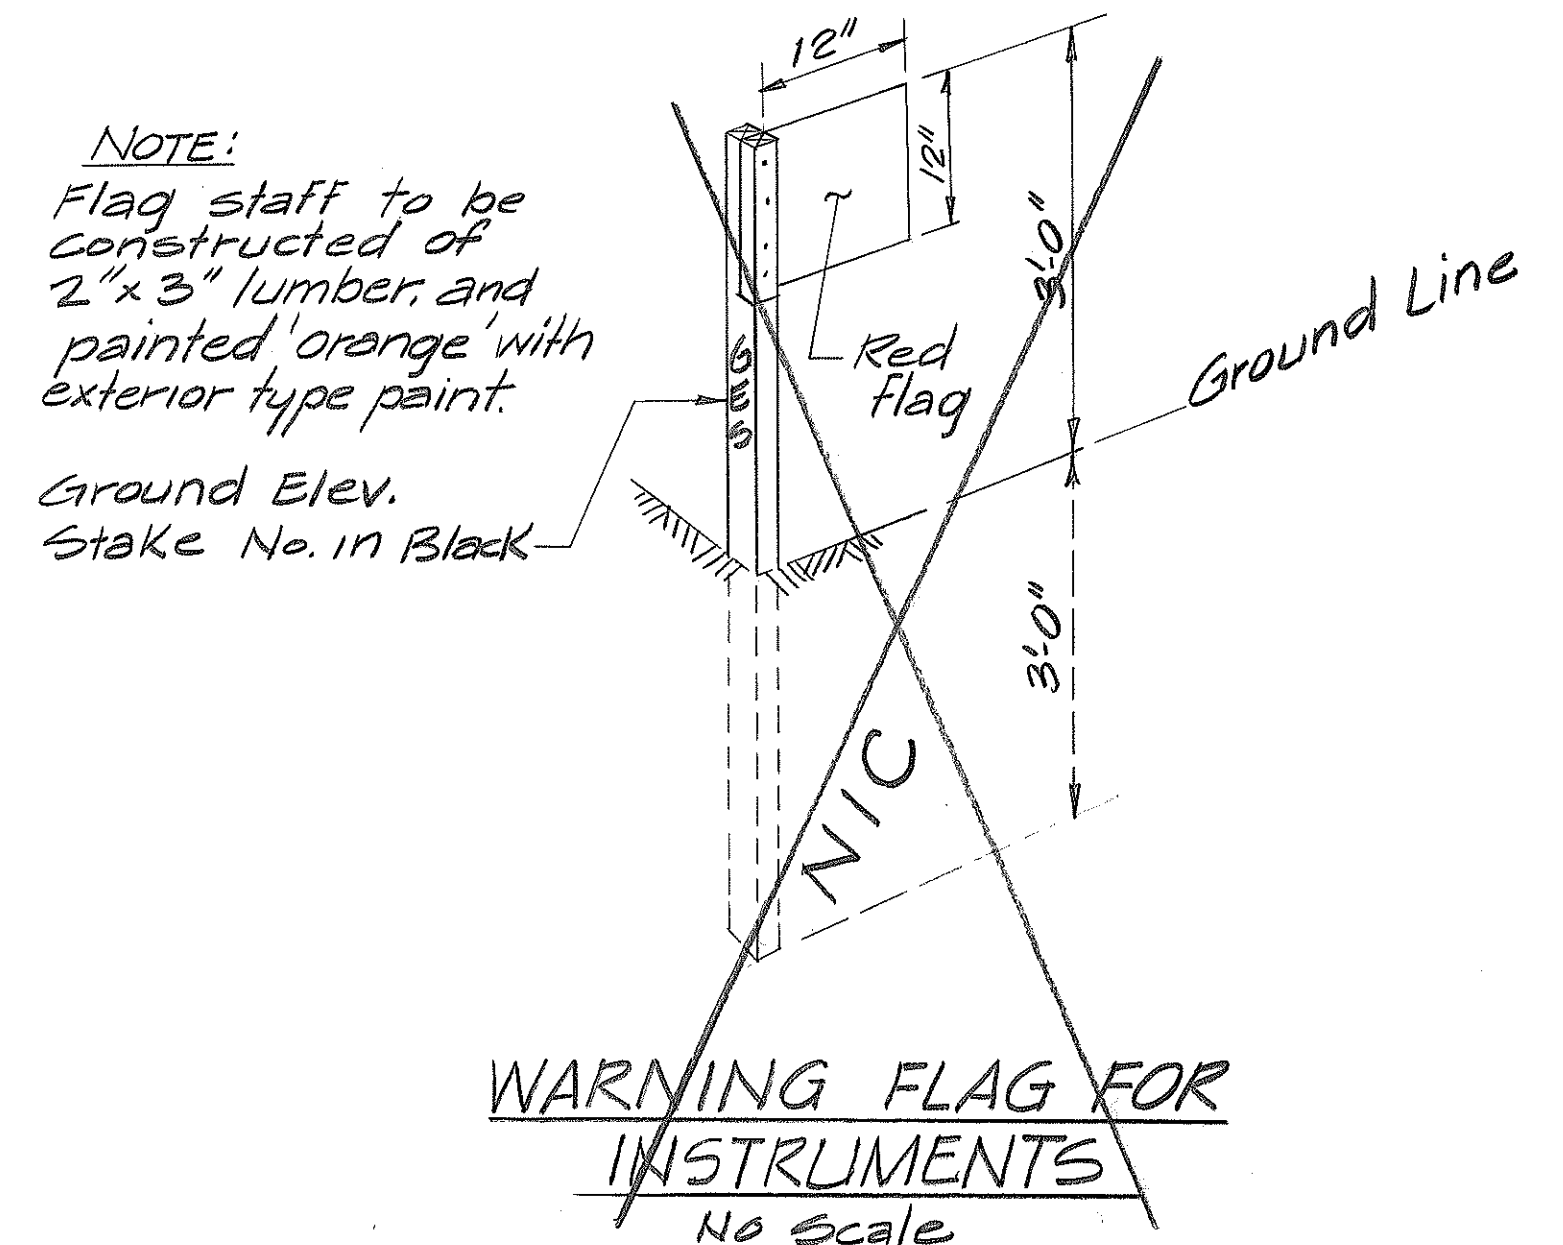


THIS WORK WAS PREPARED BY
ME OR UNDER MY SUPERVISION,
Frank M. Clemente

STATE OF HAWAII
DEPARTMENT OF TRANSPORTATION
HIGHWAYS DIVISION
KEEHI INTERCHANGE
FIELD TESTING PROGRAM
INSTRUMENTS SUPPLIED
BY CONTRACTOR
INTERSTATE ROUTE H-1
PROJECT NO. I-HI-1 (85)
SCALE: AS SHOWN DATE: 3/31/76
SHEET No. 18 OF 35 SHEETS


FED. ROAD DIST. NO.	STATE	FED. AID PROJ. NO.	FISCAL YEAR	SHEET NO.	TOTAL SHEETS
HAWAII	HAW.	IHI-1(85)	1976	19	38

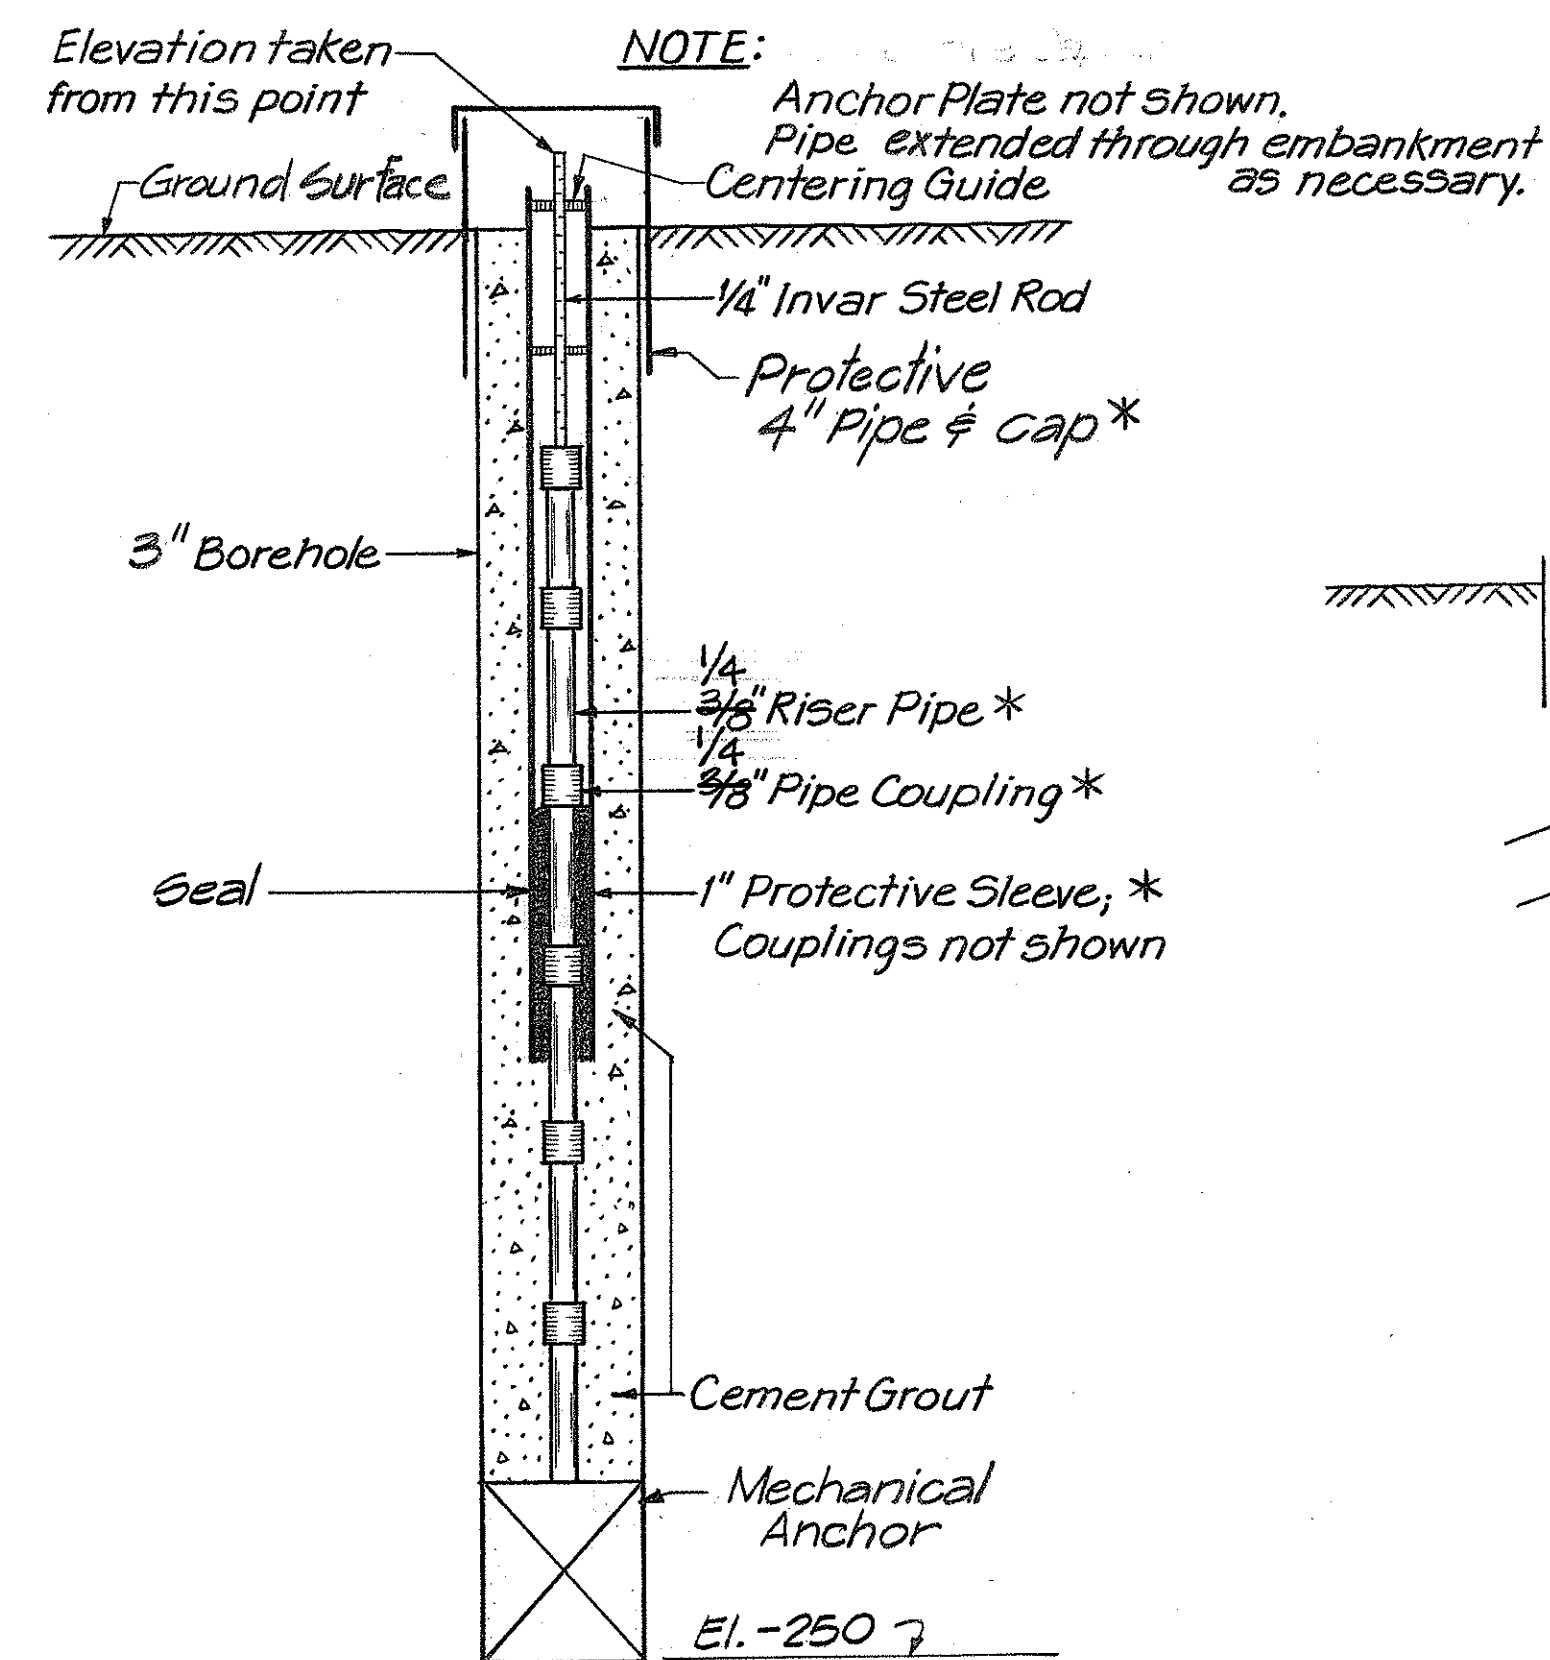


BENCHMARK

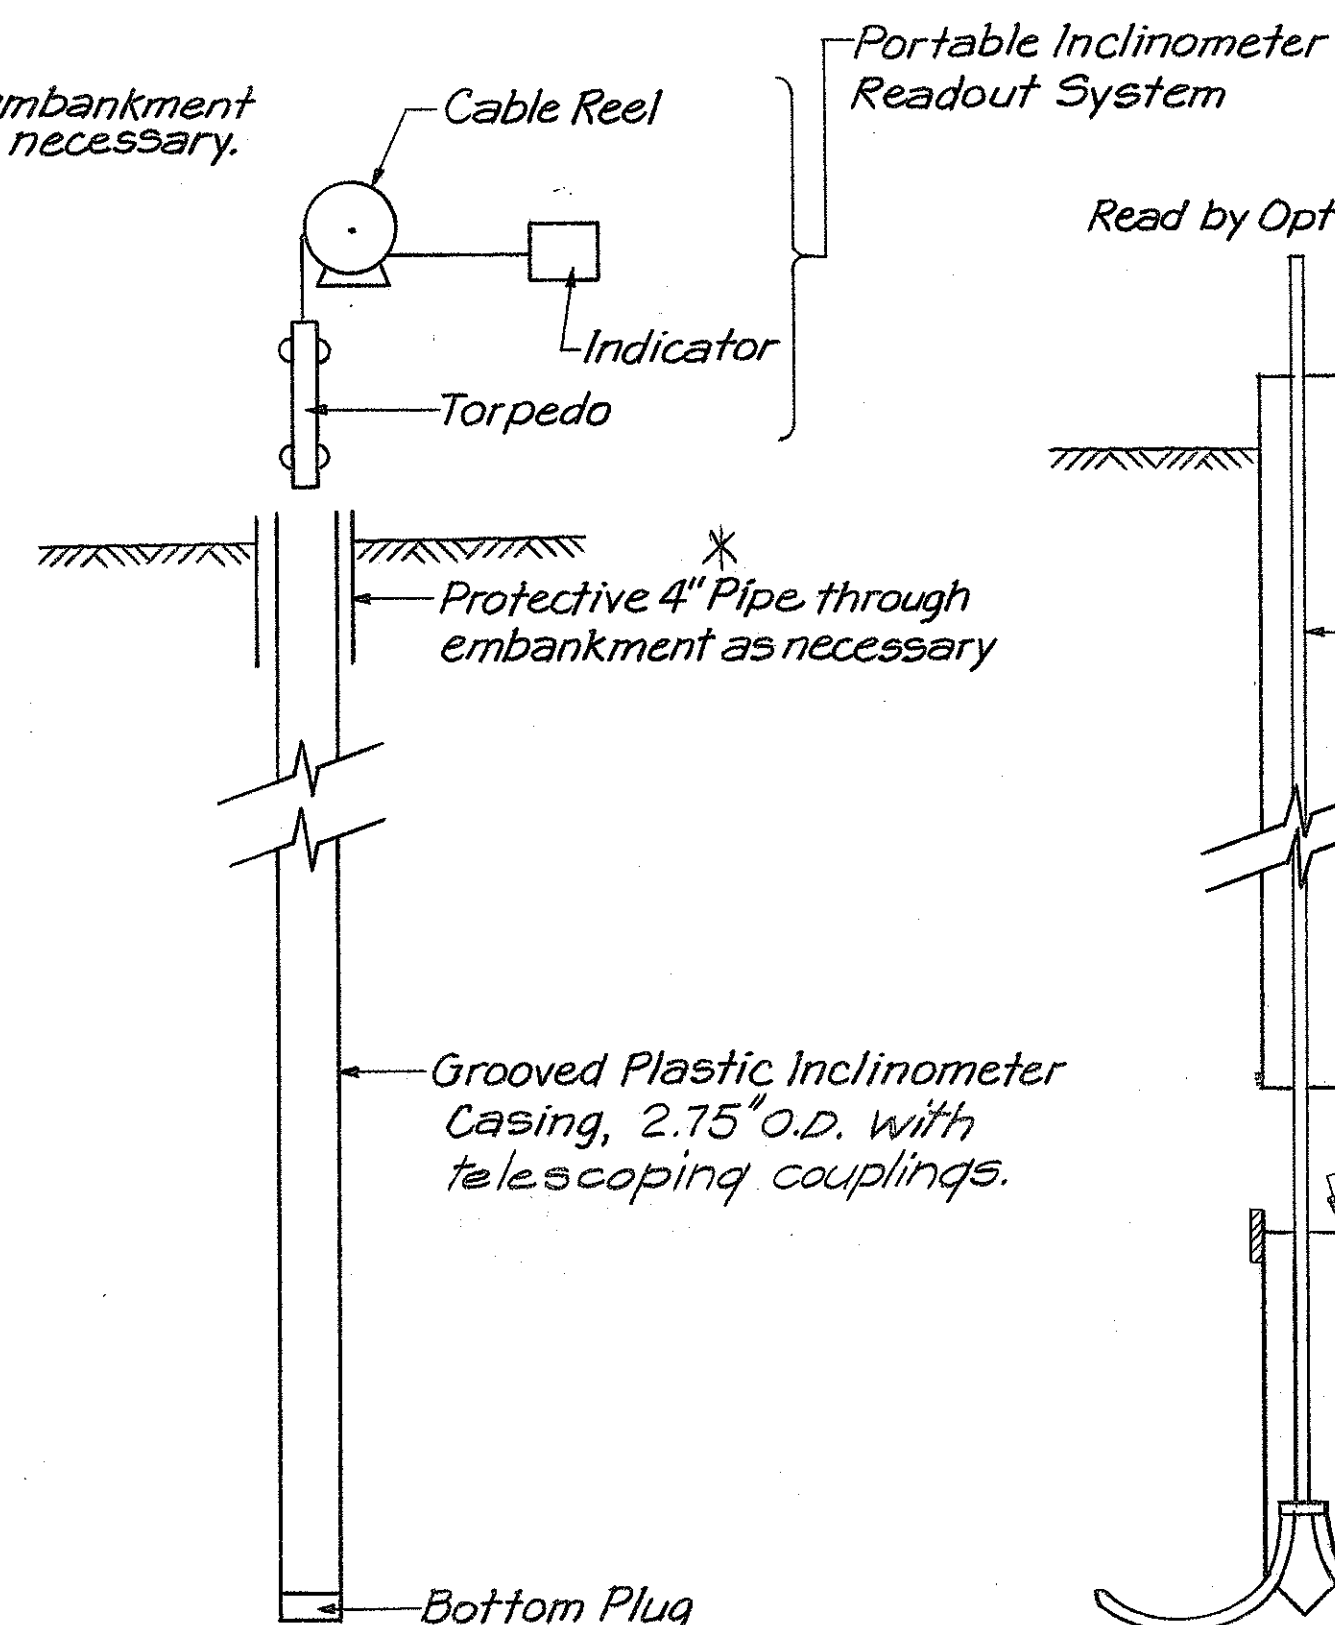


INCLINOMETER IN SOIL

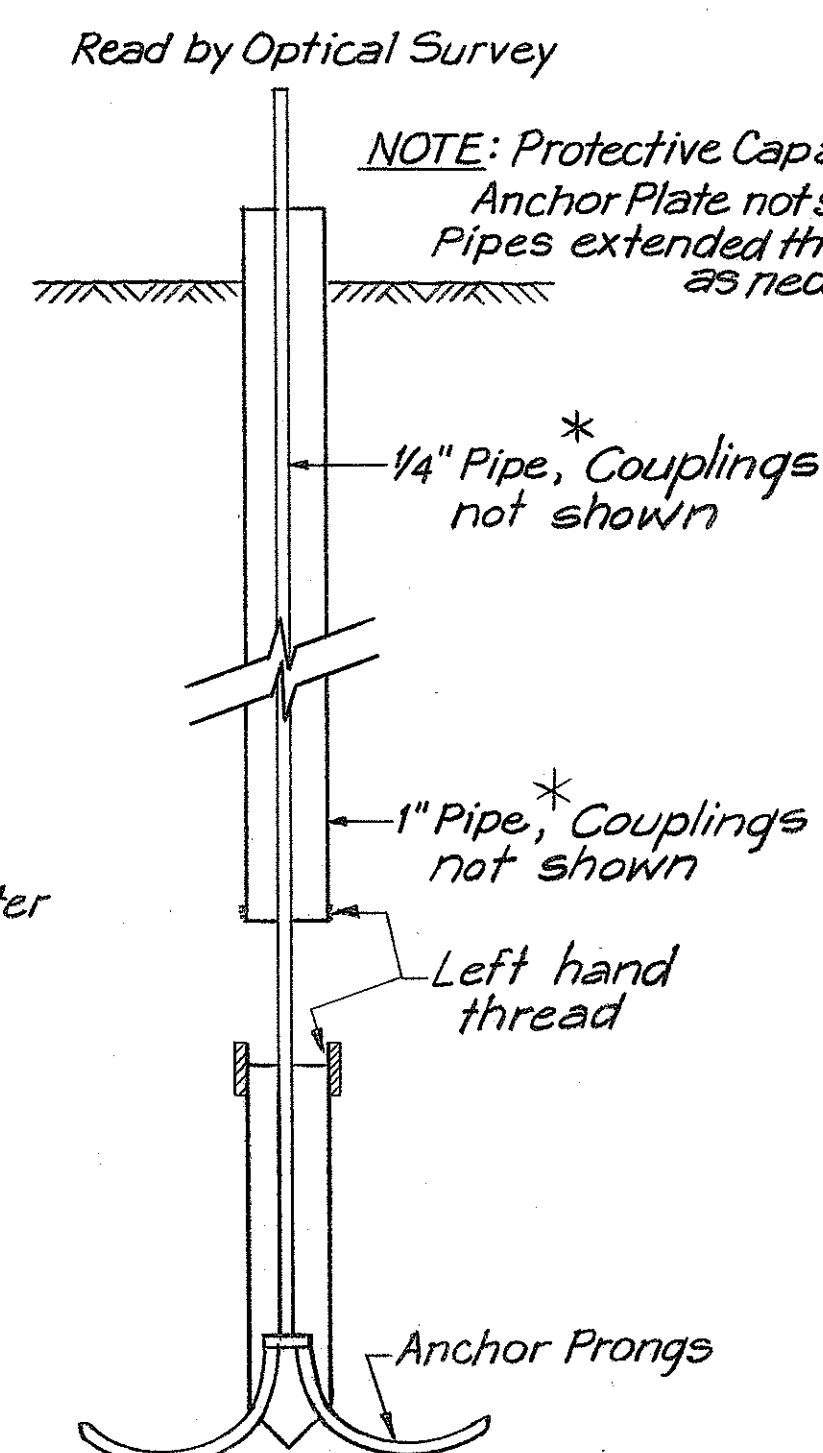


DEEP SETTLEMENT
POINT IN SOIL

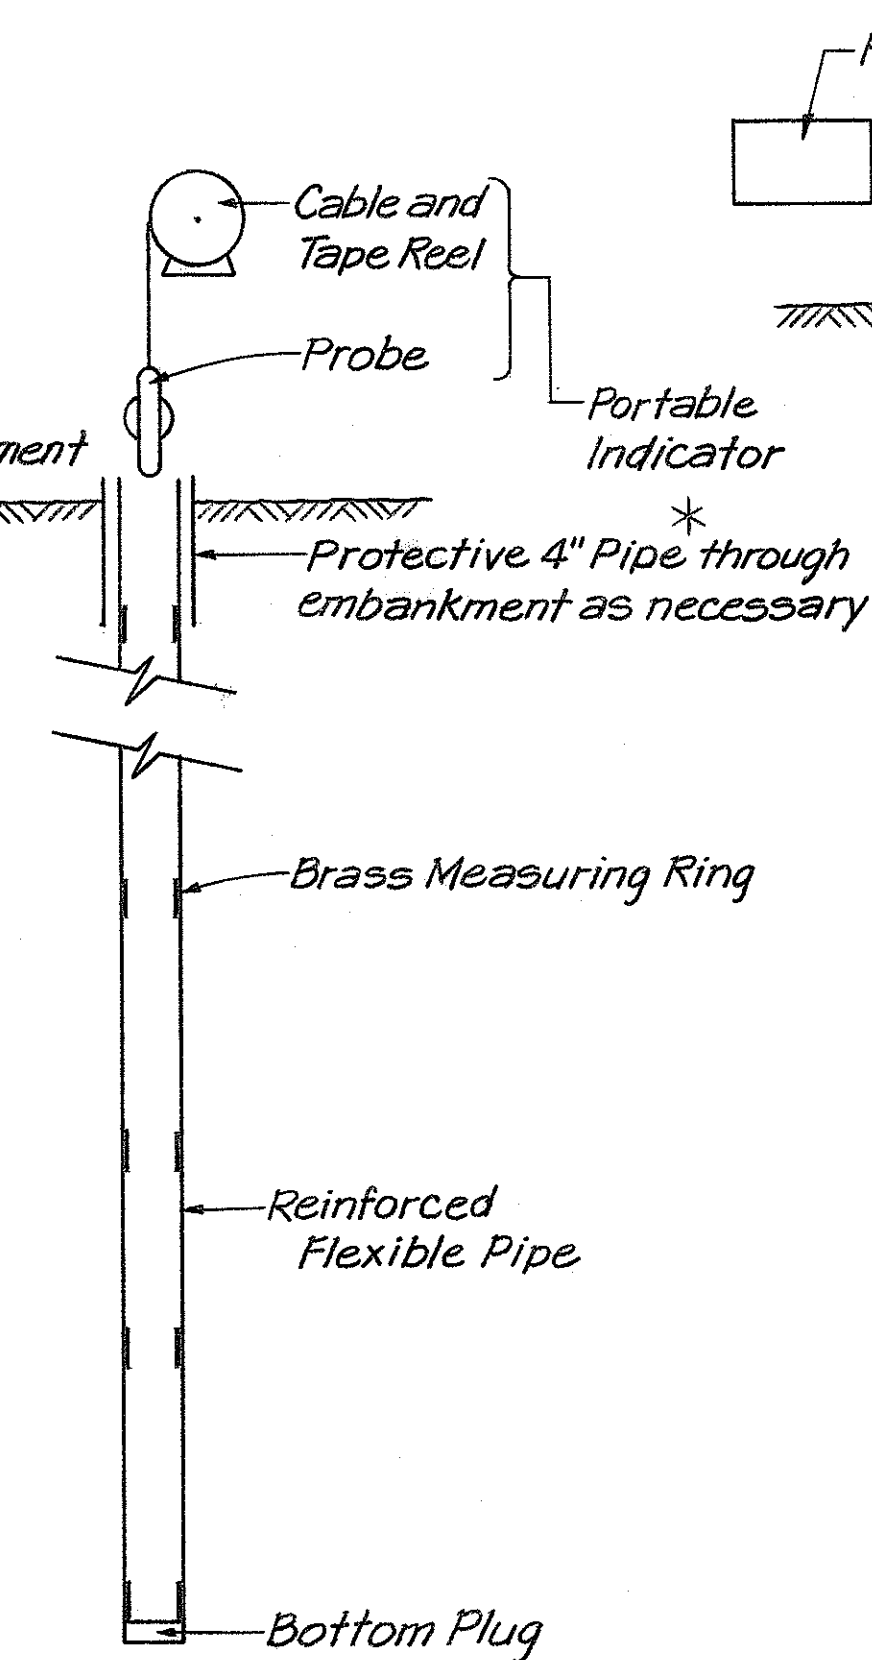


MULTIPLE DEEP SETTLEMENT
POINT (MDSP)

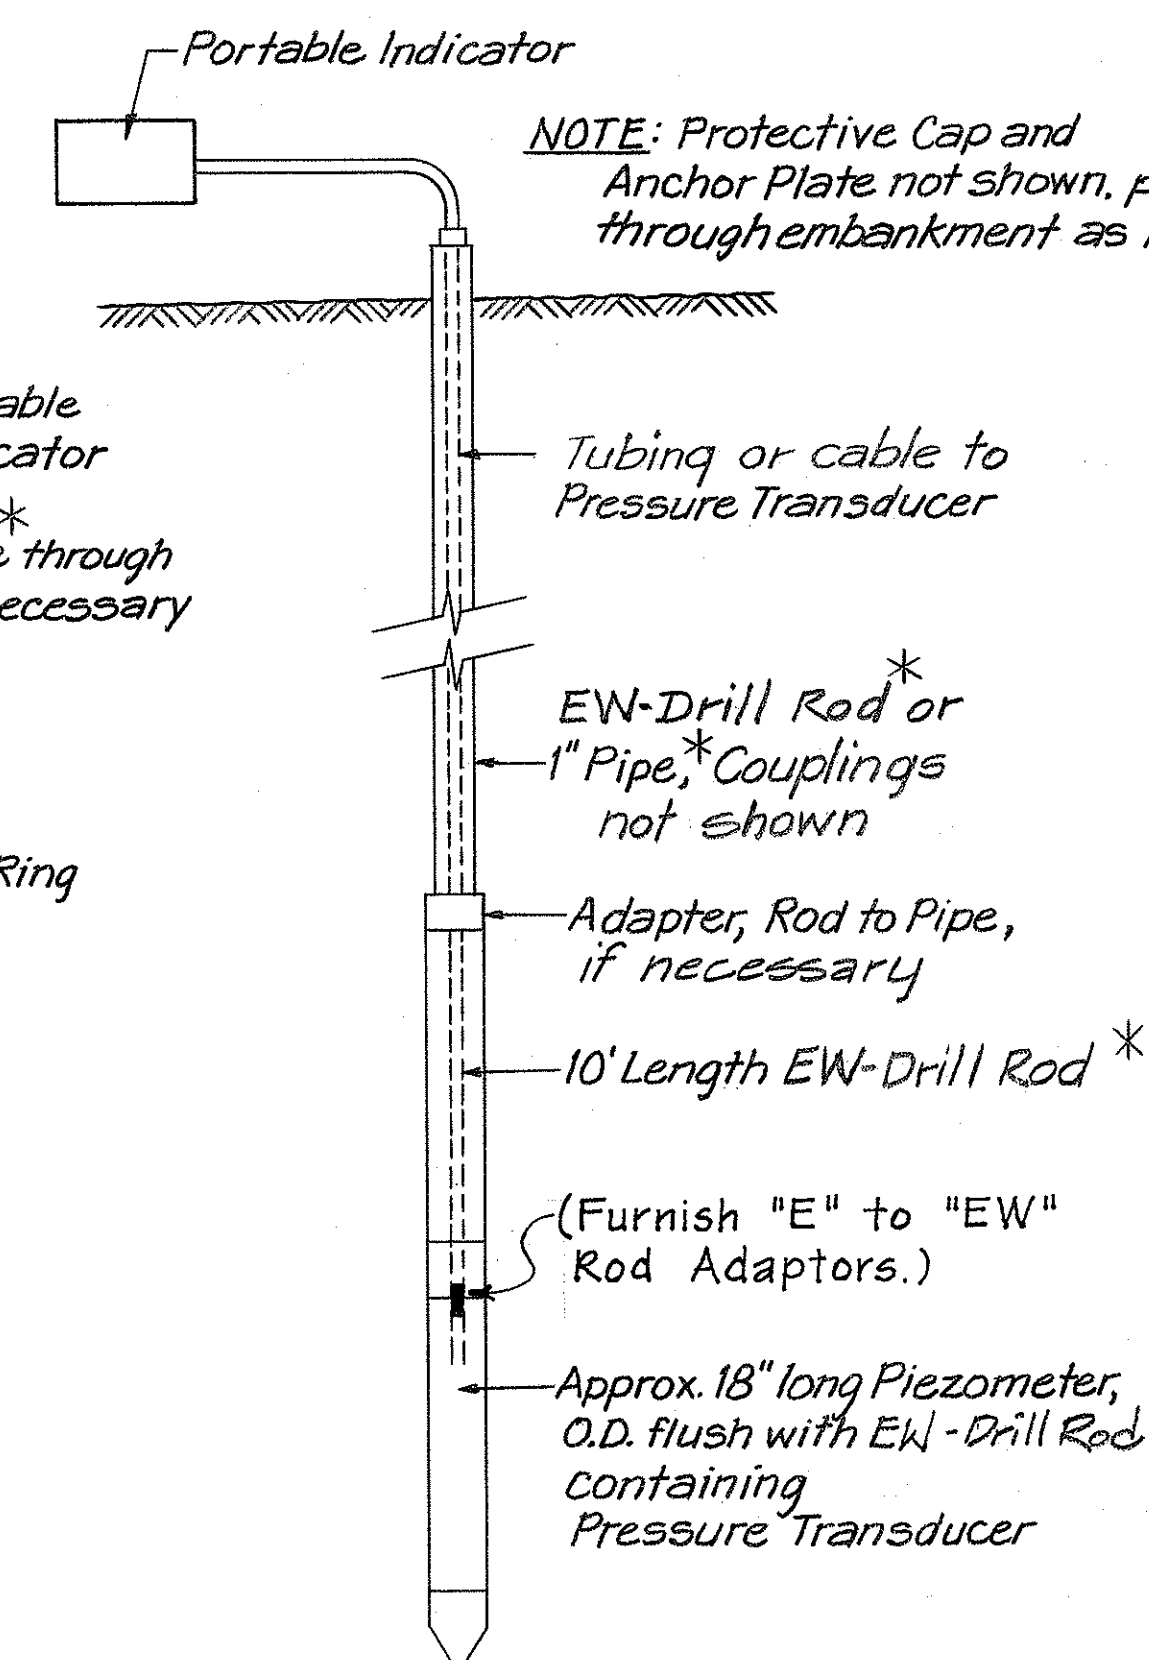


PIEZOMETER
To be salvaged when directed by Engineer.

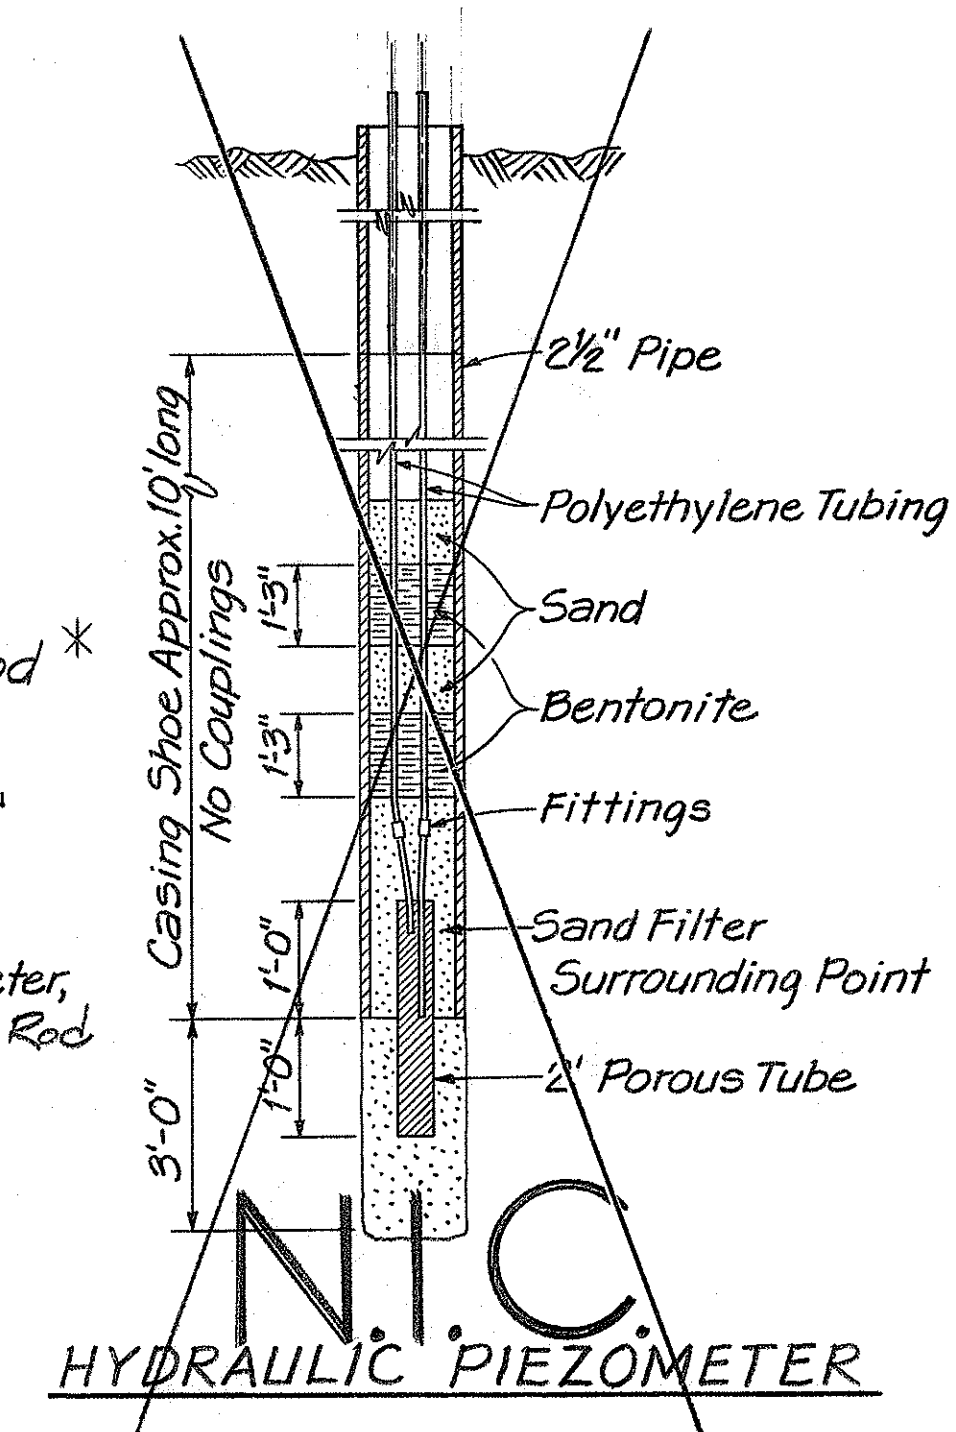


HYDRAULIC PIEZOMETER

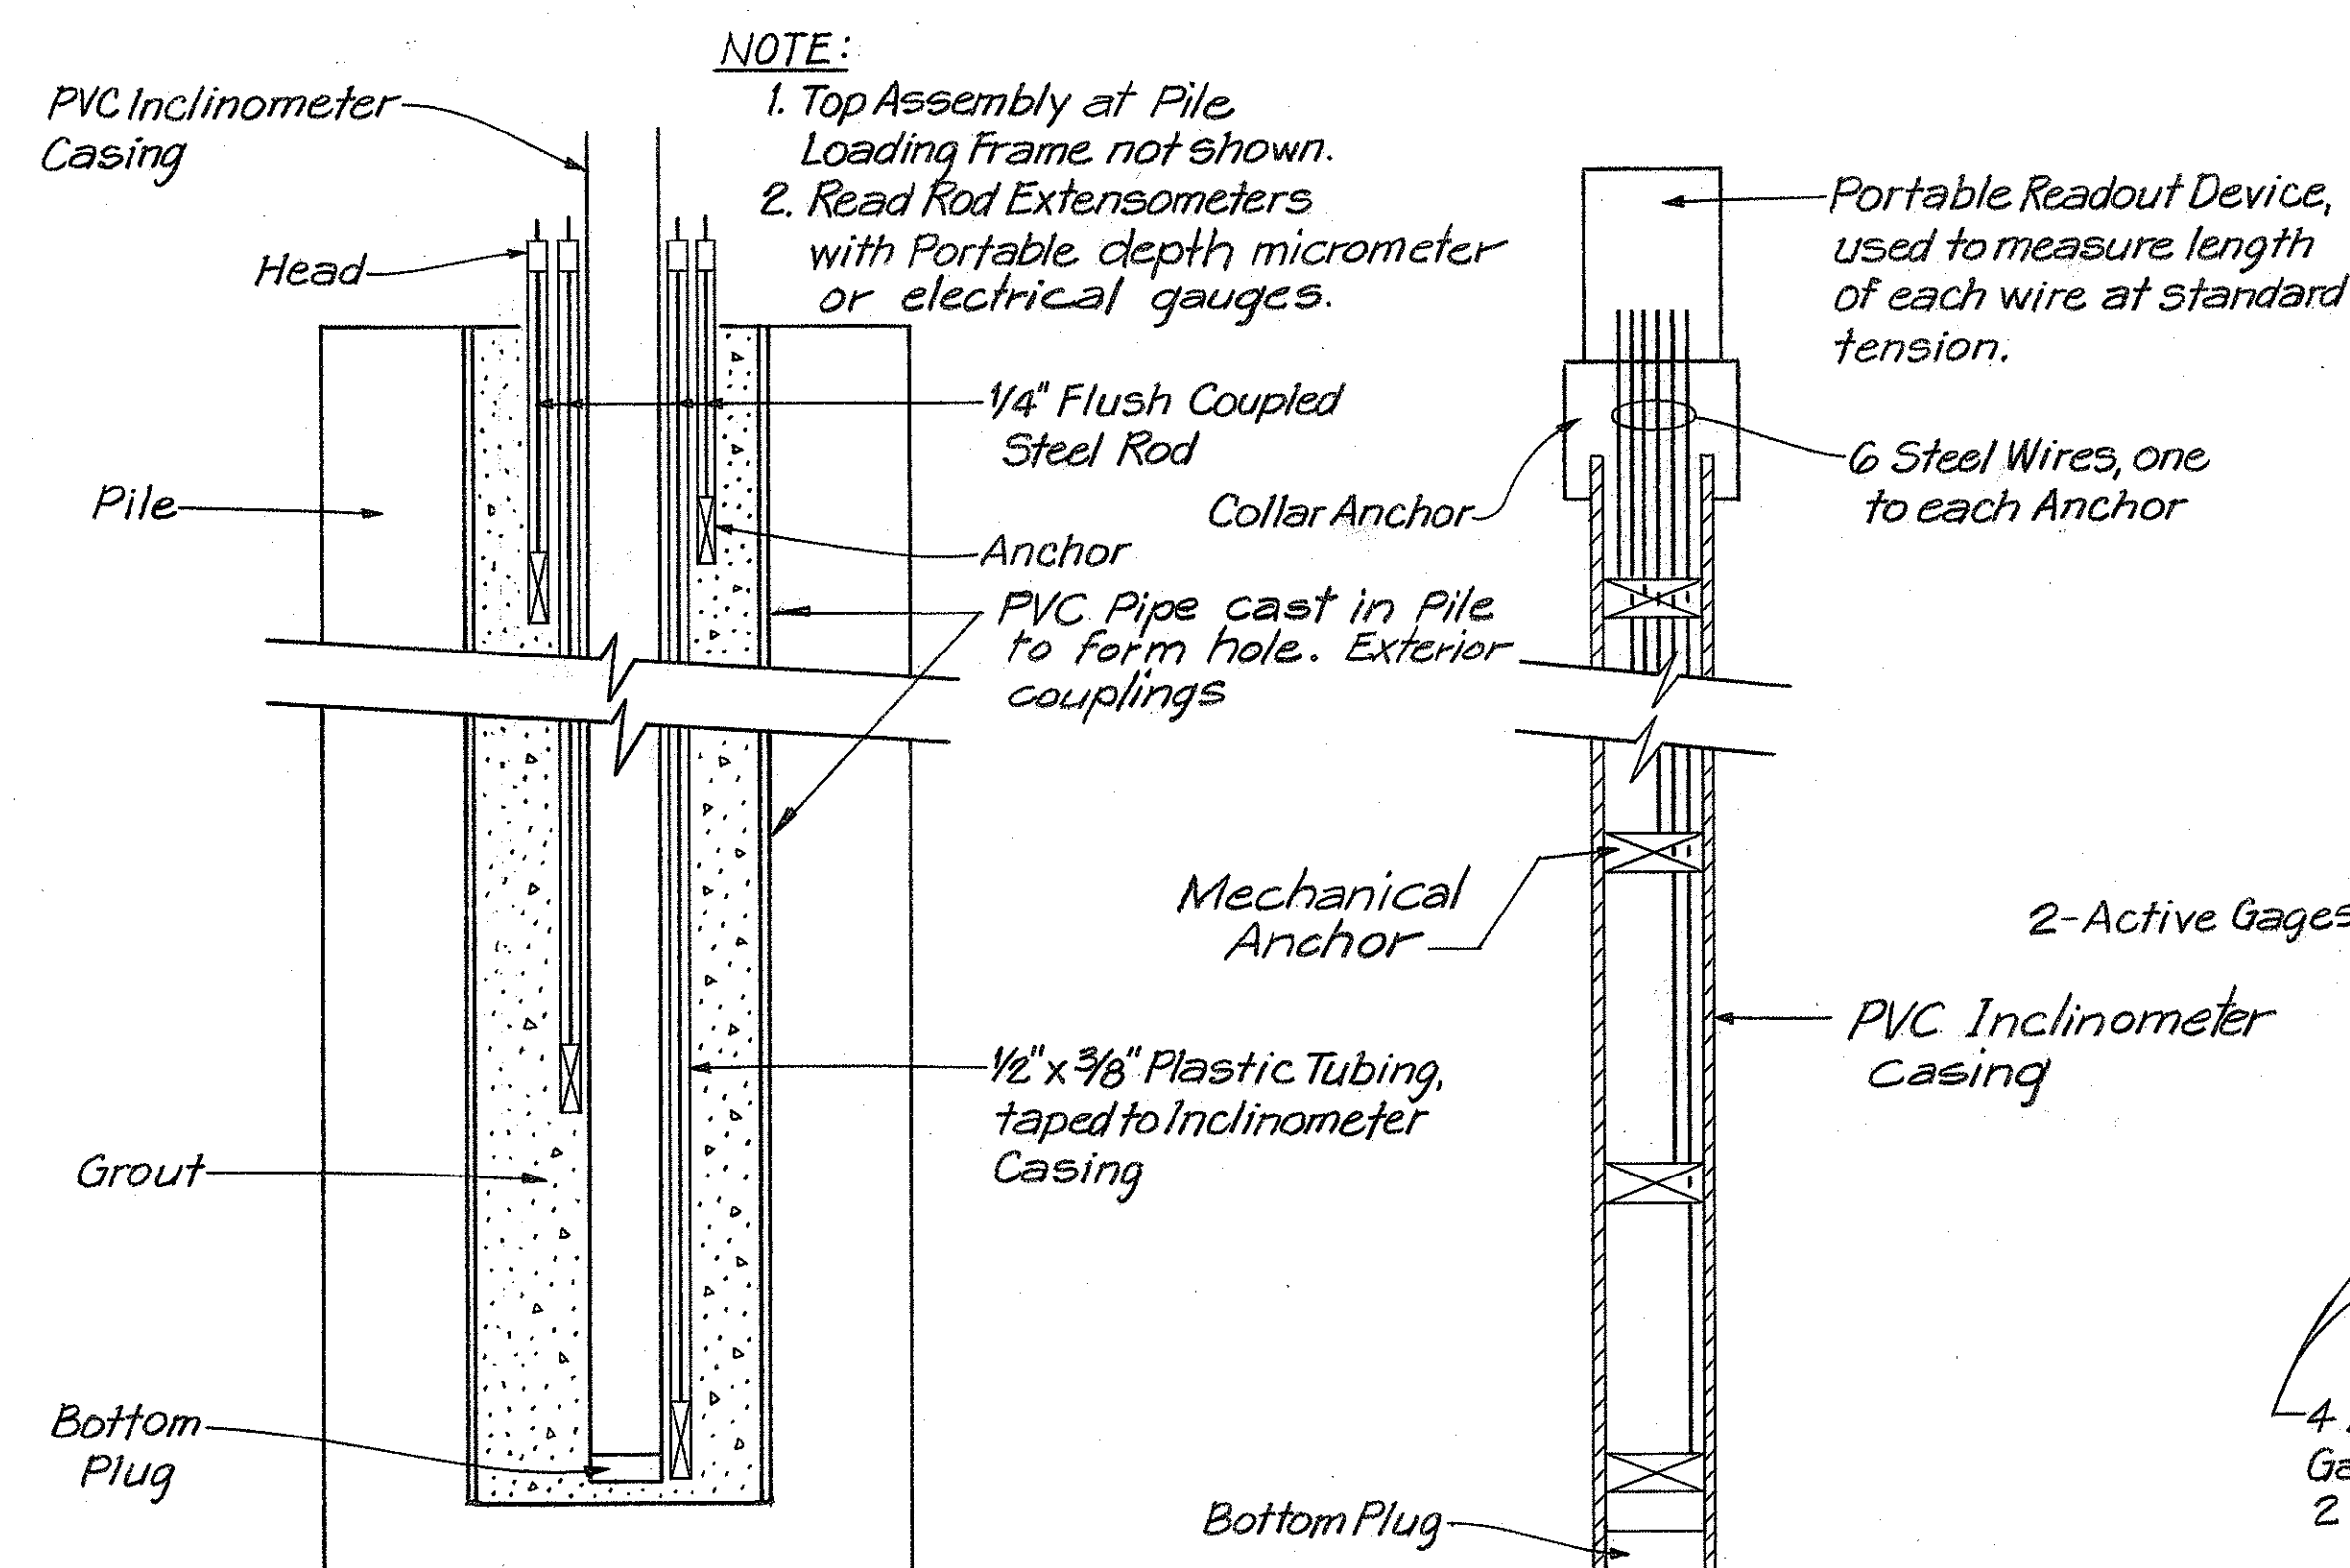


ROD EXTENSOMETER AND INCLINOMETER CASING IN PILE

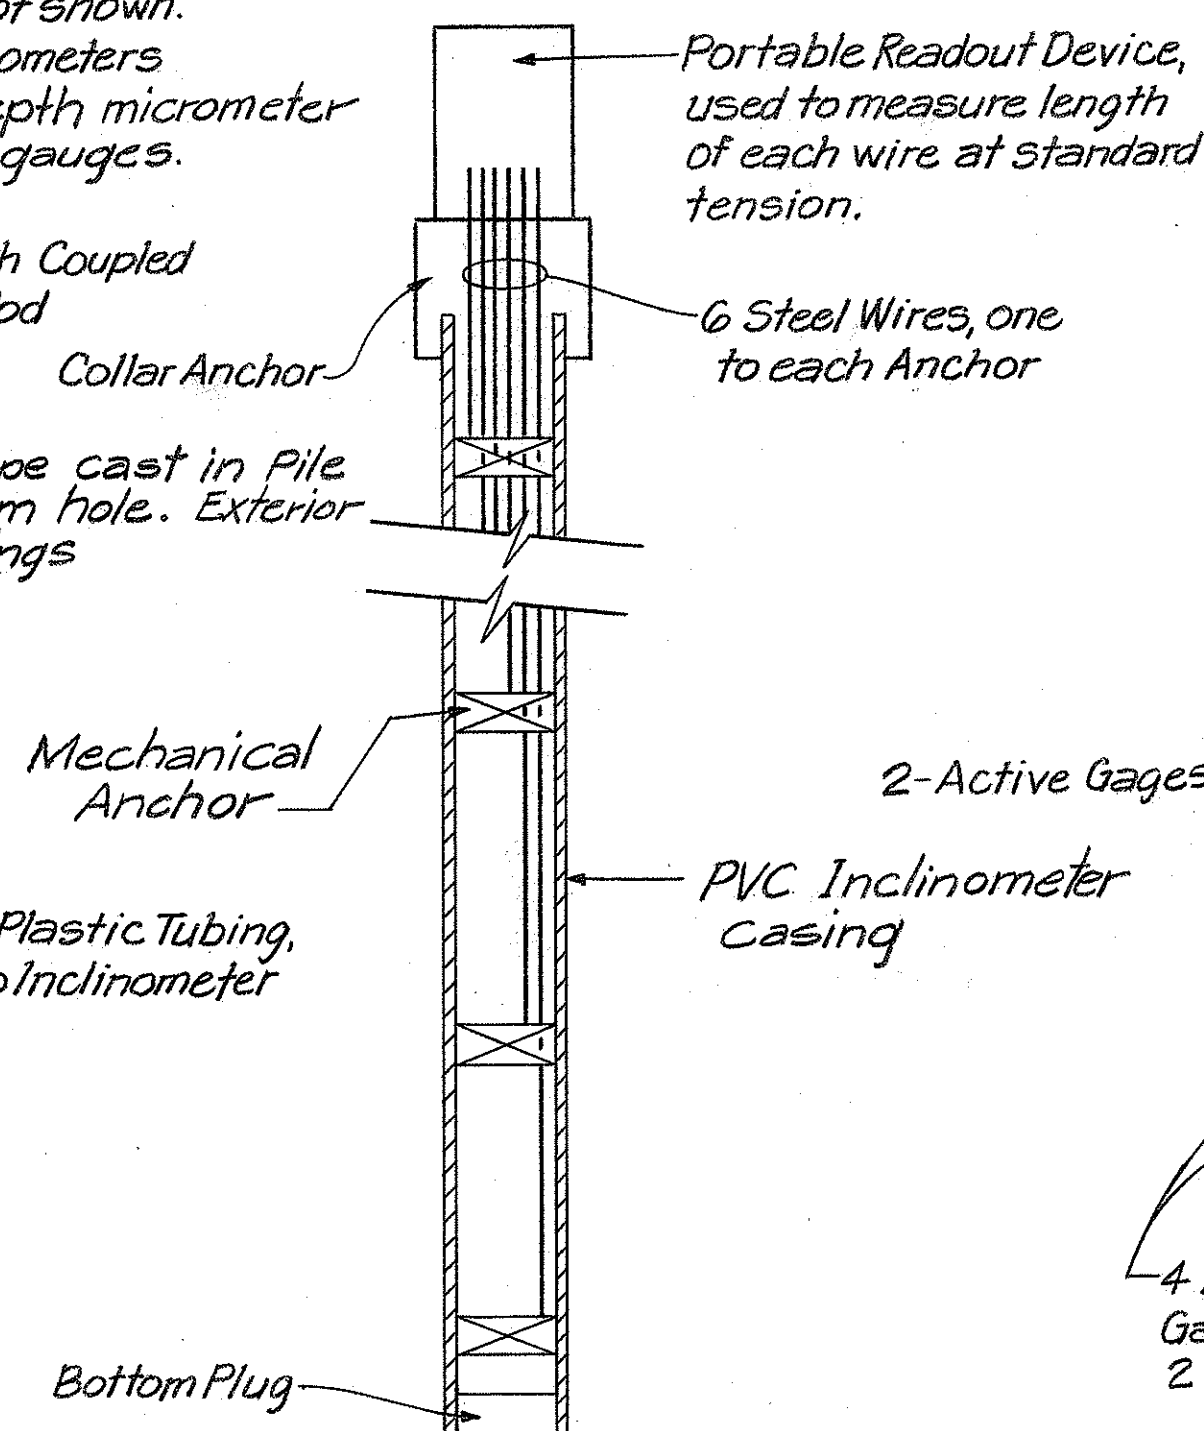

WIRE EXTENSOMETER FOR INSTALLATION IN PILES

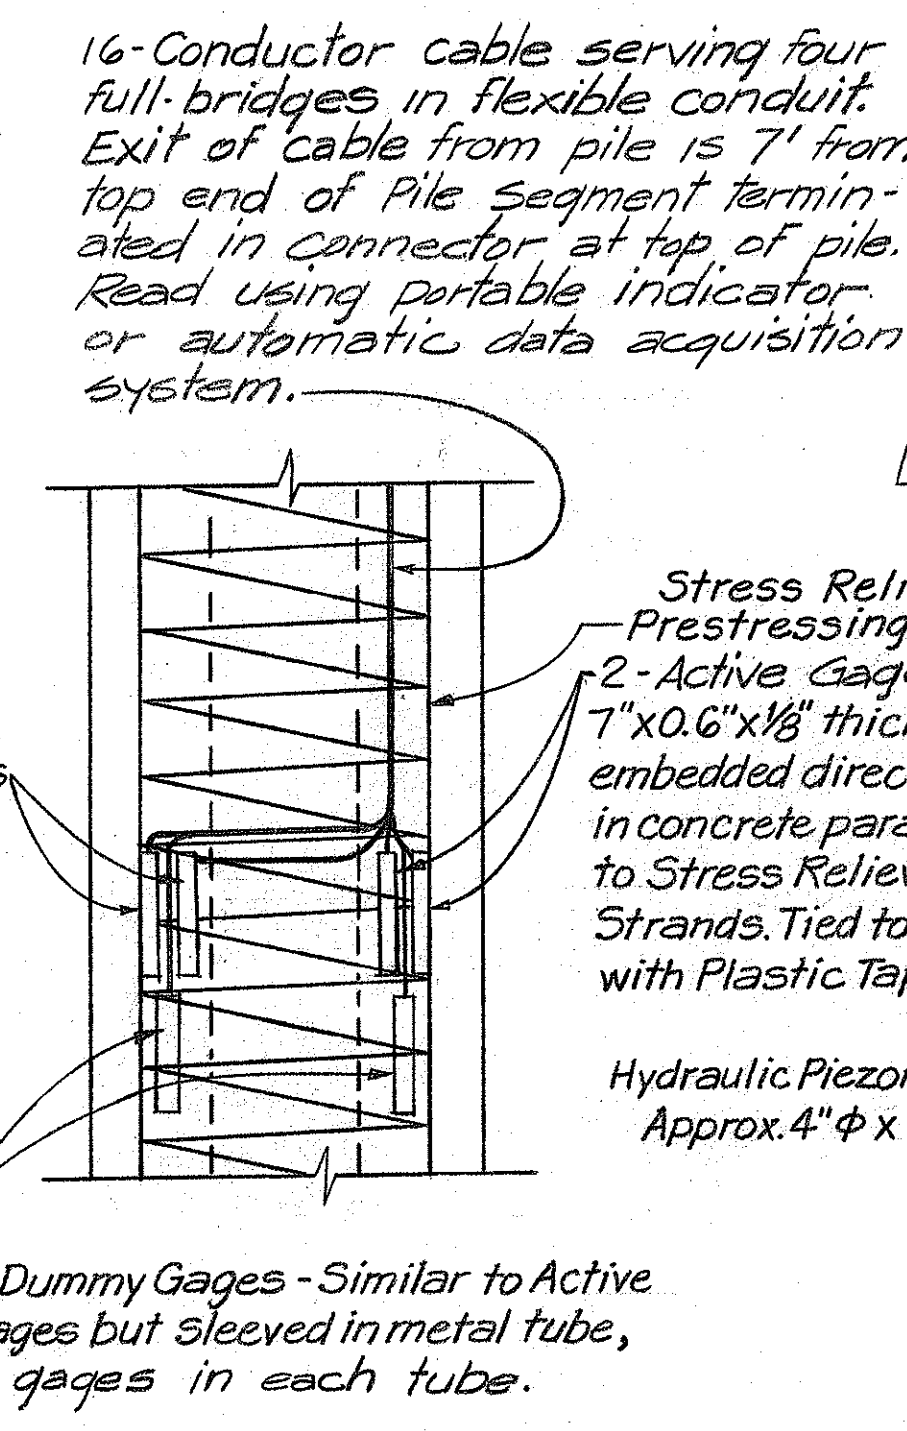


TWO FULL
STRAIN GAGE BRIDGES

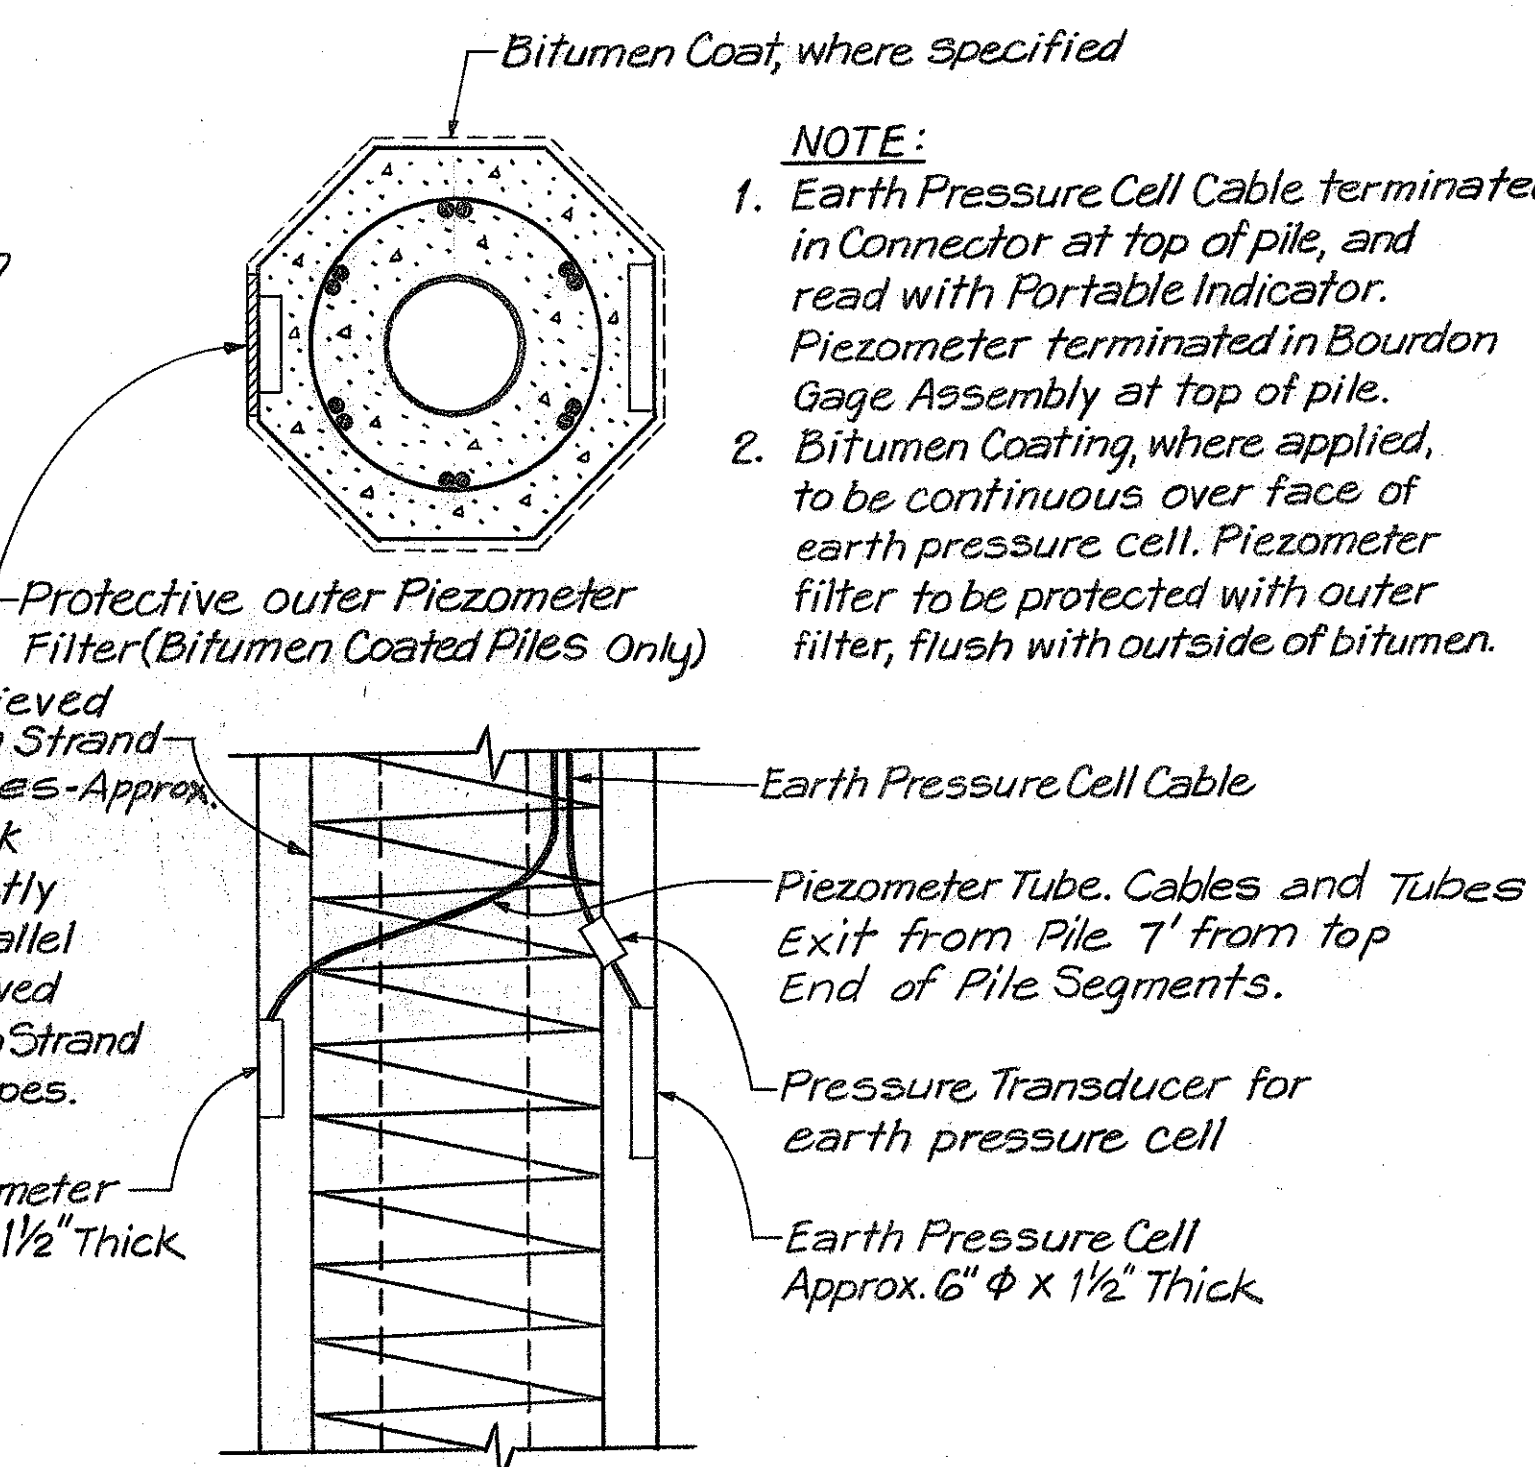

EARTH PRESSURE CELL AND PIEZOMETER IN PILE

* INDICATES MISCELLANEOUS ITEMS TO BE FURNISHED BY THE CONTRACTOR.

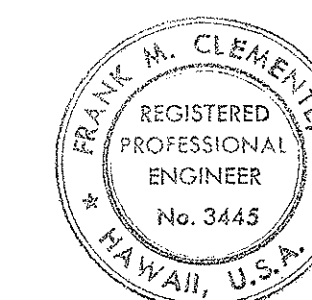

THIS WORK WAS PREPARED BY
ME OR UNDER MY SUPERVISION.
Frank M. Clement

STATE OF HAWAII
DEPARTMENT OF TRANSPORTATION
HIGHWAYS DIVISION
KEEHI INTERCHANGE
FIELD TESTING PROGRAM
INSTRUMENTS SUPPLIED
BY ENGINEER *
INTERSTATE ROUTE H-1
PROJECT NO. I-H-1 (85)
SCALE: NONE DATE: 9/31/76
SHEET NO. 19 OF 35 SHEETS