



INDEX TO DRAWINGS	
SHEET NO.	DESCRIPTION
1	TITLE SHEET
2	STANDARD PLANS SUMMARY
3	KEY PLAN
4	GENERAL NOTES AND LEGEND
5-6	WATER POLLUTION AND EROSION CONTROL NOTES
7	SITE PLAN/TERMINAL IMPACT ATTENUATOR DETAIL PLAN
8	TERMINAL IMPACT ATTENUATOR SYSTEM AND CRASH CUSHION DETAIL
9-12	GUARDRAIL DETAIL AND NOTES
13-23	TRAFFIC CONTROL PLANS
24-25	PORTABLE CONCRETE BARRIERS
26	BORING LOG NOTES AND LEGEND
27-29	BORING LOGS
30-51	STRUCTURAL DRAWINGS
52-61	ELECTRICAL DRAWINGS



STATE OF HAWAII
DEPARTMENT OF TRANSPORTATION
HIGHWAYS DIVISION
HONOLULU, HAWAII
"AS-BUILT"
PLANS FOR
INTERSTATE ROUTE H-1
SEISMIC RETROFIT
PALI INTERCHANGE AND NUUANU SEPARATION
FEDERAL AID PROJECT NO. BR-H1-1 (249)
DISTRICT OF HONOLULU
ISLAND OF OAHU

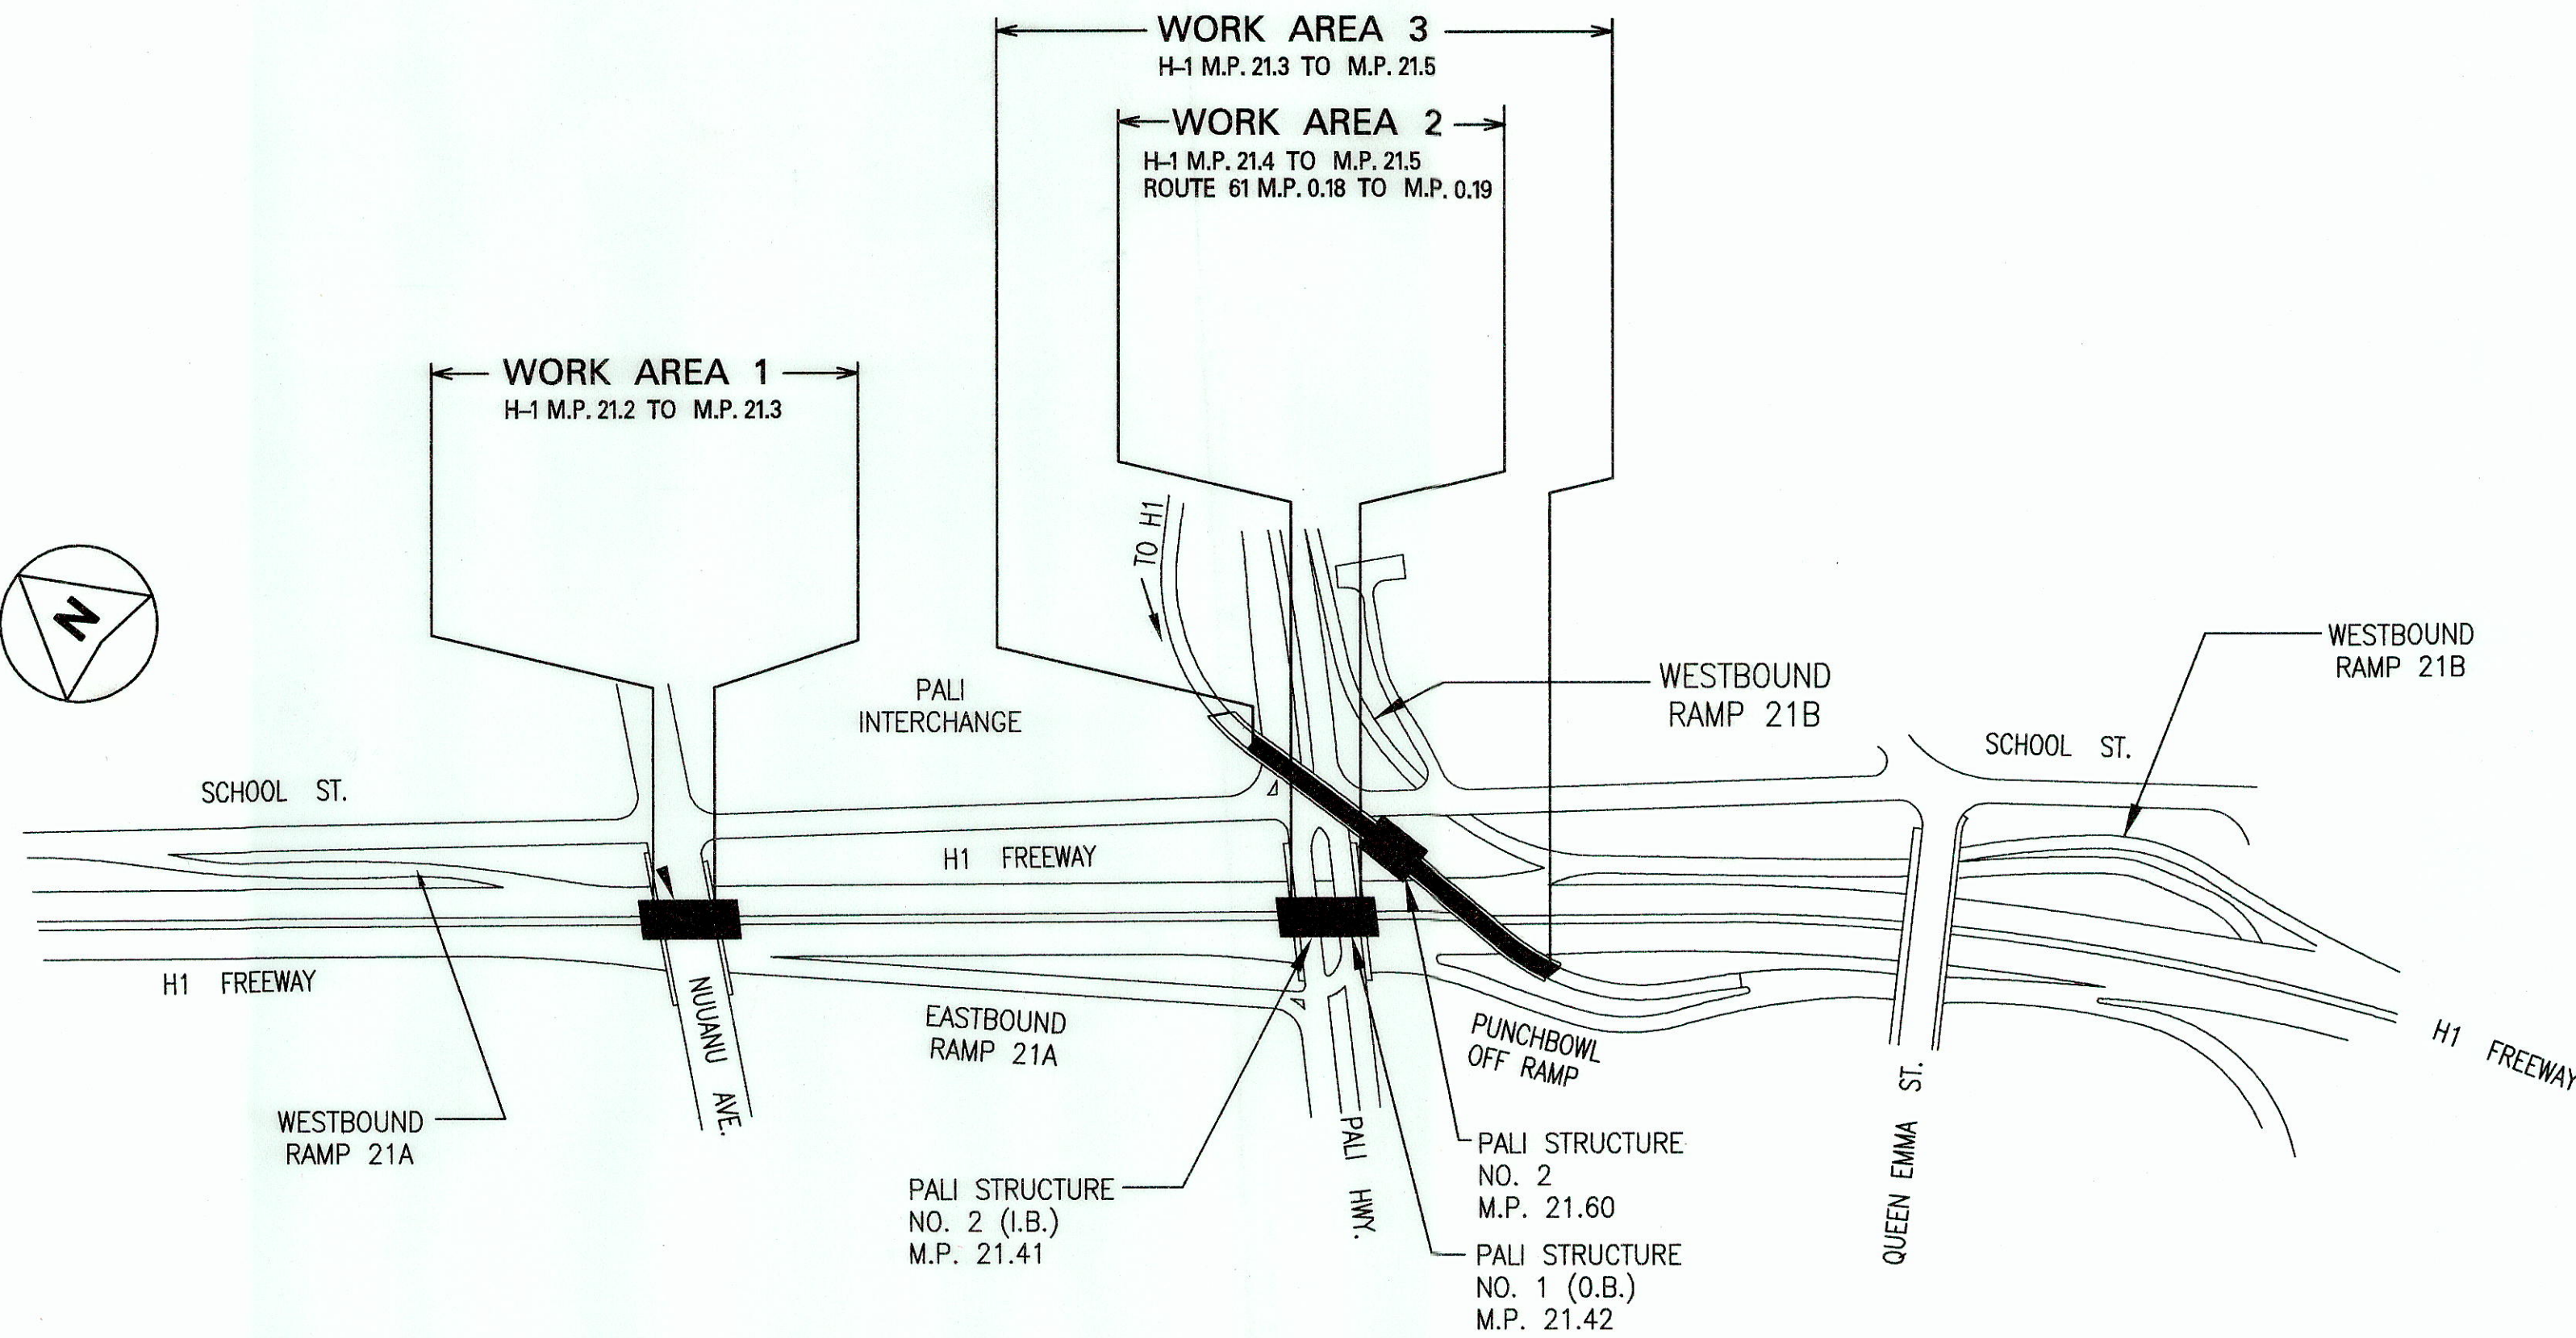

LAYOUT PLAN

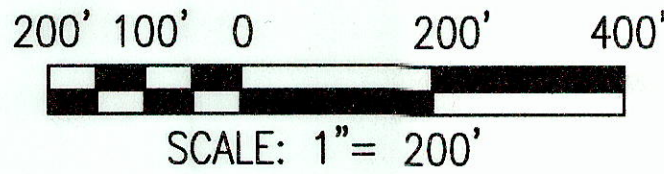

FED. ROAD DIST. NO.	STATE	FED. AID PROJ. NO.	FISCAL YEAR	SHEET NO.	TOTAL SHEETS
HAWAII	HAW.	BR-H1-1 (249)	2010	1	61

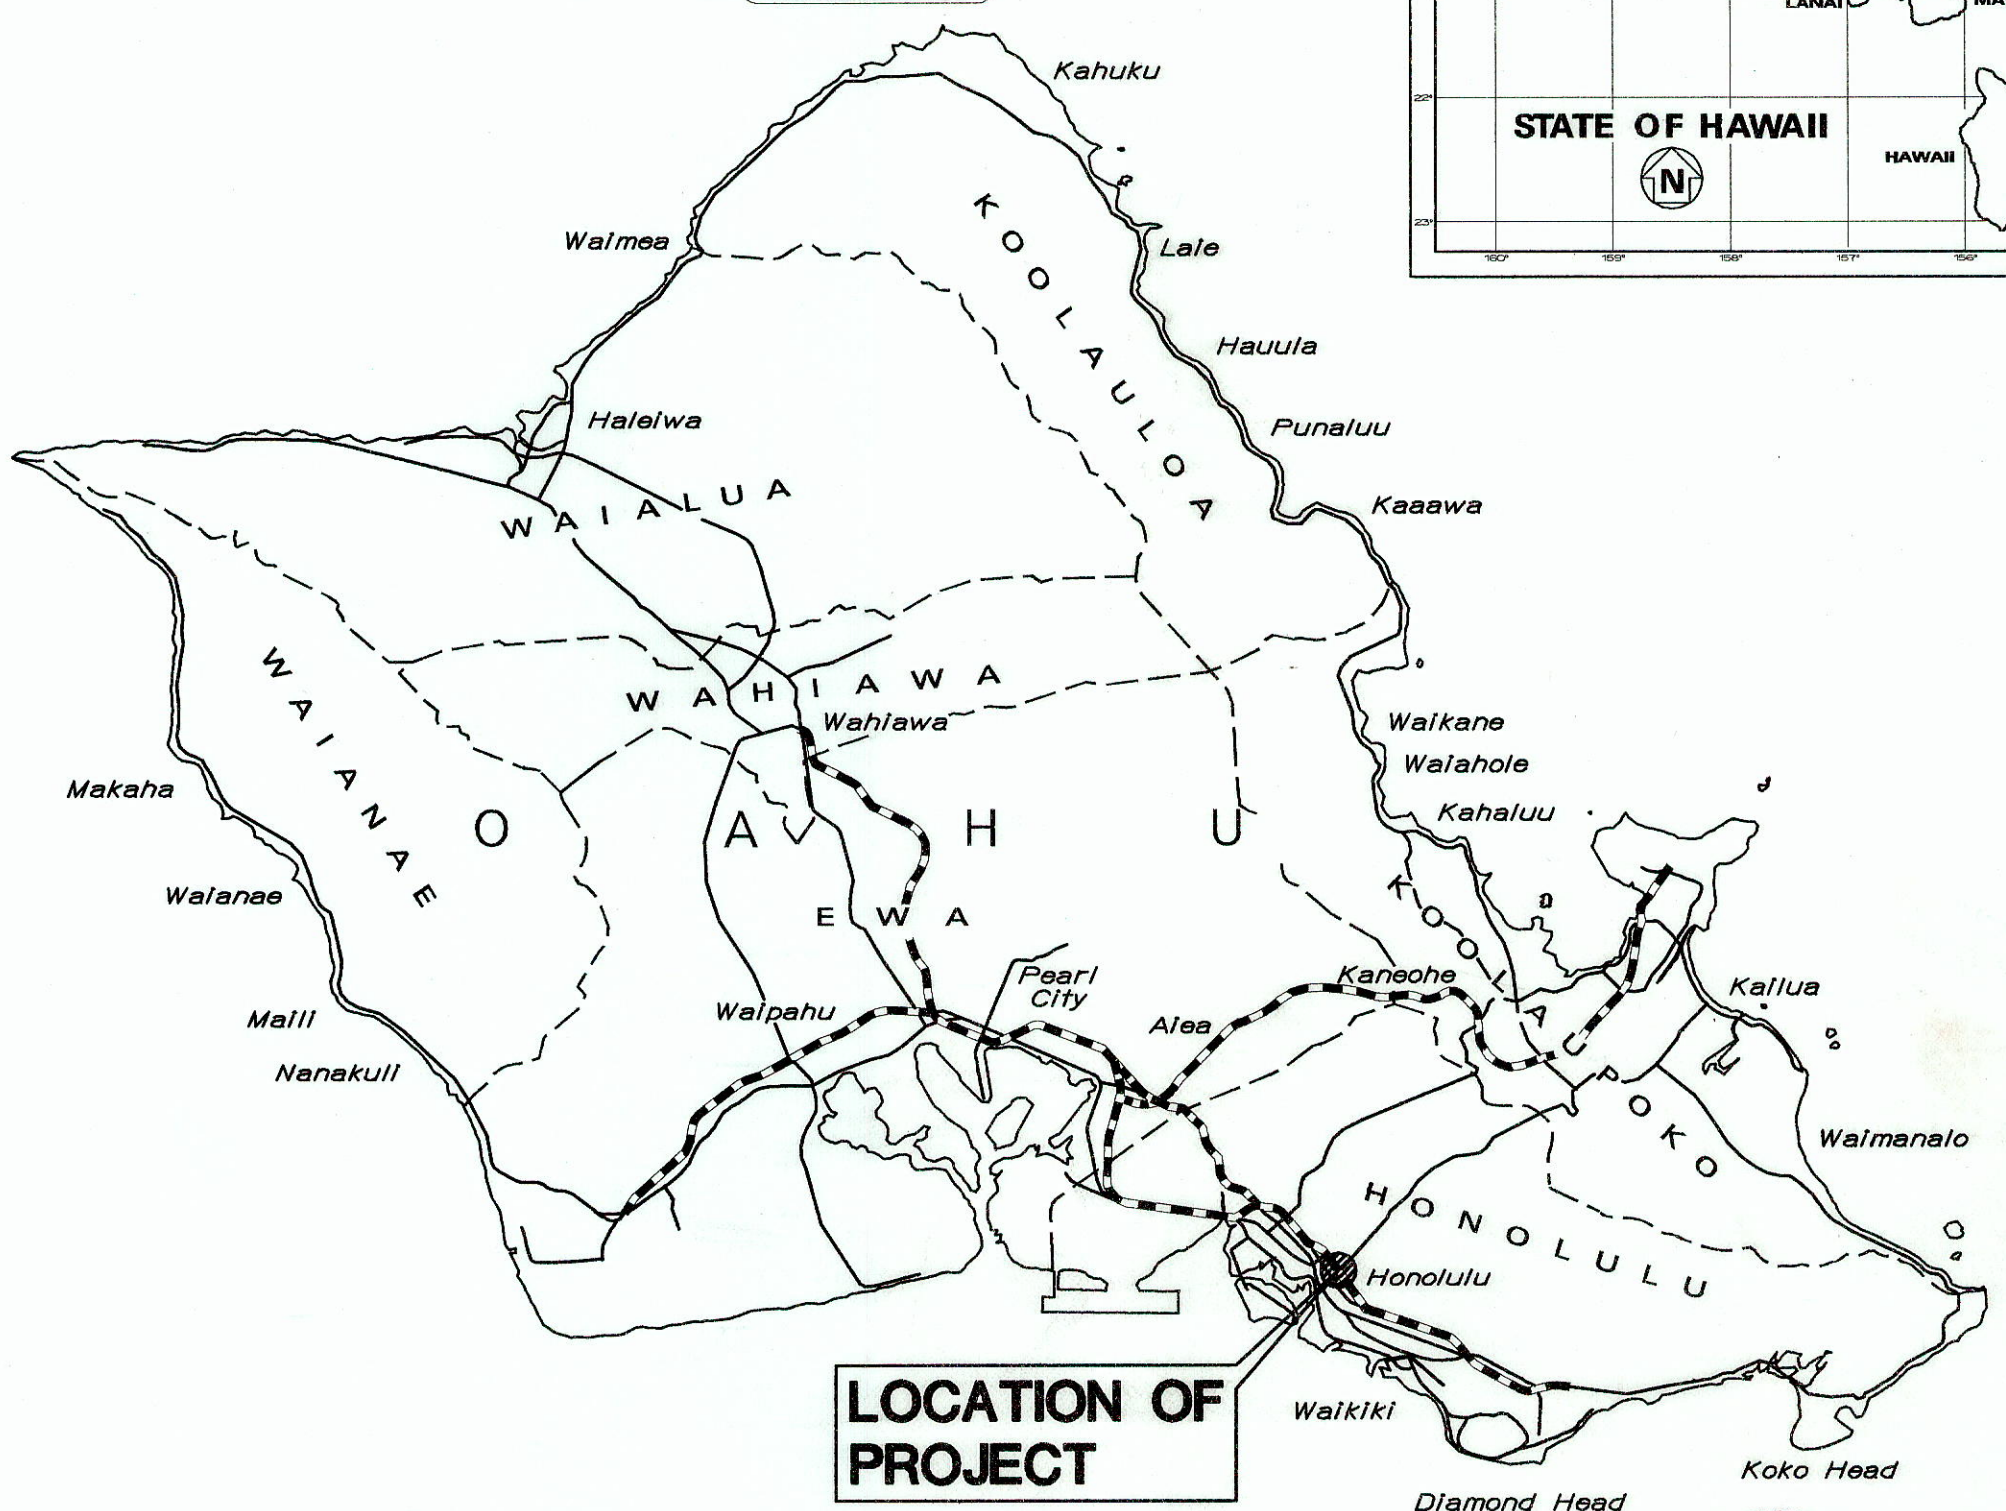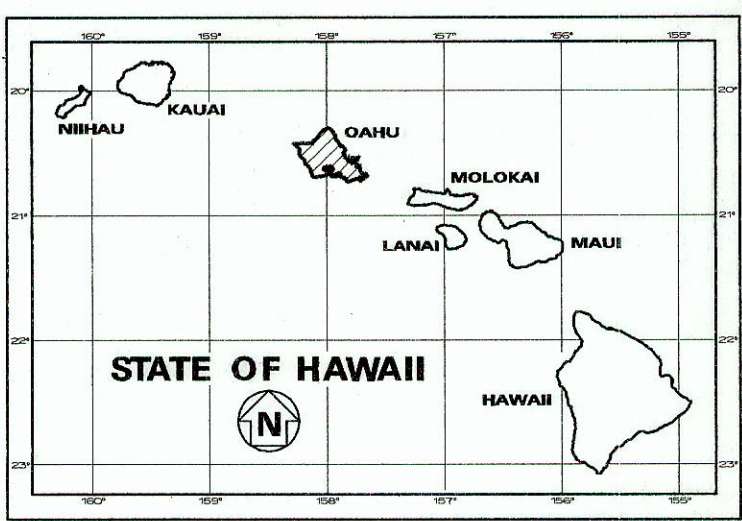

LOCATION OF PROJECT

----- FEDERAL AID INTERSTATE PROJECTS PREVIOUSLY CONSTRUCTED OR UNDER CONSTRUCTION
WORK AREA 1 H-1 MILE POST 21.2 TO MILE POST 21.3
WORK AREA 2 H-1 MILE POST 21.4 TO MILE POST 21.5 AND ROUTE 61 MILE POST 0.18 TO MILE POST 0.19
WORK AREA 3 H-1 MILE POST 21.3 TO MILE POST 21.5

DESIGN DESIGNATION

SECTION DATA	WORK AREA 1	WORK AREA 2	WORK AREA 3
ADT (2008)	18,700	28,600	23,300
ADT (2028)	22,300	34,100	26,200
DHV	2,010	2,900	2,230
D	80/20	80/20	100/0
T	N/A	1.5	1.0
T24	N/A	1.5	2.0
V	40 M.P.H	40 M.P.H	25 M.P.H

CHANGES MADE DURING CONSTRUCTION HAVE BEEN INCORPORATED ON THESE PLANS EXCEPT CHANGES IN THE ORIGINAL THEORETICAL QUANTITIES. FOR ACTUAL QUANTITIES, REFER TO PROJECT LEDGER AND/OR COMPUTATION BOOK.
RESIDENT ENGINEER
DATE 7/21/15

DEPARTMENT OF TRANSPORTATION
STATE OF HAWAII
APPROVED: [Signature]
DIR. OF TRANSPORTATION
DATE 10/14/10

MITSUNAGA & ASSOC.
DESIGNED BY
HWY-DD
MANAGED BY
692-7570
PHONE
2/2010
DATE