

DETAILED INDEX

FED. ROAD DIST. NO.	STATE	FED. AID PROJ. NO.	FISCAL YEAR	SHEET NO.	TOTAL SHEETS
HAWAII	HAW.	BR-HI-1 (263)	2012	2	46

DWG NO.	DESCRIPTION	DWG NO.	DESCRIPTION	DWG NO.	DESCRIPTION	DWG NO.	DESCRIPTION
1	Title Sheet	46	Pearl City Viaduct Deck Repair - Plan				
2	Detailed Index						
3	Notes						
4	Notes						
5	Water Pollution and Erosion Control Notes						
6	Water Pollution/Erosion Control and Traffic Notes						
7	Erosion Control Plan						
8	Erosion Control Plan						
9	Erosion Control Plan						
10	Erosion Control Plan						
11	Erosion Control Plan						
12	Erosion Control Plan						
13	Erosion Control Plan						
14	Erosion Control Details						
15	Traffic Control Notes and Details						
16	Traffic Control Details						
17	Traffic Control Plan						
18	Traffic Control Plan						
36	Structural Notes, Estimated Quantities, Index To Drawings, and Abbreviations						
37	Pearl City Viaduct Sections						
38	Typical Details						
39	Typical Details						
40	Details						
41	Typical Details						
42	Key Plan						
43	Pearl City Viaduct Deck Repair - Plan						
44	Pearl City Viaduct Deck Repair - Plan						
45	Pearl City Viaduct Deck Repair - Plan						

LEGEND FOR
AS-BUILT POSTINGS

~~~~~


+00.00=

Roadway

Squiggly line for  
as-built deletion

Double line for  
as-built deletion

Text for as-built posting

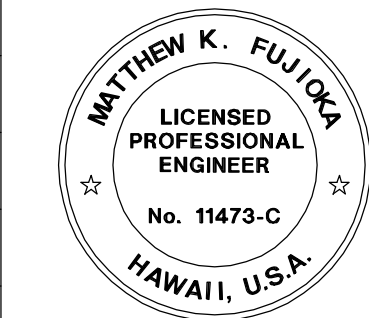

THIS WORK WAS PREPARED BY  
ME OR UNDER MY SUPERVISION.

*Matthew K. Fujioka*  
SIGNATURE  
4/30/18  
EXPIRATION DATE  
OF THE LICENSE

STATE OF HAWAII  
DEPARTMENT OF TRANSPORTATION  
HIGHWAYS DIVISION

DETAILED INDEX

INTERSTATE ROUTE H-1  
PEARL CITY AND WAIMMALU  
VIADUCT IMPROVEMENTS

FEDERAL AID PROJECT NO. BR-HI-1 (263)

Scale: As Noted  
Date: July 2016

QC/QA REVIEW 100% DATE AUGUST 8, 2012

☐ BY

☐ BY

☐ BY

☒ BY

SURVEY PLOTTED BY DATE

ORIGINAL PLAN DRAWN BY

NOTE BOOK DESIGNED BY

QUANTITIES BY CHECKED BY

No.