


FED. ROAD DIST. NO.	STATE	FED. AID PROJ. NO.	FISCAL YEAR	SHEET NO.	TOTAL SHEETS
HAWAII	HAW.	BR-HI-1 (263)	2012	42	46

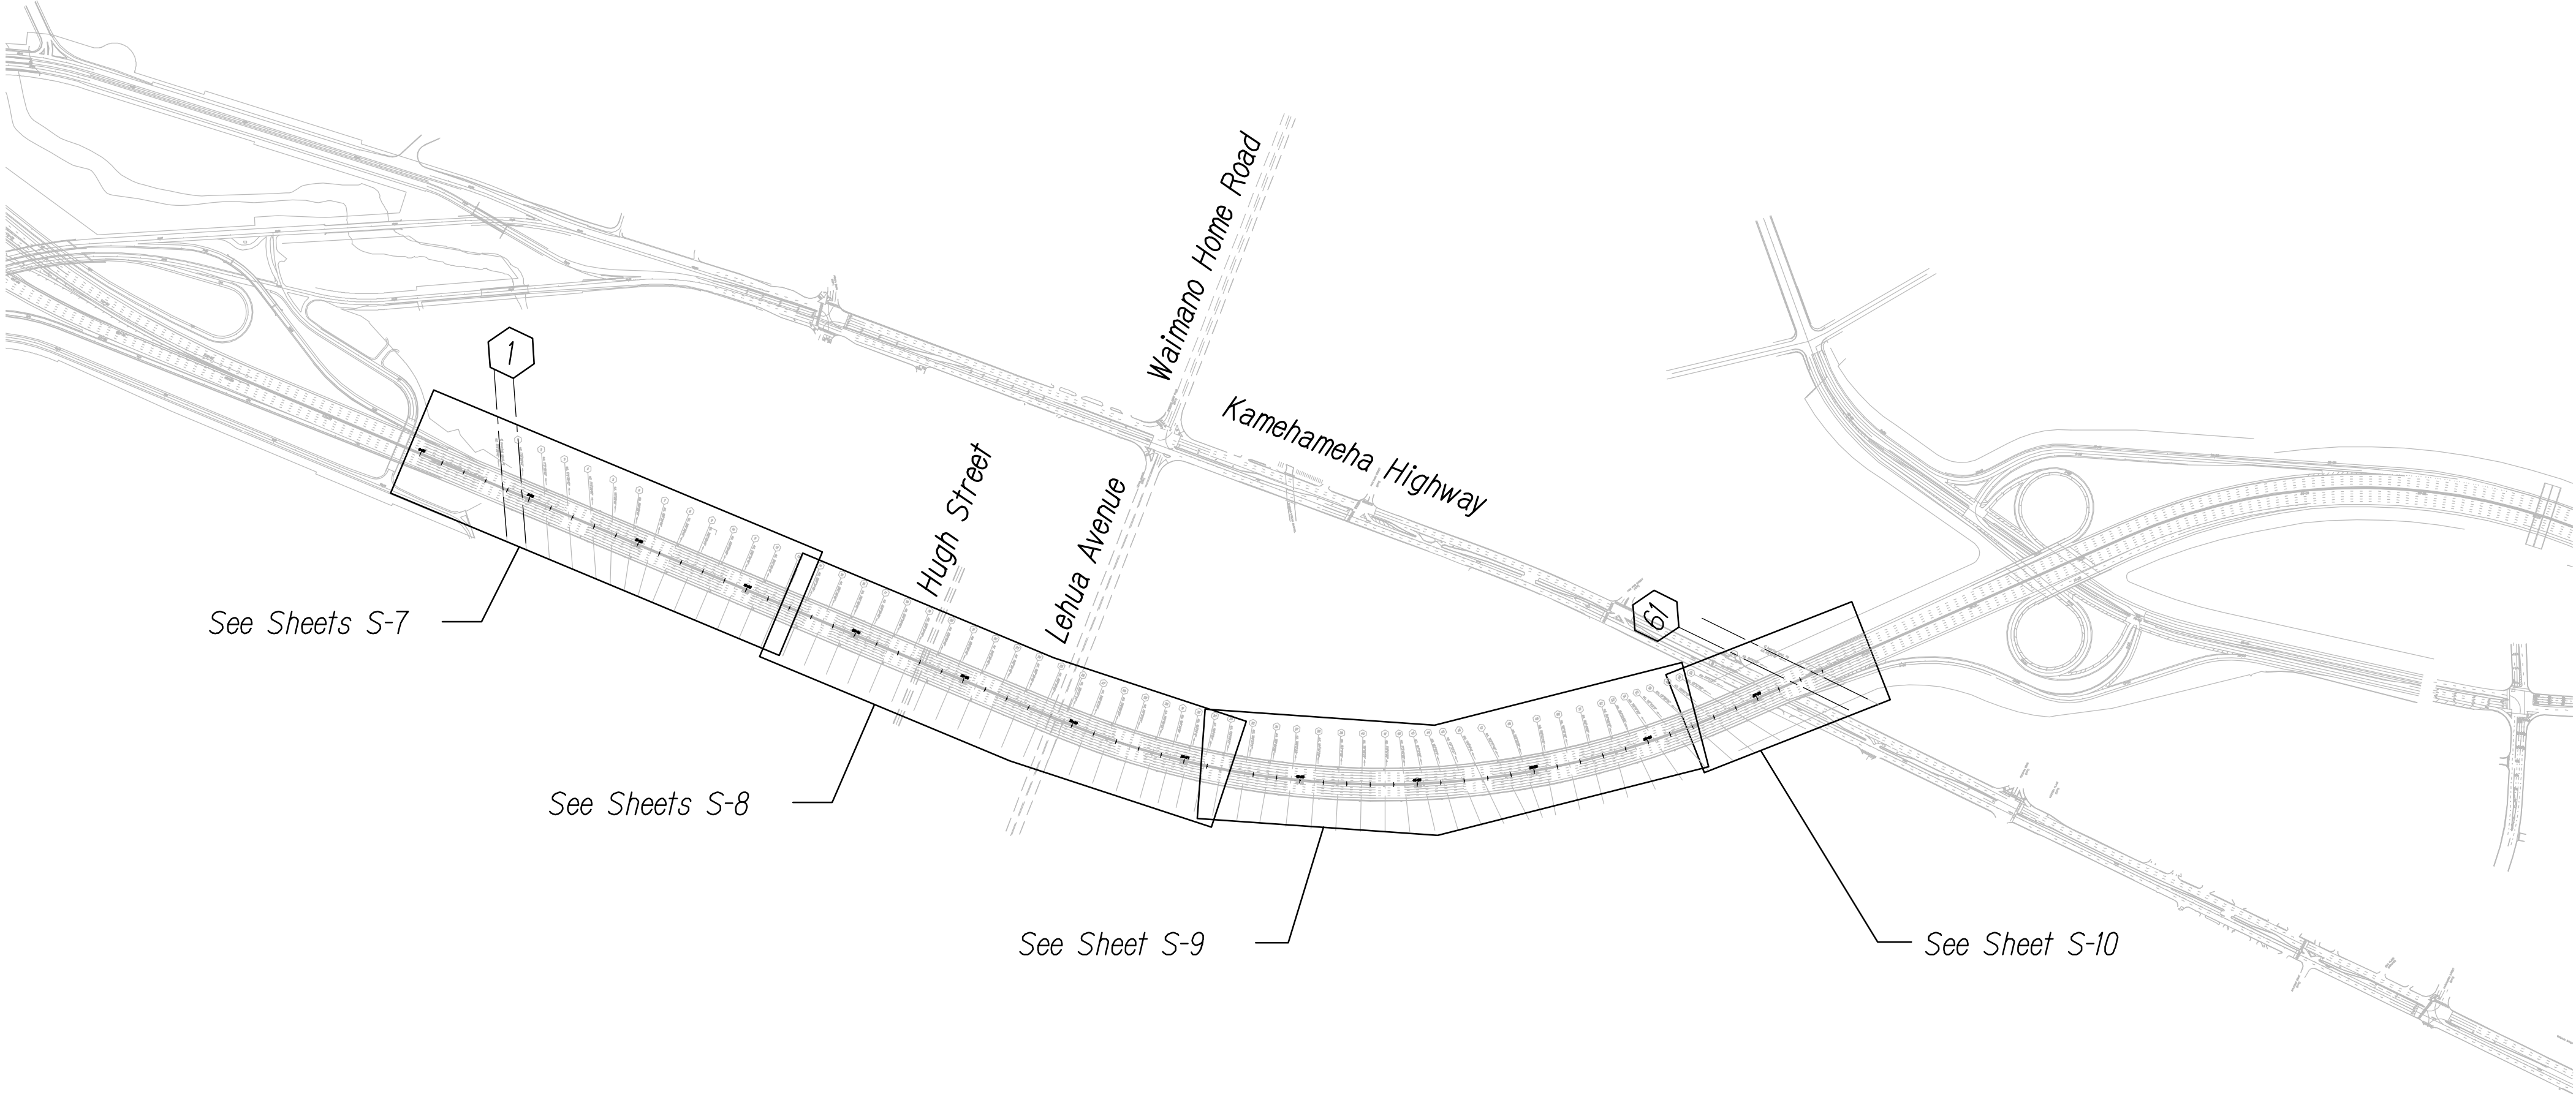

PEARL CITY VIADUCT

KEY PLAN
Not to scale

LEGEND FOR
AS-BUILT POSTINGS

~~~~~

Squiggly line for  
as-built deletion

±00.00

Double line for  
as-built deletion

Roadway

Text for as-built posting

STATE OF HAWAII  
DEPARTMENT OF TRANSPORTATION  
HIGHWAYS DIVISION

KEY PLAN

INTERSTATE ROUTE H-1  
PEARL CITY AND WAIMALU  
VIADUCT IMPROVEMENTS

FEDERAL AID PROJECT NO. BR-HI-1 (263)


Scale: As Noted

Date: July 2016

SHEET No. S-6 OF 10 SHEETS

|                                        |      |      |                |
|----------------------------------------|------|------|----------------|
| QC/QA REVIEW                           | 100% | DATE | AUGUST 8, 2012 |
| <input type="checkbox"/> BY            |      |      |                |
| <input type="checkbox"/> BY            |      |      |                |
| <input type="checkbox"/> BY            |      |      |                |
| <input checked="" type="checkbox"/> BY |      |      |                |

|               |                   |      |
|---------------|-------------------|------|
| ORIGINAL PLAN | SURVEY PLOTTED BY | DATE |
| NOTE BOOK     | DRAWN BY          |      |
|               | DESIGNED BY       |      |
|               | QUANTITIES BY     |      |
|               | CHECKED BY        |      |
| No.           |                   |      |

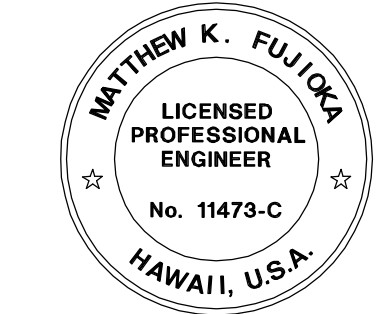

THIS WORK WAS PREPARED BY  
ME OR UNDER MY SUPERVISION.

SIGNATURE: *Matthew K. Fujioka*  
EXPIRATION DATE OF THE LICENSE: 4/30/18