
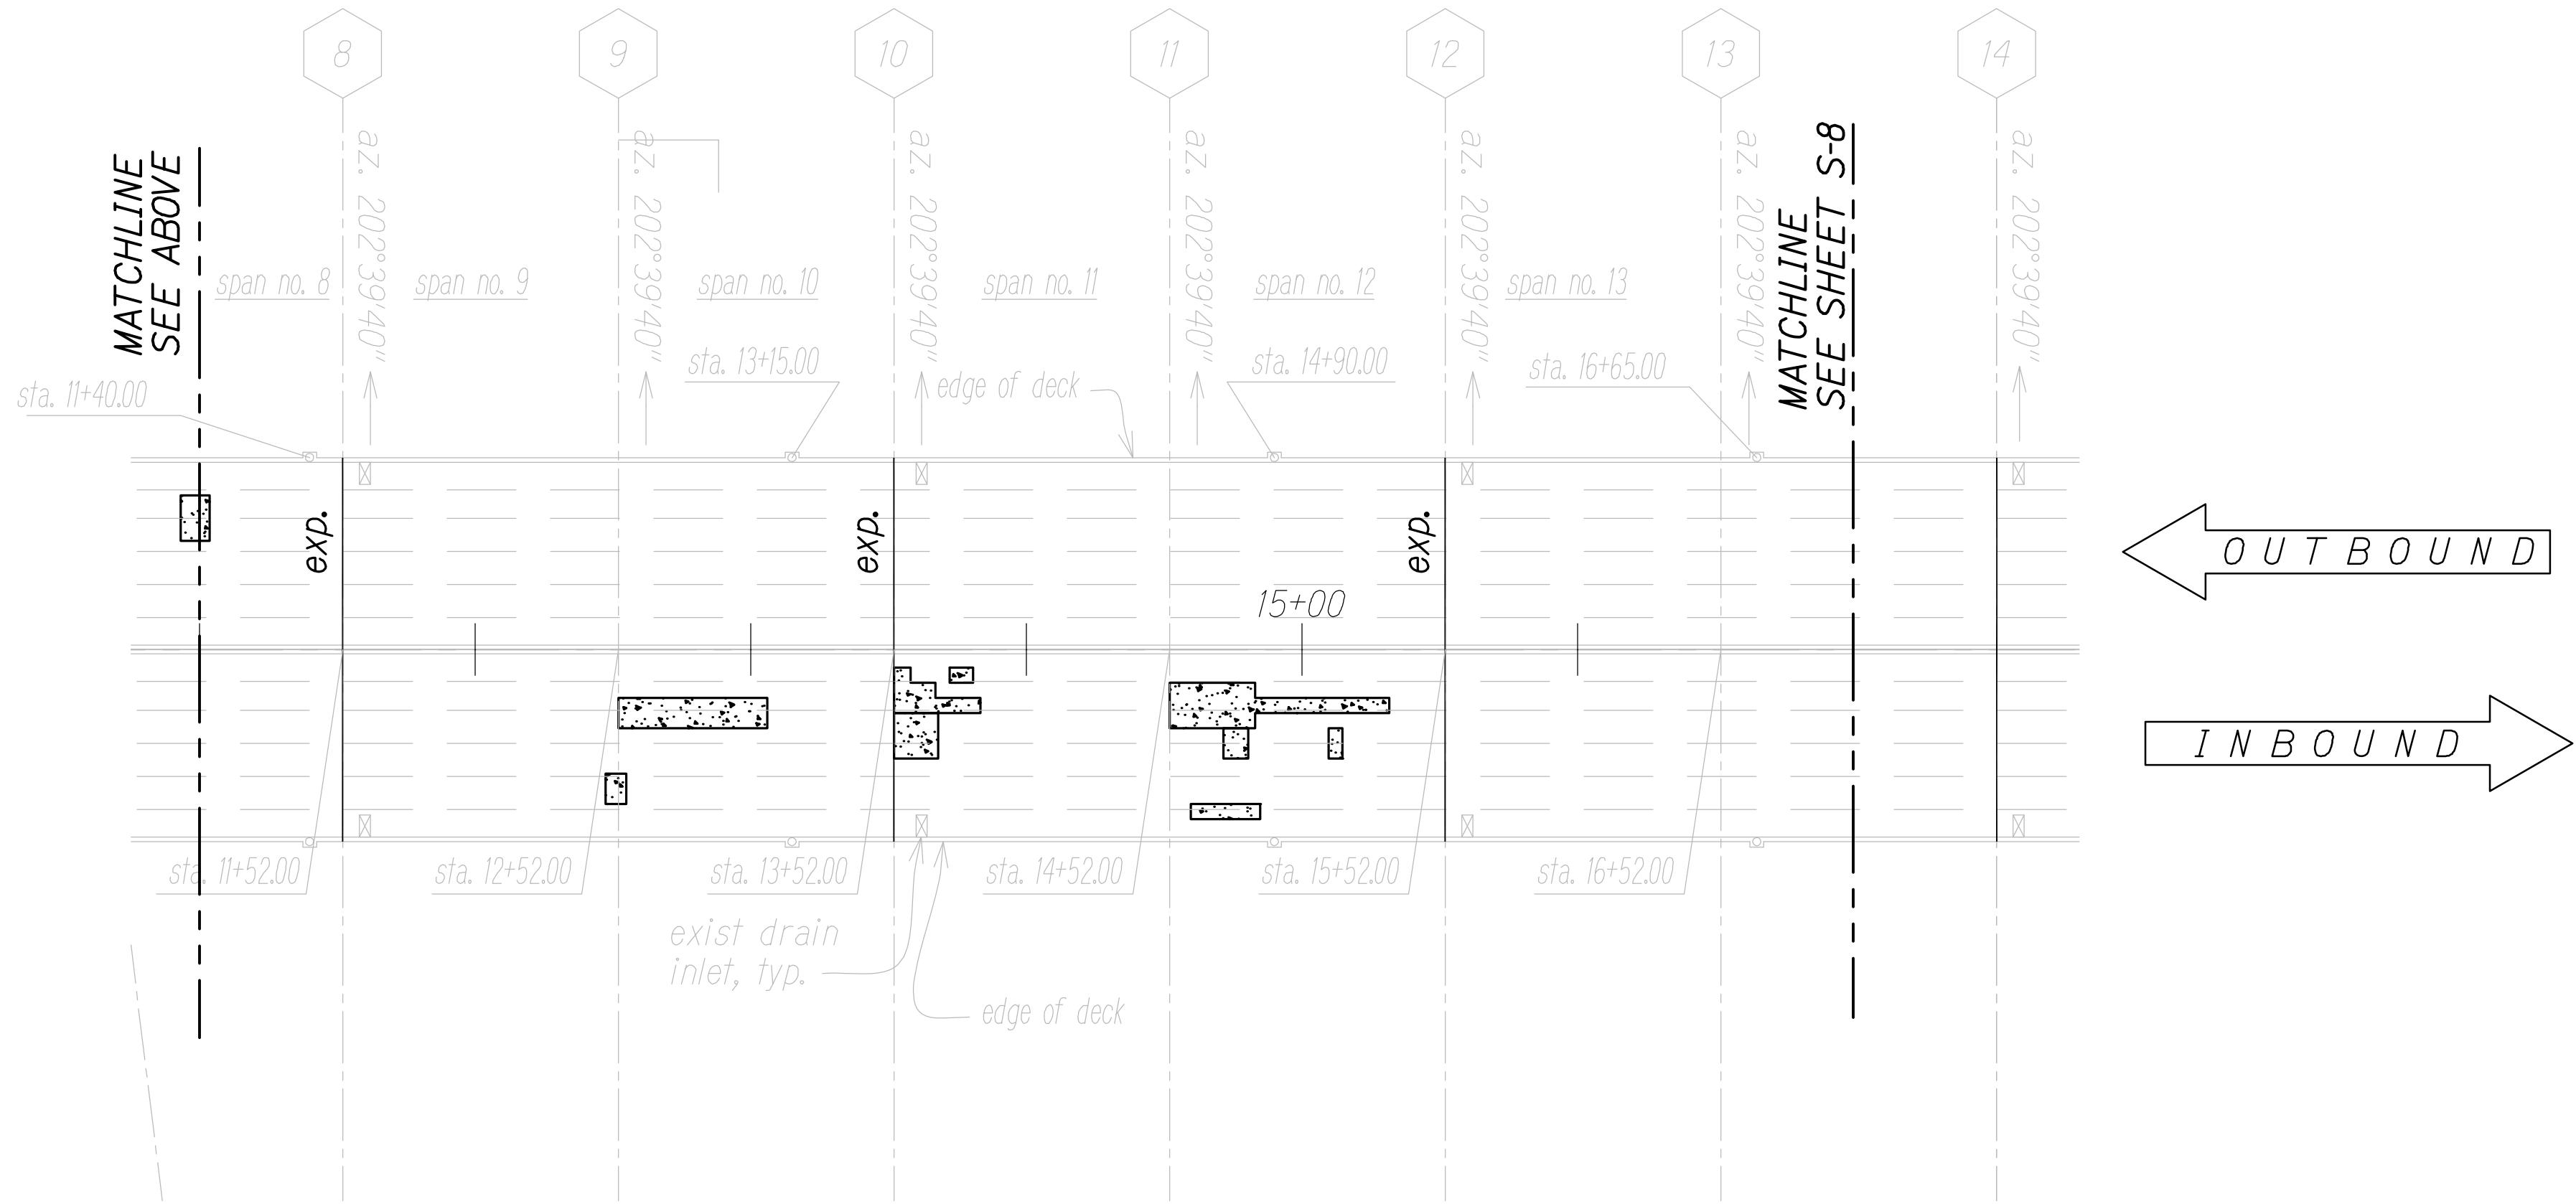


FED. ROAD DIST. NO.	STATE	FED. AID PROJ. NO.	FISCAL YEAR	SHEET NO.	TOTAL SHEETS
HAWAII	HAW.	BR-H1-1 (263)	2012	43	46

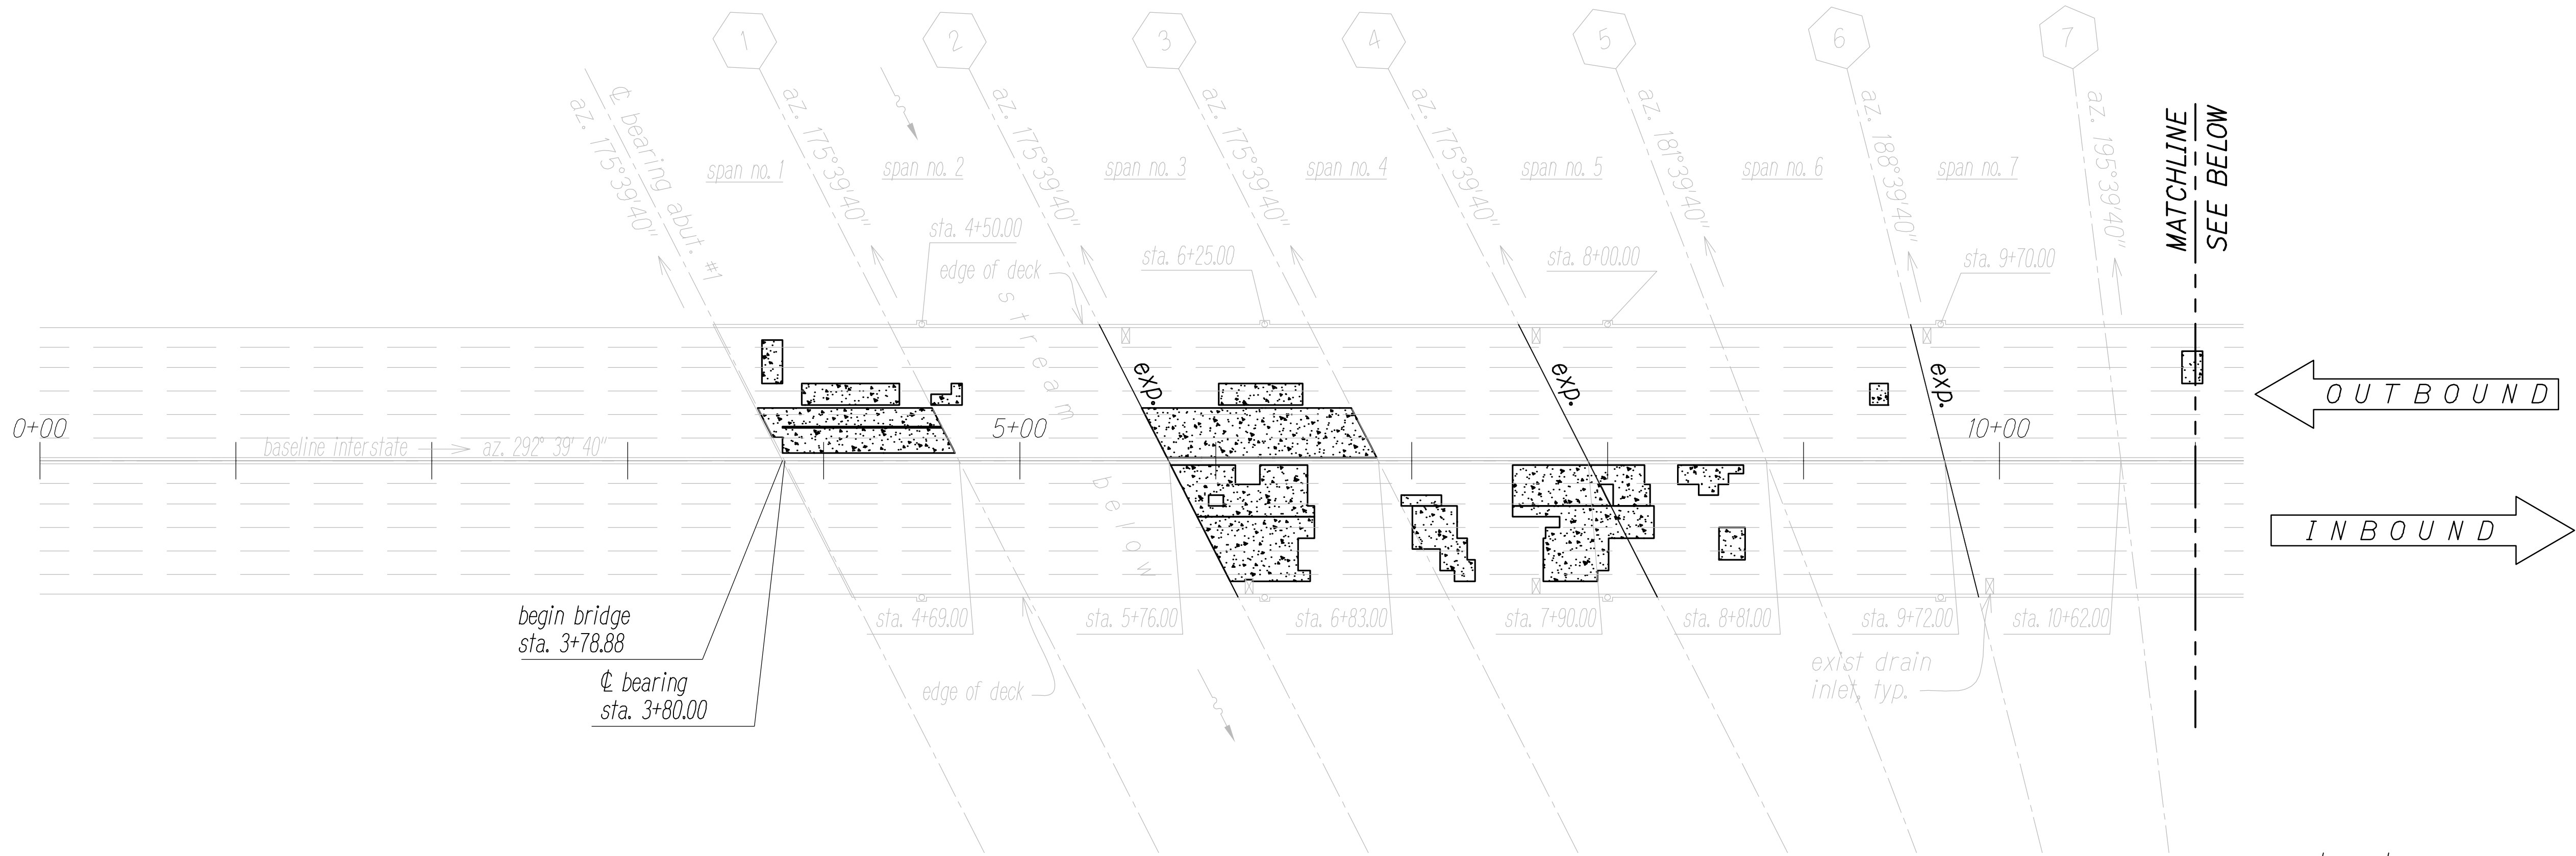

**Legend:**

- General area to be repaired  
See Note 1.d on Sht. S-0.
- Expansion Joint

**Note:**

Stations and azimuths shown are from original Construction drawings, see Structural Note 1.c. on sheet no. S-0.



THIS WORK WAS PREPARED BY  
ME OR UNDER MY SUPERVISION.


4/30/18  
SIGNATURE EXPIRATION DATE  
OF THE LICENSE

LEGEND FOR AS-BUILT POSTINGS	
	Squiggly line for as-built deletion
	Double line for as-built deletion
Roadway	Text for as-built posting

STATE OF HAWAII  
DEPARTMENT OF TRANSPORTATION  
HIGHWAYS DIVISION  
**PEARL CITY VIADUCT  
DECK REPAIR - PLAN**  
INTERSTATE ROUTE H-1  
PEARL CITY AND WAIMALU  
VIADUCT IMPROVEMENTS  
FEDERAL AID PROJECT NO. BR-H1-1 (263)  
Scale: As Noted Date: July 2016

SHEET No. S-7 OF 10 SHEETS

FED. ROAD DIST. NO.	STATE	FED. AID PROJ. NO.	FISCAL YEAR	SHEET NO.	TOTAL SHEETS
HAWAII	HAW.	BR-H1-1 (263)	2012	44	46

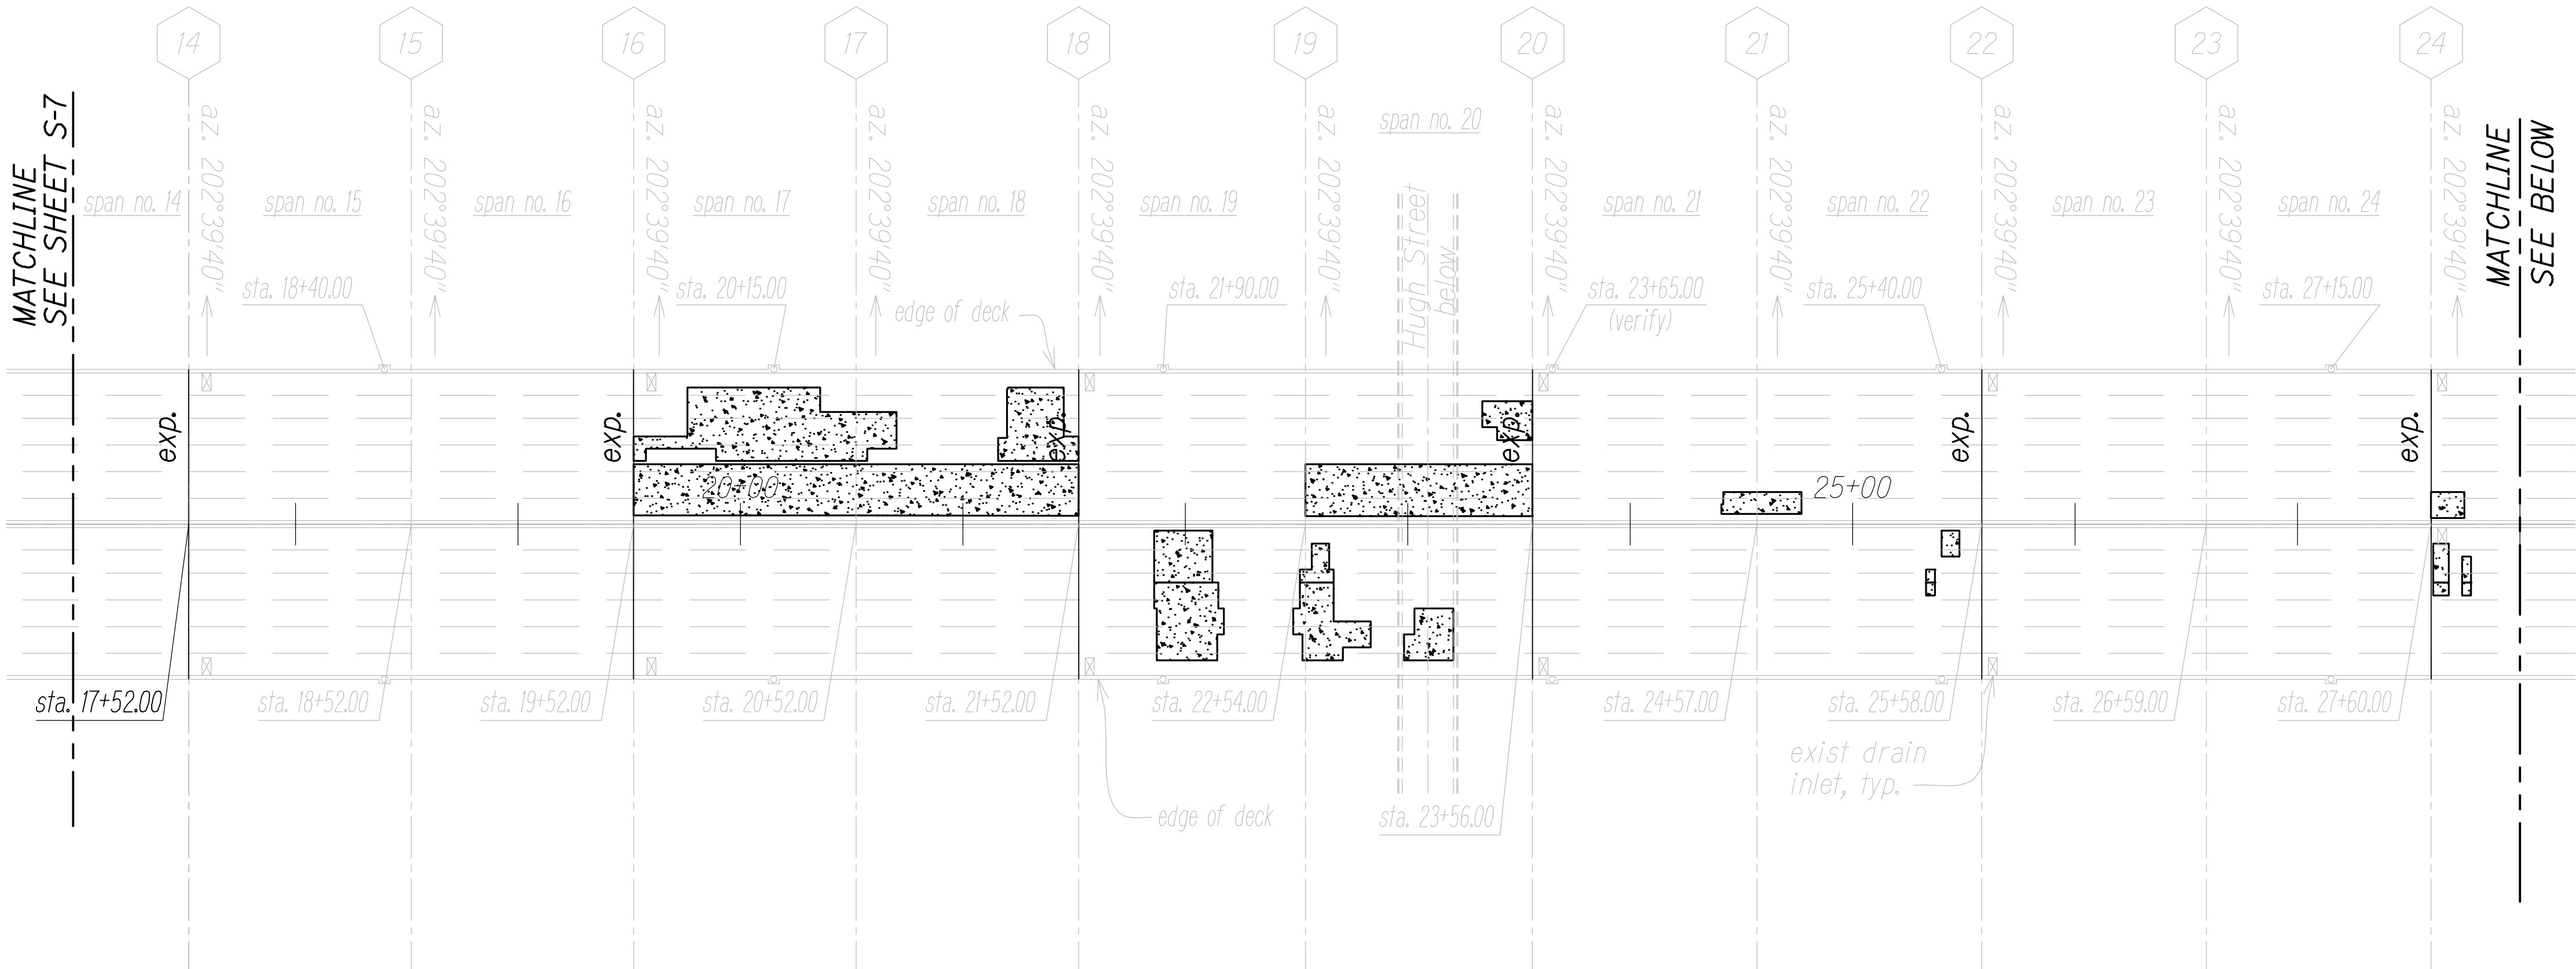

OUTBOUND

INBOUND


Legend:

General area to be repaired  
See Note 1.d on Sht. S-0.

exp. Expansion Joint

Note:

Stations and azimuths shown are from original Construction drawings, see Structural Note 1.c. on sheet no. S-0.

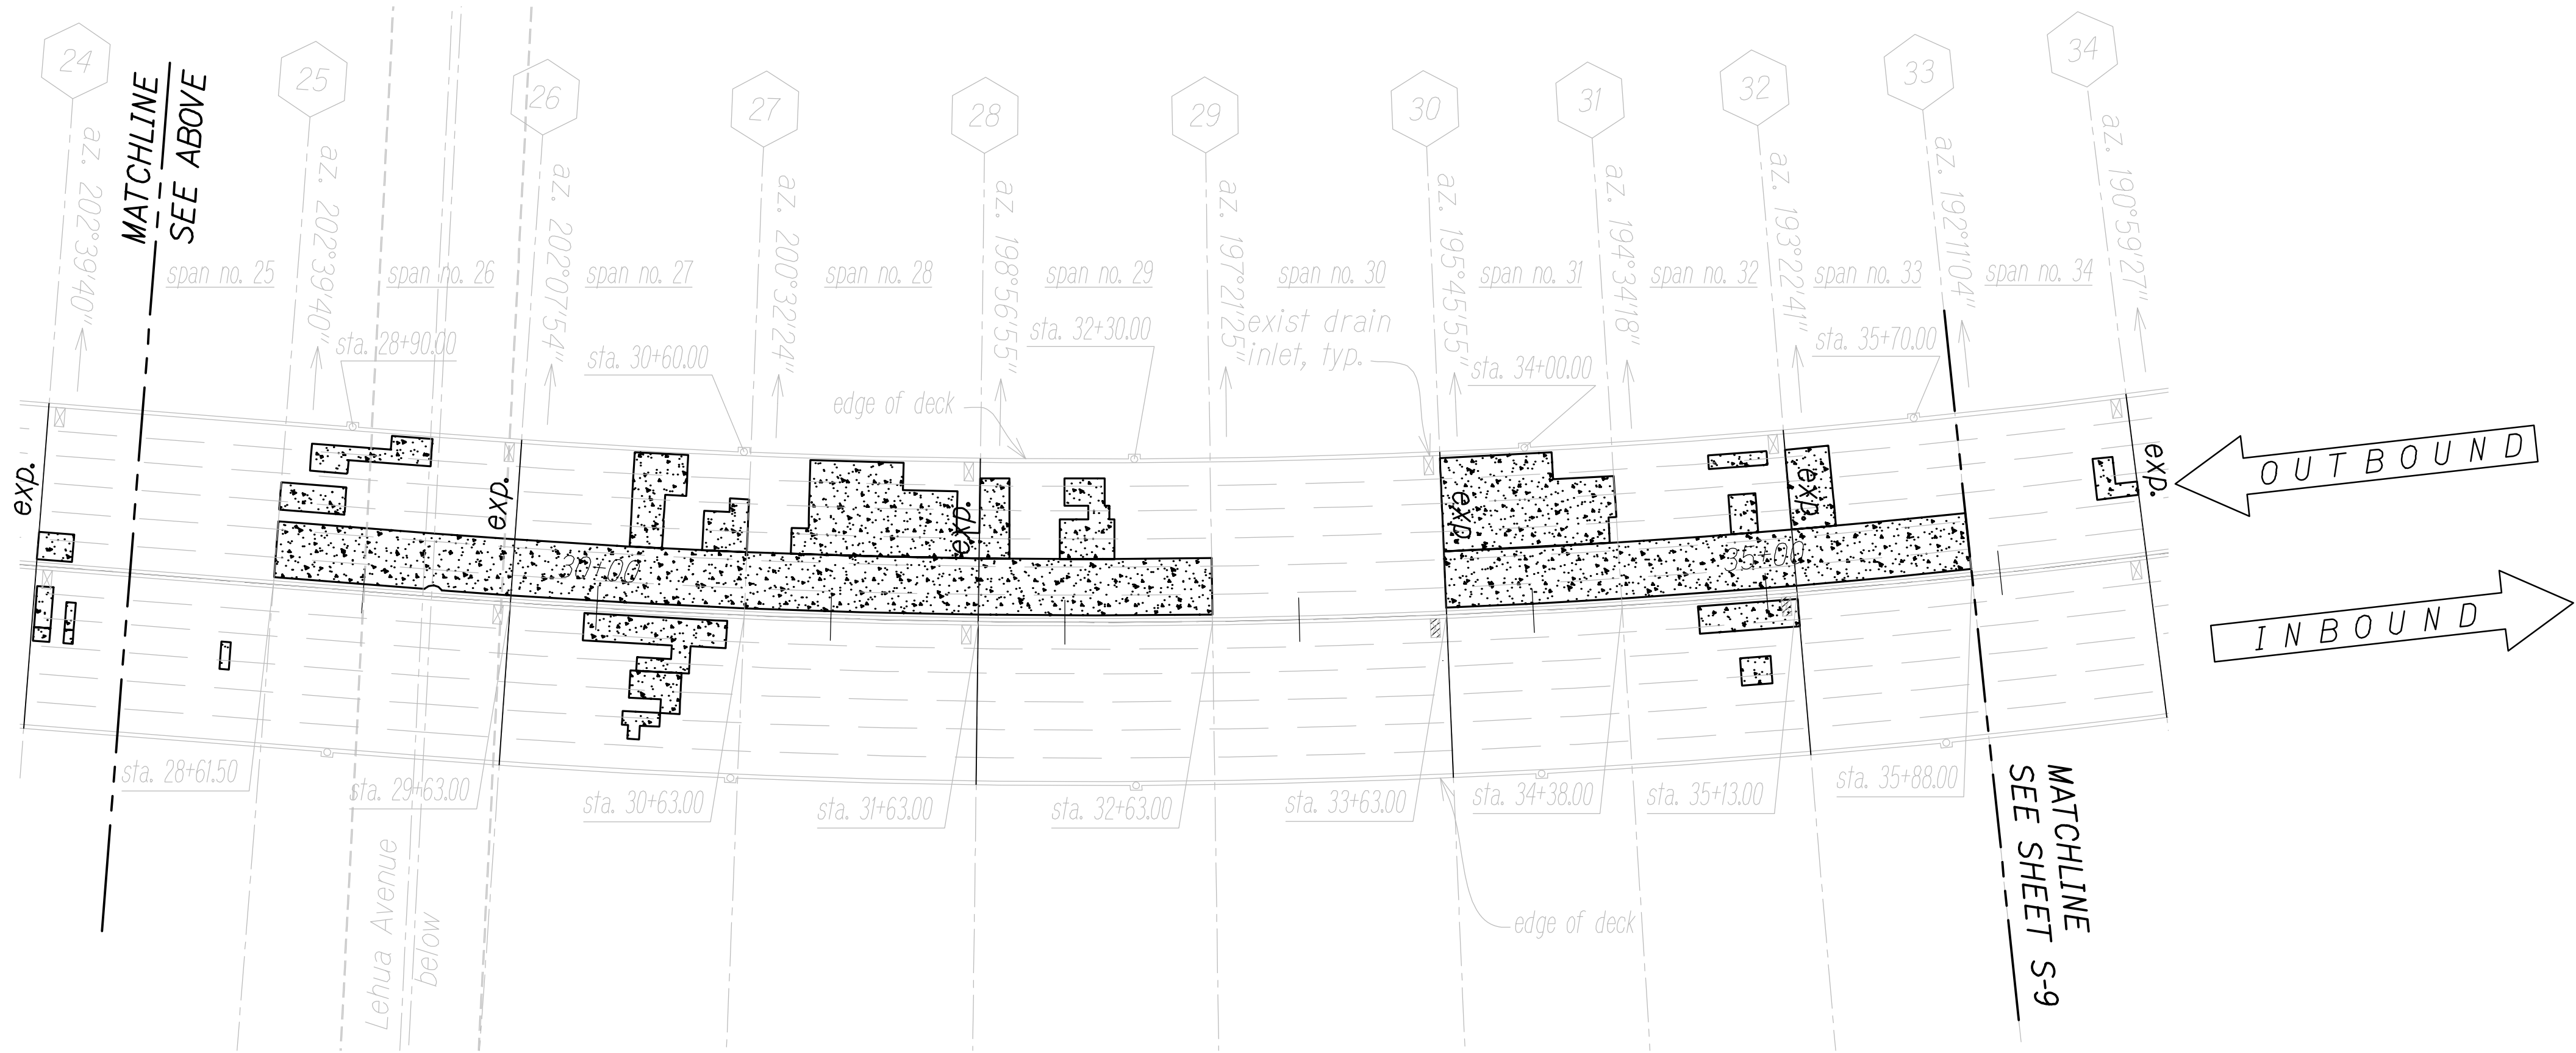

OUTBOUND

INBOUND

#### LEGEND FOR AS-BUILT POSTINGS

- Squiggly line for as-built deletion
- Double line for as-built deletion
- Roadway Text for as-built posting



THIS WORK WAS PREPARED BY ME OR UNDER MY SUPERVISION.

4/30/18  
SIGNATURE EXPIRATION DATE OF THE LICENSE

STATE OF HAWAII  
DEPARTMENT OF TRANSPORTATION  
HIGHWAYS DIVISION  
**PEARL CITY VIADUCT**  
**DECK REPAIR - PLAN**  
INTERSTATE ROUTE H-1  
PEARL CITY AND WAIMALU  
VIADUCT IMPROVEMENTS  
FEDERAL AID PROJECT NO. BR-H1-1 (263)  
Scale: As Noted Date: July 2016

SHEET No. S-8 OF 10 SHEETS

"AS-BUILT"

44

### DECK REPAIR - PLAN

Scale: 1" = 50'-0"

QC/QA REVIEW	100%	DATE	AUGUST 8, 2012
<input type="checkbox"/> BY			
<input type="checkbox"/> BY			
<input checked="" type="checkbox"/> BY			

SURVEY PLOTTED BY	DATE
DRAWN BY	
TRACED BY	
DESIGNED BY	
QUANTITIES BY	
CHECKED BY	
ORIGINAL PLAN	No.
NOTE BOOK	



FED. ROAD DIST. NO.	STATE	FED. AID PROJ. NO.	FISCAL YEAR	SHEET NO.	TOTAL SHEETS
HAWAII	HAW.	BR-HI-1 (263)	2012	45	46

LEGEND FOR  
AS-BUILT POSTINGS

~~~~~

Squiggly line for  
as-built deletion

±00.00±

Double line for  
as-built deletion

Roadway

Text for as-built posting



Legend:

General area to be repaired  
See Note 1.d on Sht. S-0.

exp.

Expansion Joint

Note:  
Stations and azimuths shown are from original Construction drawings, see Structural Note 1.c. on sheet no. S-0.



MATTHEW K. FUJIOKA  
LICENSED PROFESSIONAL ENGINEER  
No. 11473-C  
HAWAII, U.S.A.

THIS WORK WAS PREPARED BY ME OR UNDER MY SUPERVISION.

Matthew

4/30/18  
SIGNATURE EXPIRATION DATE OF THE LICENSE

STATE OF HAWAII  
DEPARTMENT OF TRANSPORTATION  
HIGHWAYS DIVISION  
**PEARL CITY VIADUCT**  
**DECK REPAIR - PLAN**  
INTERSTATE ROUTE H-1  
PEARL CITY AND WAIMALU  
VIADUCT IMPROVEMENTS  
FEDERAL AID PROJECT NO. BR-HI-1 (263)  
Scale: As Noted Date: July 2016

SHEET No. S-9 OF 10 SHEETS

DECK REPAIR - PLAN  
Scale: 1" = 50'-0"

QC/QA REVIEW 100%  
DATE AUGUST 8, 2012  
BY: [Signature]  
CHECKED BY: [Signature]

DATE: \_\_\_\_\_  
DESIGNED BY: \_\_\_\_\_  
CHECKED BY: \_\_\_\_\_  
NO. \_\_\_\_\_



