
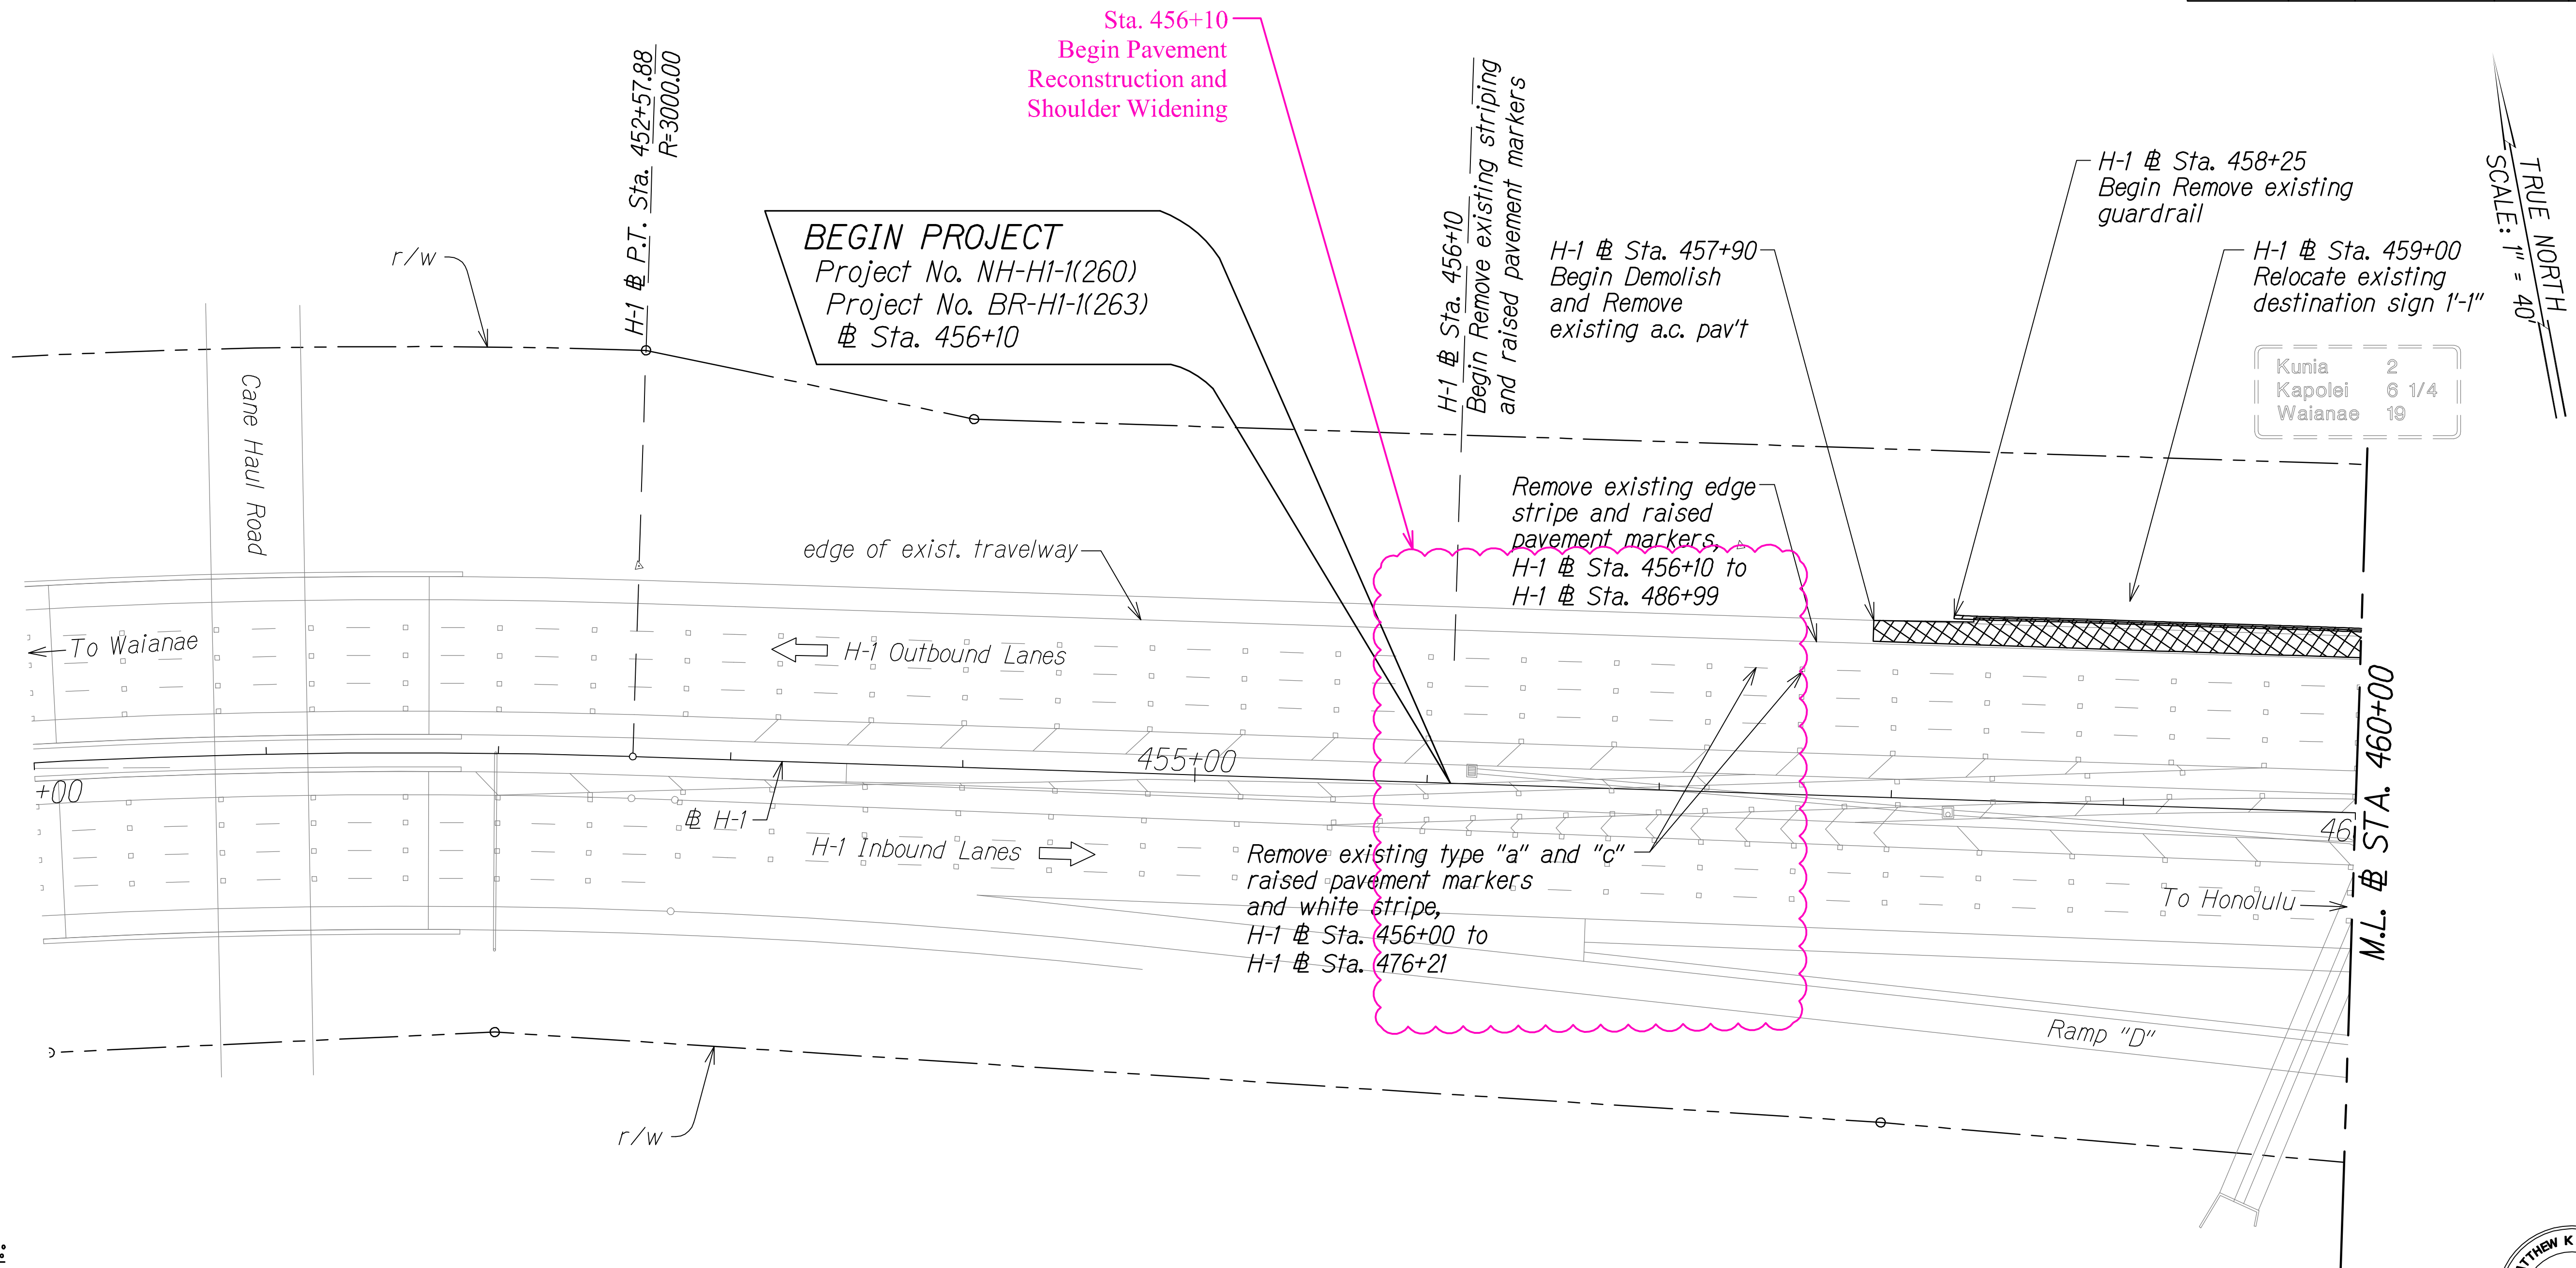


FED. ROAD DIST. NO.	STATE	FED. AID PROJ. NO.	FISCAL YEAR	SHEET NO.	TOTAL SHEETS
HAWAII	HAW.	NH-H1-1 (260)	2014	27	605

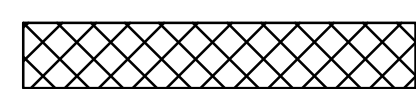


Legend:

 Demolish and Remove Feature

Notes:


1. At existing a.c. pavement demolition areas, demolish and remove existing a.c. pavement and base course. Subbase shall remain in-place.

Graphic Scale

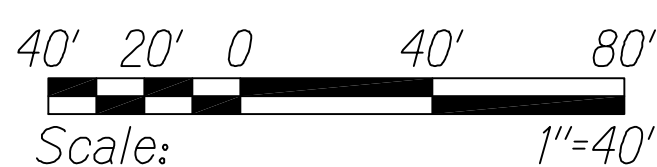

DEMOLITION PLAN
STA. 450+00 TO # STA. 460+00
Scale: 1" = 40'

LEGEND FOR AS-BUILT POSTINGS	
	Squiggly line for as-built deletion
	Double line for as-built deletion
Roadway	Text for as-built posting

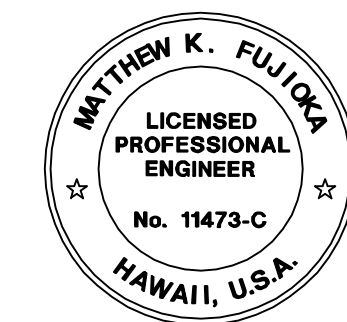

THIS WORK WAS PREPARED BY ME
OR UNDER MY SUPERVISION.

WILSON OKAMOTO CORPORATION APRIL 30, 2016
LIC. EXP. DATE

STATE OF HAWAII
DEPARTMENT OF TRANSPORTATION
HIGHWAYS DIVISION

DEMOLITION PLAN

INTERSTATE ROUTE H-1
PM CONTRAFLOW LANE, PHASE 1 # 2
FEDERAL AID PROJECT NO. NH-H1-1 (260)
Scale: 1" = 40' Date: July, 2016

SHEET No. DEM-01 OF 26 SHEETS


"AS-BUILT"

FED. ROAD DIST. NO.	STATE	FED. AID PROJ. NO.	FISCAL YEAR	SHEET NO.	TOTAL SHEETS
HAWAII	HAW.	NH-HI-1 (260)	2014	28	605

QC/QA REVIEW	100%	DATE	MARCH 23, 2016
BY		DESIGNED BY	
BY		DESIGNED BY	
BY		DESIGNED BY	
BY		DESIGNED BY	

ORIGINAL PLAN	DATE
NOTED BY	
DESIGNED BY	
QUANTITIES BY	
CHECKED BY	


Legend:

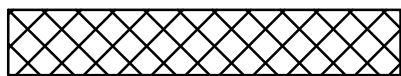 Demolish and Remove Feature

Notes:

- At existing a.c. pavement demolition areas, demolish and remove existing a.c. pavement and base course. Subbase shall remain in-place.

Graphic Scale

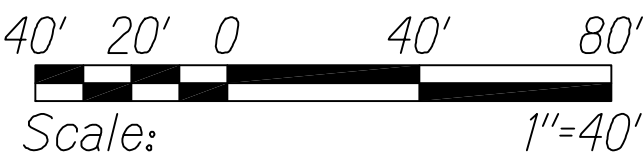

DEMOLITION PLAN
STA. 460+00 TO # STA. 475+00
Scale: 1" = 40'

LEGEND FOR AS-BUILT POSTINGS

 Squiggly line for as-built deletion

 Double line for as-built deletion


Roadway Text for as-built posting

STATE OF HAWAII
DEPARTMENT OF TRANSPORTATION
HIGHWAYS DIVISION

DEMOLITION PLAN


INTERSTATE ROUTE H-1
PM CONTRAFLOW LANE, PHASE 1 # 2
FEDERAL AID PROJECT NO. NH-HI-1 (260)
Scale: 1" = 40' Date: July, 2016

SHEET No. DEM-02 OF 26 SHEETS

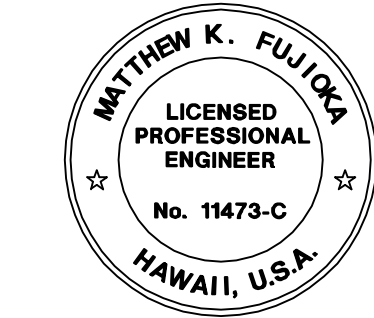


THIS WORK WAS PREPARED BY ME
OR UNDER MY SUPERVISION.

WILSON OKAMOTO CORPORATION APRIL 30, 2016 LIC. EXP. DATE

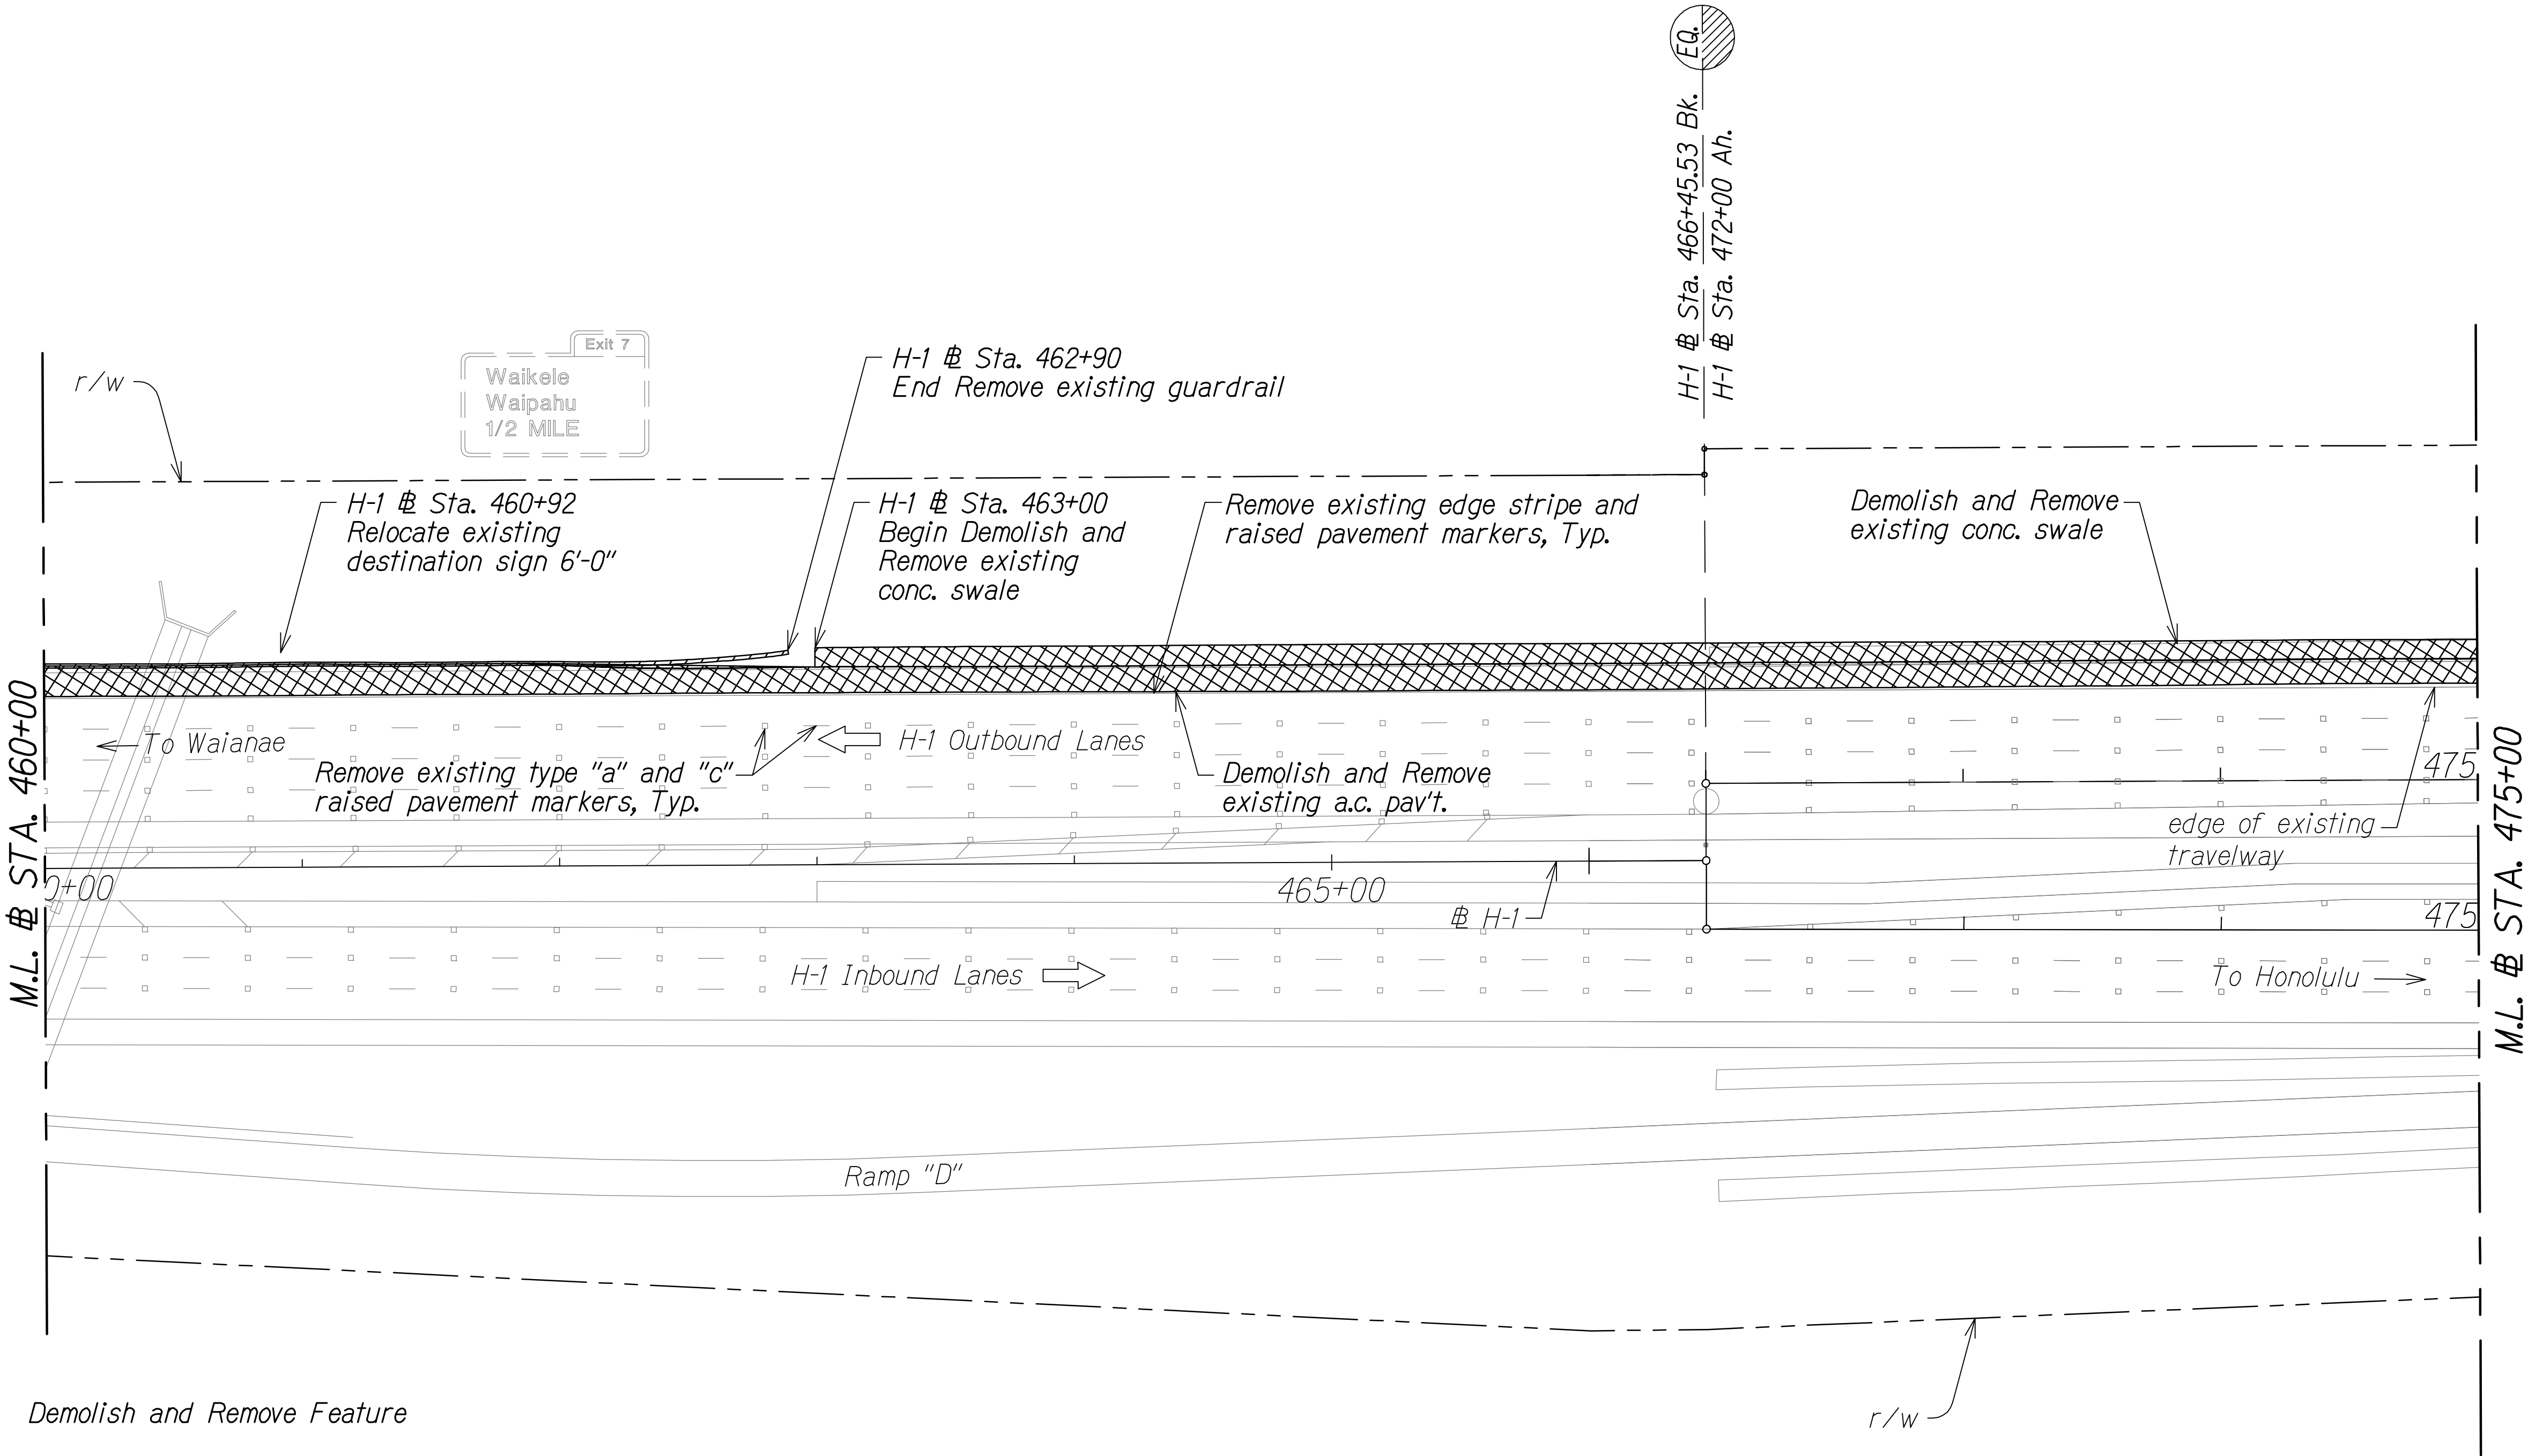

TRUE NORTH
SCALE: 1" = 40'

FED. ROAD DIST. NO.	STATE	FED. AID PROJ. NO.	FISCAL YEAR	SHEET NO.	TOTAL SHEETS
HAWAII	HAW.	NH-H1-1 (260)	2014	29	605

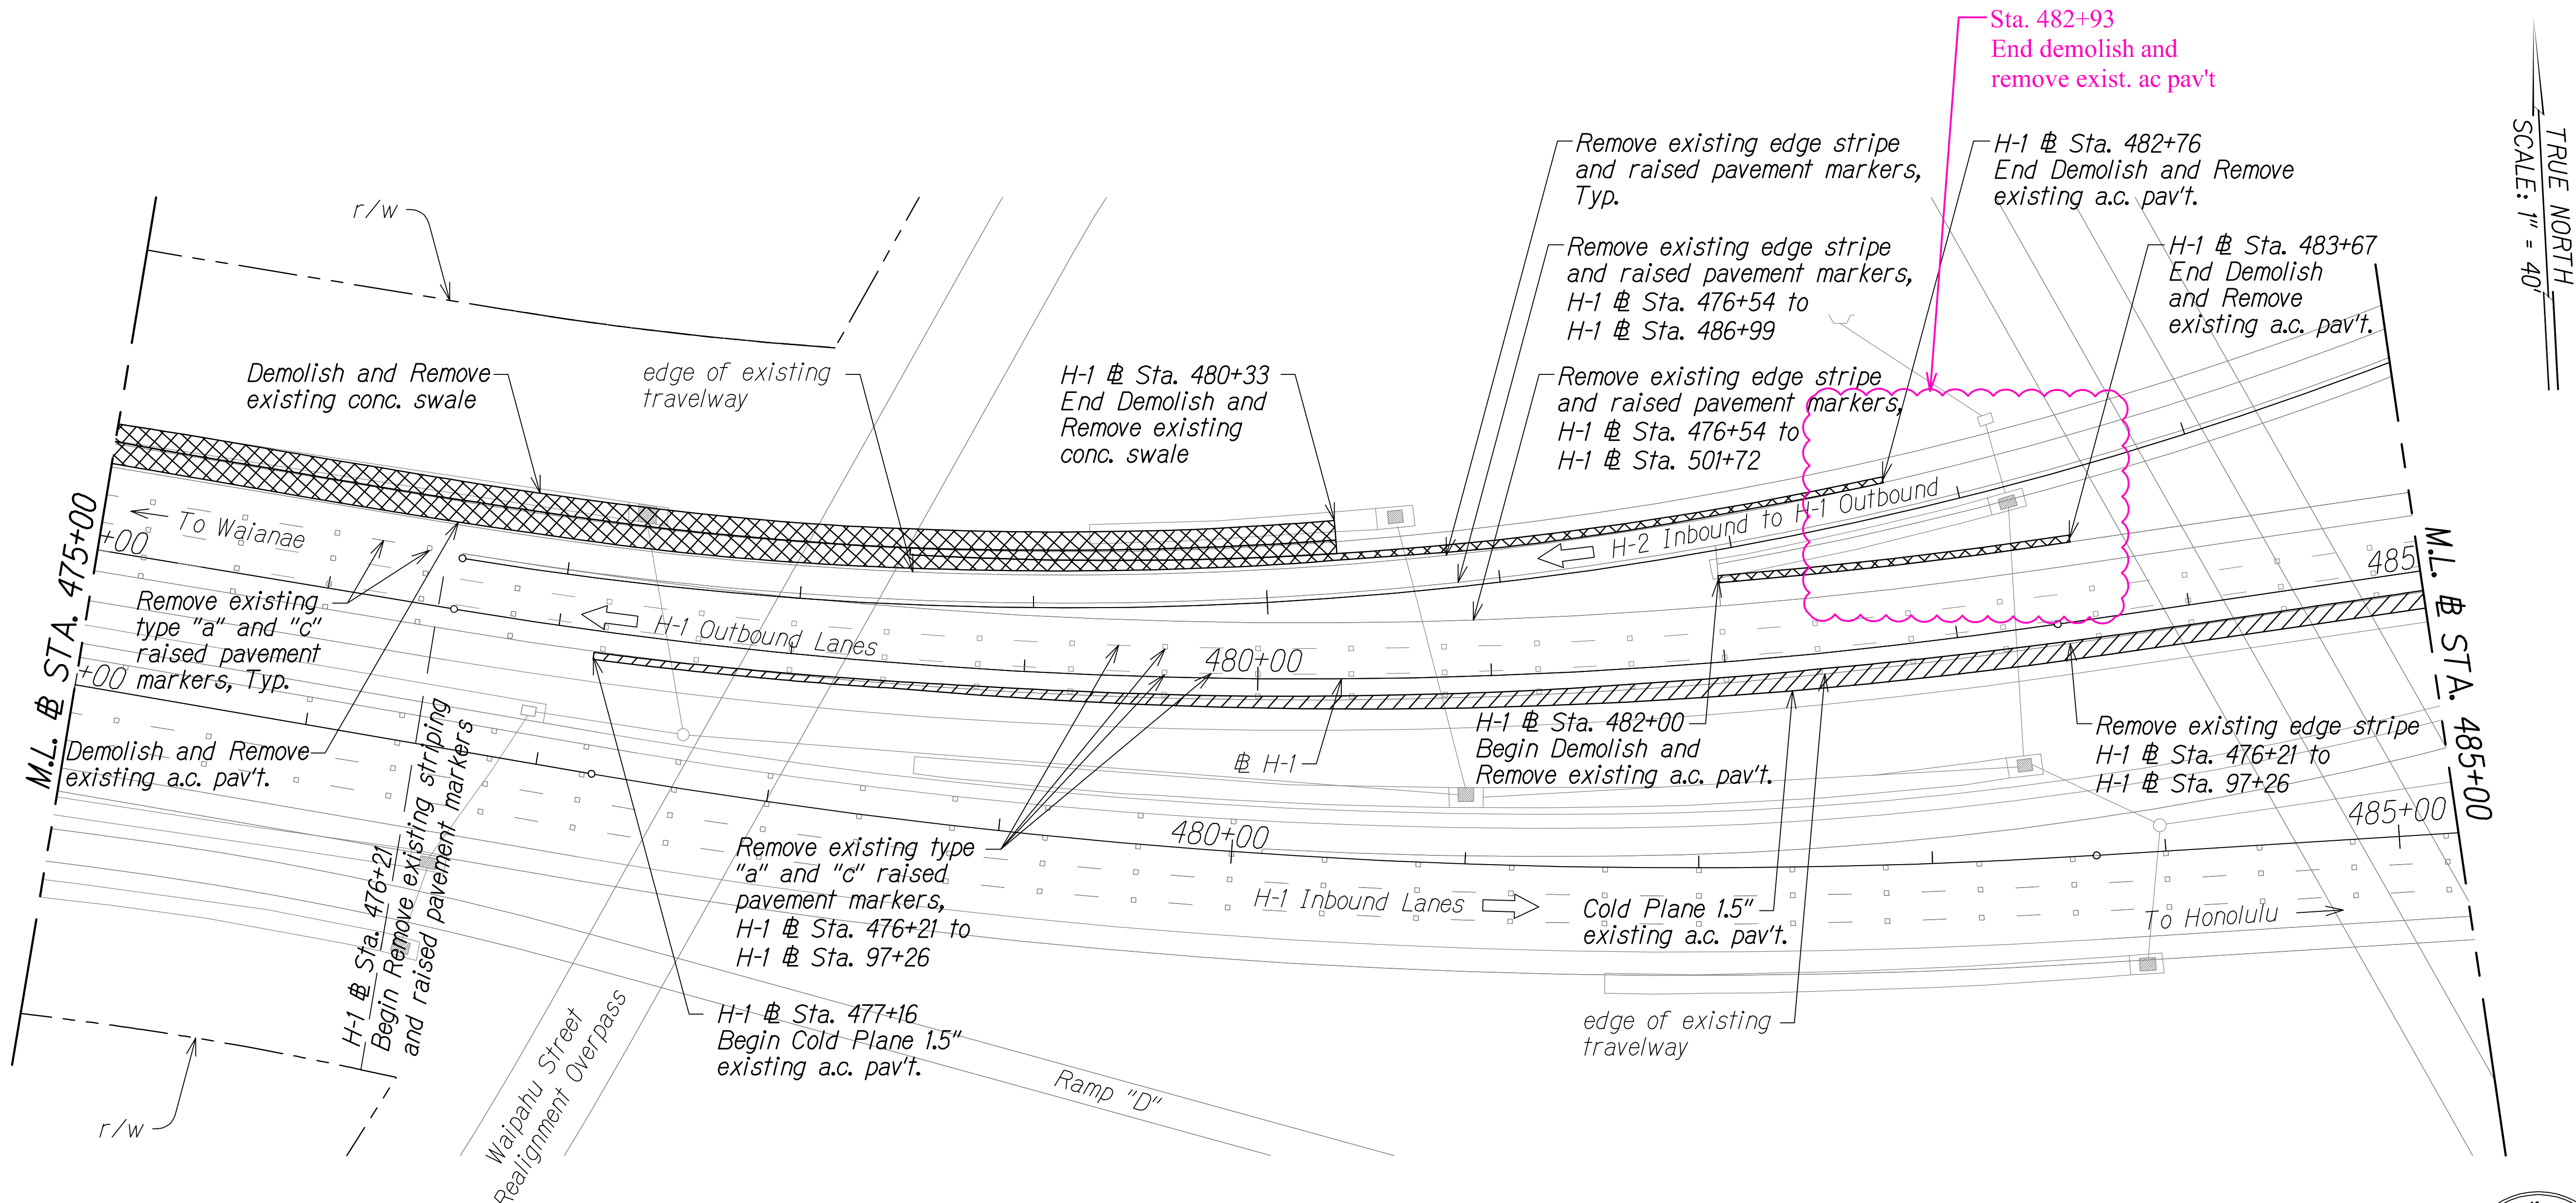

TRUE NORTH
SCALE: 1" = 40'


Legend:

- Demolish and Remove Feature
- Cold Plane existing a.c. pav't.

Notes:

- At existing a.c. pavement demolition areas, demolish and remove existing a.c. pavement and base course. Subbase shall remain in-place.


Graphic Scale

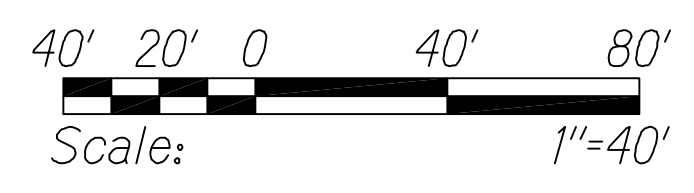

DEMOLITION PLAN
STA. 475+00 TO # STA. 485+00
Scale: 1" = 40'

LEGEND FOR AS-BUILT POSTINGS

- Squiggly line for as-built deletion
- Double line for as-built deletion
- Roadway Text for as-built posting

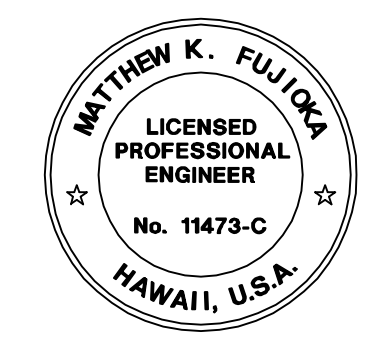

THIS WORK WAS PREPARED BY ME OR UNDER MY SUPERVISION.
Matthew K. Fujitaka
WILSON OKAMOTO CORPORATION APRIL 30, 2016 LIC. EXP. DATE


STATE OF HAWAII
DEPARTMENT OF TRANSPORTATION
HIGHWAYS DIVISION

DEMOLITION PLAN

INTERSTATE ROUTE H-1
PM CONTRAFLOW LANE, PHASE 1 # 2
FEDERAL AID PROJECT NO. NH-H1-1 (260)
Scale: 1" = 40' Date: July, 2016



SHEET No. DEM-03 OF 26 SHEETS

FED. ROAD DIST. NO.	STATE	FED. AID PROJ. NO.	FISCAL YEAR	SHEET NO.	TOTAL SHEETS
HAWAII	HAW.	NH-HI-1 (260)	2014	30	605

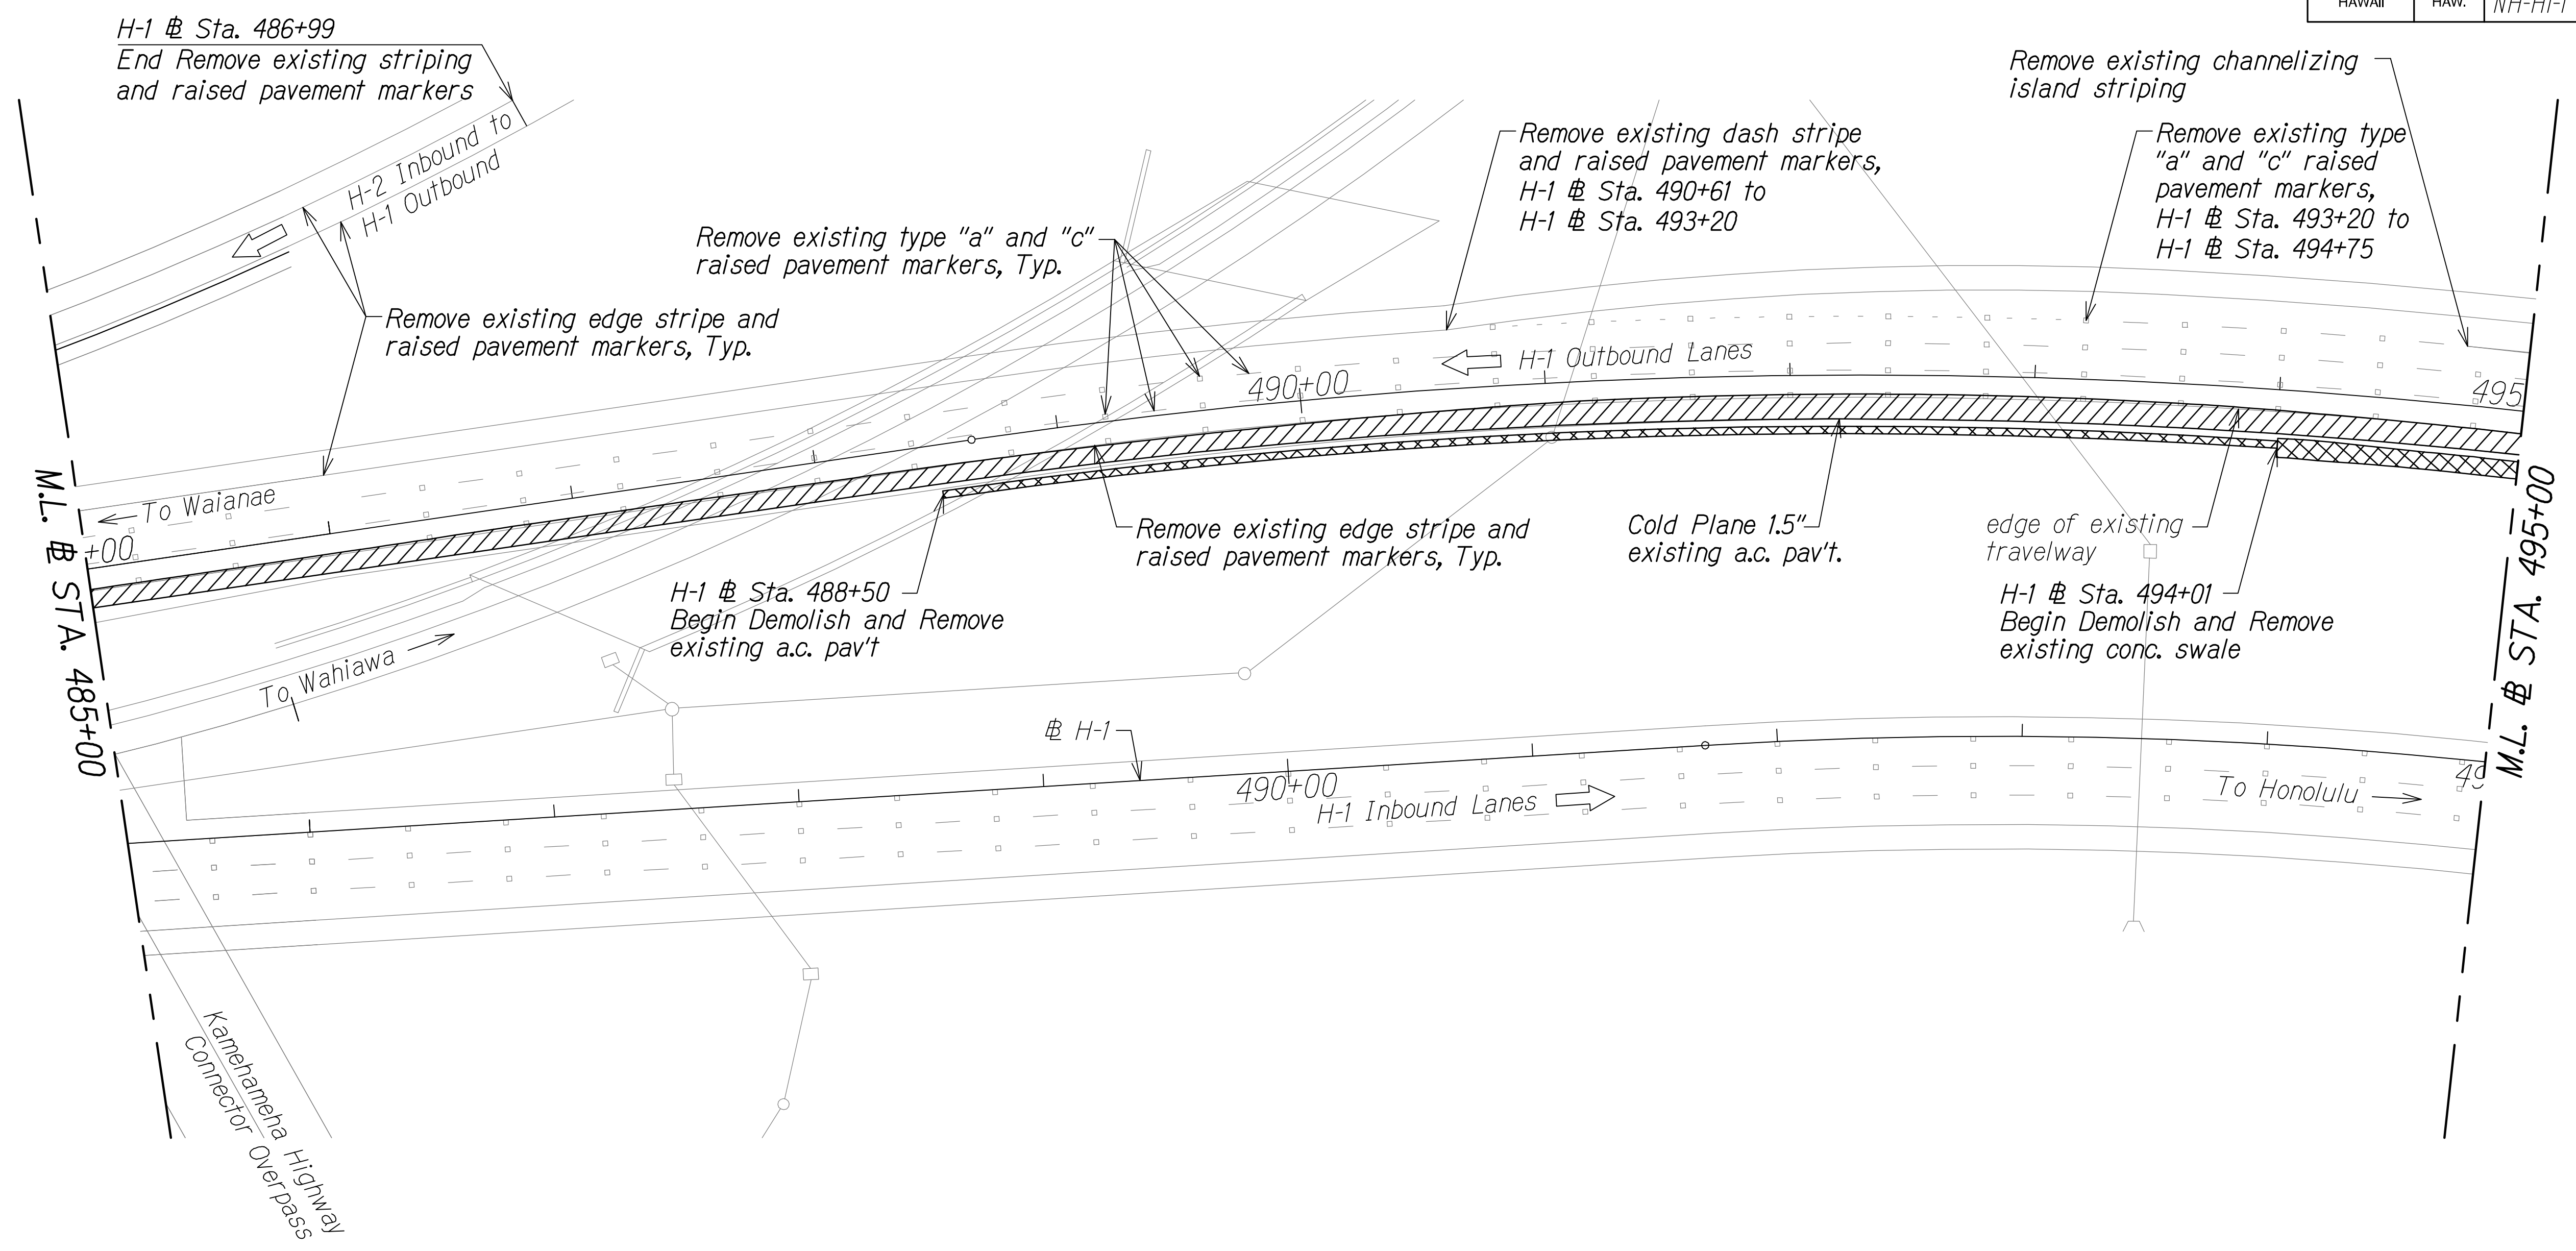

TRUE NORTH
SCALE: 1" = 40'


Legend:

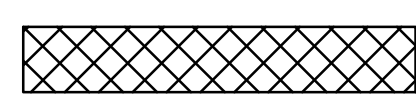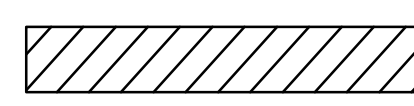-  Demolish and Remove Feature
-  Cold Plane existing a.c. pav't.

Notes:

- At existing a.c. pavement demolition areas, demolish and remove existing a.c. pavement and base course. Subbase shall remain in-place.

Graphic Scale

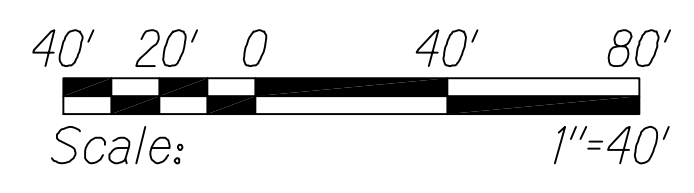

DEMOLITION PLAN
STA. 485+00 TO # STA. 495+00
Scale: 1" = 40'

LEGEND FOR AS-BUILT POSTINGS

 Squiggly line for as-built deletion

 Double line for as-built deletion

Roadway Text for as-built posting



THIS WORK WAS PREPARED BY ME OR UNDER MY SUPERVISION.
Matthew K. Fujitaka
WILSON OKAMOTO CORPORATION APRIL 30, 2016 LIC. EXP. DATE

STATE OF HAWAII
DEPARTMENT OF TRANSPORTATION
HIGHWAYS DIVISION

DEMOLITION PLAN


INTERSTATE ROUTE H-1
PM CONTRAFLOW LANE, PHASE 1 # 2
FEDERAL AID PROJECT NO. NH-HI-1 (260)
Scale: 1" = 40' Date: July, 2016

SHEET No. DEM-04 OF 26 SHEETS



QC/QA REVIEW	100%	DATE MARCH 23, 2014
BY		
BY		
BY		
BY		

SURVEY PLOTTED BY	DATE
DESIGNED BY	
DESIGNED BY	
QUANTITIES BY	
CHECKED BY	
ORIGINAL PLAN	
NOTE BOOK	
No.	

FED. ROAD DIST. NO.	STATE	FED. AID PROJ. NO.	FISCAL YEAR	SHEET NO.	TOTAL SHEETS
HAWAII	HAW.	NH-HI-1 (260)	2014	31	605

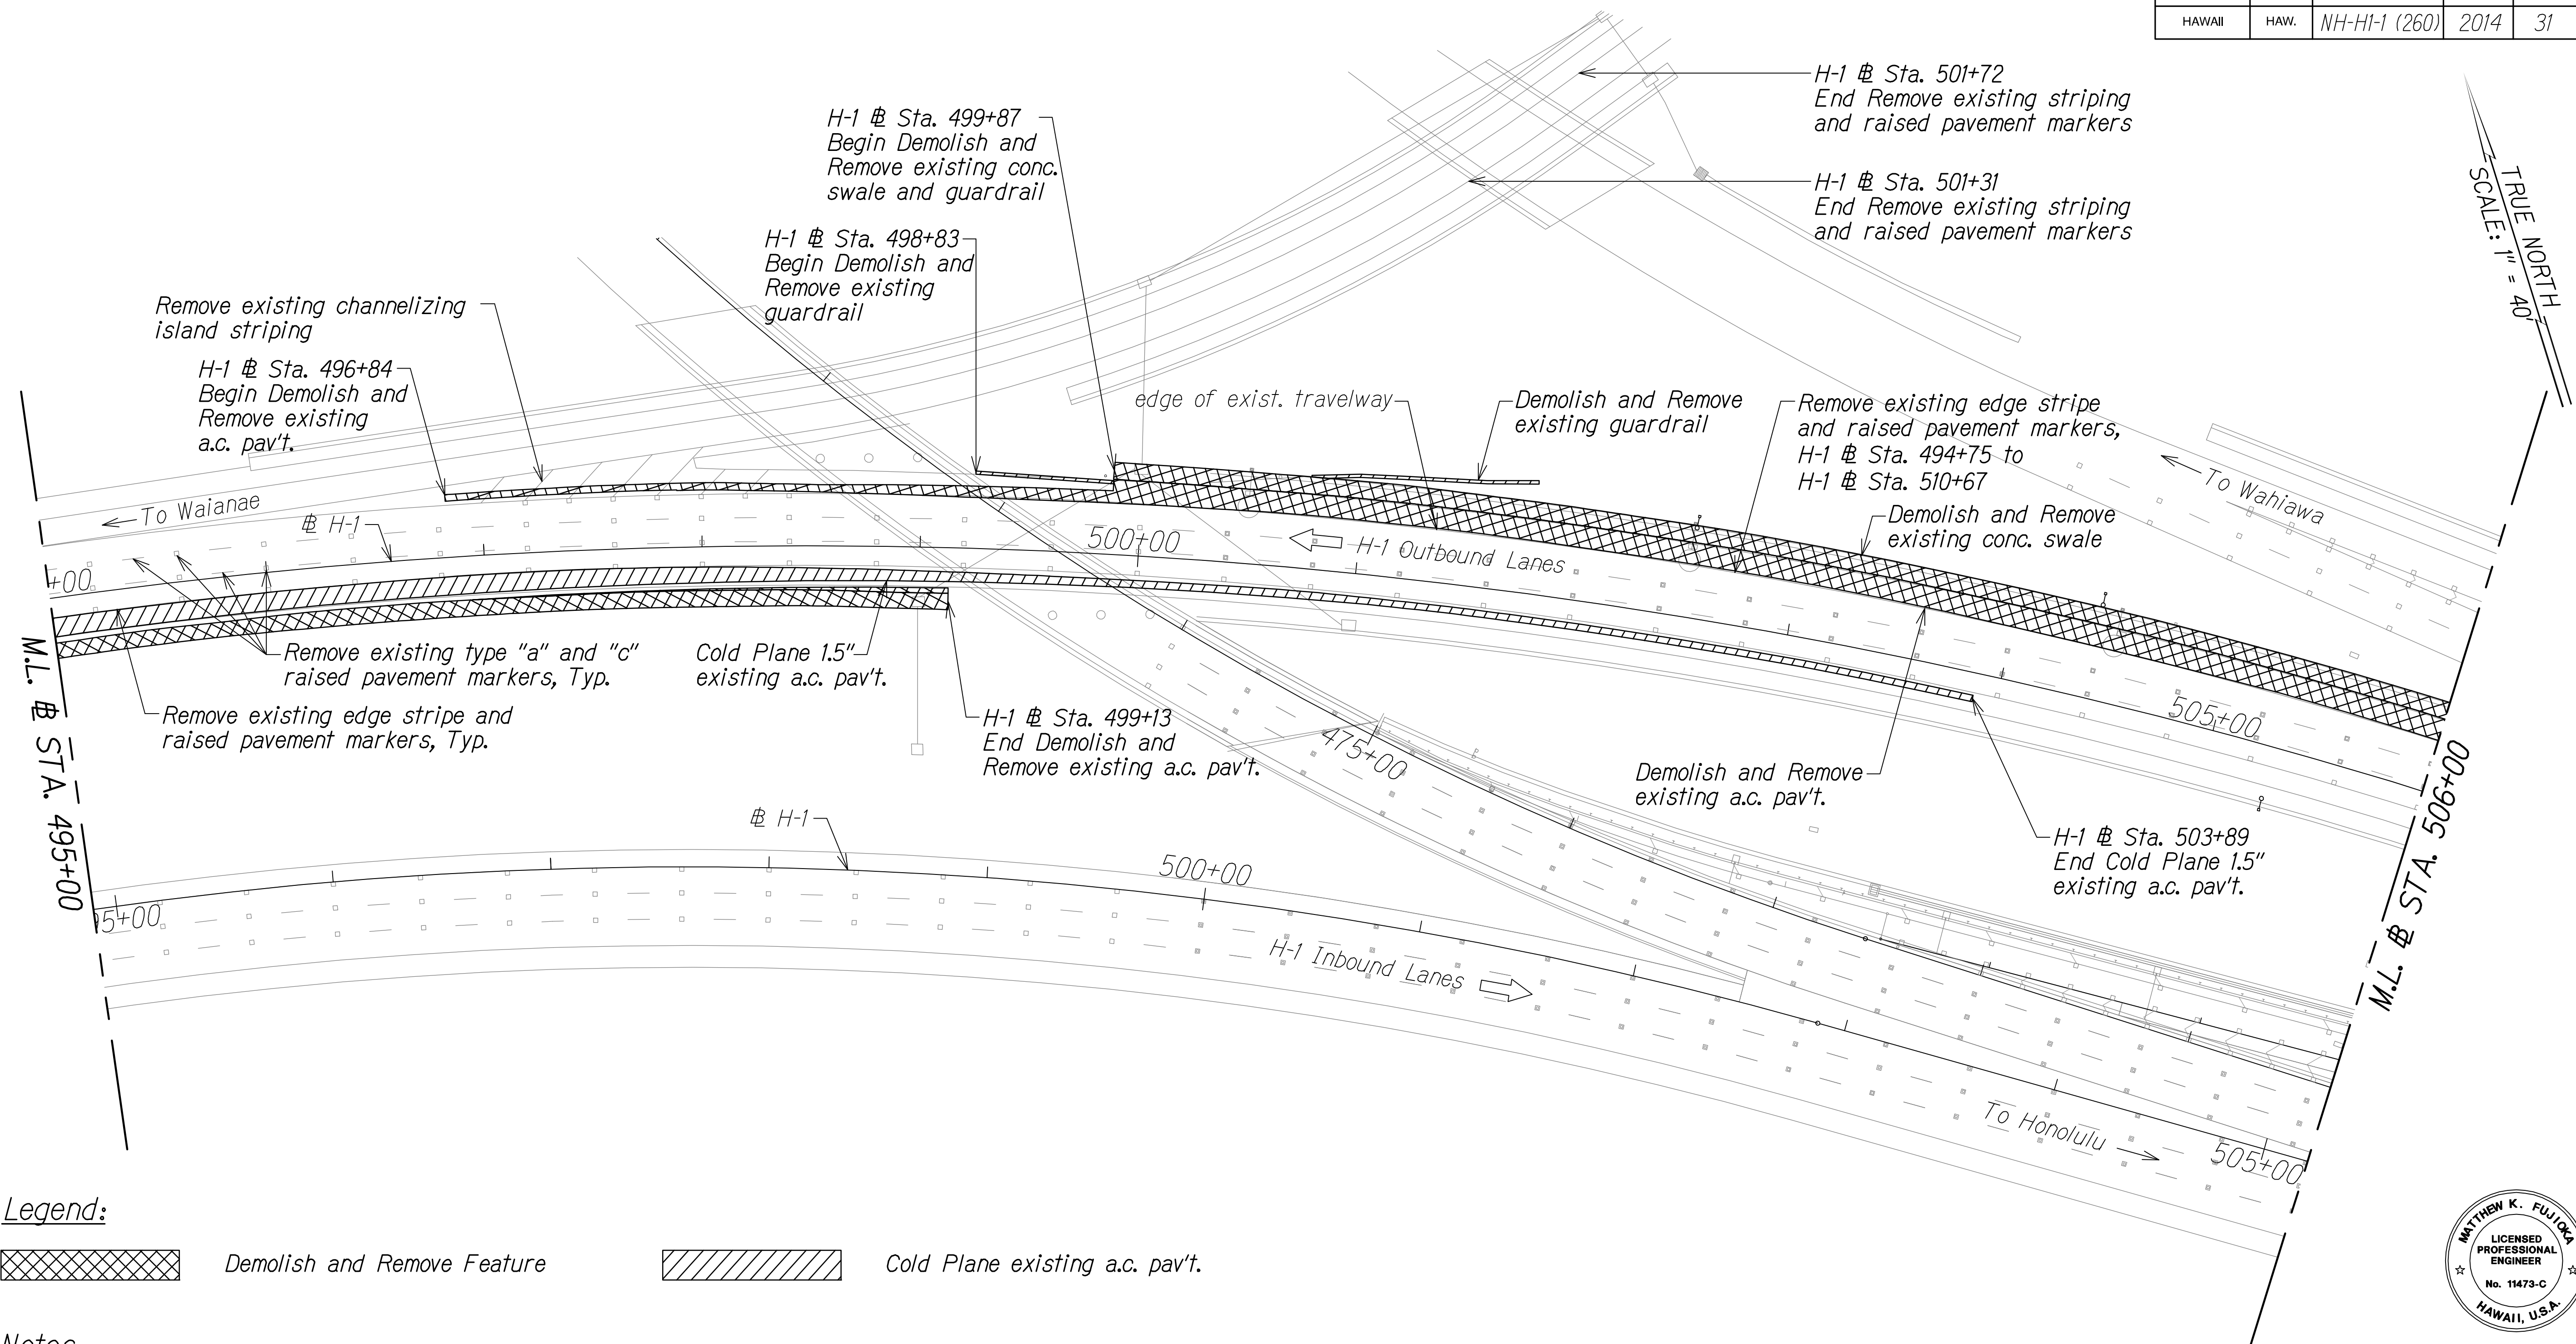


Legend:

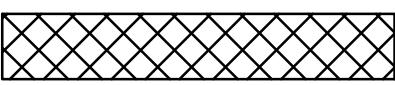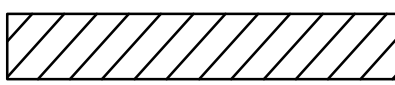-  Demolish and Remove Feature
-  Cold Plane existing a.c. pav't.

Notes:

1. At existing a.c. pavement demolition areas, demolish and remove existing a.c. pavement and base course. Subbase shall remain in-place.

Graphic Scale

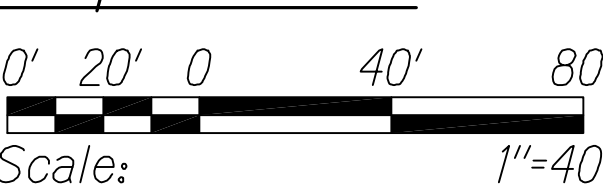

DEMOLITION PLAN
H-1 STA. 495+00 TO H-1 STA. 506+00
Scale: 1" = 40'

LEGEND FOR AS-BUILT POSTINGS

 Squiggly line for as-built deletion

 Double line for as-built deletion

Roadway Text for as-built posting



THIS WORK WAS PREPARED BY ME
OR UNDER MY SUPERVISION.
Matthew K. Fujitaka
WILSON OKAMOTO CORPORATION APRIL 30, 2018
LIC. EXP. DATE


STATE OF HAWAII
DEPARTMENT OF TRANSPORTATION
HIGHWAYS DIVISION

DEMOLITION PLAN

INTERSTATE ROUTE H-1
PM CONTRAFLOW LANE, PHASE 1 & 2
FEDERAL AID PROJECT NO. NH-HI-1 (260)
Scale: 1" = 40' Date: July, 2016

SHEET No DEM-05 OF 26 SHEETS

FED. ROAD DIST. NO.	STATE	FED. AID PROJ. NO.	FISCAL YEAR	SHEET NO.	TOTAL SHEETS
HAWAII	HAW.	NH-HI-1 (260)	2014	32	605

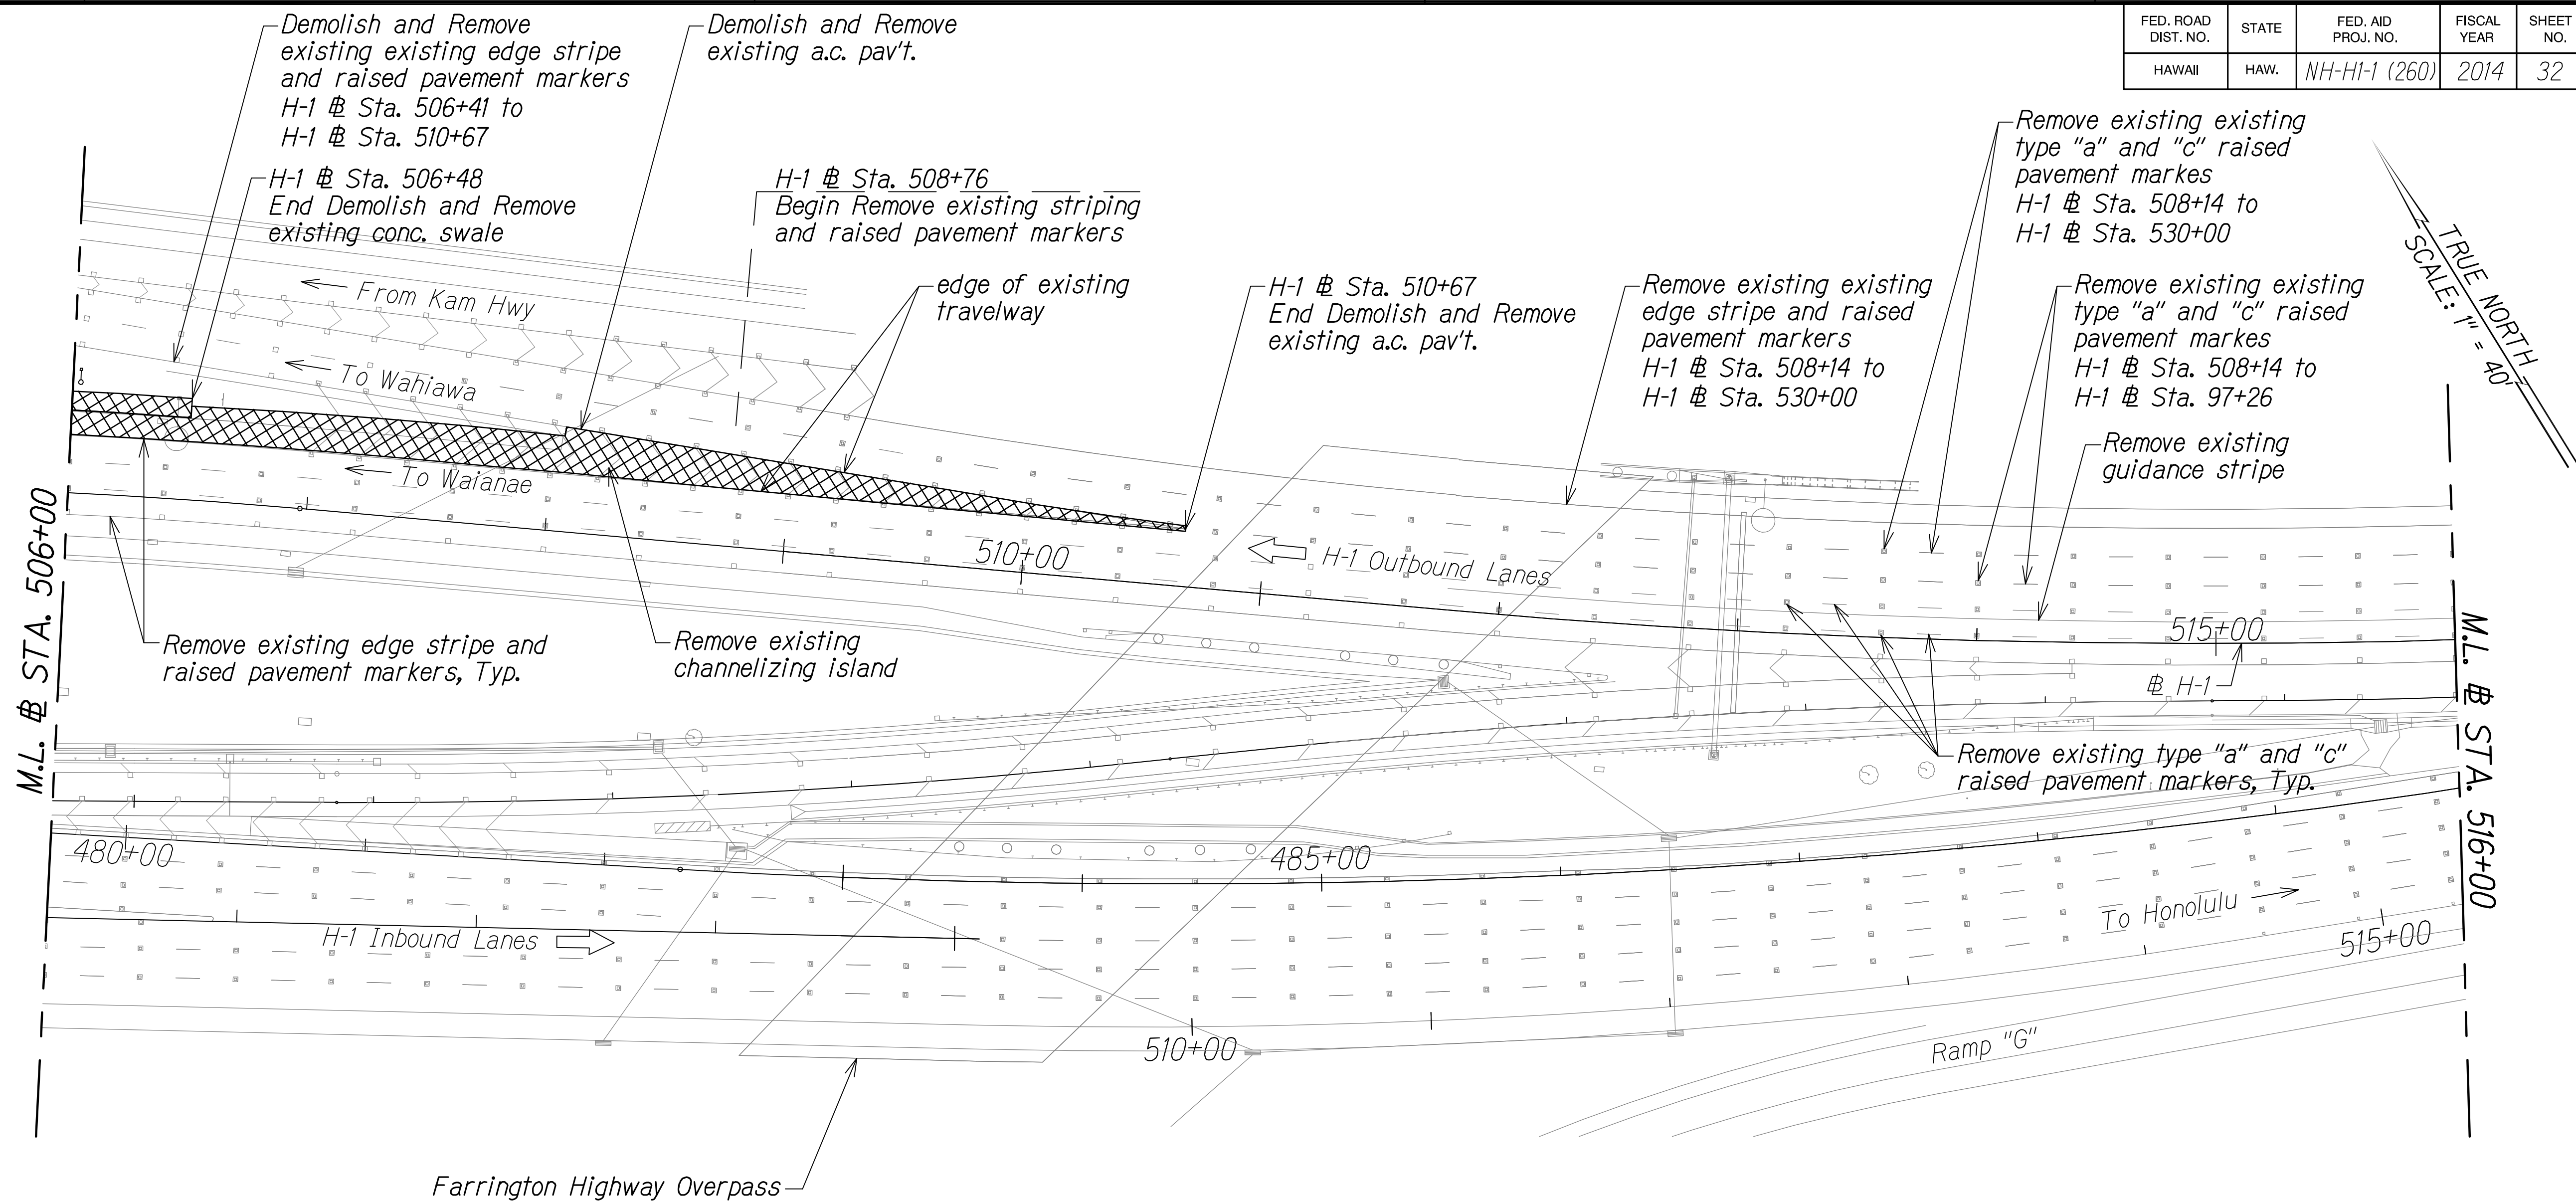

QC/QA REVIEW	100%	DATE	MARCH 23, 2014
BY		DESIGNED BY	
BY		DESIGNED BY	
BY		DESIGNED BY	
BY		DESIGNED BY	

ORIGINAL PLAN	DATE
NOTE BOOK	
NO.	


Legend:

 Demolish and Remove Feature

Notes:

1. At existing a.c. pavement demolition areas, demolish and remove existing a.c. pavement and base course. Subbase shall remain in-place.

Graphic Scale

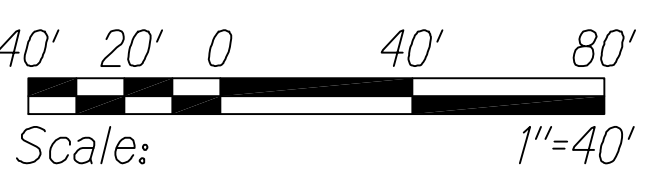

DEMOLITION PLAN
STA. 506+00 TO # STA. 516+00
Scale: 1" = 40'

LEGEND FOR AS-BUILT POSTINGS

 Squiggly line for as-built deletion

 Double line for as-built deletion

Roadway Text for as-built posting



THIS WORK WAS PREPARED BY ME OR UNDER MY SUPERVISION.

WILSON OKAMOTO CORPORATION APRIL 30, 2018 LIC. EXP. DATE

STATE OF HAWAII
DEPARTMENT OF TRANSPORTATION
HIGHWAYS DIVISION


DEMOLITION PLAN

INTERSTATE ROUTE H-1
PM CONTRAFLOW LANE, PHASE 1 # 2
FEDERAL AID PROJECT NO. NH-HI-1 (260)
Scale: 1" = 40' Date: July, 2016


SHEET No. DEM-06 OF 26 SHEETS

FED. ROAD DIST. NO.	STATE	FED. AID PROJ. NO.	FISCAL YEAR	SHEET NO.	TOTAL SHEETS
HAWAII	HAW.	NH-HI-1 (260)	2014	33	605

TRUE NORTH
SCALE: 1" = 40'

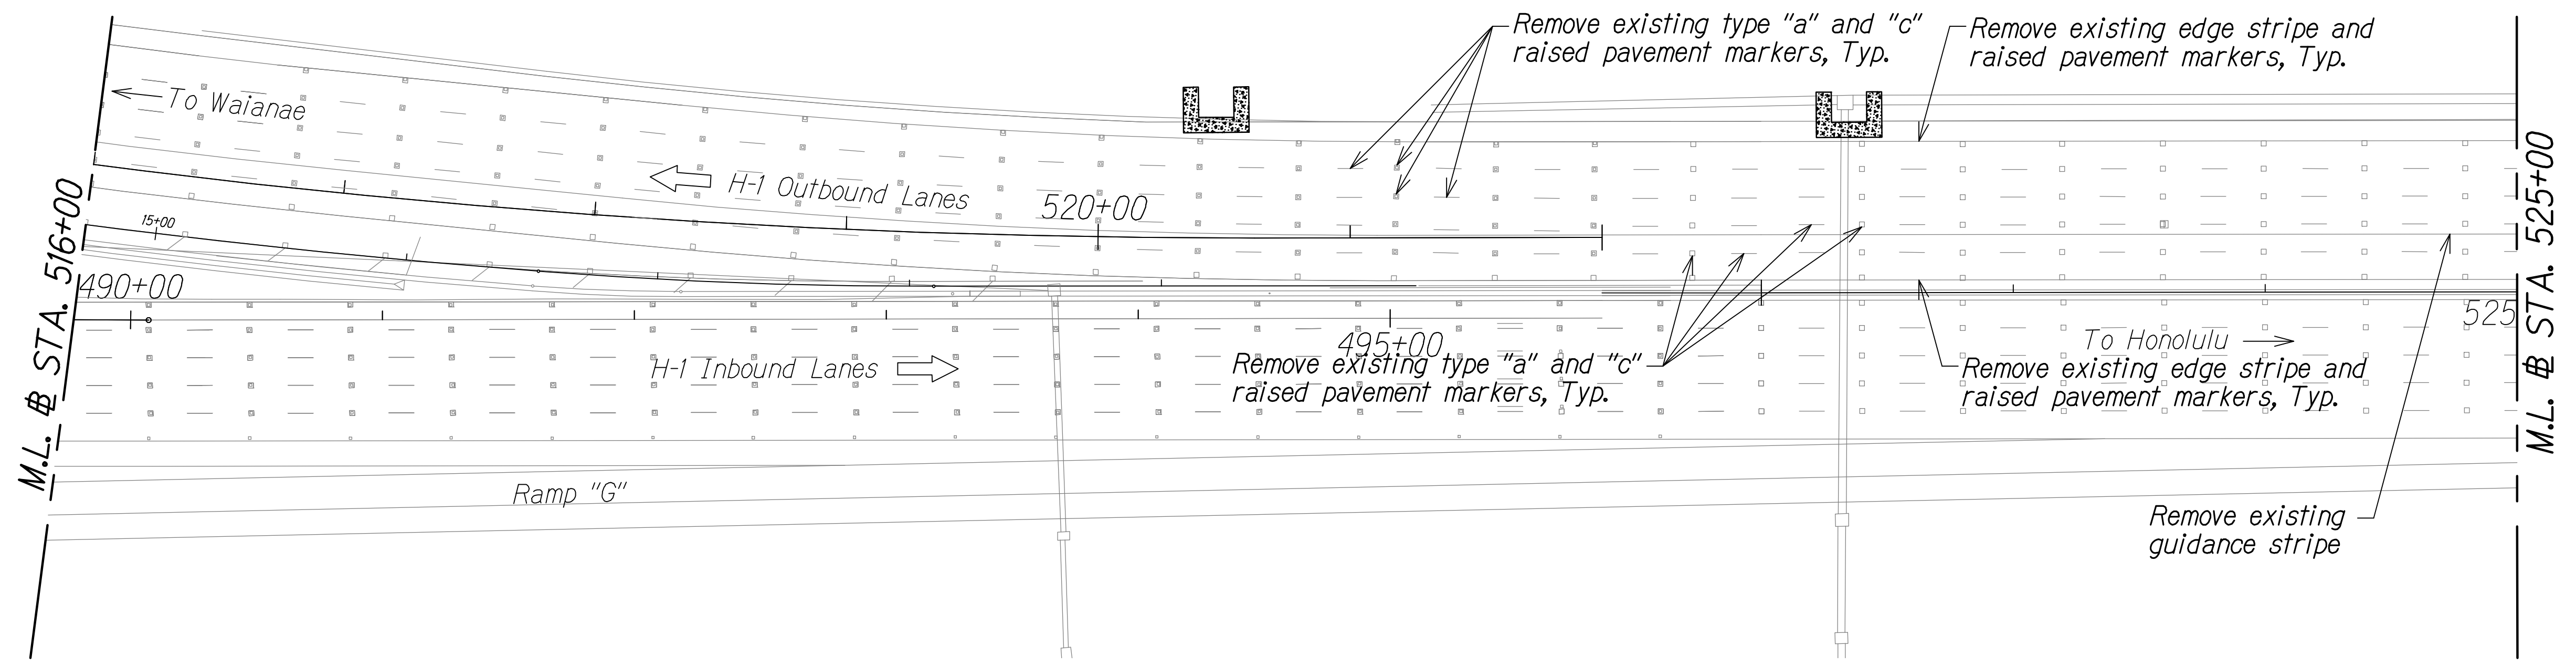

Notes:
1. Remove all outbound lane existing striping and raised pavement markers between matchlines as noted.

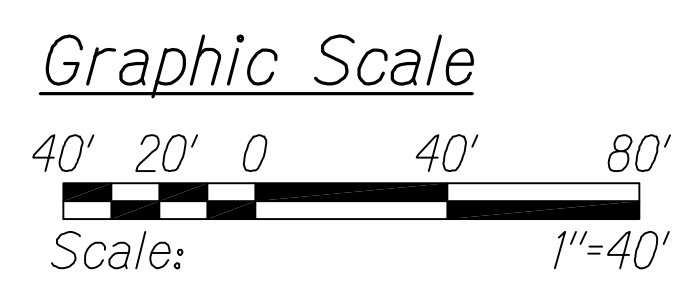

DEMOLITION PLAN
STA. 516+00 TO # STA. 525+00
Scale: 1" = 40'

LEGEND FOR AS-BUILT POSTINGS

Squiggly line for as-built deletion

Double line for as-built deletion

Roadway Text for as-built posting



THIS WORK WAS PREPARED BY ME OR UNDER MY SUPERVISION.
Matthew K. Fujitaka
WILSON OKAMOTO CORPORATION APRIL 30, 2016 LIC. EXP. DATE


STATE OF HAWAII
DEPARTMENT OF TRANSPORTATION
HIGHWAYS DIVISION

DEMOLITION PLAN

INTERSTATE ROUTE H-1
PM CONTRAFLOW LANE, PHASE 1 # 2
FEDERAL AID PROJECT NO. NH-HI-1 (260)
Scale: 1" = 40' Date: July, 2016

SHEET No. DEM-07 OF 26 SHEETS


FED. ROAD DIST. NO.	STATE	FED. AID PROJ. NO.	FISCAL YEAR	SHEET NO.	TOTAL SHEETS
HAWAII	HAW.	NH-HI-1 (260)	2014	34	605

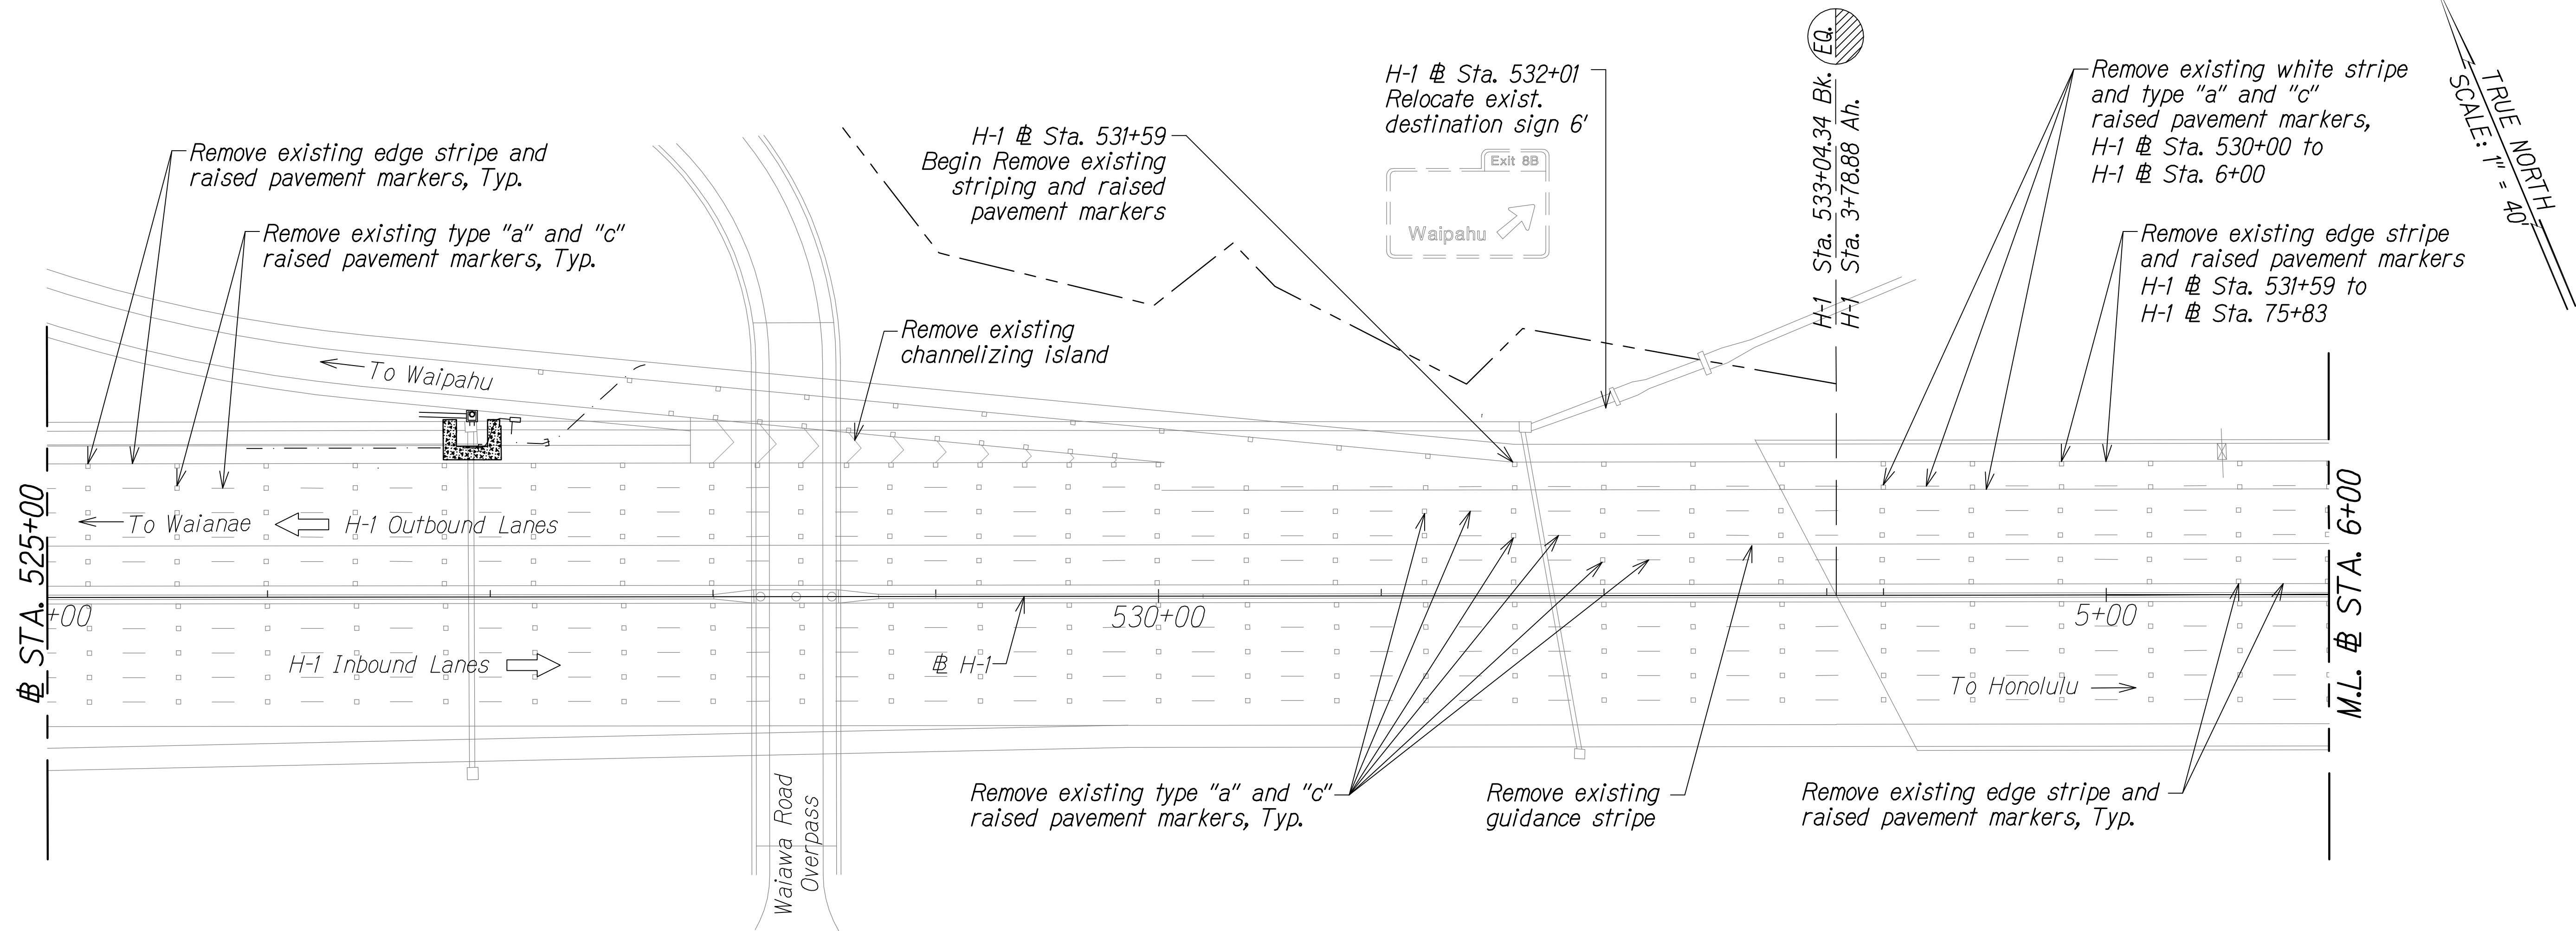

Notes:

1. Remove all outbound lane existing striping and raised pavement markers between matchlines as noted.

Graphic Scale

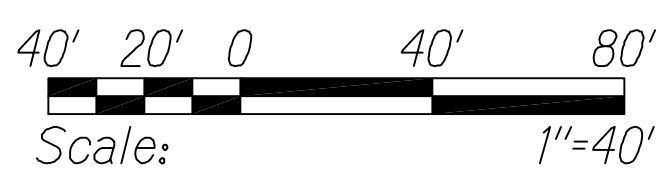

DEMOLITION PLAN
Sta. 525+00 TO Sta. 6+00
Scale: 1" = 40'

LEGEND FOR AS-BUILT POSTINGS

- ~~~~~ Squiggly line for as-built deletion
- ==00.00== Double line for as-built deletion
- Roadway Text for as-built posting



THIS WORK WAS PREPARED BY ME OR UNDER MY SUPERVISION.
Matthew K. Fujitaka
WILSON OKAMOTO CORPORATION APRIL 30, 2016 LIC. EXP. DATE

STATE OF HAWAII
DEPARTMENT OF TRANSPORTATION
HIGHWAYS DIVISION


DEMOLITION PLAN

INTERSTATE ROUTE H-1
PM CONTRAFLOW LANE, PHASE 1 & 2
FEDERAL AID PROJECT NO. NH-HI-1 (260)
Scale: 1" = 40' Date: July, 2016

SHEET No. DEM-08 OF 26 SHEETS

FED. ROAD DIST. NO.	STATE	FED. AID PROJ. NO.	FISCAL YEAR	SHEET NO.	TOTAL SHEETS
HAWAII	HAW.	NH-H1-1 (260)	2014	35	605


TRUE NORTH
SCALE: 1" = 40'

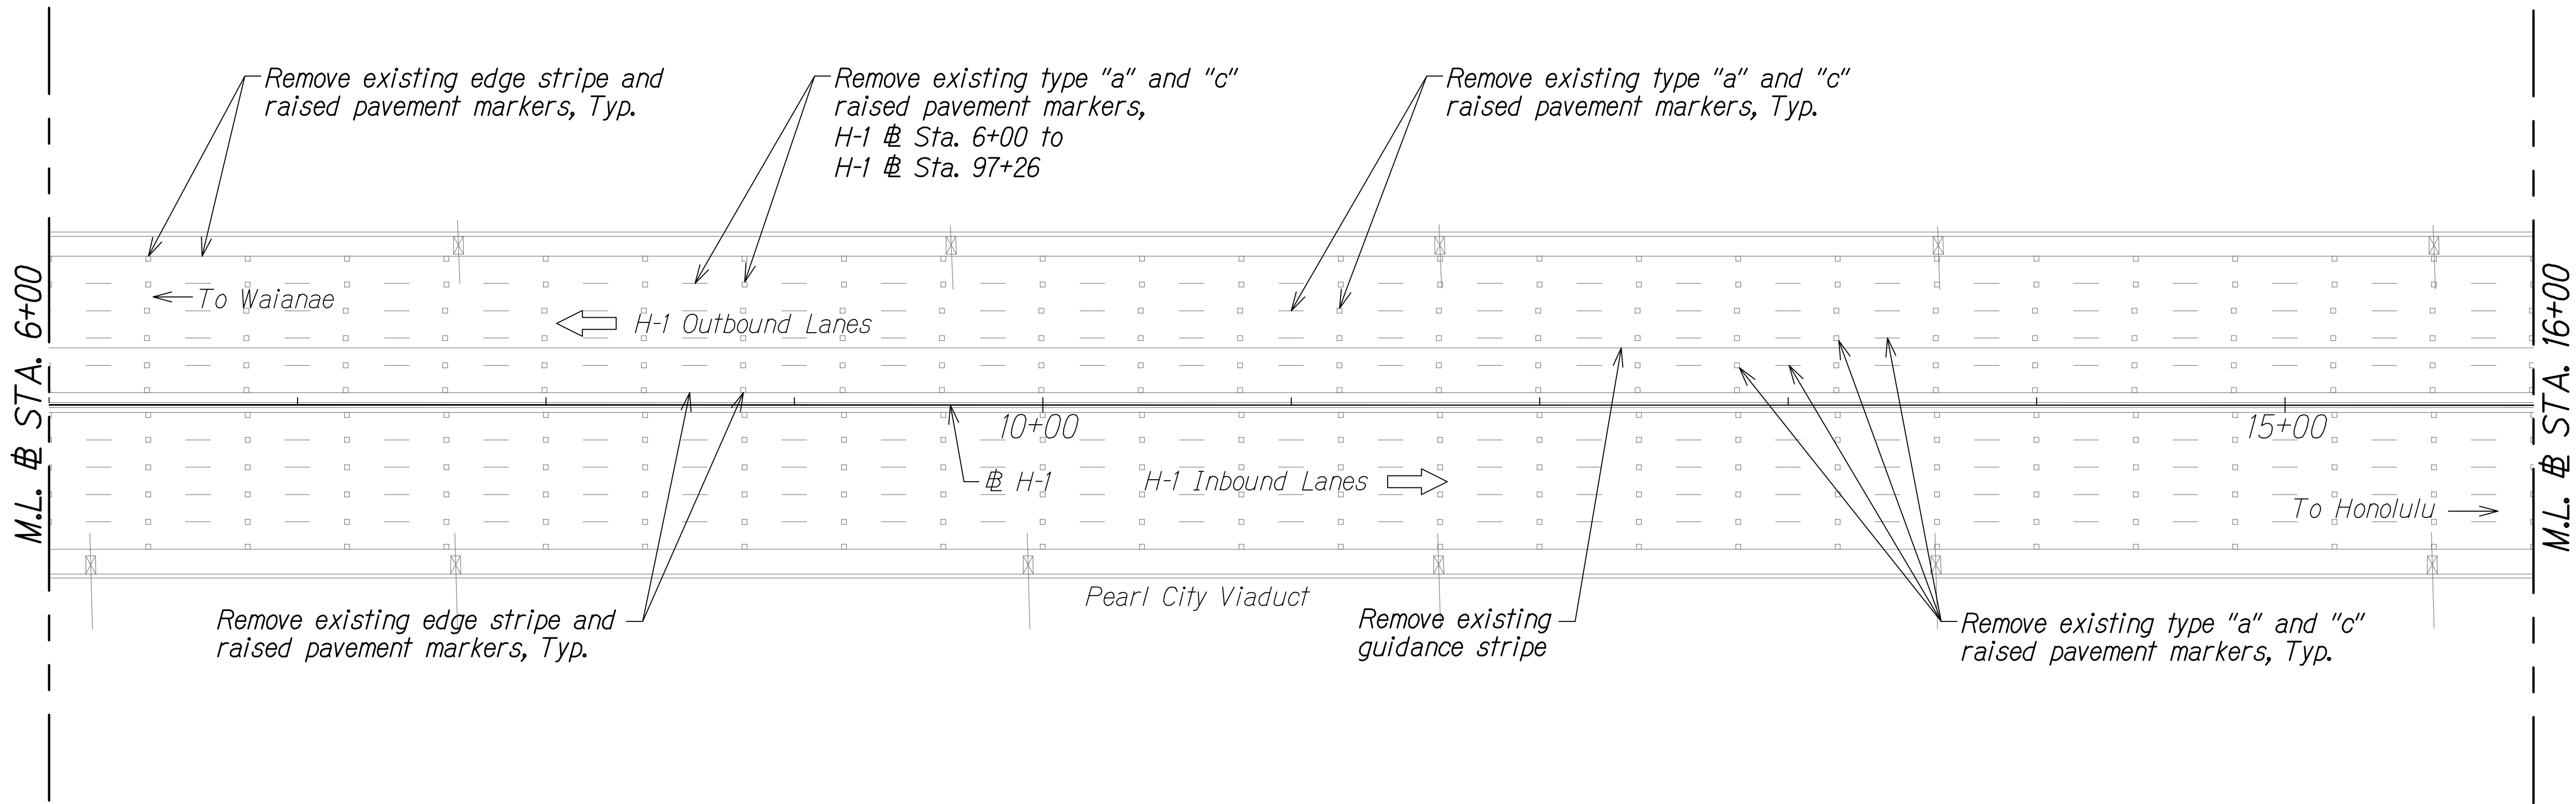

QC/QA REVIEW	100%	DATE	MARCH 23, 2014
BY		BY	
BY		BY	
BY		BY	

SURVEY PLOTTED BY	DATE
DESIGNED BY	
DESIGNED BY	
QUANTITIES BY	
CHECKED BY	

Notes:
1. Remove all outbound lane existing striping and raised pavement markers between matchlines as noted.

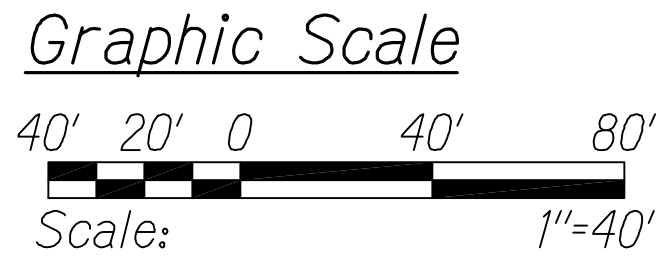

DEMOLITION PLAN
STA. 6+00 TO # STA. 16+00
Scale: 1" = 40'

LEGEND FOR AS-BUILT POSTINGS	
	Squiggly line for as-built deletion
	Double line for as-built deletion
Roadway	Text for as-built posting



THIS WORK WAS PREPARED BY ME OR UNDER MY SUPERVISION.
Matthew K. Fujioka
WILSON OKAMOTO CORPORATION APRIL 30, 2016 LIC. EXP. DATE


STATE OF HAWAII
DEPARTMENT OF TRANSPORTATION
HIGHWAYS DIVISION

DEMOLITION PLAN

INTERSTATE ROUTE H-1
PM CONTRAFLOW LANE, PHASE 1 & 2
FEDERAL AID PROJECT NO. NH-H1-1 (260)
Scale: 1" = 40' Date: July, 2016

FED. ROAD DIST. NO.	STATE	FED. AID PROJ. NO.	FISCAL YEAR	SHEET NO.	TOTAL SHEETS
HAWAII	HAW.	NH-HI-1 (260)	2014	36	605


TRUE NORTH
SCALE: 1" = 40'

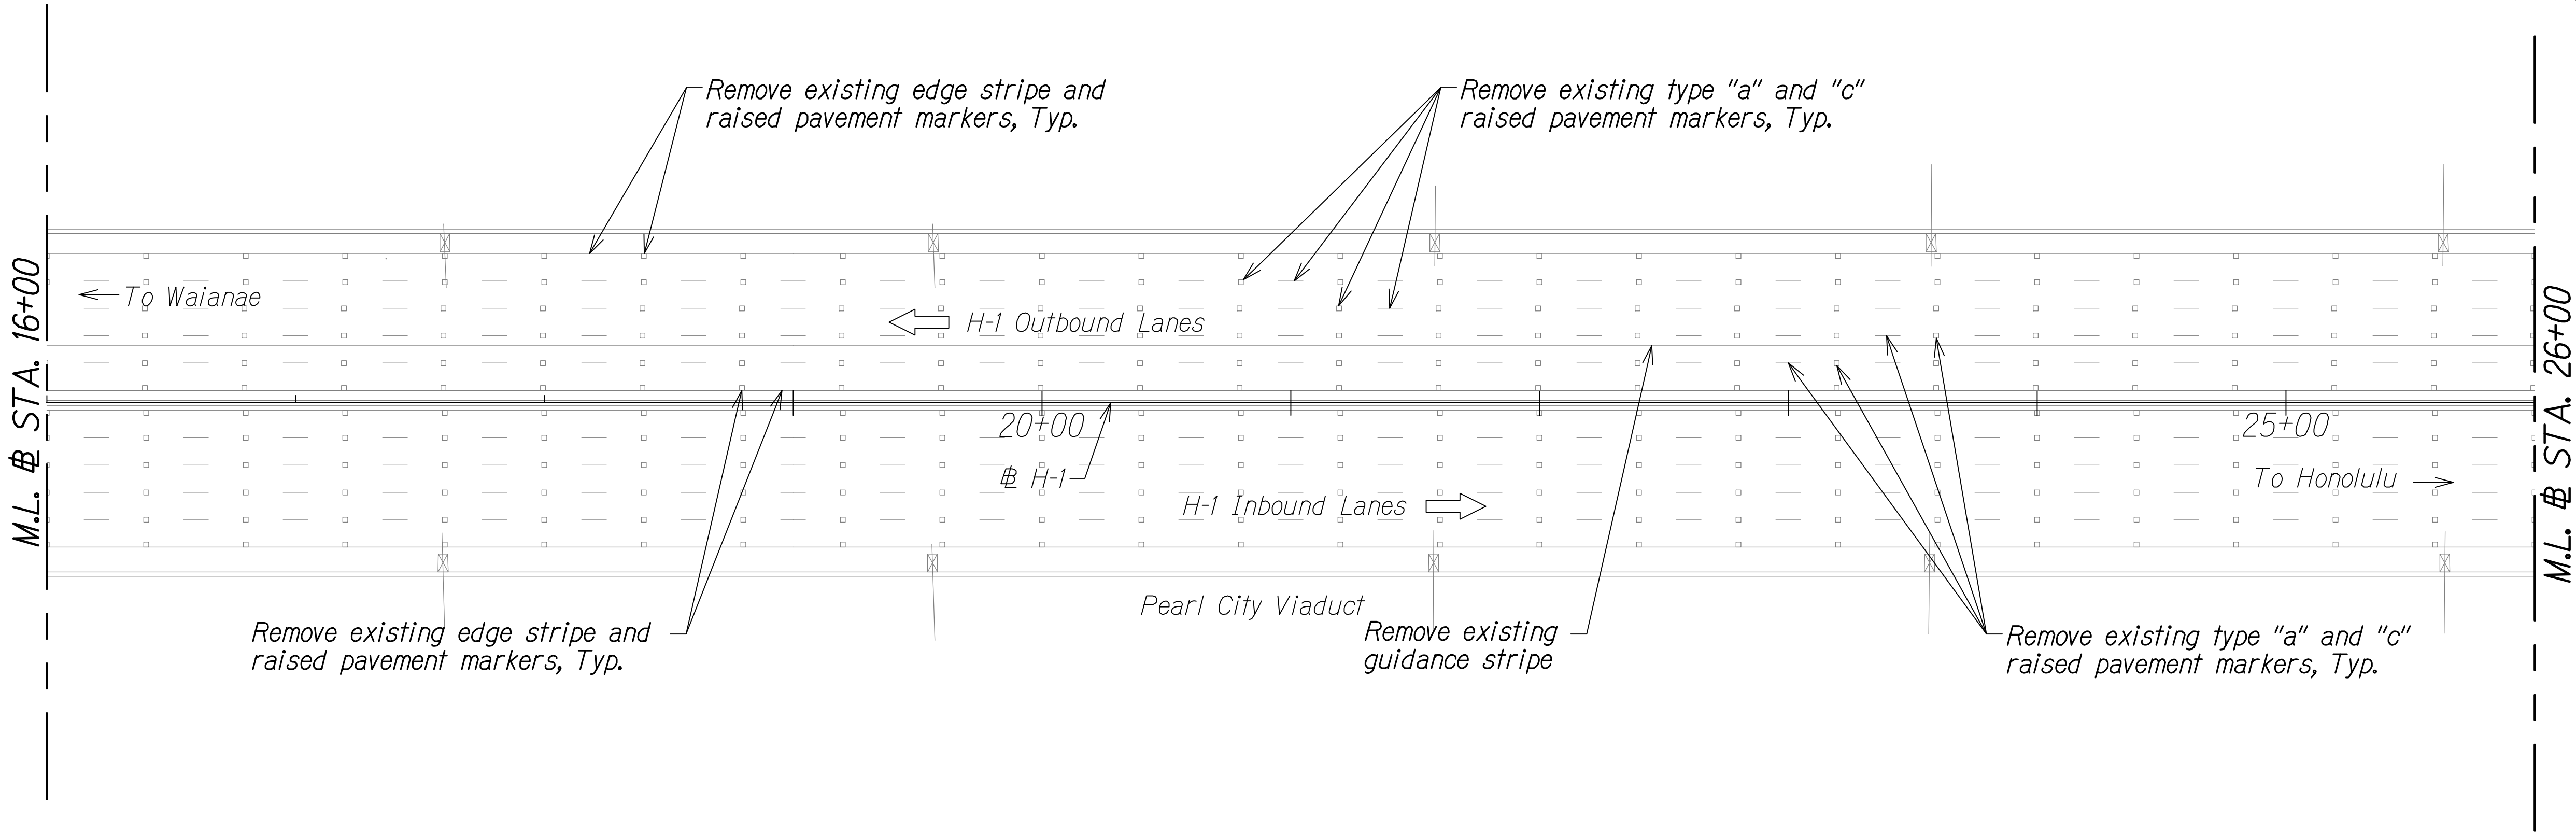

QC/QA REVIEW	100%	DATE MARCH 23, 2014
BY		
BY		
BY		
BY		

ORIGINAL PLAN	SURVEY PLOTTED BY	DATE
NOTE BOOK	DESIGNED BY	
No.	QUANTITIES BY	
	CHECKED BY	


- Notes:
1. Remove all outbound lane existing striping and raised pavement markers between matchlines as noted.

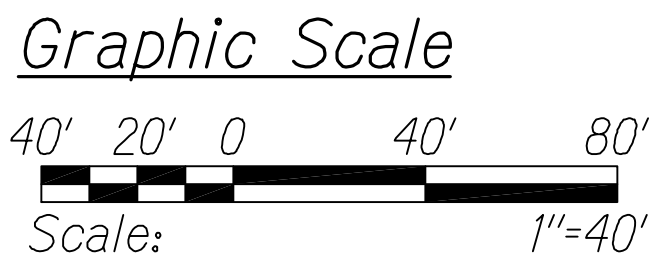

DEMOLITION PLAN
STA. 16+00 TO # STA. 26+00
Scale: 1" = 40'

LEGEND FOR AS-BUILT POSTINGS

- ~~~~~ Squiggly line for as-built deletion
- ==00.00== Double line for as-built deletion
- Roadway Text for as-built posting

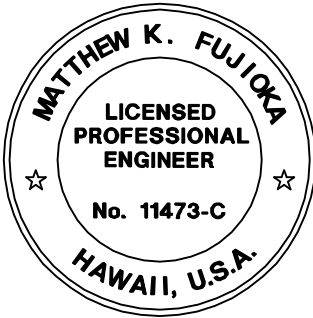

THIS WORK WAS PREPARED BY ME
OR UNDER MY SUPERVISION.
Matthew K. Fujioka
WILSON OKAMOTO CORPORATION APRIL 30, 2018 LIC. EXP. DATE

STATE OF HAWAII
DEPARTMENT OF TRANSPORTATION
HIGHWAYS DIVISION


DEMOLITION PLAN

INTERSTATE ROUTE H-1
PM CONTRAFLOW LANE, PHASE 1 & 2
FEDERAL AID PROJECT NO. NH-HI-1 (260)
Scale: 1" = 40' Date: July, 2016

SHEET No. DEM-10 OF 26 SHEETS

FED. ROAD DIST. NO.	STATE	FED. AID PROJ. NO.	FISCAL YEAR	SHEET NO.	TOTAL SHEETS
HAWAII	HAW.	NH-HI-1 (260)	2014	37	605


TRUE NORTH
SCALE: 1" = 40'

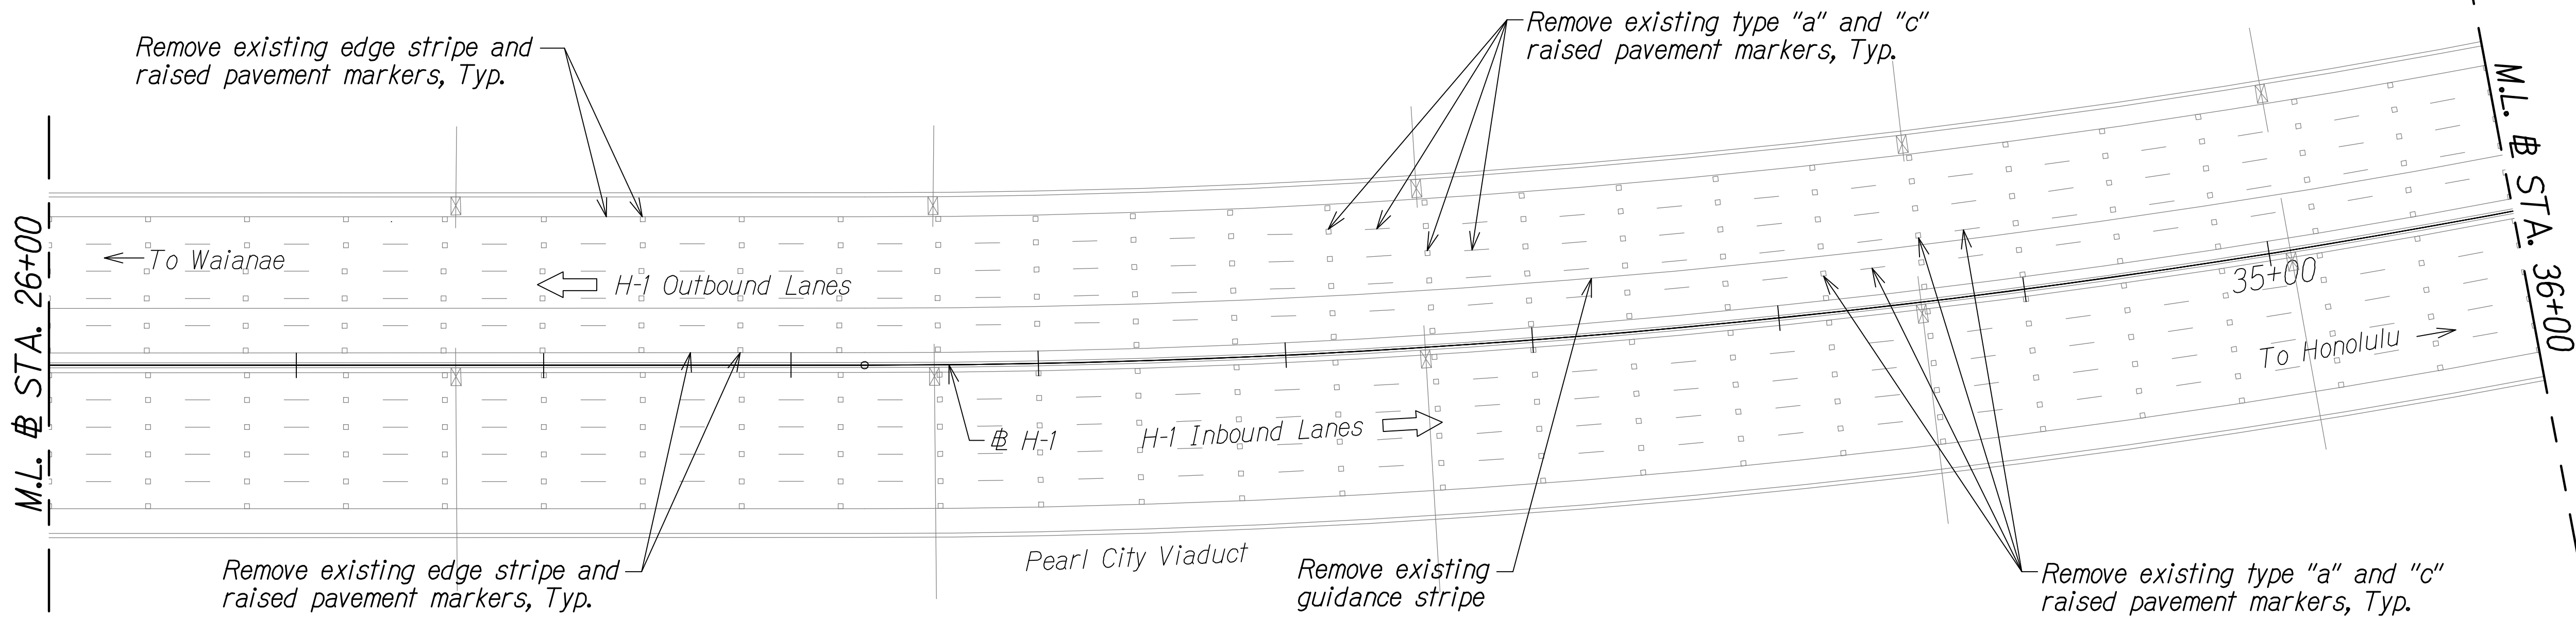

QC/QA REVIEW	100%	DATE	MARCH 23, 2017
BY		DESIGNED BY	
BY		DESIGNED BY	
BY		DESIGNED BY	
BY		DESIGNED BY	

ORIGINAL PLAN	DATE
NOTED BY	
DESIGNED BY	
QUANTITIES BY	
CHECKED BY	

Notes:
1. Remove all outbound lane existing striping and raised pavement markers between matchlines as noted.

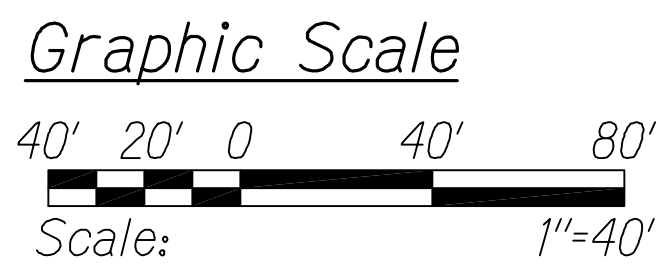

DEMOLITION PLAN
STA. 26+00 TO # STA. 36+00
Scale: 1" = 40'

LEGEND FOR
AS-BUILT POSTINGS

~~~~~ Squiggly line for as-built deletion

==00.00== Double line for as-built deletion

Roadway Text for as-built posting



THIS WORK WAS PREPARED BY ME  
OR UNDER MY SUPERVISION.  
*Matthew K. Fujitaka*  
WILSON OKAMOTO CORPORATION APRIL 30, 2016 LIC. EXP. DATE

STATE OF HAWAII  
DEPARTMENT OF TRANSPORTATION  
HIGHWAYS DIVISION


DEMOLITION PLAN

INTERSTATE ROUTE H-1  
PM CONTRAFLOW LANE, PHASE 1 & 2  
FEDERAL AID PROJECT NO. NH-HI-1 (260)  
Scale: 1" = 40' Date: July, 2016

SHEET No. DEM-11 OF 26 SHEETS

| FED. ROAD DIST. NO. | STATE | FED. AID PROJ. NO. | FISCAL YEAR | SHEET NO. | TOTAL SHEETS |
|---------------------|-------|--------------------|-------------|-----------|--------------|
| HAWAII              | HAW.  | NH-HI-1 (260)      | 2014        | 38        | 605          |


TRUE NORTH  
SCALE: 1" = 40'

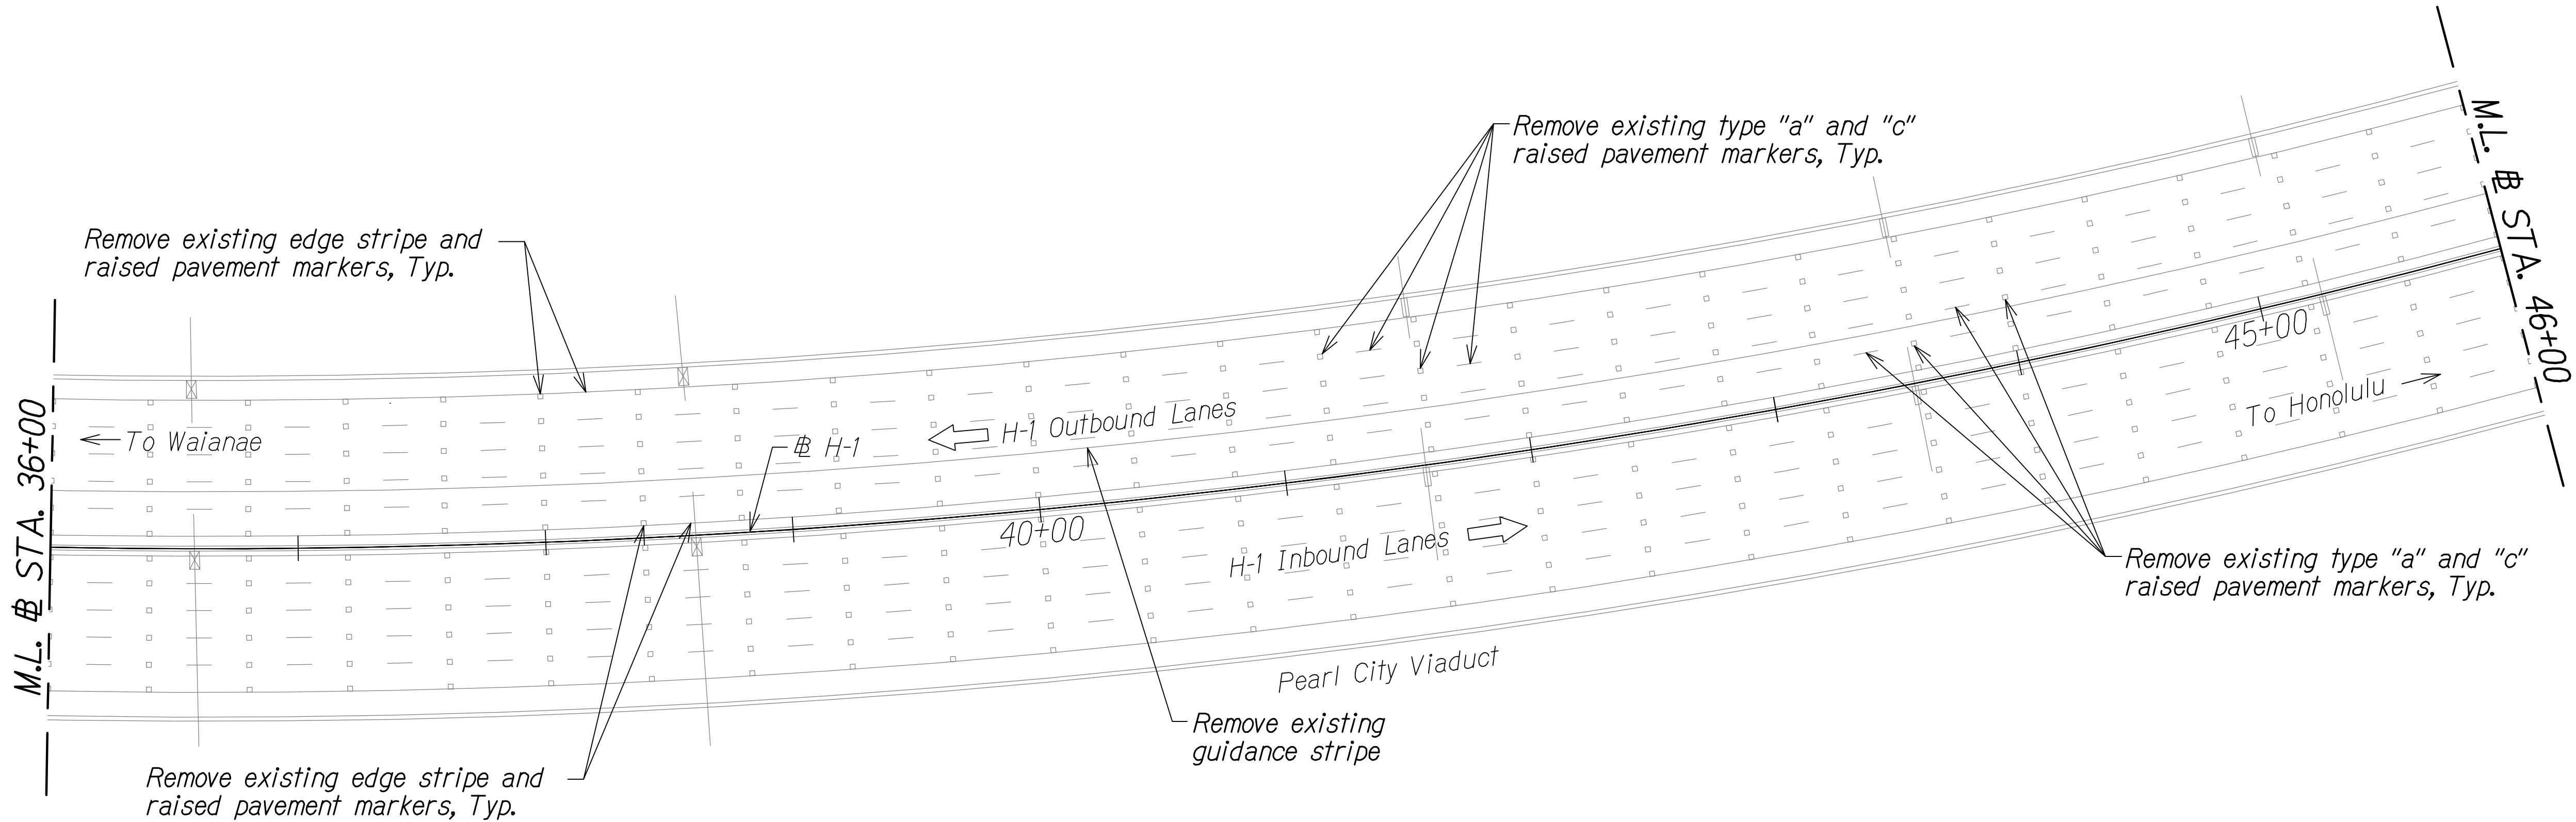

**Notes:**

1. Remove all outbound lane existing striping and raised pavement markers between matchlines as noted.

**Graphic Scale**

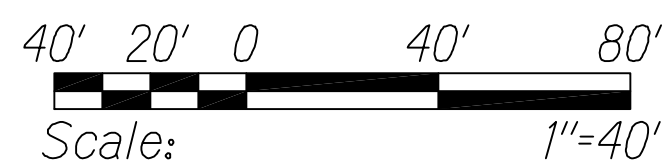

**DEMOLITION PLAN**  
**± STA. 36+00 TO ± STA. 46+00**  
Scale: 1" = 40'

| LEGEND FOR AS-BUILT POSTINGS |                                     |
|------------------------------|-------------------------------------|
|                              | Squiggly line for as-built deletion |
|                              | Double line for as-built deletion   |
| Roadway                      | Text for as-built posting           |



THIS WORK WAS PREPARED BY ME  
OR UNDER MY SUPERVISION.  
*Matthew K. Fujitaka*  
WILSON OKAMOTO CORPORATION APRIL 30, 2016  
LIC. EXP. DATE

STATE OF HAWAII  
DEPARTMENT OF TRANSPORTATION  
HIGHWAYS DIVISION


**DEMOLITION PLAN**

INTERSTATE ROUTE H-1  
PM CONTRAFLOW LANE, PHASE 1 & 2  
FEDERAL AID PROJECT NO. NH-HI-1 (260)  
Scale: 1" = 40' Date: July, 2016

SHEET No. DEM-12 OF 26 SHEETS

"AS-BUILT"

| FED. ROAD DIST. NO. | STATE | FED. AID PROJ. NO. | FISCAL YEAR | SHEET NO. | TOTAL SHEETS |
|---------------------|-------|--------------------|-------------|-----------|--------------|
| HAWAII              | HAW.  | NH-HI-1 (260)      | 2014        | 39        | 605          |

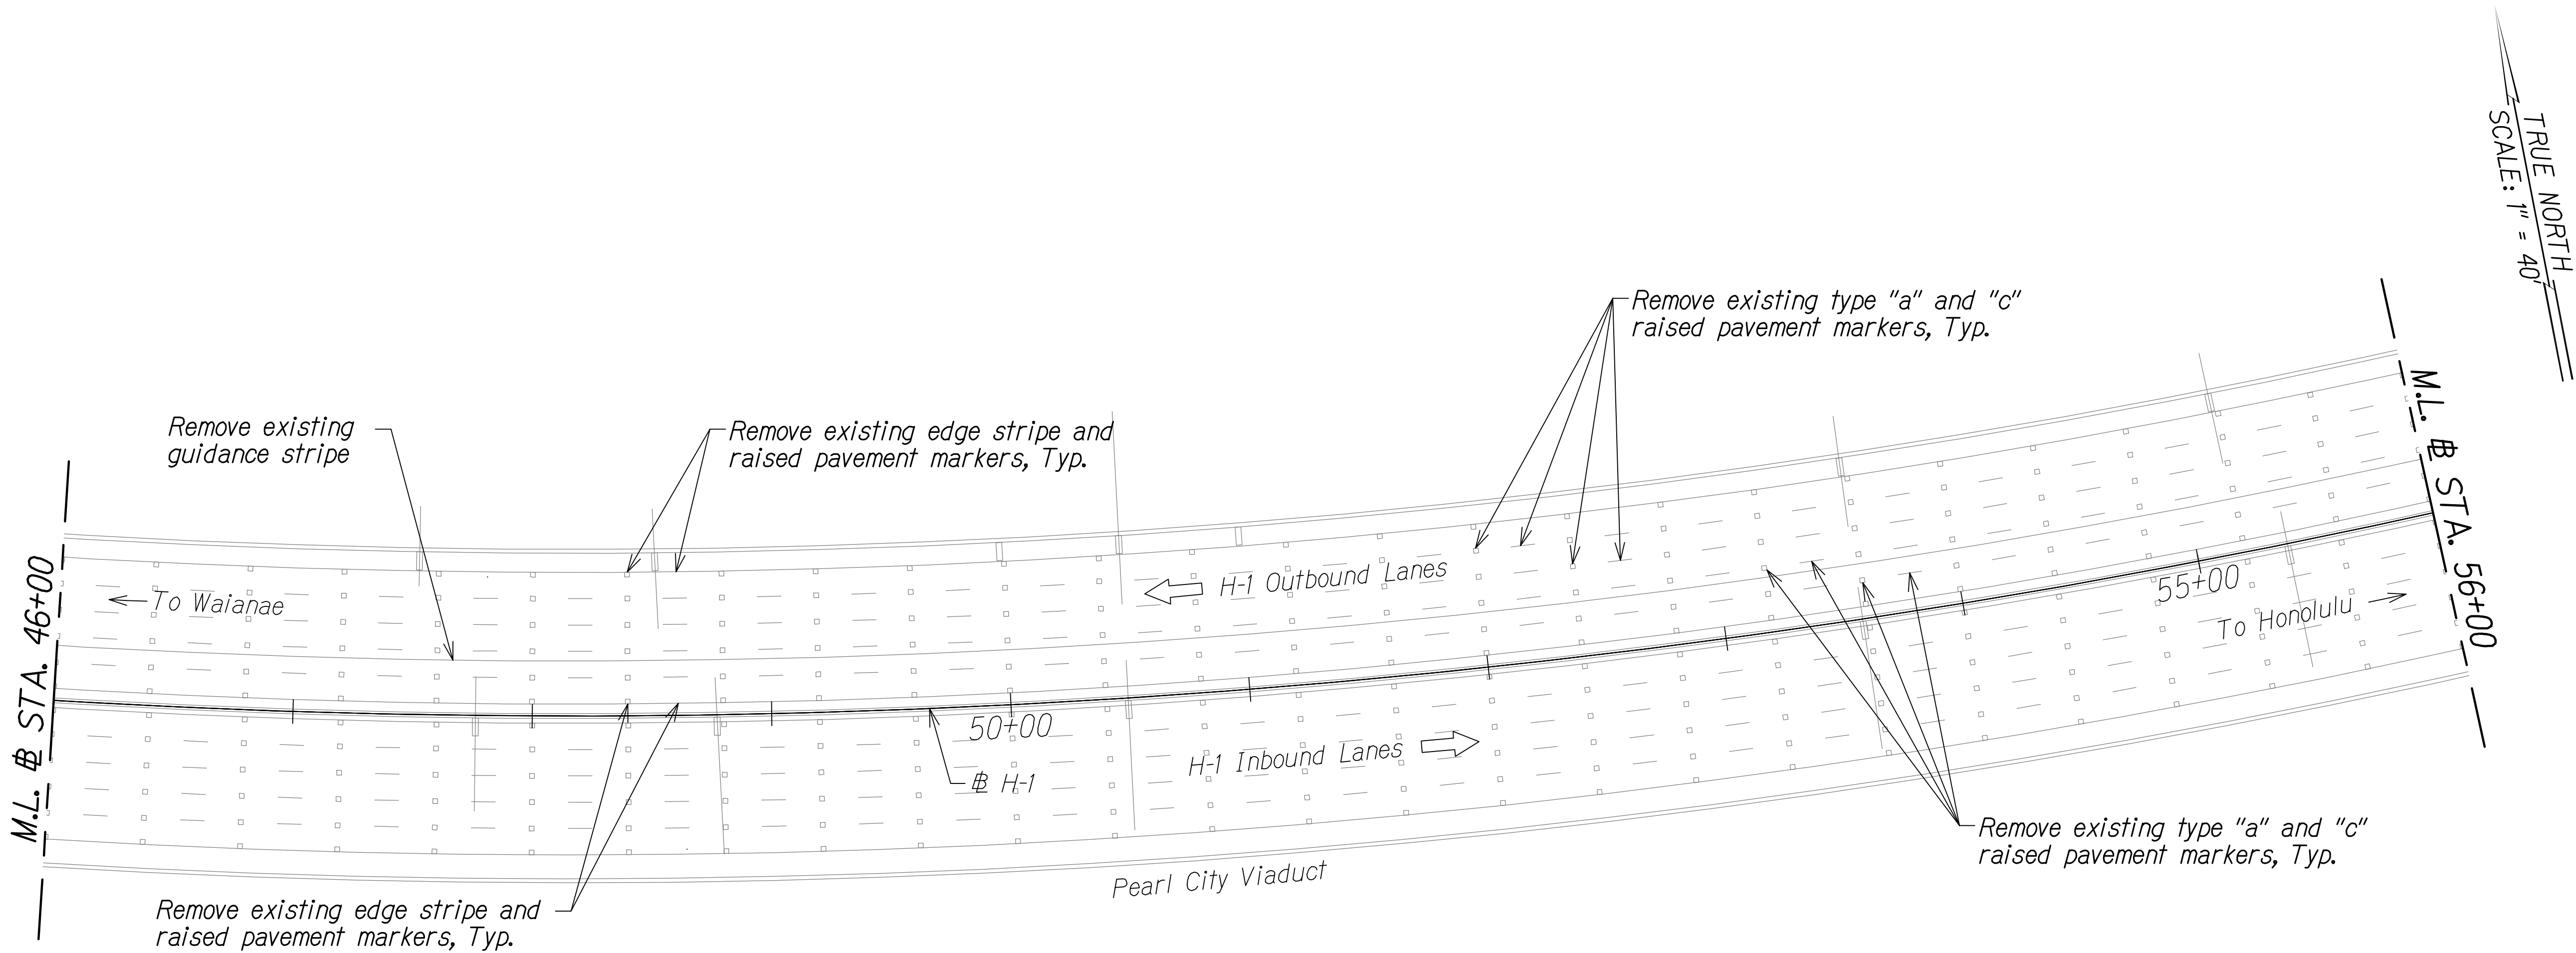


|              |      |      |                |
|--------------|------|------|----------------|
| QC/QA REVIEW | 100% | DATE | MARCH 23, 2017 |
| BY           |      | BY   |                |
| BY           |      | BY   |                |
| BY           |      | BY   |                |

|                   |      |
|-------------------|------|
| SURVEY PLOTTED BY | DATE |
| DESIGNED BY       |      |
| DESIGNED BY       |      |
| QUANTITIES BY     |      |
| CHECKED BY        |      |

|               |     |
|---------------|-----|
| ORIGINAL PLAN | No. |
| NOTE BOOK     |     |

Notes:  
1. Remove all outbound lane existing striping and raised pavement markers between matchlines as noted.

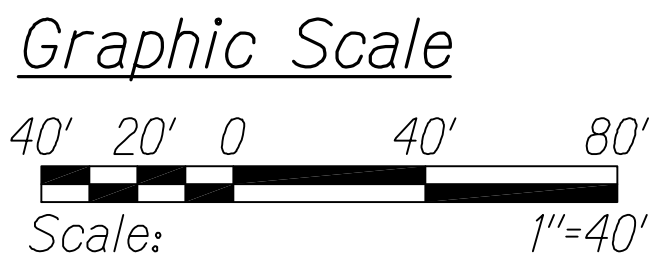

DEMOLITION PLAN  
# STA. 46+00 TO # STA. 56+00  
Scale: 1" = 40'

**LEGEND FOR AS-BUILT POSTINGS**

~~~~~ Squiggly line for as-built deletion

==00.00== Double line for as-built deletion

Roadway Text for as-built posting



THIS WORK WAS PREPARED BY ME OR UNDER MY SUPERVISION.
Matthew K. Fujitaka
WILSON OKAMOTO CORPORATION APRIL 30, 2018 LIC. EXP. DATE


STATE OF HAWAII
DEPARTMENT OF TRANSPORTATION
HIGHWAYS DIVISION

DEMOLITION PLAN


INTERSTATE ROUTE H-1
PM CONTRAFLOW LANE, PHASE 1 & 2
FEDERAL AID PROJECT NO. NH-HI-1 (260)
Scale: 1" = 40' Date: July, 2016

SHEET No. DEM-13 OF 26 SHEETS

| FED. ROAD DIST. NO. | STATE | FED. AID PROJ. NO. | FISCAL YEAR | SHEET NO. | TOTAL SHEETS |
|---------------------|-------|--------------------|-------------|-----------|--------------|
| HAWAII | HAW. | NH-HI-1 (260) | 2014 | 40 | 605 |

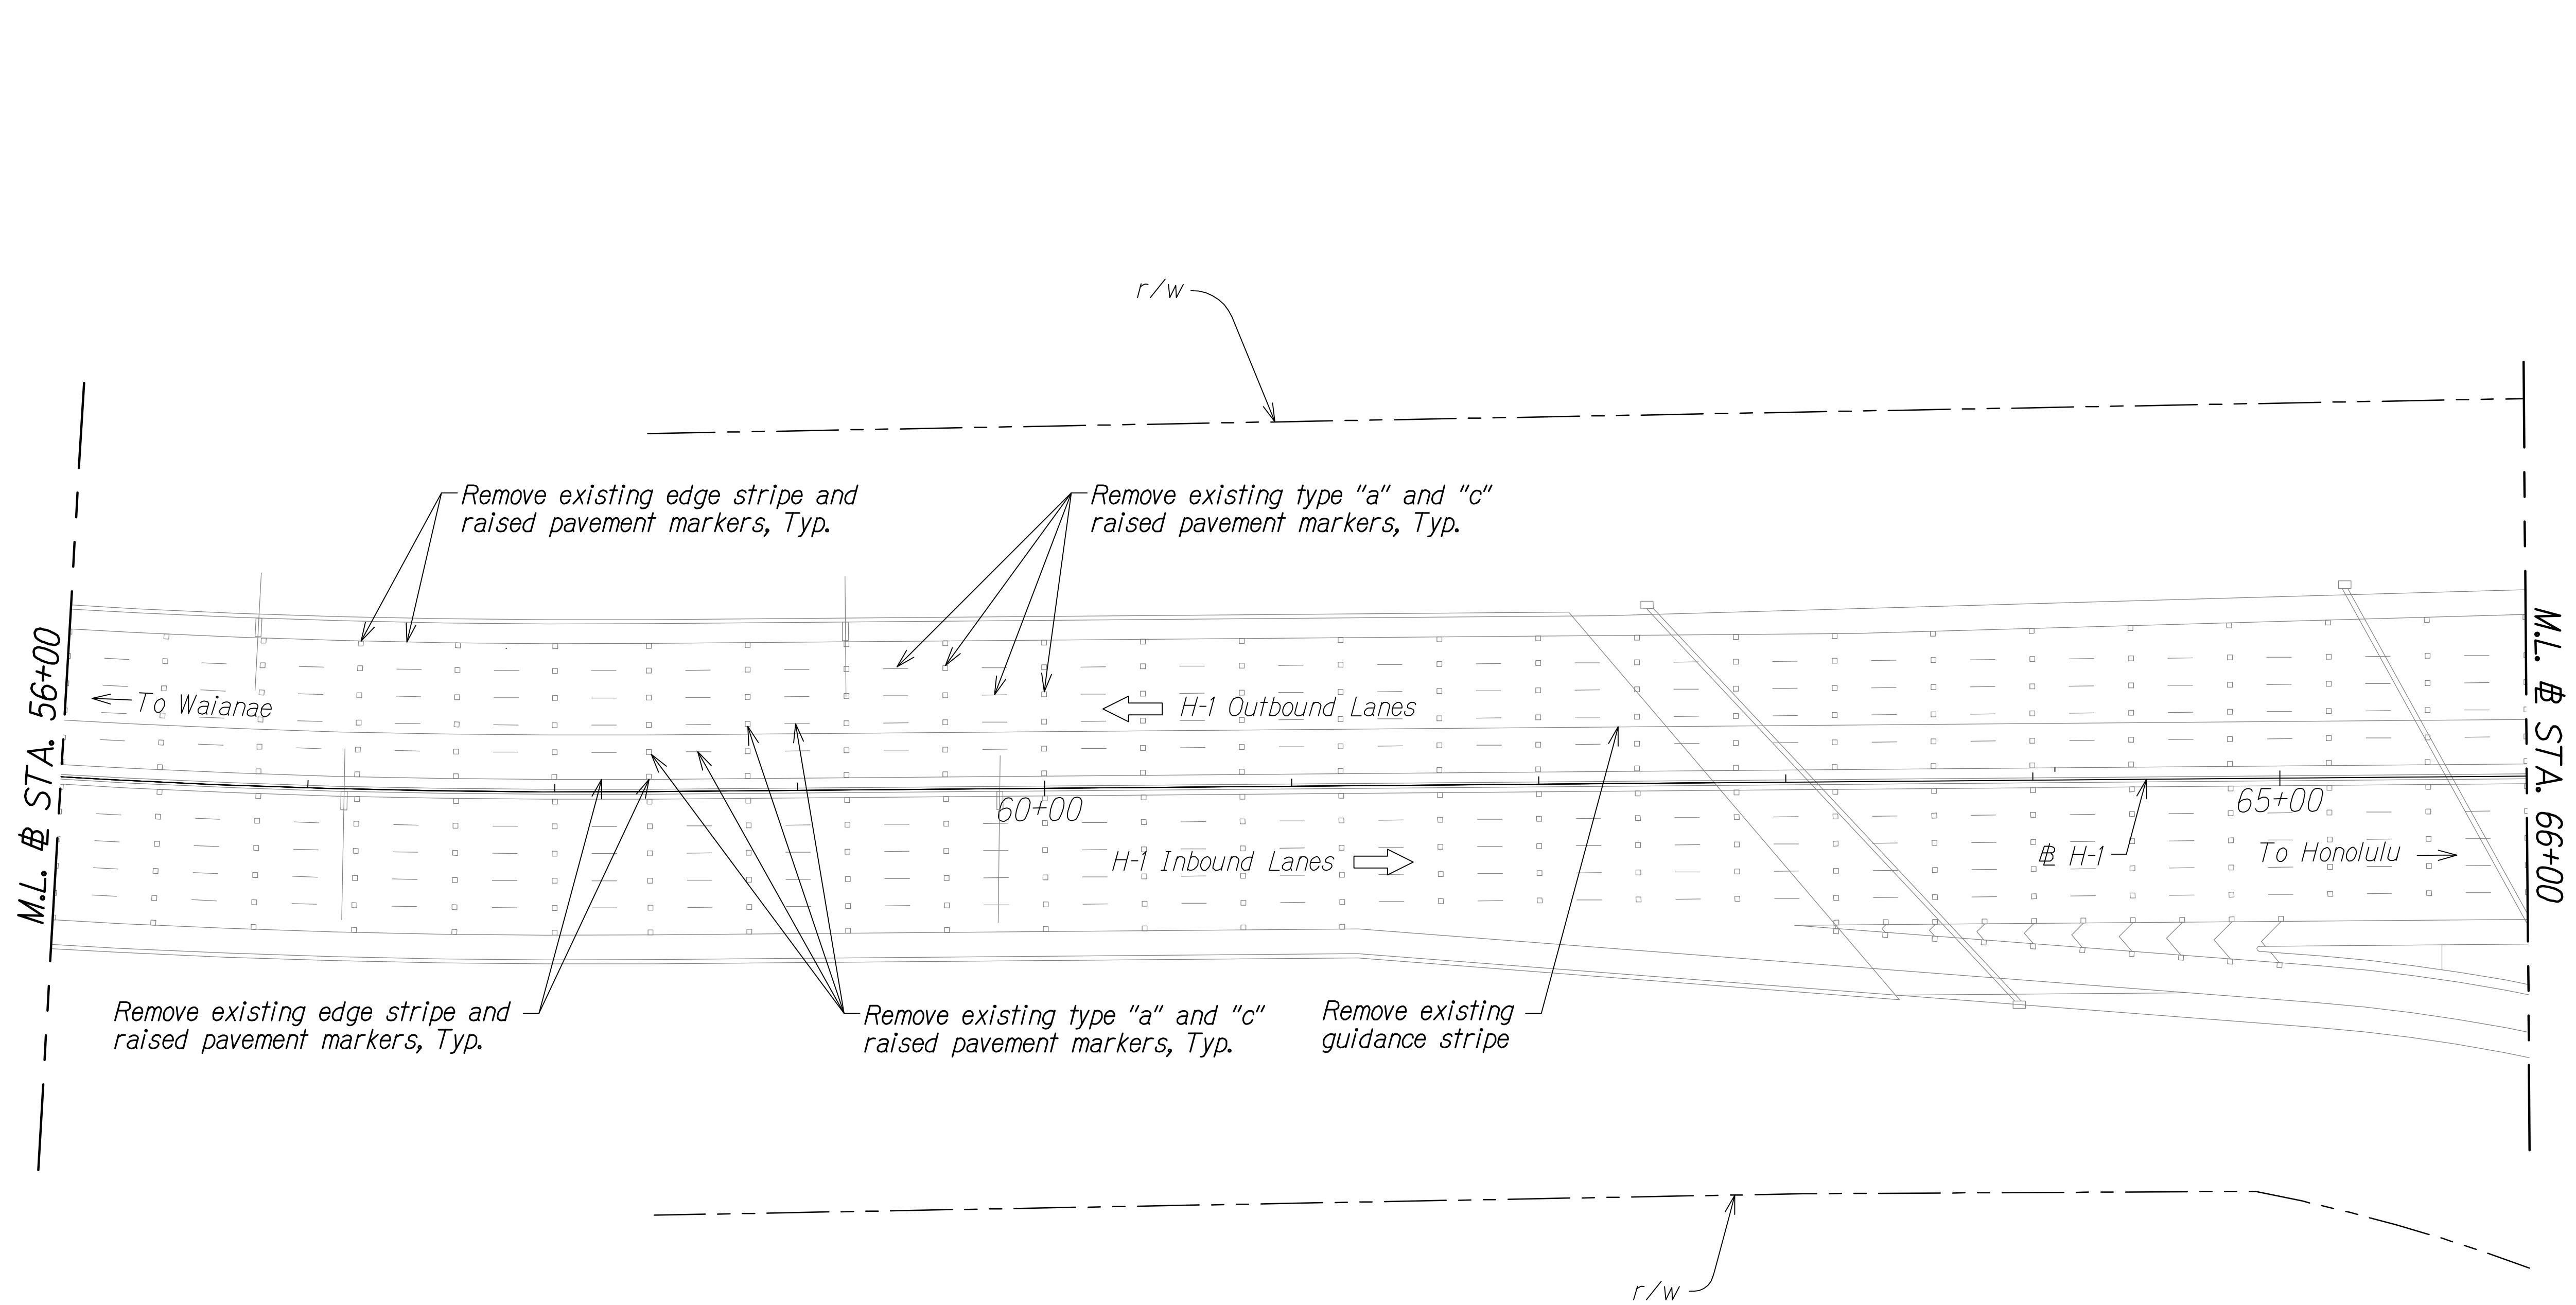

Notes:
1. Remove all outbound lane existing striping and raised pavement markers between matchlines as noted.

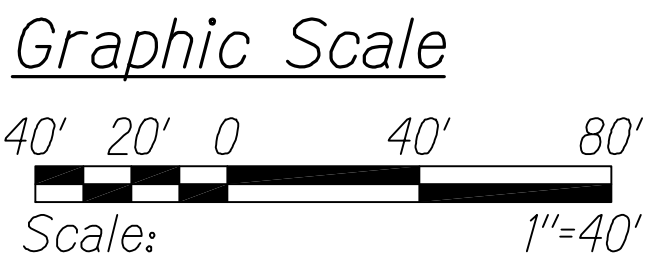


DEMOLITION PLAN
STA. 56+00 TO # STA. 66+00
Scale: 1" = 40'

LEGEND FOR AS-BUILT POSTINGS

Squiggly line for as-built deletion

Double line for as-built deletion

Roadway Text for as-built posting

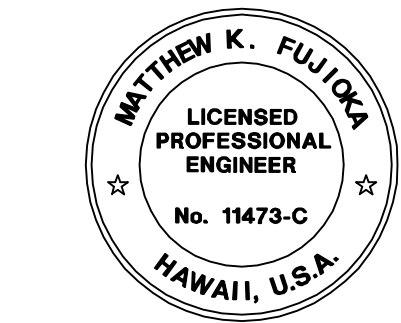

THIS WORK WAS PREPARED BY ME OR UNDER MY SUPERVISION.
Matthew K. Fujita
WILSON OKAMOTO CORPORATION APRIL 30, 2016 LIC. EXP. DATE


STATE OF HAWAII
DEPARTMENT OF TRANSPORTATION
HIGHWAYS DIVISION

DEMOLITION PLAN

INTERSTATE ROUTE H-1
PM CONTRAFLOW LANE, PHASE 1 & 2
FEDERAL AID PROJECT NO. NH-HI-1 (260)
Scale: 1" = 40' Date: July, 2016

SHEET No. DEM-14 OF 26 SHEETS

| FED. ROAD DIST. NO. | STATE | FED. AID PROJ. NO. | FISCAL YEAR | SHEET NO. | TOTAL SHEETS |
|---------------------|-------|--------------------|-------------|-----------|--------------|
| HAWAII | HAW. | NH-HI-1 (260) | 2014 | 41 | 605 |

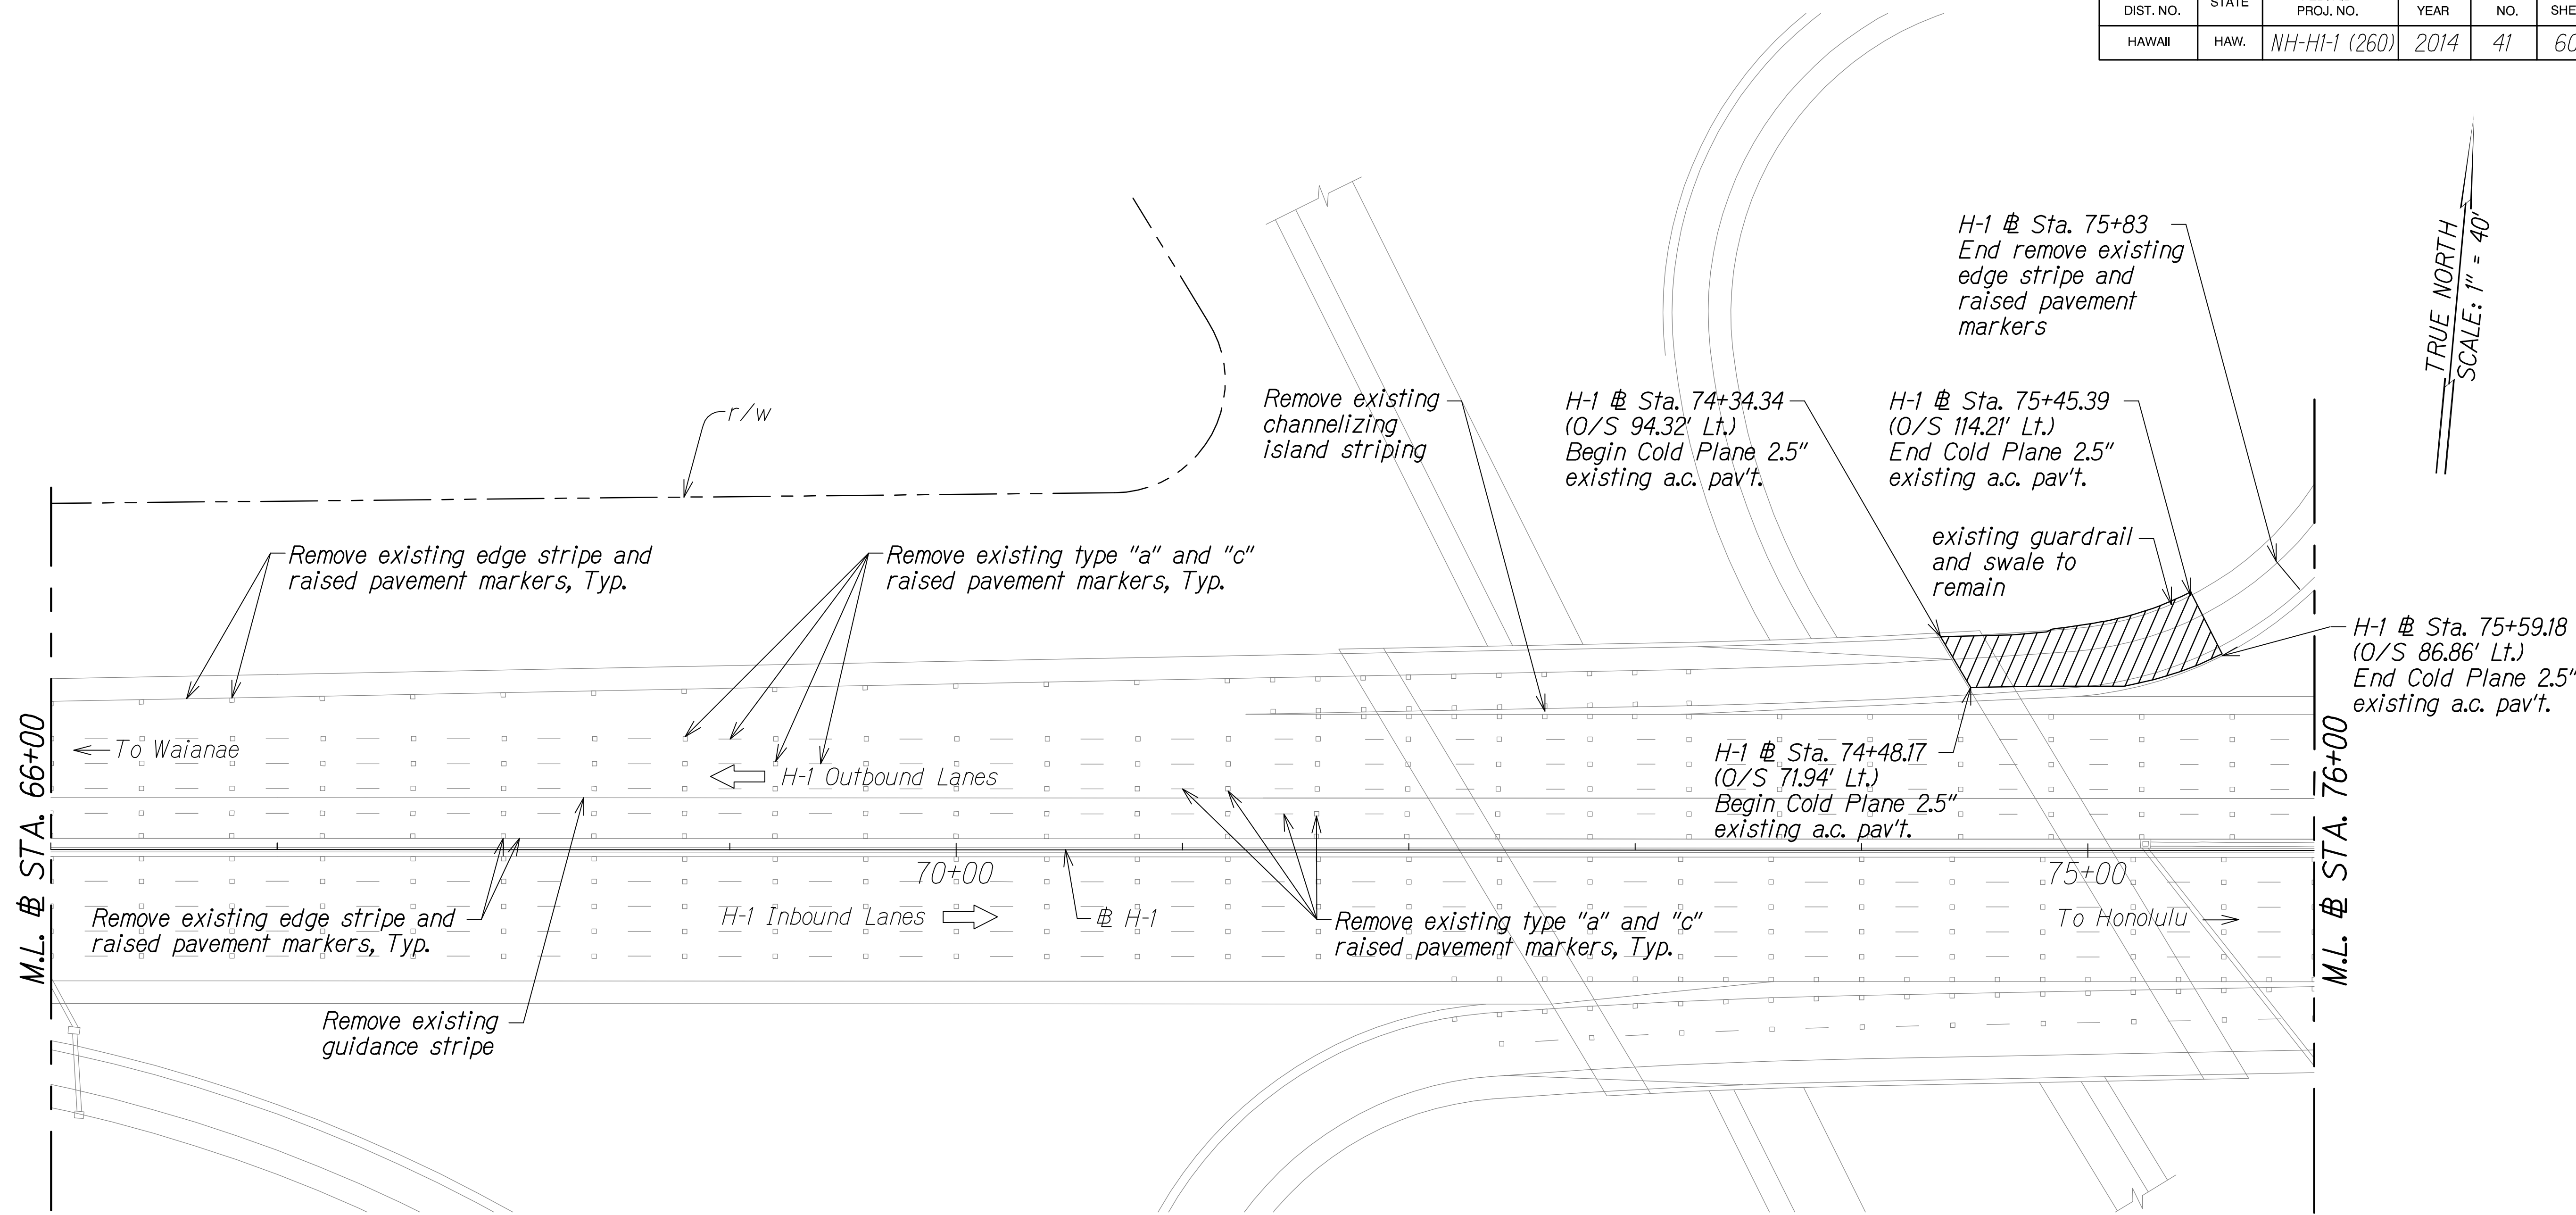


Legend:

- Demolish and Remove Feature
- Cold Plane existing a.c. pav't.

Notes:

- At existing a.c. pavement demolition areas, demolish and remove existing a.c. pavement and base course. Subbase shall remain in-place.
- Remove all outbound lane existing striping and raised pavement markers between matchlines as noted.


Graphic Scale

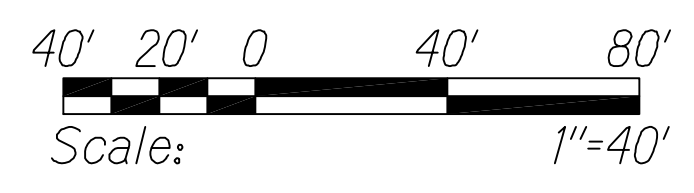

DEMOLITION PLAN
STA. 66+00 TO # STA. 76+00
Scale: 1" = 40'

LEGEND FOR AS-BUILT POSTINGS

- Squiggly line for as-built deletion
- Double line for as-built deletion
- Roadway Text for as-built posting

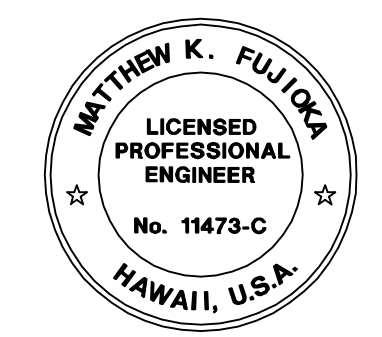

THIS WORK WAS PREPARED BY ME OR UNDER MY SUPERVISION.
Matthew K. Fujitaka
WILSON OKAMOTO CORPORATION APRIL 30, 2016 LIC. EXP. DATE


STATE OF HAWAII
DEPARTMENT OF TRANSPORTATION
HIGHWAYS DIVISION

DEMOLITION PLAN

INTERSTATE ROUTE H-1
PM CONTRAFLOW LANE, PHASE 1 & 2
FEDERAL AID PROJECT NO. NH-HI-1 (260)
Scale: 1" = 40' Date: July, 2016

SHEET No. DEM-15 OF 26 SHEETS


| FED. ROAD DIST. NO. | STATE | FED. AID PROJ. NO. | FISCAL YEAR | SHEET NO. | TOTAL SHEETS |
|---------------------|-------|--------------------|-------------|-----------|--------------|
| HAWAII | HAW. | NH-HI-1 (260) | 2014 | 42 | 605 |

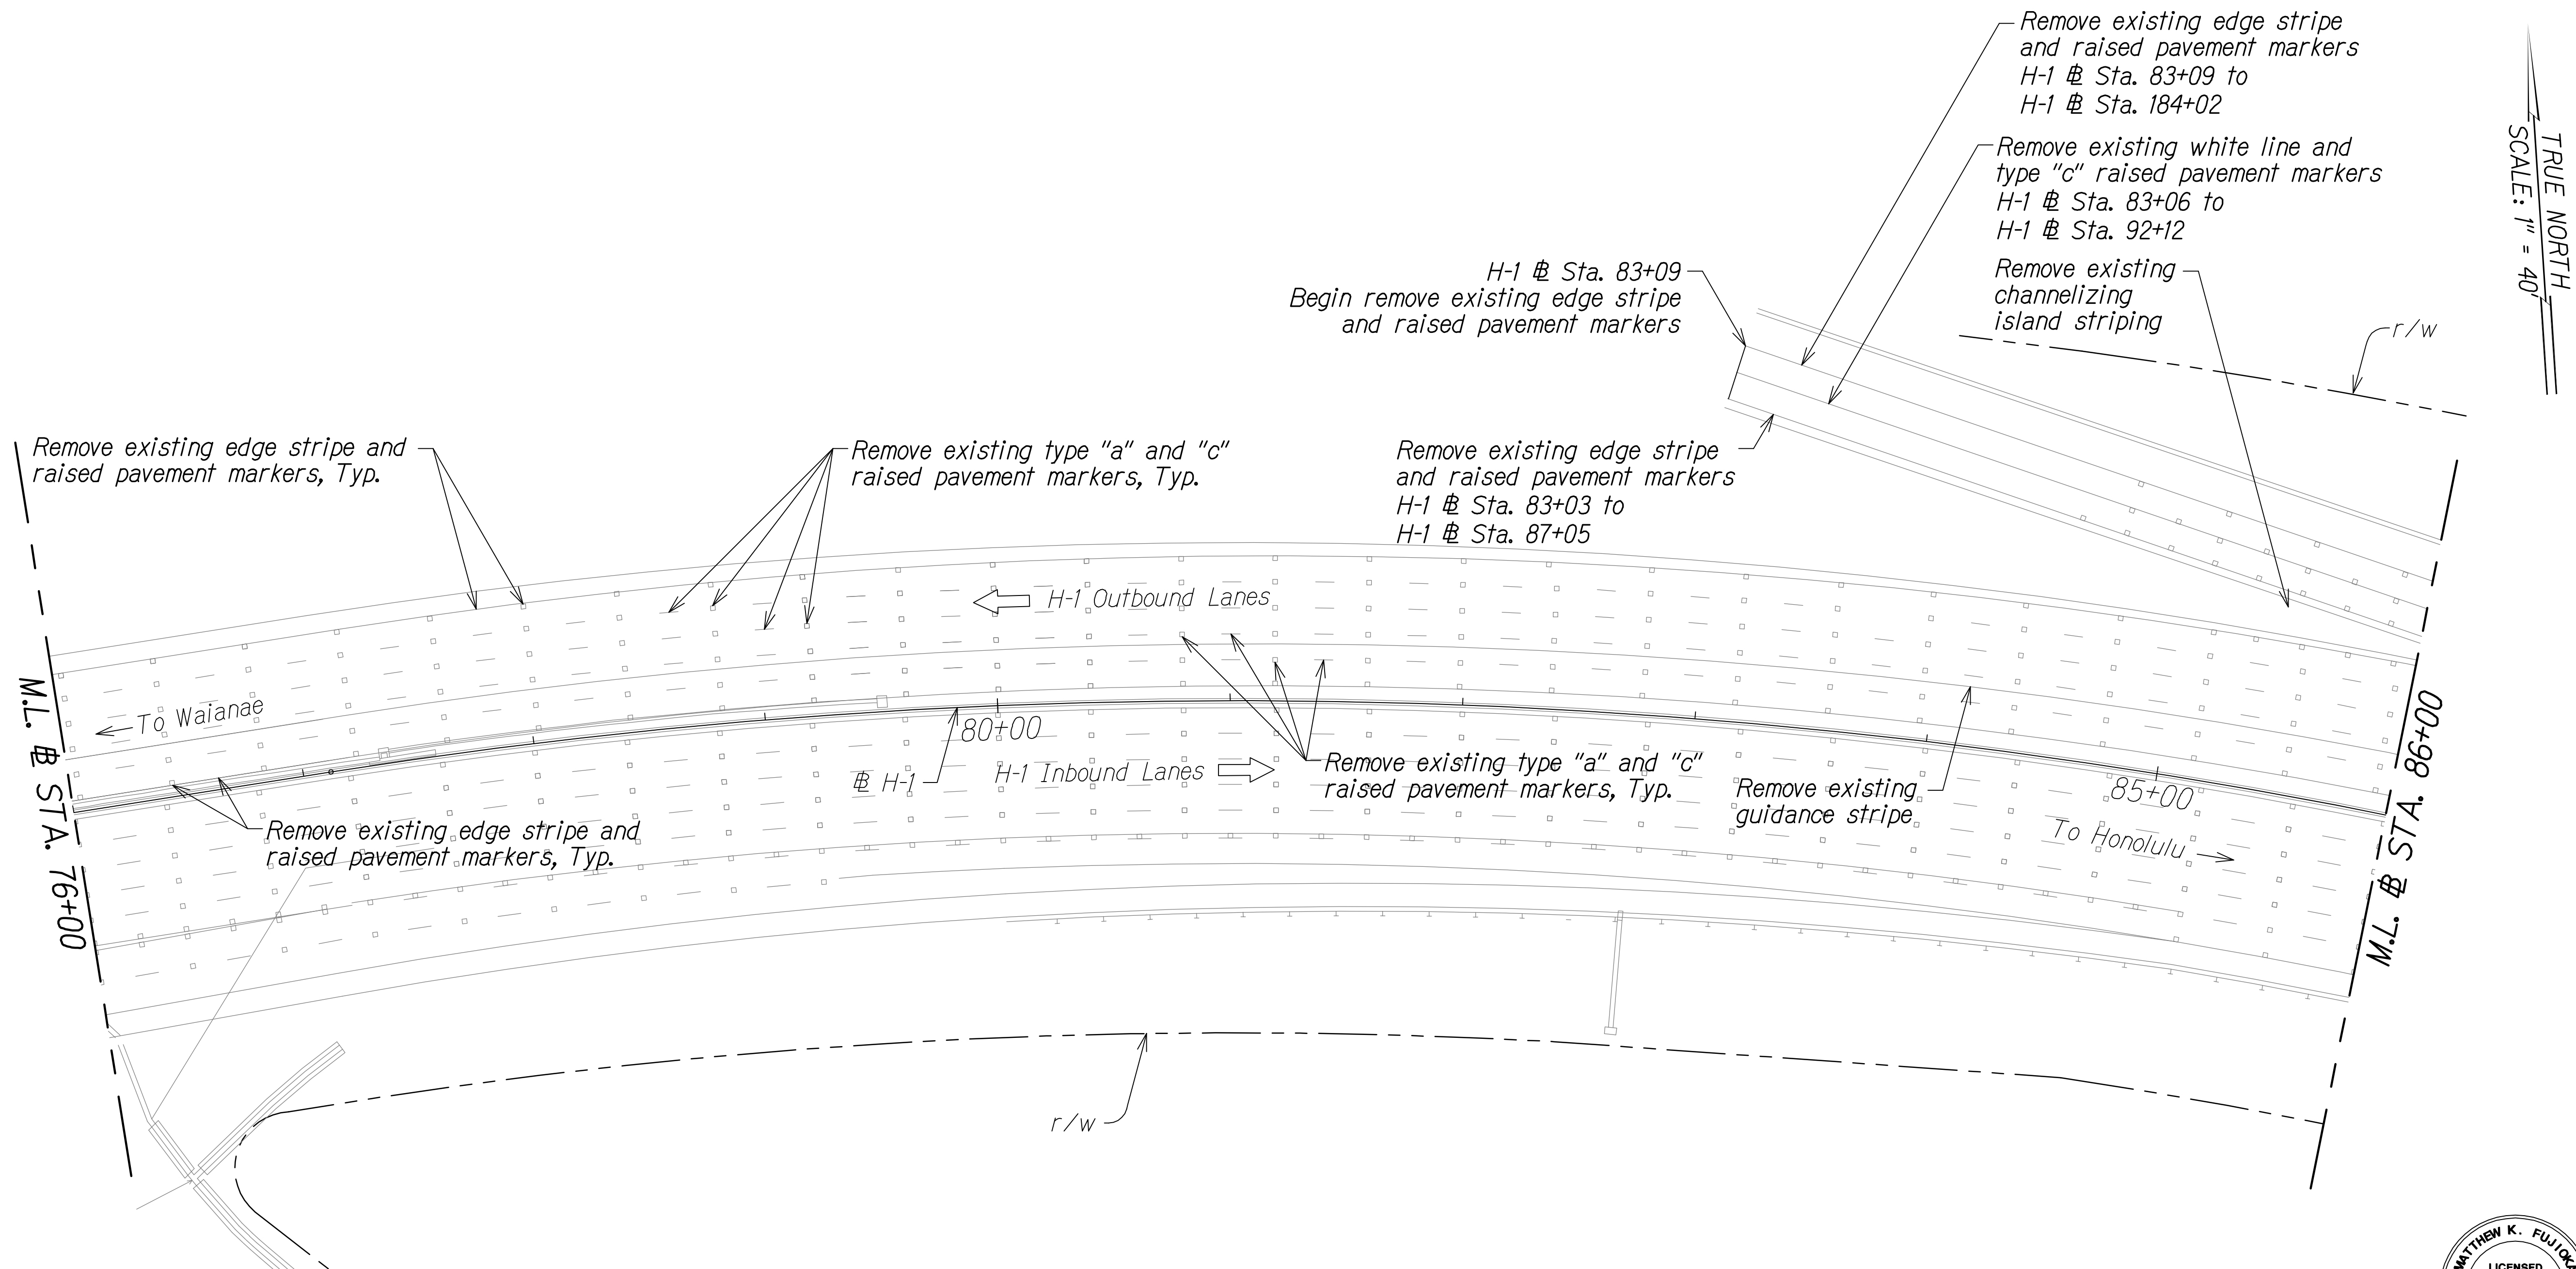

Notes:


1. Remove all outbound lane existing striping and raised pavement markers between matchlines as noted.

Graphic Scale

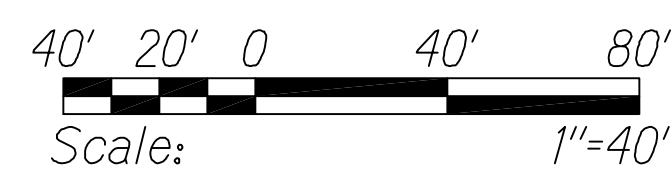

DEMOLITION PLAN
@ STA. 76+00 TO @ STA. 86+00
Scale: 1" = 40'

| LEGEND FOR AS-BUILT POSTINGS | |
|------------------------------|-------------------------------------|
| | Squiggly line for as-built deletion |
| | Double line for as-built deletion |
| Roadway | Text for as-built posting |

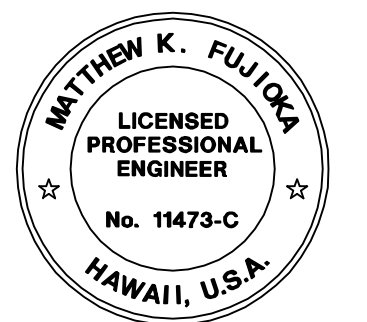

THIS WORK WAS PREPARED BY ME
OR UNDER MY SUPERVISION.
Matthew K. Fujitaka
WILSON OKAMOTO CORPORATION APRIL 30, 2018
LIC. EXP. DATE


STATE OF HAWAII
DEPARTMENT OF TRANSPORTATION
HIGHWAYS DIVISION

DEMOLITION PLAN


INTERSTATE ROUTE H-1
PM CONTRAFLOW LANE, PHASE 1 & 2
FEDERAL AID PROJECT NO. NH-HI-1 (260)
Scale: 1" = 40' Date: July, 2016

SHEET No. DEM-16 OF 26 SHEETS

| FED. ROAD DIST. NO. | STATE | FED. AID PROJ. NO. | FISCAL YEAR | SHEET NO. | TOTAL SHEETS |
|---------------------|-------|--------------------|-------------|-----------|--------------|
| HAWAII | HAW. | NH-HI-1 (260) | 2014 | 43 | 605 |

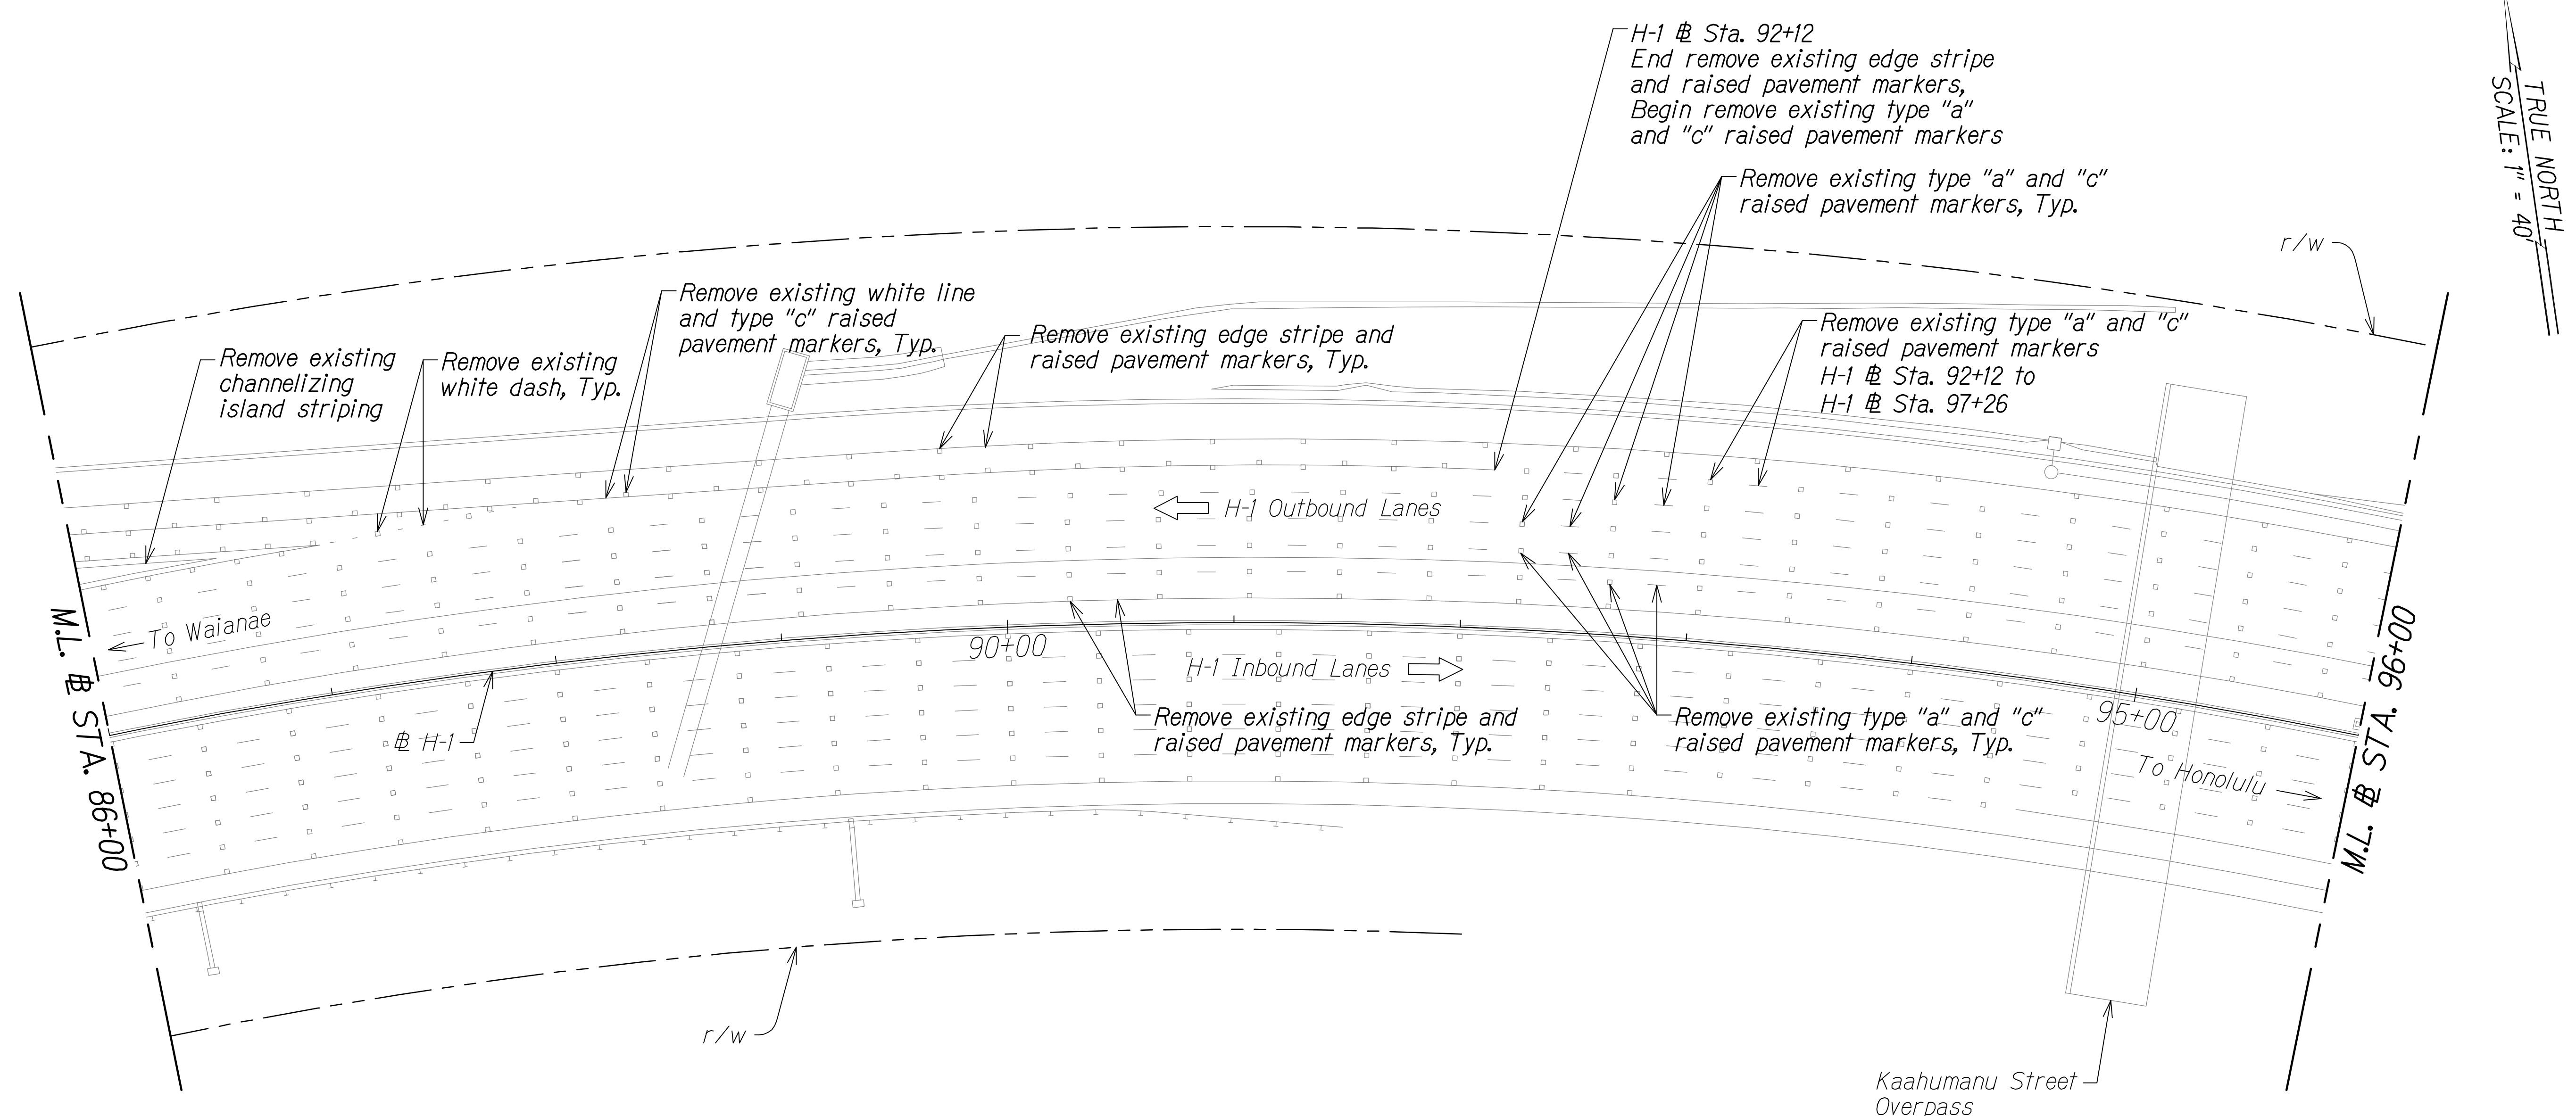


Notes:
1. Remove all outbound lane existing striping and raised pavement markers between matchlines as noted.

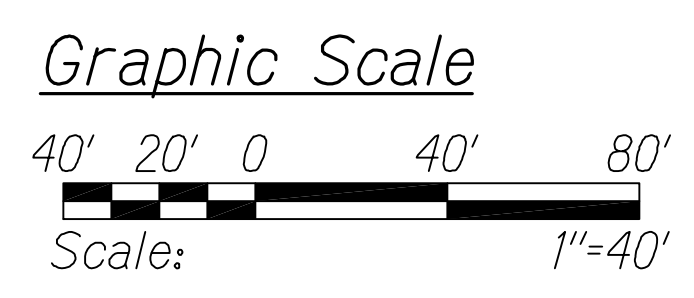

DEMOLITION PLAN
@ STA. 86+00 TO @ STA. 96+00
Scale: 1" = 40'

LEGEND FOR AS-BUILT POSTINGS

- Squiggly line for as-built deletion
- Double line for as-built deletion
- Roadway
- Text for as-built posting

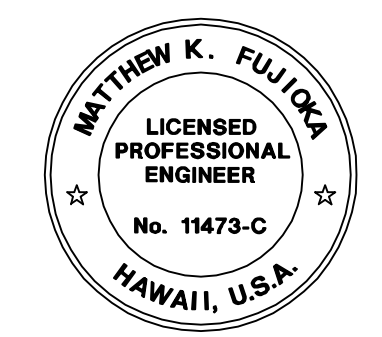

THIS WORK WAS PREPARED BY ME OR UNDER MY SUPERVISION.
Matthew K. Fujitaka
WILSON OKAMOTO CORPORATION APRIL 30, 2018 LIC. EXP. DATE


STATE OF HAWAII
DEPARTMENT OF TRANSPORTATION
HIGHWAYS DIVISION

DEMOLITION PLAN

INTERSTATE ROUTE H-1
PM CONTRAFLOW LANE, PHASE 1 & 2
FEDERAL AID PROJECT NO. NH-HI-1 (260)
Scale: 1" = 40' Date: July, 2016


| FED. ROAD DIST. NO. | STATE | FED. AID PROJ. NO. | FISCAL YEAR | SHEET NO. | TOTAL SHEETS |
|---------------------|-------|--------------------|-------------|-----------|--------------|
| HAWAII | HAW. | NH-HI-1 (260) | 2014 | 44 | 605 |

TRUE NORTH
SCALE: 1" = 40'

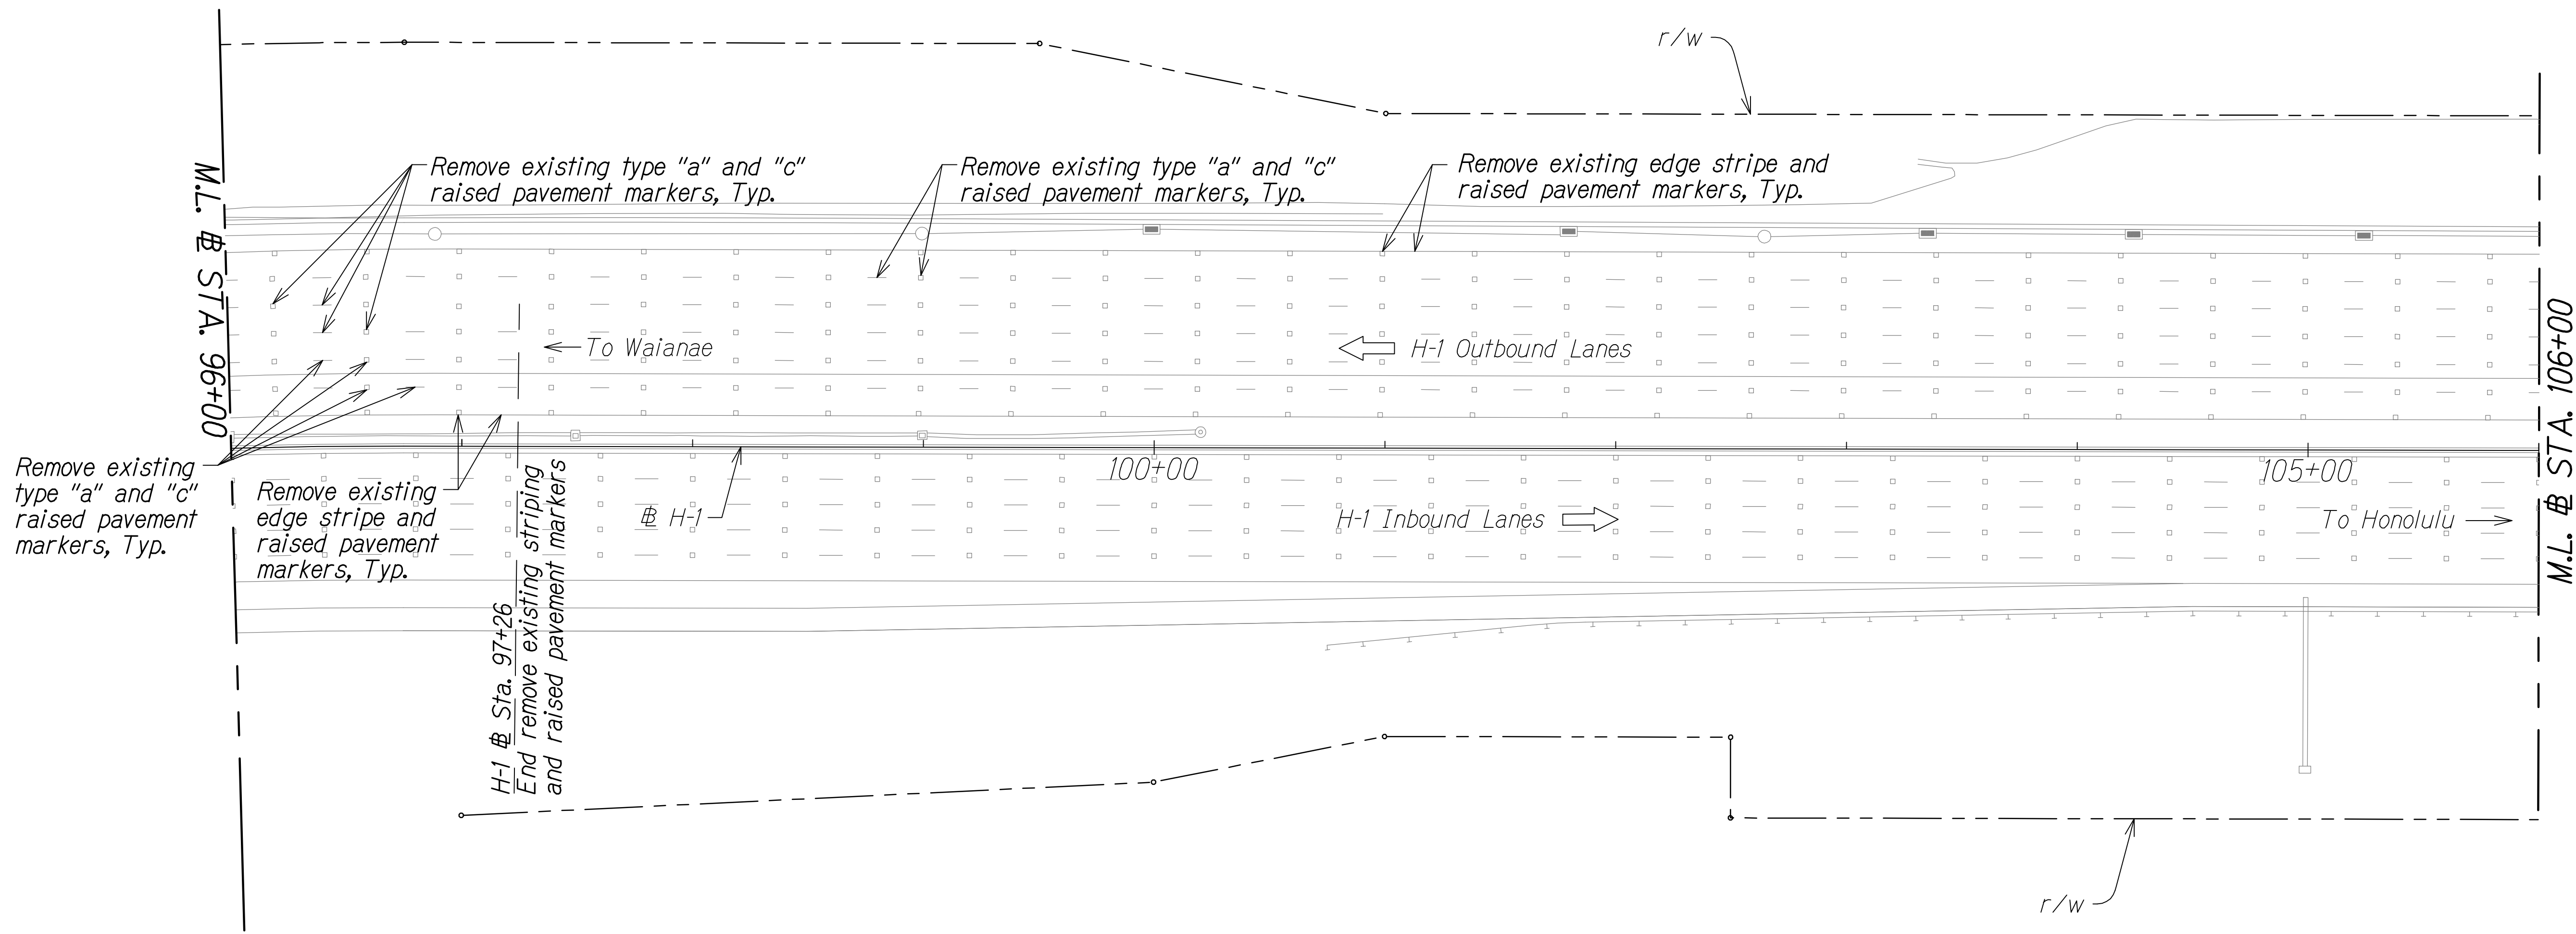

| | | | |
|--------------|------|------|----------------|
| QC/QA REVIEW | 100% | DATE | MARCH 23, 2014 |
| BY | | | |
| BY | | | |
| BY | | | |

| | |
|---------------|------|
| ORIGINAL PLAN | DATE |
| NOTED BY | |
| DESIGNED BY | |
| QUANTITIES BY | |
| CHECKED BY | |

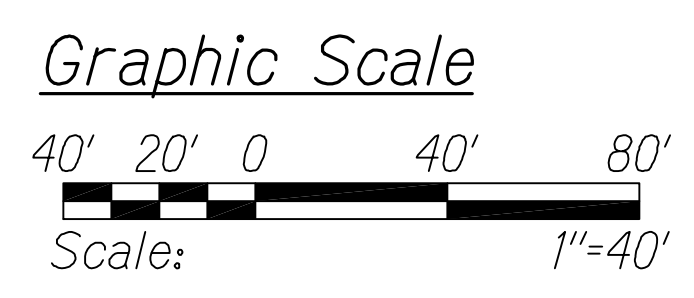

DEMOLITION PLAN
STA. 96+00 TO # STA. 106+00
Scale: 1" = 40'

LEGEND FOR AS-BUILT POSTINGS

- Squiggly line for as-built deletion
- Double line for as-built deletion
- Roadway Text for as-built posting



THIS WORK WAS PREPARED BY ME OR UNDER MY SUPERVISION.
Matthew K. Fujitaka
WILSON OKAMOTO CORPORATION LIC. EXP. DATE


STATE OF HAWAII
DEPARTMENT OF TRANSPORTATION
HIGHWAYS DIVISION

DEMOLITION PLAN

INTERSTATE ROUTE H-1
PM CONTRAFLOW LANE, PHASE 1 # 2
FEDERAL AID PROJECT NO. NH-HI-1 (260)
Scale: 1" = 40' Date: July, 2016


SHEET No. DEM-18 OF 26 SHEETS

| FED. ROAD DIST. NO. | STATE | FED. AID PROJ. NO. | FISCAL YEAR | SHEET NO. | TOTAL SHEETS |
|---------------------|-------|--------------------|-------------|-----------|--------------|
| HAWAII | HAW. | NH-HI-1 (260) | 2014 | 45 | 605 |

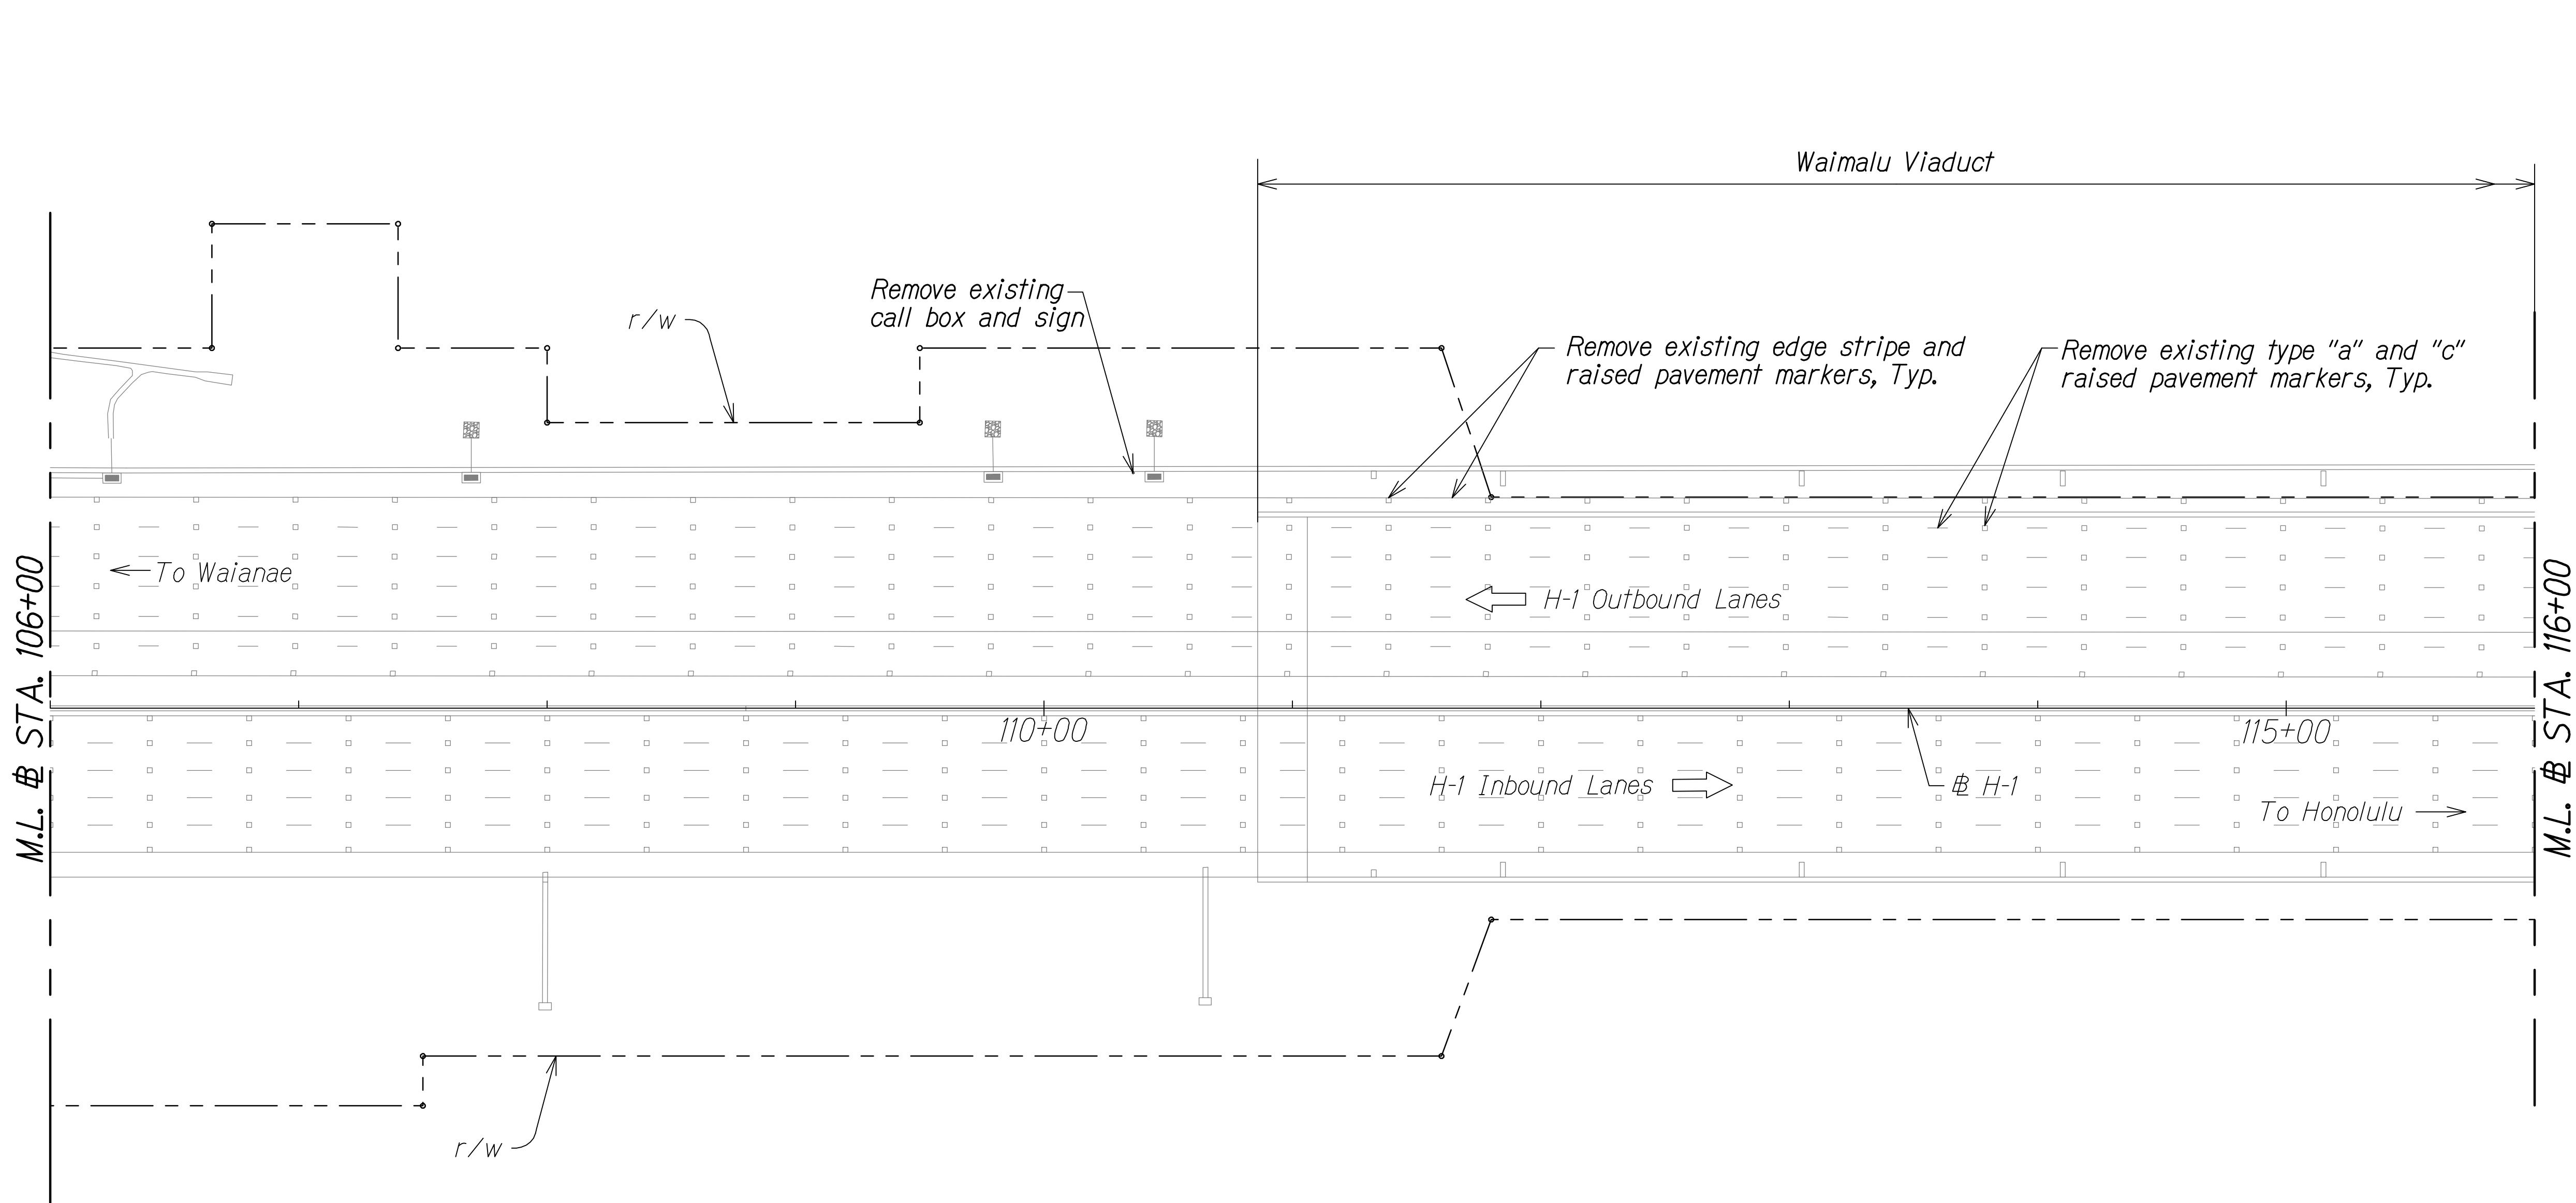


| | | | |
|--------------|------|-------------|----------------|
| QC/QA REVIEW | 100% | DATE | MARCH 23, 2017 |
| BY | | DESIGNED BY | |
| BY | | DESIGNED BY | |
| BY | | DESIGNED BY | |
| BY | | DESIGNED BY | |

| | |
|---------------|------|
| ORIGINAL PLAN | DATE |
| NOTED BY | |
| DESIGNED BY | |
| QUANTITIES BY | |
| CHECKED BY | |

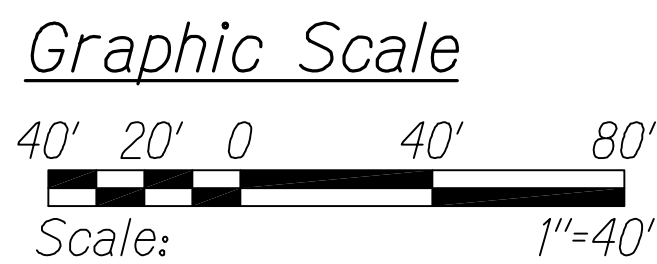

DEMOLITION PLAN
STA. 106+00 TO # STA. 116+00
Scale: 1" = 40'

| LEGEND FOR AS-BUILT POSTINGS | |
|------------------------------|-------------------------------------|
| | Squiggly line for as-built deletion |
| | Double line for as-built deletion |
| Roadway | Text for as-built posting |

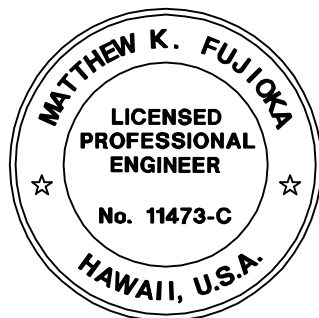

THIS WORK WAS PREPARED BY ME
OR UNDER MY SUPERVISION.
Matthew K. Fujitaka
WILSON OKAMOTO CORPORATION LIC. EXP. DATE


STATE OF HAWAII
DEPARTMENT OF TRANSPORTATION
HIGHWAYS DIVISION

DEMOLITION PLAN

INTERSTATE ROUTE H-1
PM CONTRAFLOW LANE, PHASE 1 & 2
FEDERAL AID PROJECT NO. NH-HI-1 (260)
Scale: 1" = 40' Date: July, 2016


SHEET No. DEM-19 OF 26 SHEETS

| FED. ROAD DIST. NO. | STATE | FED. AID PROJ. NO. | FISCAL YEAR | SHEET NO. | TOTAL SHEETS |
|---------------------|-------|--------------------|-------------|-----------|--------------|
| HAWAII | HAW. | NH-HI-1 (260) | 2014 | 46 | 605 |

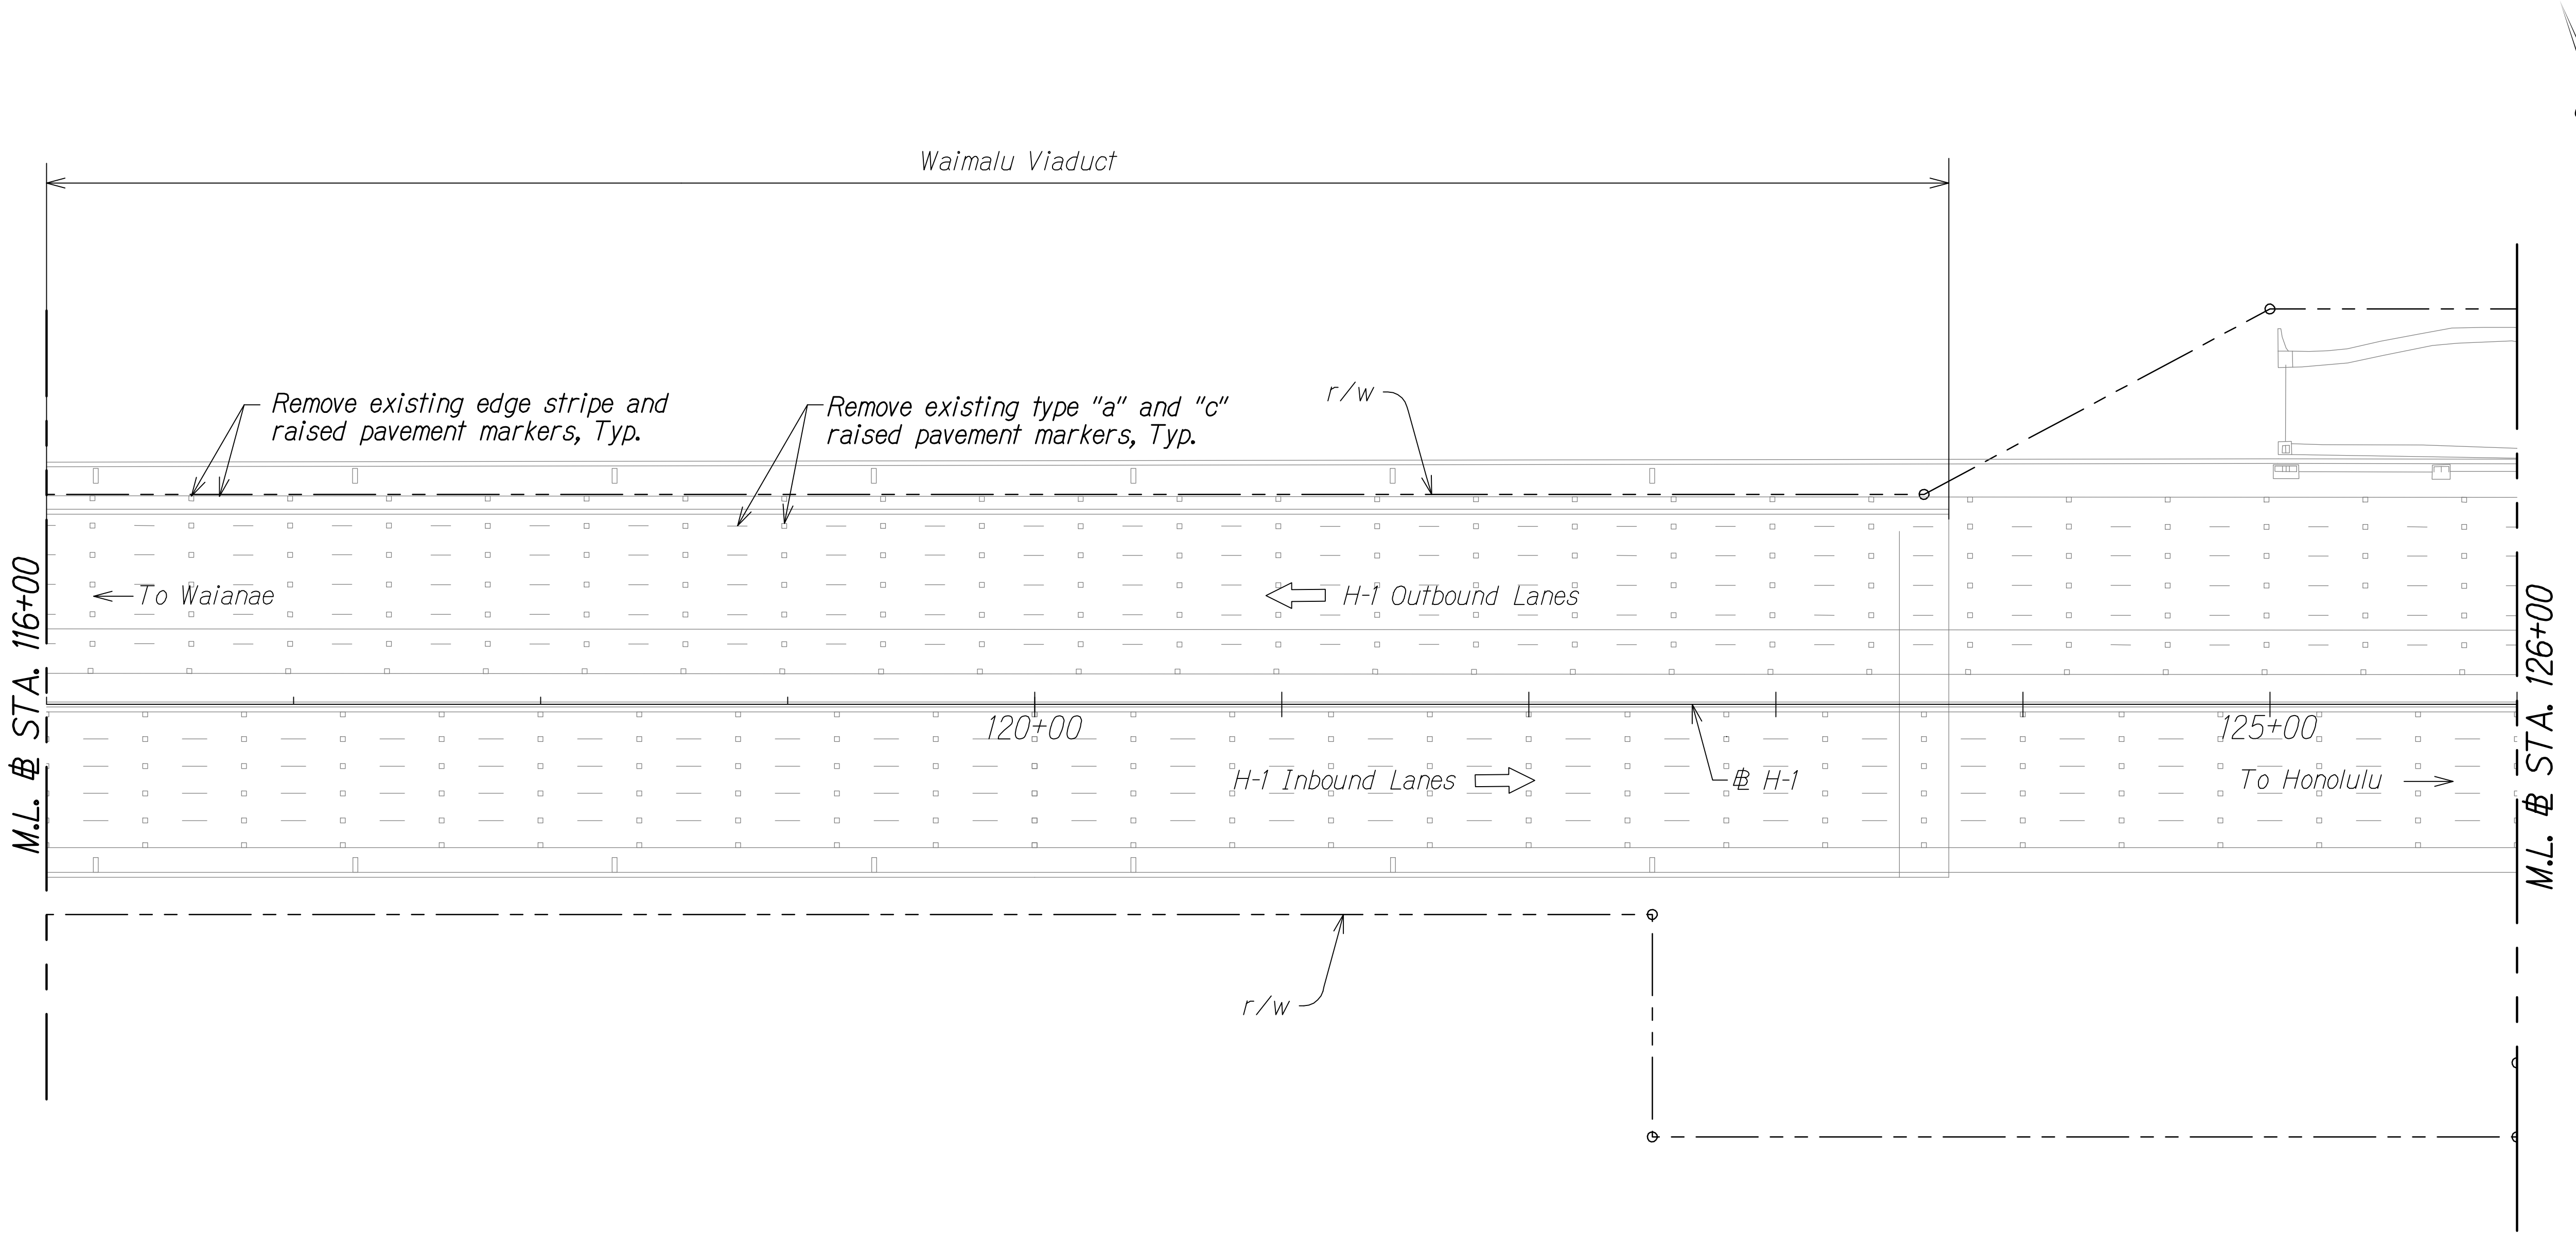

| | | | |
|--------------|------|------|----------------|
| QC/QA REVIEW | 100% | DATE | MARCH 23, 2017 |
| BY | | | |
| BY | | | |
| BY | | | |
| BY | | | |

| | | |
|---------------|-------------------|------|
| ORIGINAL PLAN | SURVEY PLOTTED BY | DATE |
| NOTE BOOK | DESIGNED BY | |
| No. | QUANTITIES BY | |
| | CHECKED BY | |

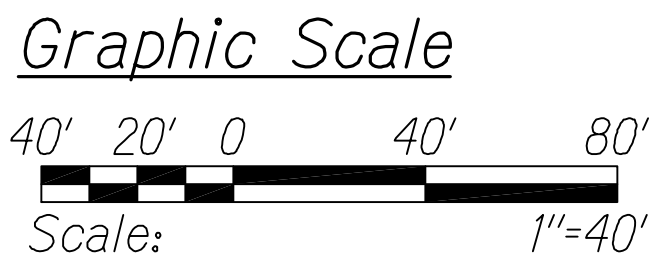

DEMOLITION PLAN
STA. 116+00 TO # STA. 126+00
Scale: 1" = 40'

LEGEND FOR AS-BUILT POSTINGS

- Squiggly line for as-built deletion
- Double line for as-built deletion
- Roadway Text for as-built posting



THIS WORK WAS PREPARED BY ME
OR UNDER MY SUPERVISION.
Matthew K. Fujitaka
WILSON OKAMOTO CORPORATION APRIL 30, 2018 LIC. EXP. DATE

STATE OF HAWAII
DEPARTMENT OF TRANSPORTATION
HIGHWAYS DIVISION


DEMOLITION PLAN

INTERSTATE ROUTE H-1
PM CONTRAFLOW LANE, PHASE 1 # 2
FEDERAL AID PROJECT NO. NH-HI-1 (260)
Scale: 1" = 40' Date: July, 2016

SHEET No DEM-20 OF 26 SHEETS


| FED. ROAD DIST. NO. | STATE | FED. AID PROJ. NO. | FISCAL YEAR | SHEET NO. | TOTAL SHEETS |
|---------------------|-------|--------------------|-------------|-----------|--------------|
| HAWAII | HAW. | NH-HI-1 (260) | 2014 | 47 | 605 |

TRUE NORTH
SCALE: 1" = 40'

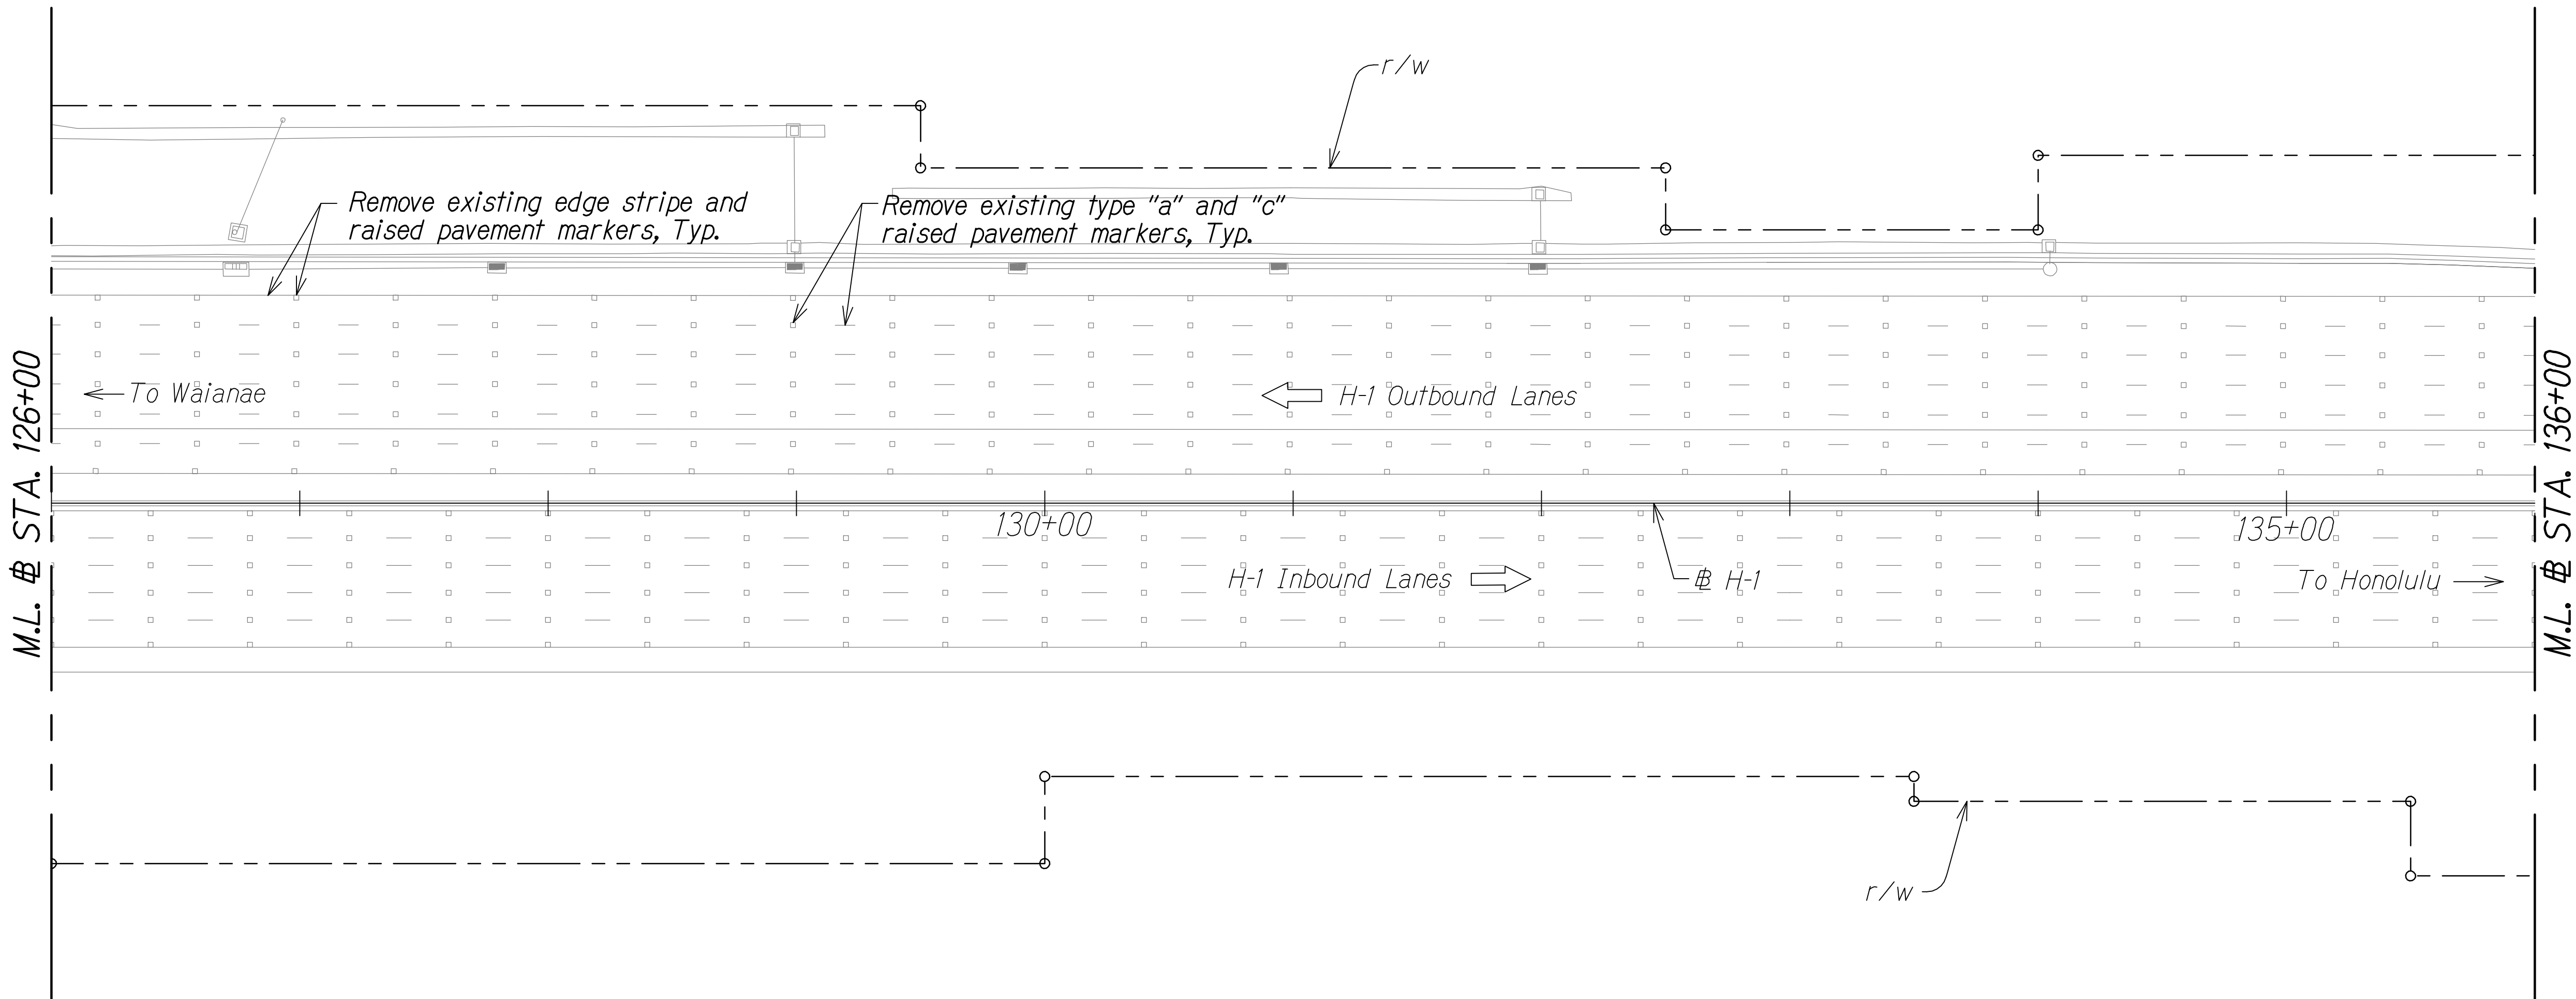

| | | | |
|--------------|------|-------------|----------------|
| QC/QA REVIEW | 100% | DATE | MARCH 23, 2014 |
| BY | | DESIGNED BY | |
| BY | | DESIGNED BY | |
| BY | | DESIGNED BY | |
| BY | | DESIGNED BY | |

| | |
|---------------|------|
| ORIGINAL PLAN | DATE |
| NOTED BY | |
| DESIGNED BY | |
| QUANTITIES BY | |
| CHECKED BY | |

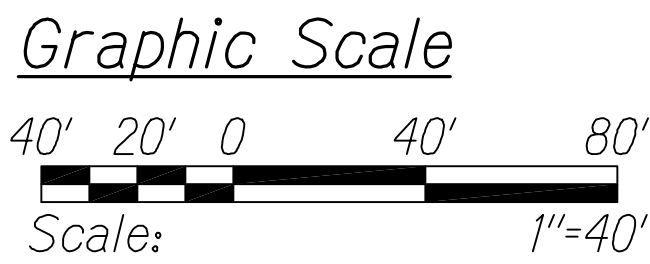

DEMOLITION PLAN
STA. 126+00 TO # STA. 136+00
Scale: 1" = 40'

LEGEND FOR AS-BUILT POSTINGS

~~~~~ Squiggly line for as-built deletion

==00.00== Double line for as-built deletion

Roadway Text for as-built posting



THIS WORK WAS PREPARED BY ME  
OR UNDER MY SUPERVISION.

*Matthew K. Fujioka*  
WILSON OKAMOTO CORPORATION LIC. EXP. DATE


STATE OF HAWAII  
DEPARTMENT OF TRANSPORTATION  
HIGHWAYS DIVISION

**DEMOLITION PLAN**

INTERSTATE ROUTE H-1  
PM CONTRAFLOW LANE, PHASE 1 & 2  
FEDERAL AID PROJECT NO. NH-HI-1 (260)  
Scale: 1" = 40' Date: July, 2016


SHEET No. DEM-21 OF 26 SHEETS

| FED. ROAD DIST. NO. | STATE | FED. AID PROJ. NO. | FISCAL YEAR | SHEET NO. | TOTAL SHEETS |
|---------------------|-------|--------------------|-------------|-----------|--------------|
| HAWAII              | HAW.  | NH-HI-1 (260)      | 2014        | 48        | 605          |

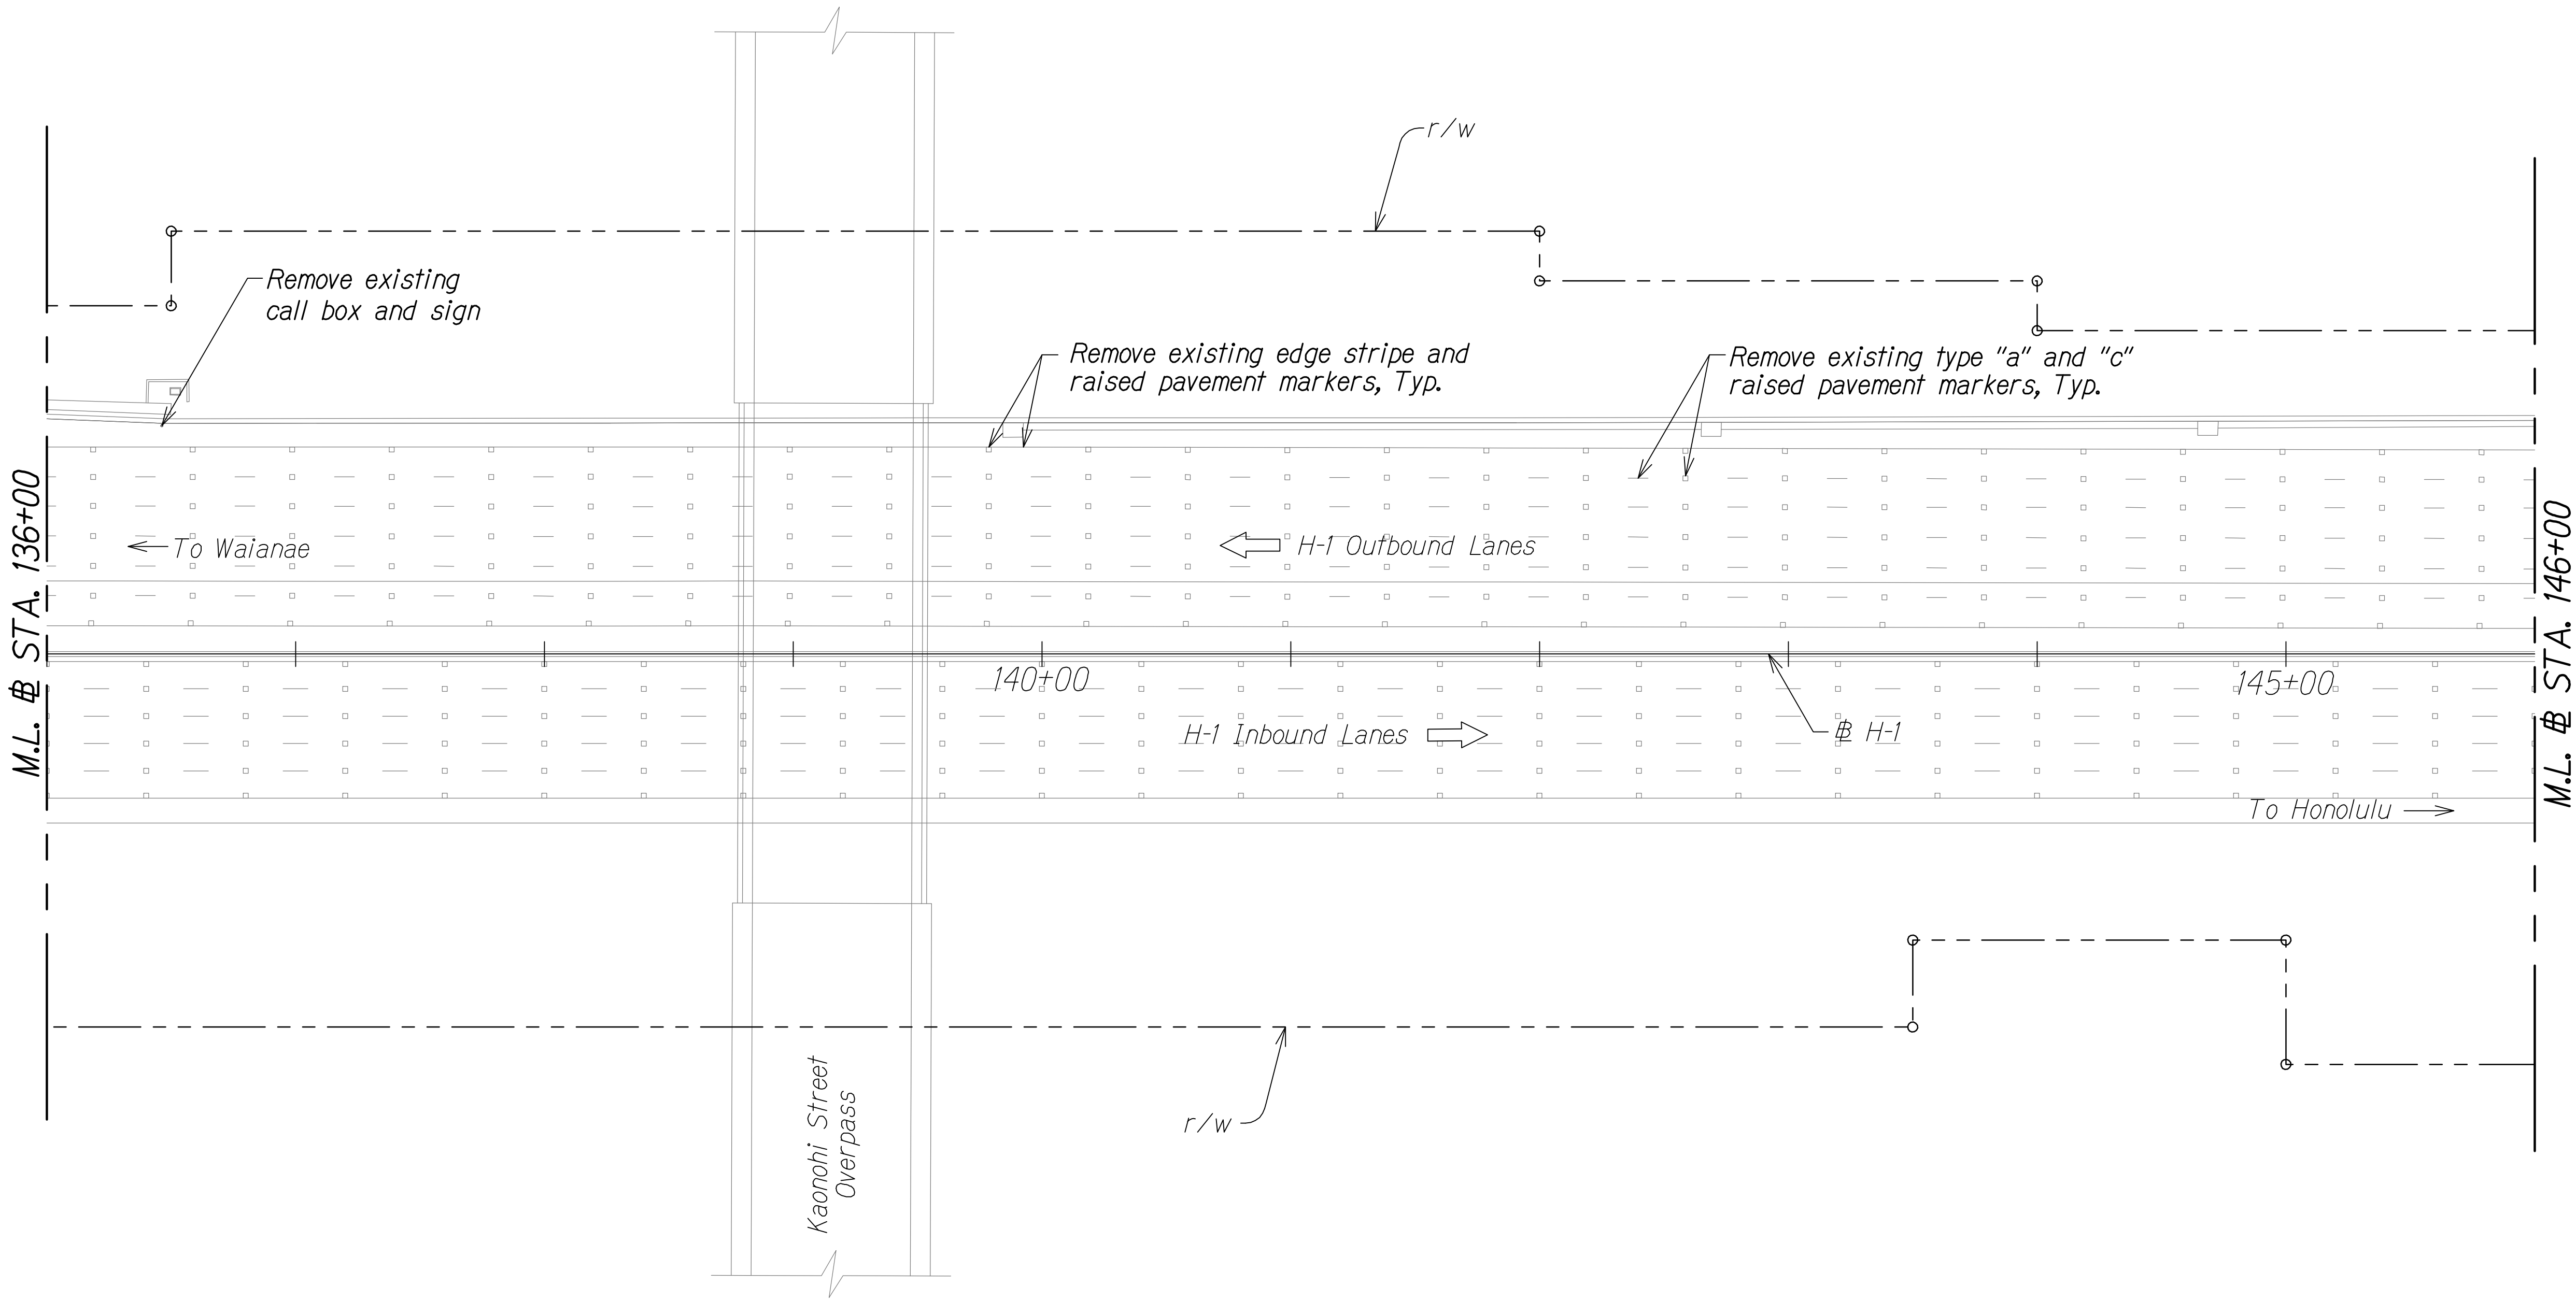

|              |      |      |                |
|--------------|------|------|----------------|
| QC/QA REVIEW | 100% | DATE | MARCH 23, 2014 |
| BY           |      | BY   |                |
| BY           |      | BY   |                |
| BY           |      | BY   |                |

|               |      |
|---------------|------|
| ORIGINAL PLAN | DATE |
| NOTED BY      |      |
| DESIGNED BY   |      |
| QUANTITIES BY |      |
| CHECKED BY    |      |

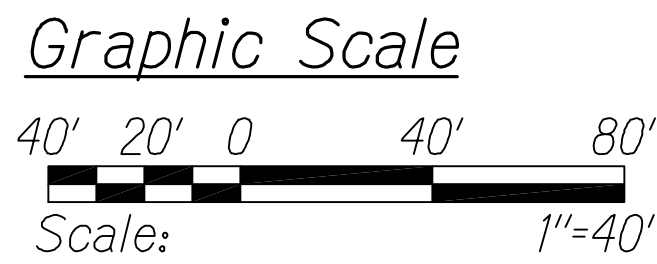

DEMOLITION PLAN  
# STA. 136+00 TO # STA. 146+00  
Scale: 1" = 40'

| LEGEND FOR AS-BUILT POSTINGS |                                     |
|------------------------------|-------------------------------------|
|                              | Squiggly line for as-built deletion |
|                              | Double line for as-built deletion   |
| Roadway                      | Text for as-built posting           |



THIS WORK WAS PREPARED BY ME  
OR UNDER MY SUPERVISION.  
*Matthew K. Fujitaka*  
WILSON OKAMOTO CORPORATION APRIL 30, 2018  
LIC. EXP. DATE

STATE OF HAWAII  
DEPARTMENT OF TRANSPORTATION  
HIGHWAYS DIVISION


**DEMOLITION PLAN**

INTERSTATE ROUTE H-1  
PM CONTRAFLOW LANE, PHASE 1 & 2  
FEDERAL AID PROJECT NO. NH-HI-1 (260)  
Scale: 1" = 40' Date: July, 2016

SHEET No. DEM-22 OF 26 SHEETS


| FED. ROAD DIST. NO. | STATE | FED. AID PROJ. NO. | FISCAL YEAR | SHEET NO. | TOTAL SHEETS |
|---------------------|-------|--------------------|-------------|-----------|--------------|
| HAWAII              | HAW.  | NH-HI-1 (260)      | 2014        | 49        | 605          |

TRUE NORTH  
SCALE: 1" = 40'

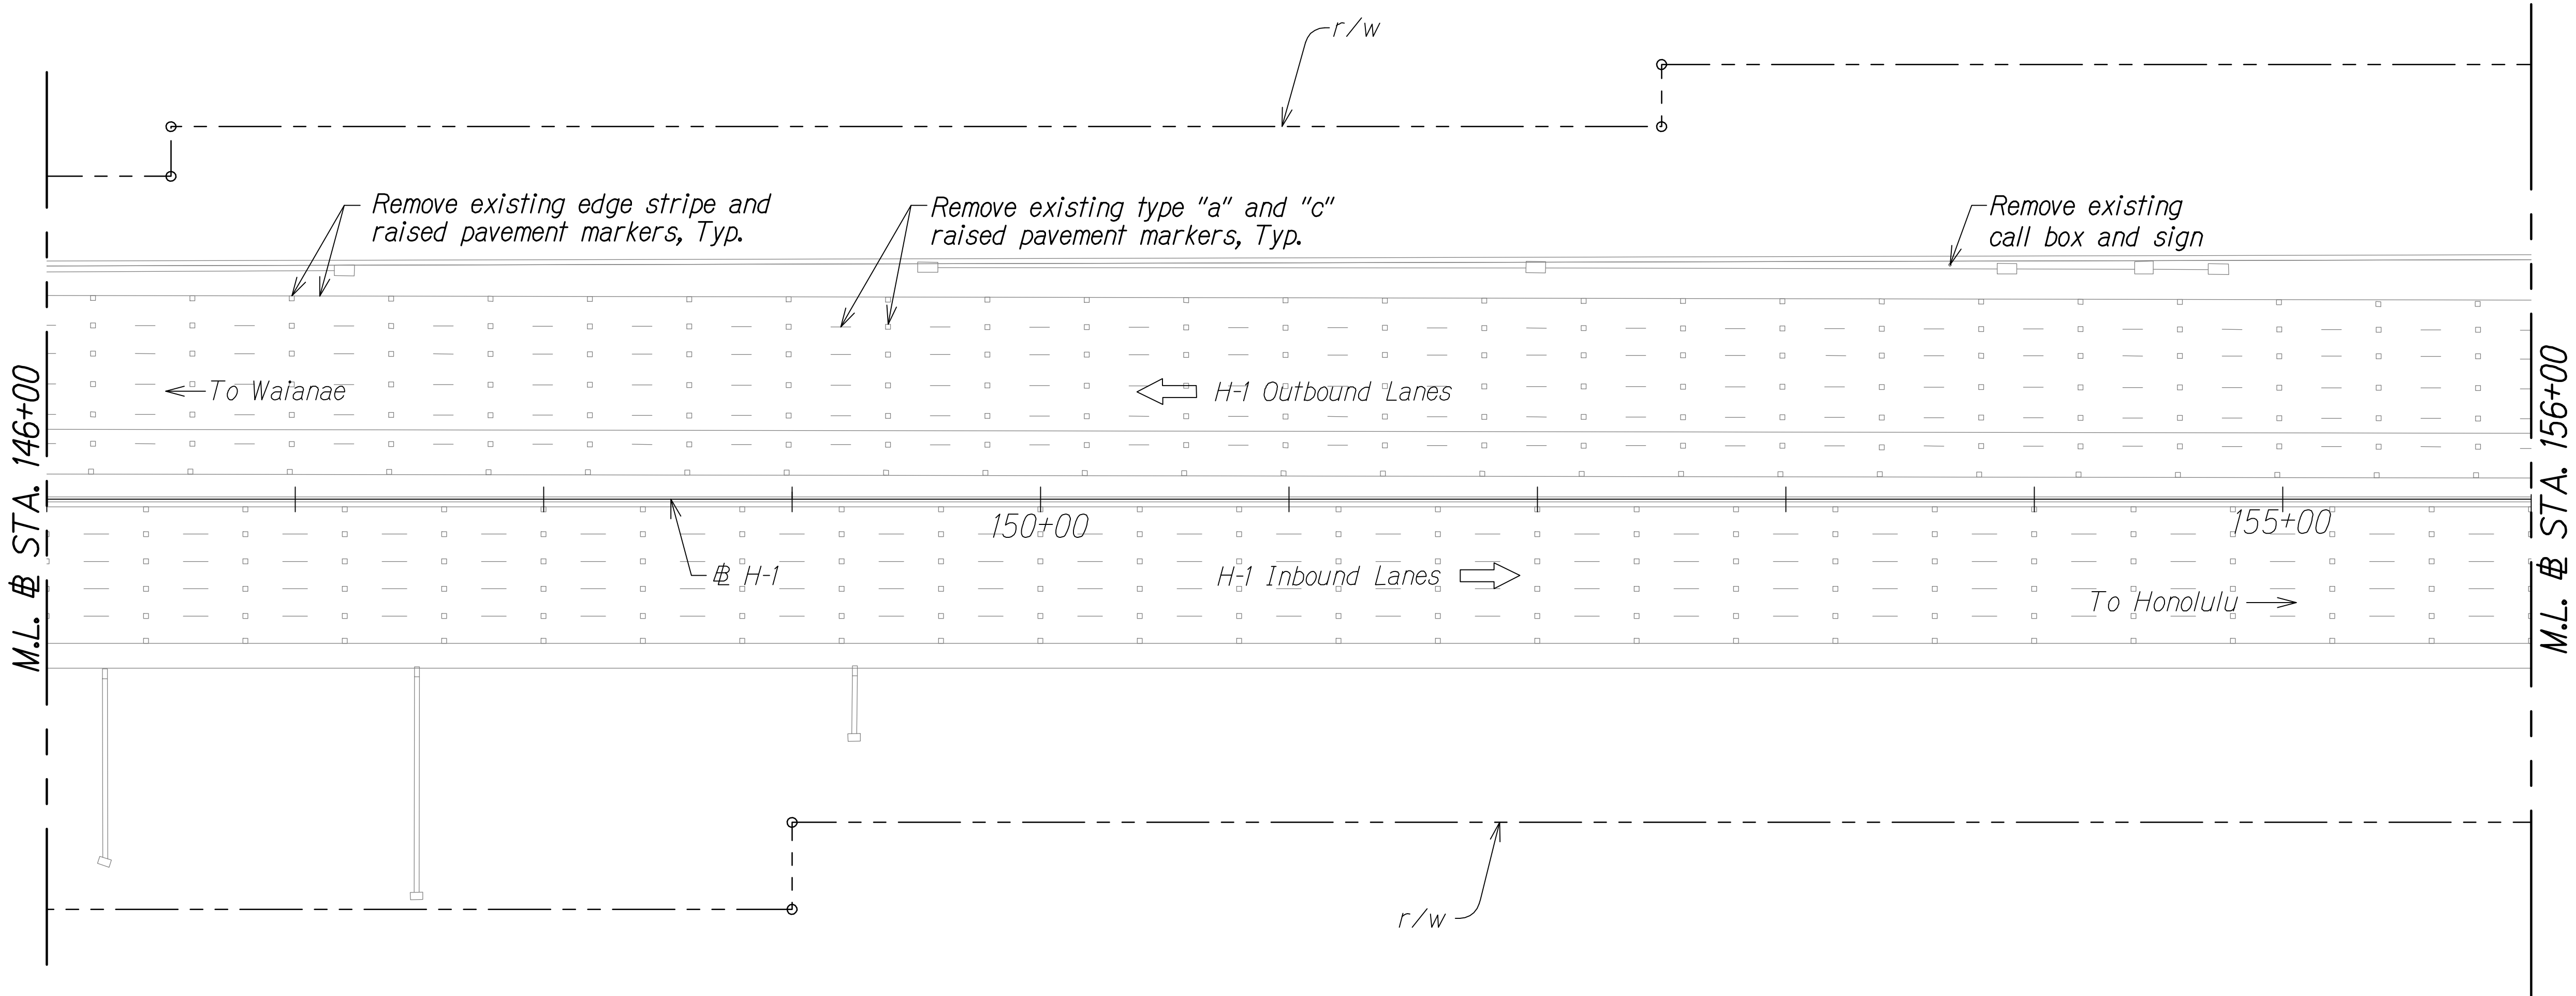

|              |      |             |                |
|--------------|------|-------------|----------------|
| QC/QA REVIEW | 100% | DATE        | MARCH 23, 2014 |
| BY           |      | DESIGNED BY |                |
| BY           |      | DESIGNED BY |                |
| BY           |      | DESIGNED BY |                |

|               |      |
|---------------|------|
| ORIGINAL PLAN | DATE |
| NOTED BY      |      |
| DESIGNED BY   |      |
| QUANTITIES BY |      |
| CHECKED BY    |      |

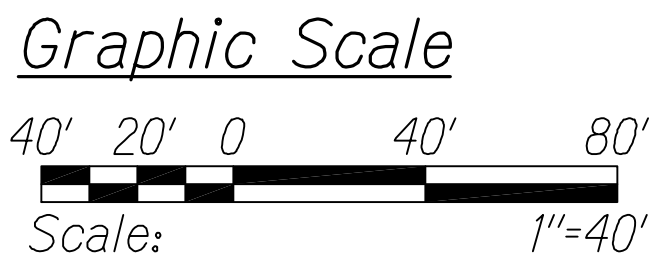

DEMOLITION PLAN  
# STA. 146+00 TO # STA. 156+00  
Scale: 1" = 40'

| LEGEND FOR AS-BUILT POSTINGS |                                     |
|------------------------------|-------------------------------------|
|                              | Squiggly line for as-built deletion |
|                              | Double line for as-built deletion   |
| Roadway                      | Text for as-built posting           |



THIS WORK WAS PREPARED BY ME  
OR UNDER MY SUPERVISION.  
*Matthew K. Fujitaka*  
WILSON OKAMOTO CORPORATION APRIL 30, 2018 LIC. EXP. DATE



STATE OF HAWAII  
DEPARTMENT OF TRANSPORTATION  
HIGHWAYS DIVISION

**DEMOLITION PLAN**

INTERSTATE ROUTE H-1  
PM CONTRAFLOW LANE, PHASE 1 & 2  
FEDERAL AID PROJECT NO. NH-HI-1 (260)  
Scale: 1" = 40' Date: July, 2016

SHEET No. DEM-23 OF 26 SHEETS

| FED. ROAD DIST. NO. | STATE | FED. AID PROJ. NO. | FISCAL YEAR | SHEET NO. | TOTAL SHEETS |
|---------------------|-------|--------------------|-------------|-----------|--------------|
| HAWAII              | HAW.  | NH-HI-1 (260)      | 2014        | 50        | 605          |

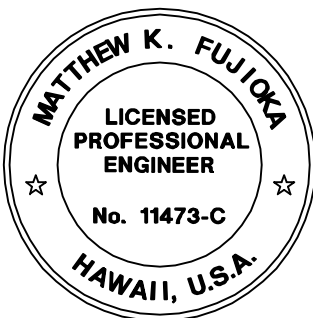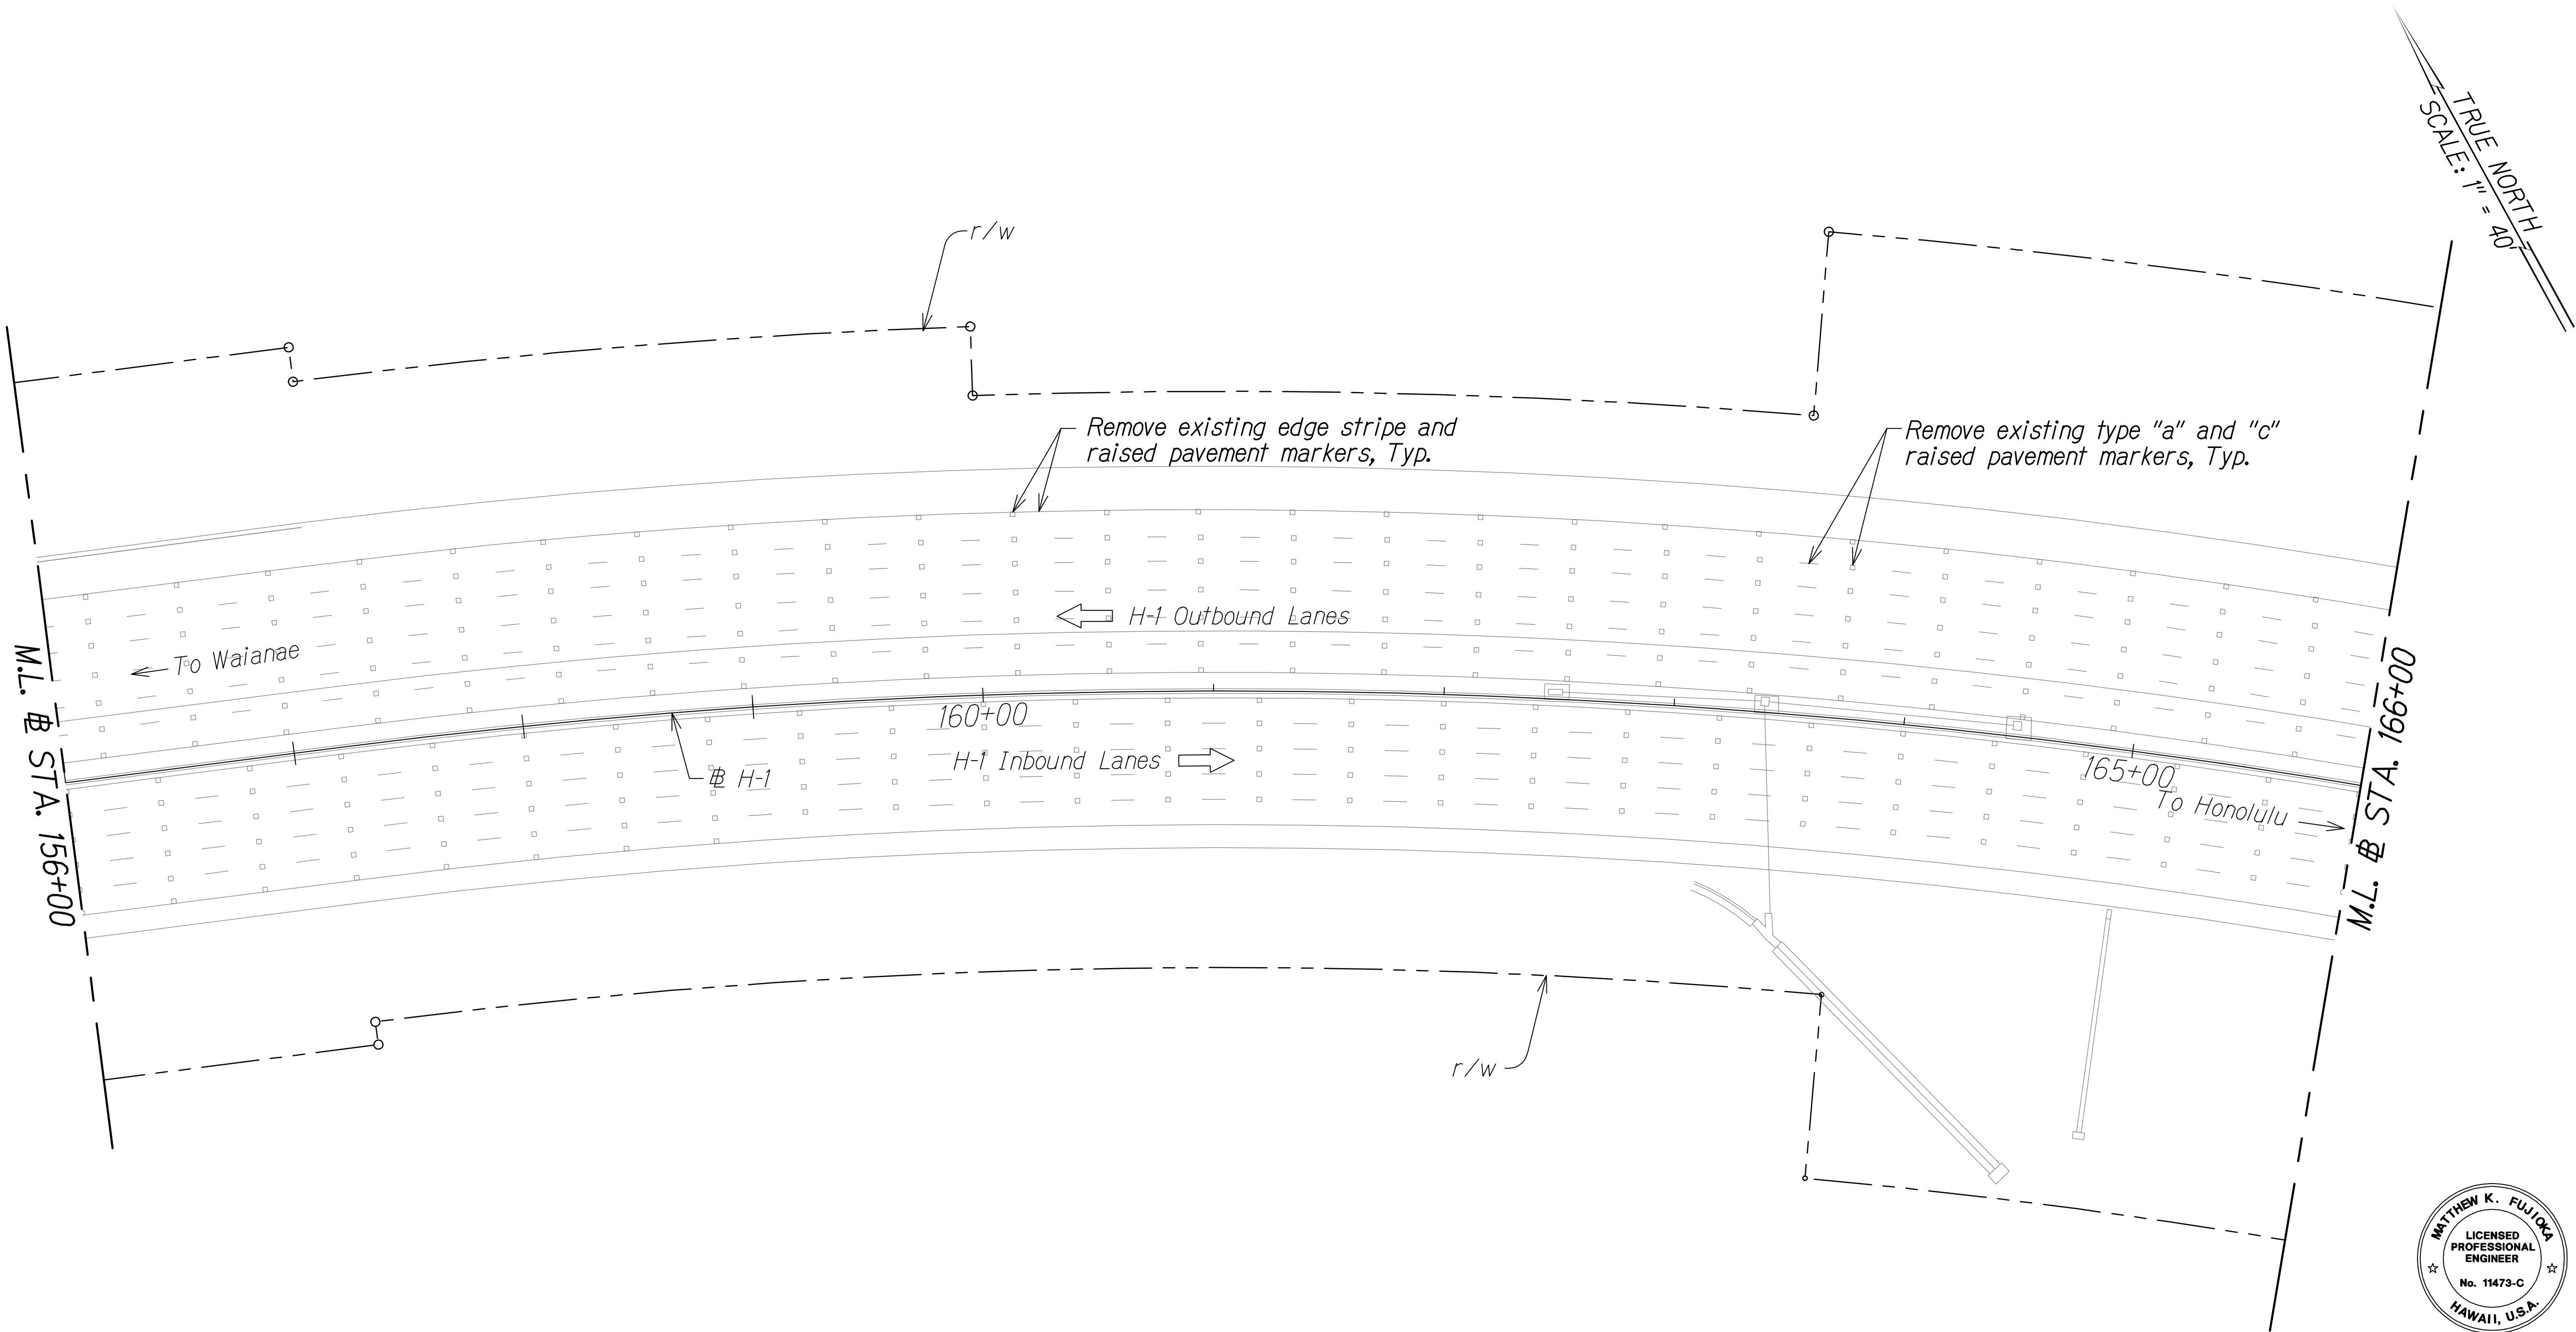

THIS WORK WAS PREPARED BY ME  
OR UNDER MY SUPERVISION.  
*Matthew K. Fujioka*  
WILSON OKAMOTO CORPORATION APRIL 30, 2018  
LIC. EXP. DATE

STATE OF HAWAII  
DEPARTMENT OF TRANSPORTATION  
HIGHWAYS DIVISION

DEMOLITION PLAN

INTERSTATE ROUTE H-1  
PM CONTRAFLOW LANE, PHASE 1 # 2  
FEDERAL AID PROJECT NO. NH-HI-1 (260)  
Scale: 1" = 40' Date: July, 2016

SHEET No. DEM-24 OF 26 SHEETS


**LEGEND FOR  
AS-BUILT POSTINGS**

Squiggly line for as-built deletion

Double line for as-built deletion

Roadway Text for as-built posting

DEMOLITION PLAN  
# STA. 156+00 TO # STA. 166+00  
Scale: 1" = 40'


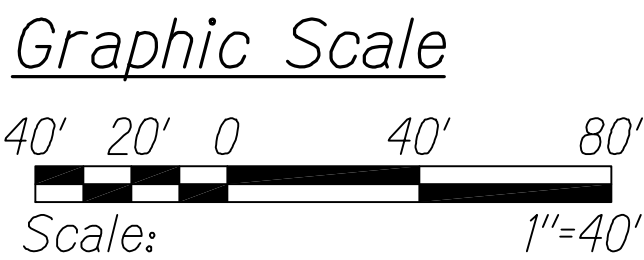


|              |      |                     |
|--------------|------|---------------------|
| QC/QA REVIEW | 100% | DATE MARCH 23, 2014 |
| BY           |      |                     |
| BY           |      |                     |
| BY           |      |                     |
| BY           |      |                     |

|                   |      |
|-------------------|------|
| SURVEY PLOTTED BY | DATE |
| DESIGNED BY       |      |
| QUANTITIES BY     |      |
| CHECKED BY        |      |


|               |     |
|---------------|-----|
| ORIGINAL PLAN | No. |
| NOTE BOOK     |     |

| FED. ROAD DIST. NO. | STATE | FED. AID PROJ. NO. | FISCAL YEAR | SHEET NO. | TOTAL SHEETS |
|---------------------|-------|--------------------|-------------|-----------|--------------|
| HAWAII              | HAW.  | NH-HI-1 (260)      | 2014        | 51        | 605          |

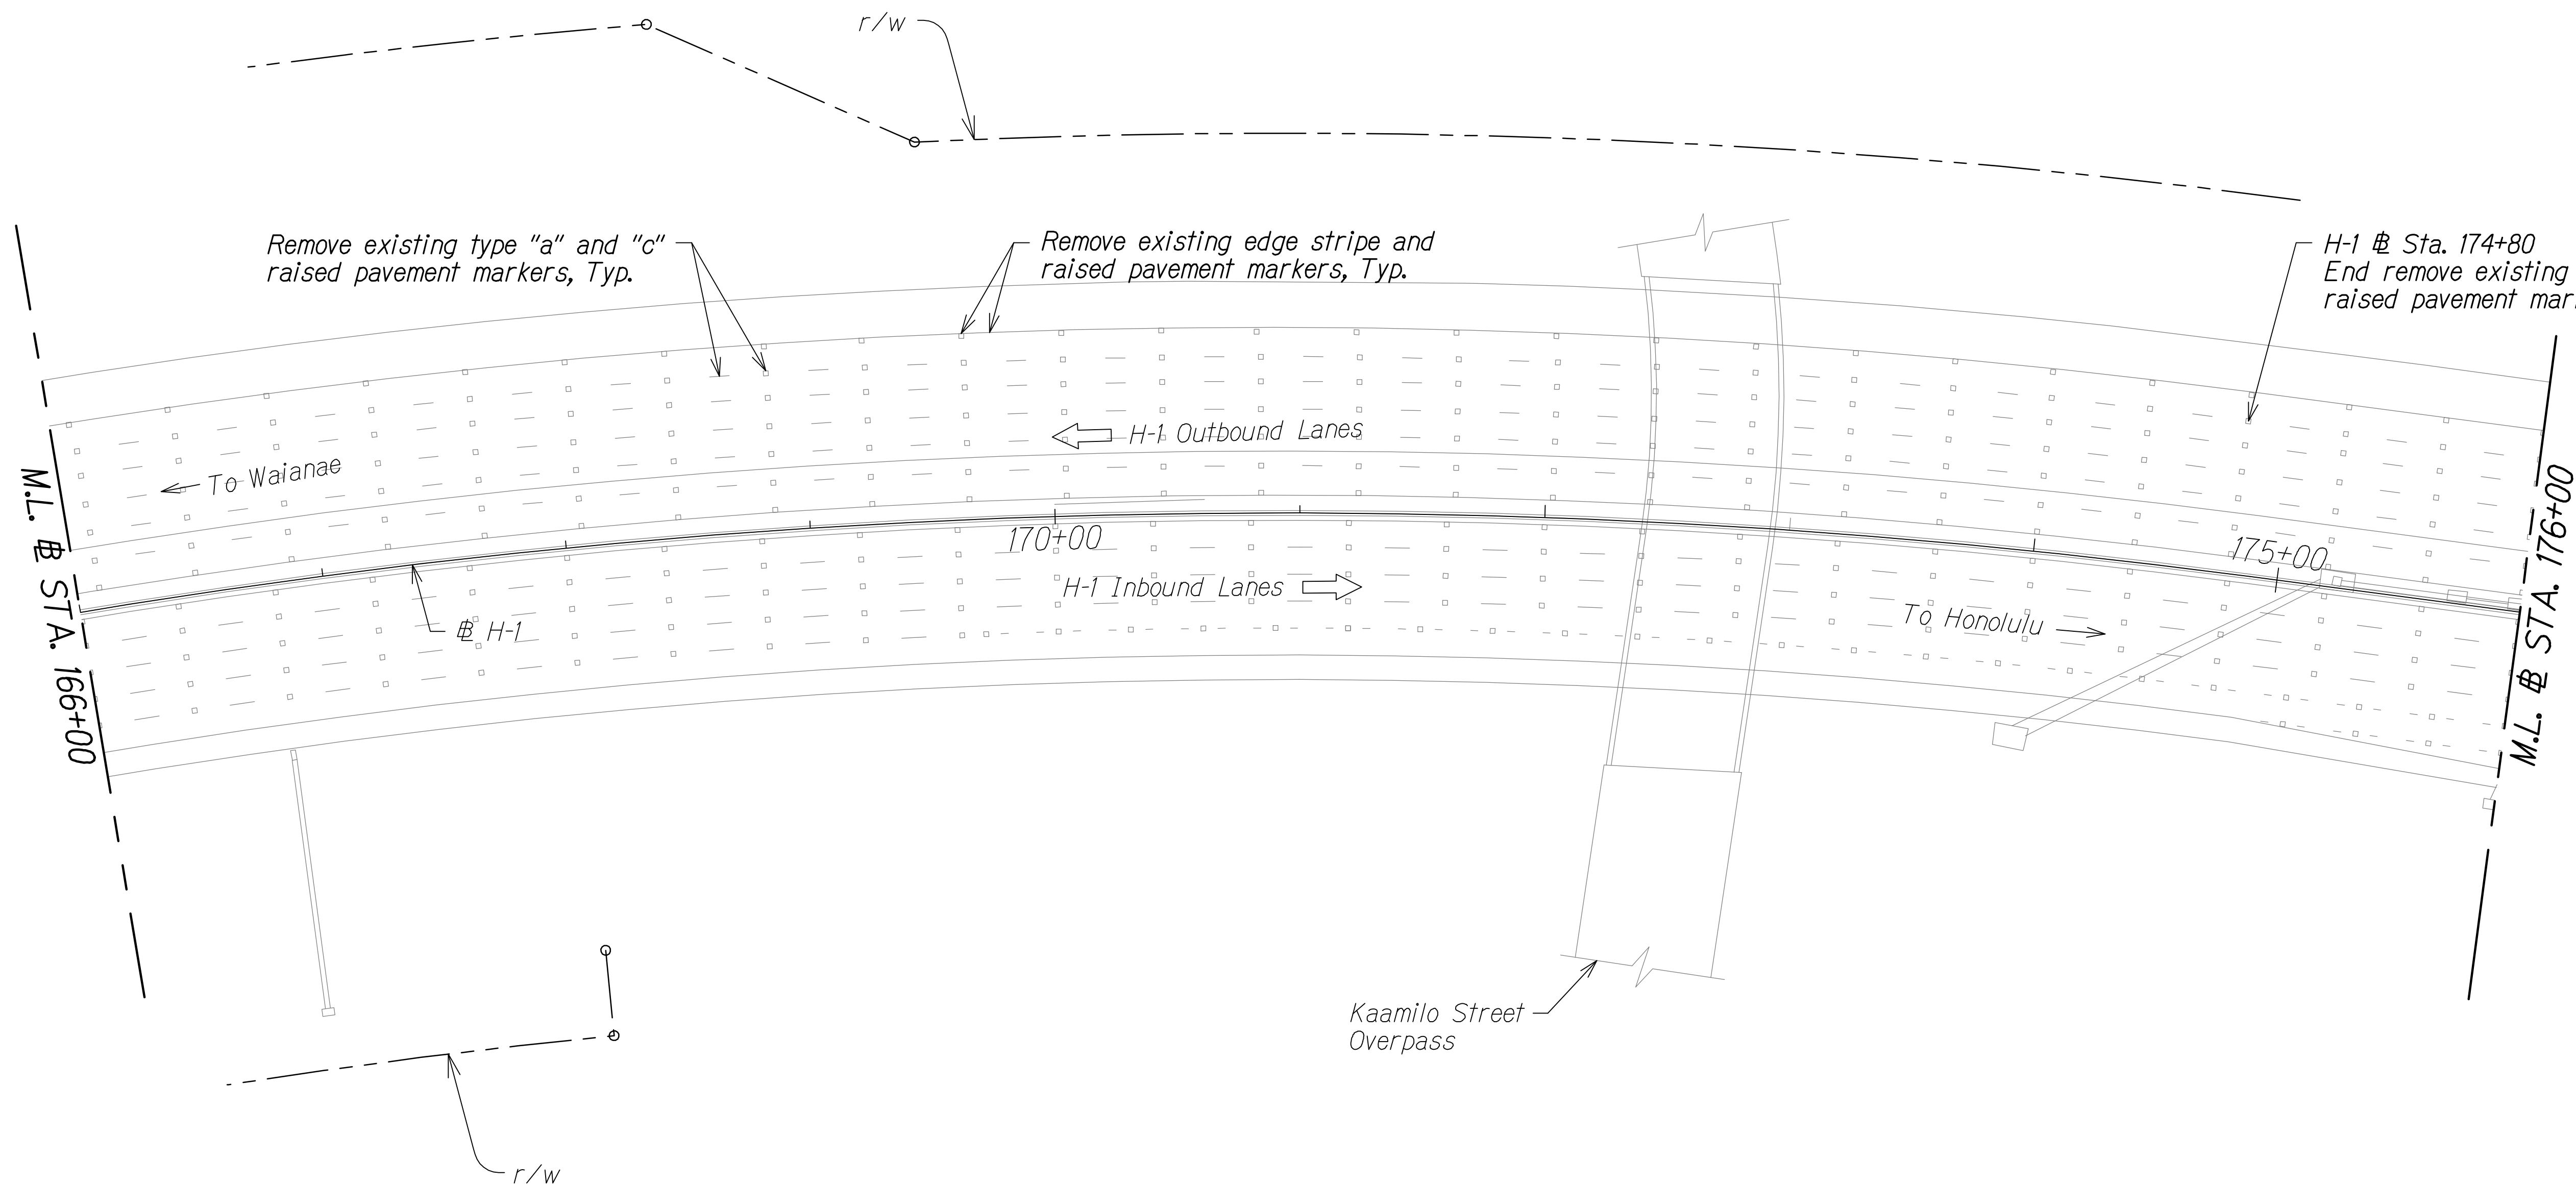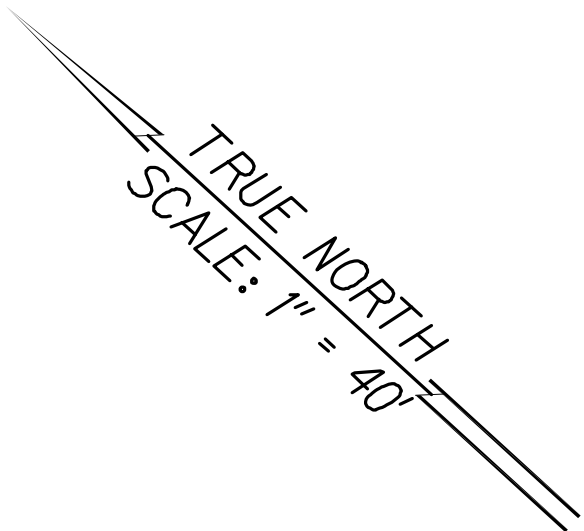

|              |      |      |                |
|--------------|------|------|----------------|
| QC/QA REVIEW | 100% | DATE | MARCH 23, 2014 |
| BY           |      | BY   |                |
| BY           |      | BY   |                |
| BY           |      | BY   |                |

|               |      |
|---------------|------|
| ORIGINAL PLAN | DATE |
| NOTED BY      |      |
| DESIGNED BY   |      |
| QUANTITIES BY |      |
| CHECKED BY    |      |

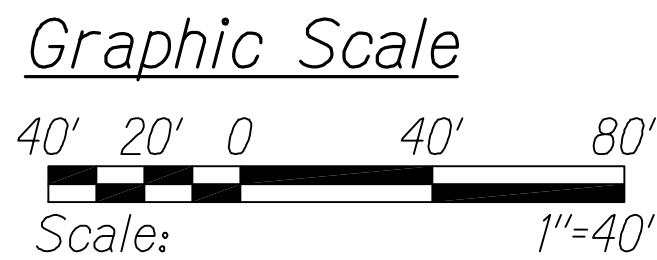


DEMOLITION PLAN  
@ STA. 166+00 TO @ STA. 176+00  
Scale: 1" = 40'

**LEGEND FOR AS-BUILT POSTINGS**

Squiggly line for as-built deletion

Double line for as-built deletion

Roadway Text for as-built posting

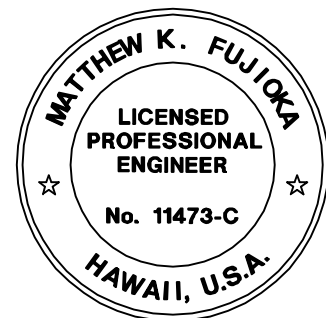

THIS WORK WAS PREPARED BY ME  
OR UNDER MY SUPERVISION.  
*Matthew K. Fujika*  
WILSON OKAMOTO CORPORATION LIC. EXP. DATE


STATE OF HAWAII  
DEPARTMENT OF TRANSPORTATION  
HIGHWAYS DIVISION

**DEMOLITION PLAN**

INTERSTATE ROUTE H-1  
PM CONTRAFLOW LANE, PHASE 1 @ 2  
FEDERAL AID PROJECT NO. NH-HI-1 (260)  
Scale: 1" = 40' Date: July, 2016

SHEET No. DEM-25 OF 26 SHEETS

| FED. ROAD DIST. NO. | STATE | FED. AID PROJ. NO. | FISCAL YEAR | SHEET NO. | TOTAL SHEETS |
|---------------------|-------|--------------------|-------------|-----------|--------------|
| HAWAII              | HAW.  | NH-HI-1 (260)      | 2014        | 52        | 605          |

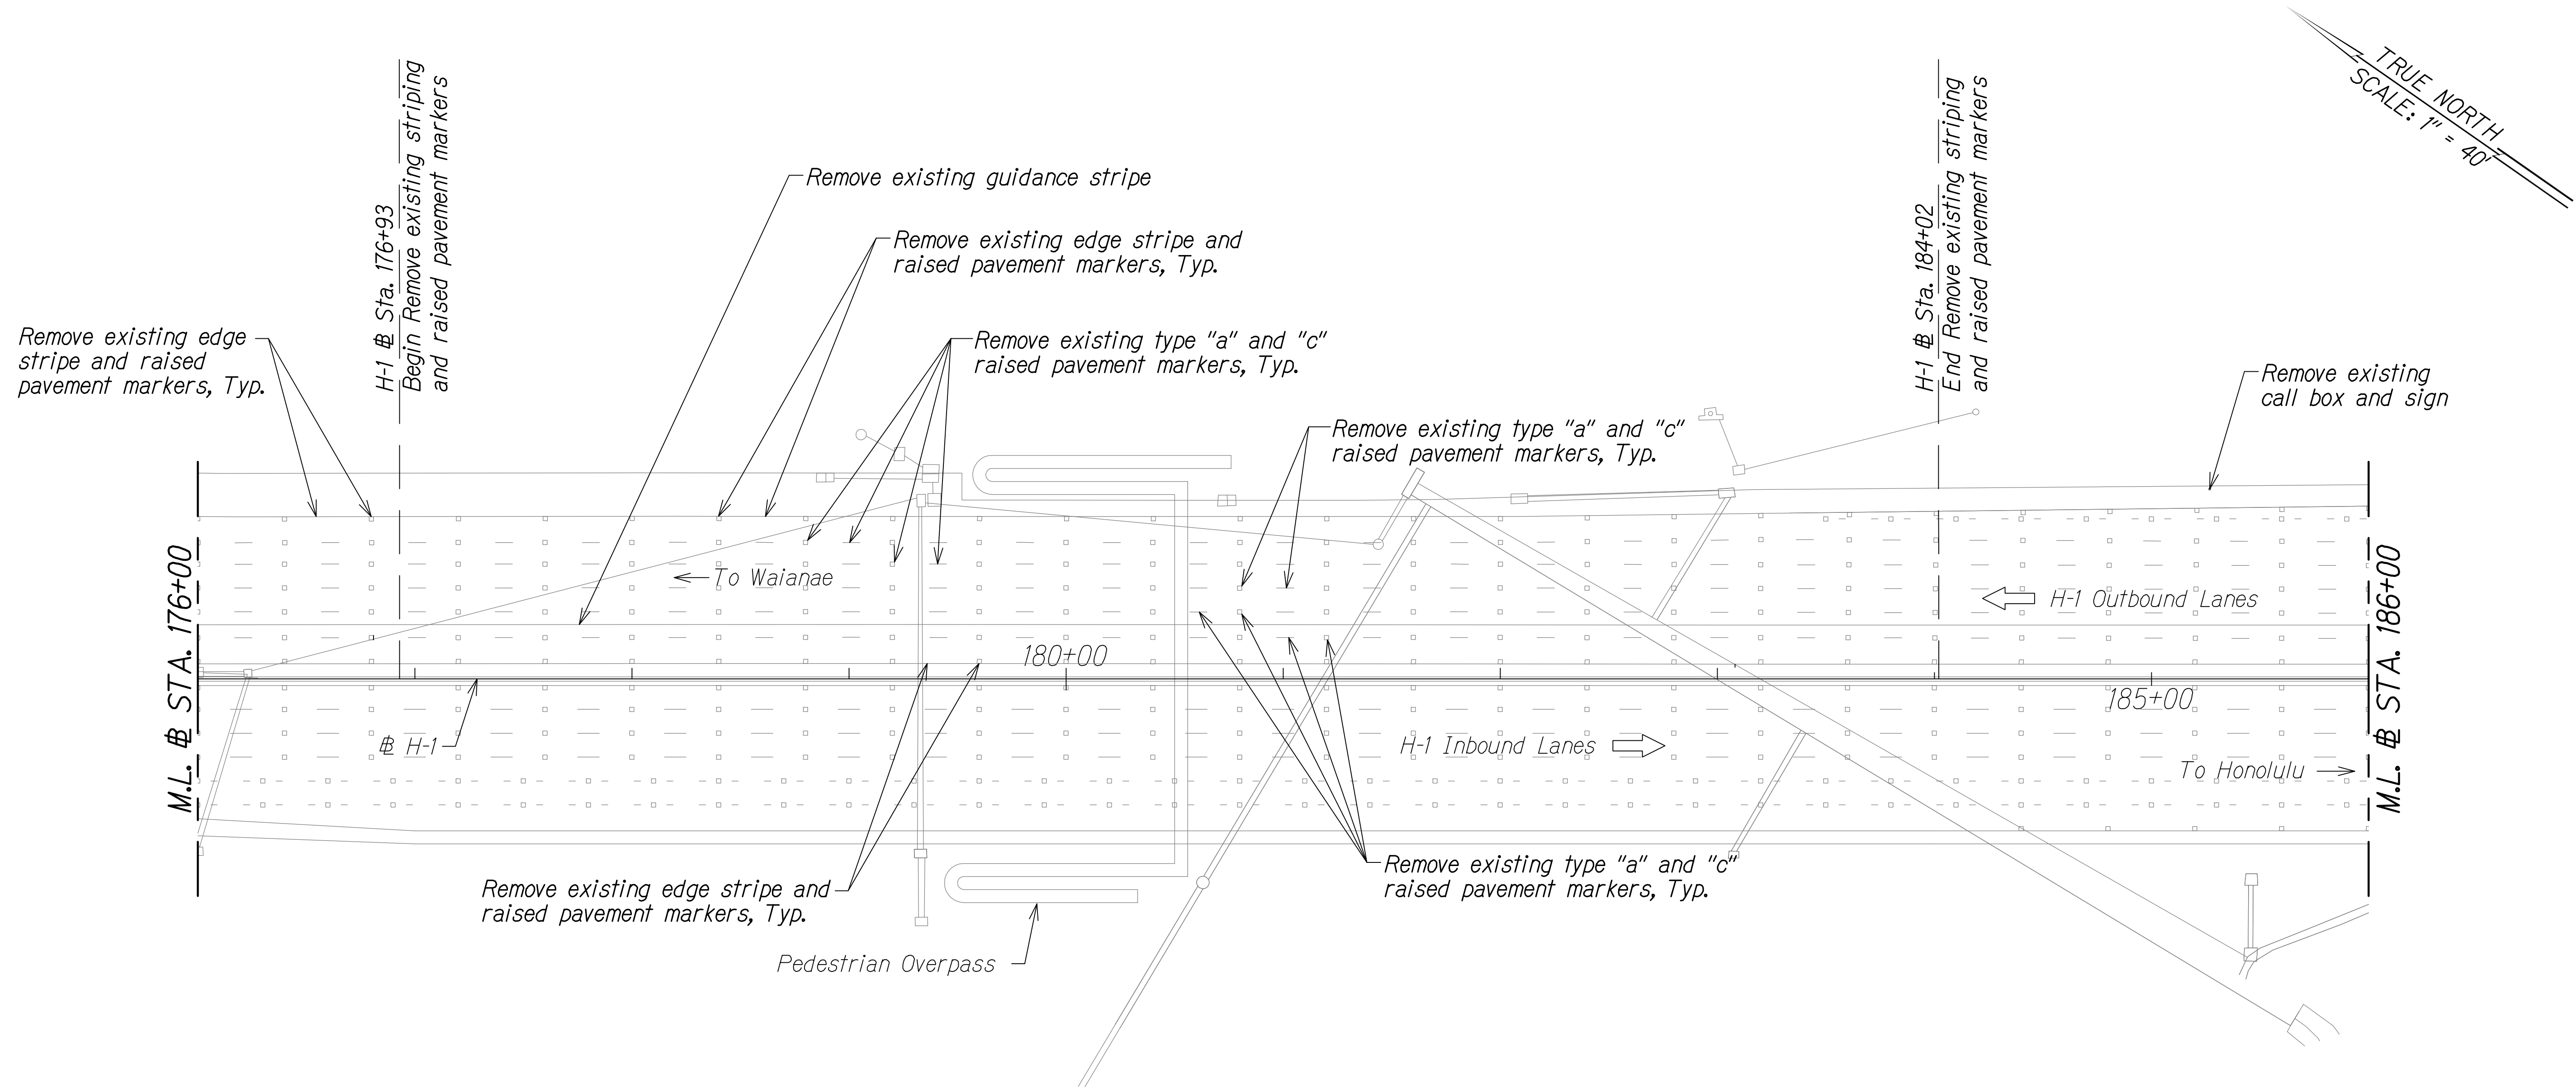

**LEGEND FOR AS-BUILT POSTINGS**

Squiggly line for as-built deletion

Double line for as-built deletion

Roadway Text for as-built posting

STATE OF HAWAII  
DEPARTMENT OF TRANSPORTATION  
HIGHWAYS DIVISION

**DEMOLITION PLAN**

INTERSTATE ROUTE H-1  
PM CONTRAFLOW LANE, PHASE 1 & 2  
FEDERAL AID PROJECT NO. NH-HI-1 (260)  
Scale: 1" = 40' Date: July, 2016


SHEET No. DEM-26 OF 26 SHEETS



THIS WORK WAS PREPARED BY ME OR UNDER MY SUPERVISION.

*Matthew K. Fujitaka*  
WILSON OKAMOTO CORPORATION APRIL 30, 2018 LIC. EXP. DATE

- Notes:
1. Remove all outbound lane existing striping and raised pavement markers as noted.

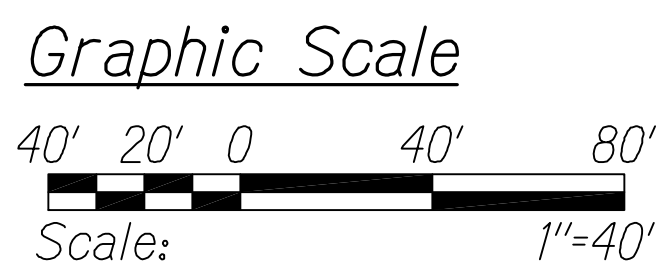

DEMOLITION PLAN  
# STA. 176+00 TO # STA. 186+00  
Scale: 1" = 40'

|              |      |             |                |
|--------------|------|-------------|----------------|
| QC/QA REVIEW | 100% | DATE        | MARCH 23, 2014 |
| BY           |      | DESIGNED BY |                |
| BY           |      | DESIGNED BY |                |
| BY           |      | DESIGNED BY |                |

|                   |      |
|-------------------|------|
| SURVEY PLOTTED BY | DATE |
| REVIEWED BY       |      |
| DESIGNED BY       |      |
| QUANTITIES BY     |      |
| CHECKED BY        |      |

ORIGINAL PLAN

NOTE BOOK

No.