


DETAILED INDEX						FED. ROAD DIST. NO.	STATE	FED. AID PROJ. NO.	FISCAL YEAR	SHEET NO.	TOTAL SHEETS
						HAWAII	HAW.	NH-H1-1 (260)	2014	2	605
DWG NO.	DESCRIPTION	DWG NO.	DESCRIPTION	DWG NO.	DESCRIPTION	DWG NO.	DESCRIPTION				
1	Title Sheet	47	Demolition Plan	93	Retaining Wall & Barrier Details	139	Pavement Marking and Striping Plan				
2	Detailed Index	48	Demolition Plan	94	Retaining Wall & Barrier Details	140	Pavement Marking and Striping Plan				
3	Detailed Index	49	Demolition Plan	95	Grading Plan	141	Pavement Marking and Striping Plan				
4	Standard Plans Summary	50	Demolition Plan	96	Grading Plan	142	Pavement Marking and Striping Plan				
5	General Notes	51	Demolition Plan	97	Grading Plan	143	Signing Plan				
6	General Notes & Legend	52	Demolition Plan	98	Grading Plan	144	Signing Plan				
7	Traffic Control and Grading Notes	53	Roadway Plan	99	Grading Plan	145	Sign Details				
8	Water Pollution and Erosion Control Notes	54	Roadway Plan	100	Grading Plan	146	Sign Details				
9	WP, EC, Signing, Pavement Marking Notes	55	Roadway Plan	101	Grading Plan	147	Sign Details				
10	General Layout Plan	56	Roadway Plan	102	Grading Plan	148	Sign Details				
11	General Layout Plan	57	Roadway Plan	103	Grading Plan	149	Sign Details				
12	General Layout Plan	58	Roadway Plan	104	Grading Plan	150	Sign Details				
13	Typical Sections	59	Roadway Plan	105	Grading Plan	151	Erosion Control and Drainage Plan				
14	Typical Sections	60	Roadway Plan	106	Grading Plan	152	Erosion Control and Drainage Plan				
15	Typical Sections	61	Roadway Plan	107	Grading Plan	153	Erosion Control and Drainage Plan				
16	Typical Sections	62	Roadway Plan	108	Grading Plan	154	Erosion Control and Drainage Plan				
17	Typical Sections	63	Roadway Plan	109	Grading Plan	155	Erosion Control and Drainage Plan				
18	Typical Sections	64	Roadway Plan	110	Grading Plan	156	Erosion Control and Drainage Plan				
19	Typical Sections	65	Roadway Plan	111	Grading Plan	157	Erosion Control and Drainage Plan				
20	Typical Sections	66	Roadway Plan	112	Grading Plan	158	Erosion Control and Drainage Plan				
21	Typical Sections	67	Roadway Plan	113	Grading Plan	159	Erosion Control and Drainage Plan				
22	Typical Sections	68	Roadway Plan	114	Grading Plan	160	Erosion Control and Drainage Plan				
23	Typical Sections	69	Roadway Plan	115	Grading Plan	161	Erosion Control and Drainage Plan				
24	Typical Sections	70	Roadway Plan	116	Pavement Marking and Striping Plan	162	Erosion Control and Drainage Plan				
25	Typical Sections	71	Roadway Plan	117	Pavement Marking and Striping Plan	163	Erosion Control and Drainage Plan				
26	Typical Sections	72	Roadway Plan	118	Pavement Marking and Striping Plan	164	Erosion Control and Drainage Plan				
27	Demolition Plan	73	Roadway Plan	119	Pavement Marking and Striping Plan	165	Erosion Control and Drainage Plan				
28	Demolition Plan	74	Roadway Plan	120	Pavement Marking and Striping Plan						
29	Demolition Plan	75	Roadway Plan	121	Pavement Marking and Striping Plan						
30	Demolition Plan	76	Roadway Plan	122	Pavement Marking and Striping Plan						
31	Demolition Plan	77	Roadway Plan	123	Pavement Marking and Striping Plan						
32	Demolition Plan	78	Roadway Plan	124	Pavement Marking and Striping Plan						
33	Demolition Plan	79	Detailed Roadway Plan	125	Pavement Marking and Striping Plan						
34	Demolition Plan	80	Detailed Roadway Plan	126	Pavement Marking and Striping Plan						
35	Demolition Plan	81	Detailed Roadway Plan	127	Pavement Marking and Striping Plan						
36	Demolition Plan	82	Detailed Roadway Plan	128	Pavement Marking and Striping Plan						
37	Demolition Plan	83	Detailed Roadway Plan	129	Pavement Marking and Striping Plan						
38	Demolition Plan	84	Detailed Roadway Plan	130	Pavement Marking and Striping Plan						
39	Demolition Plan	85	Detailed Roadway Plan	131	Pavement Marking and Striping Plan						
40	Demolition Plan	86	Detailed Roadway Plan	132	Pavement Marking and Striping Plan						
41	Demolition Plan	87	Detailed Roadway Plan	133	Pavement Marking and Striping Plan						
42	Demolition Plan	88	Detailed Roadway Plan	134	Pavement Marking and Striping Plan						
43	Demolition Plan	89	Detailed Roadway Plan	135	Pavement Marking and Striping Plan						
44	Demolition Plan	90	Retaining Wall Profile	136	Pavement Marking and Striping Plan						
45	Demolition Plan	91	Retaining Wall & Barrier Details	137	Pavement Marking and Striping Plan						
46	Demolition Plan	92	Retaining Wall & Barrier Details	138	Pavement Marking and Striping Plan						


QC/QA REVIEW 100%  
☐ BY                       
☐ BY                       
☐ BY                       
☐ BY

DATE MARCH 23, 2014


DESIGNED BY                       
CHECKED BY                       
DATE                       
SURVEY PLOTTED BY                       
ORIGINAL PLAN                       
NOTE BOOK                       
No.

LEGEND FOR  
AS-BUILT POSTINGS


 Squiggly line for as-built deletion

 Double line for as-built deletion

Roadway Text for as-built posting



THIS WORK WAS PREPARED BY ME  
OR UNDER MY SUPERVISION.



APRIL 30, 2018  
WILSON OKAMOTO CORPORATION LIC. EXP. DATE

STATE OF HAWAII  
DEPARTMENT OF TRANSPORTATION  
HIGHWAYS DIVISION

DETAILED INDEX




INTERSTATE ROUTE H-1  
PM CONTRAFLOW LANE, PHASE 1 & 2  
FEDERAL AID PROJECT NO. NH-H1-1 (260)  
Scale: None Date: July, 2016


SHEET No. T-2 OF 4 SHEETS

"AS-BUILT"2



FED. ROAD DIST. NO.	STATE	FED. AID PROJ. NO.	FISCAL YEAR	SHEET NO.	TOTAL SHEETS
HAWAII	HAW.	NH-HI-1 (260)	2014	3	605

LEGEND FOR AS-BUILT POSTINGS	
	Squiggly line for as-built deletion
	Double line for as-built deletion
	Text for as-built posting

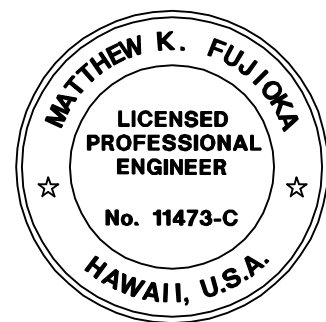

THIS WORK WAS PREPARED BY ME  
OR UNDER MY SUPERVISION.

*[Signature]* APRIL 30, 20  
WILSON OKAMOTO CORPORATION LIC. EXP. DA

STATE OF HAWAII  
DEPARTMENT OF TRANSPORTATION  
HIGHWAYS DIVISION

INTERSTATE ROUTE H-1  
PM CONTRAFLOW LANE, PHASE 1 & 2  
FEDERAL AID PROJECT NO. NH-H1-1 (260)  
 Scale: None Date: July, 2016

QC/QA REVIEW 100%  
☐ BY Mark  
☐ BY Paul  
☐ BY \_\_\_\_\_  
☐ BY \_\_\_\_\_

DATE: MARCH 23, 2017  
Barry St. Joseph  
Joe P. Belmont

ORIGINAL PLAN	SURVEY PLOTTED BY _____	DATE _____
NOTE BOOK	DRAWN BY _____	" _____
	TRACED BY _____	" _____
	DESIGNED BY _____	" _____
	QUANTITIES BY _____	" _____
No. _____	CHECKED BY _____	" _____