

FED. ROAD DIST. NO.	STATE	FED. AID PROJ. NO.	FISCAL YEAR	SHEET NO.	TOTAL SHEETS
HAWAII	HAW.	NH-H1-1 (260)	2014	10	605




QC/QA REVIEW 100%	DATE MARCH 23, 2016
BY: [Signature]	
BY: [Signature]	
BY: [Signature]	

SURVEY PLOTTED BY	DATE
DESIGNED BY	
NOTED BY	
CHECKED BY	

Legend:

1 Plan Sheet Corresponding to Roadway Plan Drawing No. 1

Graphic Scale

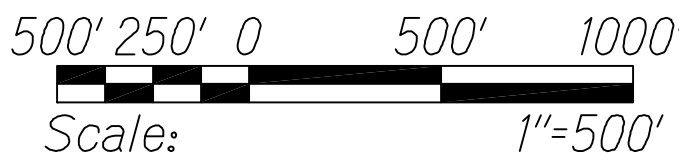

GENERAL LAYOUT PLAN
STA. 457+00 TO # STA. 490+00
Scale: 1" = 500'

BEGIN PROJECT
Project No. NH-H1-1(260) &
Project No. BR-H1-1(263)
Sta. 457+00

LEGEND FOR AS-BUILT POSTINGS	
	Squiggly line for as-built deletion
	Double line for as-built deletion
Roadway	Text for as-built posting



THIS WORK WAS PREPARED BY ME OR UNDER MY SUPERVISION.
[Signature]
APRIL 30, 2016
WILSON OKAMOTO CORPORATION LIC. EXP. DATE


STATE OF HAWAII
DEPARTMENT OF TRANSPORTATION
HIGHWAYS DIVISION

GENERAL LAYOUT PLAN

INTERSTATE ROUTE H-1
PM CONTRAFLOW LANE, PHASE 1 & 2
FEDERAL AID PROJECT NO. NH-H1-1 (260)
Scale: 1" = 500' Date: July, 2016

SHEET No. GEN-01 OF 3 SHEETS

FED. ROAD DIST. NO.	STATE	FED. AID PROJ. NO.	FISCAL YEAR	SHEET NO.	TOTAL SHEETS
HAWAII	HAW.	NH-HI-1 (260)	2014	11	605

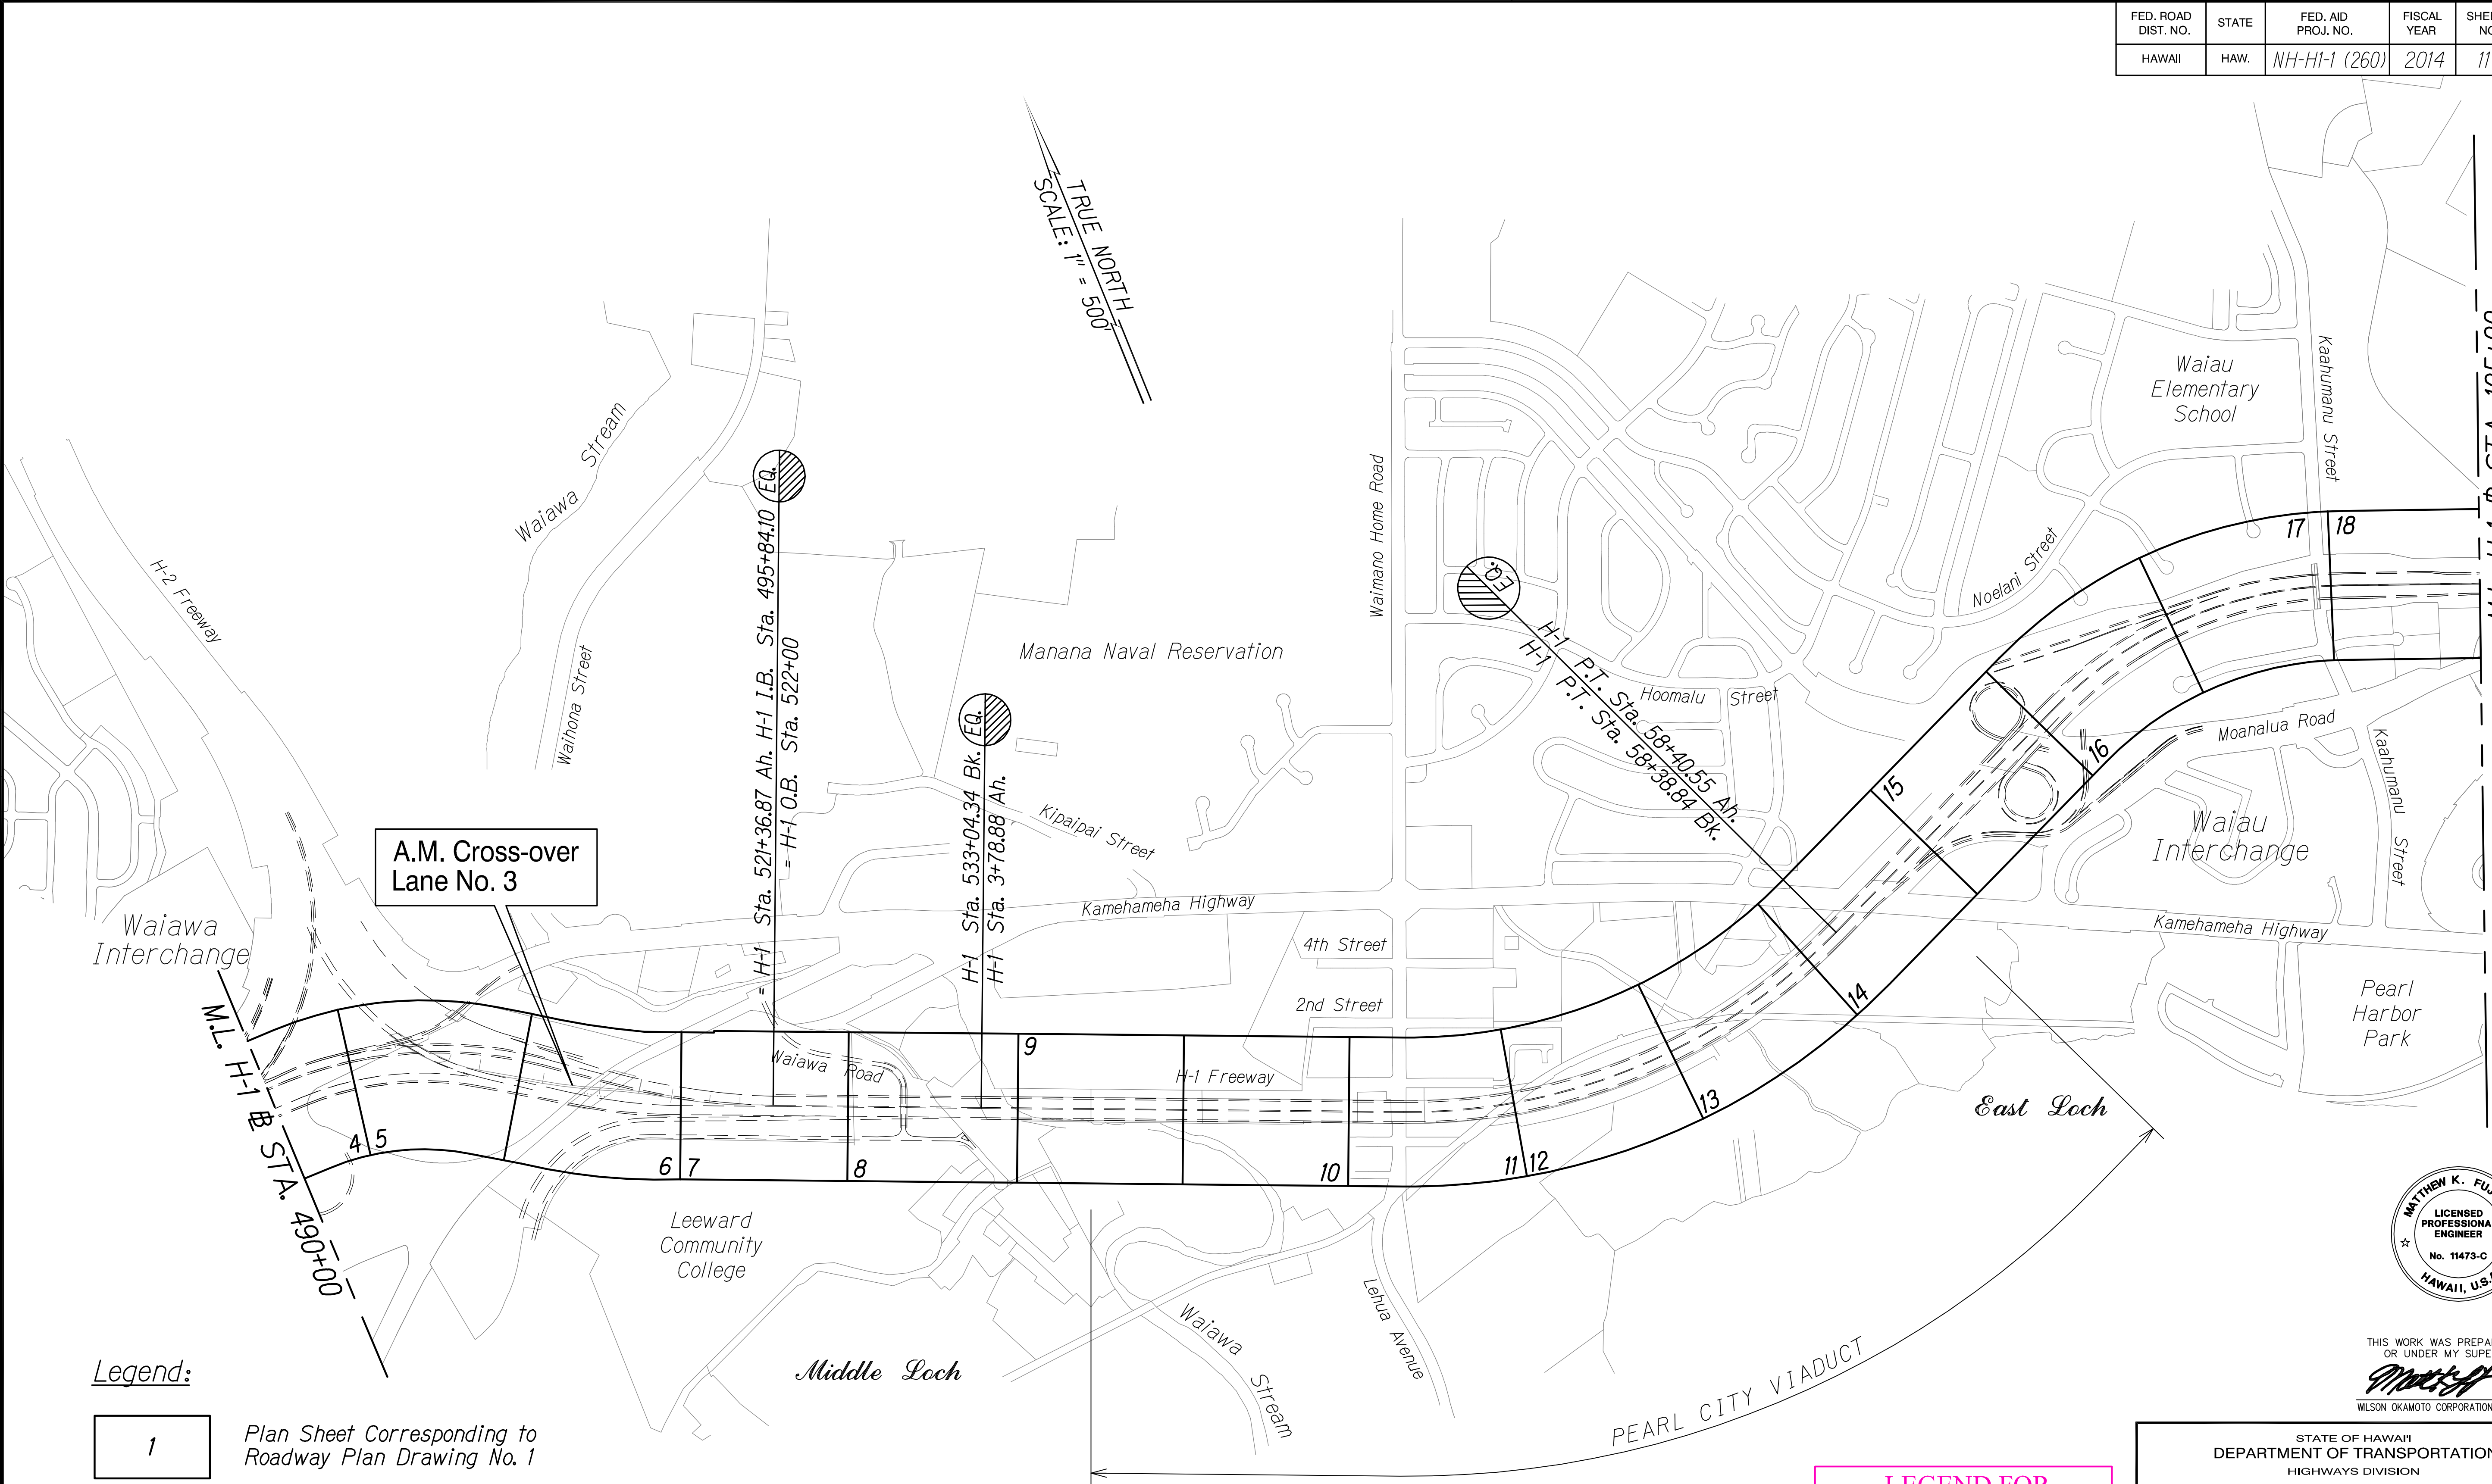

LEGEND FOR AS-BUILT POSTINGS

Squiggly line for as-built deletion

Double line for as-built deletion

Roadway Text for as-built posting

STATE OF HAWAII
DEPARTMENT OF TRANSPORTATION
HIGHWAYS DIVISION

GENERAL LAYOUT PLAN

INTERSTATE ROUTE H-1
PM CONTRAFLOW LANE, PHASE 1 & 2
FEDERAL AID PROJECT NO. NH-HI-1 (260)

Scale: 1" = 500' Date: July, 2016

SHEET No. GEN-02 OF 3 SHEETS

Legend:

Plan Sheet Corresponding to Roadway Plan Drawing No. 1

Graphic Scale

500' 250' 0 500' 1000'


Scale: 1"=500'

GENERAL LAYOUT PLAN
STA. 490+00 TO # STA. 105+00
Scale: 1" = 500'

QC/QA REVIEW 100%
DATE: MARCH 23, 2016
BY: [Signature]
OBY: [Signature]

SURVEY PLOTTED BY: [Signature]
DATE: [Blank]
DESIGNED BY: [Signature]
QUANTITIES BY: [Signature]
CHECKED BY: [Signature]


ORIGINAL PLAN
NOTE BOOK
No. [Blank]

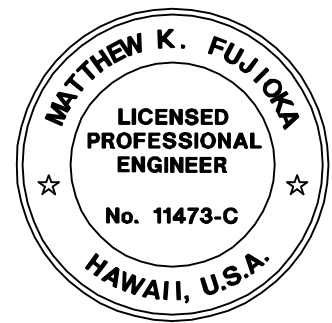

THIS WORK WAS PREPARED BY ME
OR UNDER MY SUPERVISION.

APRIL 30, 2018
WILSON OKAMOTO CORPORATION LIC. EXP. DATE

FED. ROAD DIST. NO.	STATE	FED. AID PROJ. NO.	FISCAL YEAR	SHEET NO.	TOTAL SHEETS
HAWAII	HAW.	NH-H1-1 (260)	2014	12	605

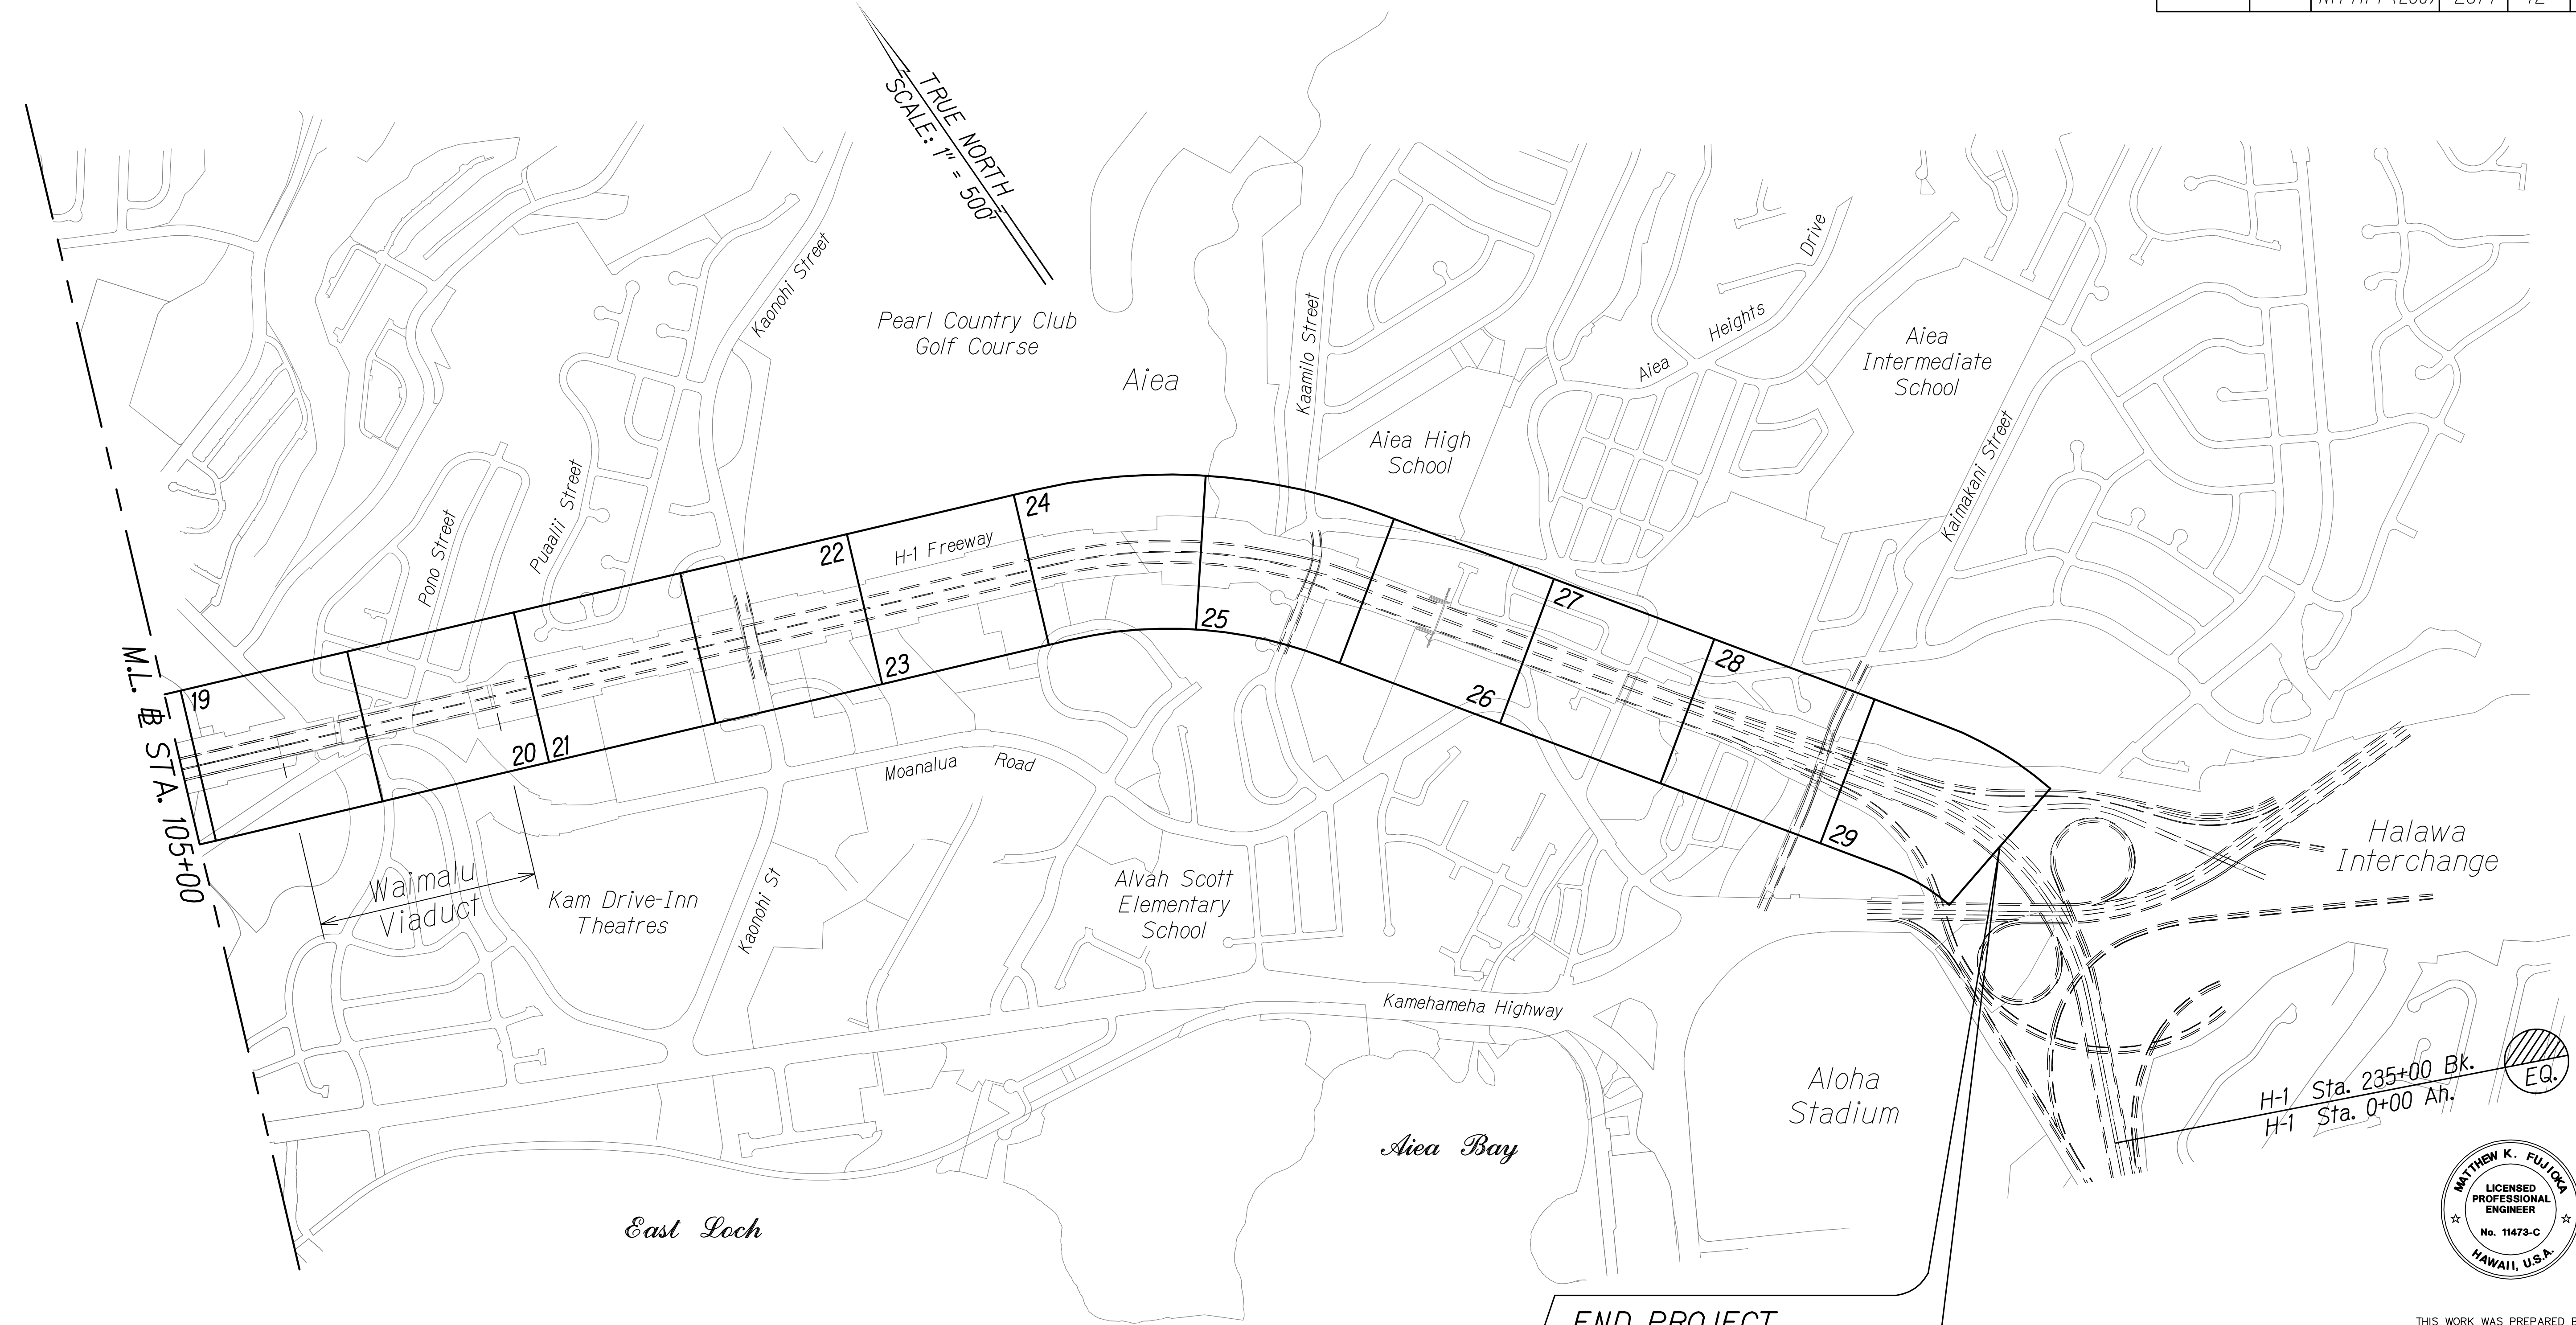

Legend:

1 Plan Sheet Corresponding to Roadway Plan Drawing No. 1


Graphic Scale



GENERAL LAYOUT PLAN
STA. 105+00 TO # STA. 237+00
Scale: 1" = 500'

END PROJECT
Project No. NH-H1-1(260) &
Project No. BR-H1-1(263)
Sta. 216+00

LEGEND FOR
AS-BUILT POSTINGS
Squiggly line for as-built deletion
Double line for as-built deletion
Roadway Text for as-built posting

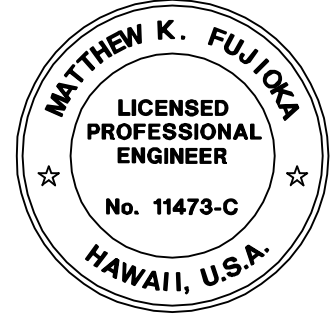

THIS WORK WAS PREPARED BY ME OR UNDER MY SUPERVISION.
APRIL 30, 2016
WILSON OKAMOTO CORPORATION LIC. EXP. DATE

STATE OF HAWAII
DEPARTMENT OF TRANSPORTATION
HIGHWAYS DIVISION
GENERAL LAYOUT PLAN
INTERSTATE ROUTE H-1
PM CONTRAFLOW LANE, PHASE 1 & 2
FEDERAL AID PROJECT NO. NH-H1-1 (260)
Scale: 1" = 500' Date: July, 2016
SHEET No. GEN-03 OF 3 SHEETS