



FED. ROAD DIST. NO.	STATE	FED. AID PROJ. NO.	FISCAL YEAR	SHEET NO.	TOTAL SHEETS
HAWAII	HAW.	NH-HI-1 (260)	2014	116	605

TRUE NORTH
SCALE: 1" = 40'

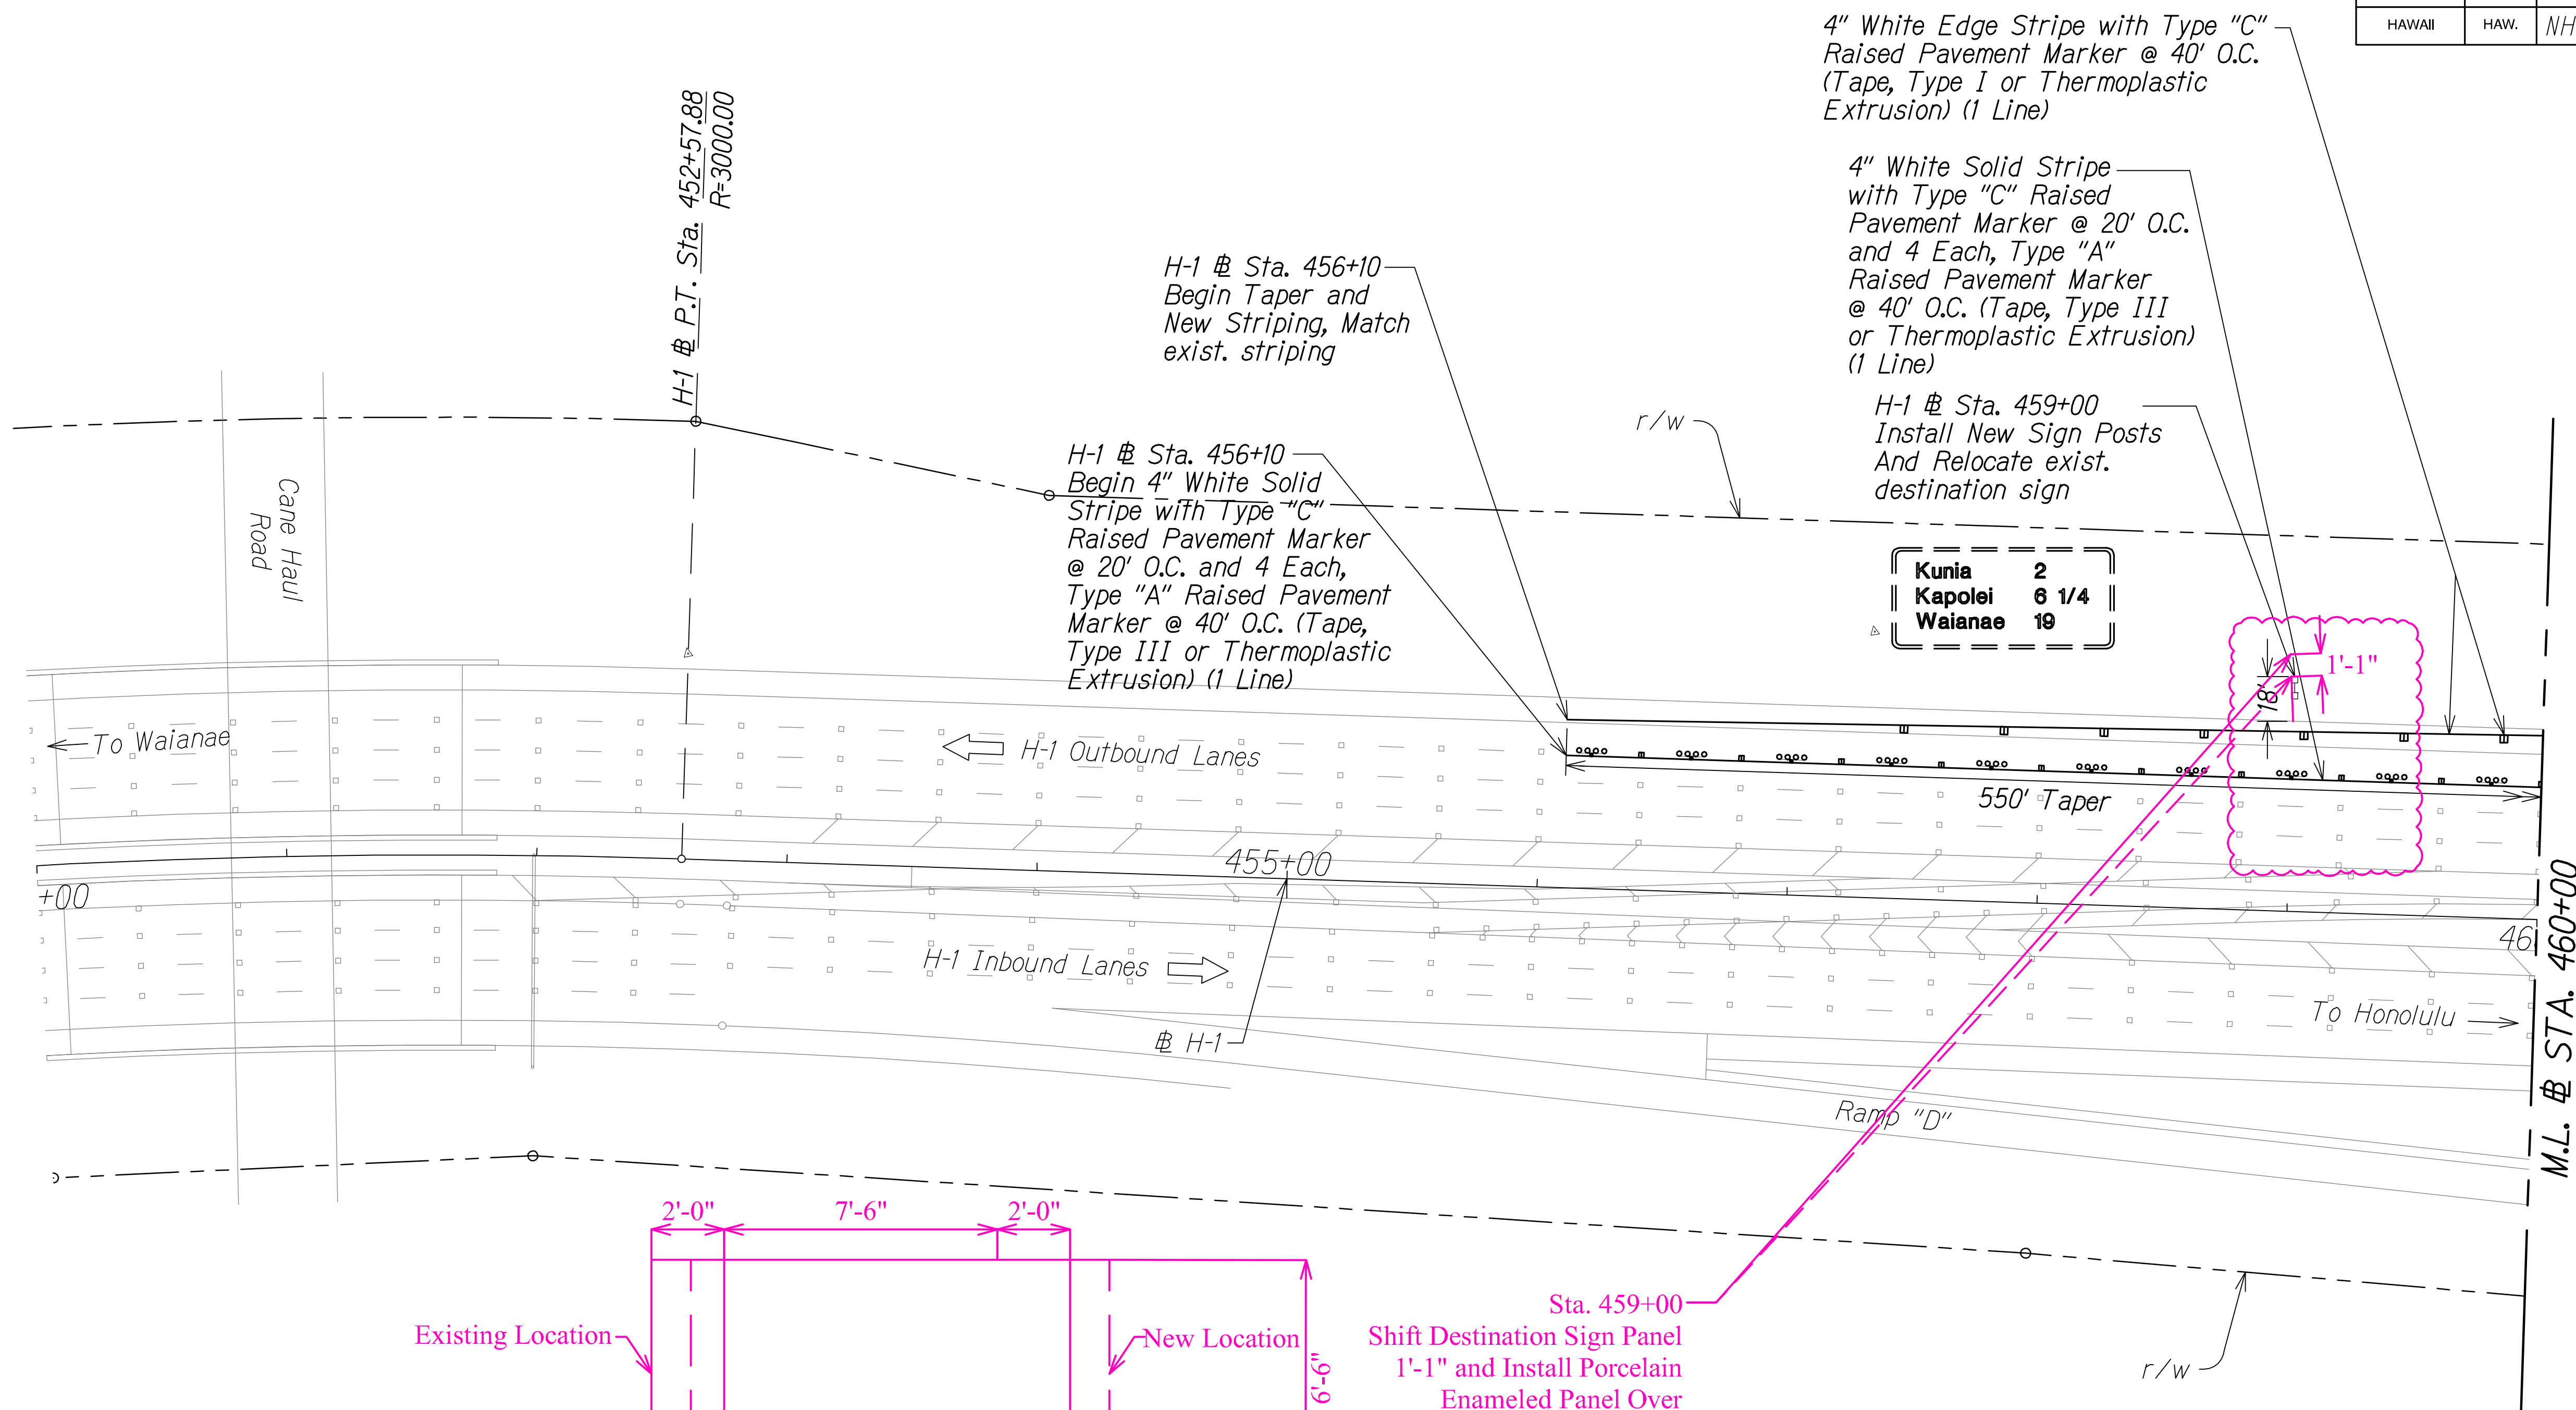

- Legend:**
- ▣ Type "C" Raised Pavement Marker
 - Type "A" Raised Pavement Marker

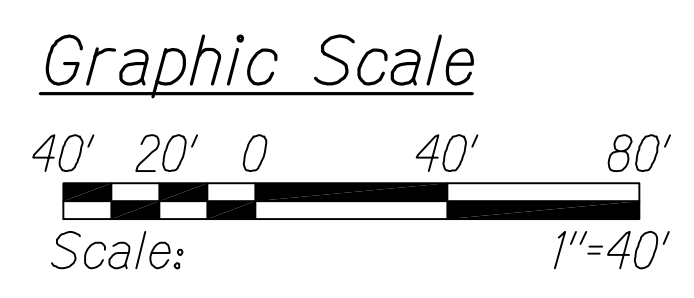

DESTINATION SIGN AT STA. 459+00
Scale: NTS

PAVEMENT MARKING AND STRIPING PLAN
STA. 450+00 TO # STA. 460+00
Scale: 1" = 40'

LEGEND FOR AS-BUILT POSTINGS

~~~~ Squiggly line for as-built deletion

== Double line for as-built deletion

Roadway Text for as-built posting



THIS WORK WAS PREPARED BY ME OR UNDER MY SUPERVISION.

*Matthew K. Fujitaka*

APRIL 30, 2018  
WILSON OKAMOTO CORPORATION LIC. EXP. DATE

STATE OF HAWAII  
DEPARTMENT OF TRANSPORTATION  
HIGHWAYS DIVISION

**PAVEMENT MARKING AND STRIPING PLAN**


INTERSTATE ROUTE H-1  
PM CONTRAFLOW LANE, PHASE 1 # 2  
FEDERAL AID PROJECT NO. NH-HI-1 (260)

Scale: 1" = 40' Date: July, 2016

SHEET No. PM-01 OF 27 SHEETS




| FED. ROAD DIST. NO. | STATE | FED. AID PROJ. NO. | FISCAL YEAR | SHEET NO. | TOTAL SHEETS |
|---------------------|-------|--------------------|-------------|-----------|--------------|
| HAWAII              | HAW.  | NH-HI-1 (260)      | 2014        | 117       | 605          |

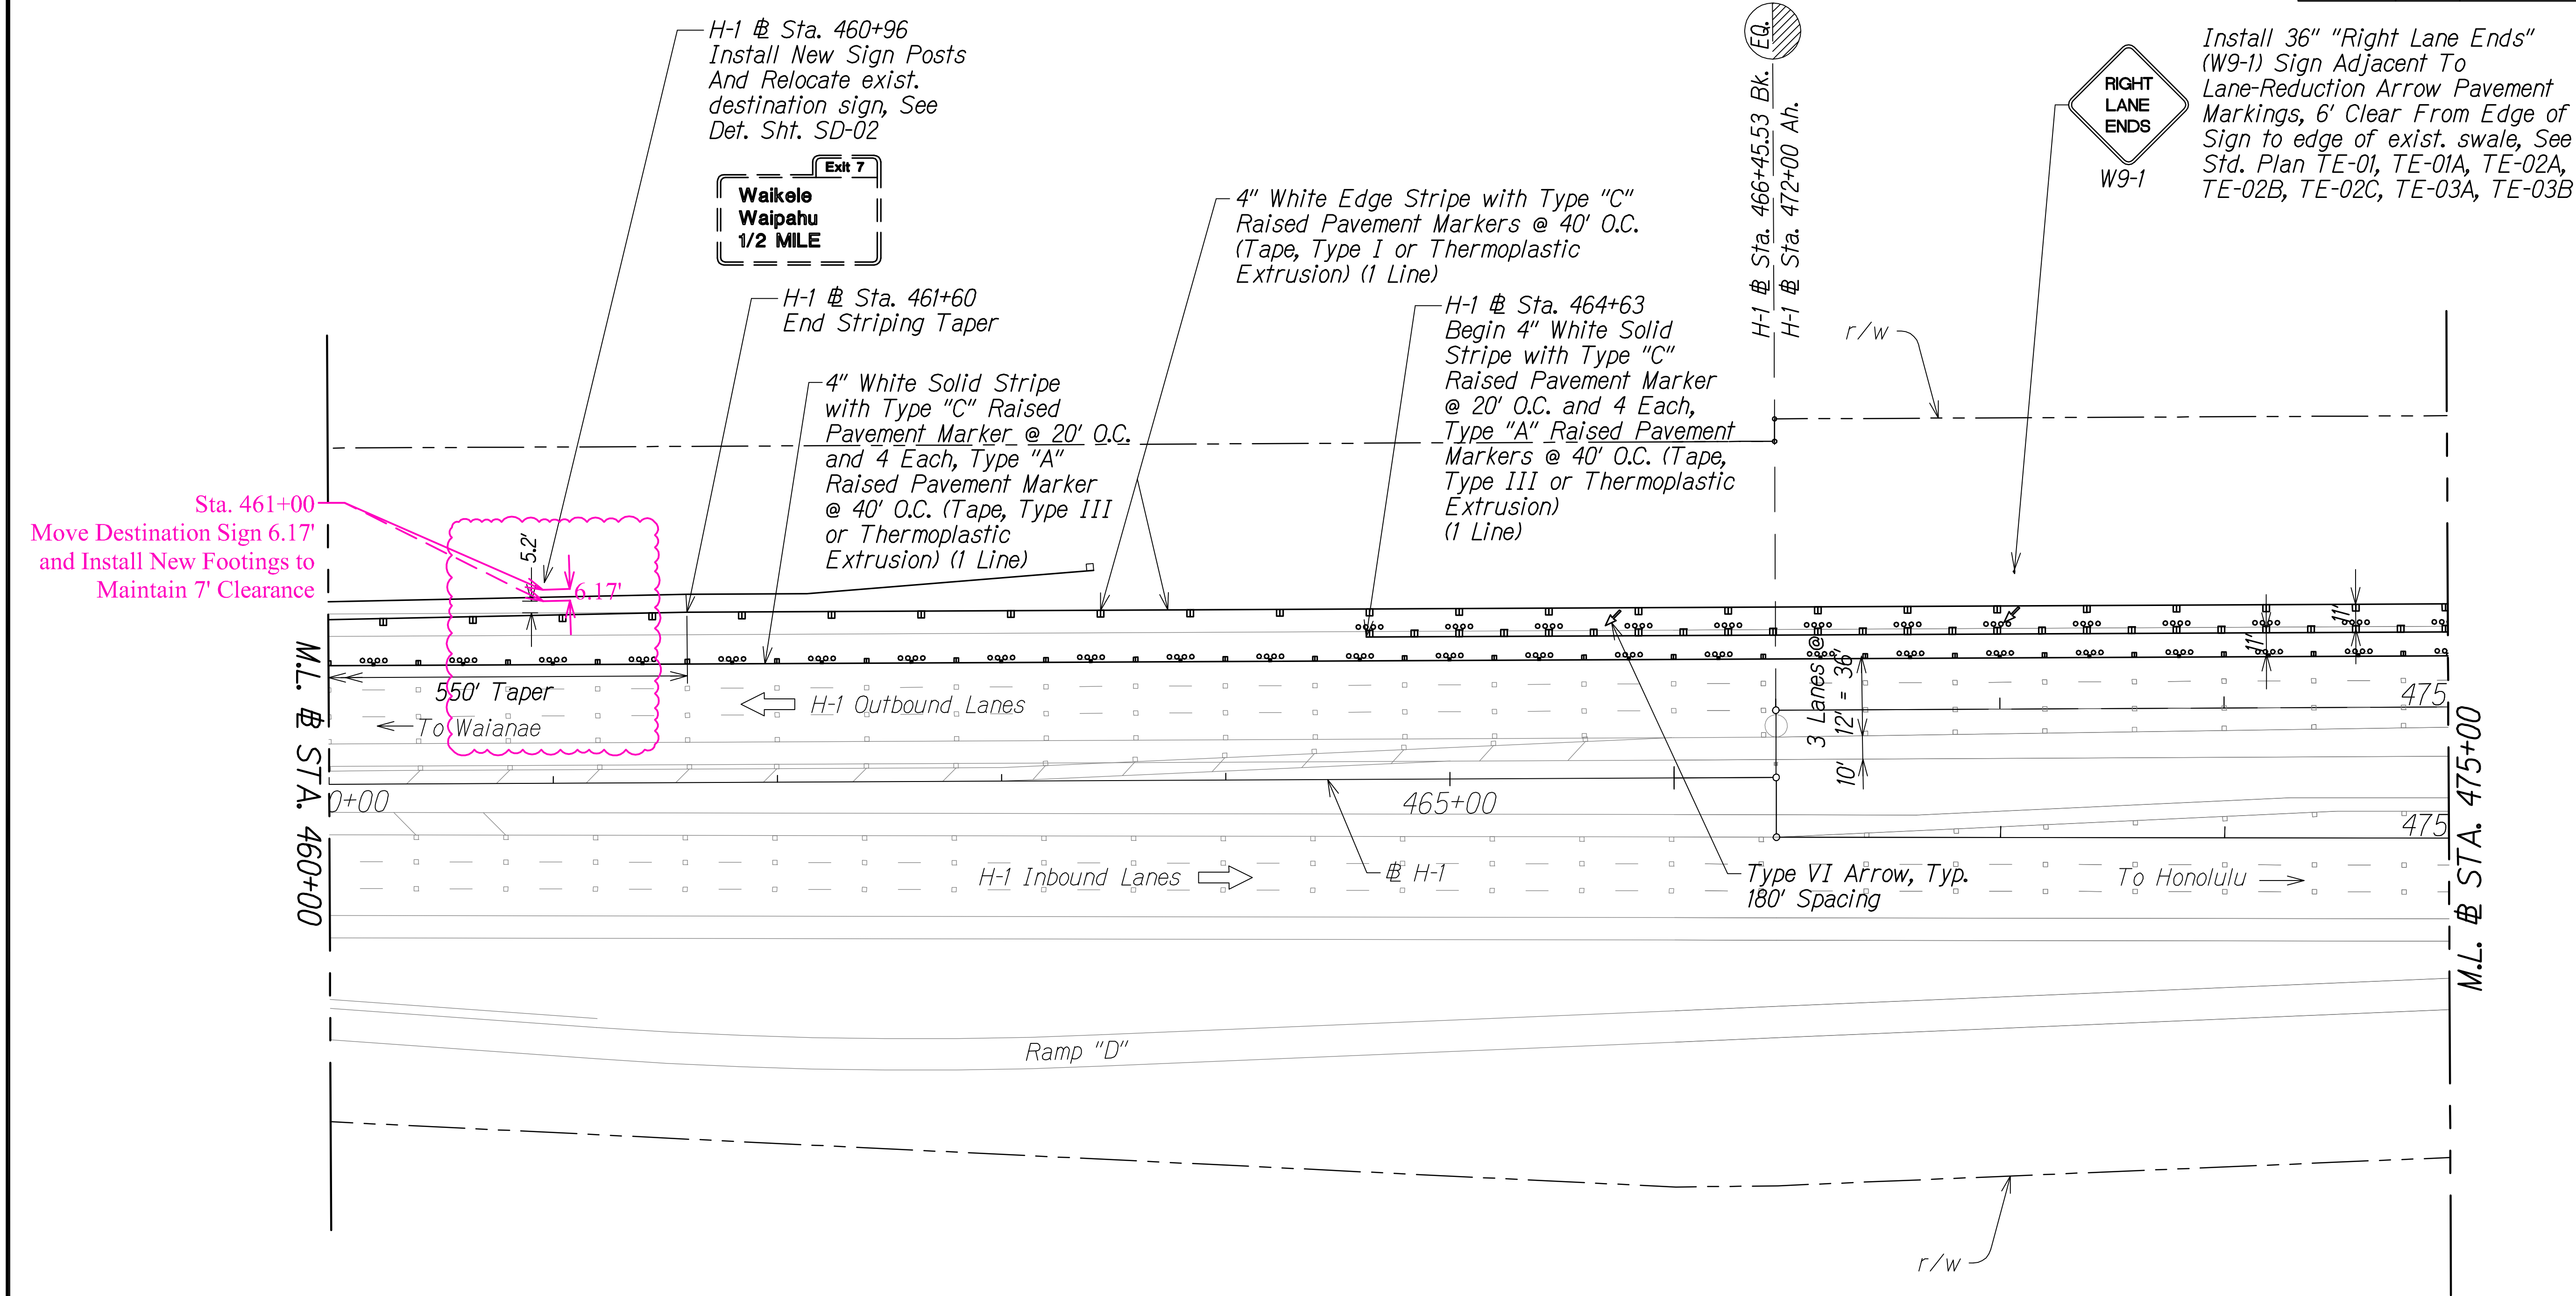

TRUE NORTH  
SCALE: 1" = 40'

Legend:

- ▣ Type "C" Raised Pavement Marker
- Type "A" Raised Pavement Marker

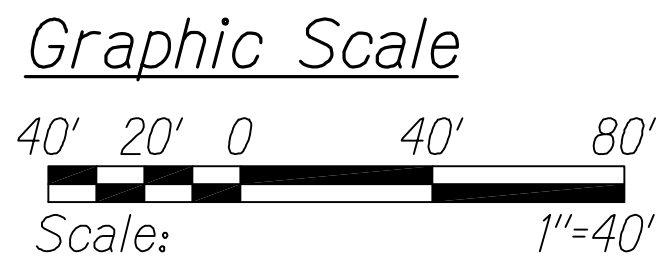


PAVEMENT MARKING AND STRIPING PLAN  
# STA. 460+00 TO # STA. 475+00  
Scale: 1" = 40'

**LEGEND FOR AS-BUILT POSTINGS**

- Squiggly line for as-built deletion
- Double line for as-built deletion
- Roadway Text for as-built posting

STATE OF HAWAII  
DEPARTMENT OF TRANSPORTATION  
HIGHWAYS DIVISION  
**PAVEMENT MARKING AND STRIPING PLAN**  
  
INTERSTATE ROUTE H-1  
PM CONTRAFLOW LANE, PHASE 1 # 2  
FEDERAL AID PROJECT NO. NH-HI-1 (260)  
Scale: 1" = 40' Date: July, 2016  
SHEET No. PM-02 OF 27 SHEETS

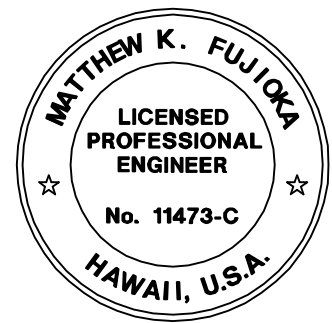

THIS WORK WAS PREPARED BY ME OR UNDER MY SUPERVISION.  
*Matthew K. Fujitaka*  
APRIL 30, 2018  
WILSON OKAMOTO CORPORATION LIC. EXP. DATE

|                       |                     |
|-----------------------|---------------------|
| QC/QA REVIEW 100%     | DATE MARCH 23, 2014 |
| BY <i>[Signature]</i> |                     |
| BY <i>[Signature]</i> |                     |
| BY <i>[Signature]</i> |                     |
| BY <i>[Signature]</i> |                     |


|                   |      |
|-------------------|------|
| SURVEY PLOTTED BY | DATE |
| DESIGNED BY       |      |
| NOTED BY          |      |
| QUANTITIES BY     |      |
| CHECKED BY        |      |
| ORIGINAL PLAN     | No.  |








| FED. ROAD DIST. NO. | STATE | FED. AID PROJ. NO. | FISCAL YEAR | SHEET NO. | TOTAL SHEETS |
|---------------------|-------|--------------------|-------------|-----------|--------------|
| HAWAII              | HAW.  | NH-HI-1 (260)      | 2014        | 119       | 605          |

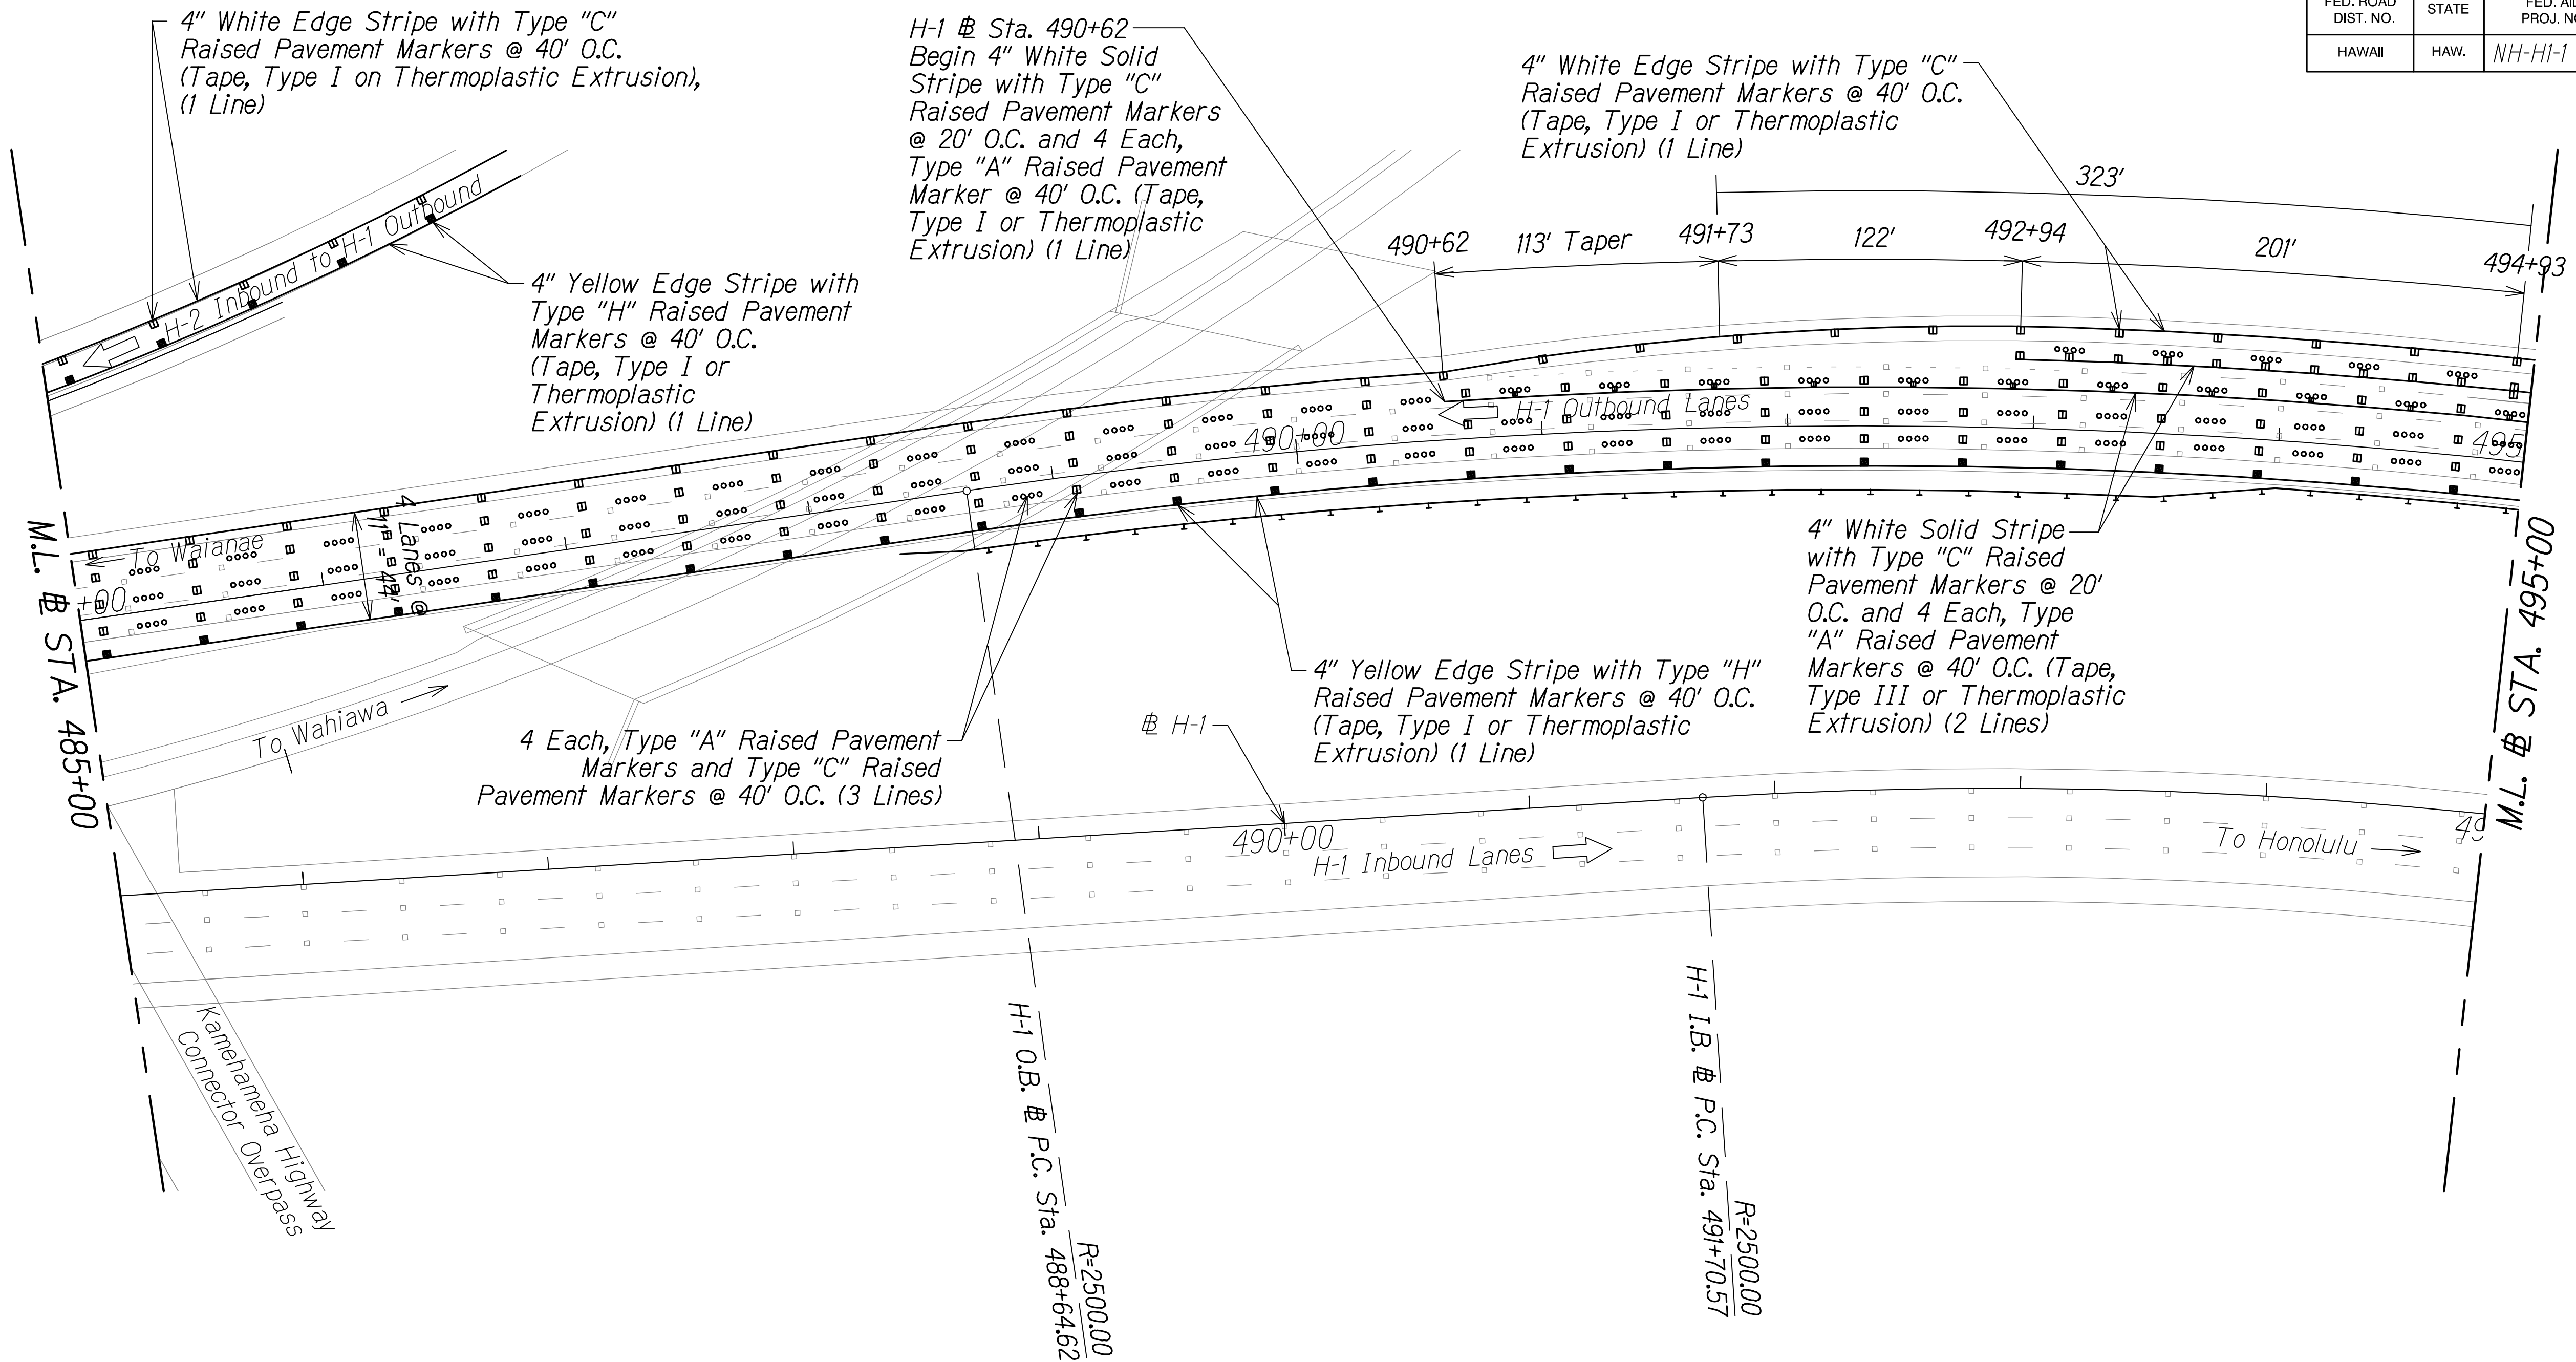

Legend:

- ▣ Type "C" Raised Pavement Marker
- Type "A" Raised Pavement Marker
- Type "H" Raised Pavement Marker

Graphic Scale

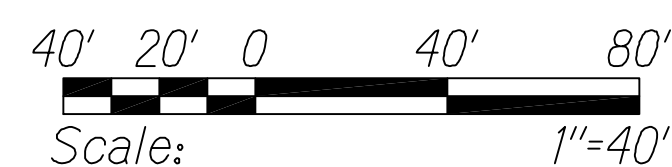

PAVEMENT MARKING AND STRIPING PLAN  
# STA. 485+00 TO # STA. 495+00

Scale: 1" = 40'

LEGEND FOR  
AS-BUILT POSTINGS

- ~~~~ Squiggly line for as-built deletion
- == Double line for as-built deletion
- Roadway Text for as-built posting



THIS WORK WAS PREPARED BY ME  
OR UNDER MY SUPERVISION.  
*Matthew K. Fujitaka*  
WILSON OKAMOTO CORPORATION APRIL 30, 2018  
LIC. EXP. DATE

STATE OF HAWAII  
DEPARTMENT OF TRANSPORTATION  
HIGHWAYS DIVISION  
PAVEMENT MARKING  
AND STRIPING PLAN

INTERSTATE ROUTE H-1  
PM CONTRAFLOW LANE, PHASE 1 # 2  
FEDERAL AID PROJECT NO. NH-HI-1 (260)  
Scale: 1" = 40' Date: July, 2016


SHEET No. PM-04 OF 27 SHEETS

"AS-BUILT"

119



| FED. ROAD DIST. NO. | STATE | FED. AID PROJ. NO. | FISCAL YEAR | SHEET NO. | TOTAL SHEETS |
|---------------------|-------|--------------------|-------------|-----------|--------------|
| HAWAII              | HAW.  | NH-HI-1 (260)      | 2014        | 120       | 605          |

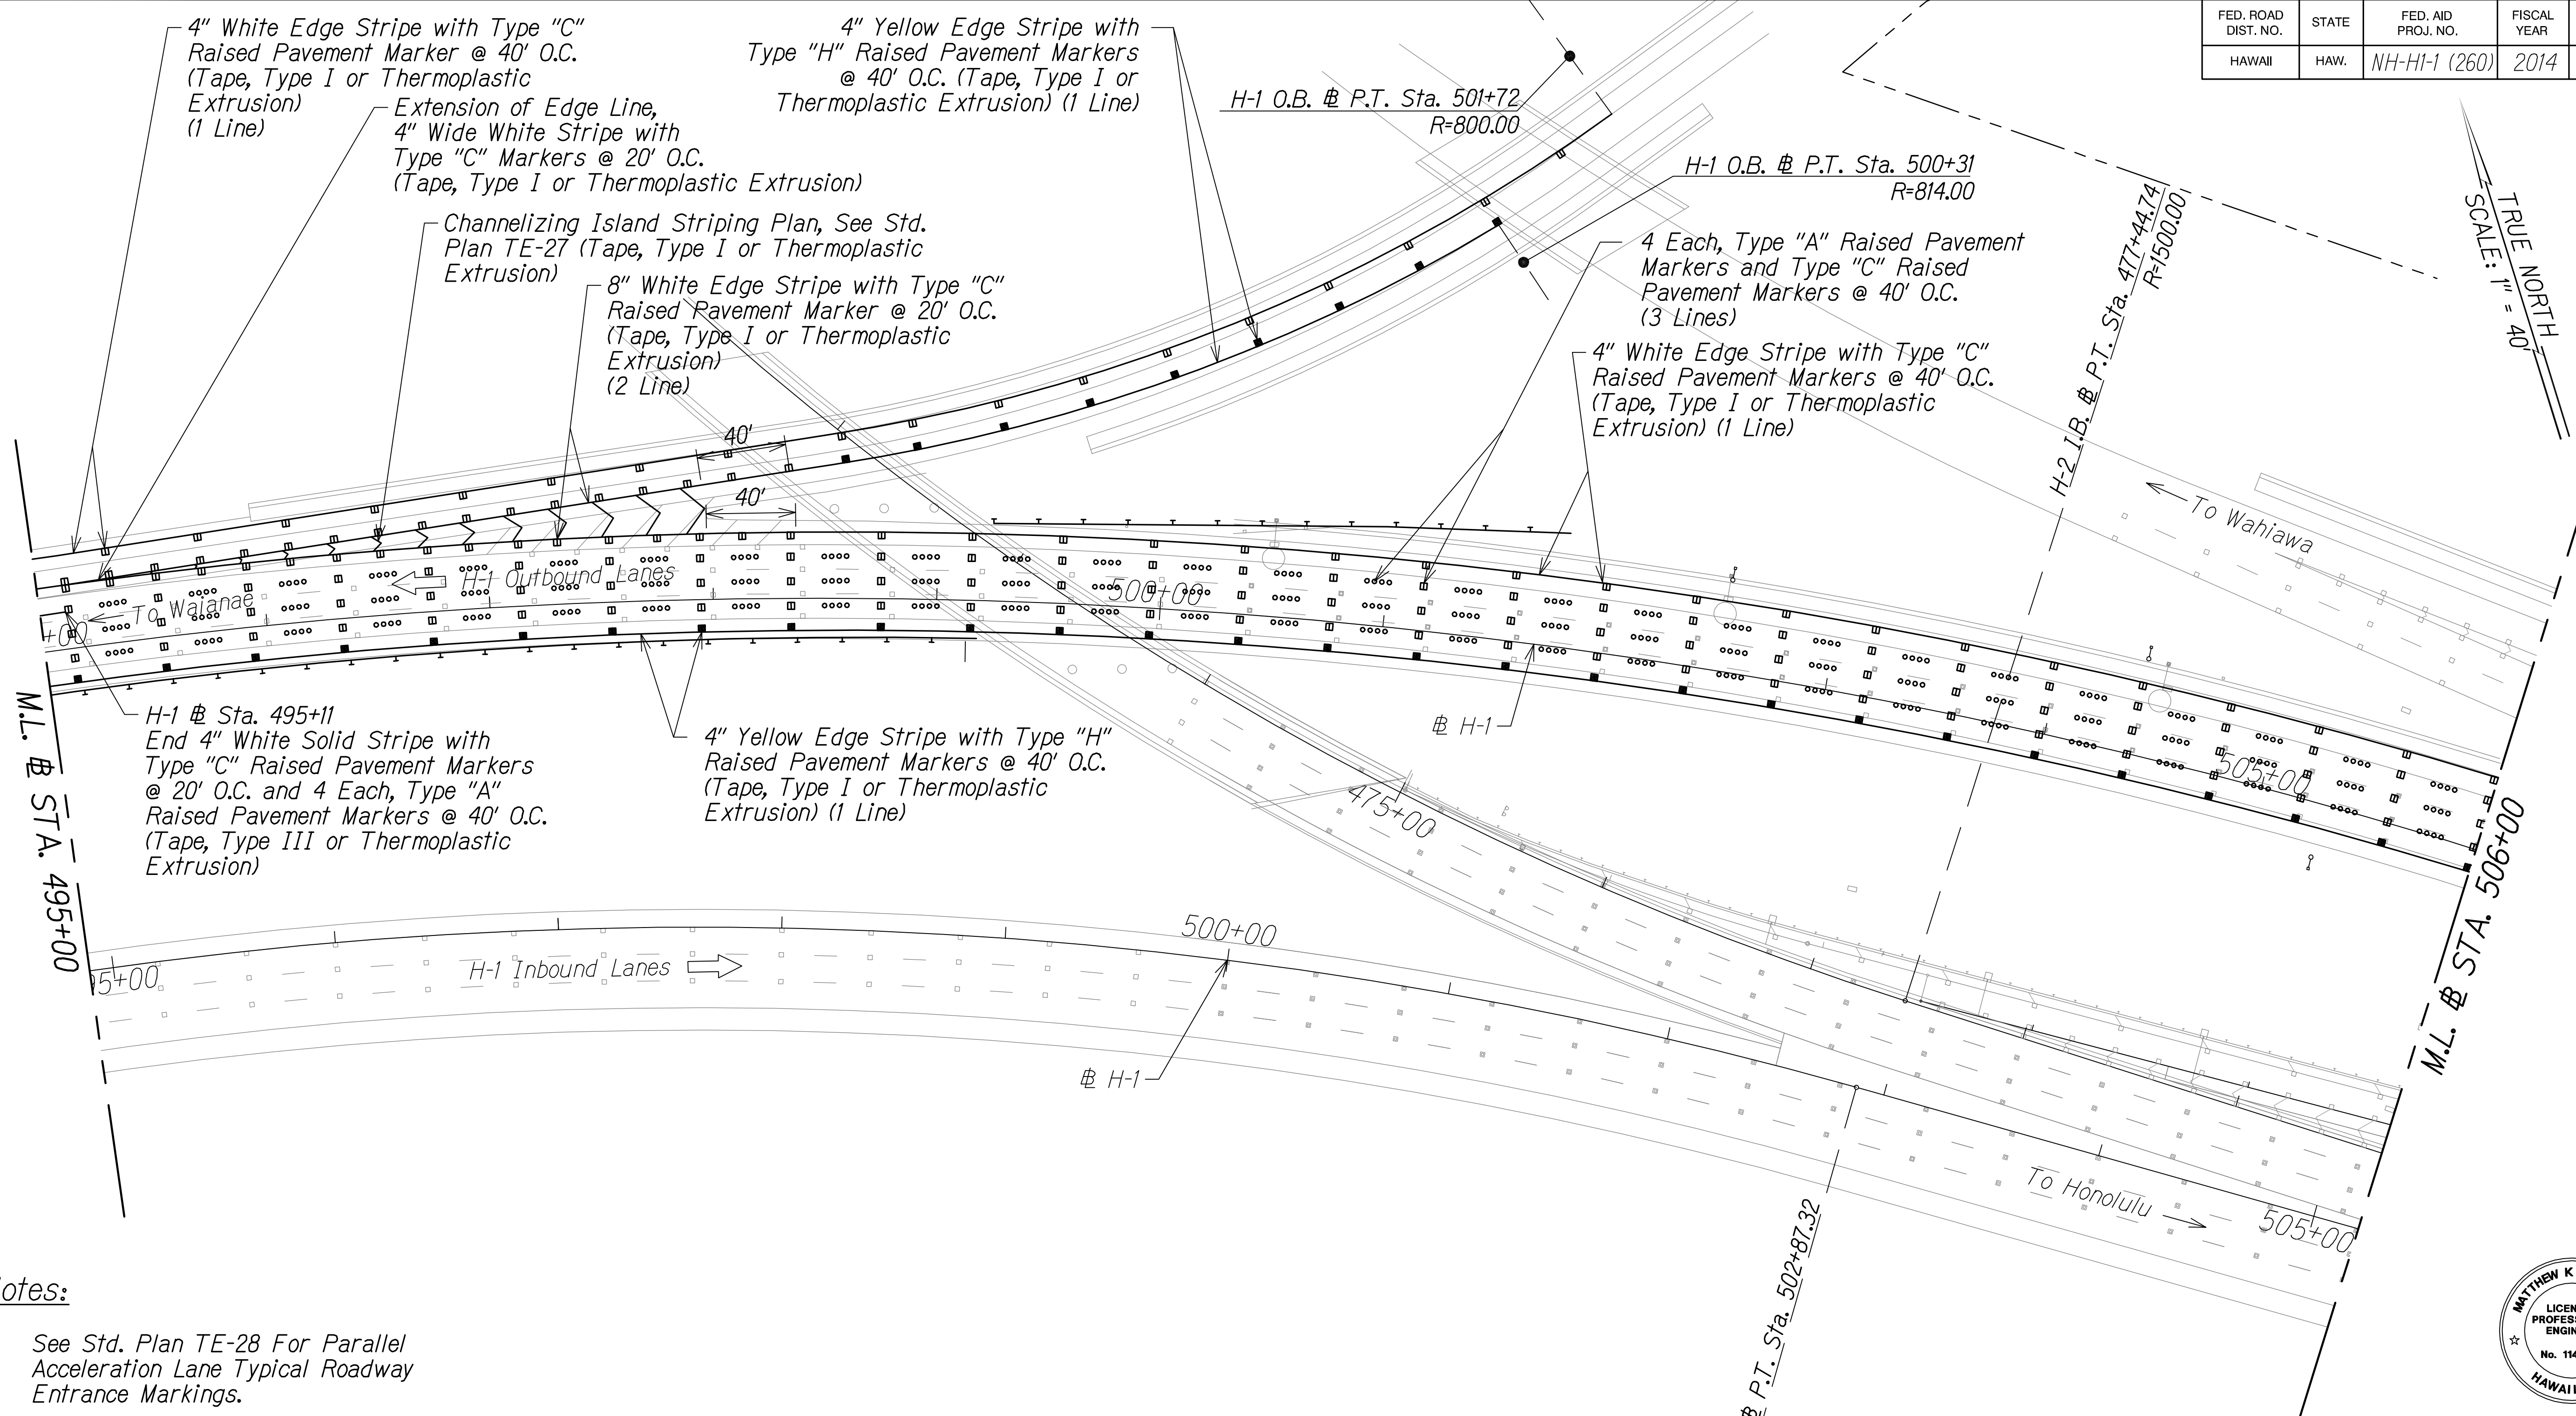


Notes:

- See Std. Plan TE-28 For Parallel Acceleration Lane Typical Roadway Entrance Markings.

Legend:

- Type "C" Raised Pavement Marker
- Type "A" Raised Pavement Marker
- Type "H" Raised Pavement Marker

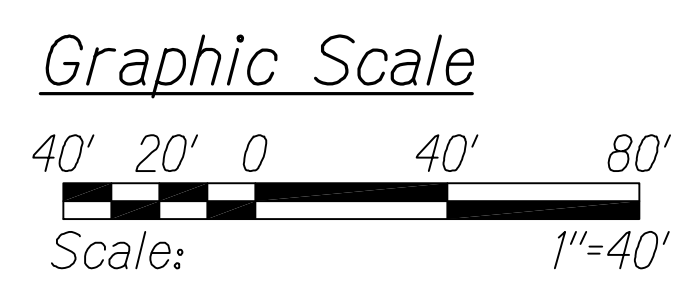

PAVEMENT MARKING AND STRIPING PLAN  
# STA. 495+00 TO # STA. 506+00  
Scale: 1" = 40'

**LEGEND FOR AS-BUILT POSTINGS**

Squiggly line for as-built deletion

Double line for as-built deletion


Roadway Text for as-built posting

STATE OF HAWAII  
DEPARTMENT OF TRANSPORTATION  
HIGHWAYS DIVISION

**PAVEMENT MARKING AND STRIPING PLAN**

INTERSTATE ROUTE H-1  
PM CONTRAFLOW LANE, PHASE 1 & 2  
FEDERAL AID PROJECT NO. NH-HI-1 (260)  
Scale: 1" = 40' Date: July, 2016

SHEET No. PM-05 OF 27 SHEETS

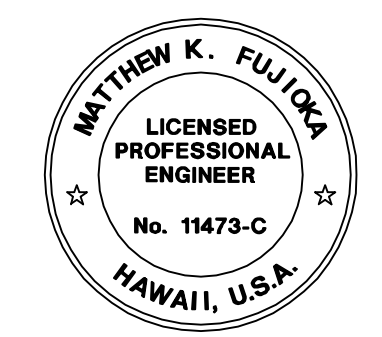

THIS WORK WAS PREPARED BY ME OR UNDER MY SUPERVISION.  
*Matthew K. Fujitaka*  
APRIL 30, 2018  
WILSON OKAMOTO CORPORATION LIC. EXP. DATE

QC/QA REVIEW 100% DATE: MARCH 23, 2016

DESIGNED BY: *[Signature]*  
CHECKED BY: *[Signature]*  
BY: *[Signature]*  
BY: *[Signature]*  
BY: *[Signature]*


SURVEY PLOTTED BY: *[Signature]* DATE: *[Blank]*

DESIGNED BY: *[Signature]*

NOTE BOOK No. *[Blank]*



| FED. ROAD DIST. NO. | STATE | FED. AID PROJ. NO. | FISCAL YEAR | SHEET NO. | TOTAL SHEETS |
|---------------------|-------|--------------------|-------------|-----------|--------------|
| HAWAII              | HAW.  | NH-HI-1 (260)      | 2014        | 121       | 605          |

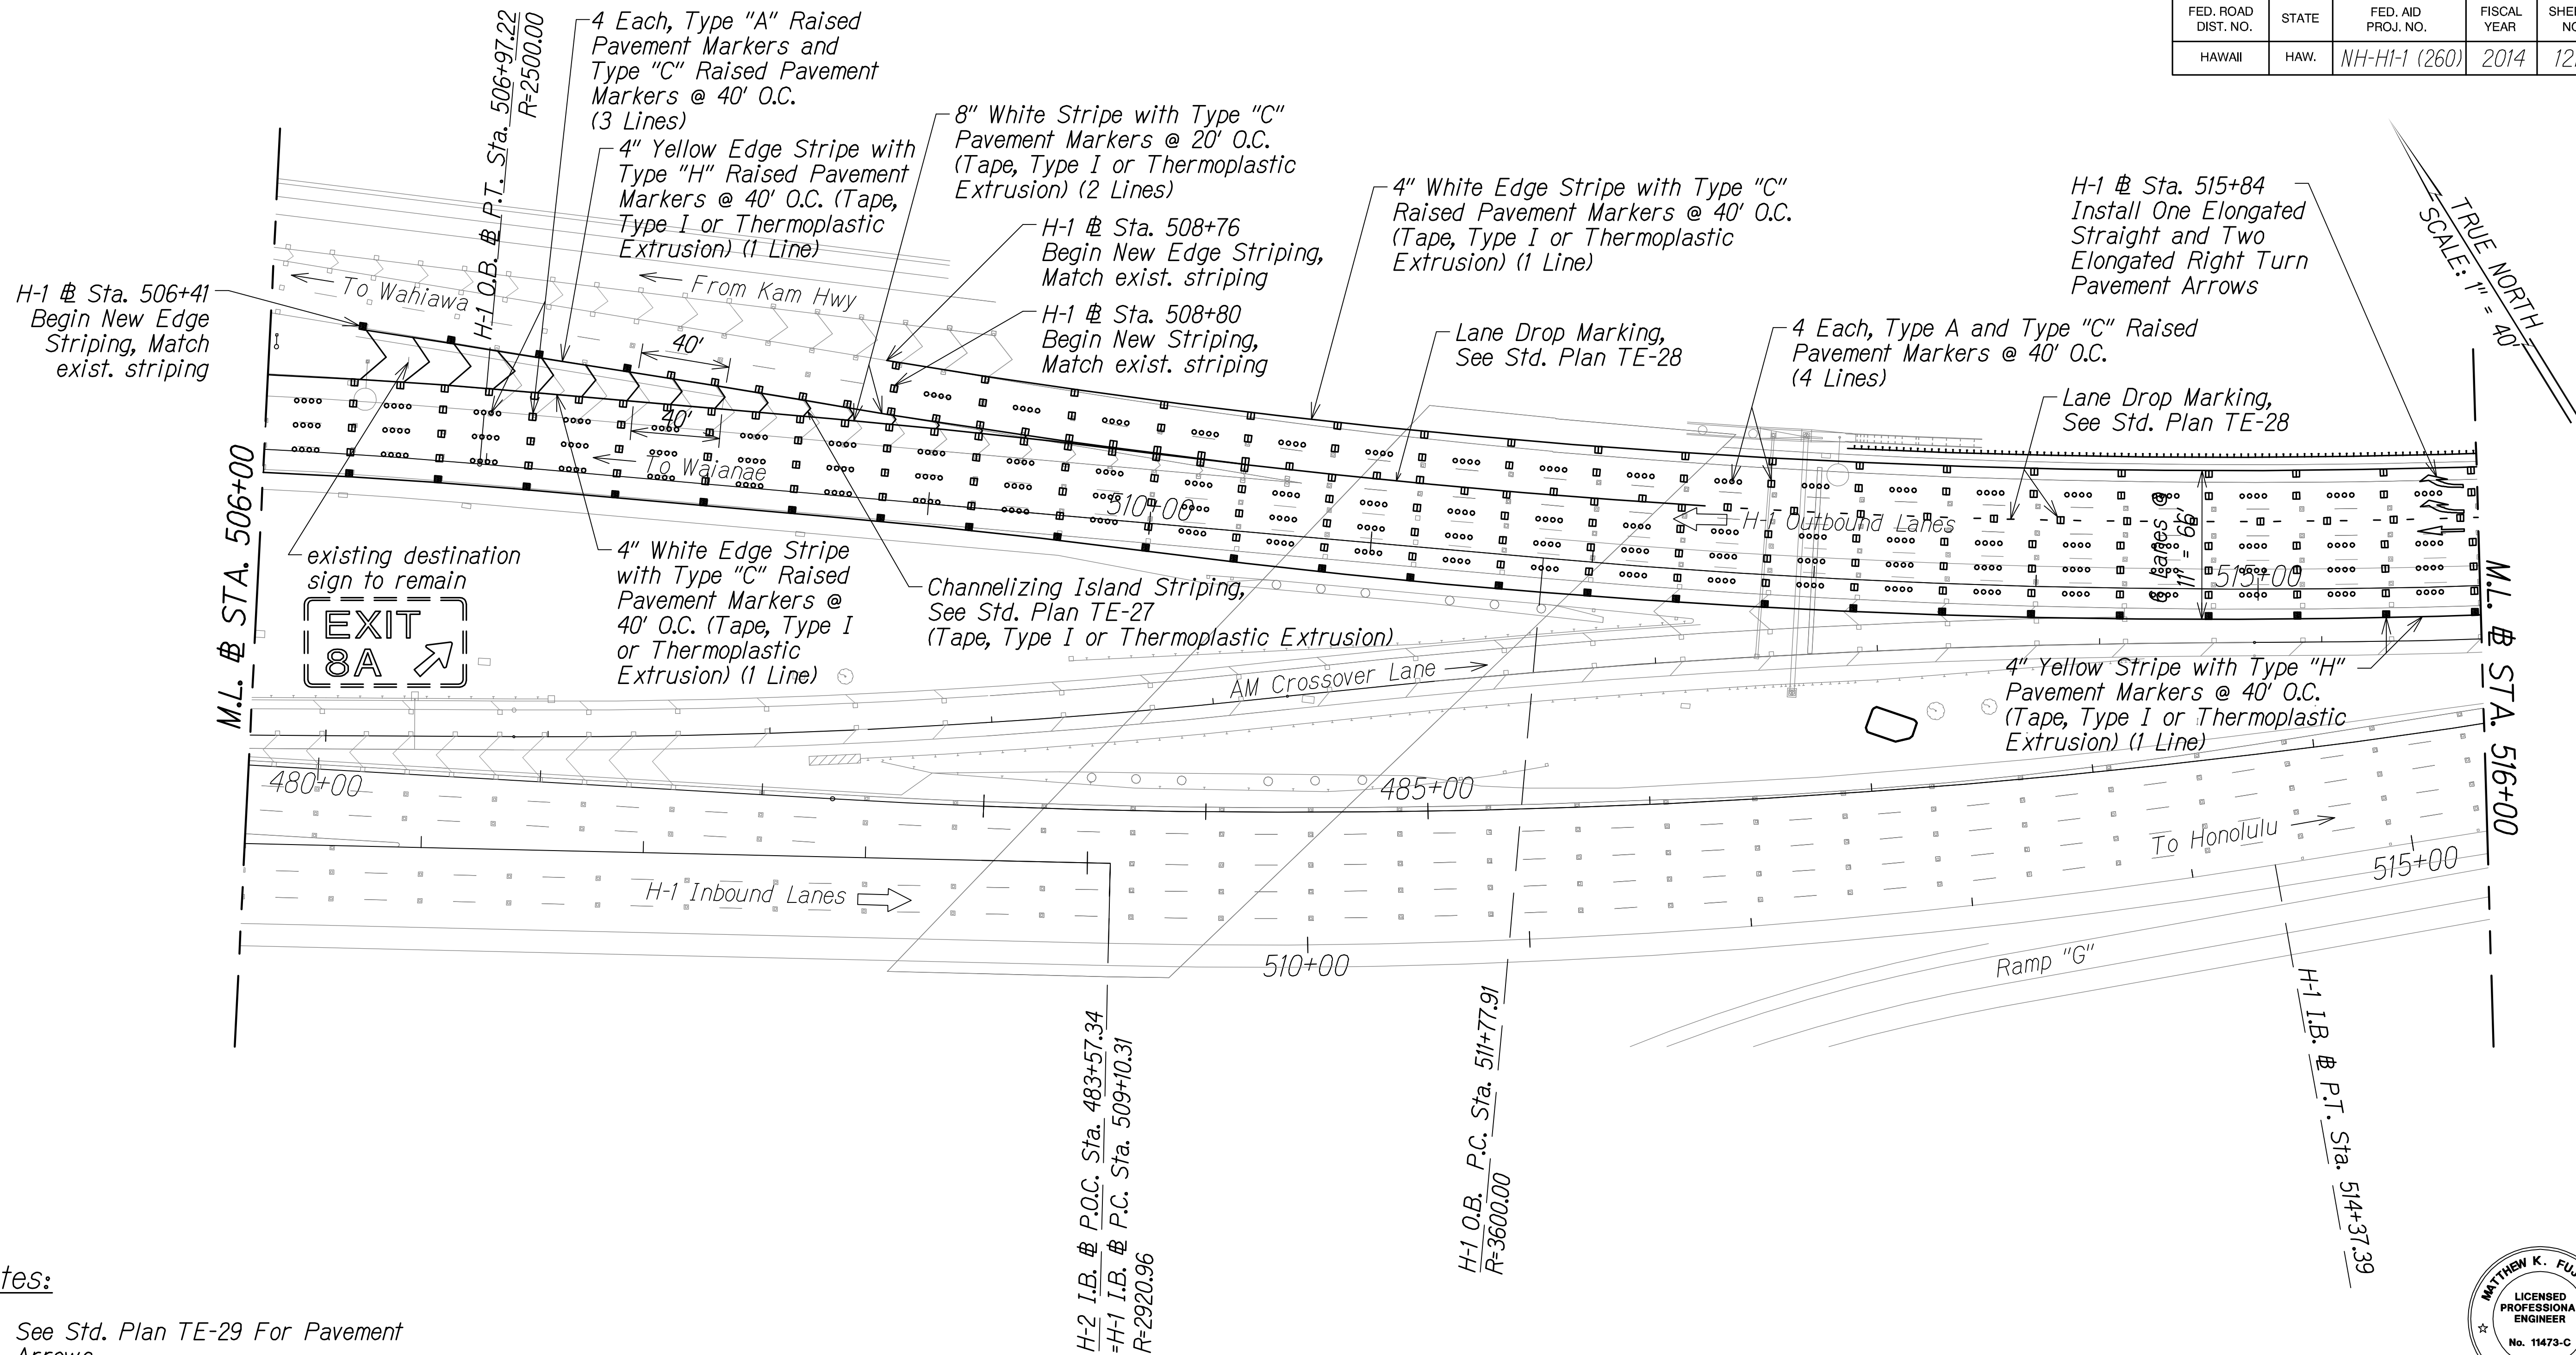


Notes:

- See Std. Plan TE-29 For Pavement Arrows.

Legend:

- Type "C" Raised Pavement Marker
- Type "A" Raised Pavement Marker
- Type "H" Raised Pavement Marker

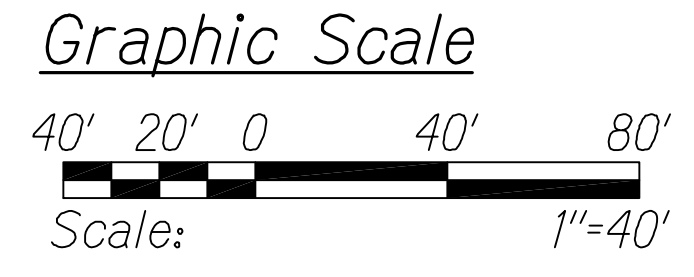

PAVEMENT MARKING AND STRIPING PLAN  
@ STA. 506+00 TO @ STA. 516+00  
Scale: 1" = 40'

**LEGEND FOR AS-BUILT POSTINGS**

Squiggly line for as-built deletion

Double line for as-built deletion

Roadway Text for as-built posting

STATE OF HAWAII  
DEPARTMENT OF TRANSPORTATION  
HIGHWAYS DIVISION

**PAVEMENT MARKING AND STRIPING PLAN**

INTERSTATE ROUTE H-1  
PM CONTRAFLOW LANE, PHASE 1 & 2  
FEDERAL AID PROJECT NO. NH-HI-1 (260)  
Scale: 1" = 40' Date: July, 2016

SHEET No. PM-06 OF 27 SHEETS



THIS WORK WAS PREPARED BY ME OR UNDER MY SUPERVISION.  
*Matthew K. Fujitaka*  
APRIL 30, 2018  
WILSON OKAMOTO CORPORATION LIC. EXP. DATE

|              |      |                     |
|--------------|------|---------------------|
| QC/QA REVIEW | 100% | DATE MARCH 23, 2014 |
| BY           |      |                     |
| BY           |      |                     |
| BY           |      |                     |


|                   |      |
|-------------------|------|
| SURVEY PLOTTED BY | DATE |
| DESIGNED BY       |      |
| QUANTITIES BY     |      |
| CHECKED BY        |      |

|               |           |
|---------------|-----------|
| ORIGINAL PLAN | NOTE BOOK |
| No.           |           |



| FED. ROAD DIST. NO. | STATE | FED. AID PROJ. NO. | FISCAL YEAR | SHEET NO. | TOTAL SHEETS |
|---------------------|-------|--------------------|-------------|-----------|--------------|
| HAWAII              | HAW.  | NH-HI-1 (260)      | 2014        | 122       | 605          |

TRUE NORTH  
SCALE: 1" = 40'

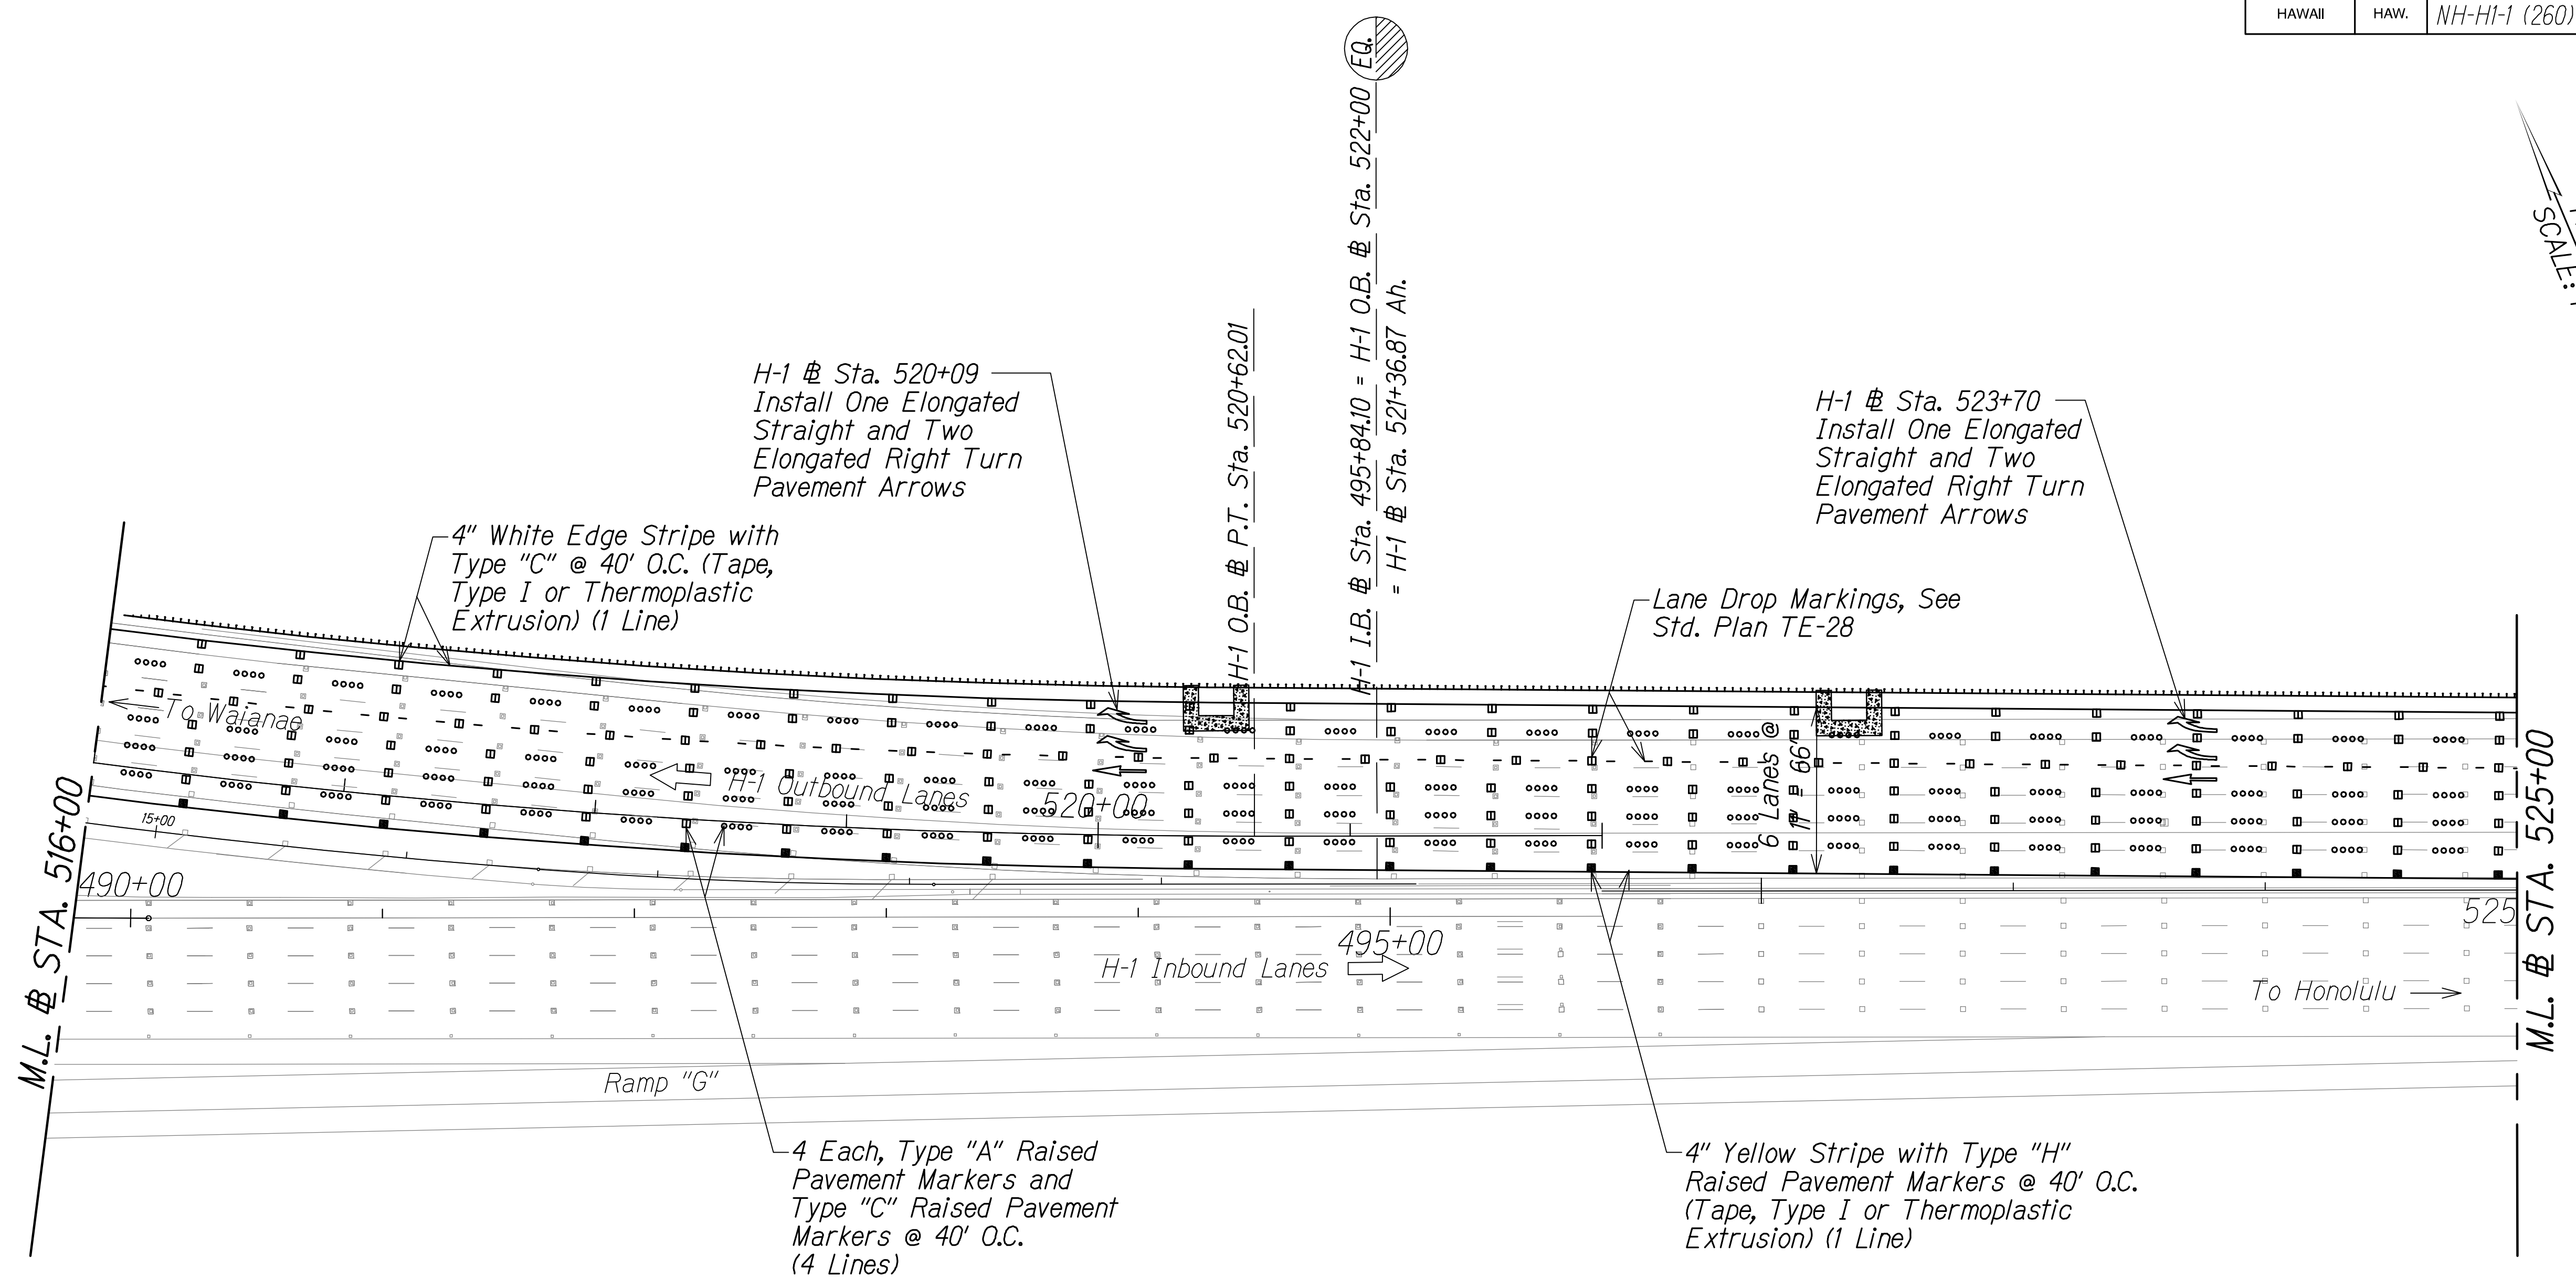


Notes:

- See Std. Plan TE-29 For Pavement Arrows.

Legend:

- Type "C" Raised Pavement Marker
- Type "A" Raised Pavement Marker
- Type "H" Raised Pavement Marker

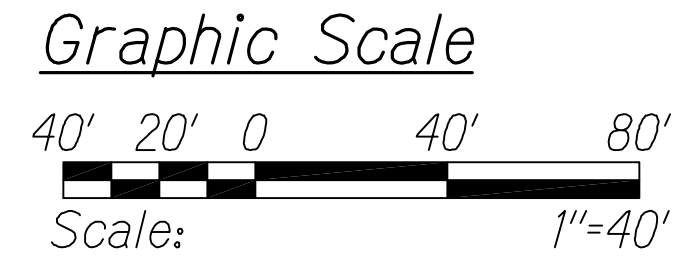

PAVEMENT MARKING AND STRIPING PLAN  
Sta. 516+00 TO Sta. 525+00  
Scale: 1" = 40'

**LEGEND FOR AS-BUILT POSTINGS**

Squiggly line for as-built deletion

Double line for as-built deletion

Roadway Text for as-built posting

STATE OF HAWAII  
DEPARTMENT OF TRANSPORTATION  
HIGHWAYS DIVISION

**PAVEMENT MARKING AND STRIPING PLAN**

INTERSTATE ROUTE H-1  
PM CONTRAFLOW LANE, PHASE 1 & 2  
FEDERAL AID PROJECT NO. NH-HI-1 (260)  
Scale: 1" = 40' Date: July, 2016

SHEET No. PM-07 OF 27 SHEETS



THIS WORK WAS PREPARED BY ME OR UNDER MY SUPERVISION.  
*Matthew K. Fujitaka*  
APRIL 30, 2016  
WILSON OKAMOTO CORPORATION LIC. EXP. DATE


|              |      |                      |
|--------------|------|----------------------|
| QC/QA REVIEW | 100% | DATE: MARCH 23, 2014 |
| BY           |      |                      |
| BY           |      |                      |
| BY           |      |                      |

|                   |      |
|-------------------|------|
| SURVEY PLOTTED BY | DATE |
| DESIGNED BY       |      |
| QUANTITIES BY     |      |
| CHECKED BY        |      |

|               |     |
|---------------|-----|
| ORIGINAL PLAN | No. |
| NOTE BOOK     |     |




| FED. ROAD DIST. NO. | STATE | FED. AID PROJ. NO. | FISCAL YEAR | SHEET NO. | TOTAL SHEETS |
|---------------------|-------|--------------------|-------------|-----------|--------------|
| HAWAII              | HAW.  | NH-HI-1 (260)      | 2014        | 123       | 605          |

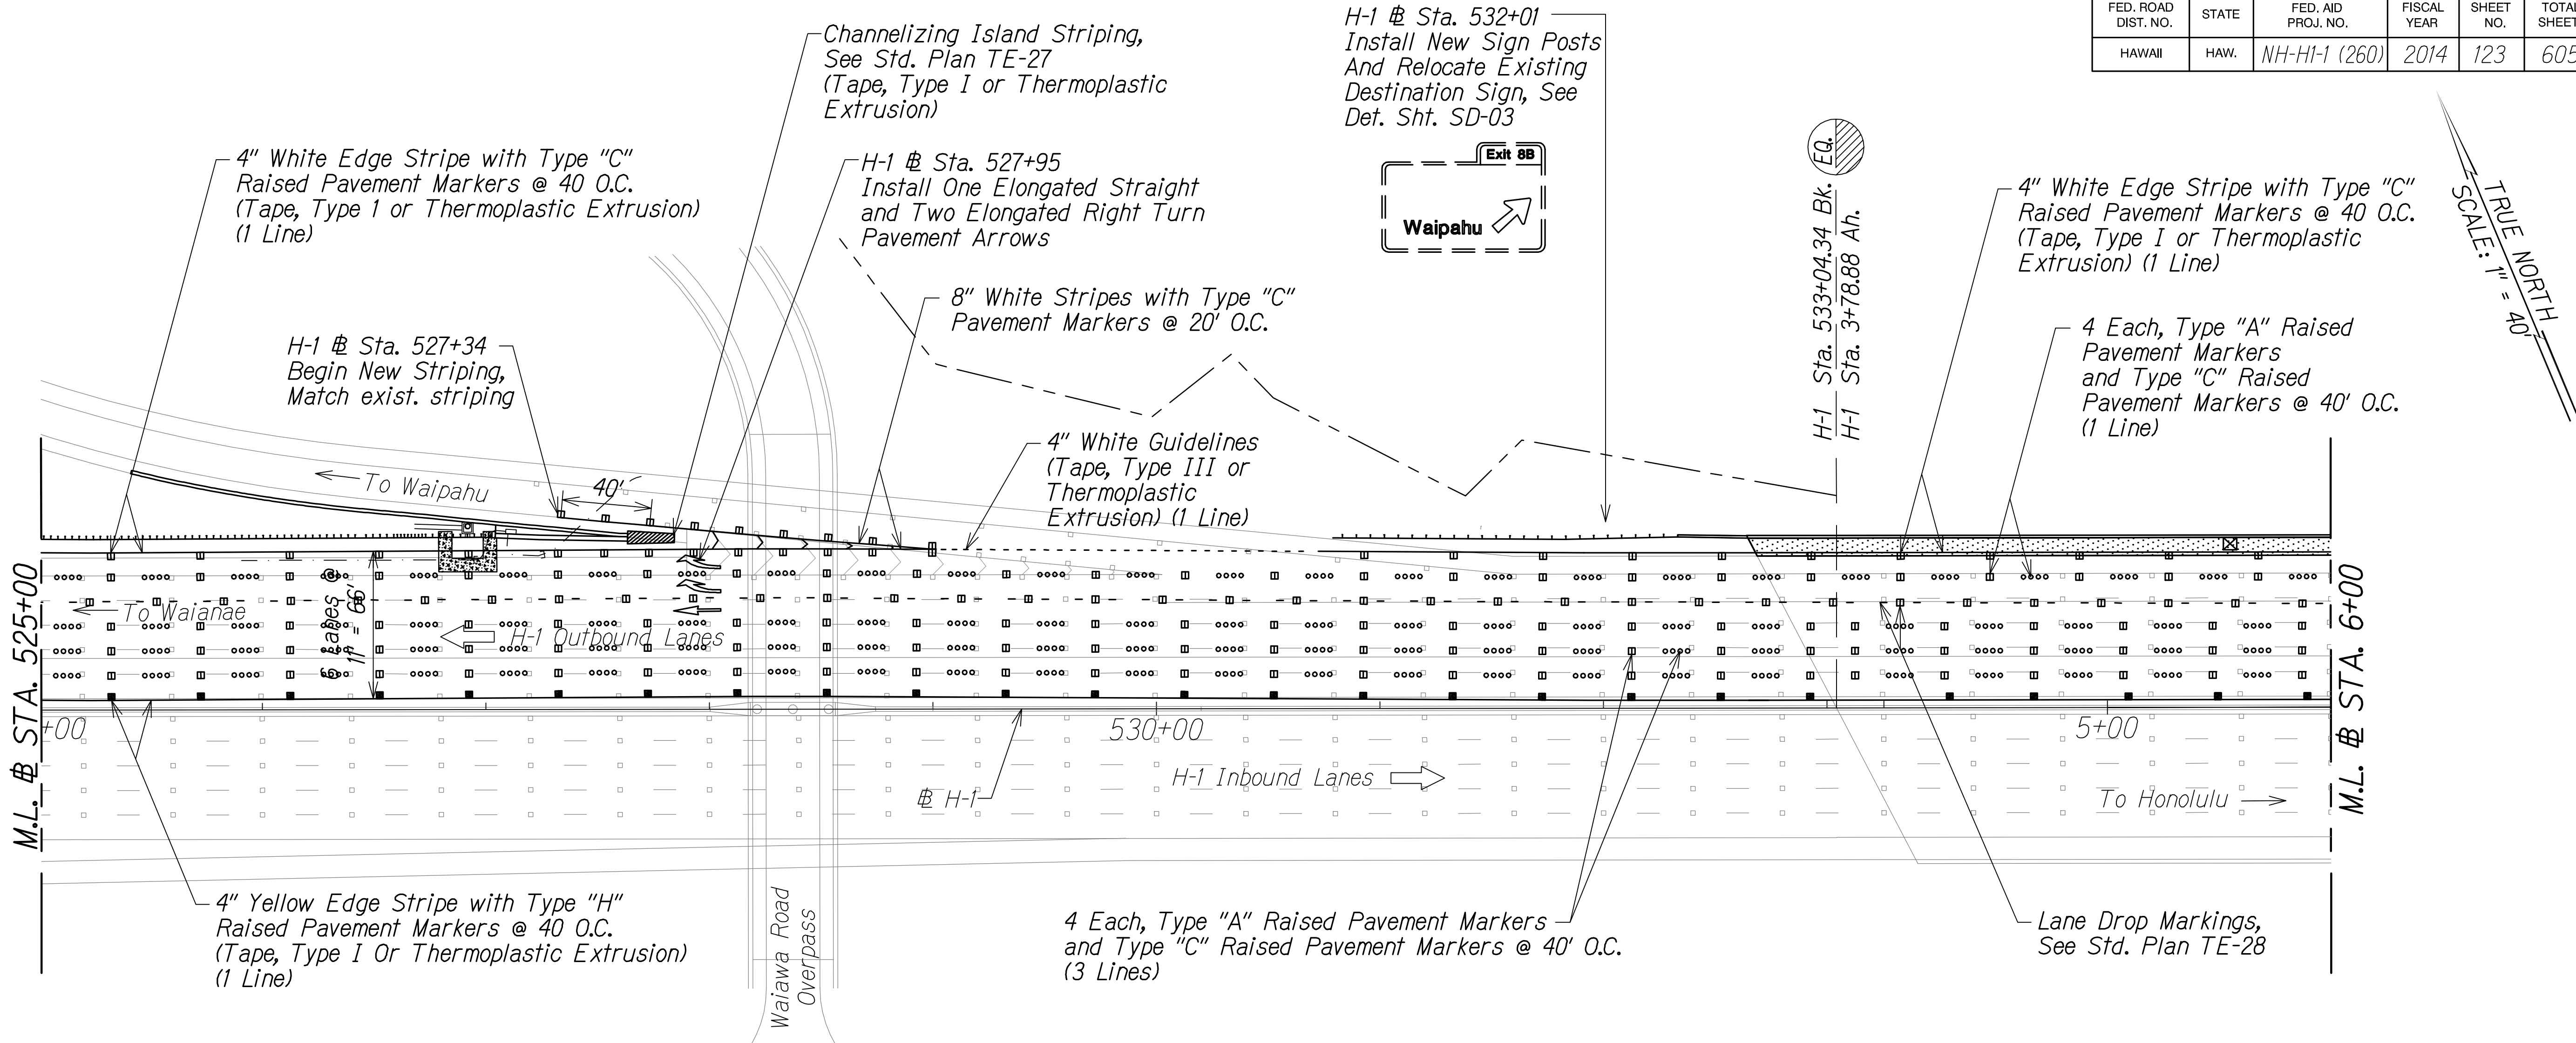

- Notes:
- See Std. Plan TE-28 For Parallel Acceleration Lane Typical Roadway Entrance Markings.
  - See Std. Plan TE-29 For Pavement Arrows.

- Legend:
- Type "C" Raised Pavement Marker
  - Type "A" Raised Pavement Marker
  - Type "H" Raised Pavement Marker

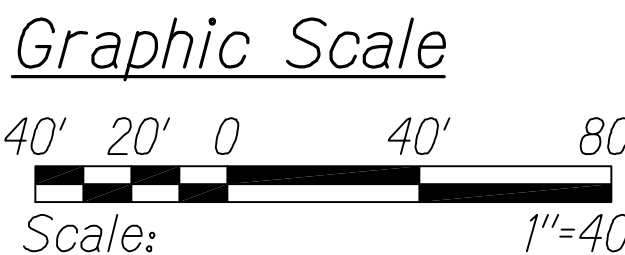

PAVEMENT MARKING AND STRIPING PLAN  
# STA. 525+00 TO # STA. 6+00  
Scale: 1" = 40'

**LEGEND FOR AS-BUILT POSTINGS**

Squiggly line for as-built deletion

Double line for as-built deletion

Roadway Text for as-built posting

THIS WORK WAS PREPARED BY ME OR UNDER MY SUPERVISION.

*Matthew K. Fujitaka* APRIL 30, 2018  
WILSON OKAMOTO CORPORATION LIC. EXP. DATE

STATE OF HAWAII  
DEPARTMENT OF TRANSPORTATION  
HIGHWAYS DIVISION

**PAVEMENT MARKING AND STRIPING PLAN**


INTERSTATE ROUTE H-1  
PM CONTRAFLOW LANE, PHASE 1 # 2  
FEDERAL AID PROJECT NO. NH-HI-1 (260)  
Scale: 1" = 40' Date: July, 2016

SHEET No. PM-08 OF 27 SHEETS



| FED. ROAD DIST. NO. | STATE | FED. AID PROJ. NO. | FISCAL YEAR | SHEET NO. | TOTAL SHEETS |
|---------------------|-------|--------------------|-------------|-----------|--------------|
| HAWAII              | HAW.  | NH-HI-1 (260)      | 2014        | 124       | 605          |

TRUE NORTH  
SCALE: 1" = 40'

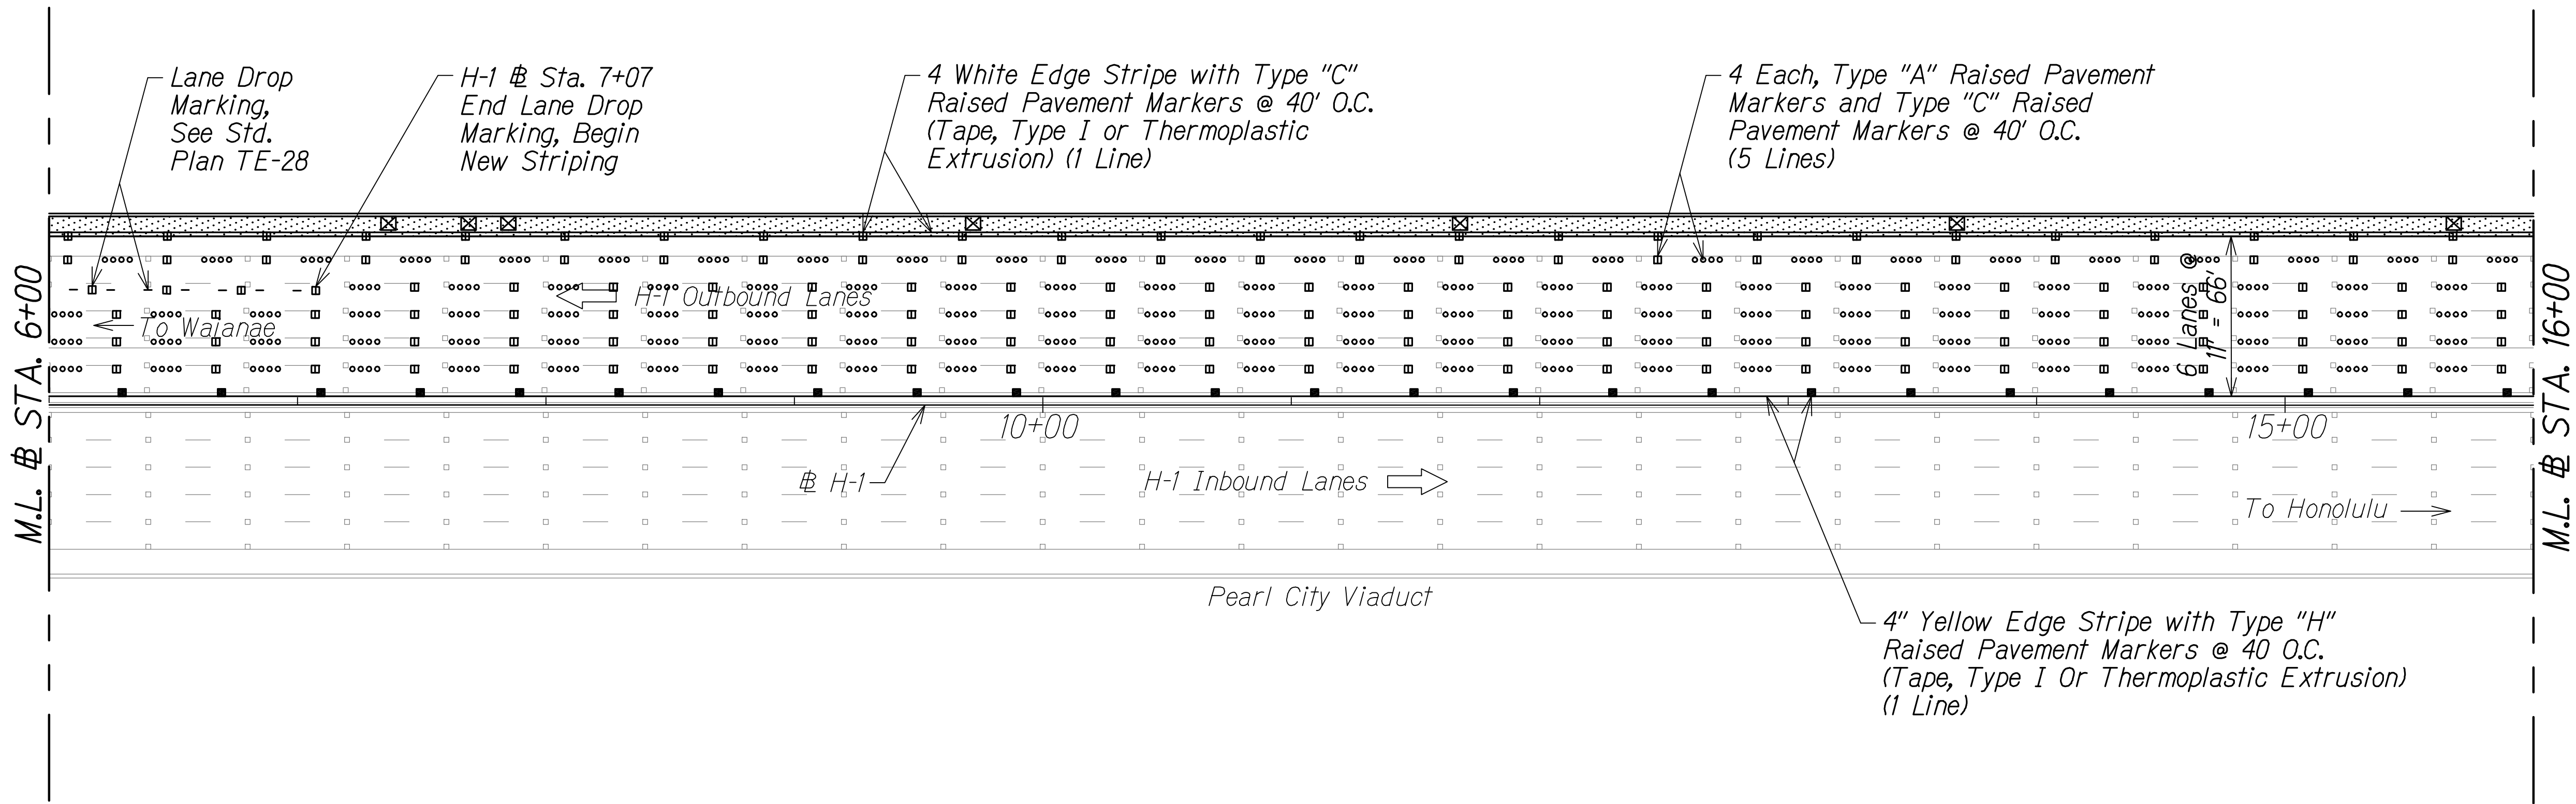


|              |      |                     |
|--------------|------|---------------------|
| QC/QA REVIEW | 100% | DATE MARCH 23, 2014 |
| BY           |      |                     |
| BY           |      |                     |
| BY           |      |                     |
| BY           |      |                     |

|                   |      |
|-------------------|------|
| SURVEY PLOTTED BY | DATE |
| DESIGNED BY       |      |
| DESIGNED BY       |      |
| QUANTITIES BY     |      |
| CHECKED BY        |      |

|               |     |
|---------------|-----|
| ORIGINAL PLAN | No. |
| NOTE BOOK     |     |


Legend:

- Type "C" Raised Pavement Marker
- Type "A" Raised Pavement Marker
- Type "H" Raised Pavement Marker

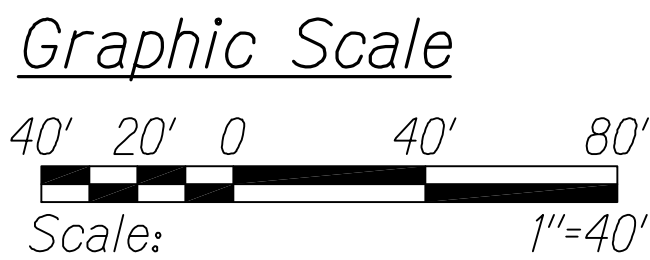

PAVEMENT MARKING AND STRIPING PLAN  
# STA. 6+00 TO # STA. 16+00  
Scale: 1" = 40'

| LEGEND FOR AS-BUILT POSTINGS |                                     |
|------------------------------|-------------------------------------|
|                              | Squiggly line for as-built deletion |
|                              | Double line for as-built deletion   |
| Roadway                      | Text for as-built posting           |

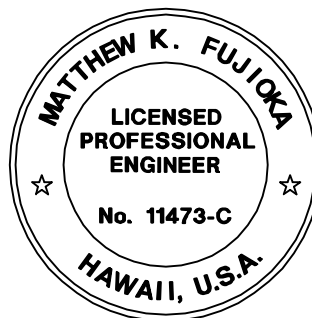

THIS WORK WAS PREPARED BY ME OR UNDER MY SUPERVISION.  
*Matthew K. Fujitaka*  
WILSON OKAMOTO CORPORATION APRIL 30, 2016 LIC. EXP. DATE


STATE OF HAWAII  
DEPARTMENT OF TRANSPORTATION  
HIGHWAYS DIVISION  
**PAVEMENT MARKING AND STRIPING PLAN**  
  
INTERSTATE ROUTE H-1  
PM CONTRAFLOW LANE, PHASE 1 # 2  
FEDERAL AID PROJECT NO. NH-HI-1 (260)  
Scale: 1" = 40' Date: July, 2016

SHEET No. PM-09 OF 27 SHEETS



| FED. ROAD DIST. NO. | STATE | FED. AID PROJ. NO. | FISCAL YEAR | SHEET NO. | TOTAL SHEETS |
|---------------------|-------|--------------------|-------------|-----------|--------------|
| HAWAII              | HAW.  | NH-HI-1 (260)      | 2014        | 125       | 605          |

TRUE NORTH  
SCALE: 1" = 40'

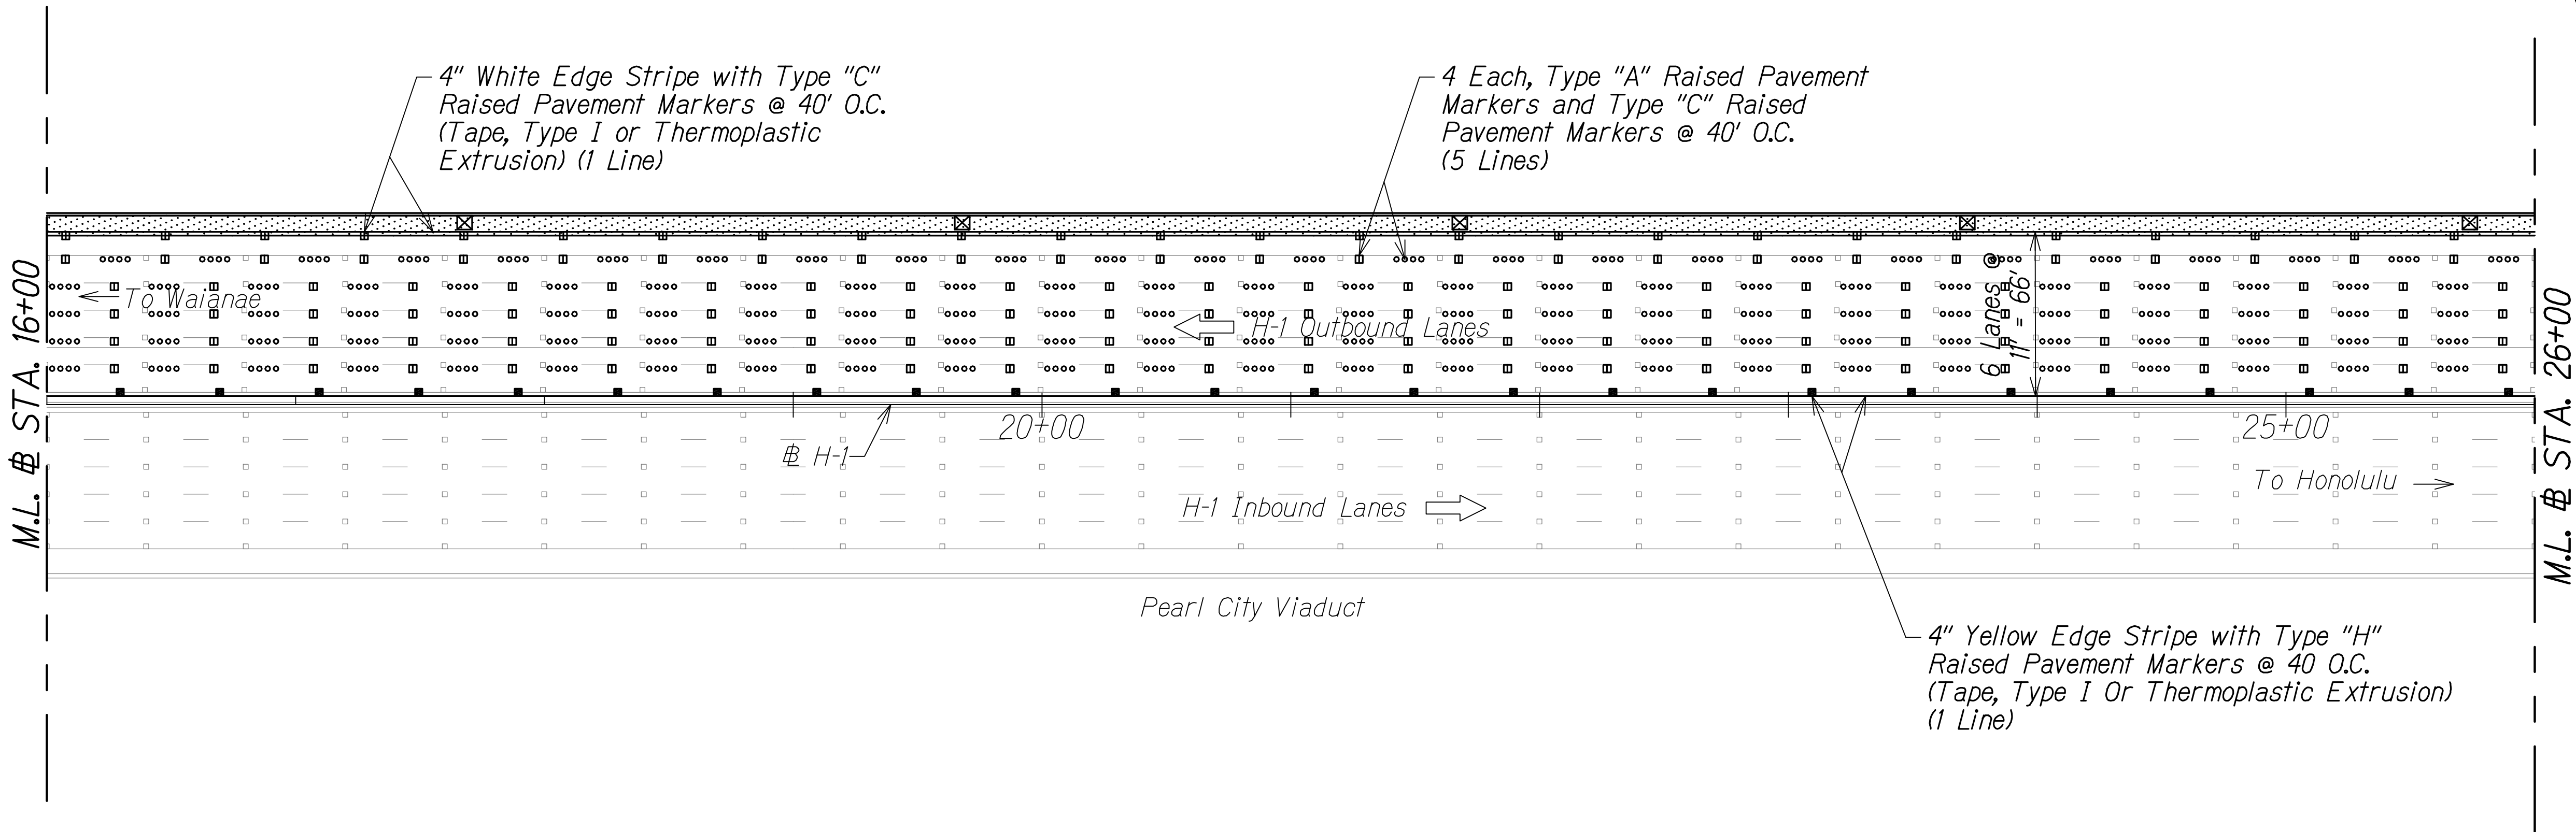


|              |      |             |                |
|--------------|------|-------------|----------------|
| QC/QA REVIEW | 100% | DATE        | MARCH 23, 2014 |
| BY           |      | DESIGNED BY | Benji J. J. J. |
| BY           |      | DESIGNED BY | Benji J. J. J. |
| BY           |      | DESIGNED BY | Benji J. J. J. |
| BY           |      | DESIGNED BY | Benji J. J. J. |

|               |      |
|---------------|------|
| ORIGINAL PLAN | DATE |
| NOTED BY      |      |
| DESIGNED BY   |      |
| QUANTITIES BY |      |
| CHECKED BY    |      |
| No.           |      |

Legend:

- Type "C" Raised Pavement Marker
- Type "A" Raised Pavement Marker
- Type "H" Raised Pavement Marker

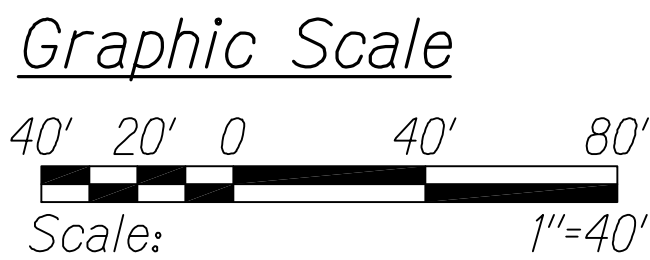


PAVEMENT MARKING AND STRIPING PLAN  
# STA. 16+00 TO # STA. 26+00  
Scale: 1" = 40'

**LEGEND FOR AS-BUILT POSTINGS**

~~~~~ Squiggly line for as-built deletion

==00.00== Double line for as-built deletion

Roadway Text for as-built posting

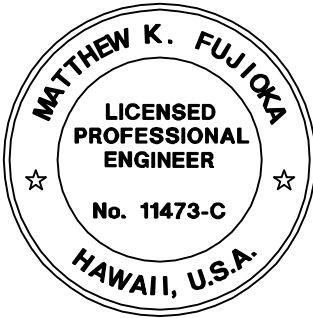

THIS WORK WAS PREPARED BY ME OR UNDER MY SUPERVISION.

Matthew K. Fujitaka

APRIL 30, 2016
WILSON OKAMOTO CORPORATION LIC. EXP. DATE

STATE OF HAWAII
DEPARTMENT OF TRANSPORTATION
HIGHWAYS DIVISION

PAVEMENT MARKING AND STRIPING PLAN


INTERSTATE ROUTE H-1
PM CONTRAFLOW LANE, PHASE 1 # 2
FEDERAL AID PROJECT NO. NH-HI-1 (260)

Scale: 1" = 40' Date: July, 2016

SHEET No. PM-10 OF 27 SHEETS

| FED. ROAD DIST. NO. | STATE | FED. AID PROJ. NO. | FISCAL YEAR | SHEET NO. | TOTAL SHEETS |
|---------------------|-------|--------------------|-------------|-----------|--------------|
| HAWAII | HAW. | NH-HI-1 (260) | 2014 | 126 | 605 |


TRUE NORTH
SCALE: 1" = 40'

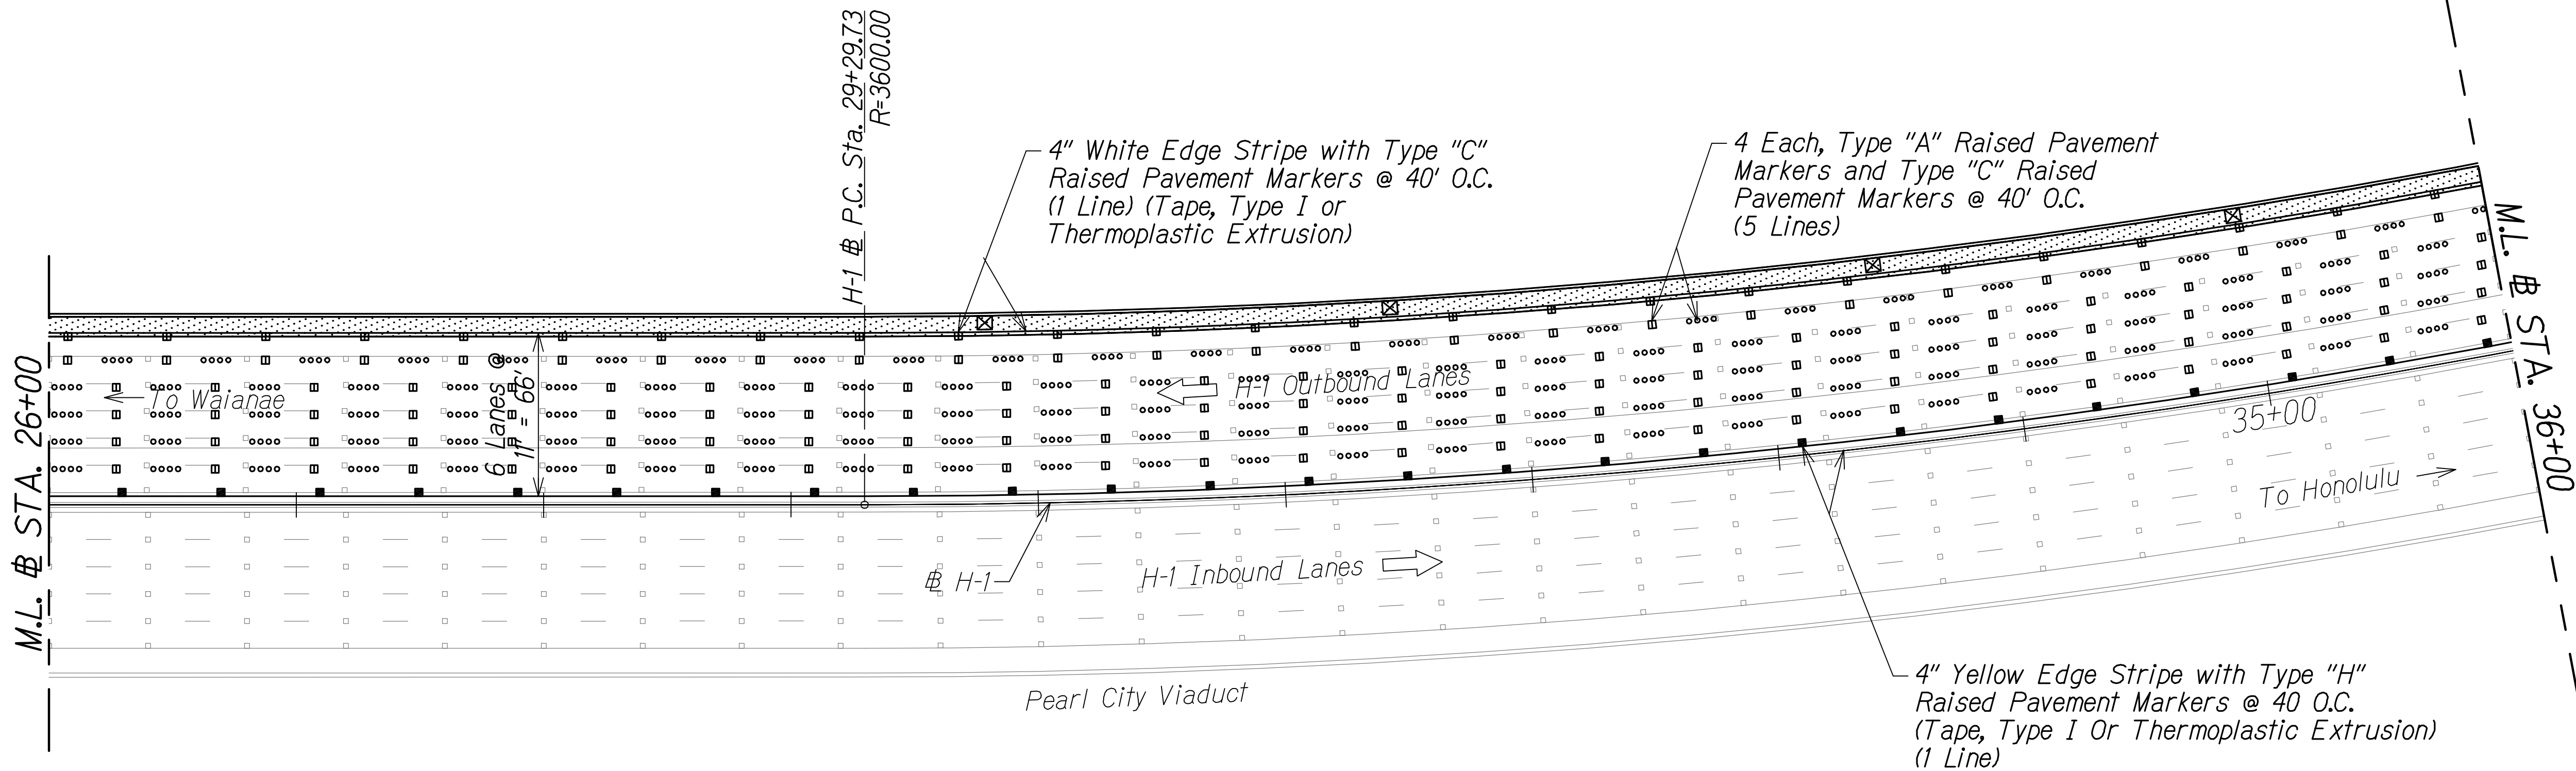

| | | | |
|--------------|------|-------------|----------------|
| QC/QA REVIEW | 100% | DATE | MARCH 23, 2014 |
| BY | | DESIGNED BY | |
| BY | | DESIGNED BY | |
| BY | | DESIGNED BY | |

| | |
|---------------|------|
| ORIGINAL PLAN | DATE |
| NOTED BY | |
| DESIGNED BY | |
| QUANTITIES BY | |
| CHECKED BY | |

- Legend:
- Type "C" Raised Pavement Marker
 - Type "A" Raised Pavement Marker
 - Type "H" Raised Pavement Marker

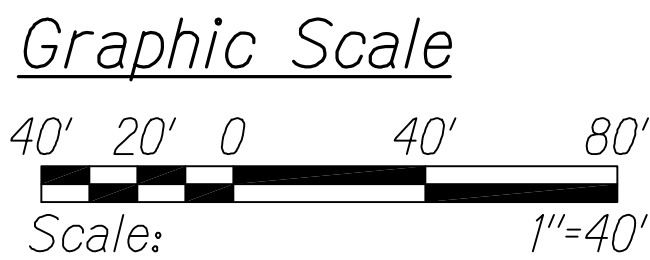

PAVEMENT MARKING AND STRIPING PLAN
STA. 26+00 TO # STA. 36+00
Scale: 1" = 40'

LEGEND FOR
AS-BUILT POSTINGS

~~~~ Squiggly line for as-built deletion

== Double line for as-built deletion

Roadway Text for as-built posting



THIS WORK WAS PREPARED BY ME  
OR UNDER MY SUPERVISION.

*Matthew K. Fujitaka*  
APRIL 30, 2016  
WILSON OKAMOTO CORPORATION LIC. EXP. DATE

STATE OF HAWAII  
DEPARTMENT OF TRANSPORTATION  
HIGHWAYS DIVISION

PAVEMENT MARKING  
AND STRIPING PLAN

INTERSTATE ROUTE H-1  
PM CONTRAFLOW LANE, PHASE 1 & 2  
FEDERAL AID PROJECT NO. NH-HI-1 (260)


Scale: 1" = 40' Date: July, 2016

SHEET No. PM-11 OF 27 SHEETS



| FED. ROAD DIST. NO. | STATE | FED. AID PROJ. NO. | FISCAL YEAR | SHEET NO. | TOTAL SHEETS |
|---------------------|-------|--------------------|-------------|-----------|--------------|
| HAWAII              | HAW.  | NH-HI-1 (260)      | 2014        | 127       | 605          |

TRUE NORTH  
SCALE: 1" = 40'

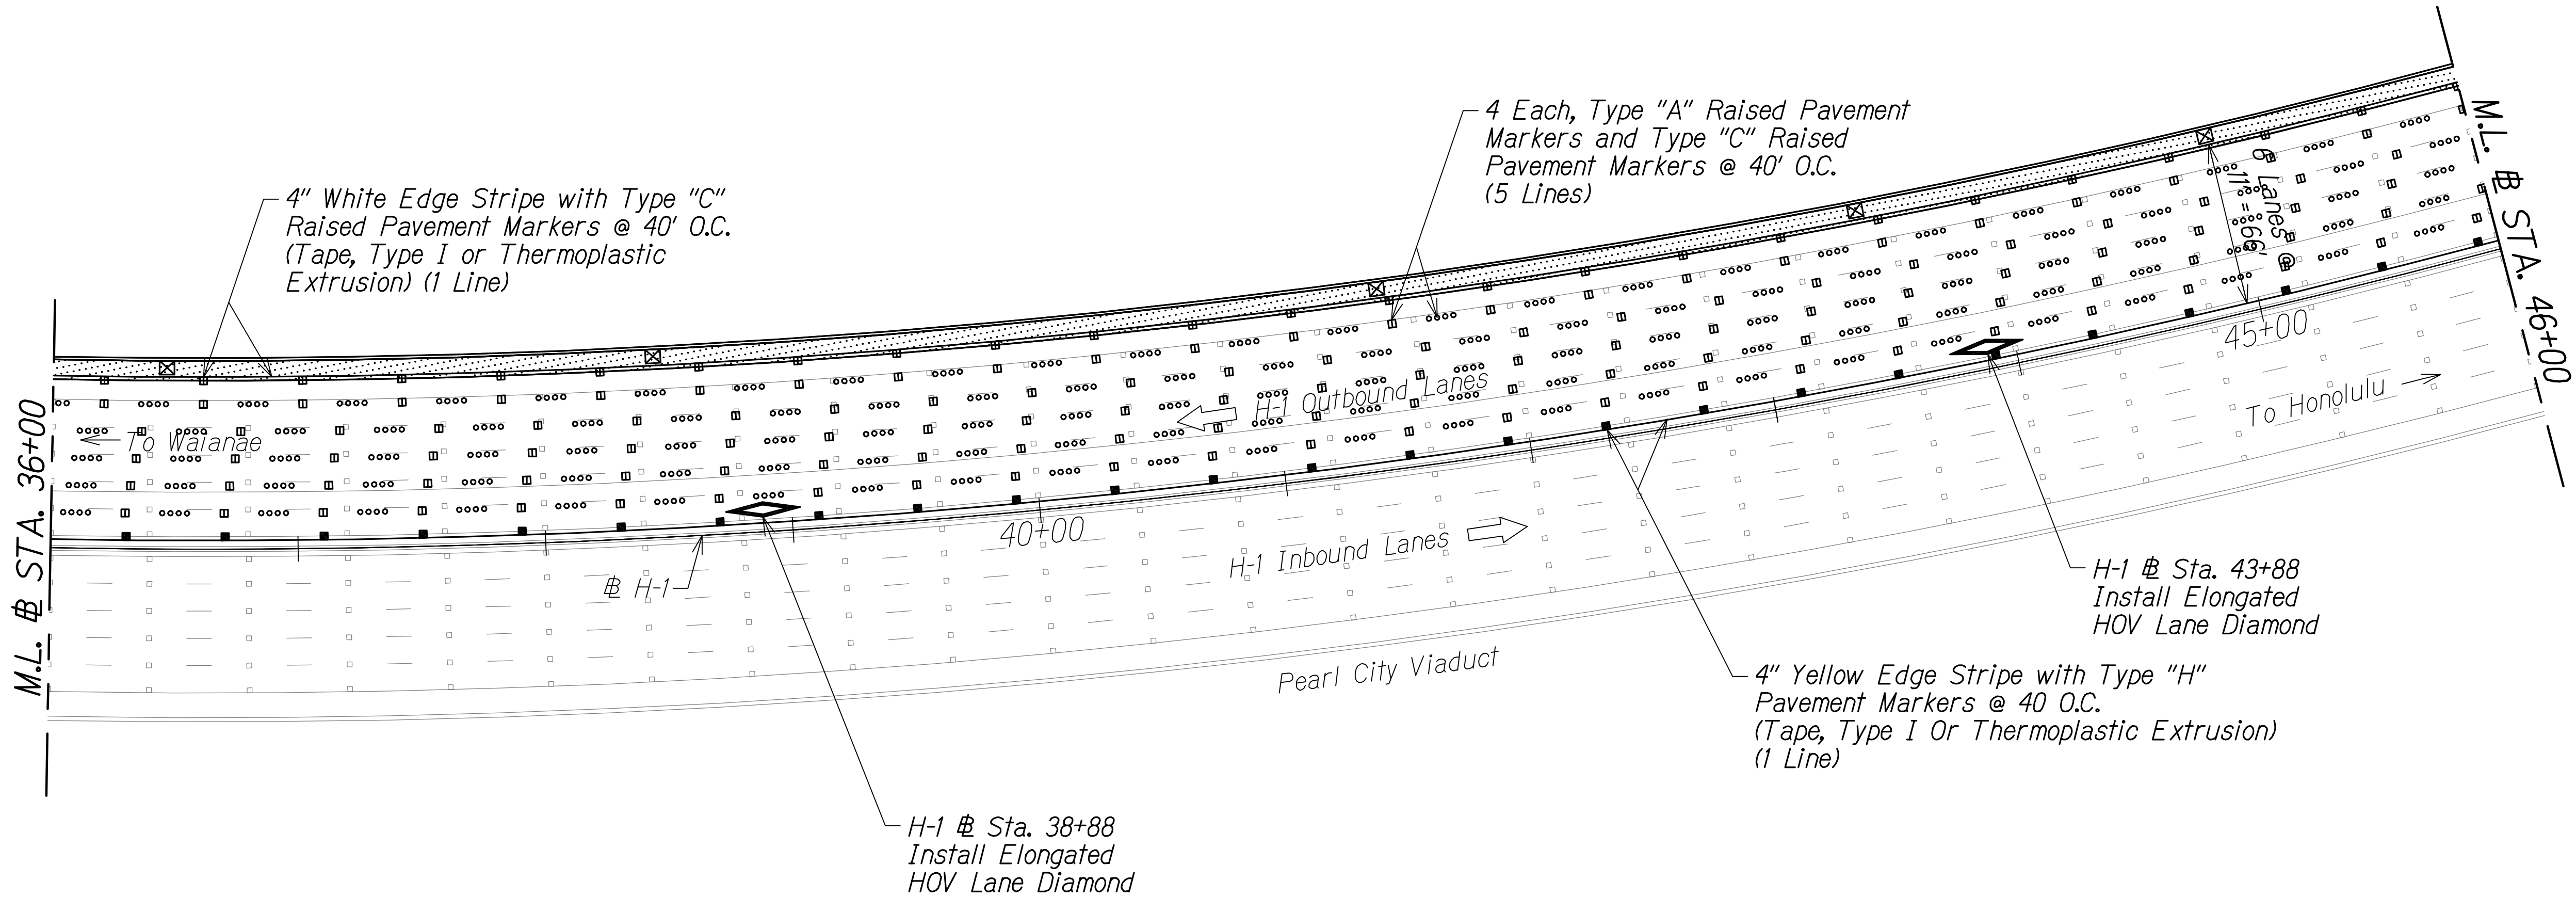


Notes:

- See Std. Plan TE-29 For Elongated HOV Lane Diamond.

Legend:

- Type "C" Raised Pavement Marker
- Type "A" Raised Pavement Marker
- Type "H" Raised Pavement Marker

Graphic Scale

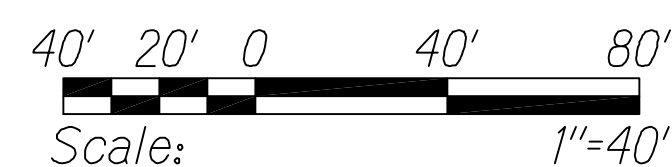


PAVEMENT MARKING AND STRIPING PLAN  
# STA. 36+00 TO # STA. 46+00

Scale: 1" = 40'

LEGEND FOR  
AS-BUILT POSTINGS

- Squiggly line for as-built deletion
- Double line for as-built deletion
- Roadway Text for as-built posting

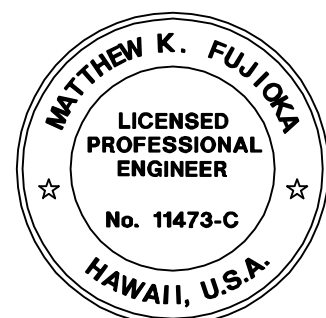

THIS WORK WAS PREPARED BY ME  
OR UNDER MY SUPERVISION.  
*Matthew K. Fujitaka*  
WILSON OKAMOTO CORPORATION APRIL 30, 2016  
LIC. EXP. DATE

STATE OF HAWAII  
DEPARTMENT OF TRANSPORTATION  
HIGHWAYS DIVISION  
PAVEMENT MARKING  
AND STRIPING PLAN


INTERSTATE ROUTE H-1  
PM CONTRAFLOW LANE, PHASE 1 # 2  
FEDERAL AID PROJECT NO. NH-HI-1 (260)  
Scale: 1" = 40' Date: July, 2016

SHEET No. PM-12 OF 27 SHEETS

"AS-BUILT"



| FED. ROAD DIST. NO. | STATE | FED. AID PROJ. NO. | FISCAL YEAR | SHEET NO. | TOTAL SHEETS |
|---------------------|-------|--------------------|-------------|-----------|--------------|
| HAWAII              | HAW.  | NH-HI-1 (260)      | 2014        | 128       | 605          |

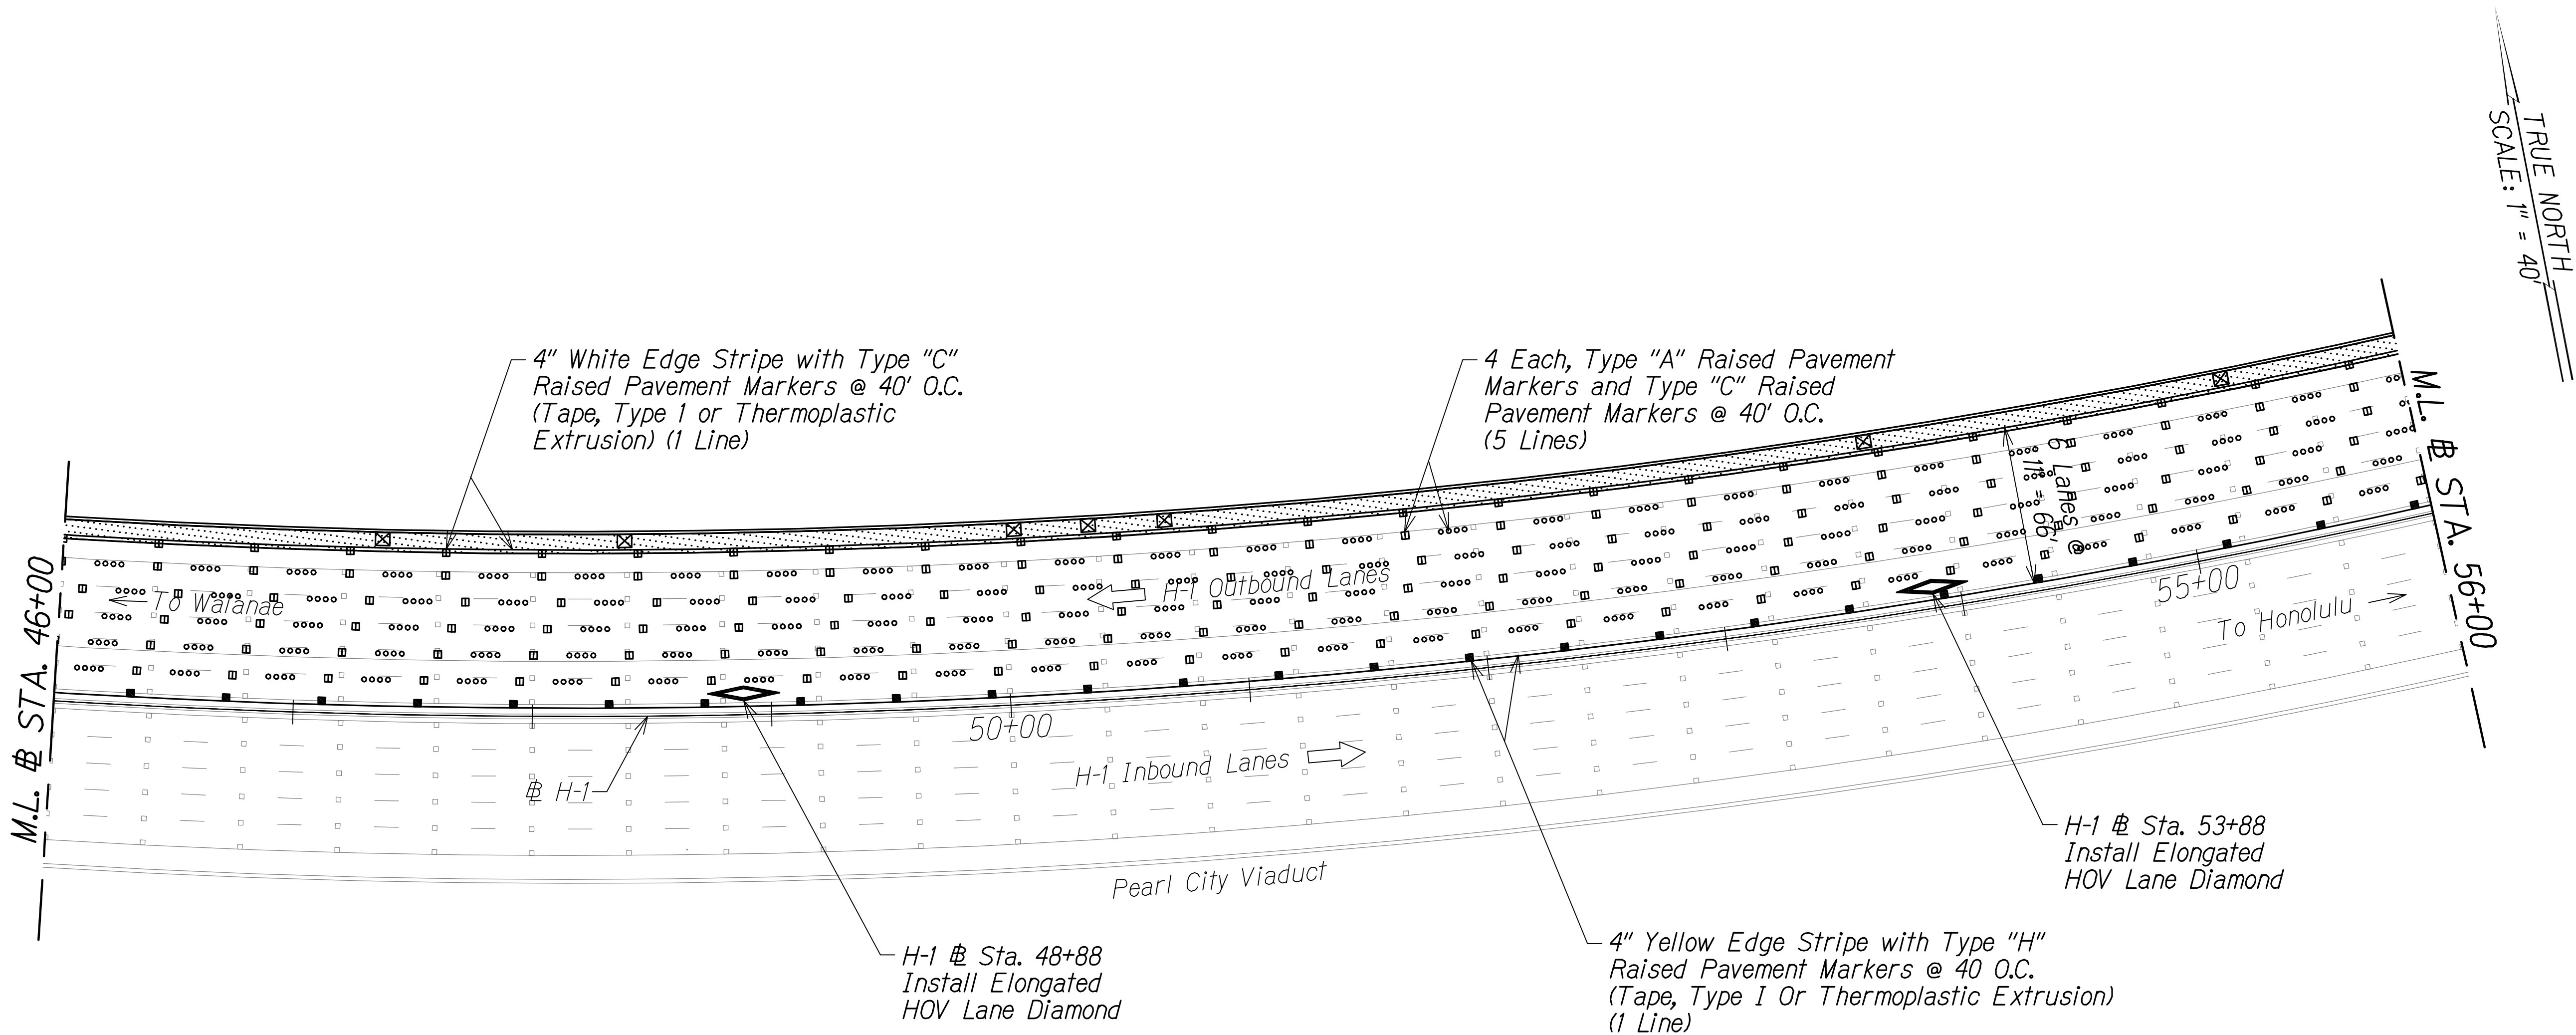


**Notes:**

- See Std. Plan TE-29 For Elongated HOV Lane Diamond.

**Legend:**

- Type "C" Raised Pavement Marker
- Type "A" Raised Pavement Marker
- Type "H" Raised Pavement Marker

**Graphic Scale**

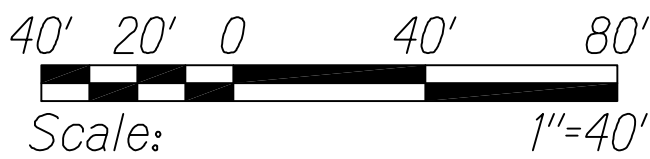

**PAVEMENT MARKING AND STRIPING PLAN**  
**# STA. 46+00 TO # STA. 56+00**

Scale: 1" = 40'

**LEGEND FOR**  
**AS-BUILT POSTINGS**

- Squiggly line for as-built deletion
- Double line for as-built deletion
- Roadway Text for as-built posting



THIS WORK WAS PREPARED BY ME  
OR UNDER MY SUPERVISION.  
*Matthew K. Fujita*  
WILSON OKAMOTO CORPORATION APRIL 30, 2018  
LIC. EXP. DATE

STATE OF HAWAII  
DEPARTMENT OF TRANSPORTATION  
HIGHWAYS DIVISION  
**PAVEMENT MARKING  
AND STRIPING PLAN**


INTERSTATE ROUTE H-1  
PM CONTRAFLOW LANE, PHASE 1 & 2  
FEDERAL AID PROJECT NO. NH-HI-1 (260)  
Scale: 1" = 40' Date: July, 2016

SHEET No. PM-13 OF 27 SHEETS

"AS-BUILT"



| FED. ROAD DIST. NO. | STATE | FED. AID PROJ. NO. | FISCAL YEAR | SHEET NO. | TOTAL SHEETS |
|---------------------|-------|--------------------|-------------|-----------|--------------|
| HAWAII              | HAW.  | NH-HI-1 (260)      | 2014        | 129       | 605          |

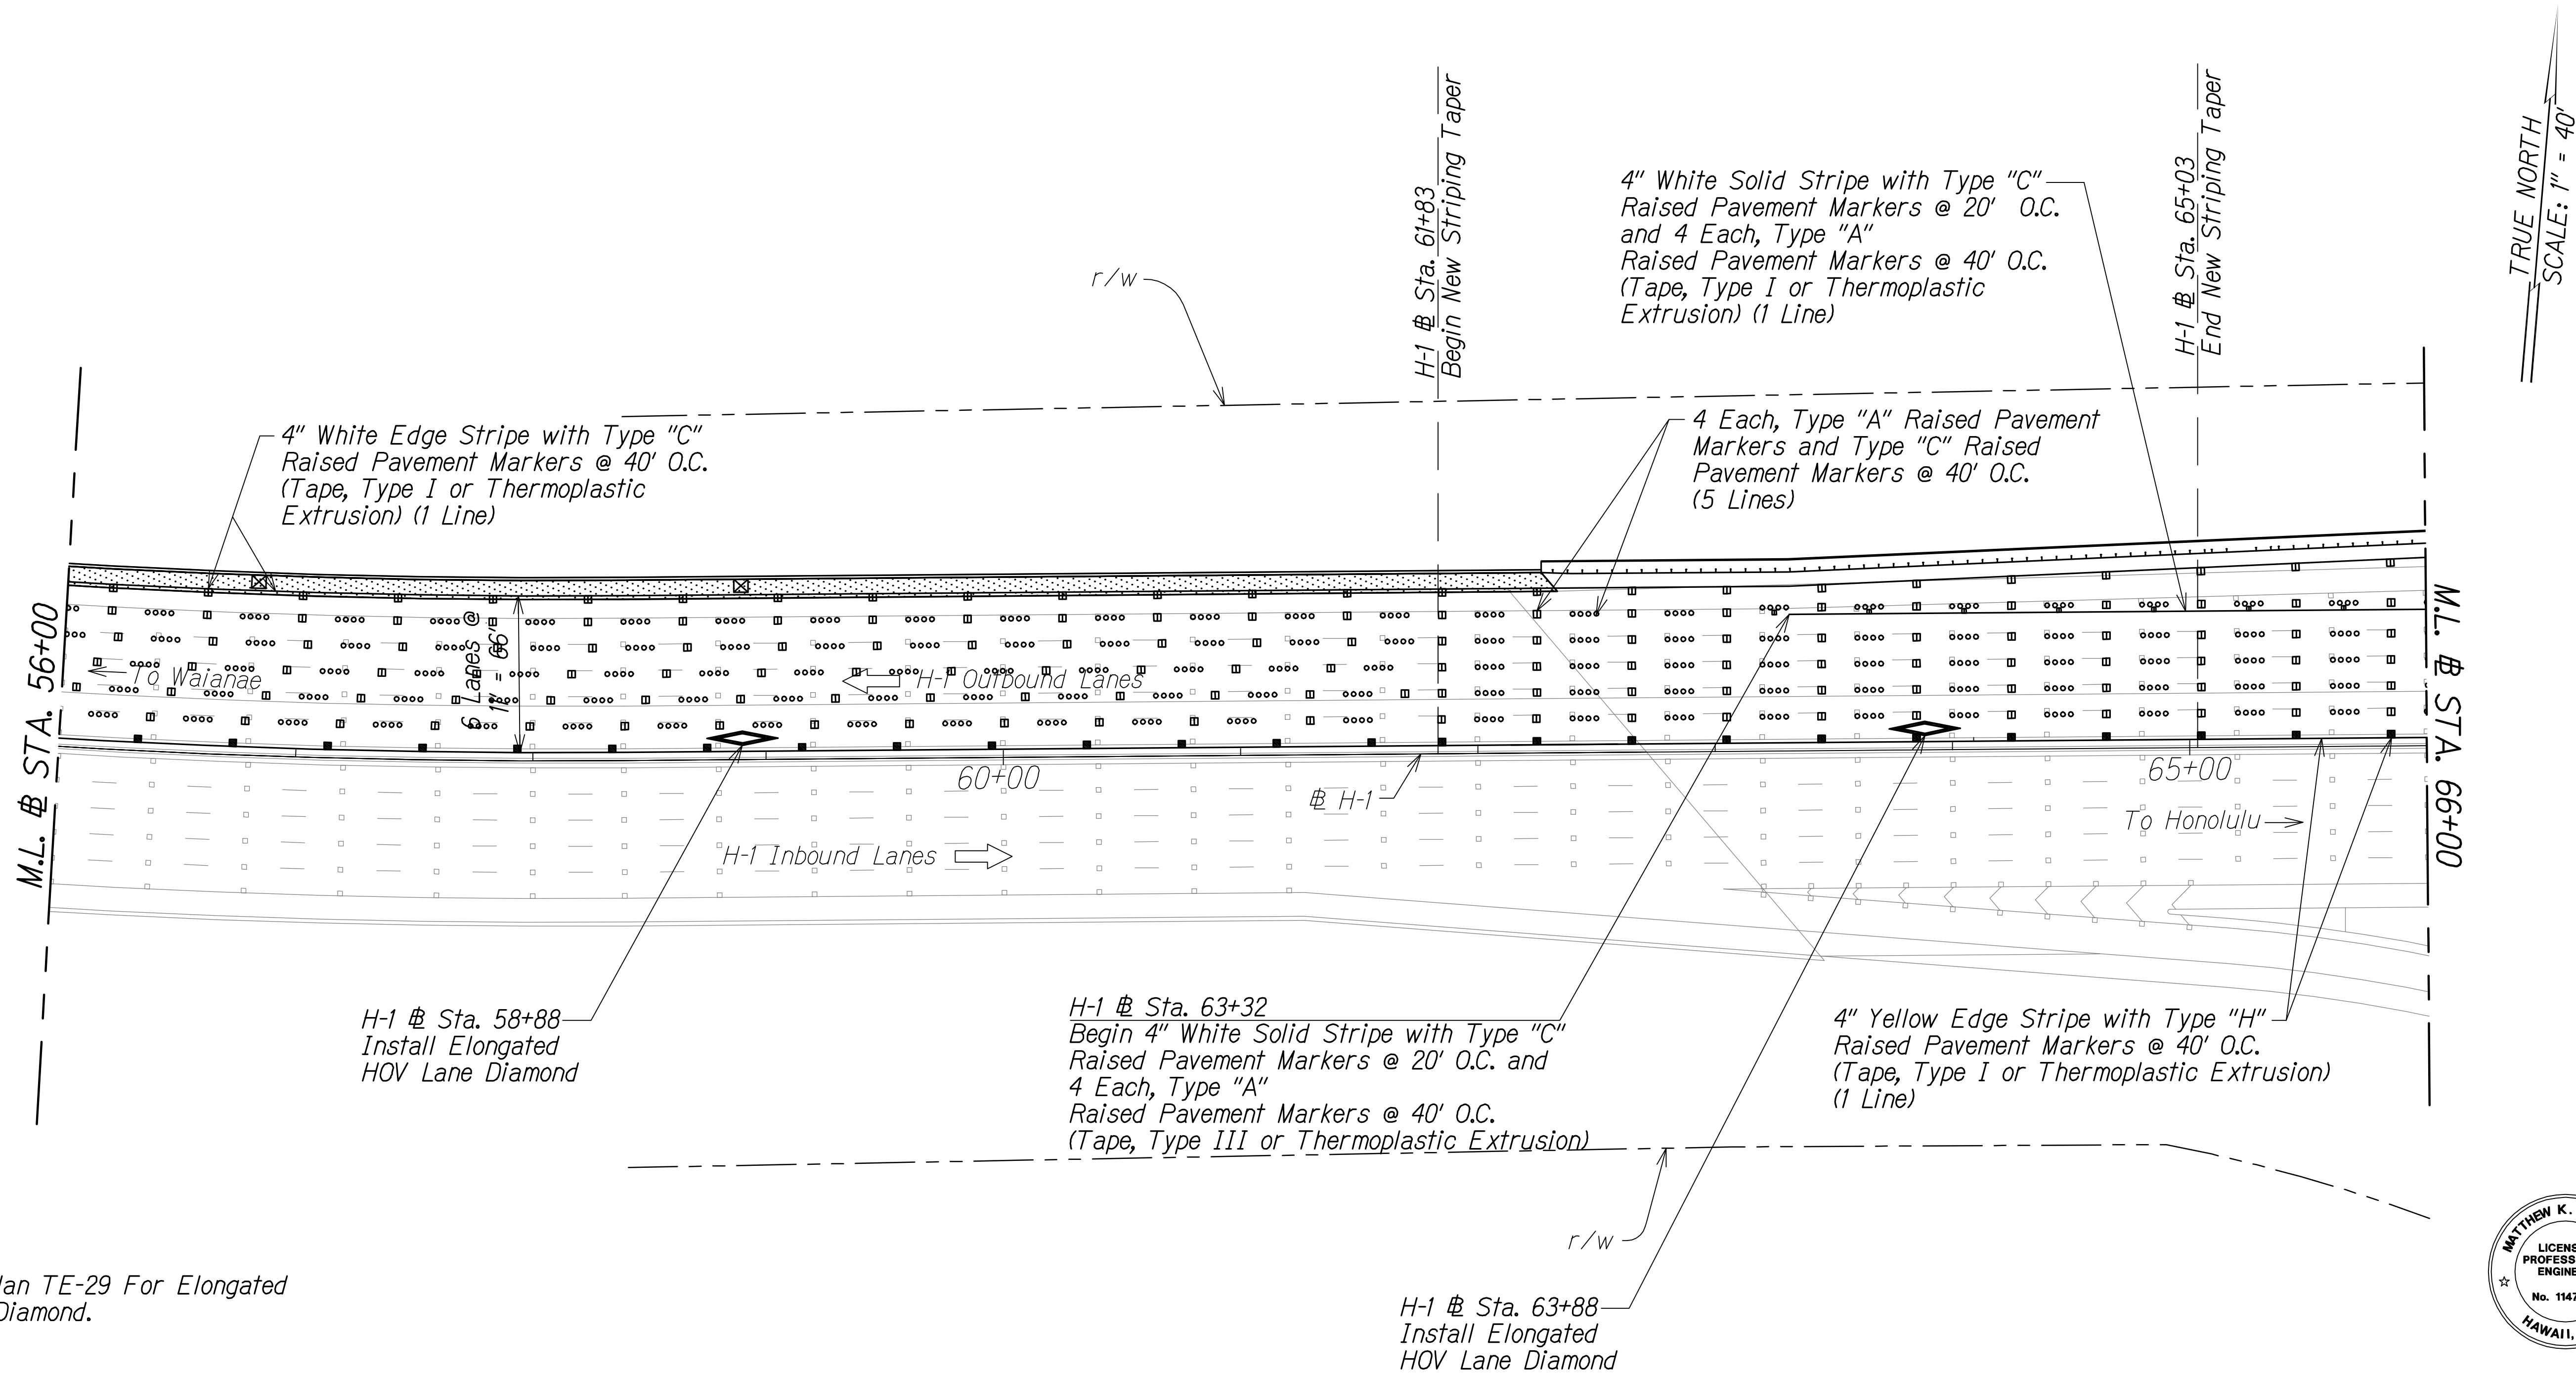

Notes:

- See Std. Plan TE-29 For Elongated HOV Lane Diamond.

Legend:

- Type "C" Raised Pavement Marker
- Type "A" Raised Pavement Marker
- Type "H" Raised Pavement Marker




PAVEMENT MARKING AND STRIPING PLAN  
# STA. 56+00 TO # STA. 66+00  
Scale: 1" = 40'

| LEGEND FOR AS-BUILT POSTINGS |                                     |
|------------------------------|-------------------------------------|
|                              | Squiggly line for as-built deletion |
|                              | Double line for as-built deletion   |
| Roadway                      | Text for as-built posting           |

STATE OF HAWAII  
DEPARTMENT OF TRANSPORTATION  
HIGHWAYS DIVISION  
**PAVEMENT MARKING AND STRIPING PLAN**  
INTERSTATE ROUTE H-1  
PM CONTRAFLOW LANE, PHASE 1 # 2  
FEDERAL AID PROJECT NO. NH-HI-1 (260)  
Scale: 1" = 40' Date: July, 2016  
SHEET No. PM-14 OF 27 SHEETS

|              |      |                      |
|--------------|------|----------------------|
| QC/QA REVIEW | 100% | DATE: MARCH 23, 2014 |
| BY           |      |                      |
| BY           |      |                      |
| BY           |      |                      |
| BY           |      |                      |


|                   |      |
|-------------------|------|
| SURVEY PLOTTED BY | DATE |
| DESIGNED BY       |      |
| NOTED BY          |      |
| QUANTITIES BY     |      |
| CHECKED BY        |      |
| No.               |      |

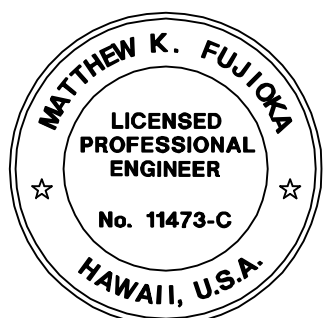

THIS WORK WAS PREPARED BY ME  
OR UNDER MY SUPERVISION.  
*Matthew K. Fujitaka*  
APRIL 30, 2018  
WILSON OKAMOTO CORPORATION LIC. EXP. DATE




| FED. ROAD DIST. NO. | STATE | FED. AID PROJ. NO. | FISCAL YEAR | SHEET NO. | TOTAL SHEETS |
|---------------------|-------|--------------------|-------------|-----------|--------------|
| HAWAII              | HAW.  | NH-HI-1 (260)      | 2014        | 130       | 605          |

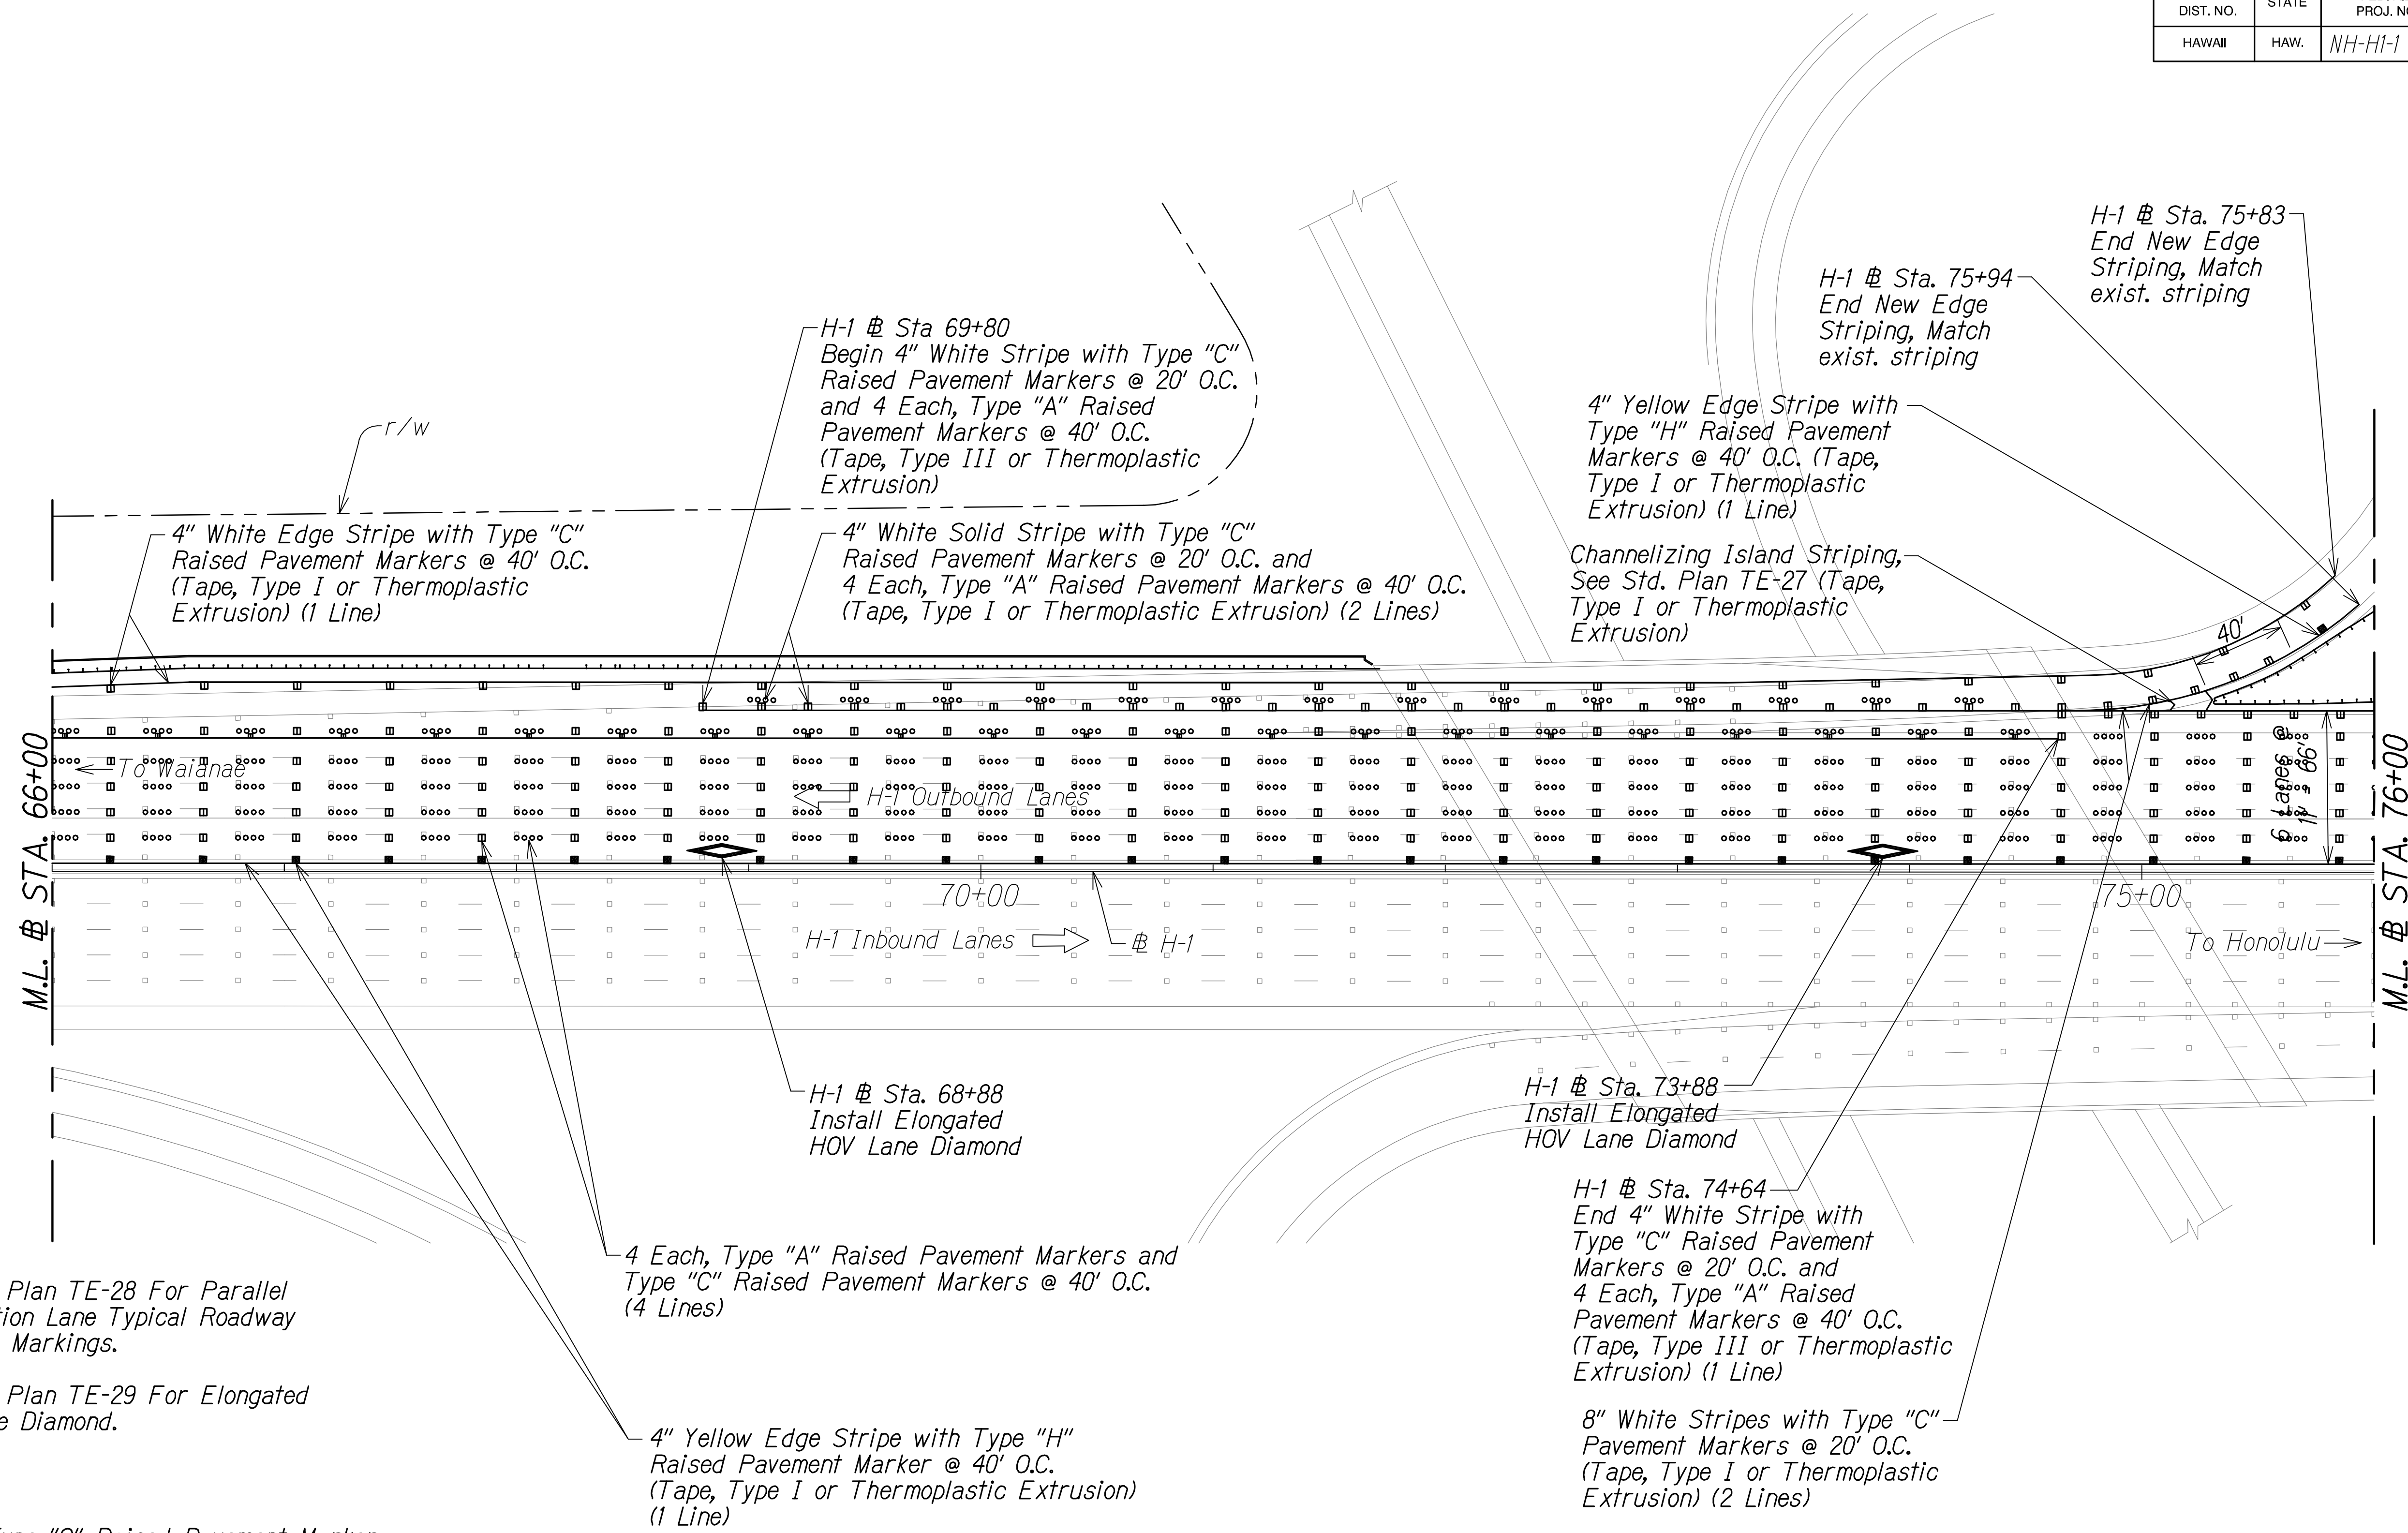

TRUE NORTH  
SCALE: 1" = 40'

- Notes:**
- See Std. Plan TE-28 For Parallel Acceleration Lane Typical Roadway Entrance Markings.
  - See Std. Plan TE-29 For Elongated HOV Lane Diamond.

- Legend:**
- Type "C" Raised Pavement Marker
  - Type "A" Raised Pavement Marker
  - Type "H" Raised Pavement Marker

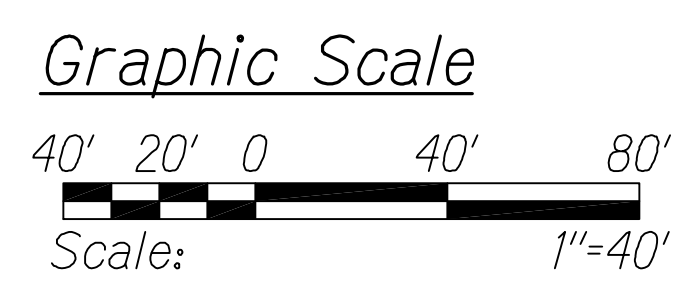

PAVEMENT MARKING AND STRIPING PLAN  
# STA. 66+00 TO # STA. 76+00  
Scale: 1" = 40'

**LEGEND FOR AS-BUILT POSTINGS**

~~~~~ Squiggly line for as-built deletion

==00.00== Double line for as-built deletion


Roadway Text for as-built posting

STATE OF HAWAII
DEPARTMENT OF TRANSPORTATION
HIGHWAYS DIVISION

PAVEMENT MARKING AND STRIPING PLAN

INTERSTATE ROUTE H-1
PM CONTRAFLOW LANE, PHASE 1 # 2
FEDERAL AID PROJECT NO. NH-HI-1 (260)
Scale: 1" = 40' Date: July, 2016

SHEET No. PM-15 OF 27 SHEETS

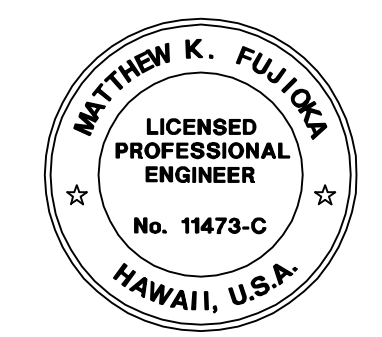

THIS WORK WAS PREPARED BY ME OR UNDER MY SUPERVISION.

Matthew K. Fujitaka
APRIL 30, 2018
WILSON OKAMOTO CORPORATION LIC. EXP. DATE


QC/QA REVIEW 100% DATE: MARCH 23, 2014

DESIGNED BY: [Signature]
CHECKED BY: [Signature]
BY: [Signature]
BY: [Signature]
BY: [Signature]

SURVEY PLOTTED BY: [Signature]
DATE: [Signature]
DESIGNED BY: [Signature]
CHECKED BY: [Signature]
BY: [Signature]
BY: [Signature]

ORIGINAL PLAN NOTE BOOK No. [Signature]

| FED. ROAD DIST. NO. | STATE | FED. AID PROJ. NO. | FISCAL YEAR | SHEET NO. | TOTAL SHEETS |
|---------------------|-------|--------------------|-------------|-----------|--------------|
| HAWAII | HAW. | NH-HI-1 (260) | 2014 | 132 | 605 |

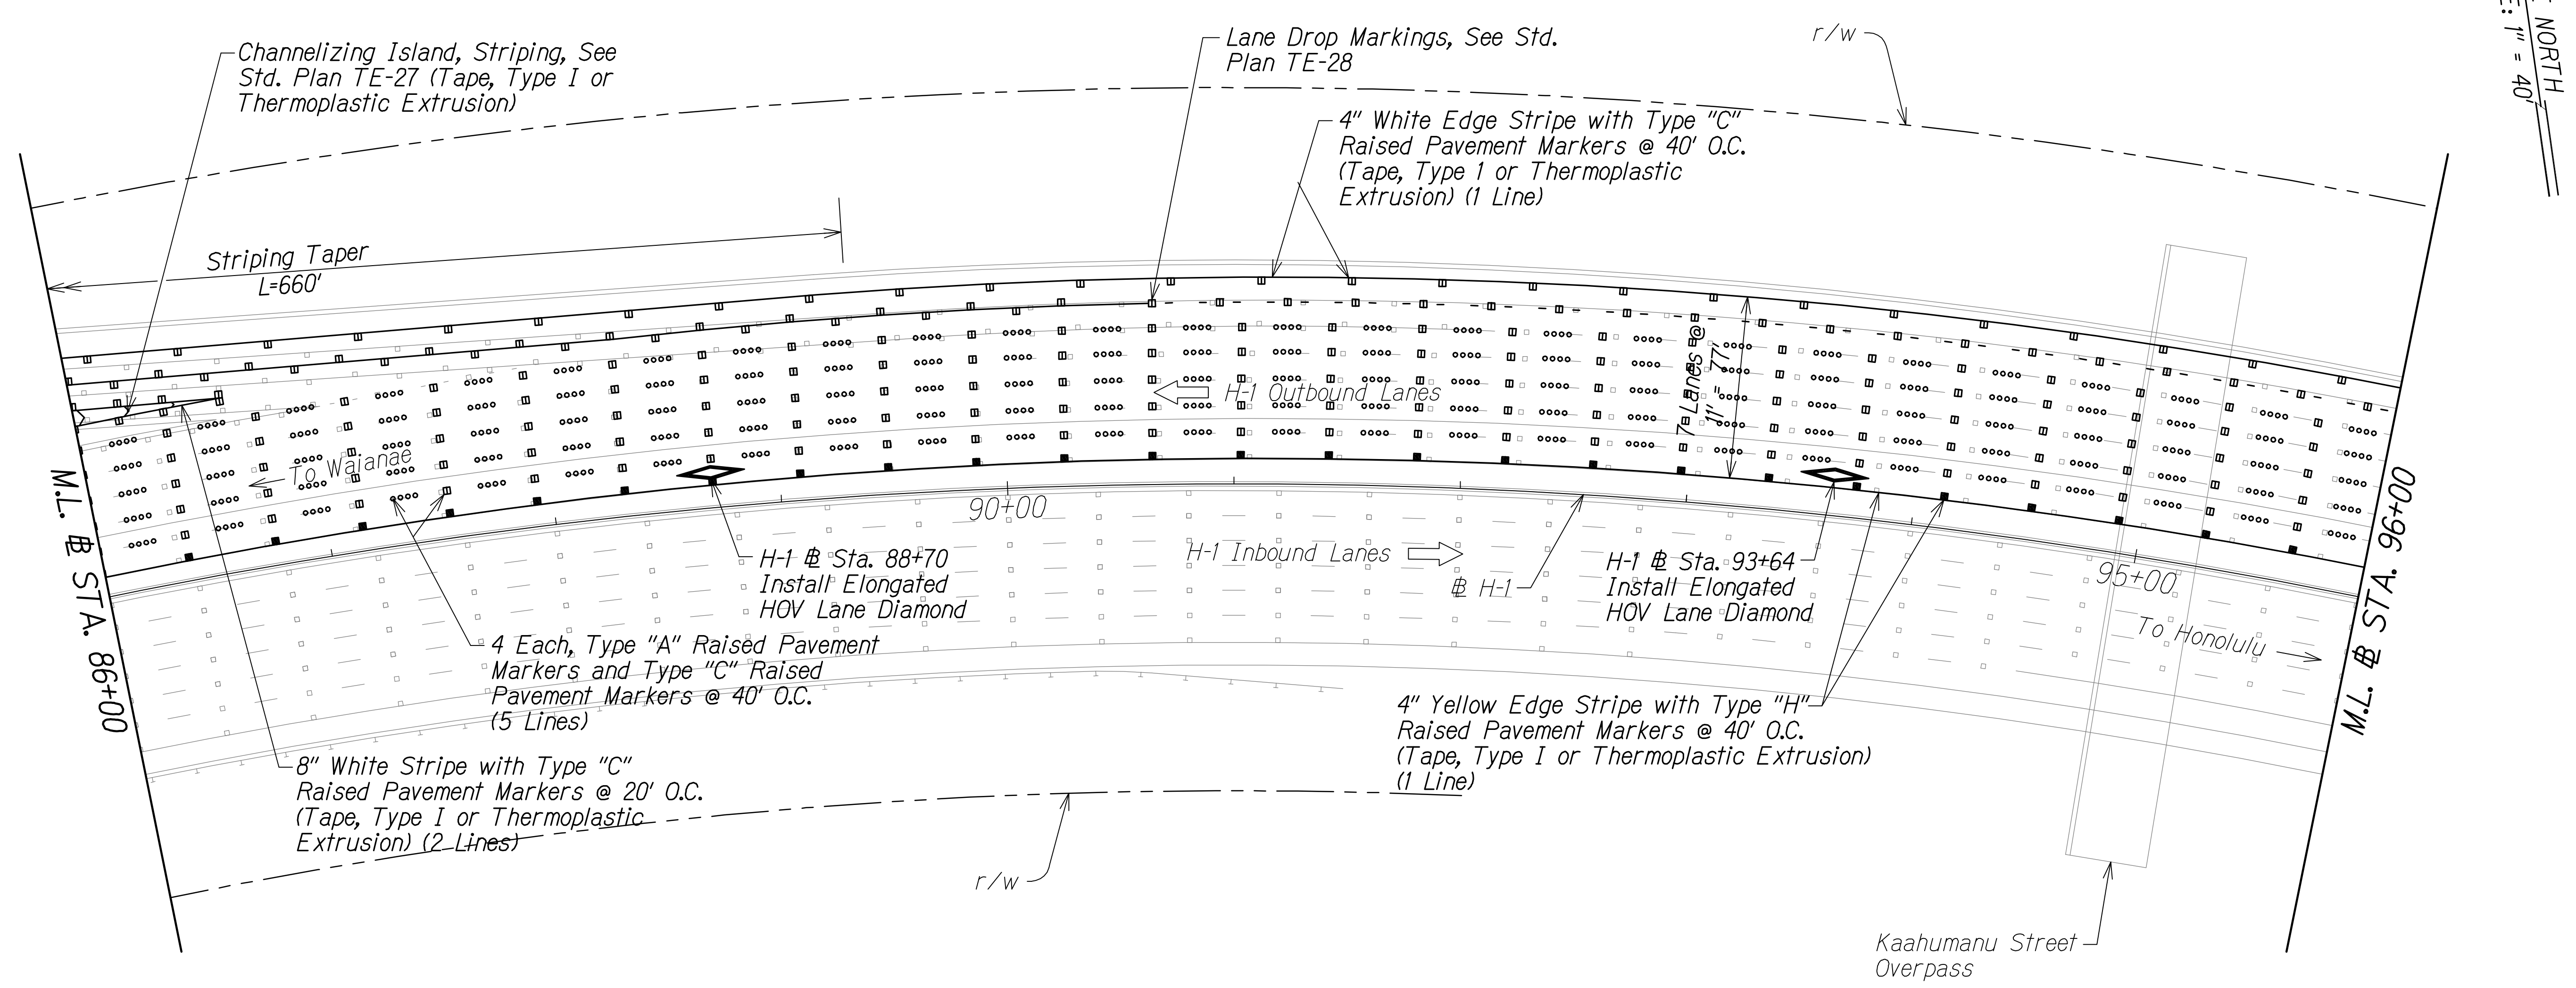


Notes:

- 1. See Std. Plan TE-29 For Elongated HOV Lane Diamond.

Legend:

- ▣ Type "C" Raised Pavement Marker
- Type "A" Raised Pavement Marker
- Type "H" Raised Pavement Marker

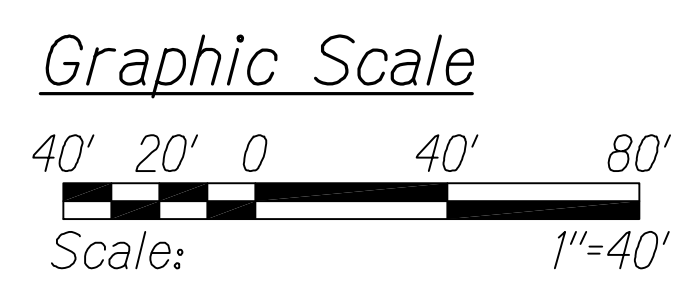

PAVEMENT MARKING AND STRIPING PLAN
STA. 86+00 TO # STA. 96+00
Scale: 1" = 40'

LEGEND FOR AS-BUILT POSTINGS

Squiggly line for as-built deletion

Double line for as-built deletion

Roadway Text for as-built posting

THIS WORK WAS PREPARED BY ME OR UNDER MY SUPERVISION.

APRIL 30, 2018
WILSON OKAMOTO CORPORATION LIC. EXP. DATE


STATE OF HAWAII
DEPARTMENT OF TRANSPORTATION
HIGHWAYS DIVISION

PAVEMENT MARKING AND STRIPING PLAN

INTERSTATE ROUTE H-1
PM CONTRAFLOW LANE, PHASE 1 # 2
FEDERAL AID PROJECT NO. NH-HI-1 (260)
Scale: 1" = 40' Date: July, 2016

SHEET No. PM-17 OF 27 SHEETS

| FED. ROAD DIST. NO. | STATE | FED. AID PROJ. NO. | FISCAL YEAR | SHEET NO. | TOTAL SHEETS |
|---------------------|-------|--------------------|-------------|-----------|--------------|
| HAWAII | HAW. | NH-HI-1 (260) | 2014 | 133 | 605 |

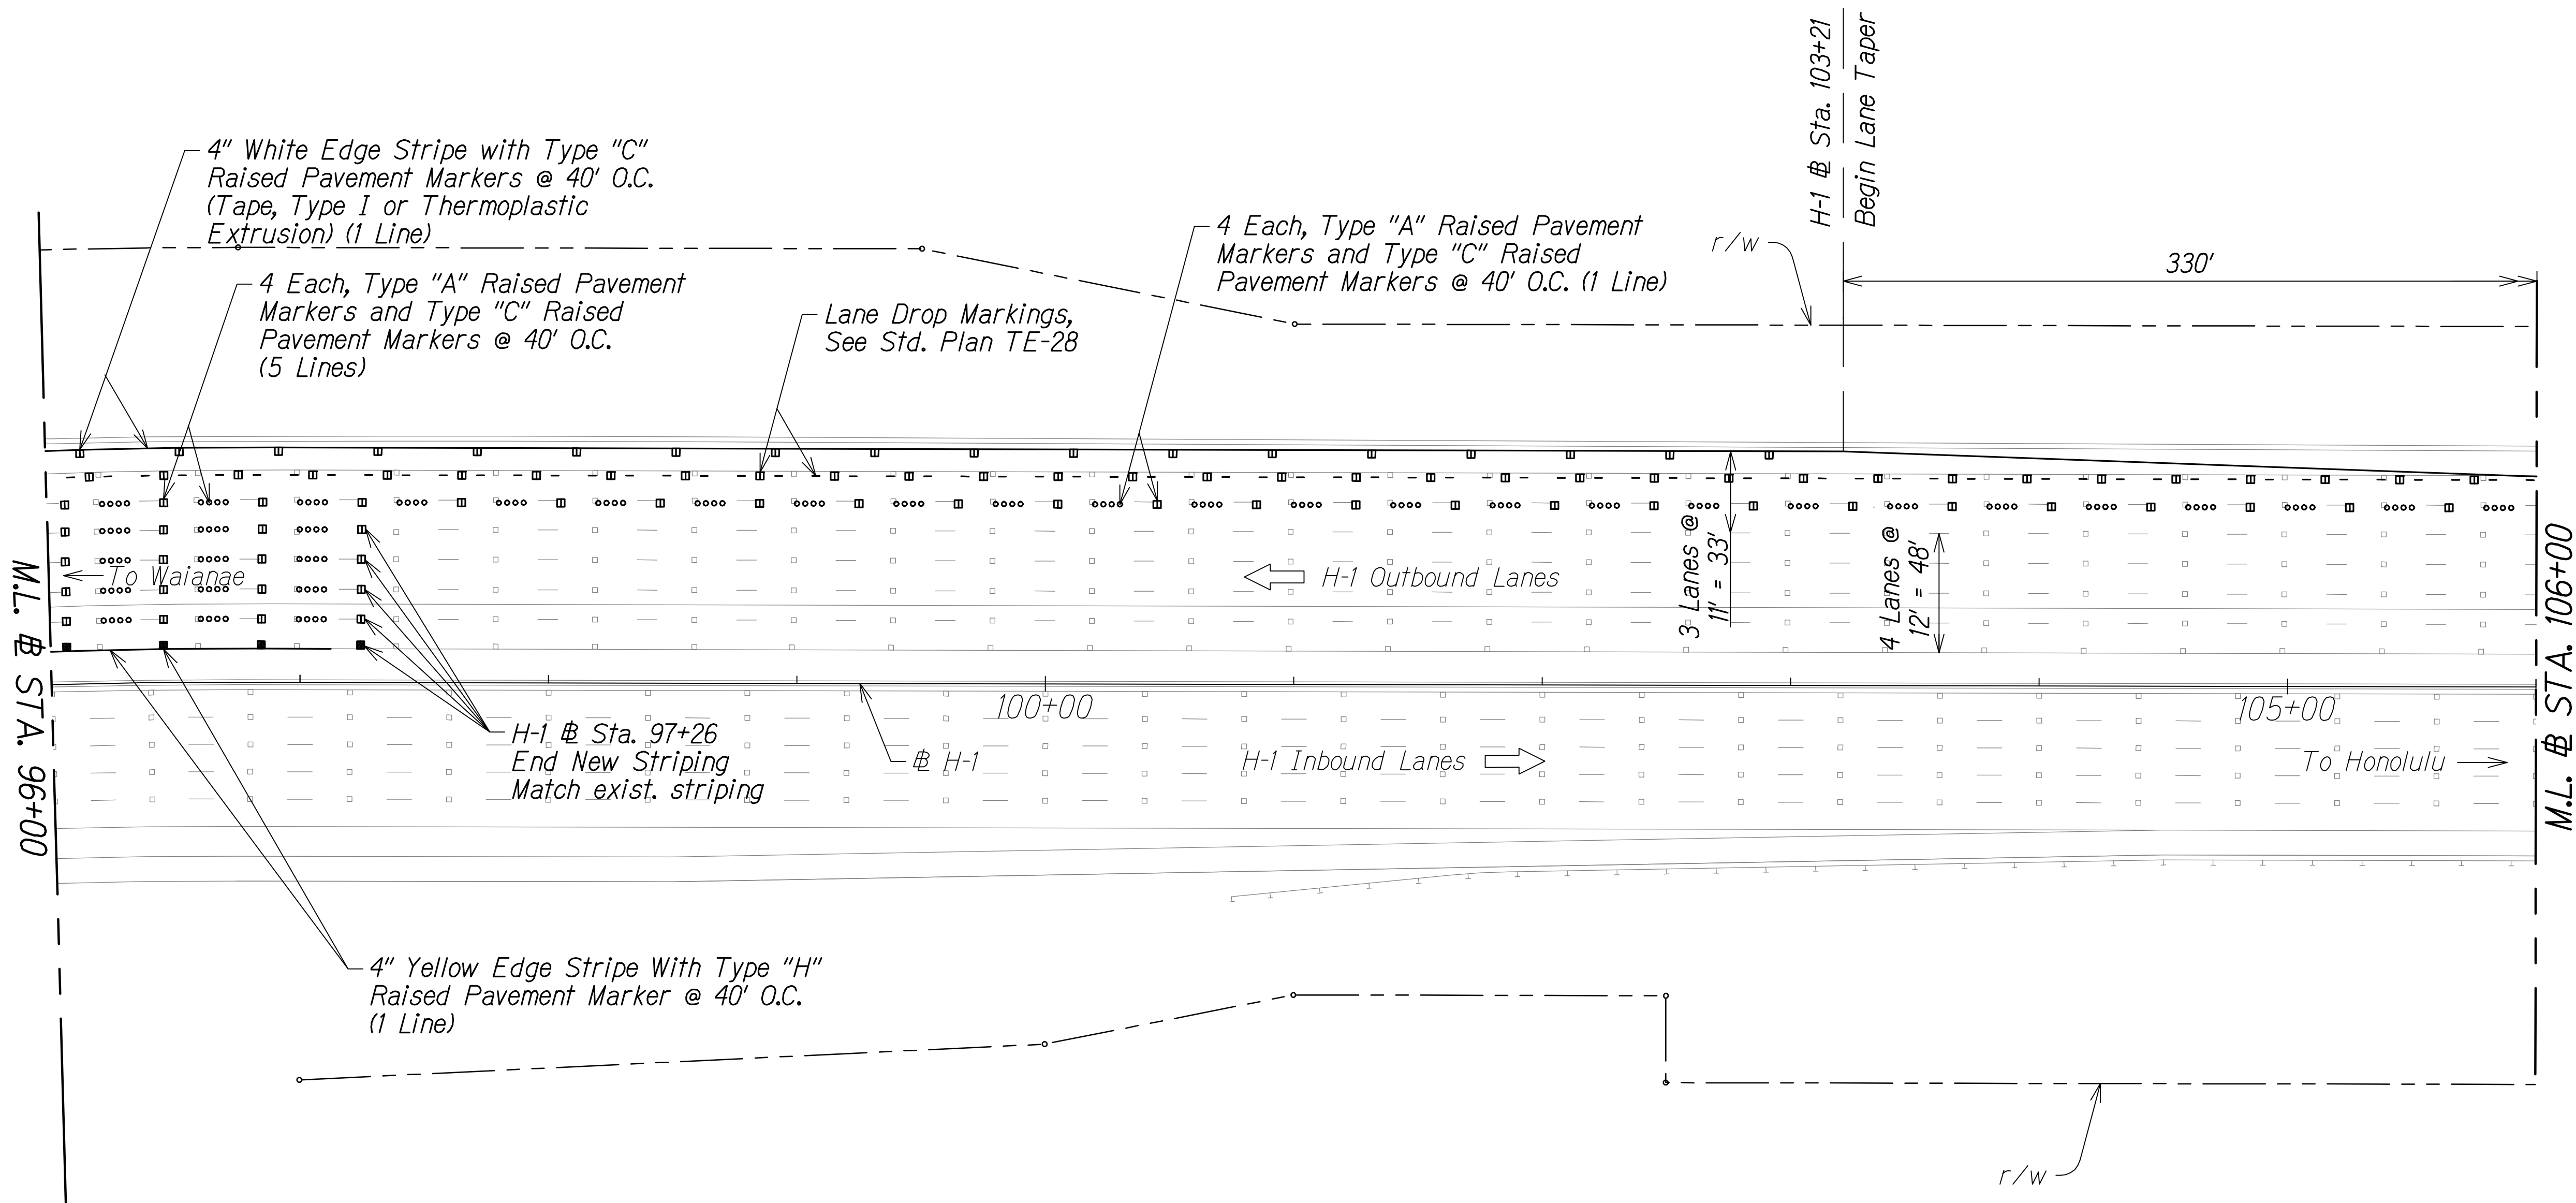


TRUE NORTH
SCALE: 1" = 40'

| | | | |
|--------------|------|-------------|----------------|
| QC/QA REVIEW | 100% | DATE | MARCH 23, 2014 |
| BY | | DESIGNED BY | |
| BY | | DESIGNED BY | |
| BY | | DESIGNED BY | |


| | |
|-------------------|------|
| SURVEY PLOTTED BY | DATE |
| DESIGNED BY | |
| DESIGNED BY | |
| QUANTITIES BY | |
| CHECKED BY | |

- Legend:**
- ▣ Type "C" Raised Pavement Marker
 - Type "A" Raised Pavement Marker
 - Type "H" Raised Pavement Marker

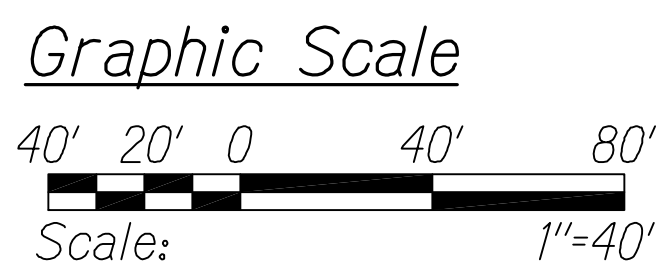

PAVEMENT MARKING AND STRIPING PLAN
STA. 96+00 TO # STA. 106+00
Scale: 1" = 40'


| LEGEND FOR AS-BUILT POSTINGS | |
|------------------------------|-------------------------------------|
| | Squiggly line for as-built deletion |
| | Double line for as-built deletion |
| Roadway | Text for as-built posting |

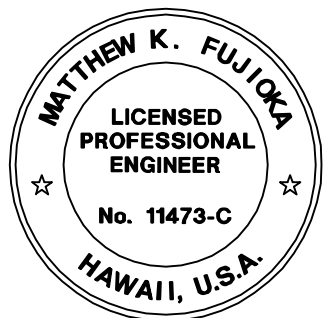

THIS WORK WAS PREPARED BY ME OR UNDER MY SUPERVISION.
Matthew K. Fujitaka
WILSON OKAMOTO CORPORATION APRIL 30, 2018 LIC. EXP. DATE

STATE OF HAWAII
DEPARTMENT OF TRANSPORTATION
HIGHWAYS DIVISION
PAVEMENT MARKING AND STRIPING PLAN
INTERSTATE ROUTE H-1
PM CONTRAFLOW LANE, PHASE 1 # 2
FEDERAL AID PROJECT NO. NH-HI-1 (260)
Scale: 1" = 40' Date: July, 2016
SHEET No. PM-18 OF 27 SHEETS

| FED. ROAD DIST. NO. | STATE | FED. AID PROJ. NO. | FISCAL YEAR | SHEET NO. | TOTAL SHEETS |
|---------------------|-------|--------------------|-------------|-----------|--------------|
| HAWAII | HAW. | NH-HI-1 (260) | 2014 | 134 | 605 |

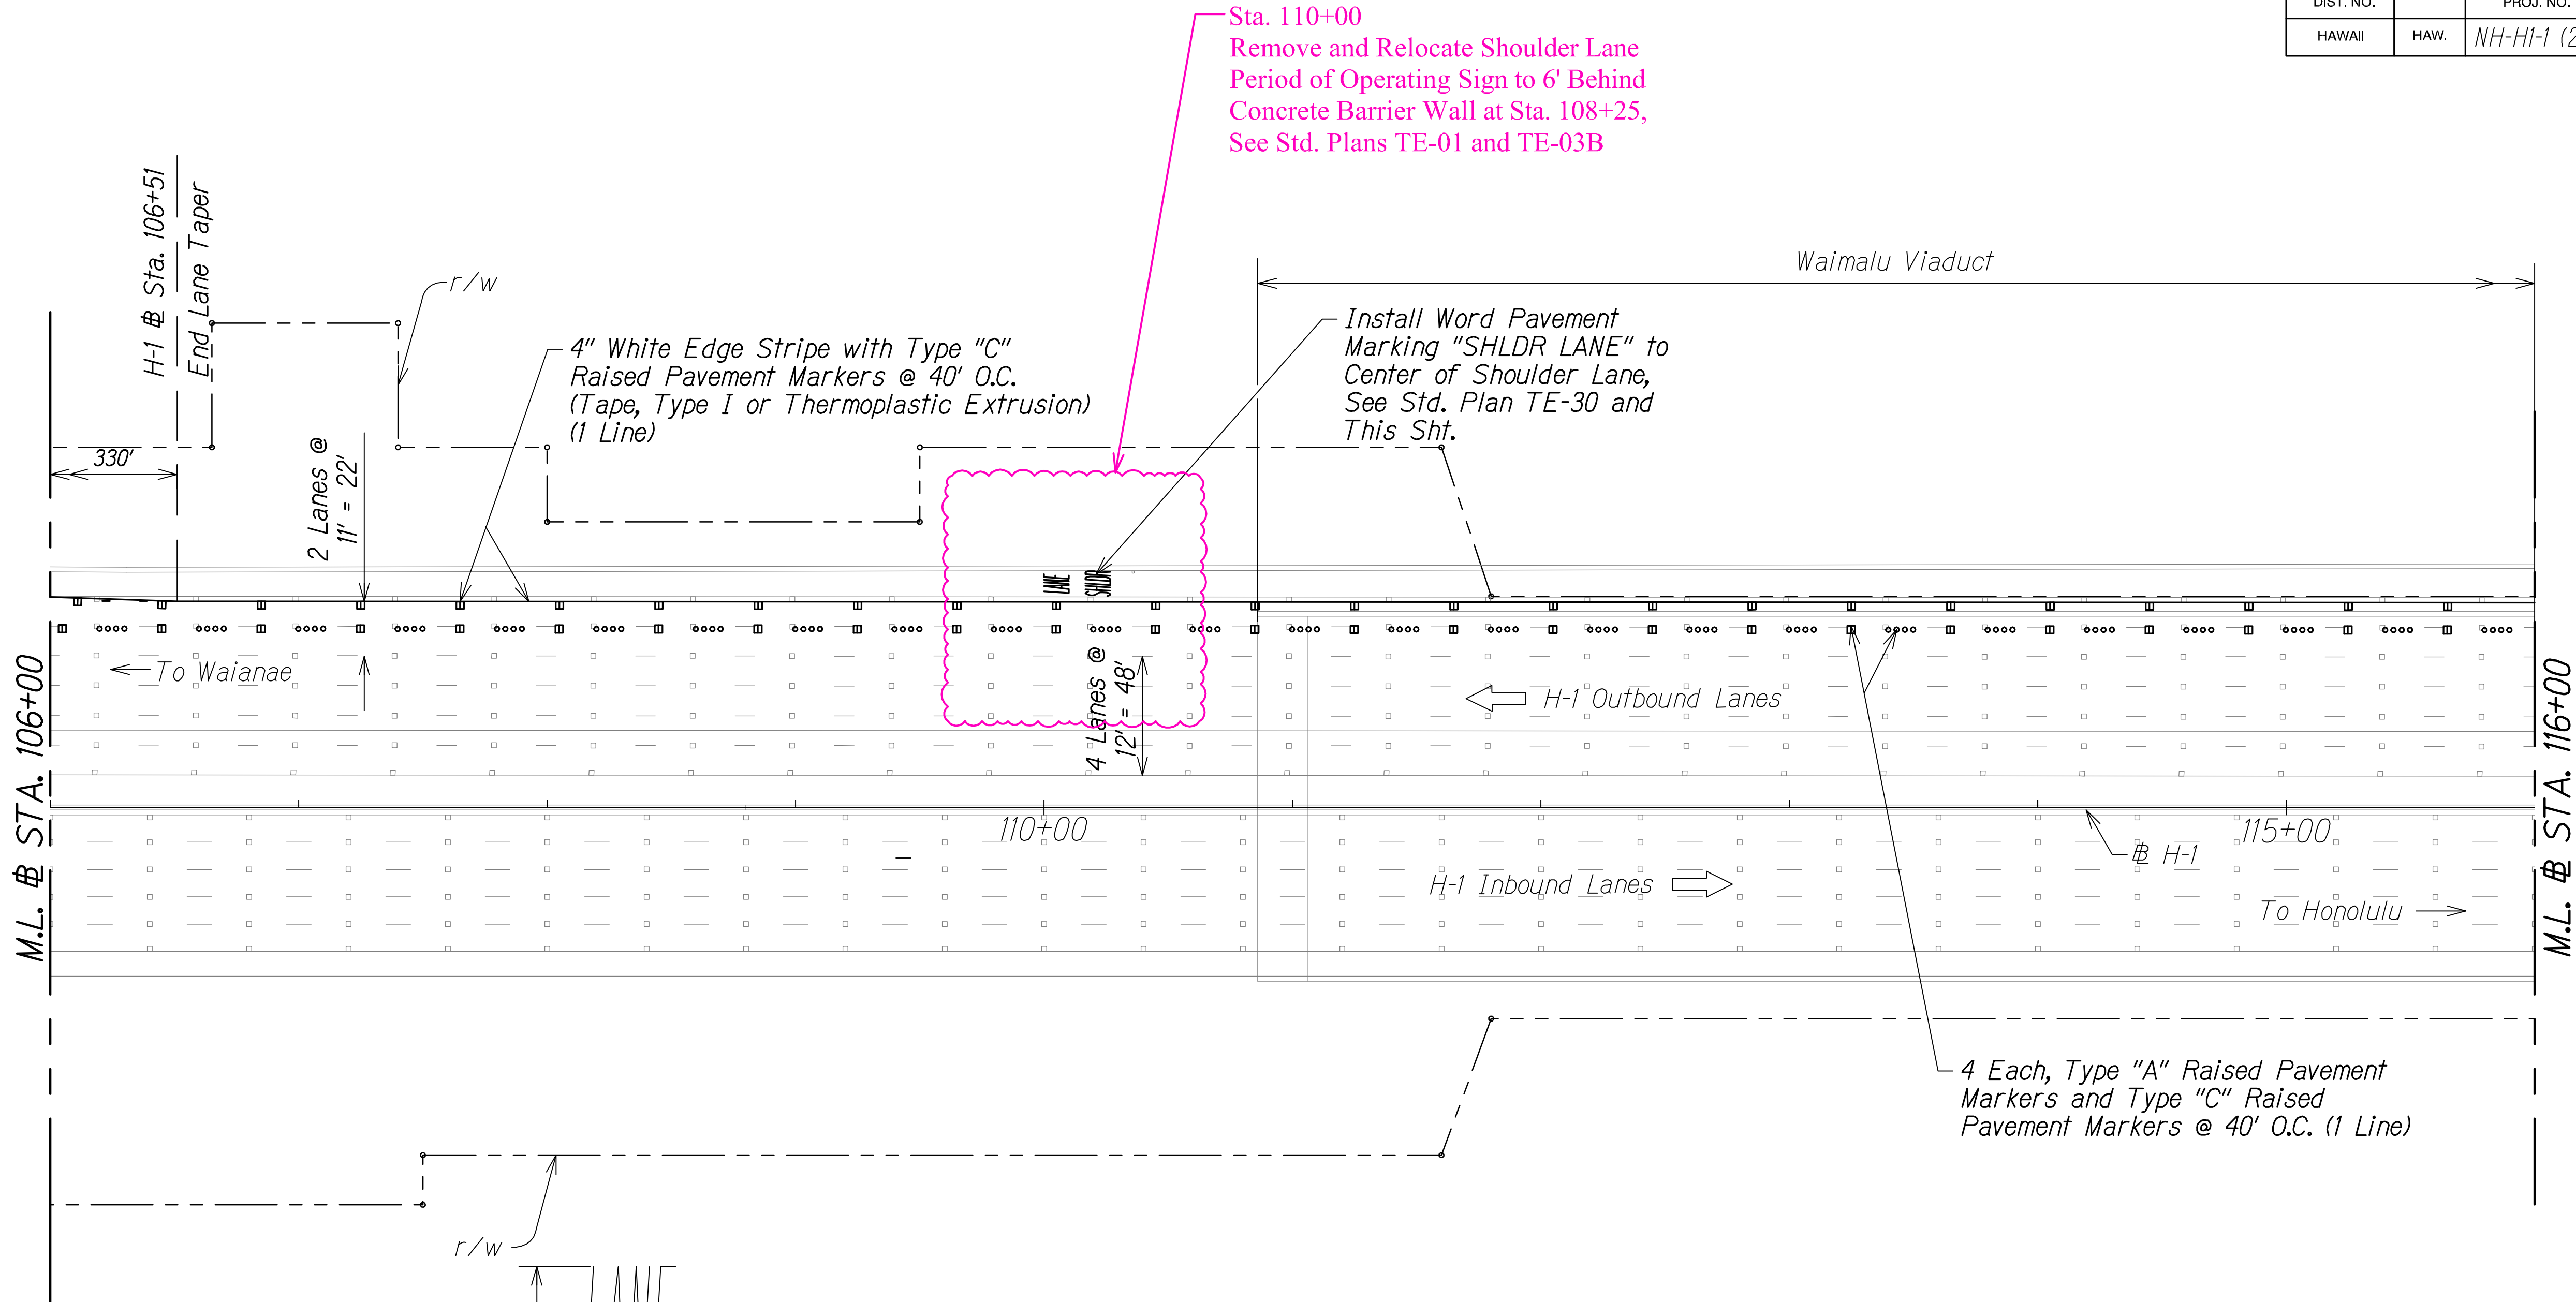

TRUE NORTH
SCALE: 1" = 40'

- Legend:**
- ▣ Type "C" Raised Pavement Marker
 - Type "A" Raised Pavement Marker

"SHOULDER LANE" WORD PAVEMENT MARKING DETAIL
Not to Scale



PAVEMENT MARKING AND STRIPING PLAN
STA. 106+00 TO # STA. 116+00
Scale: 1" = 40'

LEGEND FOR AS-BUILT POSTINGS

Squiggly line for as-built deletion

Double line for as-built deletion

Roadway Text for as-built posting

STATE OF HAWAII
DEPARTMENT OF TRANSPORTATION
HIGHWAYS DIVISION

PAVEMENT MARKING AND STRIPING PLAN

INTERSTATE ROUTE H-1
PM CONTRAFLOW LANE, PHASE 1 # 2
FEDERAL AID PROJECT NO. NH-HI-1 (260)
Scale: 1" = 40' Date: July, 2016

SHEET No. PM-19 OF 27 SHEETS



THIS WORK WAS PREPARED BY ME OR UNDER MY SUPERVISION.

Matthew K. Fujitaka
APRIL 30, 2018
WILSON OKAMOTO CORPORATION LIC. EXP. DATE

QC/QA REVIEW 100% DATE: MARCH 23, 2016

DESIGNED BY: *Benji J. Joffe*

CHECKED BY: *Benji J. Joffe*

DATE: *3/23/16*

ORIGINAL PLAN

NOTED BY: _____

DATE: _____


DESIGNED BY: _____

DATE: _____

CHECKED BY: _____

DATE: _____

| FED. ROAD DIST. NO. | STATE | FED. AID PROJ. NO. | FISCAL YEAR | SHEET NO. | TOTAL SHEETS |
|---------------------|-------|--------------------|-------------|-----------|--------------|
| HAWAII | HAW. | NH-HI-1 (260) | 2014 | 135 | 605 |

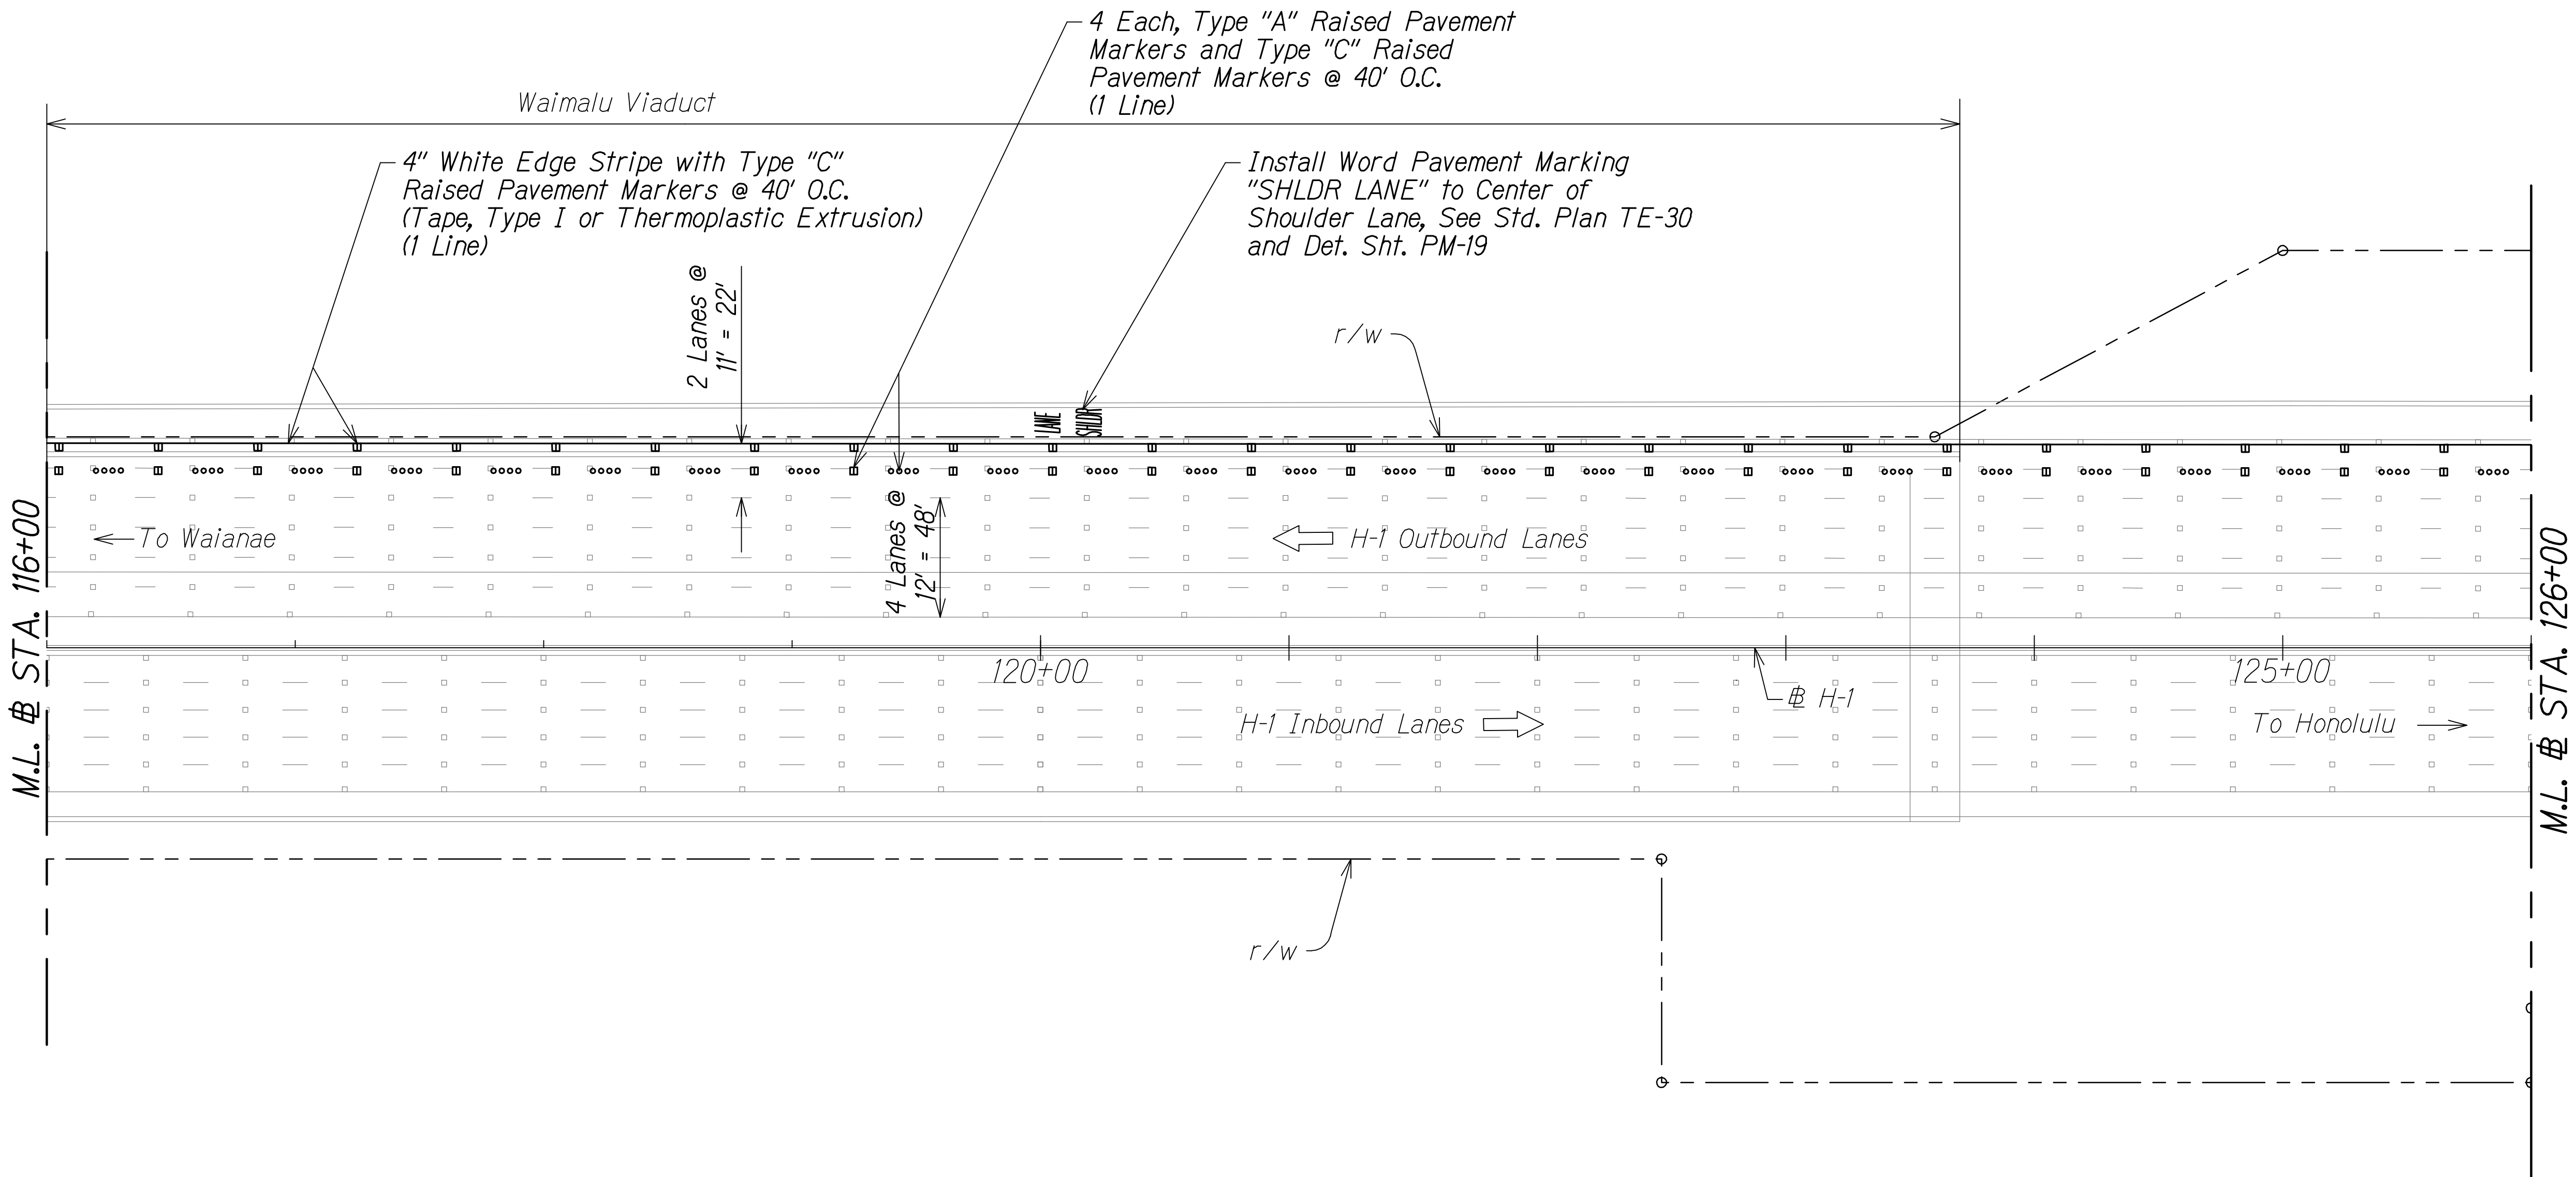

TRUE NORTH
SCALE: 1" = 40'


| | | | |
|--------------|------|------|----------------|
| QC/QA REVIEW | 100% | DATE | MARCH 23, 2014 |
| BY | | | |
| BY | | | |
| BY | | | |

| | |
|-------------------|------|
| SURVEY PLOTTED BY | DATE |
| DESIGNED BY | |
| QUANTITIES BY | |
| CHECKED BY | |

| | |
|---------------|-----|
| ORIGINAL PLAN | NO. |
| NOTE BOOK | |

Legend:

- Type "C" Raised Pavement Marker
- Type "A" Raised Pavement Marker

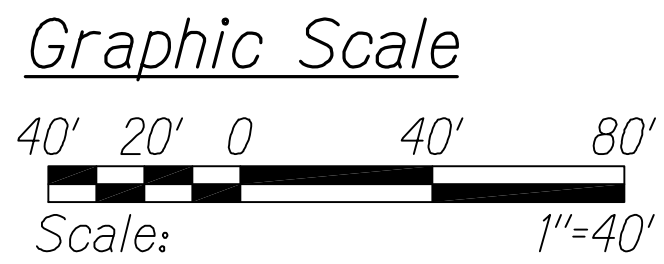

PAVEMENT MARKING AND STRIPING PLAN
STA. 116+00 TO # STA. 126+00
Scale: 1" = 40'

LEGEND FOR AS-BUILT POSTINGS

Squiggly line for as-built deletion

Double line for as-built deletion

Roadway Text for as-built posting



THIS WORK WAS PREPARED BY ME OR UNDER MY SUPERVISION.
Matthew K. Fujitaka
WILSON OKAMOTO CORPORATION APRIL 30, 2018 LIC. EXP. DATE


STATE OF HAWAII
DEPARTMENT OF TRANSPORTATION
HIGHWAYS DIVISION

PAVEMENT MARKING AND STRIPING PLAN

INTERSTATE ROUTE H-1
PM CONTRAFLOW LANE, PHASE 1 # 2
FEDERAL AID PROJECT NO. NH-HI-1 (260)
Scale: 1" = 40' Date: July, 2016

SHEET No. PM-20 OF 27 SHEETS

| FED. ROAD DIST. NO. | STATE | FED. AID PROJ. NO. | FISCAL YEAR | SHEET NO. | TOTAL SHEETS |
|---------------------|-------|--------------------|-------------|-----------|--------------|
| HAWAII | HAW. | NH-HI-1 (260) | 2014 | 136 | 605 |

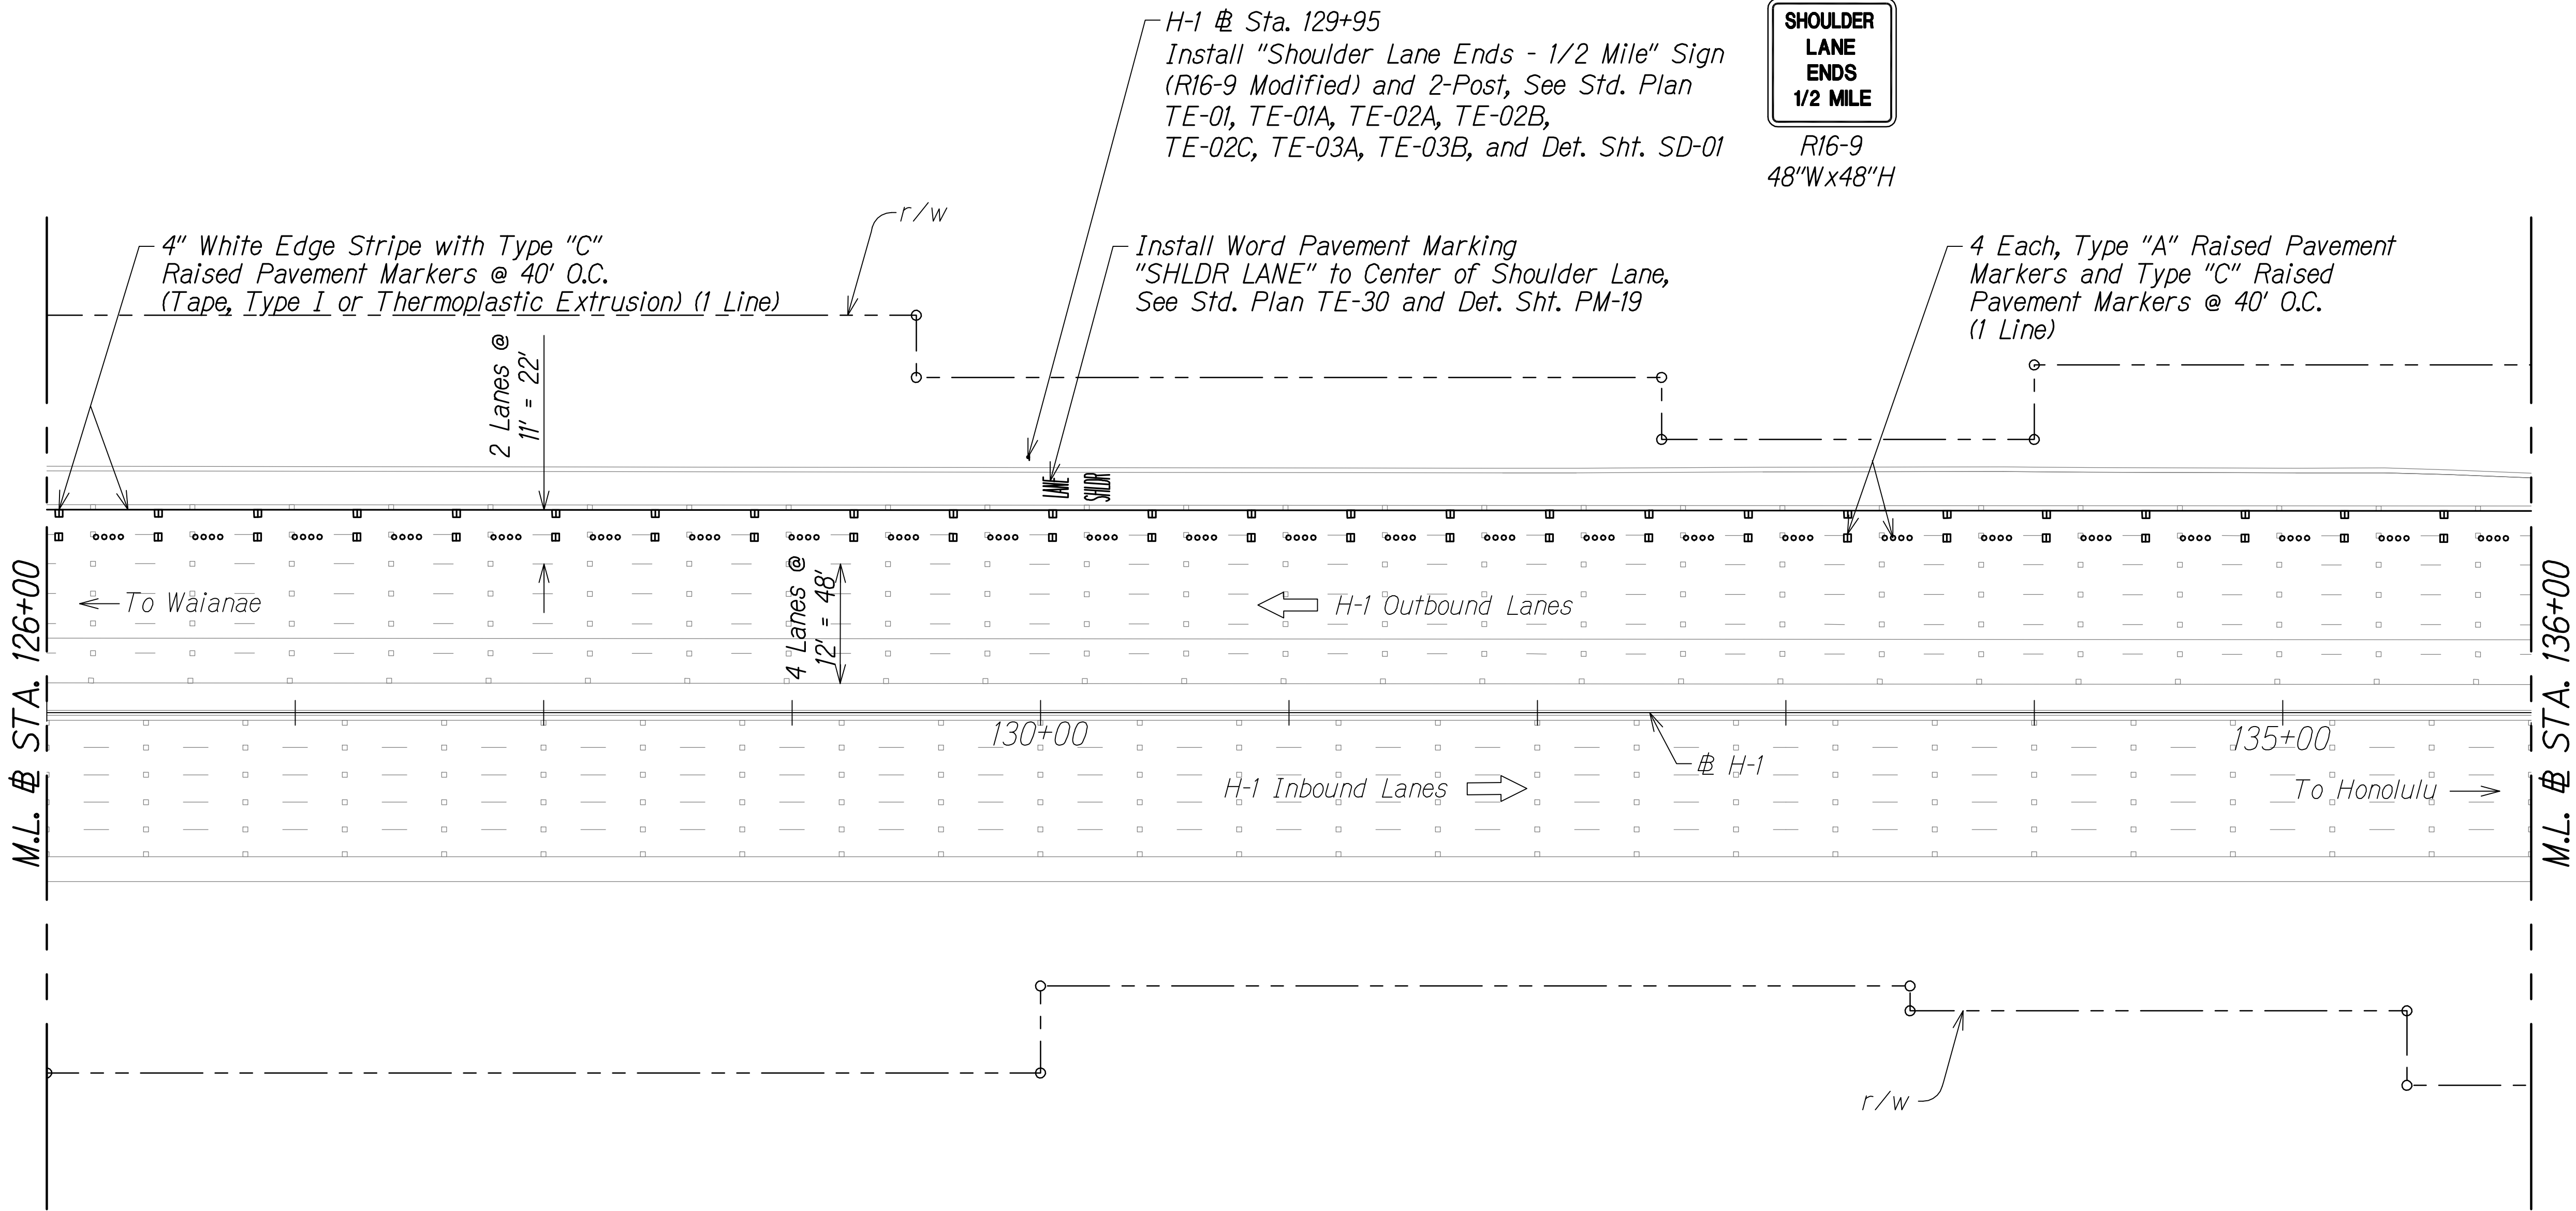


TRUE NORTH
SCALE: 1" = 40'

| | | | |
|--------------|------|------|----------------|
| QC/QA REVIEW | 100% | DATE | MARCH 23, 2014 |
| BY | | | |
| BY | | | |
| BY | | | |
| BY | | | |

| | |
|-------------------|------|
| SURVEY PLOTTED BY | DATE |
| DESIGNED BY | |
| DESIGNED BY | |
| QUANTITIES BY | |
| CHECKED BY | |

| | |
|---------------|-----|
| ORIGINAL PLAN | No. |
| NOTE BOOK | |

- Legend:
- ▣ Type "C" Raised Pavement Marker
 - Type "A" Raised Pavement Marker

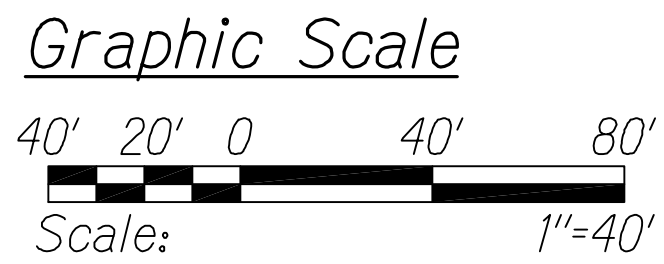

PAVEMENT MARKING AND STRIPING PLAN
@ STA. 126+00 TO @ STA. 136+00
Scale: 1" = 40'

LEGEND FOR AS-BUILT POSTINGS

- Squiggly line for as-built deletion
- Double line for as-built deletion
- Roadway Text for as-built posting



THIS WORK WAS PREPARED BY ME OR UNDER MY SUPERVISION.
Matthew K. Fujitaka
WILSON OKAMOTO CORPORATION APRIL 30, 2016 LIC. EXP. DATE

STATE OF HAWAII
DEPARTMENT OF TRANSPORTATION
HIGHWAYS DIVISION
PAVEMENT MARKING AND STRIPING PLAN

INTERSTATE ROUTE H-1
PM CONTRAFLOW LANE, PHASE 1 @ 2
FEDERAL AID PROJECT NO. NH-HI-1 (260)
Scale: 1" = 40' Date: July, 2016
SHEET No. PM-21 OF 27 SHEETS

| FED. ROAD DIST. NO. | STATE | FED. AID PROJ. NO. | FISCAL YEAR | SHEET NO. | TOTAL SHEETS |
|---------------------|-------|--------------------|-------------|-----------|--------------|
| HAWAII | HAW. | NH-HI-1 (260) | 2014 | 137 | 605 |

SHOULDER LANE
3PM - 7PM
EXC SAT SUN HOL
NO TRUCKS OR BUSES

R16-10
48"Wx54"H
H-1 @ Sta. 137+50
Install "Shoulder Lane Period of Operation" Sign (R16-10) and 2-Post, See Std. Plan TE-01, TE-01A, TE-02A, TE-02B, TE-02C, TE-03A, TE-03B, and Det. Sht. SD-01

4" White Edge Stripe with Type "C" Raised Pavement Markers @ 40' O.C. (Tape, Type I or Thermoplastic Extrusion) (1 Line)

Install Word Pavement Marking "SHLDR LANE" to Center of Shoulder Lane, See Std. Plan TE-30 and Det. Sht. PM-19

4 Each, Type "A" Raised Pavement Markers and Type "C" Raised Pavement Markers @ 40' O.C. (1 Line)

2 Lanes @ 11' = 22'

4 Lanes @ 12' = 48'

M.L. @ STA. 136+00

M.L. @ STA. 146+00

← To Wāianae

← H-1 Outbound Lanes

H-1 Inbound Lanes →

@ H-1


→ To Honolulu

Kaonohi Street Overpass

r/w

TRUE NORTH
SCALE: 1" = 40'

Legend:
■ Type "C" Raised Pavement Marker
.... Type "A" Raised Pavement Marker

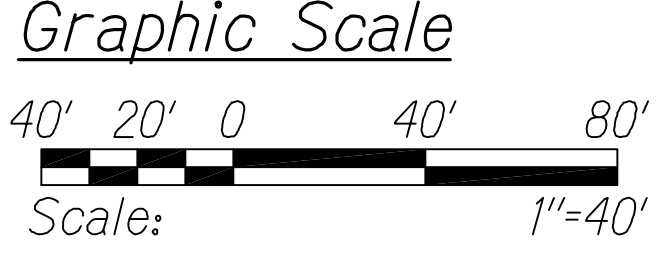

PAVEMENT MARKING AND STRIPING PLAN
@ STA. 136+00 TO @ STA. 146+00


Scale: 1" = 40'

LEGEND FOR AS-BUILT POSTINGS

~~~~~ Squiggly line for as-built deletion

==00.00== Double line for as-built deletion

Roadway Text for as-built posting

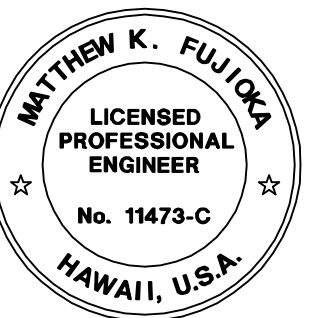

THIS WORK WAS PREPARED BY ME OR UNDER MY SUPERVISION.  
*Matthew K. Fujitaka*  
WILSON OKAMOTO CORPORATION APRIL 30, 2016 LIC. EXP. DATE


STATE OF HAWAII  
DEPARTMENT OF TRANSPORTATION  
HIGHWAYS DIVISION  
**PAVEMENT MARKING AND STRIPING PLAN**

INTERSTATE ROUTE H-1  
PM CONTRAFLOW LANE, PHASE 1 @ 2  
FEDERAL AID PROJECT NO. NH-HI-1 (260)  
Scale: 1" = 40' Date: July, 2016

SHEET No. PM-22 OF 27 SHEETS



| FED. ROAD DIST. NO. | STATE | FED. AID PROJ. NO. | FISCAL YEAR | SHEET NO. | TOTAL SHEETS |
|---------------------|-------|--------------------|-------------|-----------|--------------|
| HAWAII              | HAW.  | NH-HI-1 (260)      | 2014        | 138       | 605          |

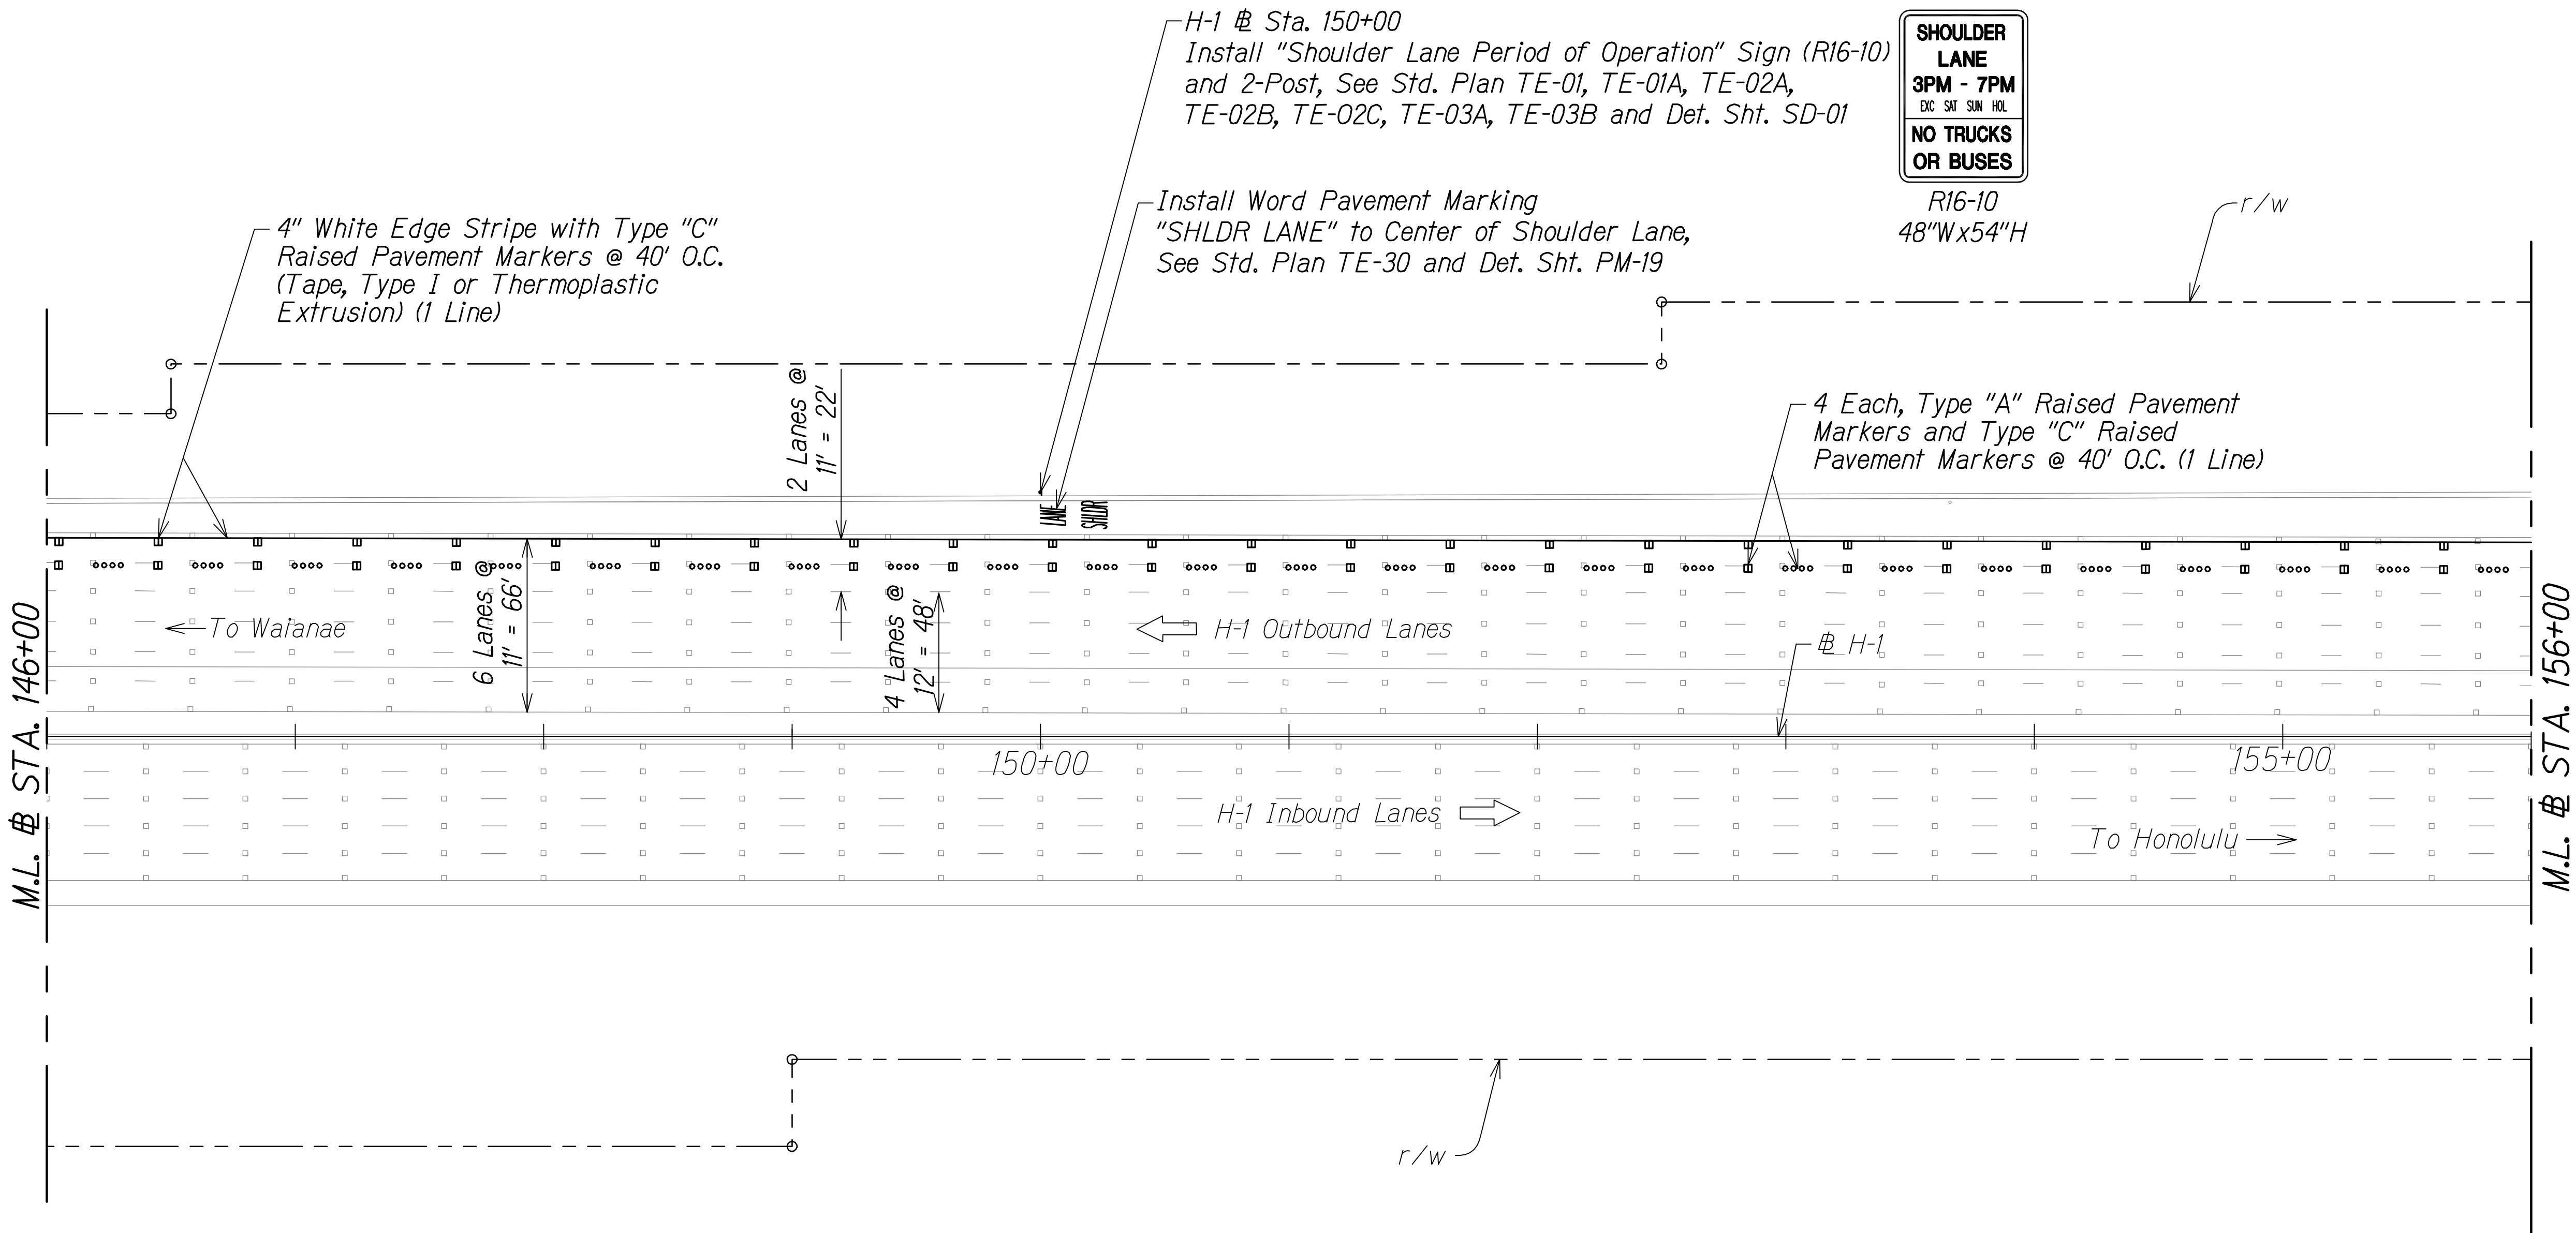


SHOULDER  
LANE  
3PM - 7PM  
EXC SAT SUN HOL  
NO TRUCKS  
OR BUSES

R16-10  
48"Wx54"H

TRUE NORTH  
SCALE: 1" = 40'

- Legend:
- ▣ Type "C" Raised Pavement Marker
  - .... Type "A" Raised Pavement Marker

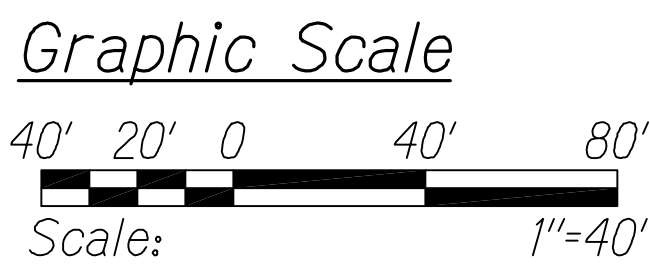

PAVEMENT MARKING AND STRIPING PLAN  
# STA. 146+00 TO # STA. 156+00


Scale: 1" = 40'

LEGEND FOR  
AS-BUILT POSTINGS

~~~~~ Squiggly line for as-built deletion

==00.00== Double line for as-built deletion

Roadway Text for as-built posting

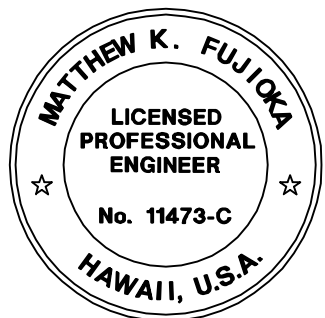

THIS WORK WAS PREPARED BY ME
OR UNDER MY SUPERVISION.

Matthew K. Fujitaka
WILSON OKAMOTO CORPORATION LIC. EXP. DATE

STATE OF HAWAII
DEPARTMENT OF TRANSPORTATION
HIGHWAYS DIVISION


PAVEMENT MARKING
AND STRIPING PLAN

INTERSTATE ROUTE H-1
PM CONTRAFLOW LANE, PHASE 1 # 2
FEDERAL AID PROJECT NO. NH-HI-1 (260)

Scale: 1" = 40' Date: July, 2016


SHEET No. PM-23 OF 27 SHEETS

| FED. ROAD DIST. NO. | STATE | FED. AID PROJ. NO. | FISCAL YEAR | SHEET NO. | TOTAL SHEETS |
|---------------------|-------|--------------------|-------------|-----------|--------------|
| HAWAII | HAW. | NH-HI-1 (260) | 2014 | 139 | 605 |

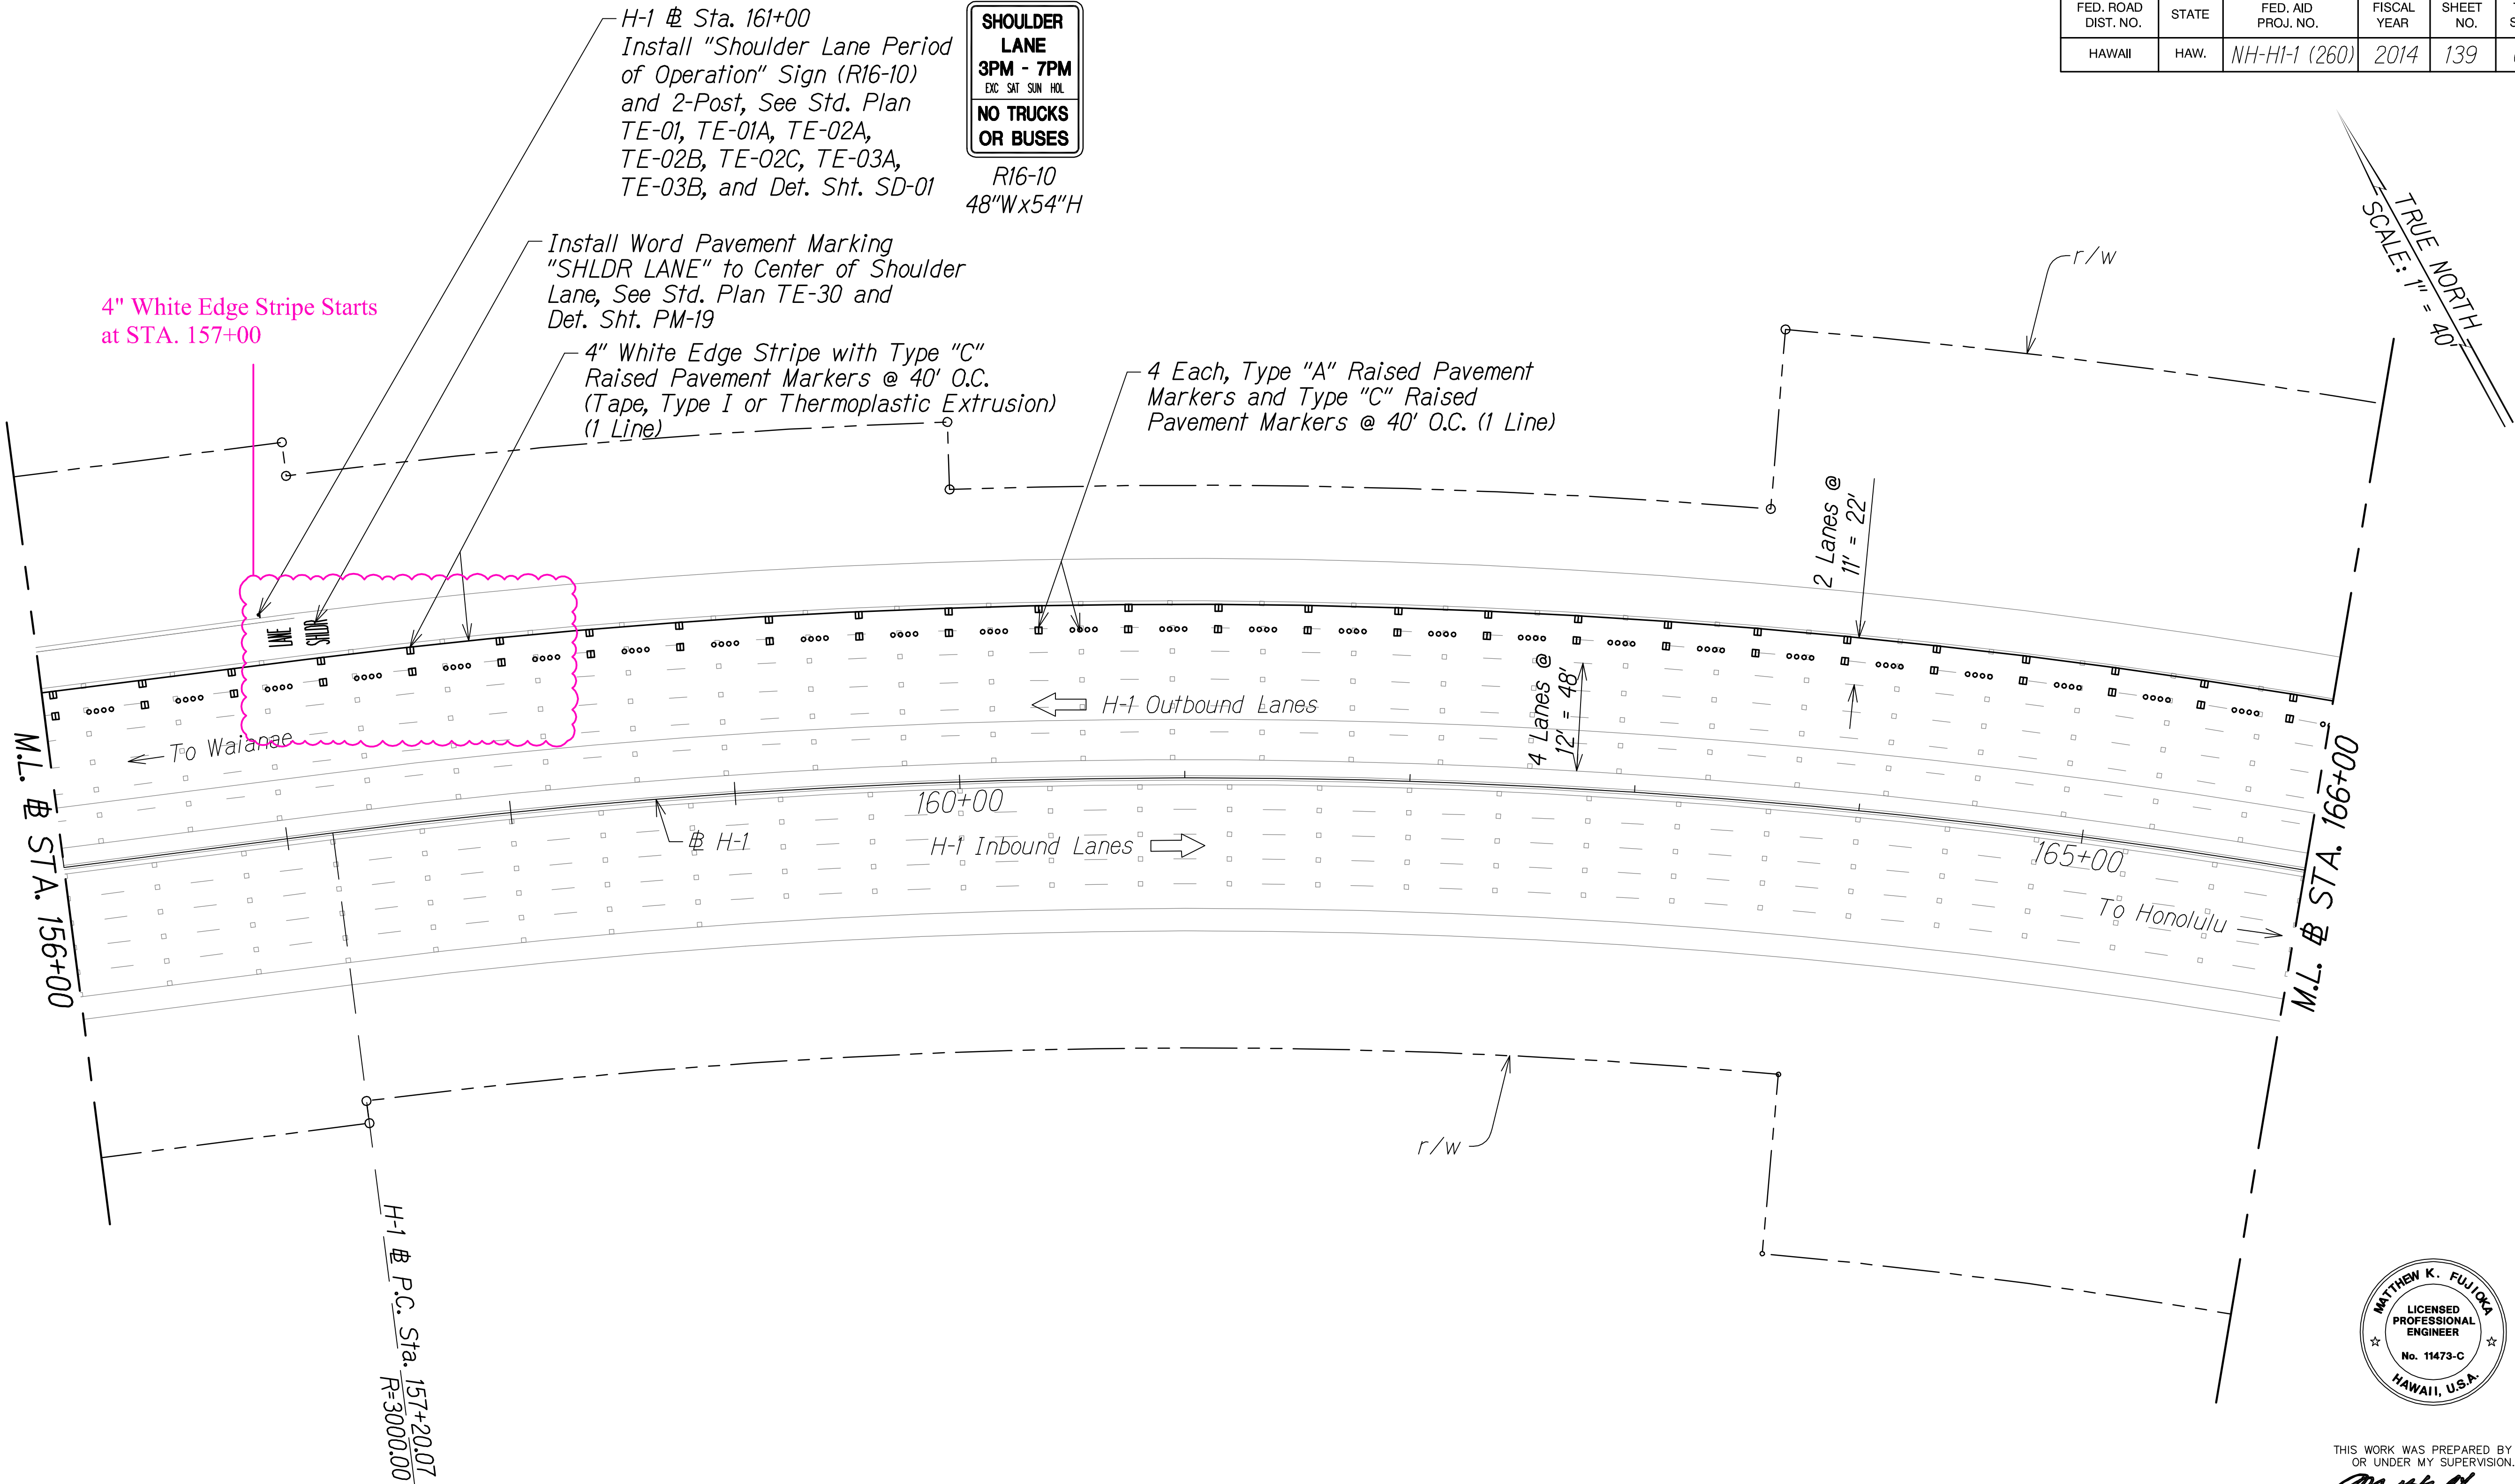

Legend:

- ▣ Type "C" Raised Pavement Marker
- Type "A" Raised Pavement Marker

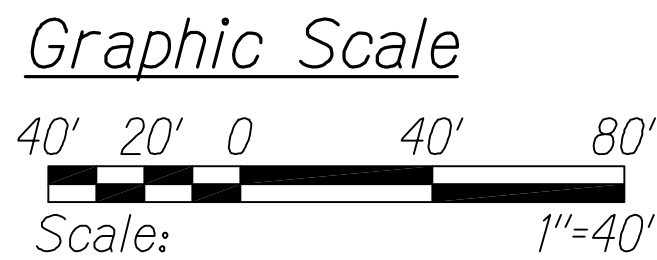

PAVEMENT MARKING AND STRIPING PLAN
STA. 156+00 TO # STA. 166+00

Scale: 1" = 40'

LEGEND FOR
AS-BUILT POSTINGS

- ~~~~ Squiggly line for as-built deletion
- == Double line for as-built deletion
- Roadway Text for as-built posting



THIS WORK WAS PREPARED BY ME
OR UNDER MY SUPERVISION.
Matthew K. Fujitaka
WILSON OKAMOTO CORPORATION LIC. EXP. DATE


STATE OF HAWAII
DEPARTMENT OF TRANSPORTATION
HIGHWAYS DIVISION
PAVEMENT MARKING
AND STRIPING PLAN

INTERSTATE ROUTE H-1
PM CONTRAFLOW LANE, PHASE 1 & 2
FEDERAL AID PROJECT NO. NH-HI-1 (260)
Scale: 1" = 40' Date: July, 2016

SHEET No. PM-24 OF 27 SHEETS


"AS-BUILT"

| FED. ROAD DIST. NO. | STATE | FED. AID PROJ. NO. | FISCAL YEAR | SHEET NO. | TOTAL SHEETS |
|---------------------|-------|--------------------|-------------|-----------|--------------|
| HAWAII | HAW. | NH-HI-1 (260) | 2014 | 140 | 605 |

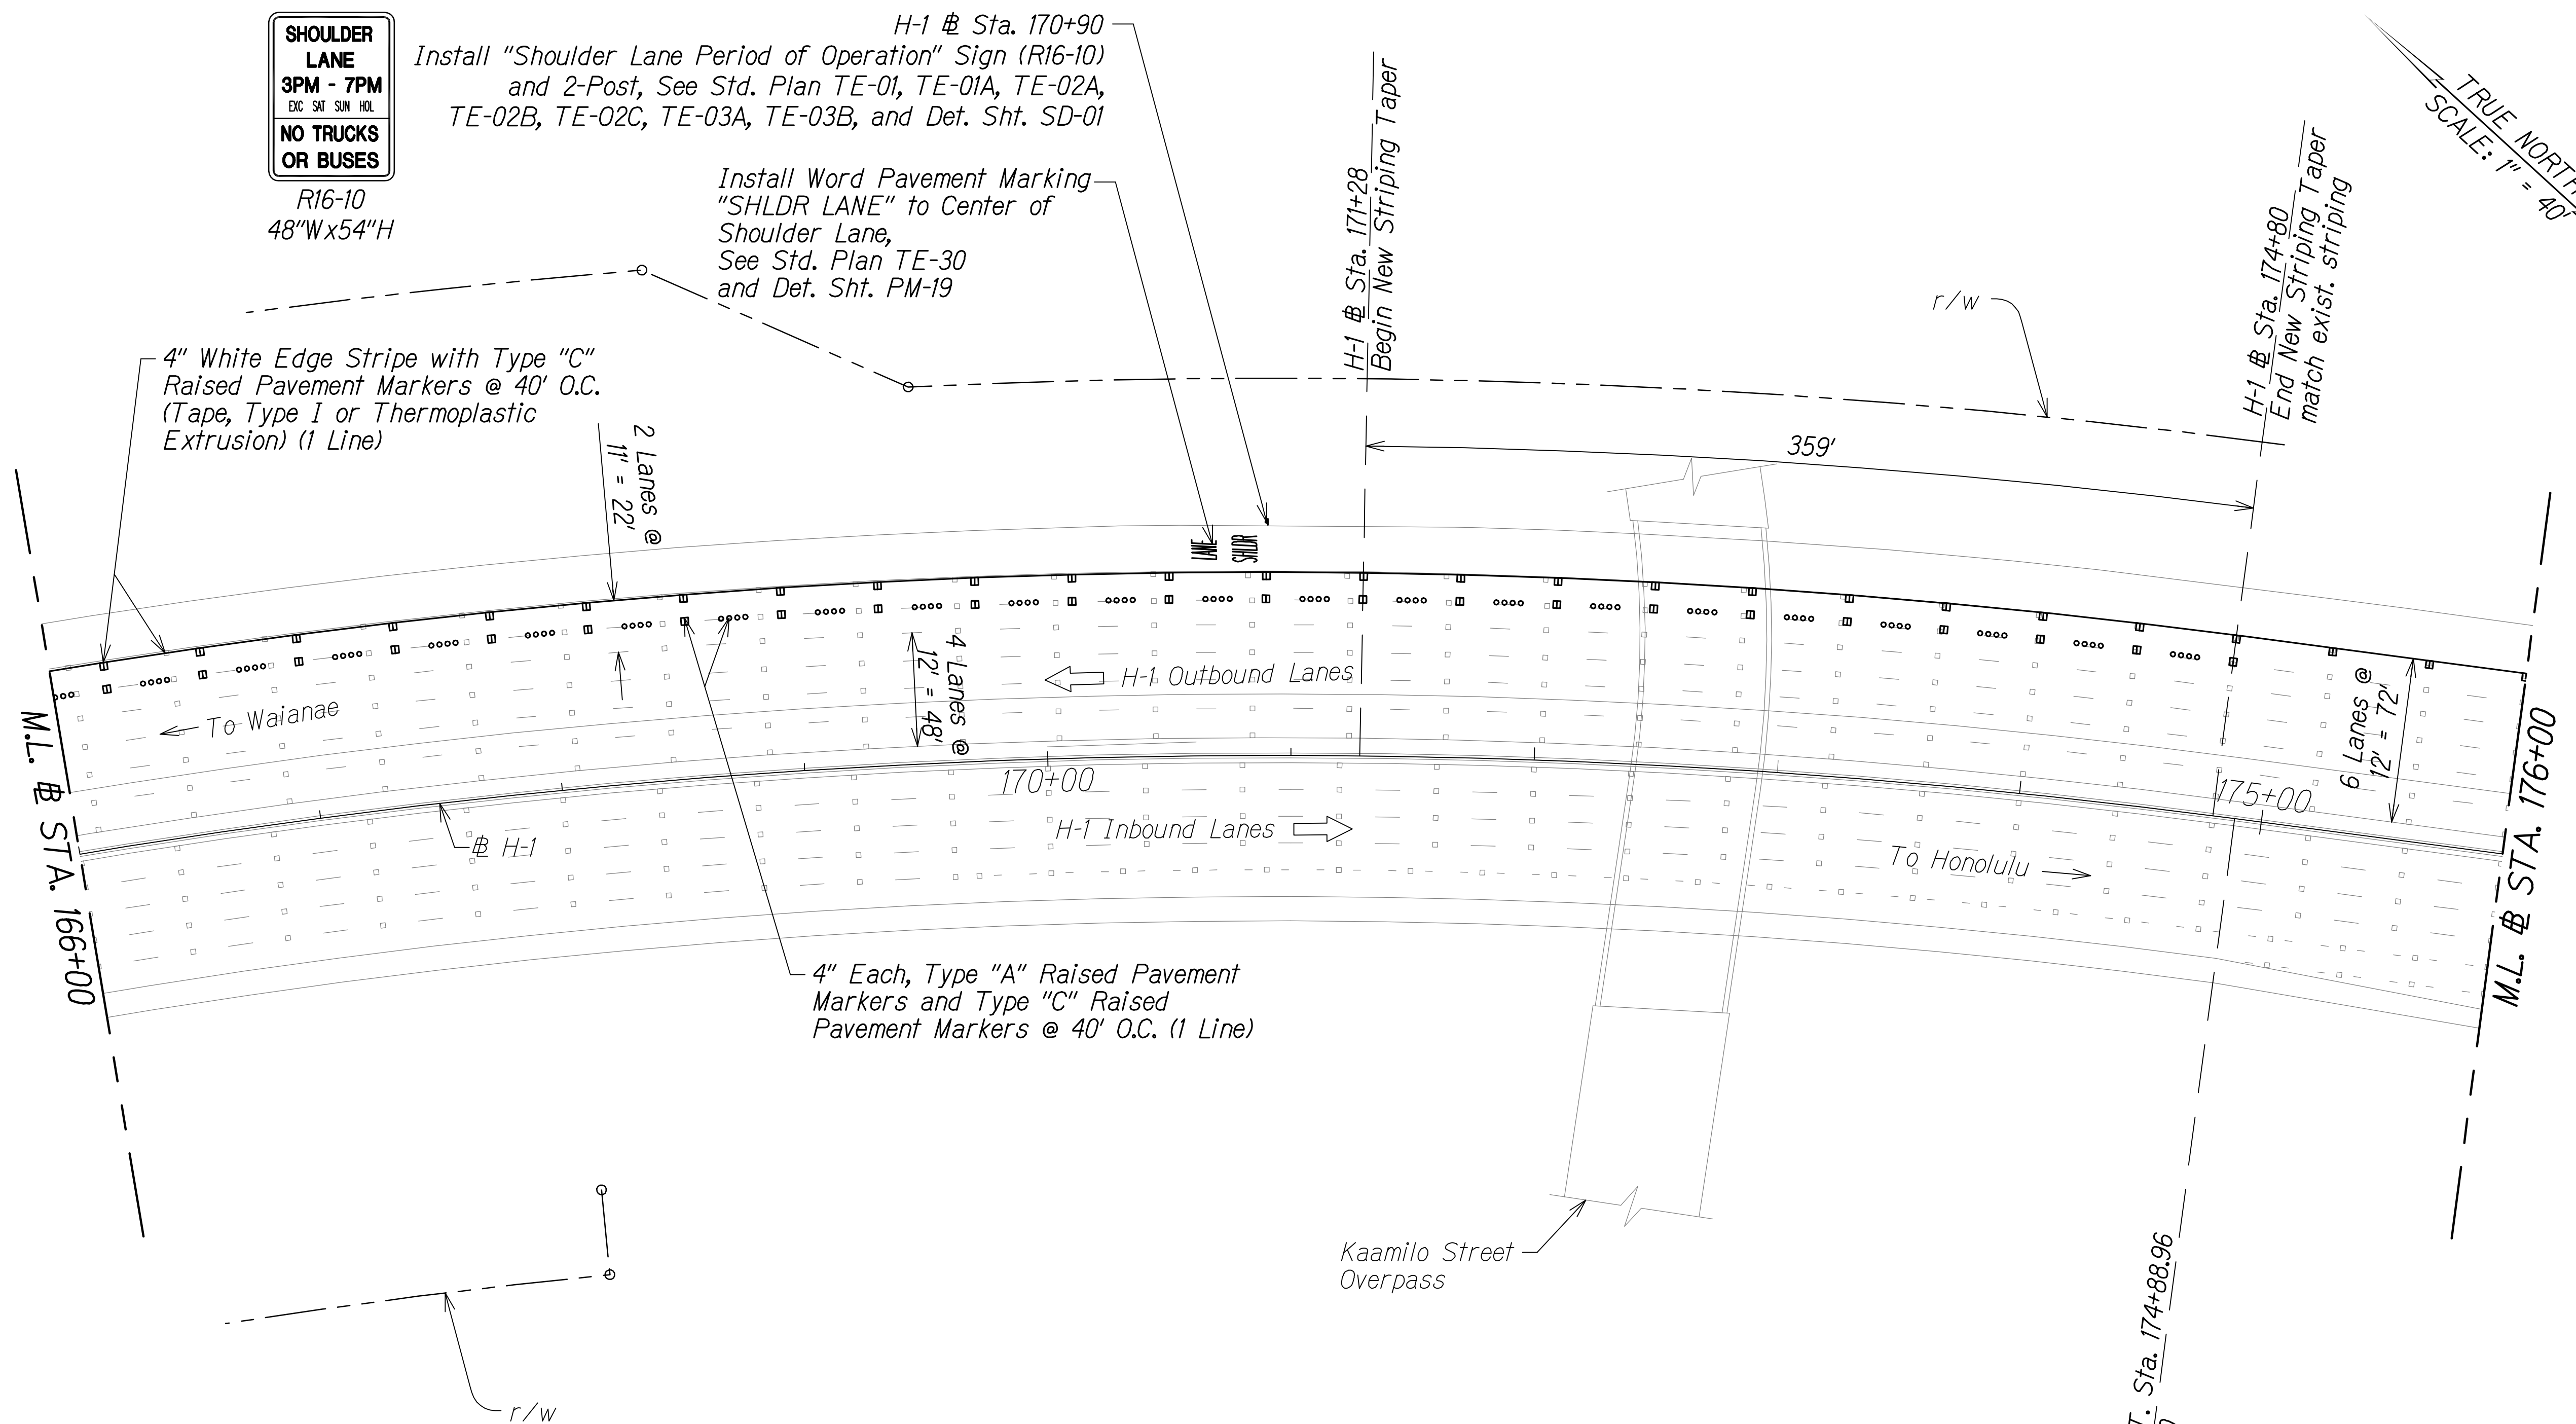

TRUE NORTH
SCALE: 1" = 40'

- Legend:**
- ▣ Type "C" Raised Pavement Marker
 - Type "A" Raised Pavement Marker

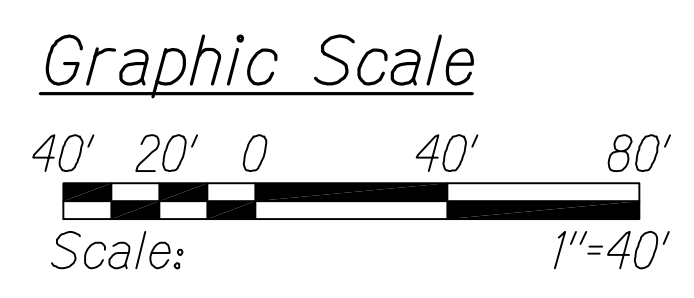

PAVEMENT MARKING AND STRIPING PLAN
STA. 166+00 TO # STA. 176+00
Scale: 1" = 40'

LEGEND FOR AS-BUILT POSTINGS

~~~~~ Squiggly line for as-built deletion

== Double line for as-built deletion

Roadway Text for as-built posting


STATE OF HAWAII  
DEPARTMENT OF TRANSPORTATION  
HIGHWAYS DIVISION

**PAVEMENT MARKING AND STRIPING PLAN**

INTERSTATE ROUTE H-1  
PM CONTRAFLOW LANE, PHASE 1 # 2  
FEDERAL AID PROJECT NO. NH-HI-1 (260)

Scale: 1" = 40' Date: July, 2016

SHEET No. PM-25 OF 27 SHEETS

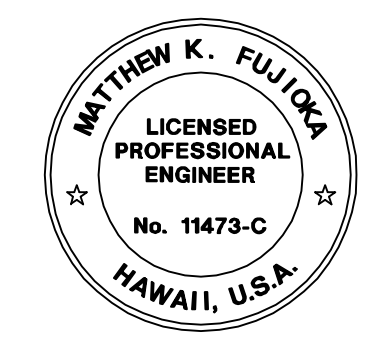

THIS WORK WAS PREPARED BY ME OR UNDER MY SUPERVISION.

*Matthew K. Fujitaka*



APRIL 30, 2018  
WILSON OKAMOTO CORPORATION LIC. EXP. DATE

|              |      |      |                |
|--------------|------|------|----------------|
| QC/QA REVIEW | 100% | DATE | MARCH 23, 2014 |
| BY           |      |      |                |
| BY           |      |      |                |
| BY           |      |      |                |
| BY           |      |      |                |

|               |      |
|---------------|------|
| ORIGINAL PLAN | DATE |
| NOTED BY      |      |
| DESIGNED BY   |      |
| QUANTITIES BY |      |
| CHECKED BY    |      |




| FED. ROAD DIST. NO. | STATE | FED. AID PROJ. NO. | FISCAL YEAR | SHEET NO. | TOTAL SHEETS |
|---------------------|-------|--------------------|-------------|-----------|--------------|
| HAWAII              | HAW.  | NH-HI-1 (260)      | 2014        | 141       | 605          |

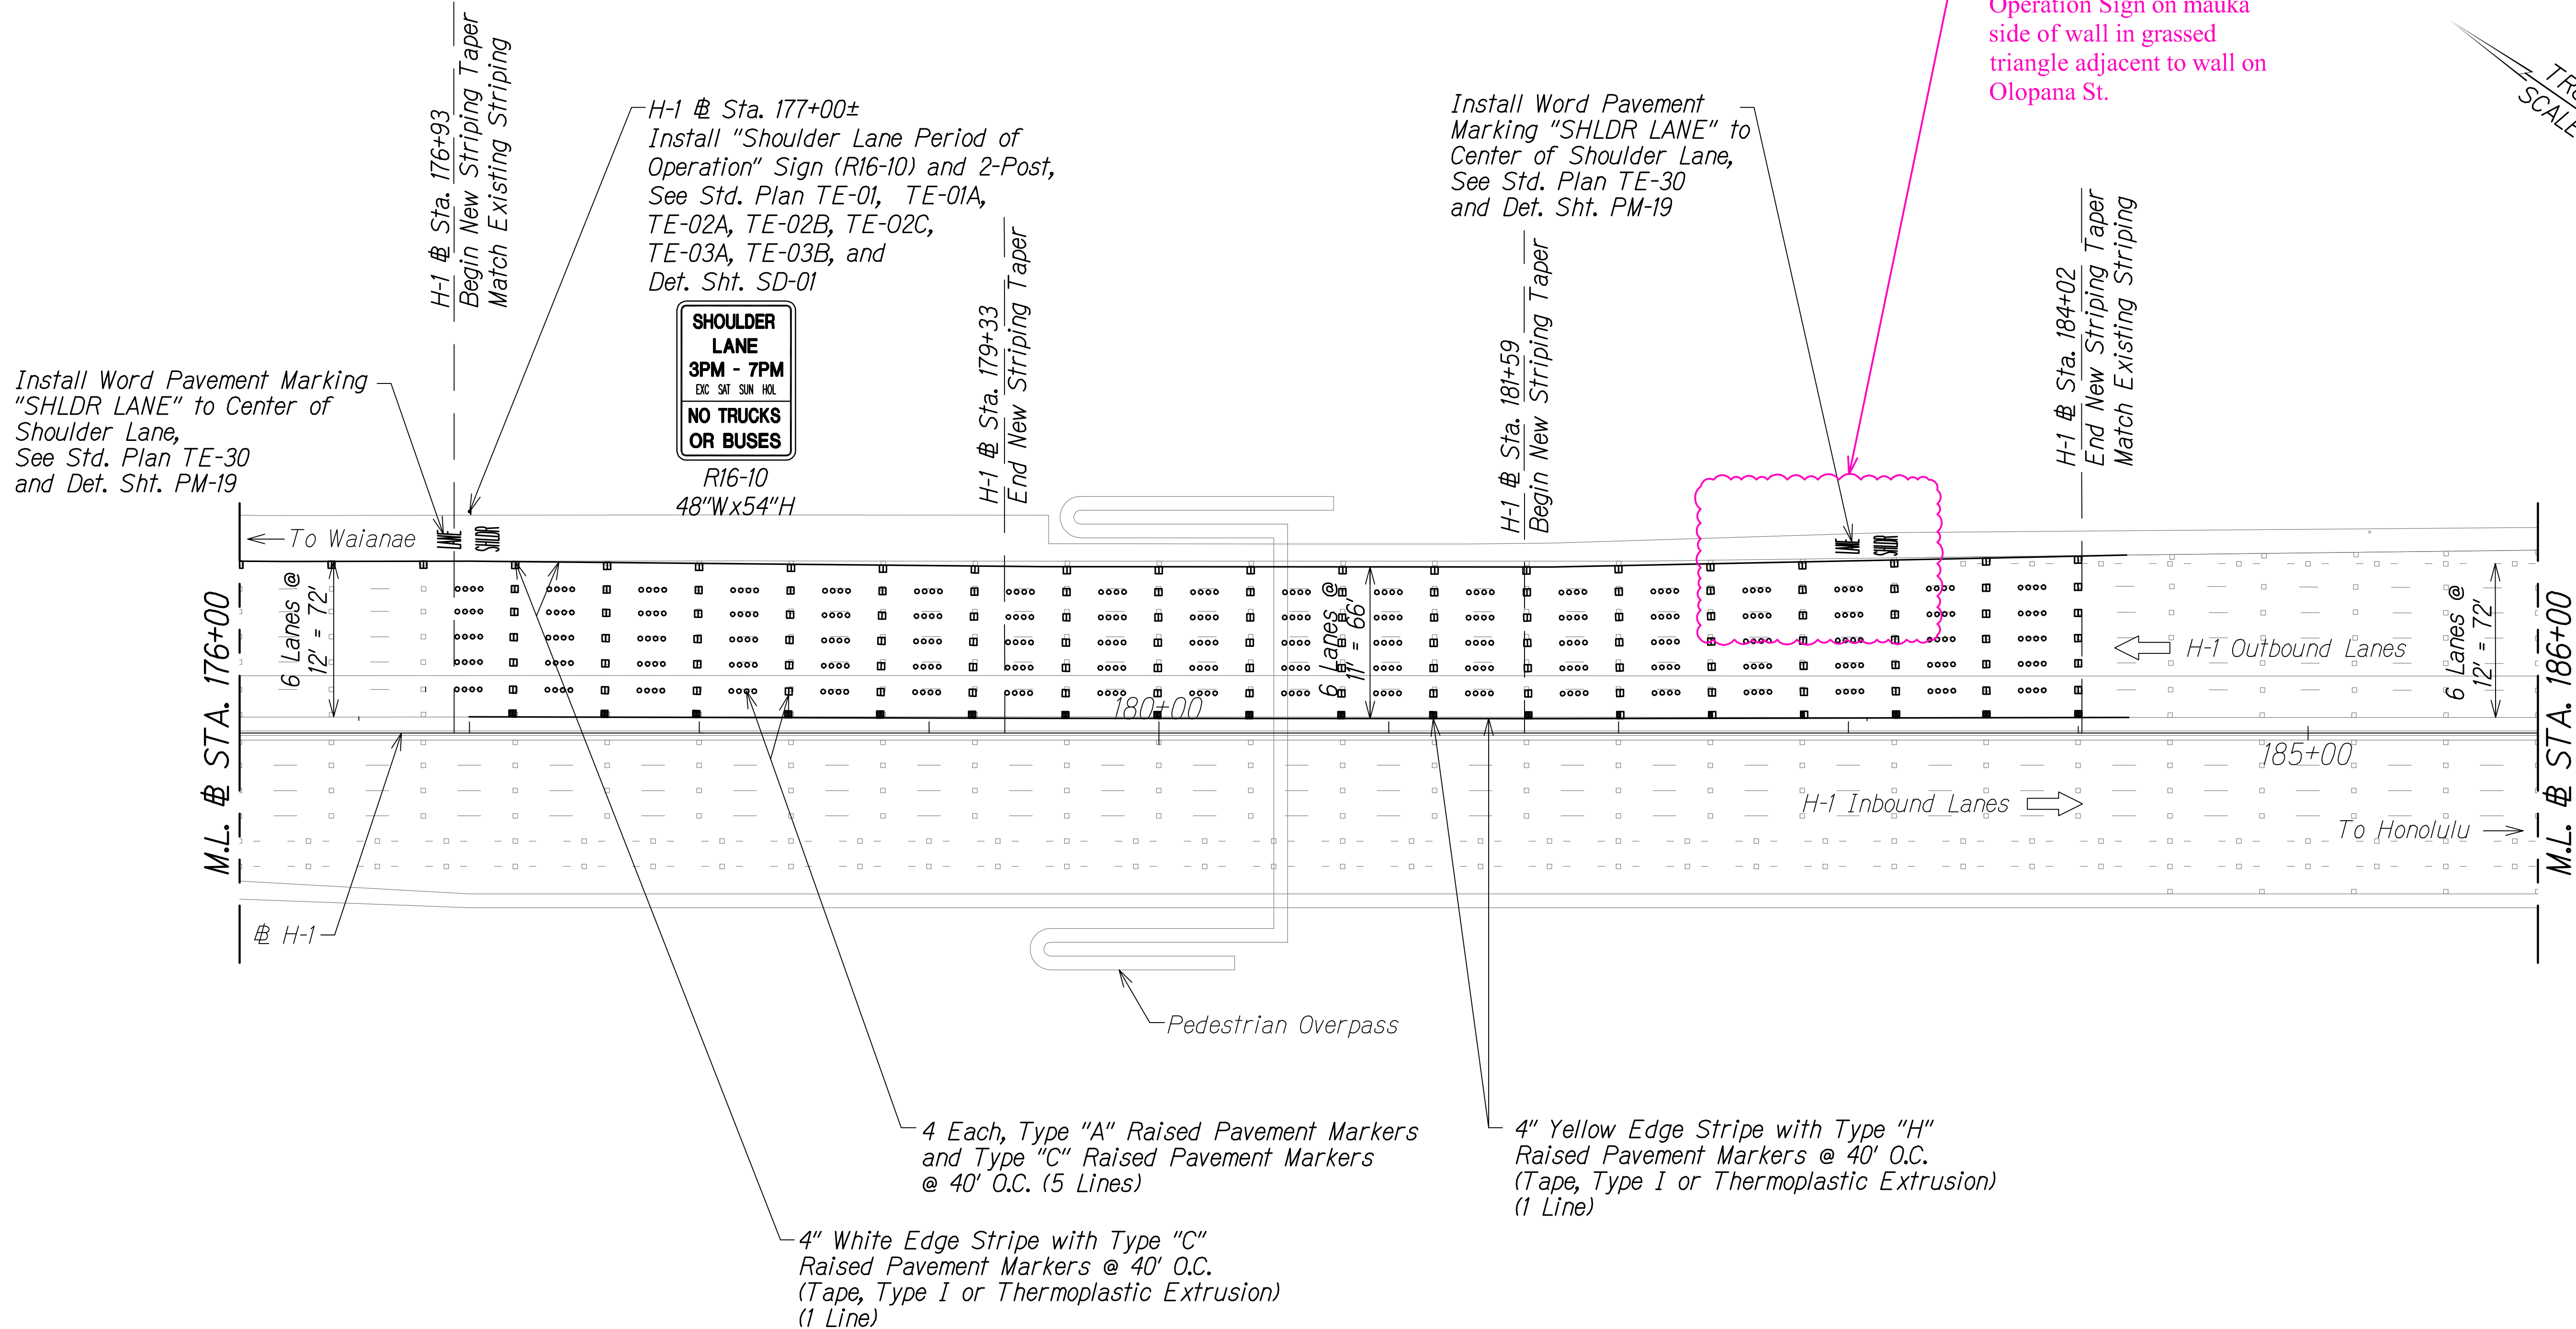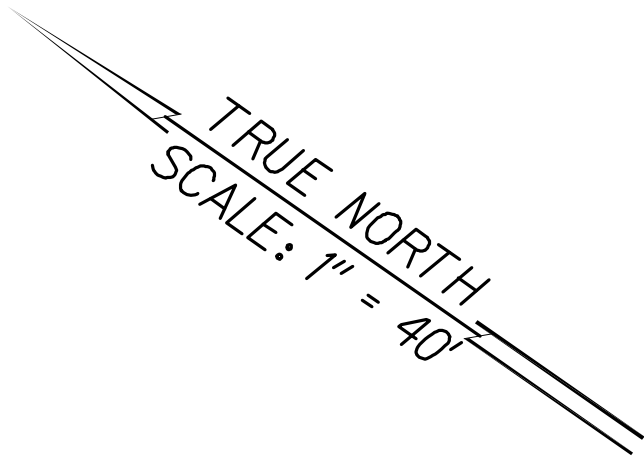

**Legend:**

- Type "C" Raised Pavement Marker
- Type "A" Raised Pavement Marker
- Type "H" Raised Pavement Marker

**Graphic Scale**

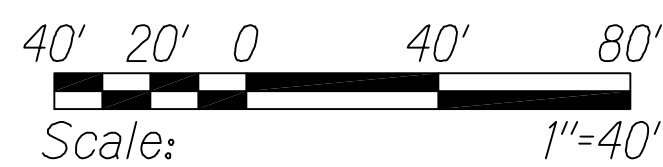


**PAVEMENT MARKING AND STRIPING PLAN**  
**± STA. 176+00 TO ± STA. 186+00**

Scale: 1" = 40'

**LEGEND FOR AS-BUILT POSTINGS**

- ~~~~ Squiggly line for as-built deletion
- == Double line for as-built deletion
- Roadway Text for as-built posting

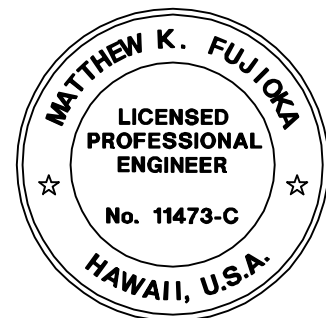

THIS WORK WAS PREPARED BY ME  
OR UNDER MY SUPERVISION.  
*Matthew K. Fujitaka*  
APRIL 30, 2016  
WILSON OKAMOTO CORPORATION LIC. EXP. DATE

STATE OF HAWAII  
DEPARTMENT OF TRANSPORTATION  
HIGHWAYS DIVISION  
**PAVEMENT MARKING AND STRIPING PLAN**

INTERSTATE ROUTE H-1  
PM CONTRAFLOW LANE, PHASE 1 & 2  
FEDERAL AID PROJECT NO. NH-HI-1 (260)  
Scale: 1" = 40' Date: July, 2016



SHEET No. PM-26 OF 27 SHEETS

"AS-BUILT"

141




| FED. ROAD DIST. NO. | STATE | FED. AID PROJ. NO. | FISCAL YEAR | SHEET NO. | TOTAL SHEETS |
|---------------------|-------|--------------------|-------------|-----------|--------------|
| HAWAII              | HAW.  | NH-HI-1 (260)      | 2014        | 142       | 605          |

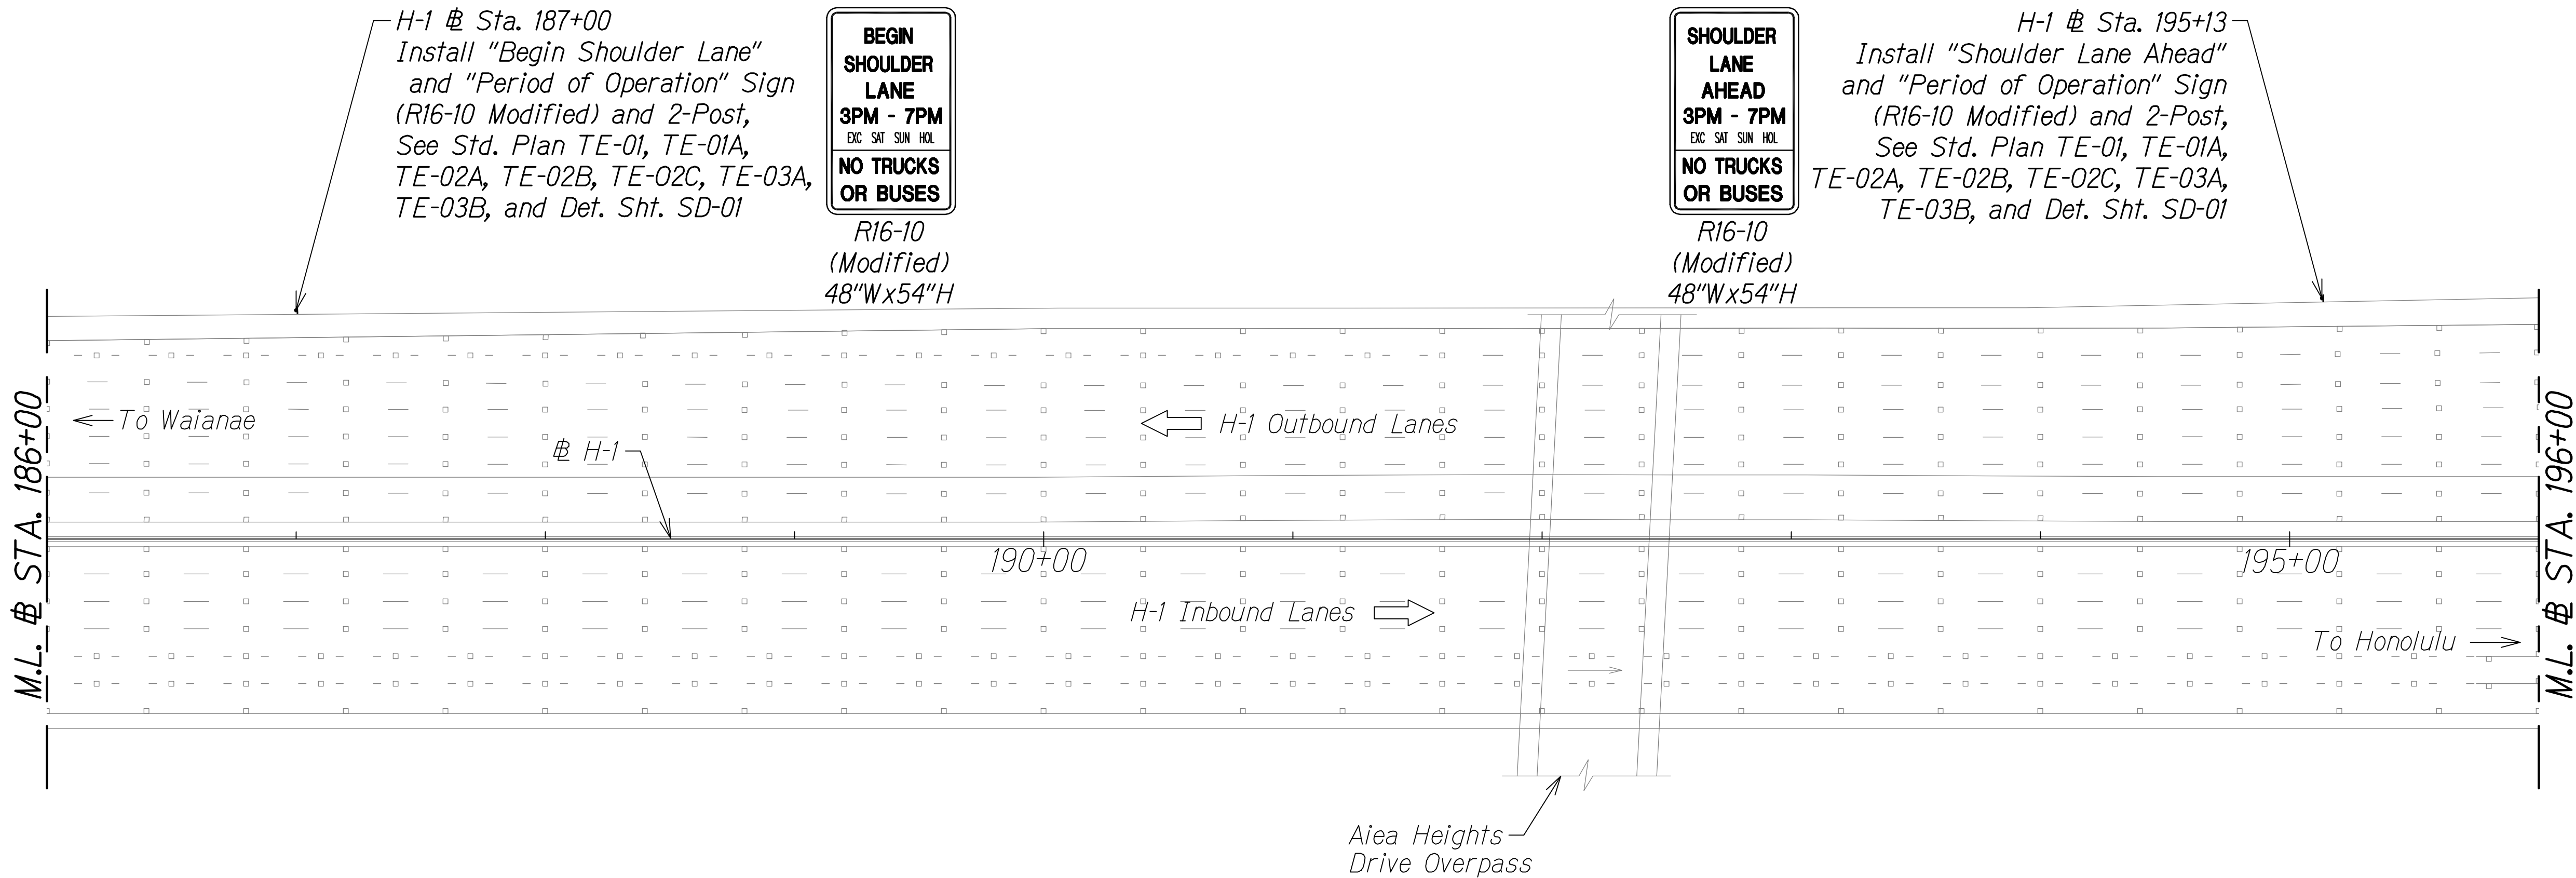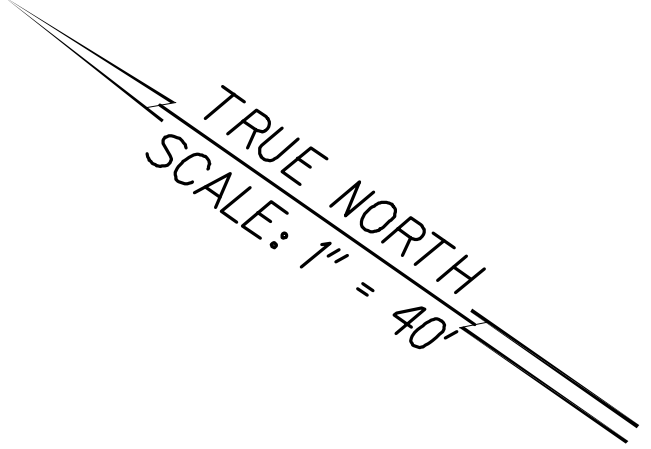

|              |      |             |                |
|--------------|------|-------------|----------------|
| QC/QA REVIEW | 100% | DATE        | MARCH 23, 2014 |
| BY           |      | DESIGNED BY |                |
| BY           |      | DESIGNED BY |                |
| BY           |      | DESIGNED BY |                |
| BY           |      | DESIGNED BY |                |

|               |      |
|---------------|------|
| ORIGINAL PLAN | DATE |
| NOTED BY      |      |
| DESIGNED BY   |      |
| QUANTITIES BY |      |
| CHECKED BY    |      |

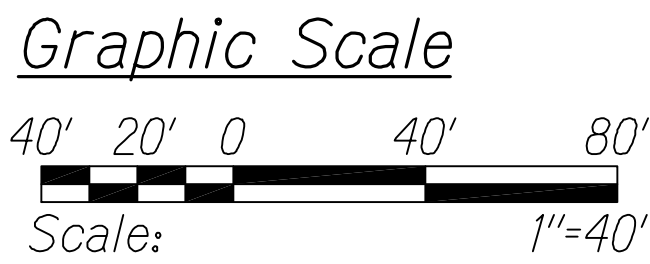

PAVEMENT MARKING AND STRIPING PLAN  
# STA. 186+00 TO # STA. 196+00  
Scale: 1" = 40'

| LEGEND FOR AS-BUILT POSTINGS |                                     |
|------------------------------|-------------------------------------|
|                              | Squiggly line for as-built deletion |
|                              | Double line for as-built deletion   |
| Roadway                      | Text for as-built posting           |



THIS WORK WAS PREPARED BY ME OR UNDER MY SUPERVISION.  
*Matthew K. Fujitaka*  
WILSON OKAMOTO CORPORATION APRIL 30, 2018 LIC. EXP. DATE

STATE OF HAWAII  
DEPARTMENT OF TRANSPORTATION  
HIGHWAYS DIVISION  
**PAVEMENT MARKING AND STRIPING PLAN**  
  
INTERSTATE ROUTE H-1  
PM CONTRAFLOW LANE, PHASE 1 & 2  
FEDERAL AID PROJECT NO. NH-HI-1 (260)  
Scale: 1" = 40' Date: July, 2016  
SHEET No. PM-27 OF 27 SHEETS