


FED. ROAD DIST. NO.	STATE	FED. AID PROJ. NO.	FISCAL YEAR	SHEET NO.	TOTAL SHEETS
HAWAII	HAW.	NH-H1-1 (260)	2014	145	605



*R16-10
(Modified)
48"Wx54"H*

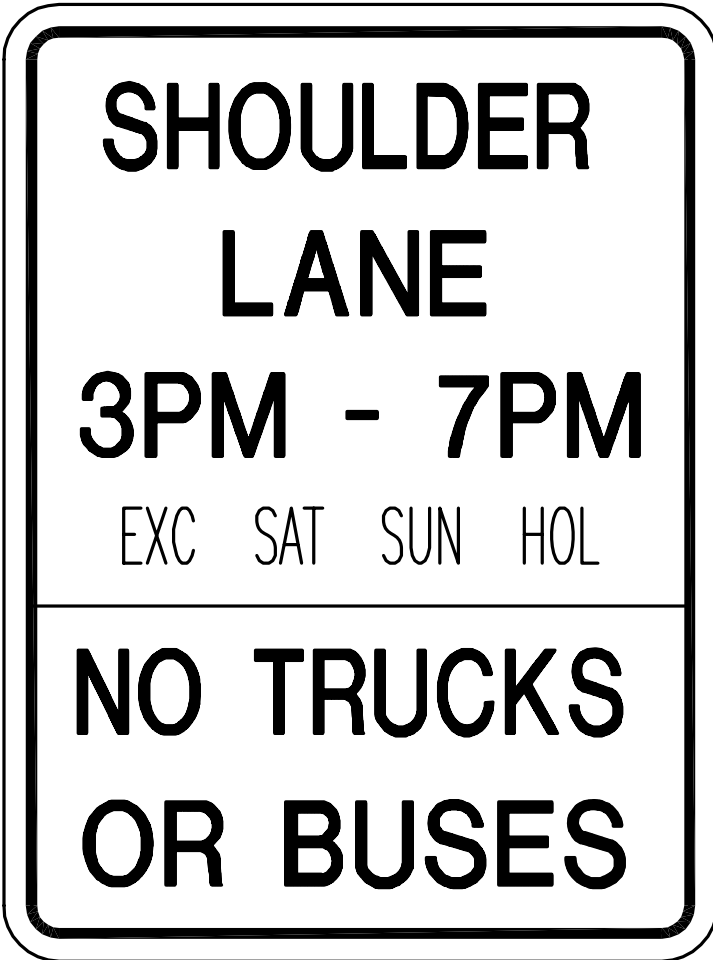

*R16-10
(Modified)
48"Wx54"H*




*R16-10
(Modified)
48"Wx54"H*



*R16-9
(Modified)
48"Wx48"H*



*R16-9
(Modified)
48"Wx48"H*

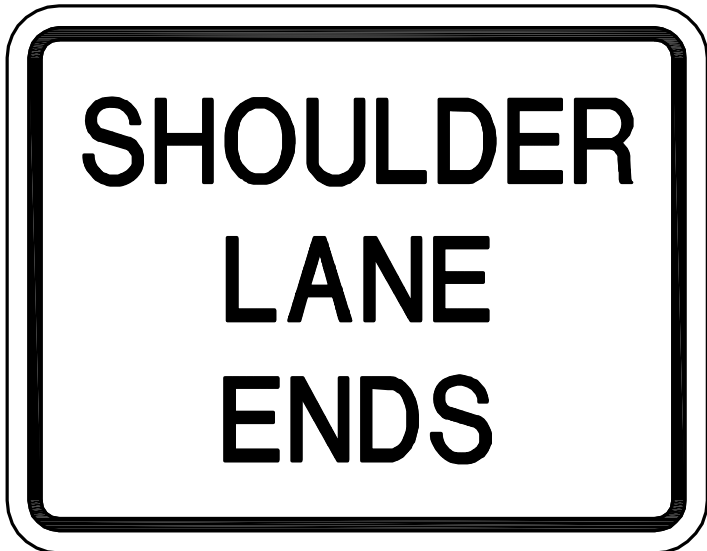

*R16-9
(Modified)
48"Wx30"H*



*R16-9
(Modified)
48"Wx48"H*



*R16-9
(Modified)
48"Wx48"H*



*R16-9
(Modified)
48"Wx30"H*

Notes:

- Contractor shall submit shop drawings of all signs to Engineer prior to fabrication.
- Colors:
Legend: Black (Non-Ref.)
Background: White (Ref.)
Border: Black

LEGEND FOR
AS-BUILT POSTINGS

-  Squiggly line for as-built deletion
-  Double line for as-built deletion
- Roadway Text for as-built posting



THIS WORK WAS PREPARED BY ME
OR UNDER MY SUPERVISION.

WILSON OKAMOTO CORPORATION APRIL 30, 2016 LIC. EXP. DATE

STATE OF HAWAII
DEPARTMENT OF TRANSPORTATION
HIGHWAYS DIVISION

SIGN DETAILS

INTERSTATE ROUTE H-1
PM CONTRAFLOW LANE, PHASE 1 & 2
FEDERAL AID PROJECT NO. NH-H1-1 (260)

Scale: None Date: July, 2016

SHEET No. SD-01 OF 6 SHEETS

"AS-BUILT"

145


QC/QA REVIEW	100%	DATE: MARCH 23, 2014
BY		
BY		
BY		
BY		

ORIGINAL PLAN	SURVEY PLOTTED BY	DATE
NOTE BOOK	DESIGNED BY	
No.	QUANTITIES BY	
	CHECKED BY	

FED. ROAD DIST. NO.	STATE	FED. AID PROJ. NO.	FISCAL YEAR	SHEET NO.	TOTAL SHEETS
HAWAII	HAW.	NH-H1-1 (260)	2014	146	605

QC/QA REVIEW	100%	DATE	MARCH 23, 2017
BY		BY	
BY		BY	
BY		BY	

ORIGINAL PLAN	DATE
NOTED BY	
DESIGNED BY	
QUANTITIES BY	
CHECKED BY	

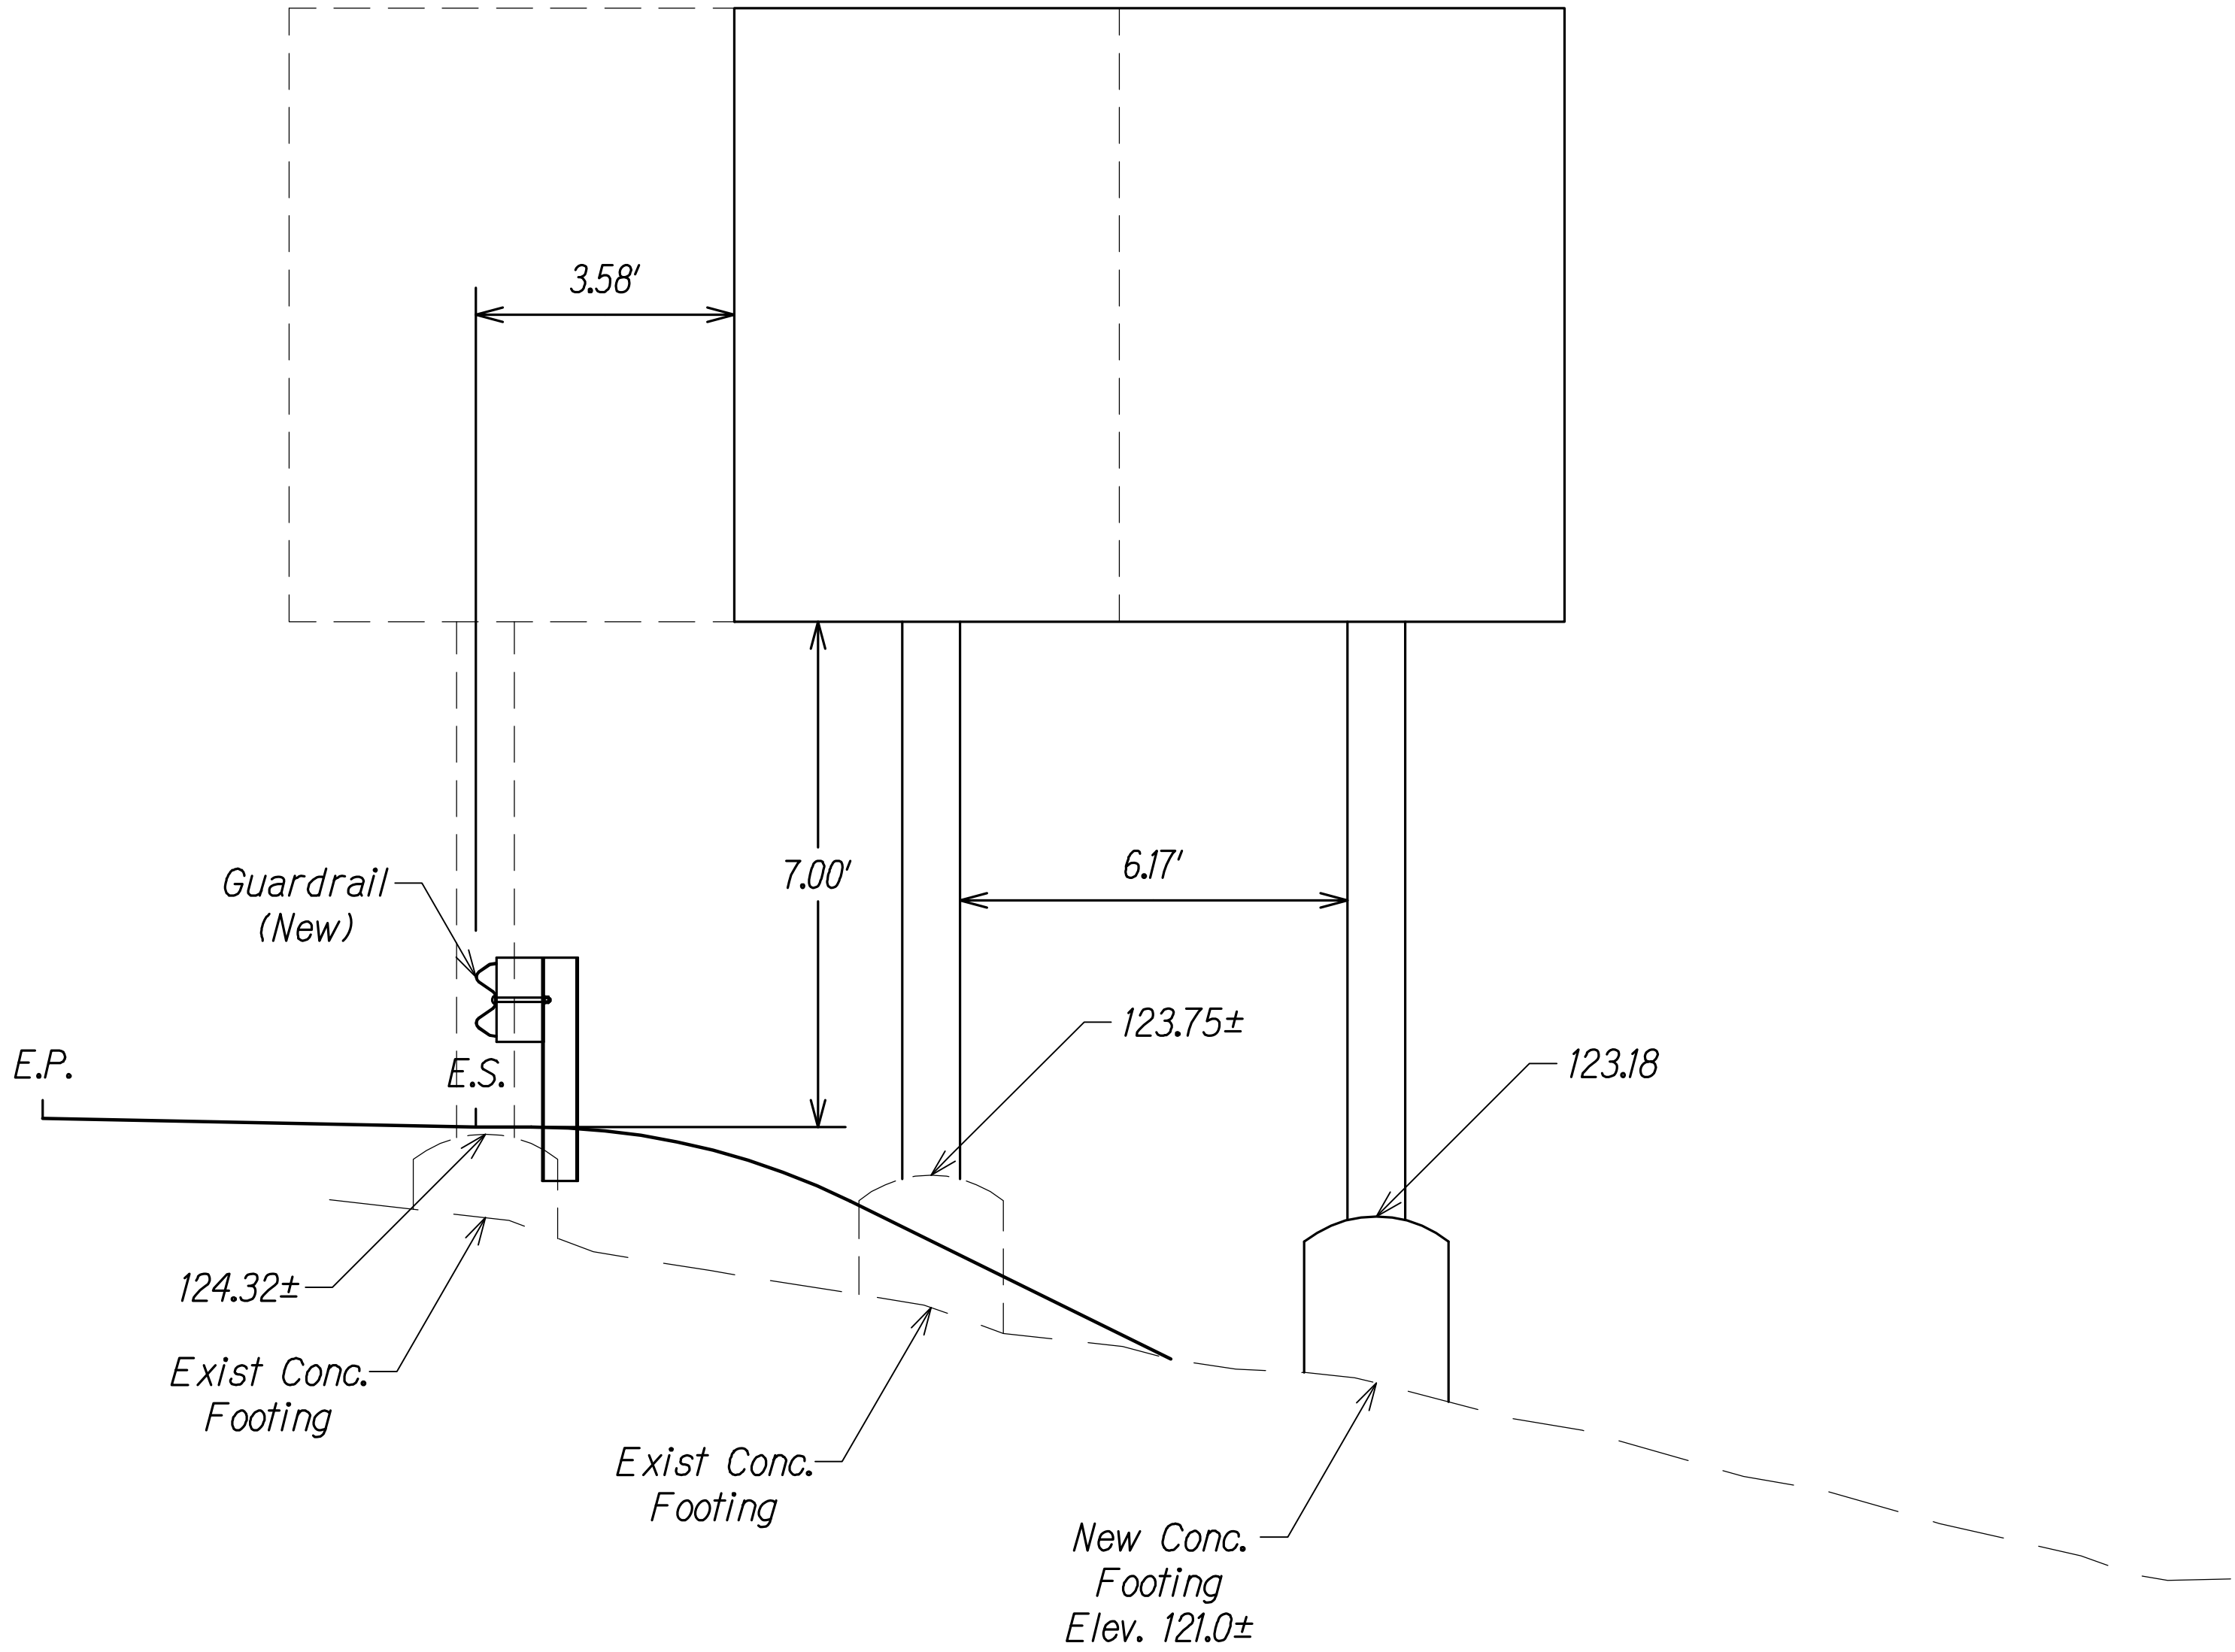

DESTINATION SIGN DETAILS
Sta. 460+96
Scale: Not to Scale

LEGEND FOR AS-BUILT POSTINGS

~~~~~ Squiggly line for as-built deletion

== Double line for as-built deletion

Roadway Text for as-built posting




THIS WORK WAS PREPARED BY ME  
OR UNDER MY SUPERVISION.  
*Matthew K. Fujioka*  
WILSON OKAMOTO CORPORATION APRIL 30, 2018  
LIC. EXP. DATE

STATE OF HAWAII  
DEPARTMENT OF TRANSPORTATION  
HIGHWAYS DIVISION  
**DESTINATION SIGN DETAILS**

INTERSTATE ROUTE H-1  
PM CONTRAFLOW LANE, PHASE 1 & 2  
FEDERAL AID PROJECT NO. NH-H1-1 (260)  
Scale: None Date: July, 2016



| FED. ROAD DIST. NO. | STATE | FED. AID PROJ. NO. | FISCAL YEAR | SHEET NO. | TOTAL SHEETS |
|---------------------|-------|--------------------|-------------|-----------|--------------|
| HAWAII              | HAW.  | NH-H1-1 (260)      | 2014        | 147       | 605          |

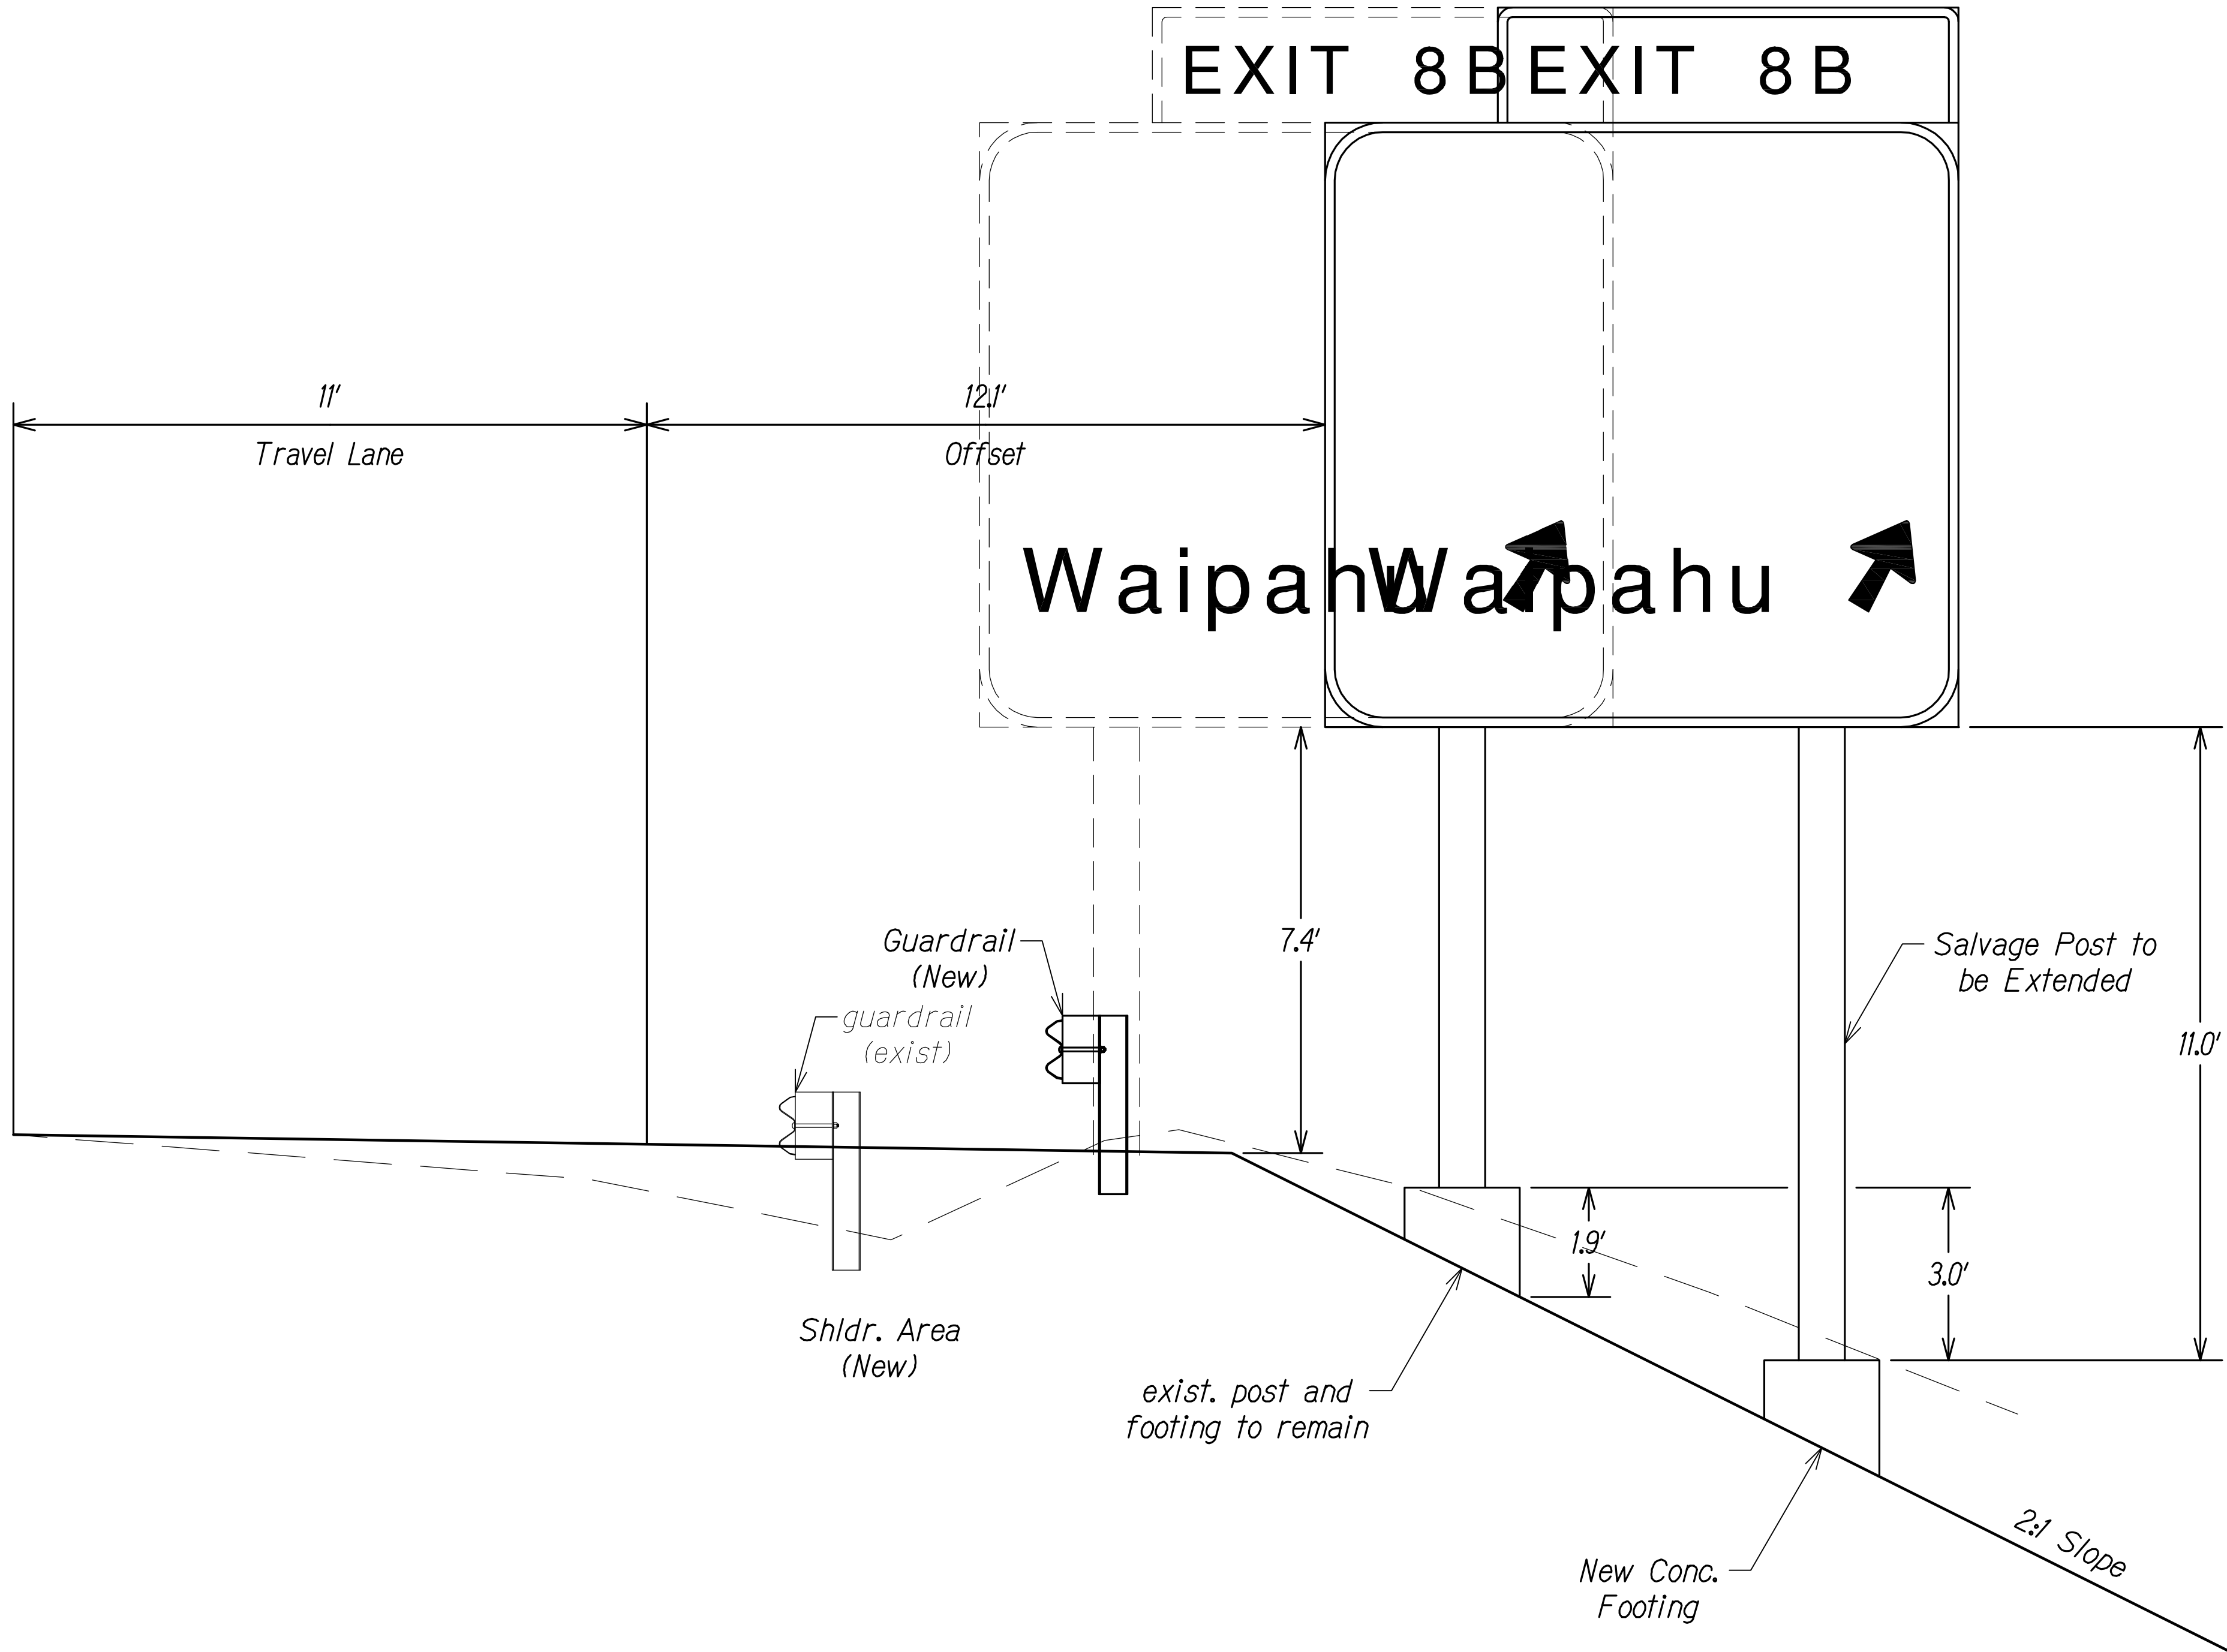


**LEGEND FOR AS-BUILT POSTINGS**

Squiggly line for as-built deletion

Double line for as-built deletion

Roadway Text for as-built posting

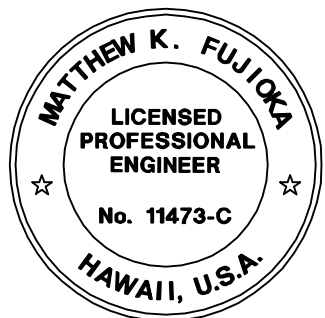

THIS WORK WAS PREPARED BY ME OR UNDER MY SUPERVISION.

*Matthew K. Fujitaka* APRIL 30, 2018  
WILSON OKAMOTO CORPORATION LIC. EXP. DATE

STATE OF HAWAII  
DEPARTMENT OF TRANSPORTATION  
HIGHWAYS DIVISION

**DESTINATION SIGN**  
**DETAILS**

INTERSTATE ROUTE H-1  
PM CONTRAFLOW LANE, PHASE 1 & 2  
FEDERAL AID PROJECT NO. NH-H1-1 (260)

Scale: None Date: July, 2016

SHEET No. SD-03 OF 6 SHEETS

"AS-BUILT"

|              |      |      |                |
|--------------|------|------|----------------|
| QC/QA REVIEW | 100% | DATE | MARCH 23, 2017 |
| BY           |      | BY   |                |
| BY           |      | BY   |                |
| BY           |      | BY   |                |

|               |      |
|---------------|------|
| ORIGINAL PLAN | DATE |
| NOTED BY      |      |
| DESIGNED BY   |      |
| QUANTITIES BY |      |
| CHECKED BY    |      |

DESTINATION SIGN DETAILS

# Sta. 532+01


Scale: Not to Scale







| FED. ROAD DIST. NO. | STATE | FED. AID PROJ. NO. | FISCAL YEAR | SHEET NO. | TOTAL SHEETS |
|---------------------|-------|--------------------|-------------|-----------|--------------|
| HAWAII              | HAW.  | NH-HI-1 (260)      | 2014        | 149       | 605          |

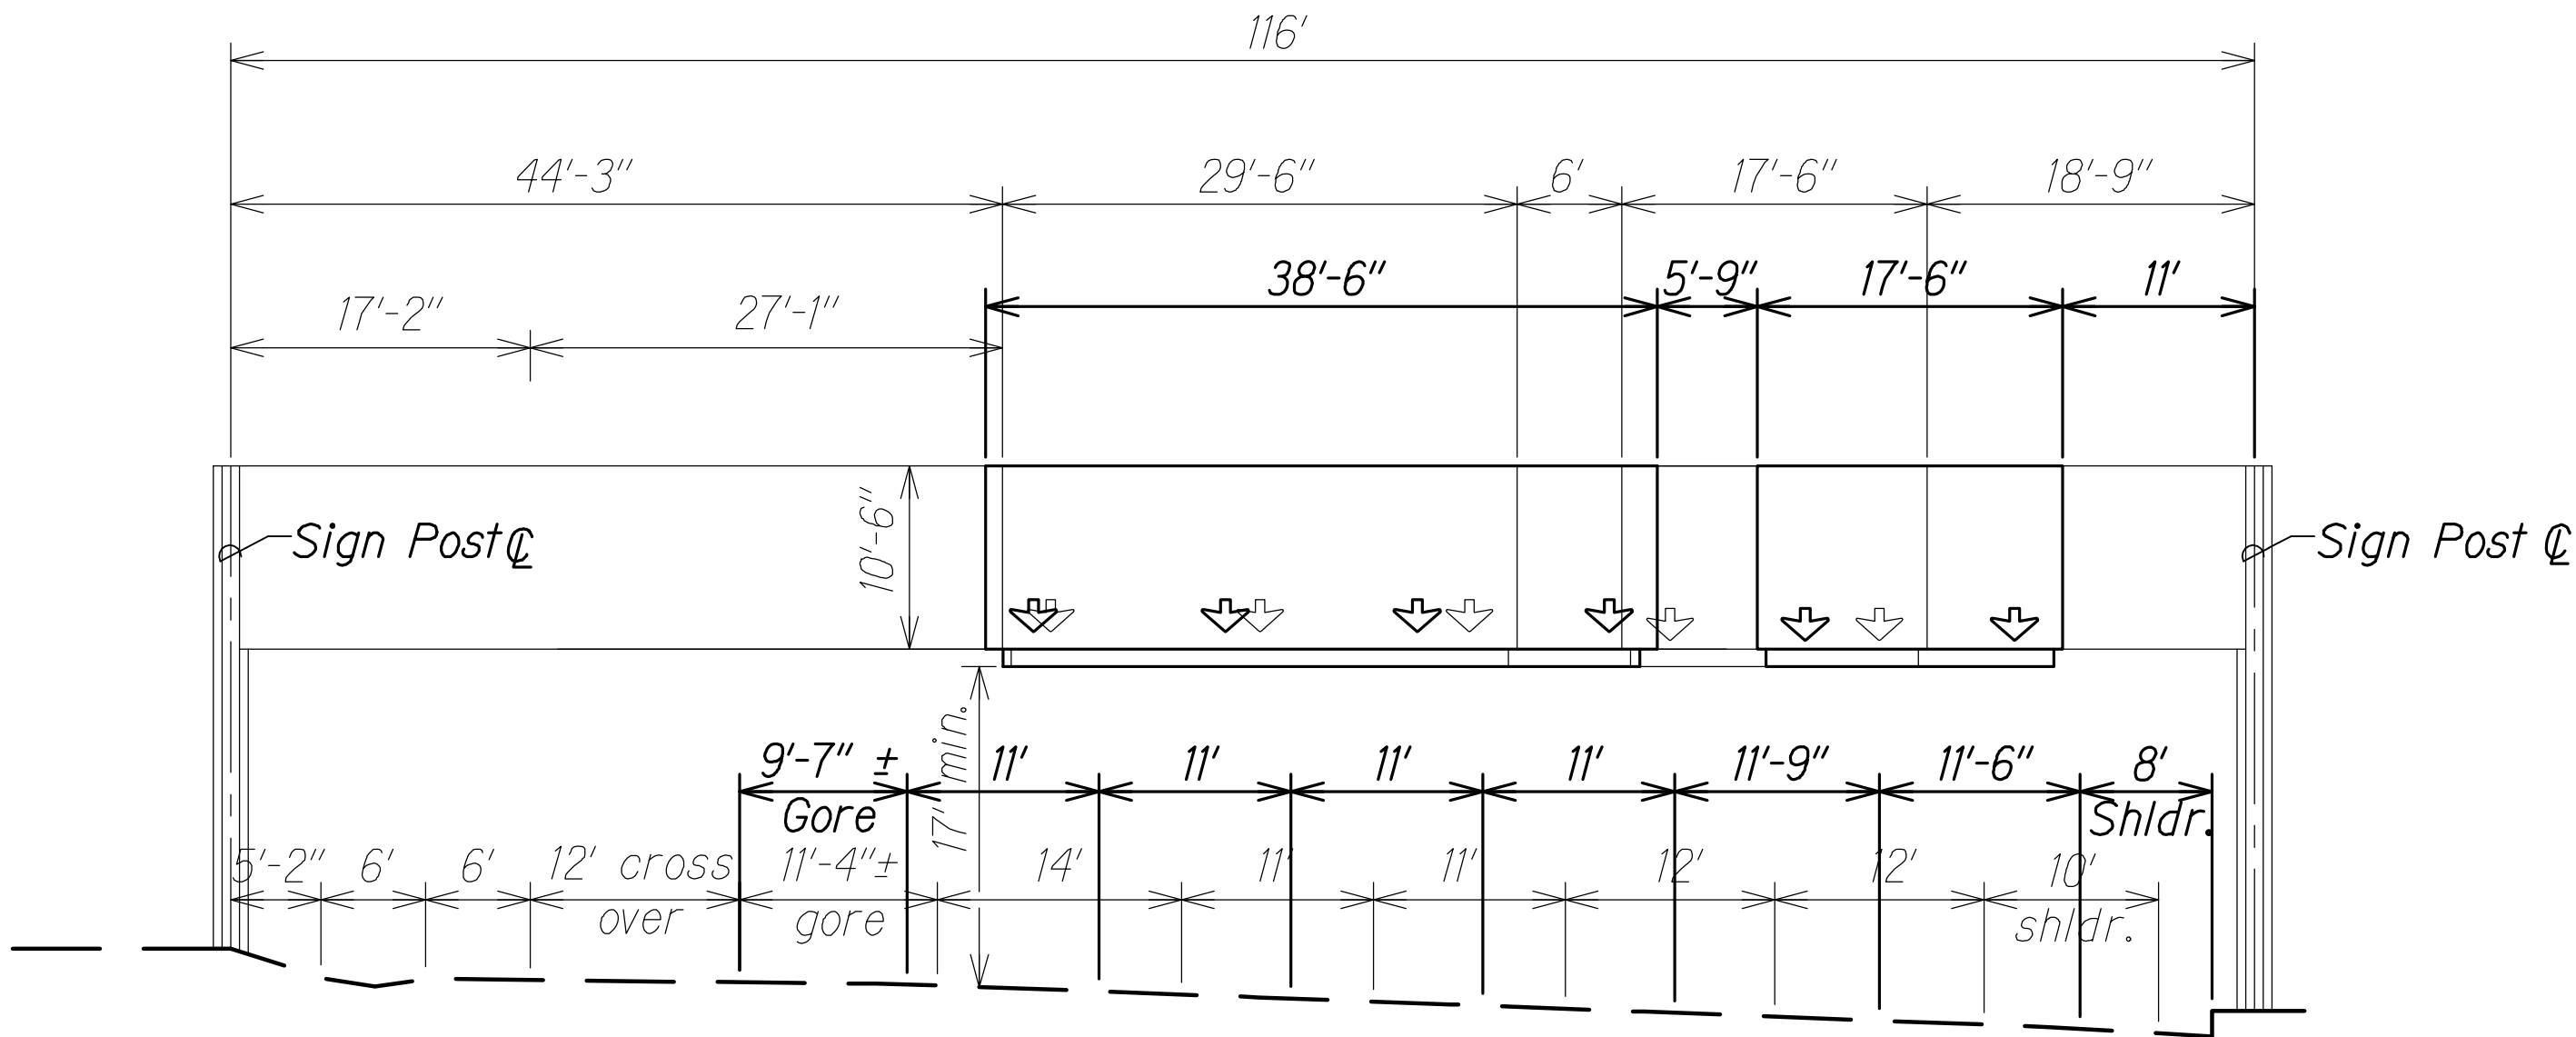


OVERHEAD SIGN ELEVATION  
FARRINGTON HIGHWAY OVERPASS

Scale: 1" = 10'

|              |      |      |                |
|--------------|------|------|----------------|
| QC/QA REVIEW | 100% | DATE | MARCH 23, 2014 |
| BY           |      | BY   |                |
| BY           |      | BY   |                |
| BY           |      | BY   |                |

|               |      |
|---------------|------|
| ORIGINAL PLAN | DATE |
| NOTED BY      |      |
| DESIGNED BY   |      |
| QUANTITIES BY |      |
| CHECKED BY    |      |

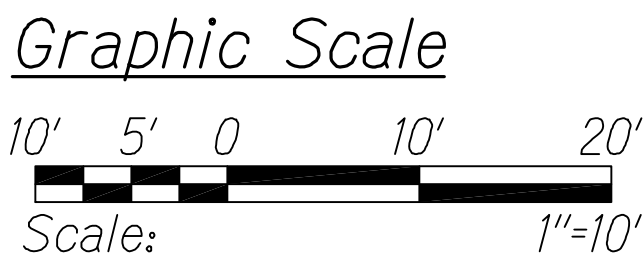

LEGEND FOR  
AS-BUILT POSTINGS

- Squiggly line for as-built deletion
- Double line for as-built deletion
- Roadway Text for as-built posting



THIS WORK WAS PREPARED BY ME  
OR UNDER MY SUPERVISION.  
*Matthew K. Fujioka*  
WILSON OKAMOTO CORPORATION APRIL 30, 2018 LIC. EXP. DATE

STATE OF HAWAII  
DEPARTMENT OF TRANSPORTATION  
HIGHWAYS DIVISION  
**DESTINATION SIGN ELEVATIONS**  
*INTERSTATE ROUTE H-1  
PM CONTRAFLOW LANE, PHASE 1 & 2  
FEDERAL AID PROJECT NO. NH-HI-1 (260)*  
Scale: None Date: July, 2016




| FED. ROAD DIST. NO. | STATE | FED. AID PROJ. NO. | FISCAL YEAR | SHEET NO. | TOTAL SHEETS |
|---------------------|-------|--------------------|-------------|-----------|--------------|
| HAWAII              | HAW.  | NH-H1-1 (260)      | 2014        | 150       | 605          |

LEGEND FOR  
AS-BUILT POSTINGS

 Squiggly line for as-built deletion


 Double line for as-built deletion

 Text for as-built posting

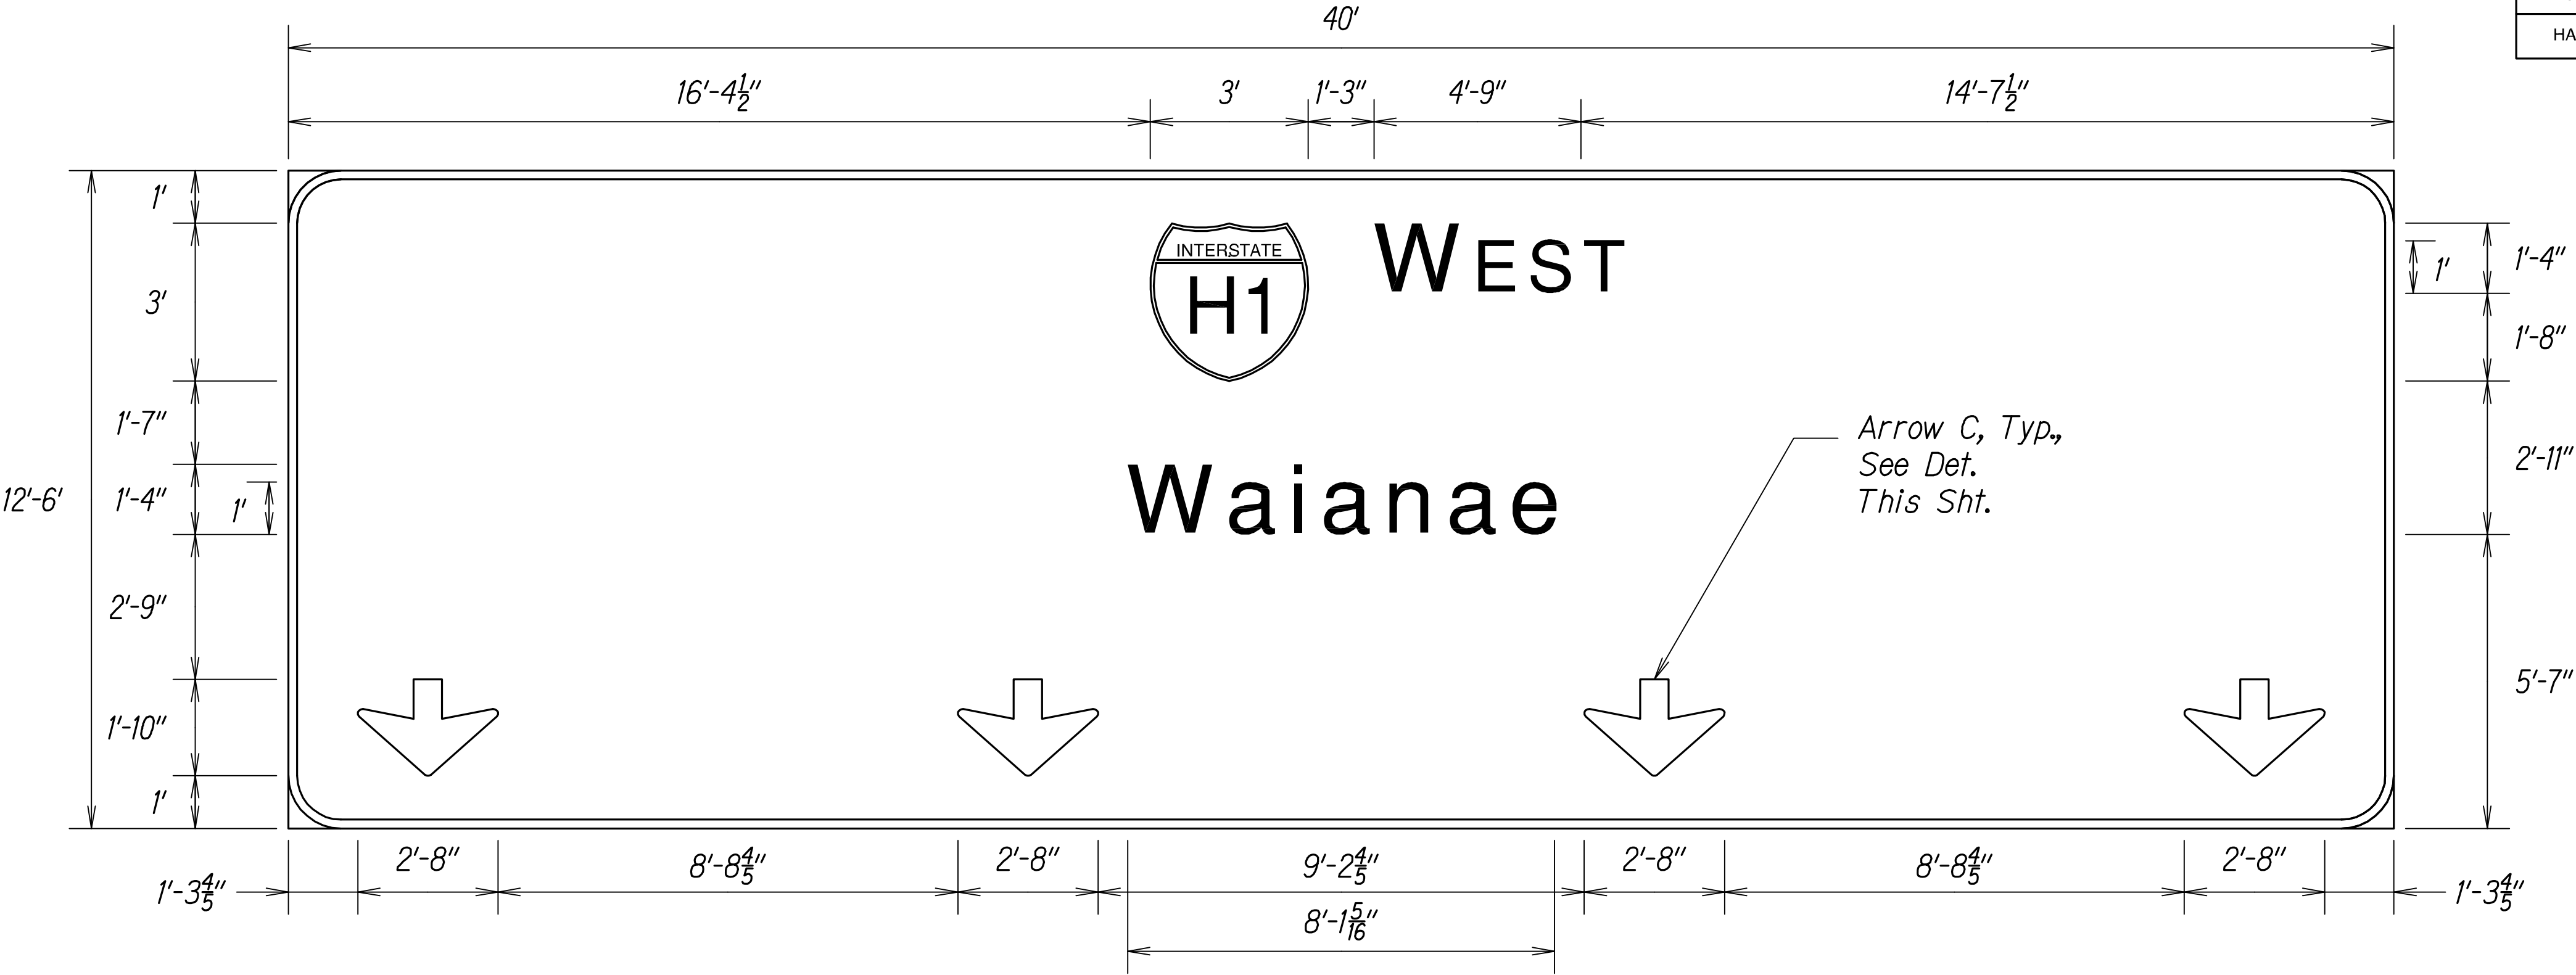


12.000" Radius, 2.000" Border, White on Green  
"WEST" ClearviewHwy-5-W;  
"Waianae" ClearviewHwy-5-W;

DESTINATION SIGN H-1 - KAAHUMANU OVERPASS  
Not To Scale

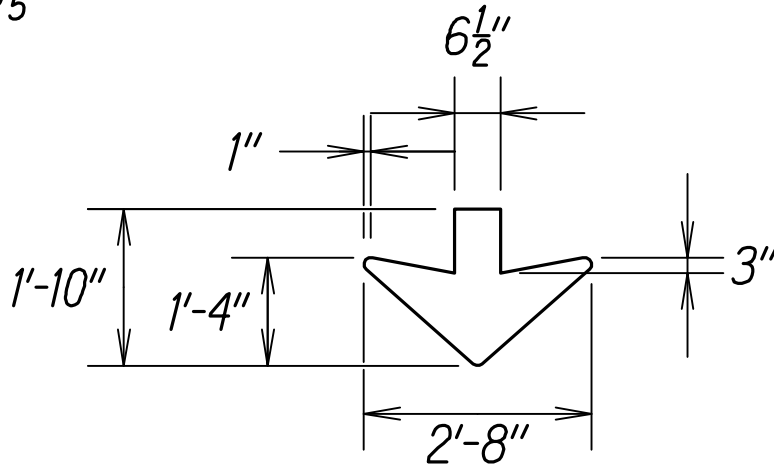


ARROW C  
Not To Scale

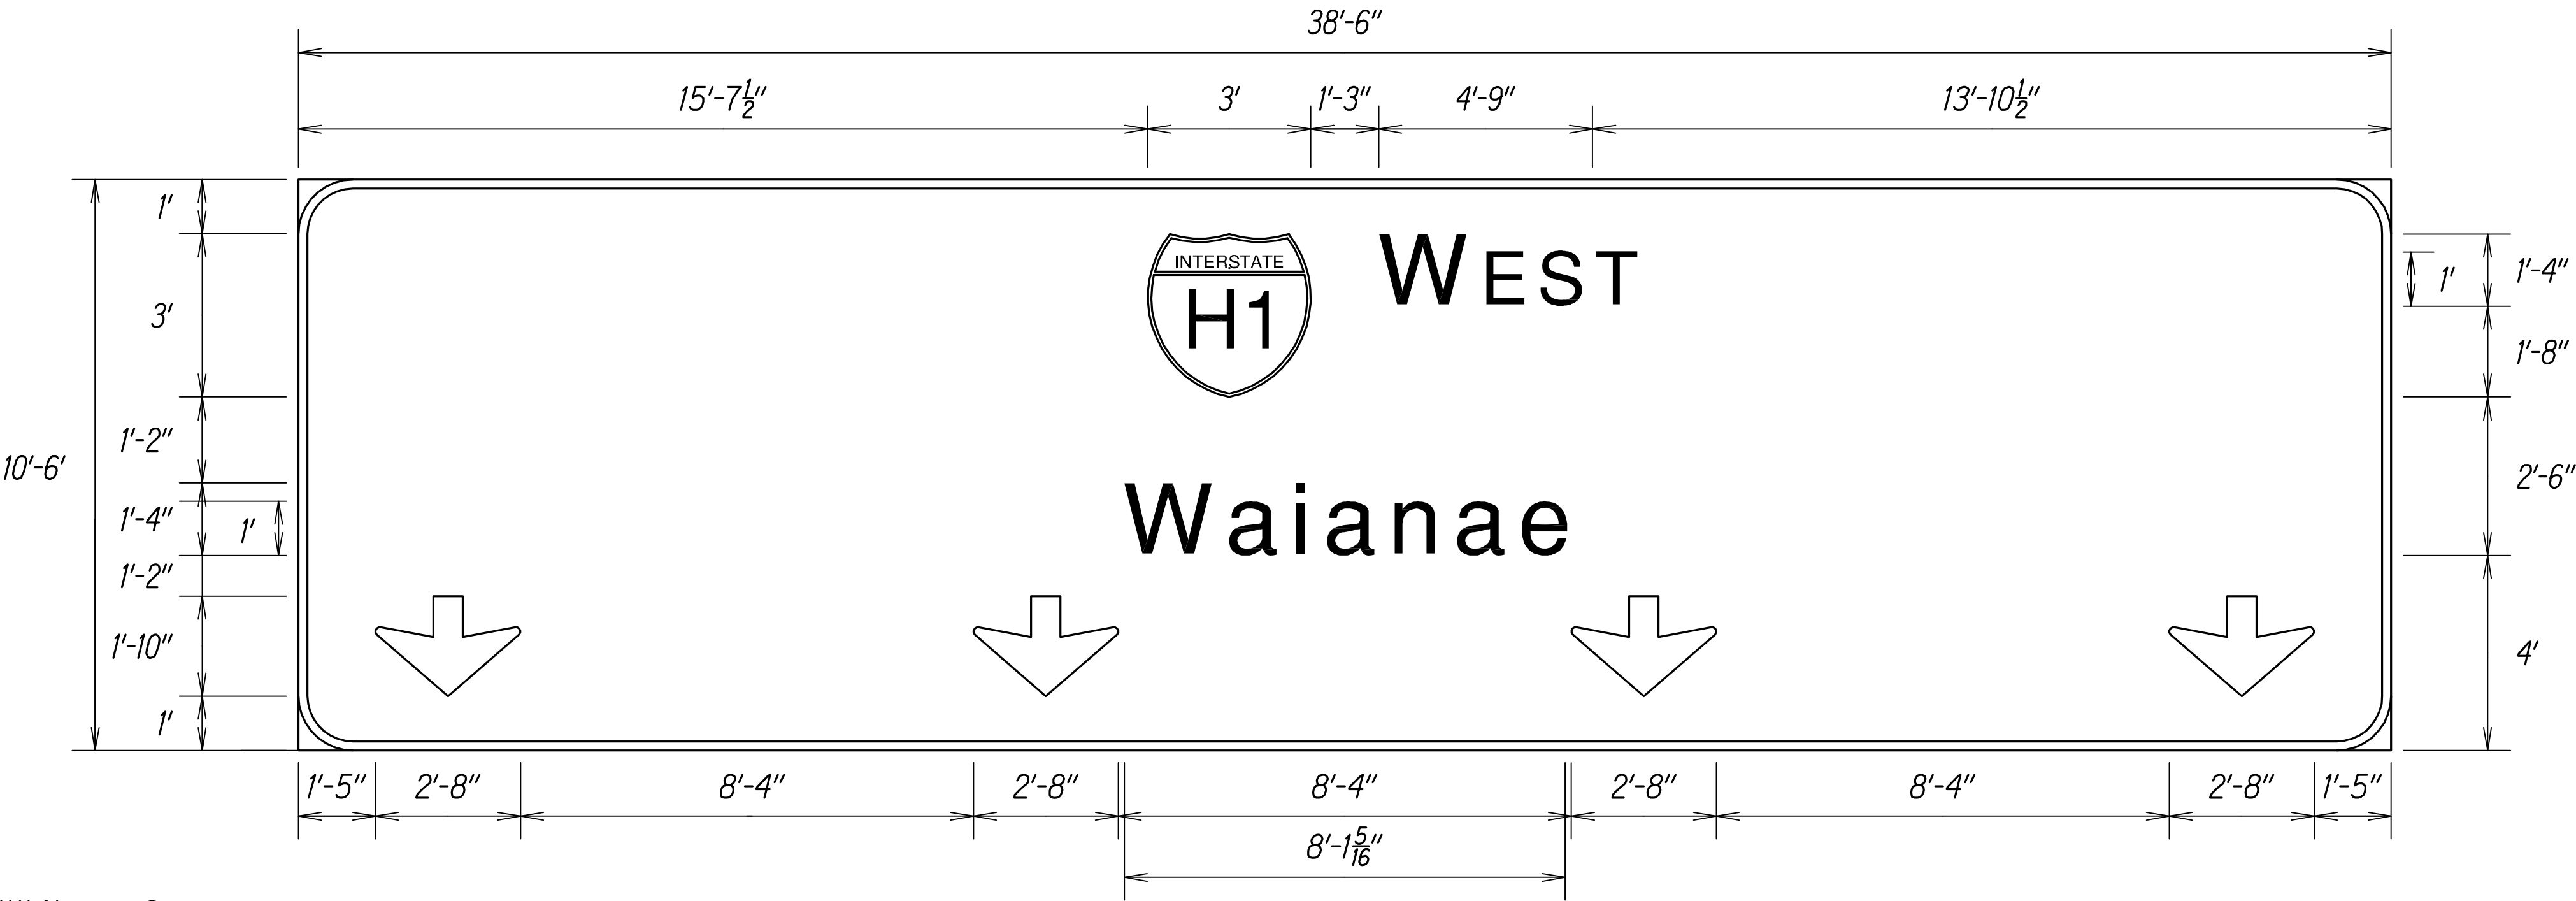

12.000" Radius, 2.000" Border, White on Green  
"WEST" ClearviewHwy-5-W;  
"Waianae" ClearviewHwy-5-W;

DESTINATION SIGN H-1 - WAIAWA/FARRINGTON OVERPASS  
Not To Scale

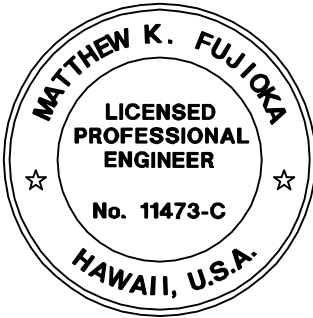

THIS WORK WAS PREPARED BY ME  
OR UNDER MY SUPERVISION.  
*Matthew K. Fujitaka*  
WILSON OKAMOTO CORPORATION APRIL 30, 2018  
LIC. EXP. DATE

STATE OF HAWAII  
DEPARTMENT OF TRANSPORTATION  
HIGHWAYS DIVISION

DESTINATION SIGN  
PANEL LAYOUT

INTERSTATE ROUTE H-1  
PM CONTRAFLOW LANE, PHASE 1 & 2  
FEDERAL AID PROJECT NO. NH-H1-1 (260)

Scale: None Date: July, 2016

|              |      |      |                |
|--------------|------|------|----------------|
| QC/QA REVIEW | 100% | DATE | MARCH 23, 2014 |
| BY           |      | BY   |                |
| BY           |      | BY   |                |
| BY           |      | BY   |                |
| BY           |      | BY   |                |

|                   |      |
|-------------------|------|
| SURVEY PLOTTED BY | DATE |
| DESIGNED BY       |      |
| QUANTITIES BY     |      |
| CHECKED BY        |      |
| ORIGINAL PLAN     |      |
| NOTE BOOK         |      |
| No.               |      |