

STANDARD PLANS SUMMARY


FED. ROAD DIST. NO.	STATE	FED. AID PROJ. NO.	FISCAL YEAR	SHEET NO.	TOTAL SHEETS
HAWAII	HAW.	NH-HI-1 (260)	2014	4	605

STANDARD PLAN NO.	TITLE	DATE	STANDARD PLAN NO.	TITLE	DATE	STANDARD PLAN NO.	TITLE	DATE	STANDARD PLAN NO.	TITLE	DATE
B-01 ●	Notes and Miscellaneous Details	05/31/07	H-01A	Type A Catch Basin	05/31/07	TE-09	Bike Route Sign and Supplementary Plates	07/11/08	TE-31 ●	Pavement Alphabets, Numbers and Symbols	07/11/08
B-03 ●	Backfill Details at Earth Retaining Structures	05/31/07	H-01B	Type B Catch Basin	05/31/07	TE-10	Interstate Route Marker	07/11/08	TE-32 ●	Type I and II Traffic Signal System Misc. Details	05/31/07
B-12	Prestressed Concrete Piles and Compression Splice Can Details	05/31/07	H-01C	Type C Catch Basin	05/31/07	TE-11 ●	State Route Marker and Auxiliary Markers	07/11/08	TE-33 ●	Type II Traffic Signal System	08/16/06
			H-01D	Type D Catch Basin	05/31/07	TE-12	State Route Marker and Border Detail for Guide Signs	07/11/08	TE-33AJ ●	Type II Traffic Signal Standard	05/31/07
B-12A	Prestressed Concrete Piles, Pile and Compression Splice Can Details and Notes	05/31/07	H-01E	Catch Basin Sections	05/31/07	TE-12A ●	Route Sign Assemblies	07/11/08	TE-33A2 ●	Type II Traffic Signal Standard	05/31/07
			H-02A	Type A1 Catch Basin	05/31/07	TE-13 ●	Street Name Sign on Mast Arm	07/11/08	TE-34 ●	Loop Detector Details	07/11/08
B-12B	Pile Interaction Diagram	05/31/07	H-02B	Type B2 Catch Basin	05/31/07	TE-14 ●	Miscellaneous Reflector Markers	07/11/08	TE-35 ●	Loop Detectors and Duct Details	07/11/08
B-13	Prestressed Concrete Pile Build-up Details	05/31/07	H-02C	Type C1 Catch Basin	05/31/07	TE-15 ●	Object Markers	07/11/08	TE-36 ●	Traffic Signal Details	07/11/08
			H-02D	Type D1 Catch Basin	05/31/07	TE-16 ●	Mile Posts	07/11/08	TE-37 ●	Pullbox and Cover Details	07/11/08
D-01	Cattle Gate	05/31/07	H-02E	Catch Basin Section	05/31/07	TE-17A	Cantilever Overhead Sign Elevation and Details	05/31/07	TE-37A ●	Type "A" Traffic Pullbox	05/31/07
D-02	Chain Link Fence with Toprail	05/31/07	H-03 ●	Type A, B, and C Storm Drain Manhole	05/31/07	TE-17B	Cantilever Sign Frame Detail and Section	05/31/07	TE-37B ●	Type "A" Traffic Pullbox Reinforcing	05/31/07
D-03	Chain Link Fence without Toprail	05/31/07	H-04 ●	Type D Storm Drain Manhole	05/31/07	TE-17C	Cantilever Sign Frame Detail	05/31/07	TE-37C ●	Type "B" Traffic Pullbox	05/31/07
D-04	Wire Fence with Metal Posts	05/31/07	H-05 ●	Typical Reinforcing Details for Drainage Structures	05/31/07	TE-17D	Cantilever Sign Frame Section	05/31/07	TE-37D ●	Type "B" Traffic Pullbox Reinforcing	05/31/07
D-05 ●	Typical Details of Curbs and/or Gutters	05/31/07	H-06 ●	Typical Reinforcing Details for Drainage Structures	05/31/07	TE-17E	Cantilever Sign Frame Detail	05/31/07	TE-37E ●	Type "B" Traffic Pullbox Foundation	05/31/07
D-06	Typical Detail of Reinforced Concrete Drop Driveway	05/31/07	H-07 ●	Catch Basin and Manhole Castings	05/31/07	TE-18A	Two Post Overhead Sign Frame Elevations	05/31/07	TE-37F ●	Type "C" Traffic Pullbox	05/31/07
D-07	Centerline and Reference Survey Monuments	05/31/07	H-08	Type 1A-9 and 1A-9P Grated Drop Inlet	05/31/07	TE-18B	Two Post Sign Framing Plan Section	05/31/07	TE-37G ●	Type "C" Traffic Pullbox Reinforcing	05/31/07
D-08	Street Survey Monument	05/31/07	H-09	Type 2A-9 and 2A-9P Grated Drop Inlet	05/31/07	TE-18C	Two Post Sign Framing Sections and Details	05/31/07	TE-37H ●	Type "C" Traffic Pullbox Foundation	05/31/07
D-15	Concrete Sidewalk	05/31/07	H-10	Type A-9 or A-9P Steel Frames	05/31/07	TE-18D	Two Post Sign Frame Details	05/31/07	TE-37J ●	Traffic Pullbox Cover and Details	05/31/07
D-16	P.C.C. Bus Pad	05/31/07	H-11	Type A-9 and A-9P Steel Grates	05/31/07	TE-18E	Two Post Sign Frame Details	05/31/07	TE-38	Type III Traffic Signal Standard	05/31/07
D-17	P.C.C. Bus Pad	05/31/07	H-12 ●	Type 61614P and 1211214P Grated Drop Inlet	05/31/07	TE-19A	Overhead Sign Framing Schedule	05/31/07	TE-38AJ	Type III Traffic Signal Standard	05/31/07
D-18 ●	P.C.C. Pavement Layout	05/31/07	H-13 ●	Type 61616P and 1211216P Grated Drop Inlet	05/31/07	TE-19B	Sign Post Drilled Shaft Foundation	05/31/07	TE-38A2	Type III Traffic Signal Standard	05/31/07
D-19 ●	P.C.C. Pavement with Permeable Base Joint Details	05/31/07	H-14 ●	Type 61214P Grated Drop Inlet	05/31/07	TE-19C	Spread Footing	05/31/07	TE-39 ●	Metal Guardrail Connection to Concrete Barrier	07/11/08
D-20 ●	P.C.C. Pavement with Permeable Base Joint Details	05/31/07	H-15	Type 1211214, 1211214P, 1211216, 1211216P Steel Frame and Grates	05/31/07	TE-19D	Sign Frame Foundation Schedule	05/31/07	TE-40 ●	Concrete Barrier Transition	05/31/07
D-21 ●	P.C.C. Longitudinal Joint Details	05/31/07				TE-19D.1	Sign Frame Foundation Schedule	05/31/07	TE-40A ●	Concrete Barrier Transition	05/31/07
D-22 ●	P.C.C. Connection to Curbs and Gutters	05/31/07	H-16 ●	Type 61614, 61614P, 61616, 61616P Steel Frame and Grates	05/31/07	TE-19D.2	Sign Frame Foundation Schedule	05/31/07	TE-41 ●	Sections Guardrail Type 4 (Rigid Barrier)	05/31/07
D-23	Joints	05/31/07				TE-19D.3	Sign Frame Foundation Schedule	05/31/07	TE-42	Portable Concrete Barrier	05/31/07
			H-17 ●	Type 61214 Steel Frames and Grates	05/31/07	TE-19D.4	Sign Frame Foundation Schedule	05/31/07	TE-43	Portable Concrete Barrier	05/31/07
L-01	Tree Planting	08/16/06	H-18 ●	Type 61214p Steel Grates	05/31/07	TE-19D.5	Sign Frame Foundation Schedule	05/31/07	TE-44 ●	Guardrail Type 4 Miscellaneous Details	07/11/08
L-02	Tree Planting	08/16/06	H-19	Type 61614b Steel Frame and Grates	05/31/07	TE-19E	Anchorage Details	05/31/07	TE-45	Barricades	07/11/08
L-03	Tree Transplanting	08/16/06	H-20	Cement Rubble Masonry Structures	05/31/07	TE-19F	Anchorage Details	05/31/07	TE-46	Delineation and Pavement Markings at Narrow Bridges	07/11/08
L-04	Palm Planting	08/16/06	H-21	Concrete and Cement Rubble Masonry Structures	05/31/07	TE-19G	Miscellaneous Sign Frame Details	05/31/07	TE-47	Highway Light Standard	05/31/07
L-05	Shrub Planting	08/16/06	H-22	Inlet/Outlet Structure	05/31/07	TE-19H	Luminaire Walkway Support	05/31/07			
L-06	Landscape Details	08/16/06	H-23	Inlet/Outlet Structure	05/31/07	TE-19J	Fixed Message Luminaire Support	05/31/07			
L-07	Landscape Details	08/16/06	H-24	Flared End Section for Culverts	05/31/07	TE-19K	Miscellaneous Sign Details	05/31/07			
L-08	Landscape Details	08/16/06	H-25	Flared End Section for Culverts	05/31/07	TE-19L	Miscellaneous Sign Details	05/31/07			
L-09	Landscape Details	08/16/06	H-26	Concrete Spillway Inlet	05/31/07	TE-19M	Miscellaneous Sign Frame Details	05/31/07			
L-10	Landscape Details	08/16/06	H-27	Cap Coupling Details Standard Joint	05/31/07	TE-20	Supports for Ground Mounted Guide Sign	05/31/07			
L-11	Planting Notes	08/16/06	H-28 ●	Reinforced Concrete Collar & Jacket	05/31/07	TE-20A	Supports for Ground Mounted Guide Sign	05/31/07			
L-12	Irrigation Details	08/16/06	H-29	Underdrain Cleanout Steel Frame and Cover	05/31/07	TE-20B	Supports for Ground Mounted Guide Sign	05/31/07			
L-13	Irrigation Details	08/16/06	H-30	Underdrain Connection to Drainage Structure	05/31/07	TE-20C	Supports for Ground Mounted Guide Sign	05/31/07			
L-14	Irrigation Details	08/16/06				TE-21A	Sign Breakaway Mounts	05/31/07			
L-15	Irrigation Details	08/16/06	TE-01 ●	Sign Height and Location	07/11/08	TE-21B	Sign Breakaway Mounts	05/31/07			
L-16	Irrigation Details	08/16/06	TE-01A ●	Sign Installation	07/11/08	TE-22	Laminated Aluminum Sign Panels (Overhead)	05/31/07			
L-17	Irrigation Details	08/16/06	TE-02A ●	Galvanized Flanged Channel Sign Post Mounting	05/31/07	TE-23	Laminated Aluminum Sign Panels (Ground Mounted)	07/11/08			
L-18	Irrigation Details	08/16/06	TE-02B ●	Galvanized Flanged Channel Sign Post Mounting	05/31/07	TE-24	Solid Aluminum Extruded Sign Panel and Accessory Details	05/31/07			
L-19	Irrigation Details	08/16/06	TE-02C ●	Galvanized Flanged Channel Sign Post Mounting	05/31/07	TE-25	Guide Signs Luminaire Mountings	05/31/07			
L-20	Irrigation Details	08/16/06	TE-03A ●	Galvanized Square Tube Sign Post Mounting	05/31/07	TE-26 ●	Raised Pavement Markers and Striping	07/11/08			
L-21	Irrigation Details	08/16/06	TE-03B ●	Galvanized Square Tube Sign Post Mounting	05/31/07	TE-27 ●	Raised Pavement Markers and Striping	07/11/08			
L-22	Irrigation Details	08/16/06	TE-04 ●	Regulatory Signs	07/11/08	TE-28 ●	Entrance and Exit Pavement Markings	07/11/08			
L-23	Irrigation Details	08/16/06	TE-05 ●	Warning Signs	07/11/08	TE-28A ●	Entrance and Exit Pavement Markings	07/11/08			
L-24	Irrigation Notes	08/16/06	TE-06 ●	Miscellaneous Signs	07/11/08	TE-28A ●	Miscellaneous Pavement Markings	07/11/08			
			TE-07 ●	Construction Signs	07/11/08	TE-29 ●	Pavement Arrows and Symbols	07/11/08			
			TE-08	Miscellaneous Intersection Signs	07/11/08	TE-30 ●	Pavement Alphabets, Numbers and Symbols	07/11/08			

NOTE:
STANDARD PLANS APPLICABLE TO THIS
PROJECT ARE INDICATED BY A " ● "
NEXT TO THE STANDARD PLAN NO.
(FOR EXAMPLE: D-07 ●)

LEGEND FOR
AS-BUILT POSTINGS

 Squiggly line for
as-built deletion
 Double line for
as-built deletion
Roadway Text for as-built posting

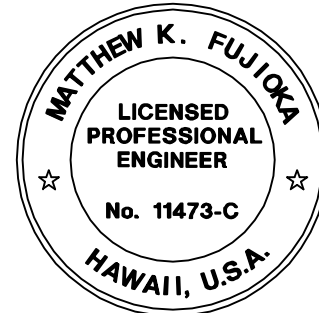

THIS WORK WAS PREPARED BY ME
OR UNDER MY SUPERVISION.

WILSON OKAMOTO CORPORATION APRIL 30, 2018
LIC. EXP. DATE

STATE OF HAWAII
DEPARTMENT OF TRANSPORTATION
HIGHWAYS DIVISION

STANDARD PLANS SUMMARY

INTERSTATE ROUTE H-1
PM CONTRAFLOW LANE, PHASE 1 & 2
FEDERAL AID PROJECT NO. NH-HI-1 (260)
Scale: None Date: July, 2016

SHEET No. T-4 OF 4 SHEETS

"AS-BUILT"