

PHONE

অ

P.S.


STATE OF HAWAII


DEPARTMENT OF TRANSPORTATION

HIGHWAYS DIVISION HONOLULU, HAWAII AS-BUILT PLANS FOR

INTERSTATE ROUTE H-1
P.M. CONTRAFLOW LANE, PHASE 1 & 2
VICINITY OF RADFORD DRIVE
TO WAIAWA INTERCHANGE
FEDERAL AID PROJECT NO. NH-H1-1 (260)

DISTRICT OF EWA AND HONOLULU ISLAND OF OAHU

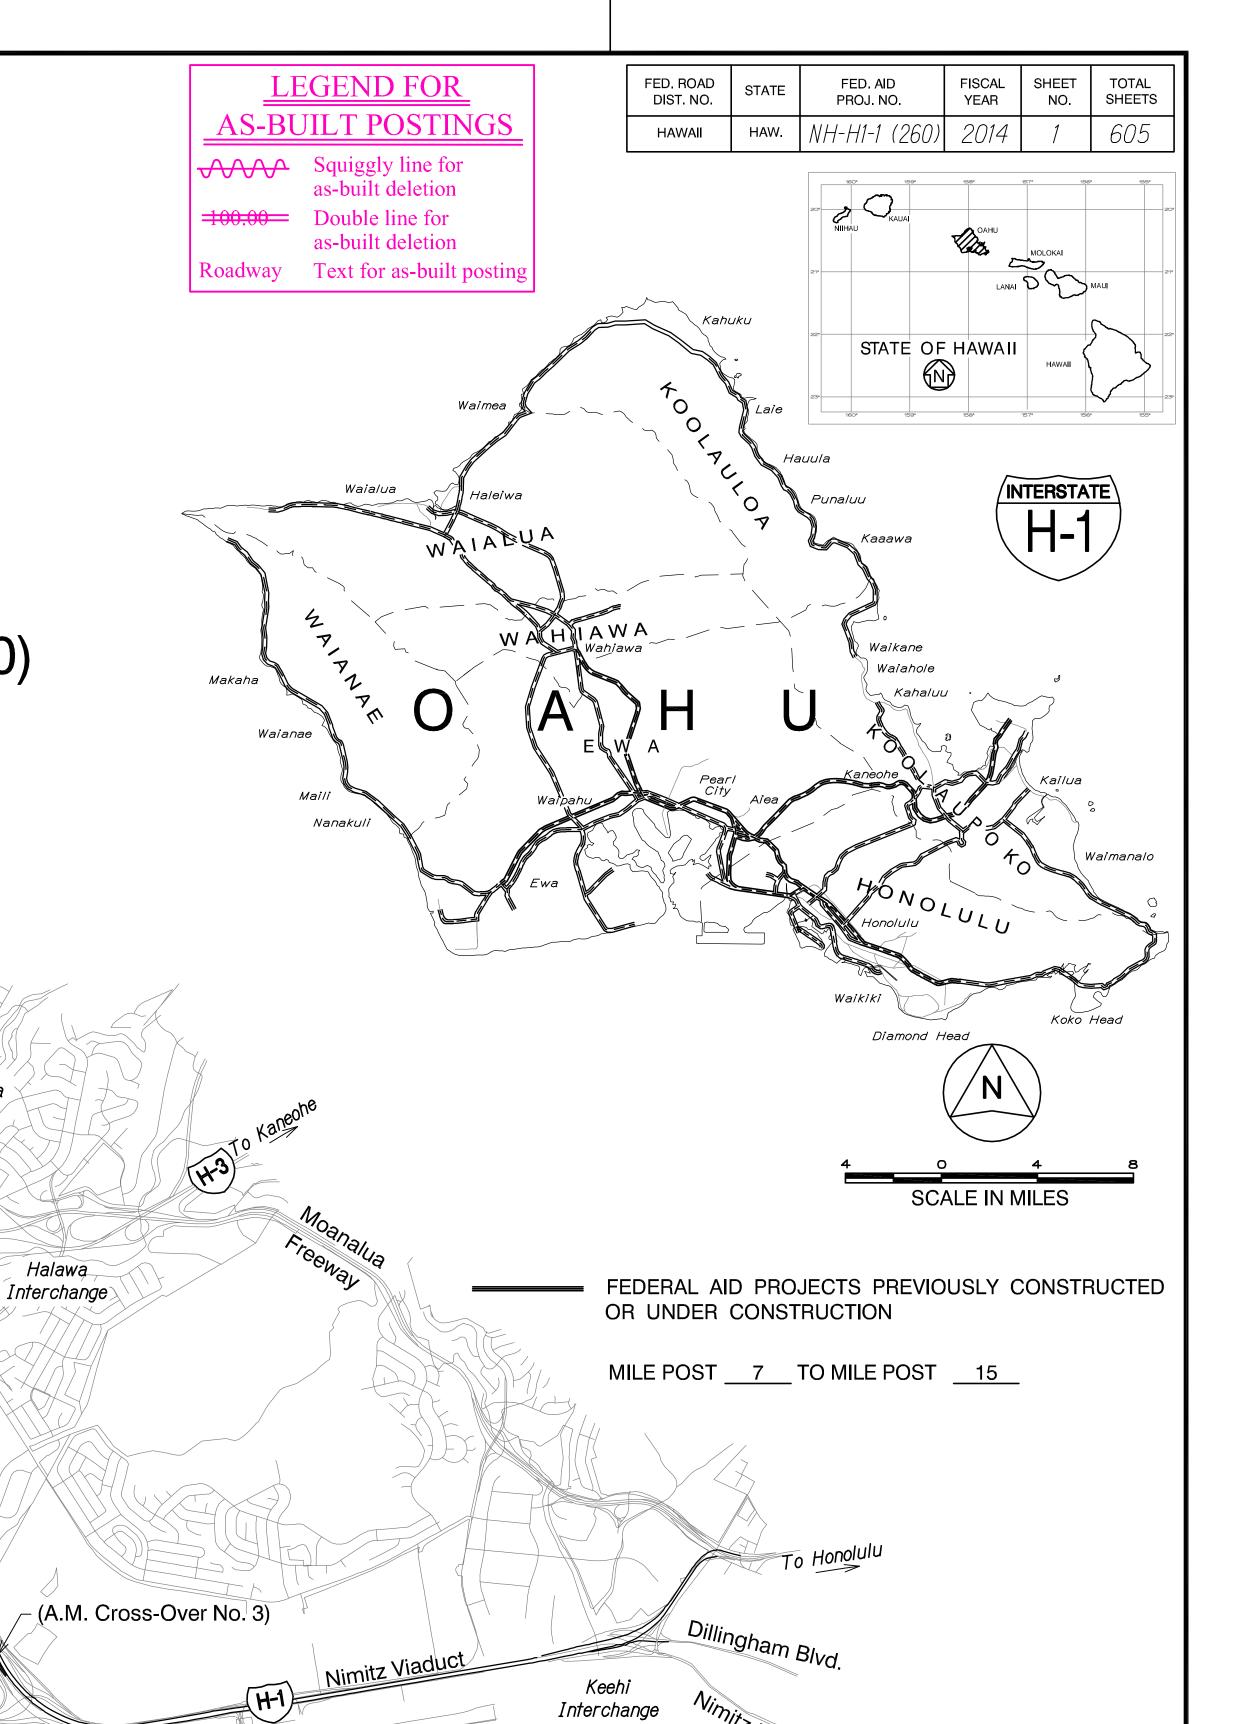

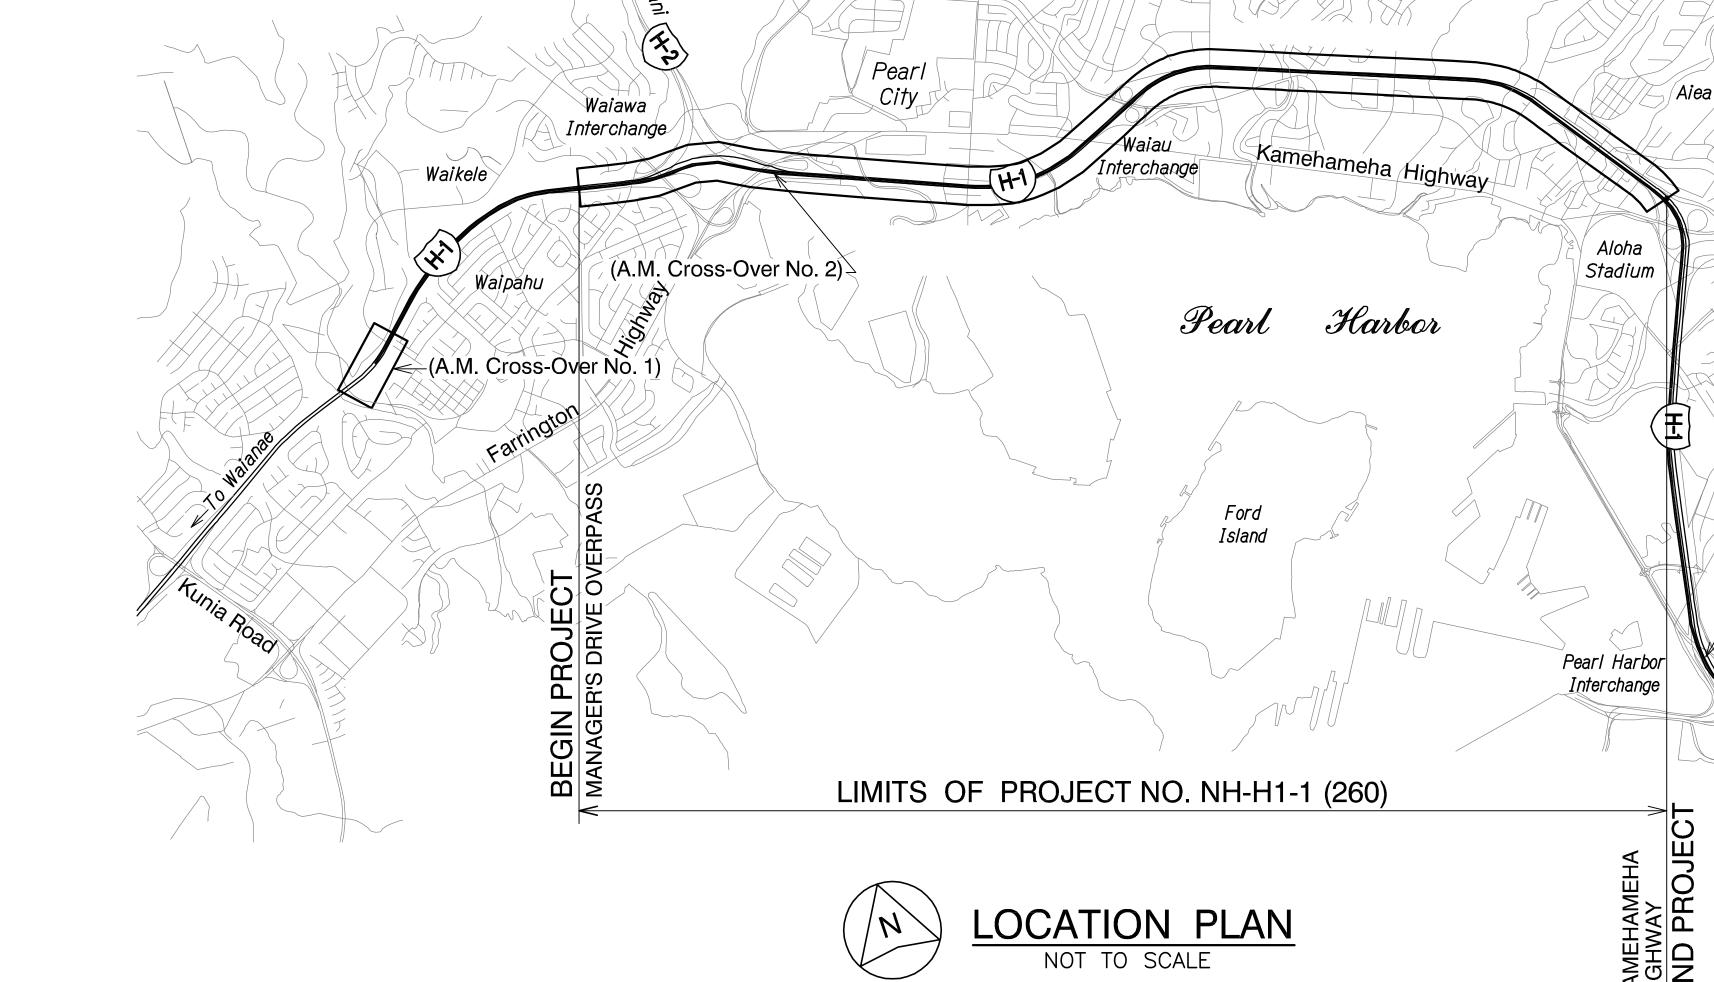

HAWAIIAN DREDGING CONSTRUCTION COMPANY, INC.

Honolulu International Airport