



FED. ROAD DIST. NO.	STATE	FED. AID PROJ. NO.	FISCAL YEAR	SHEET NO.	TOTAL SHEETS
HAWAII	HAW.	NH-H1-1 (260)	2014	51	200

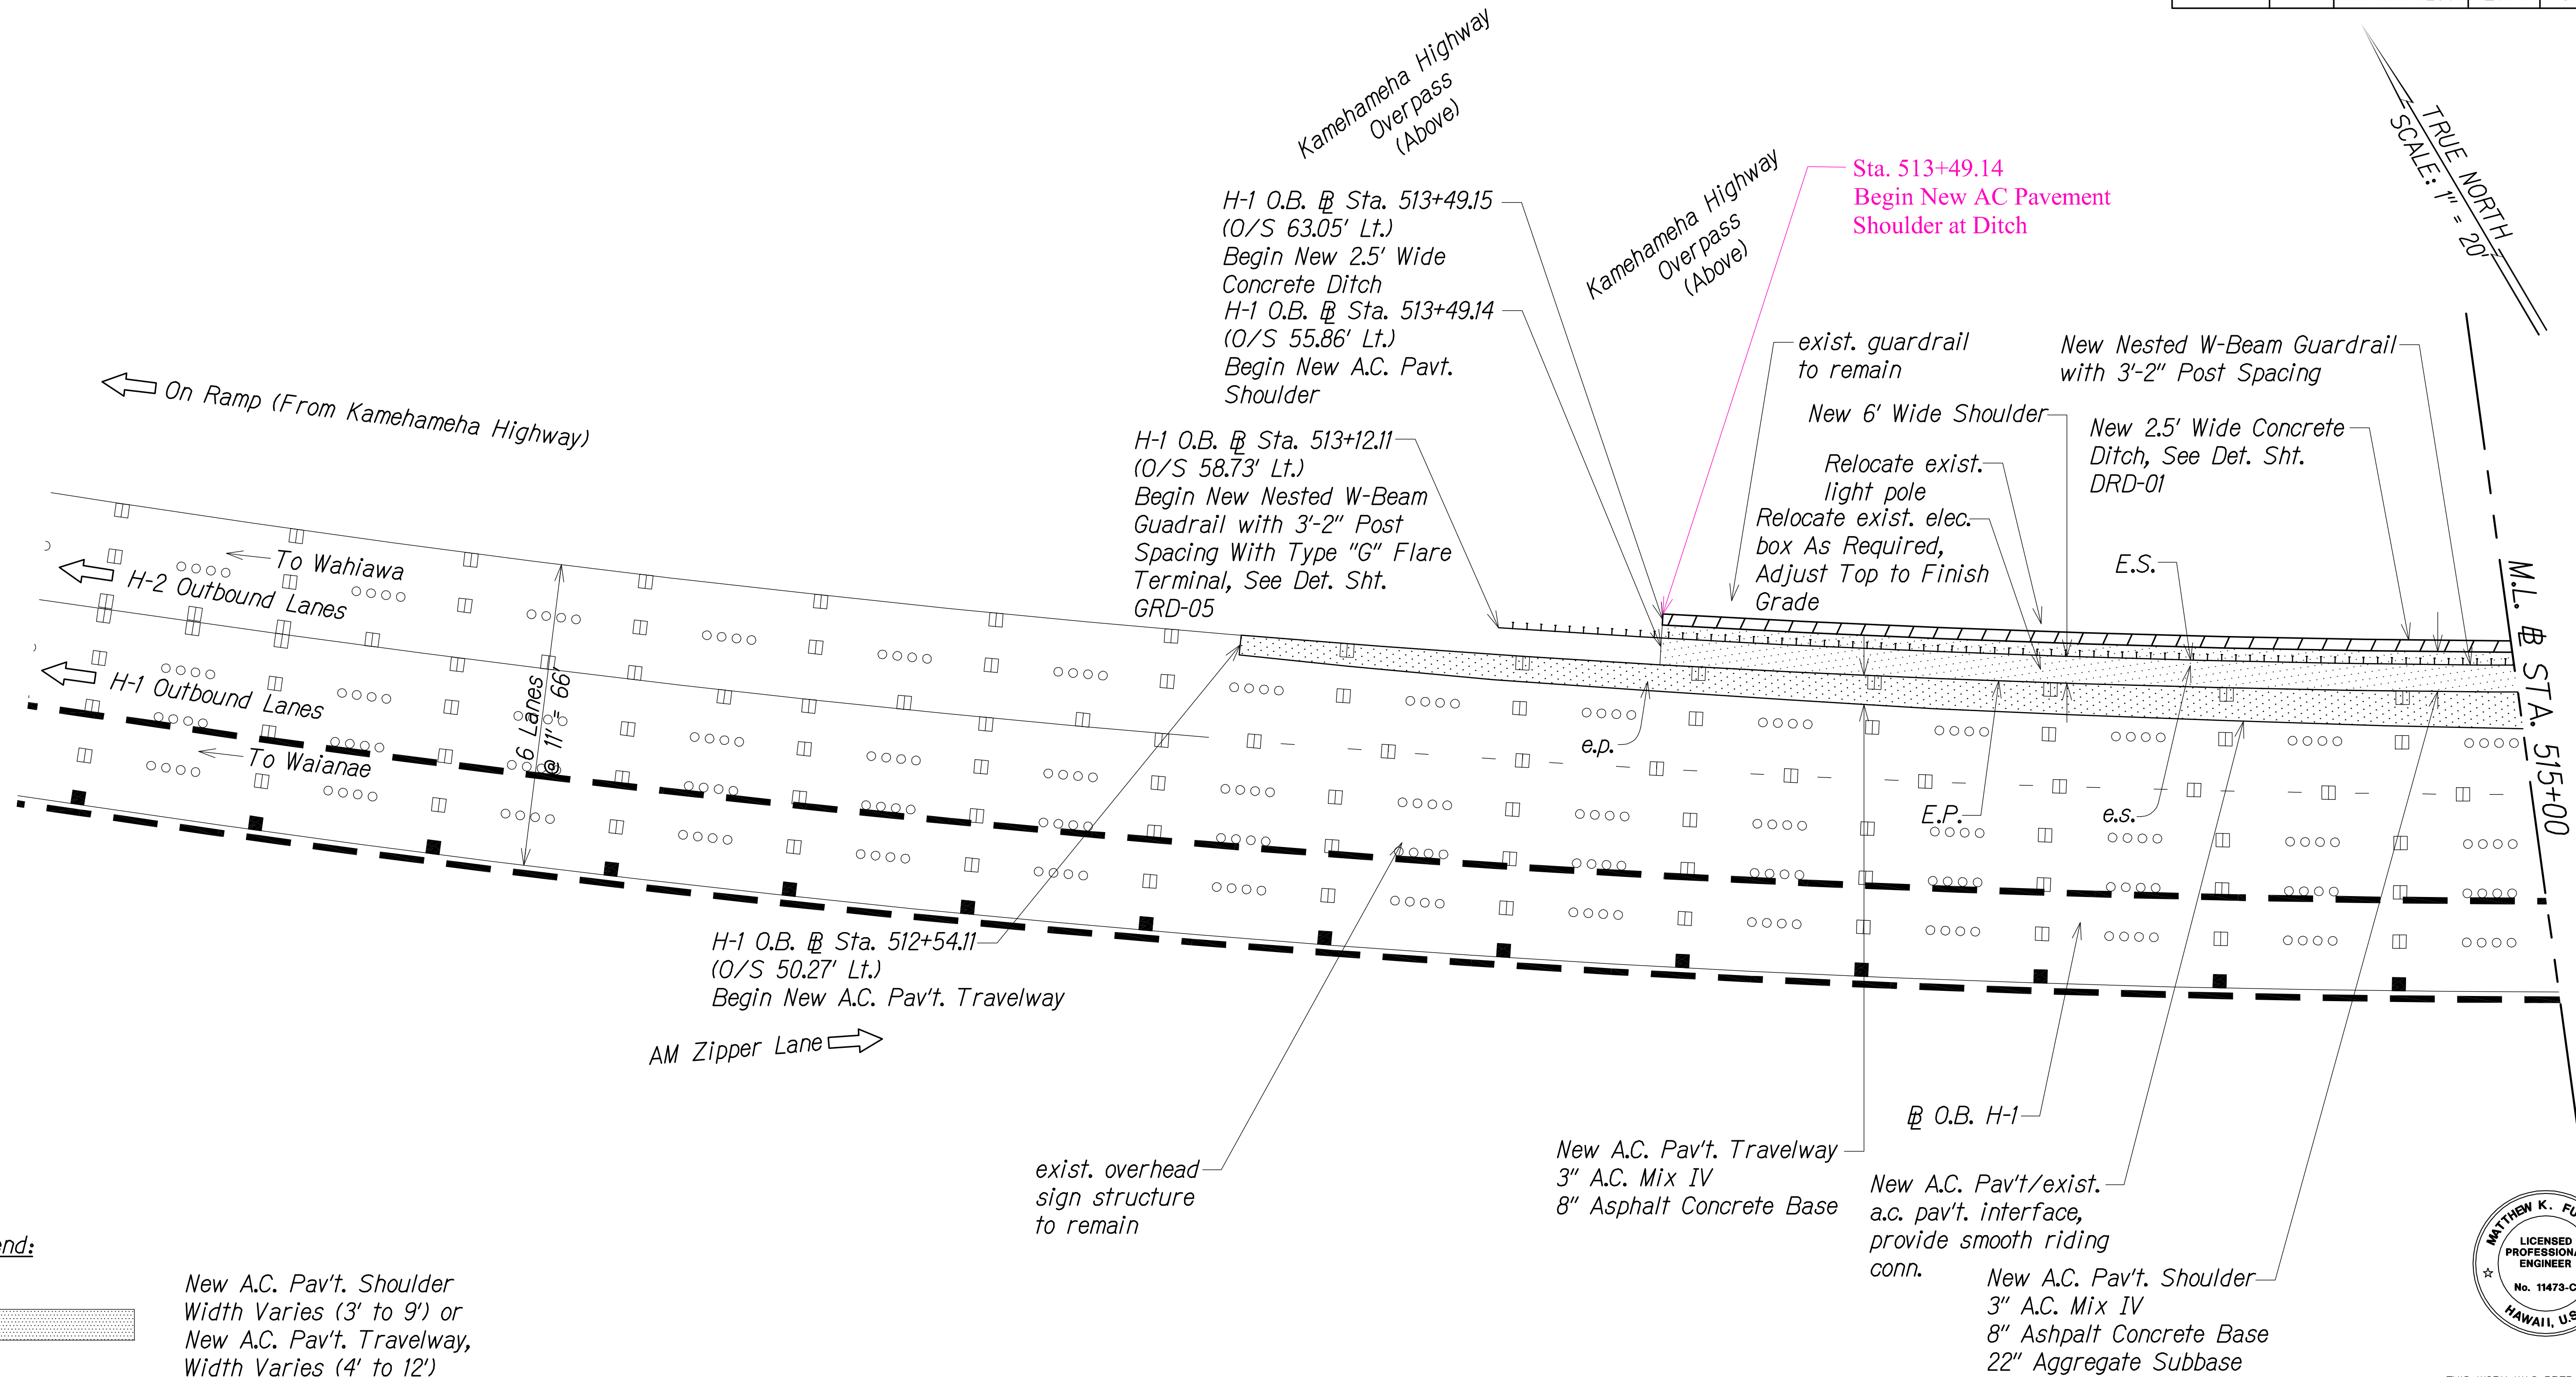

Legend:

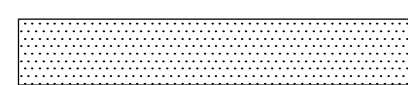

New A.C. Pav't. Shoulder
Width Varies (3' to 9') or
New A.C. Pav't. Travelway,
Width Varies (4' to 12')



New Concrete Ditch

e.p.

Edge of exist. pavement

e.s.

Edge of exist. shoulder


E.P.

Edge of Pavement

E.S.

Edge of Shoulder


Graphic Scale

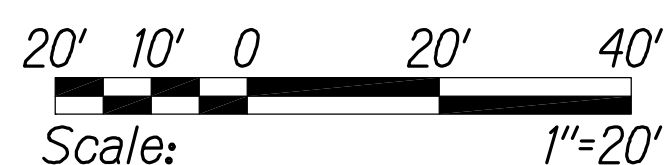

ROADWAY PLAN
@ STA. 510+00 TO @ STA. 515+00
Scale: 1" = 20'

LEGEND FOR
AS-BUILT POSTINGS

- Squiggly line for as-built deletion
- Double line for as-built deletion
- Roadway Text for as-built posting

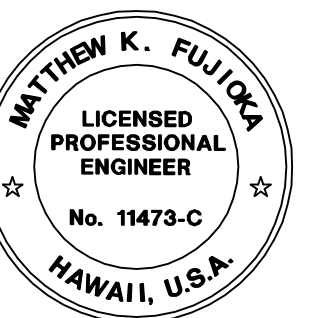

THIS WORK WAS PREPARED BY ME
OR UNDER MY SUPERVISION.
Matthew K. Fujita
APRIL 30, 2016
WILSON OKAMOTO CORPORATION LIC. EXP. DATE

STATE OF HAWAII
DEPARTMENT OF TRANSPORTATION
HIGHWAYS DIVISION


DETAILED ROADWAY PLAN

INTERSTATE ROUTE H-1
PM CONTRAFLOW LANE, PHASE 3
FEDERAL AID PROJECT NO. NH-H1-1 (260)
Scale: 1" = 20' Date: December, 2014

SHEET No. RWP-30 OF 40 SHEETS

"AS-BUILT"


FED. ROAD DIST. NO.	STATE	FED. AID PROJ. NO.	FISCAL YEAR	SHEET NO.	TOTAL SHEETS
HAWAII	HAW.	NH-H1-1 (260)	2014	52	200

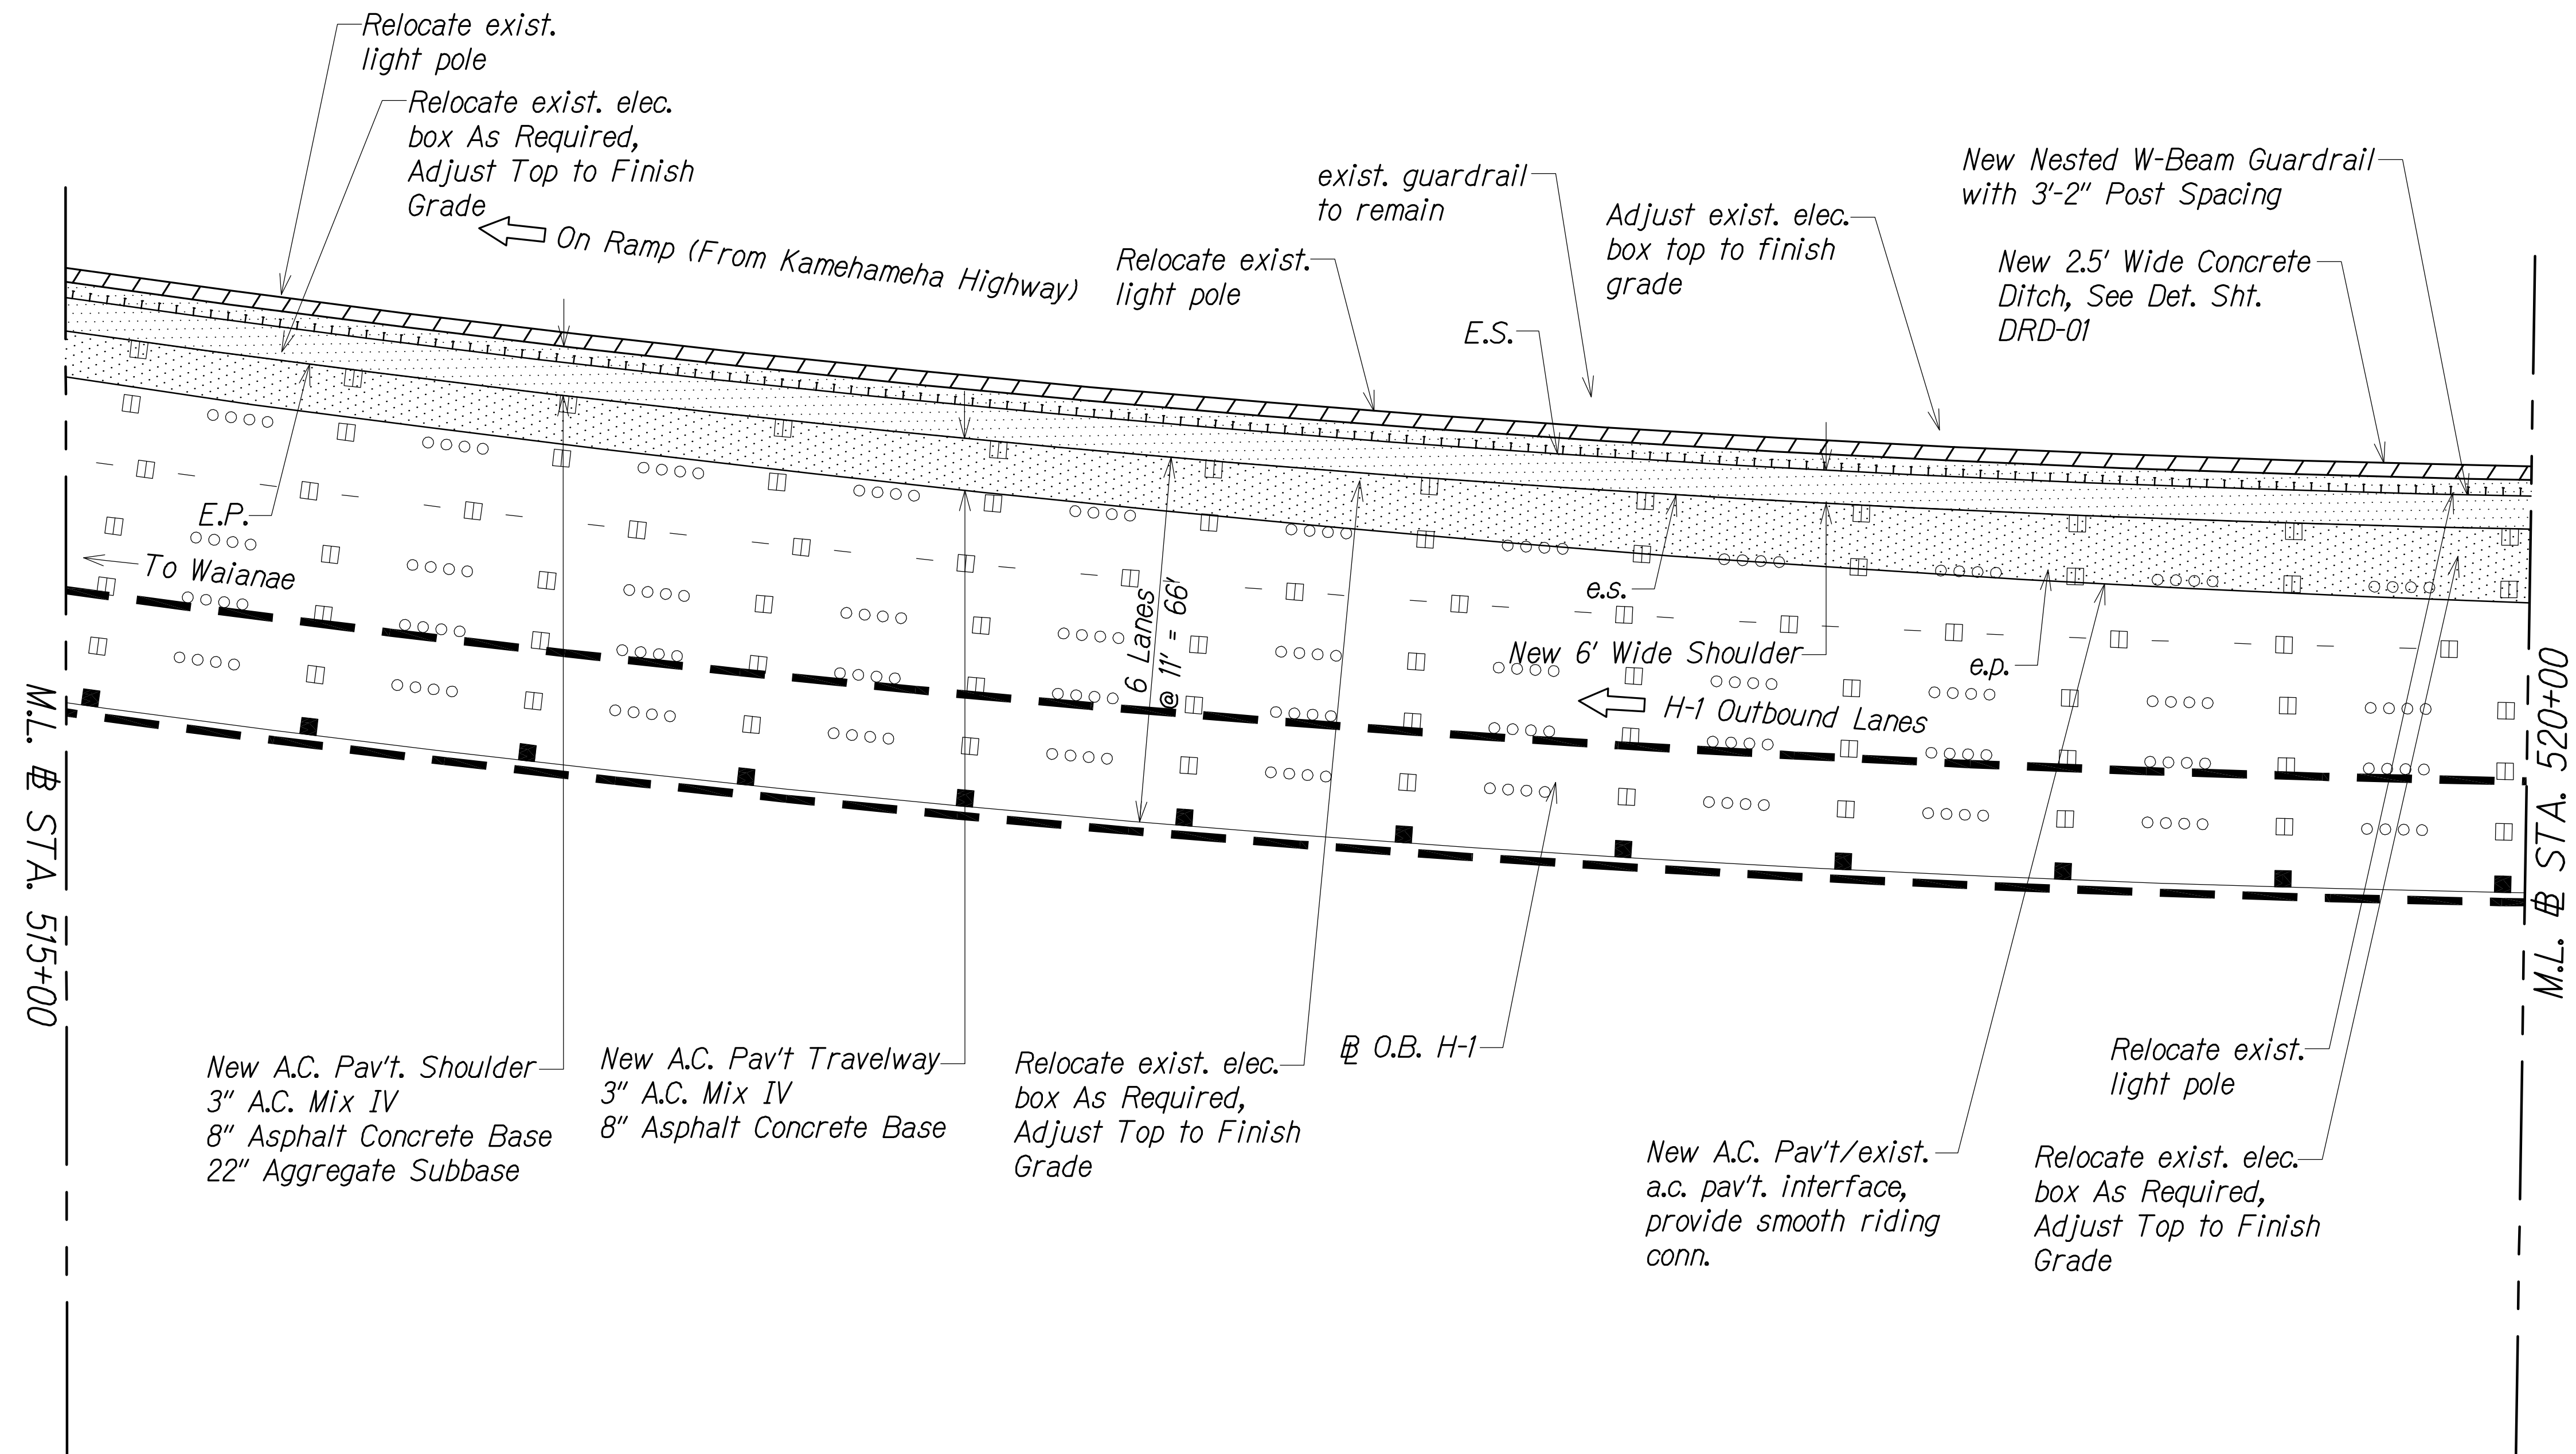

Legend:


- New A.C. Pav't. Shoulder Width Varies (3' to 9') or New A.C. Pav't. Travelway, Width Varies (4' to 12')
- New Concrete Ditch
- e.p. Edge of exist. pavement
- e.s. Edge of exist. shoulder
- E.P. Edge of Pavement
- E.S. Edge of Shoulder

Graphic Scale

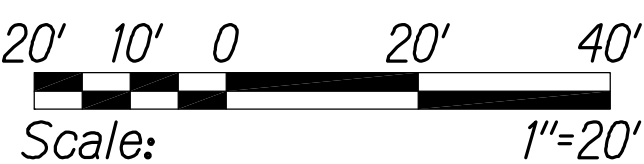

ROADWAY PLAN
STA. 515+00 TO # STA. 520+00
Scale: 1" = 20'

- LEGEND FOR AS-BUILT POSTINGS
- Squiggly line for as-built deletion
 - Double line for as-built deletion
 - Roadway Text for as-built posting

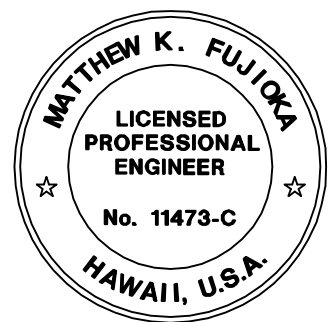

THIS WORK WAS PREPARED BY ME OR UNDER MY SUPERVISION.
Matthew K. Fujioa
APRIL 30, 2016
WILSON OKAMOTO CORPORATION LIC. EXP. DATE

STATE OF HAWAII
DEPARTMENT OF TRANSPORTATION
HIGHWAYS DIVISION


DETAILED ROADWAY PLAN

INTERSTATE ROUTE H-1
PM CONTRAFLOW LANE, PHASE 3
FEDERAL AID PROJECT NO. NH-H1-1 (260)
Scale: 1" = 20' Date: December, 2014

SHEET No. RWP-31 OF 40 SHEETS

"AS-BUILT"

FED. ROAD DIST. NO.	STATE	FED. AID PROJ. NO.	FISCAL YEAR	SHEET NO.	TOTAL SHEETS
HAWAII	HAW.	NH-H1-1 (260)	2014	53	200

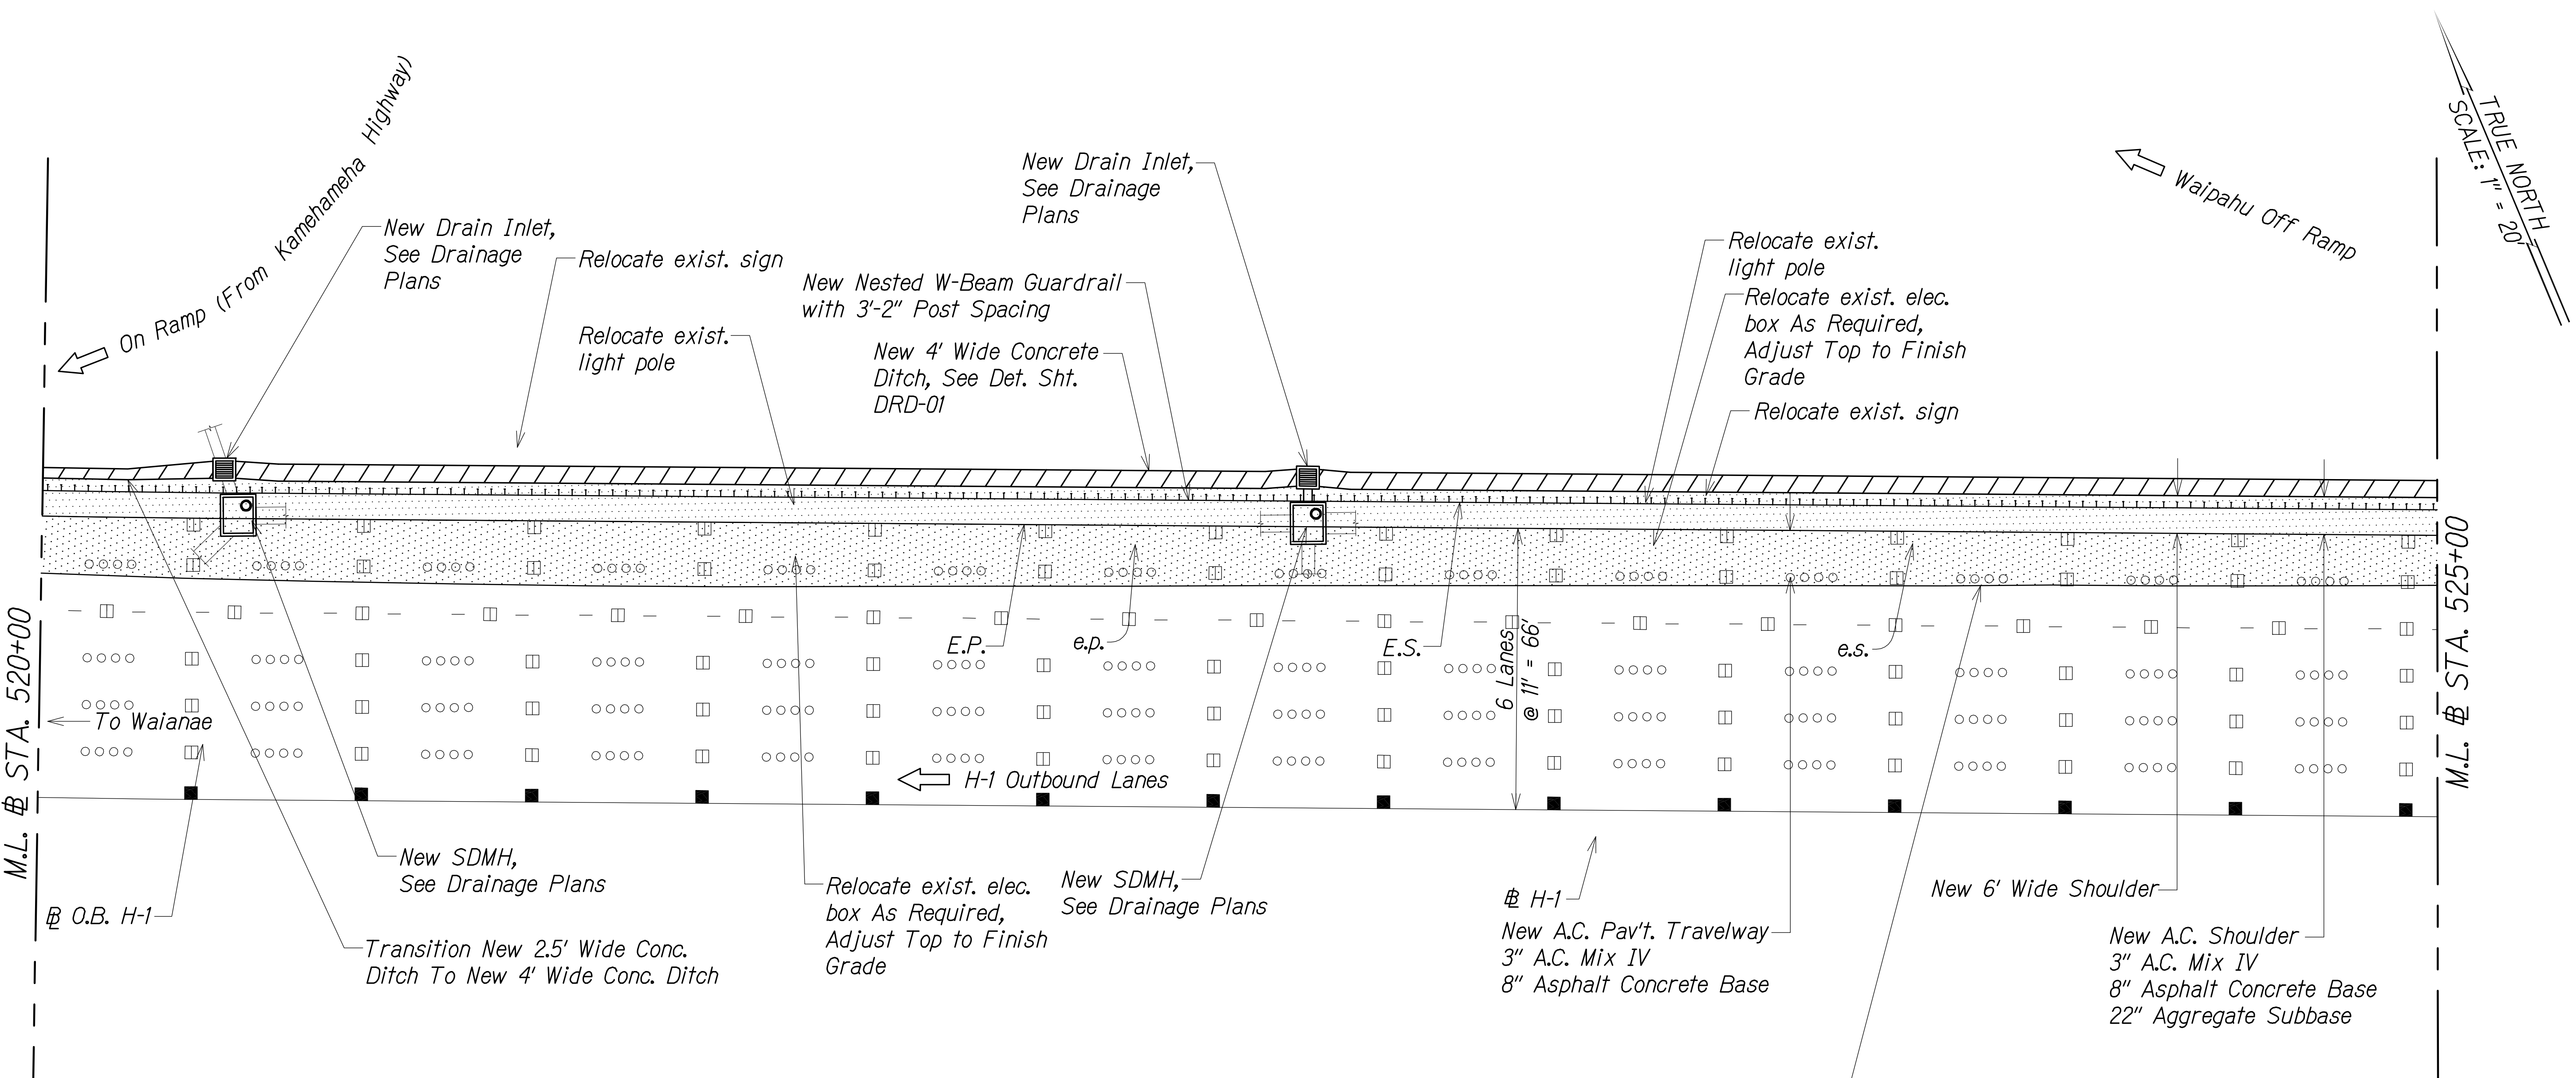


QC/QA REVIEW	100%	DATE	JUL 12, 2015
BY			
BY			
BY			

ORIGINAL PLAN	DATE
DESIGNED BY	
TRACED BY	
DESIGNED BY	
QUANTITIES BY	
CHECKED BY	

Legend:

- New A.C. Pav't. Shoulder
Width Varies (3' to 9') or
New A.C. Pav't. Travelway,
Width Varies (4' to 12')
- New Concrete Swale
- e.p. Edge of exist. pavement
- e.s. Edge of exist. shoulder
- E.P. Edge of Pavement
- E.S. Edge of Shoulder

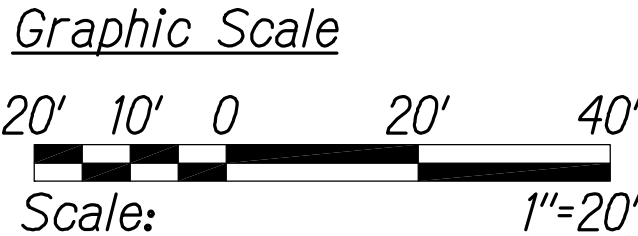

ROADWAY PLAN
STA. 520+00 TO # STA. 525+00
Scale: 1" = 20'

LEGEND FOR AS-BUILT POSTINGS

- Squiggly line for as-built deletion
- Double line for as-built deletion
- Roadway Text for as-built posting

THIS WORK WAS PREPARED BY ME OR UNDER MY SUPERVISION.
Matthew K. Fujimura
APRIL 30, 2016
WILSON OKAMOTO CORPORATION LIC. EXP. DATE


STATE OF HAWAII
DEPARTMENT OF TRANSPORTATION
HIGHWAYS DIVISION

DETAILED ROADWAY PLAN

INTERSTATE ROUTE H-1
PM CONTRAFLOW LANE, PHASE 3
FEDERAL AID PROJECT NO. NH-H1-1 (260)
Scale: 1" = 20' Date: December, 2014


SHEET No. RWP-32 OF 40 SHEETS

FED. ROAD DIST. NO.	STATE	FED. AID PROJ. NO.	FISCAL YEAR	SHEET NO.	TOTAL SHEETS
HAWAII	HAW.	NH-HI-1 (260)	2014	54	200

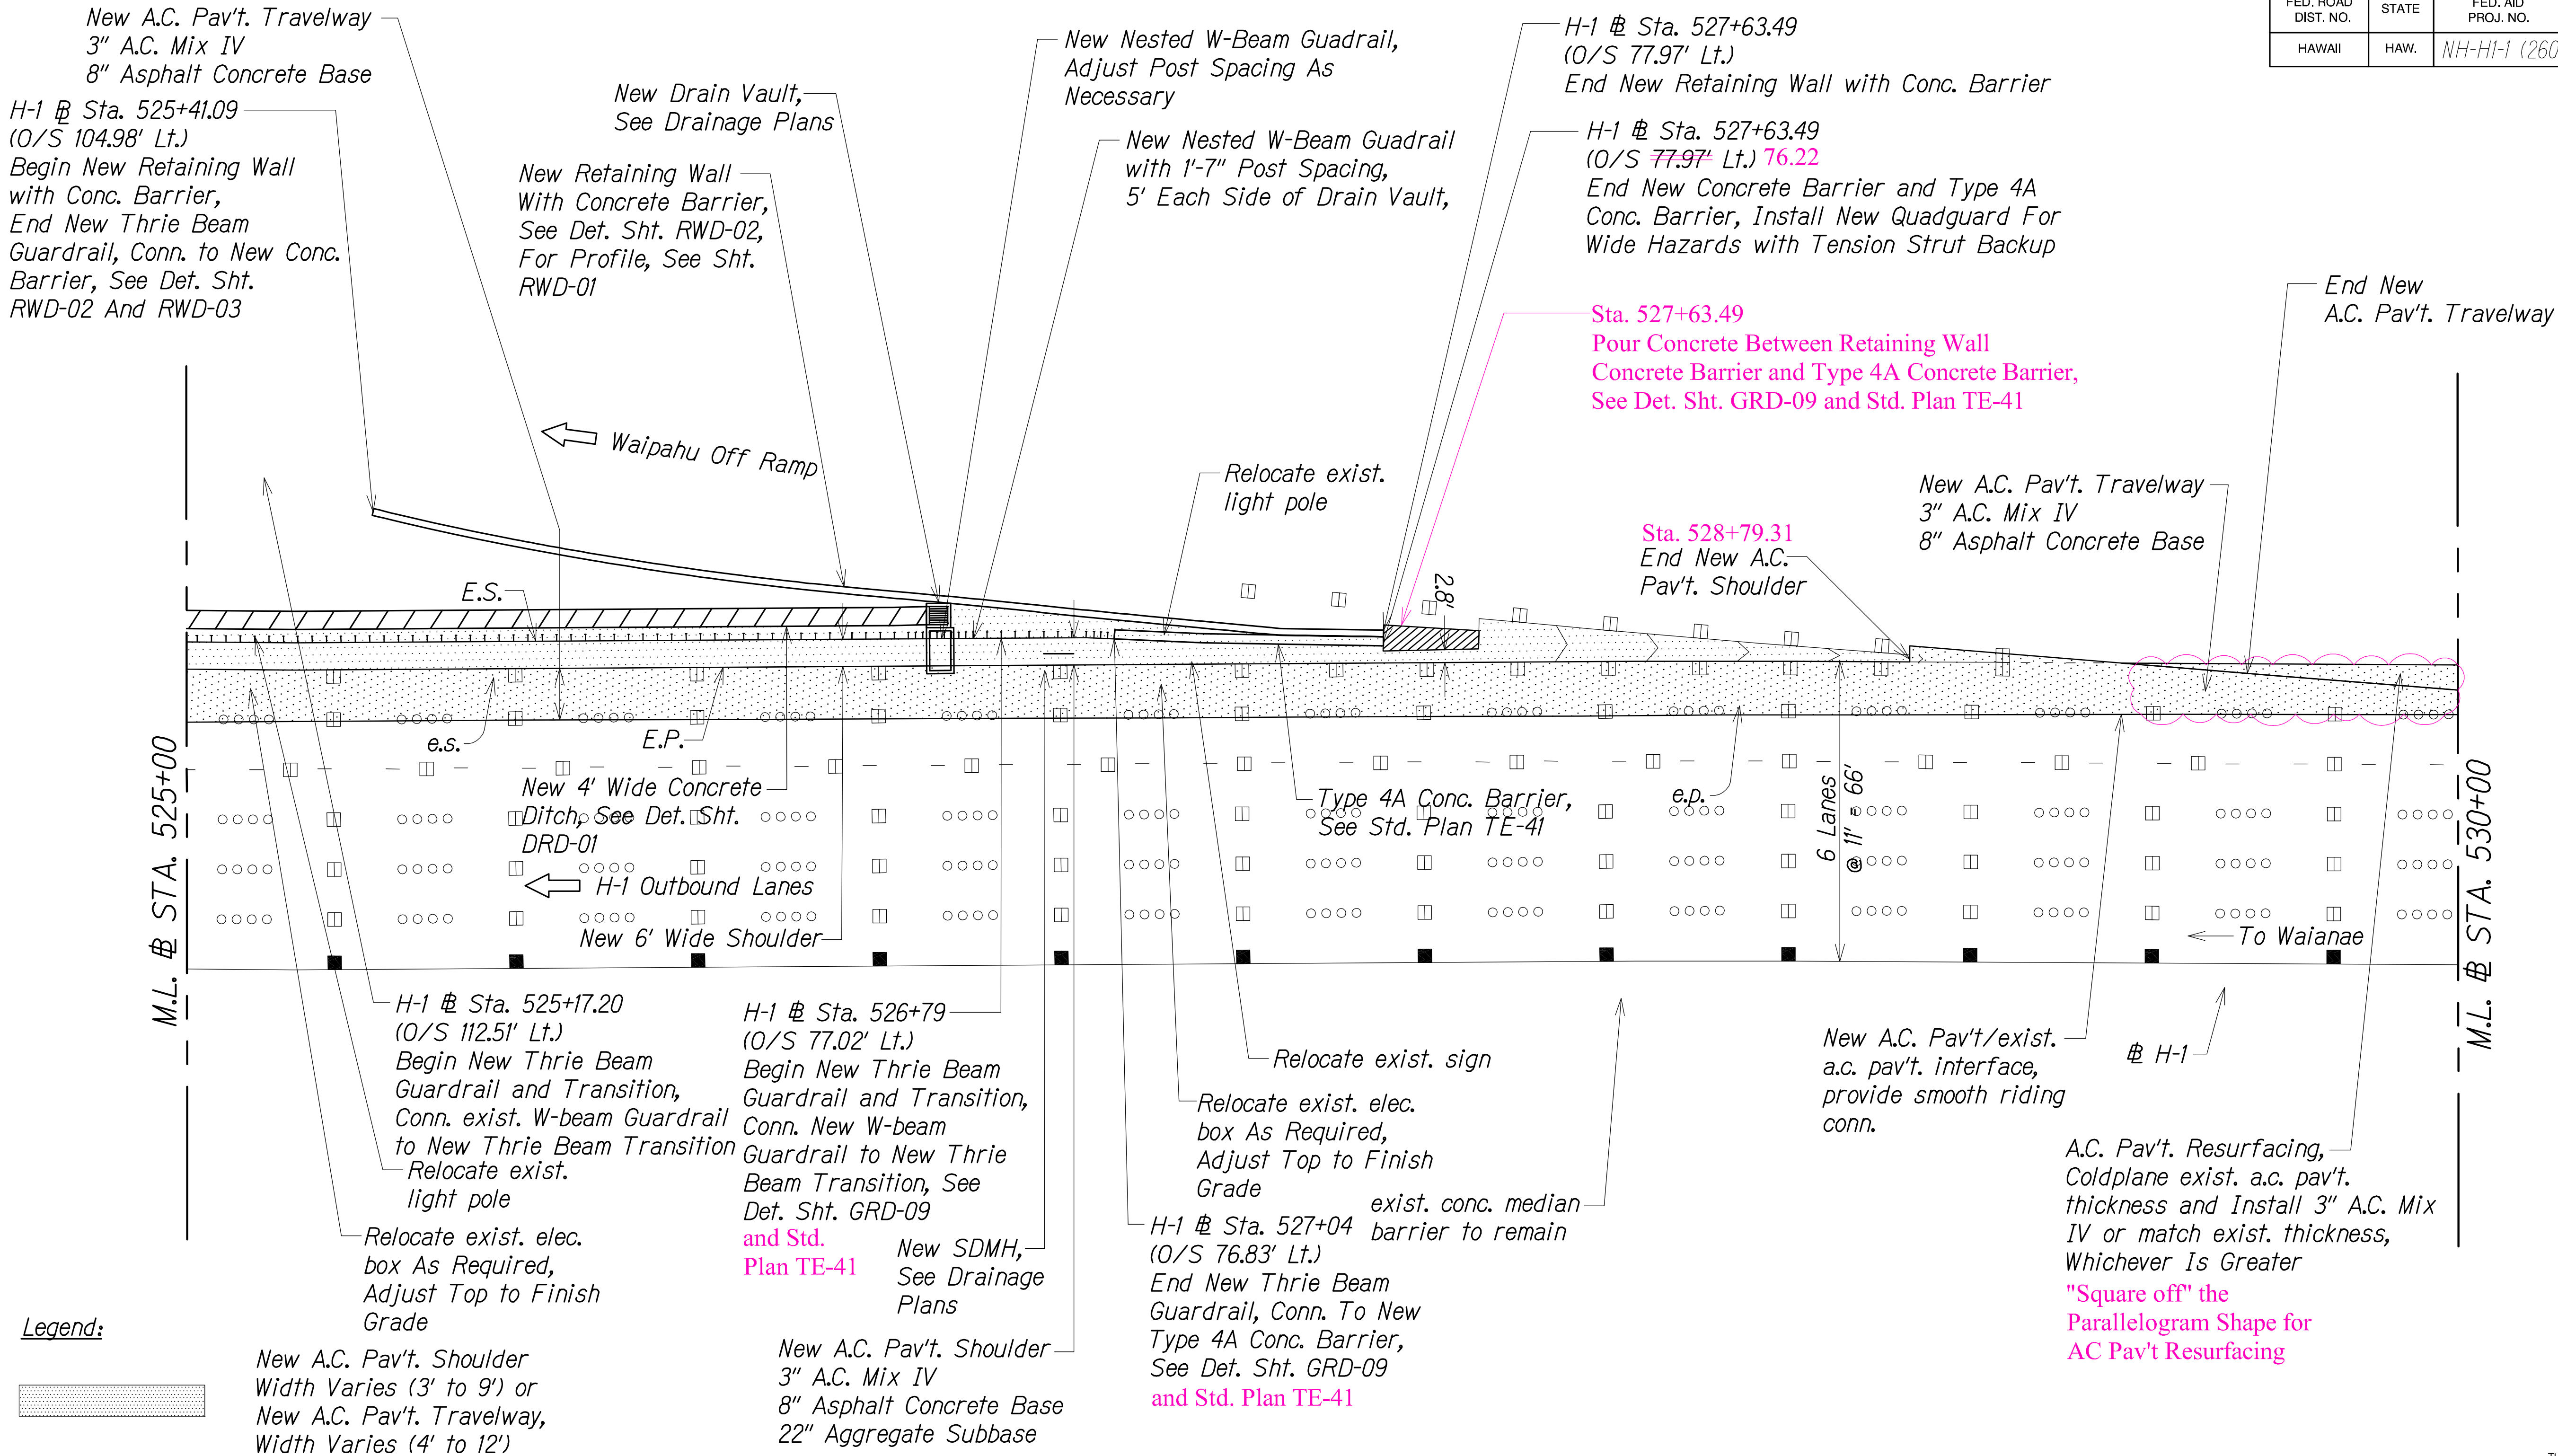

QC/QA REVIEW	100%	DATE	JUL 12, 2015
BY		BY	
BY		BY	
BY		BY	


ORIGINAL PLAN	DATE
SURVEY PLOTTED BY	
DRAWN BY	
DESIGNED BY	
QUANTITIES BY	
CHECKED BY	
No.	

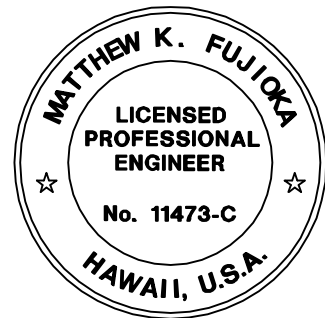


THIS WORK WAS PREPARED BY ME
OR UNDER MY SUPERVISION.
Matthew K. Fujio
APRIL 30, 2016
WILSON OKAMOTO CORPORATION LIC. EXP. DATE

FED. ROAD DIST. NO.	STATE	FED. AID PROJ. NO.	FISCAL YEAR	SHEET NO.	TOTAL SHEETS
HAWAII	HAW.	NH-HI-1 (260)	2014	55	200

TRUE NORTH
SCALE: 1" = 20'

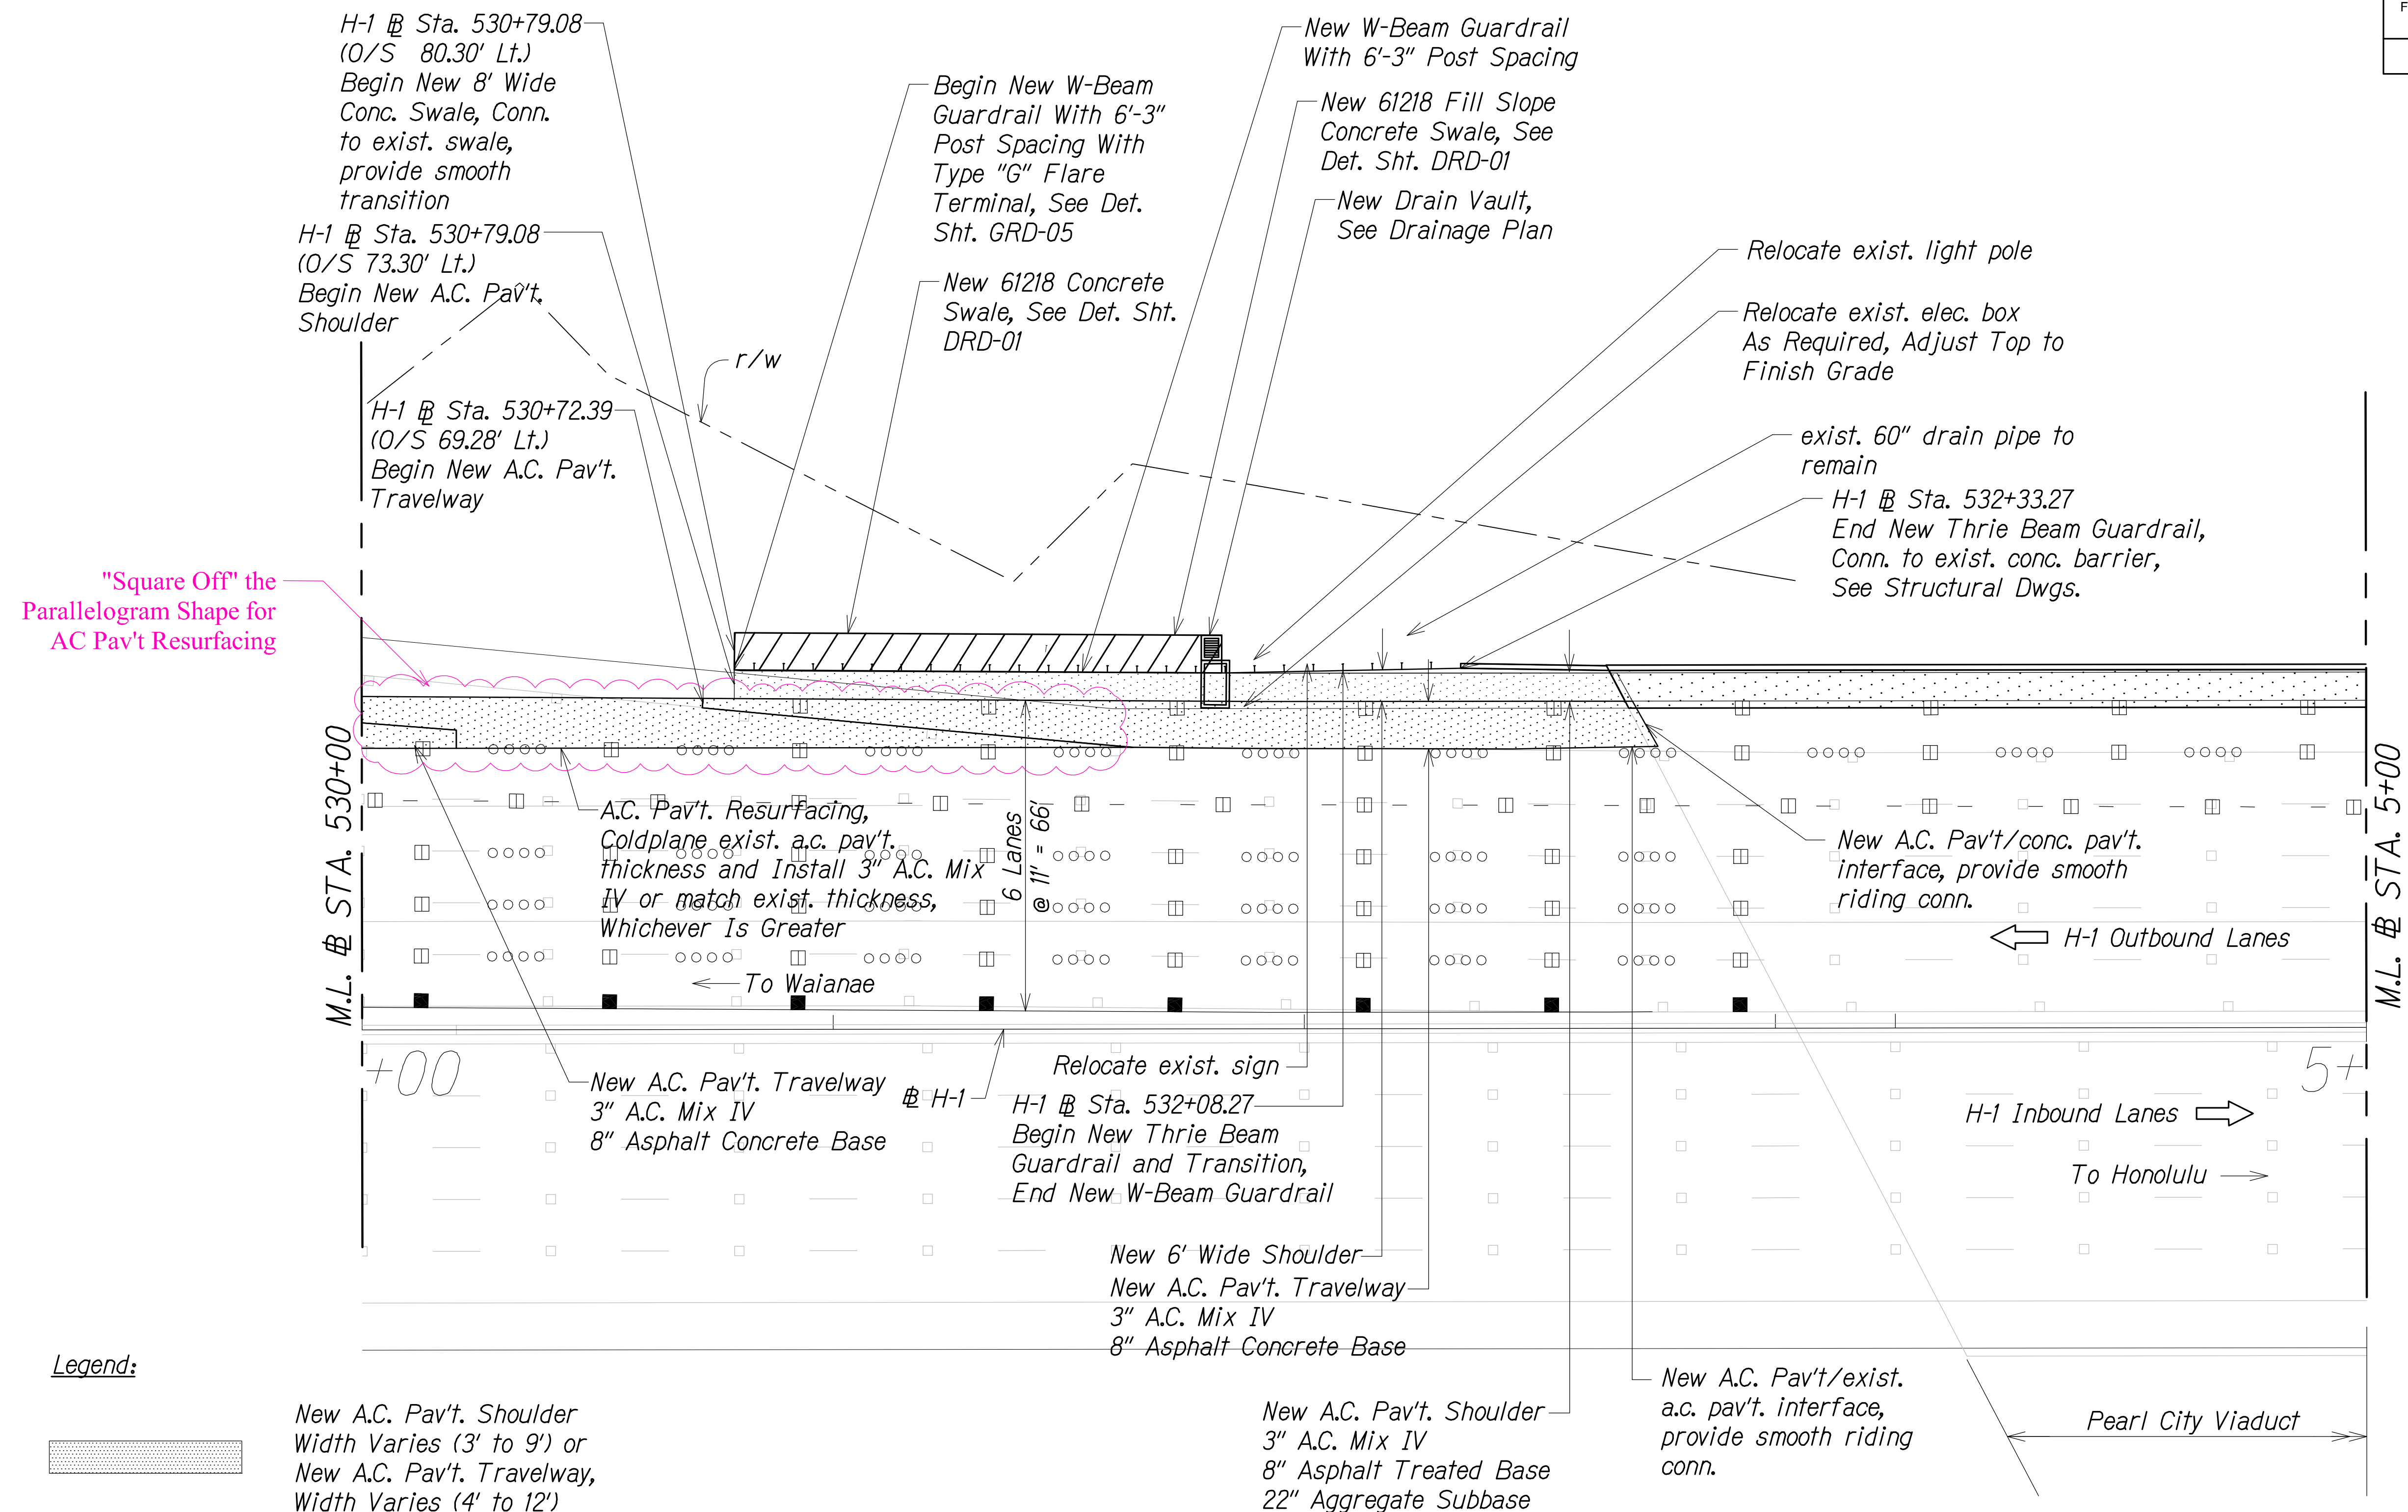

- Legend:**
- New A.C. Pav't. Shoulder
Width Varies (3' to 9') or
New A.C. Pav't. Travelway,
Width Varies (4' to 12')
 - New Concrete Swale
 - e.p. Edge of exist. pavement
 - e.s. Edge of exist. shoulder
 - E.P. Edge of Pavement
 - E.S. Edge of Shoulder

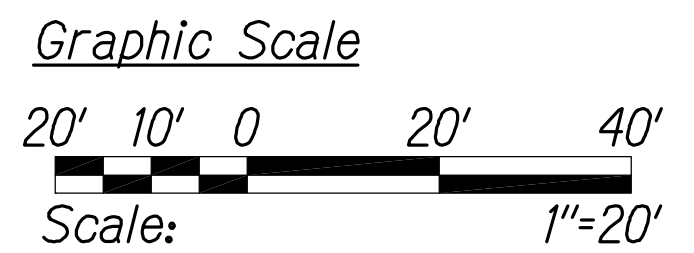

ROADWAY PLAN
± STA. 530+00 TO ± STA. 5+00
Scale: 1" = 20'

- LEGEND FOR AS-BUILT POSTINGS**
- Squiggly line for as-built deletion
 - Double line for as-built deletion
 - Roadway
 - Text for as-built posting

THIS WORK WAS PREPARED BY ME OR UNDER MY SUPERVISION.

Matthew K. Fujimura

APRIL 30, 2016
WILSON OKAMOTO CORPORATION LIC. EXP. DATE

STATE OF HAWAII
DEPARTMENT OF TRANSPORTATION
HIGHWAYS DIVISION

DETAILED ROADWAY PLAN

INTERSTATE ROUTE H-1
PM CONTRAFLOW LANE, PHASE 3
FEDERAL AID PROJECT NO. NH-HI-1 (260)


Scale: 1" = 20' Date: December, 2014

SHEET No. RWP-34 OF 40 SHEETS

QC/QA REVIEW	100%	DATE JUL 12, 2015
BY		
BY		
BY		
BY		

SURVEY PLOTTED BY	DATE
DRAWN BY	
TRACED BY	
DESIGNED BY	
QUANTITIES BY	
CHECKED BY	
ORIGINAL PLAN	
NOTE BOOK	
No.	


FED. ROAD DIST. NO.	STATE	FED. AID PROJ. NO.	FISCAL YEAR	SHEET NO.	TOTAL SHEETS
HAWAII	HAW.	NH-HI-1 (260)	2014	56	200

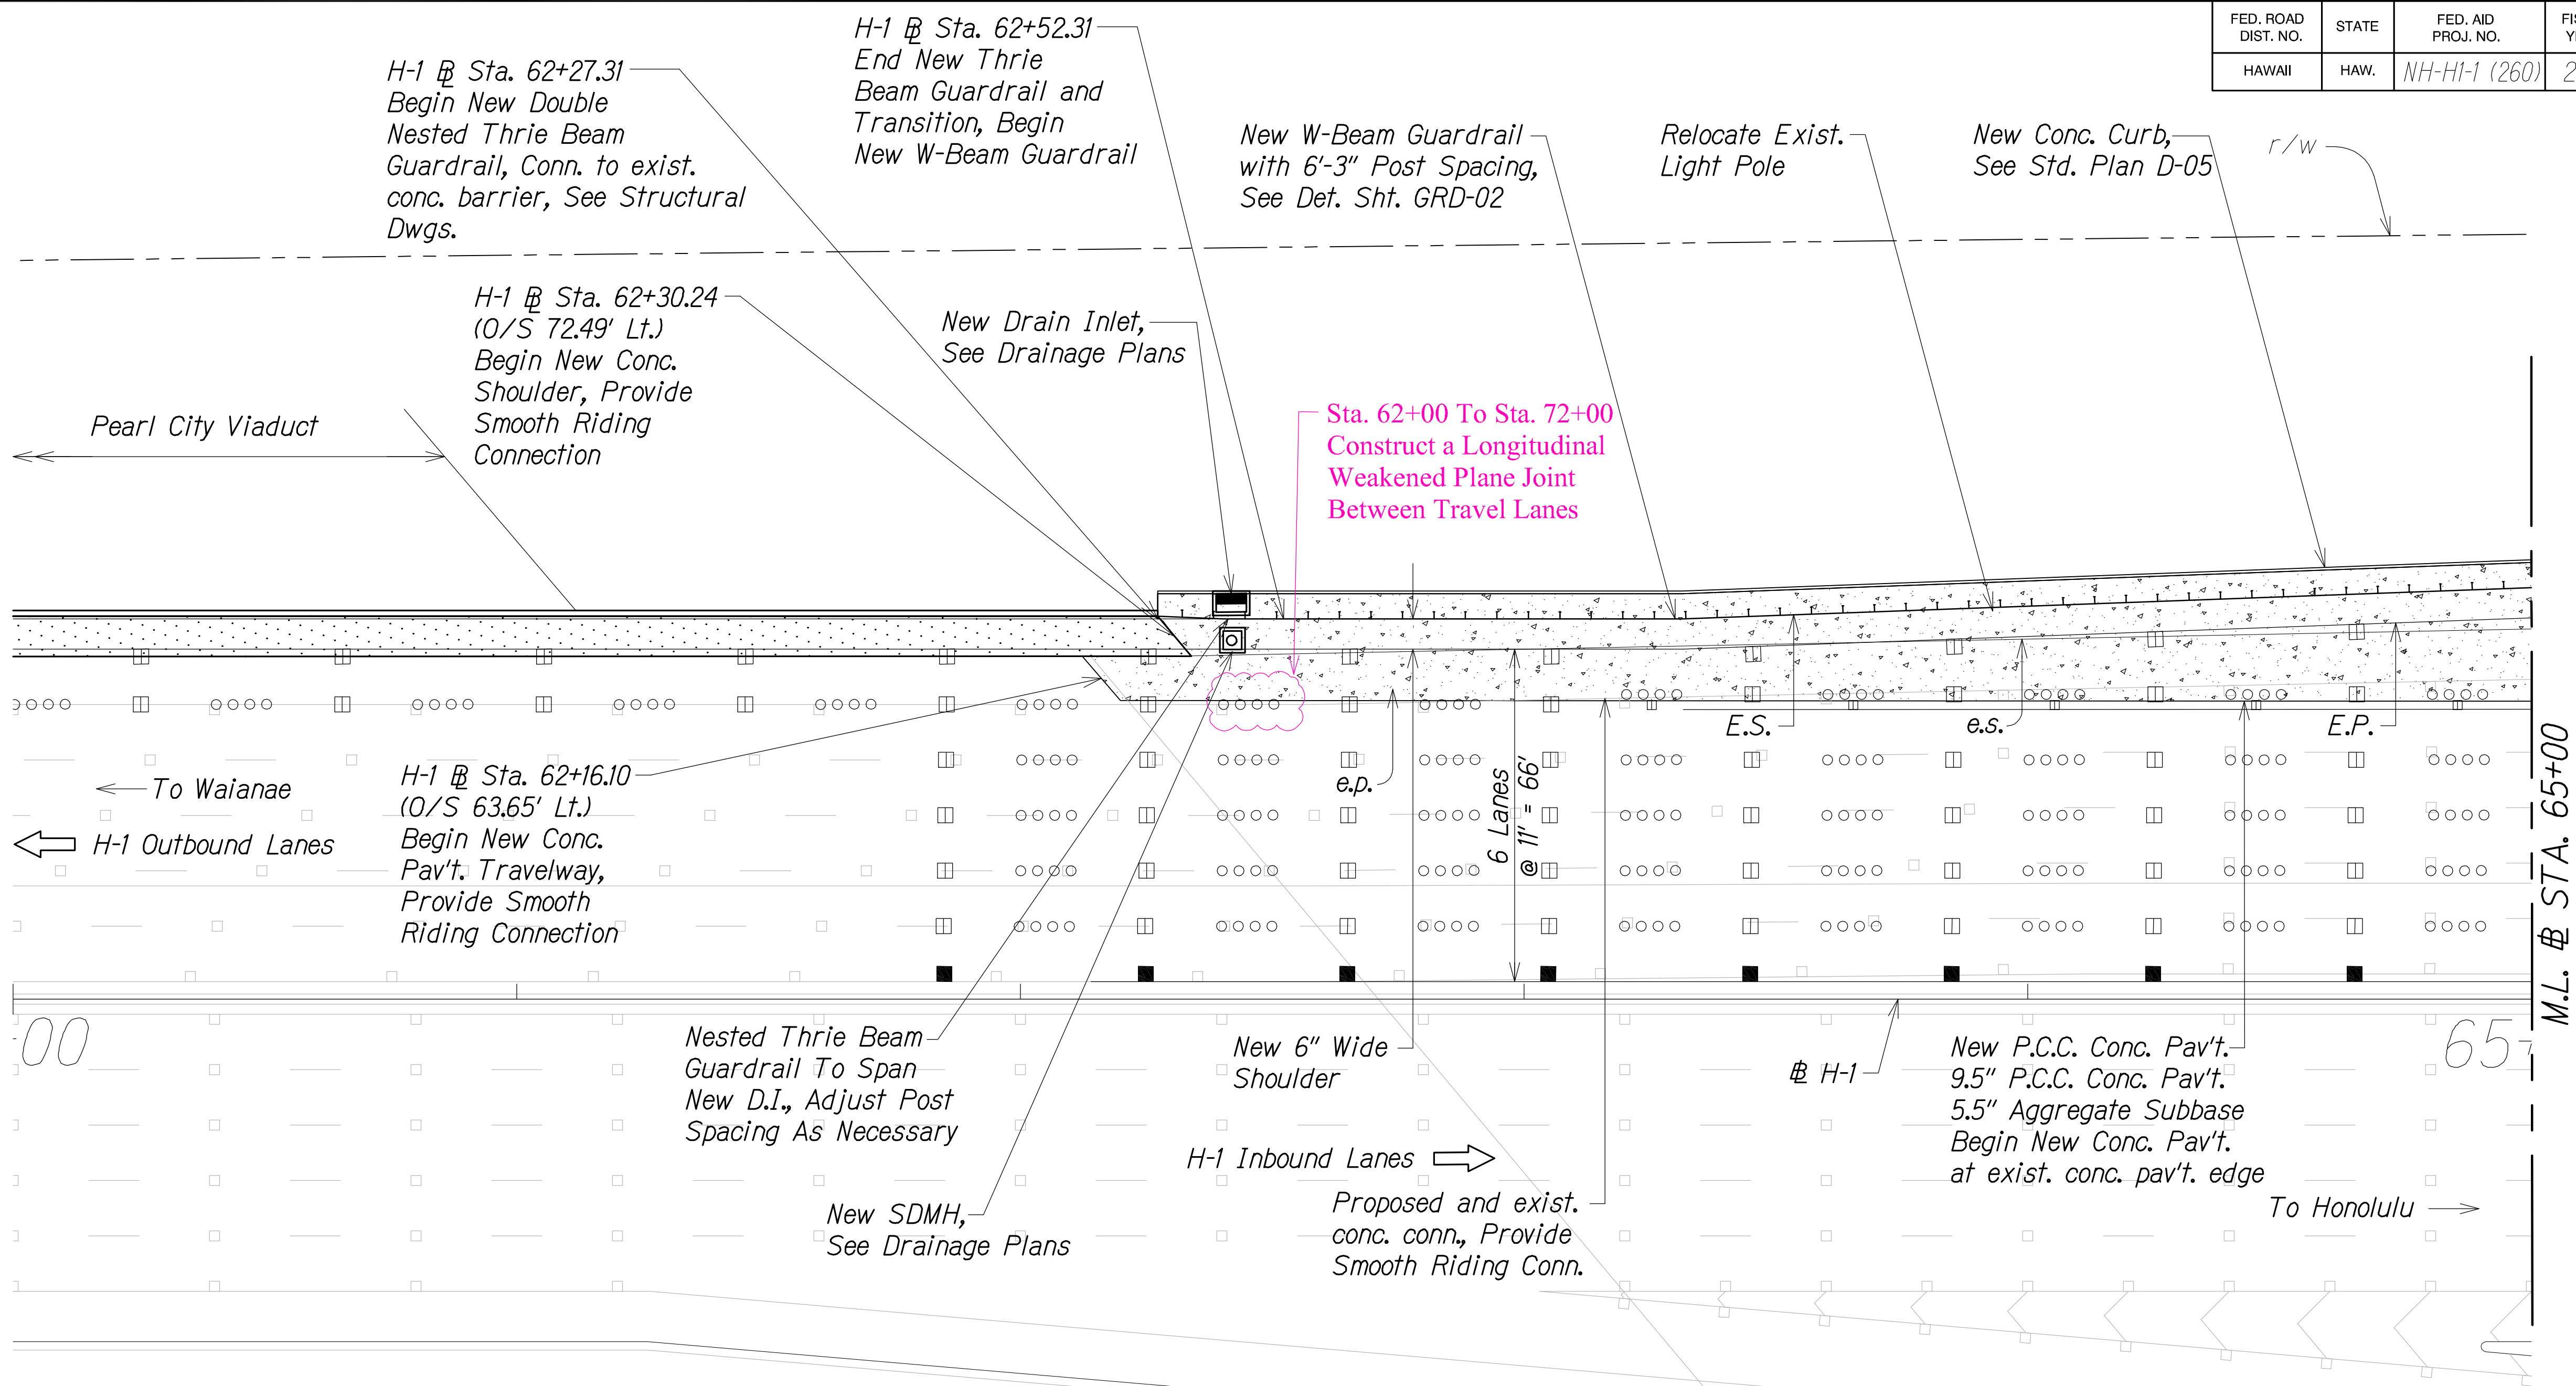

TRUE NORTH
SCALE: 1" = 20'

Legend:

- New P.C.C. Concrete Pav't.
- e.p. Edge of exist. pavement
- e.s. Edge of exist. shoulder
- E.P. Edge of Pavement
- E.S. Edge of Shoulder

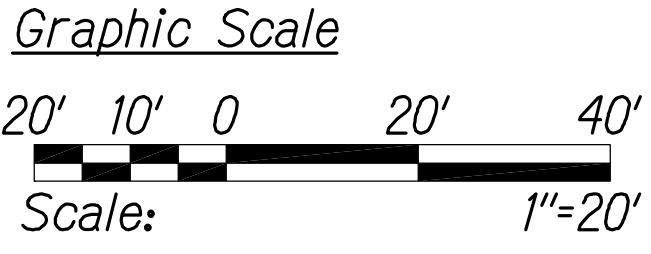

ROADWAY PLAN
STA. 60+00 TO # STA. 65+00
Scale: 1" = 20'

LEGEND FOR AS-BUILT POSTINGS

- Squiggly line for as-built deletion
- Double line for as-built deletion
- Roadway Text for as-built posting

STATE OF HAWAII
DEPARTMENT OF TRANSPORTATION
HIGHWAYS DIVISION

DETAILED ROADWAY PLAN

INTERSTATE ROUTE H-1
PM CONTRAFLOW LANE, PHASE 3
FEDERAL AID PROJECT NO. NH-HI-1 (260)
Scale: 1" = 20' Date: December, 2014

SHEET No. RWP-35 OF 40 SHEETS




THIS WORK WAS PREPARED BY ME OR UNDER MY SUPERVISION.
Matthew K. Fujio
WILSON OKAMOTO CORPORATION LIC. EXP. DATE

QC/QA REVIEW	100%	DATE	JUL 12, 2015
BY			
BY			
BY			
BY			

SURVEY PLOTTED BY	DATE
DRAWN BY	
TRACED BY	
DESIGNED BY	
QUANTITIES BY	
CHECKED BY	
ORIGINAL PLAN	
NOTE BOOK	
No.	


FED. ROAD DIST. NO.	STATE	FED. AID PROJ. NO.	FISCAL YEAR	SHEET NO.	TOTAL SHEETS
HAWAII	HAW.	NH-HI-1 (260)	2014	57	200

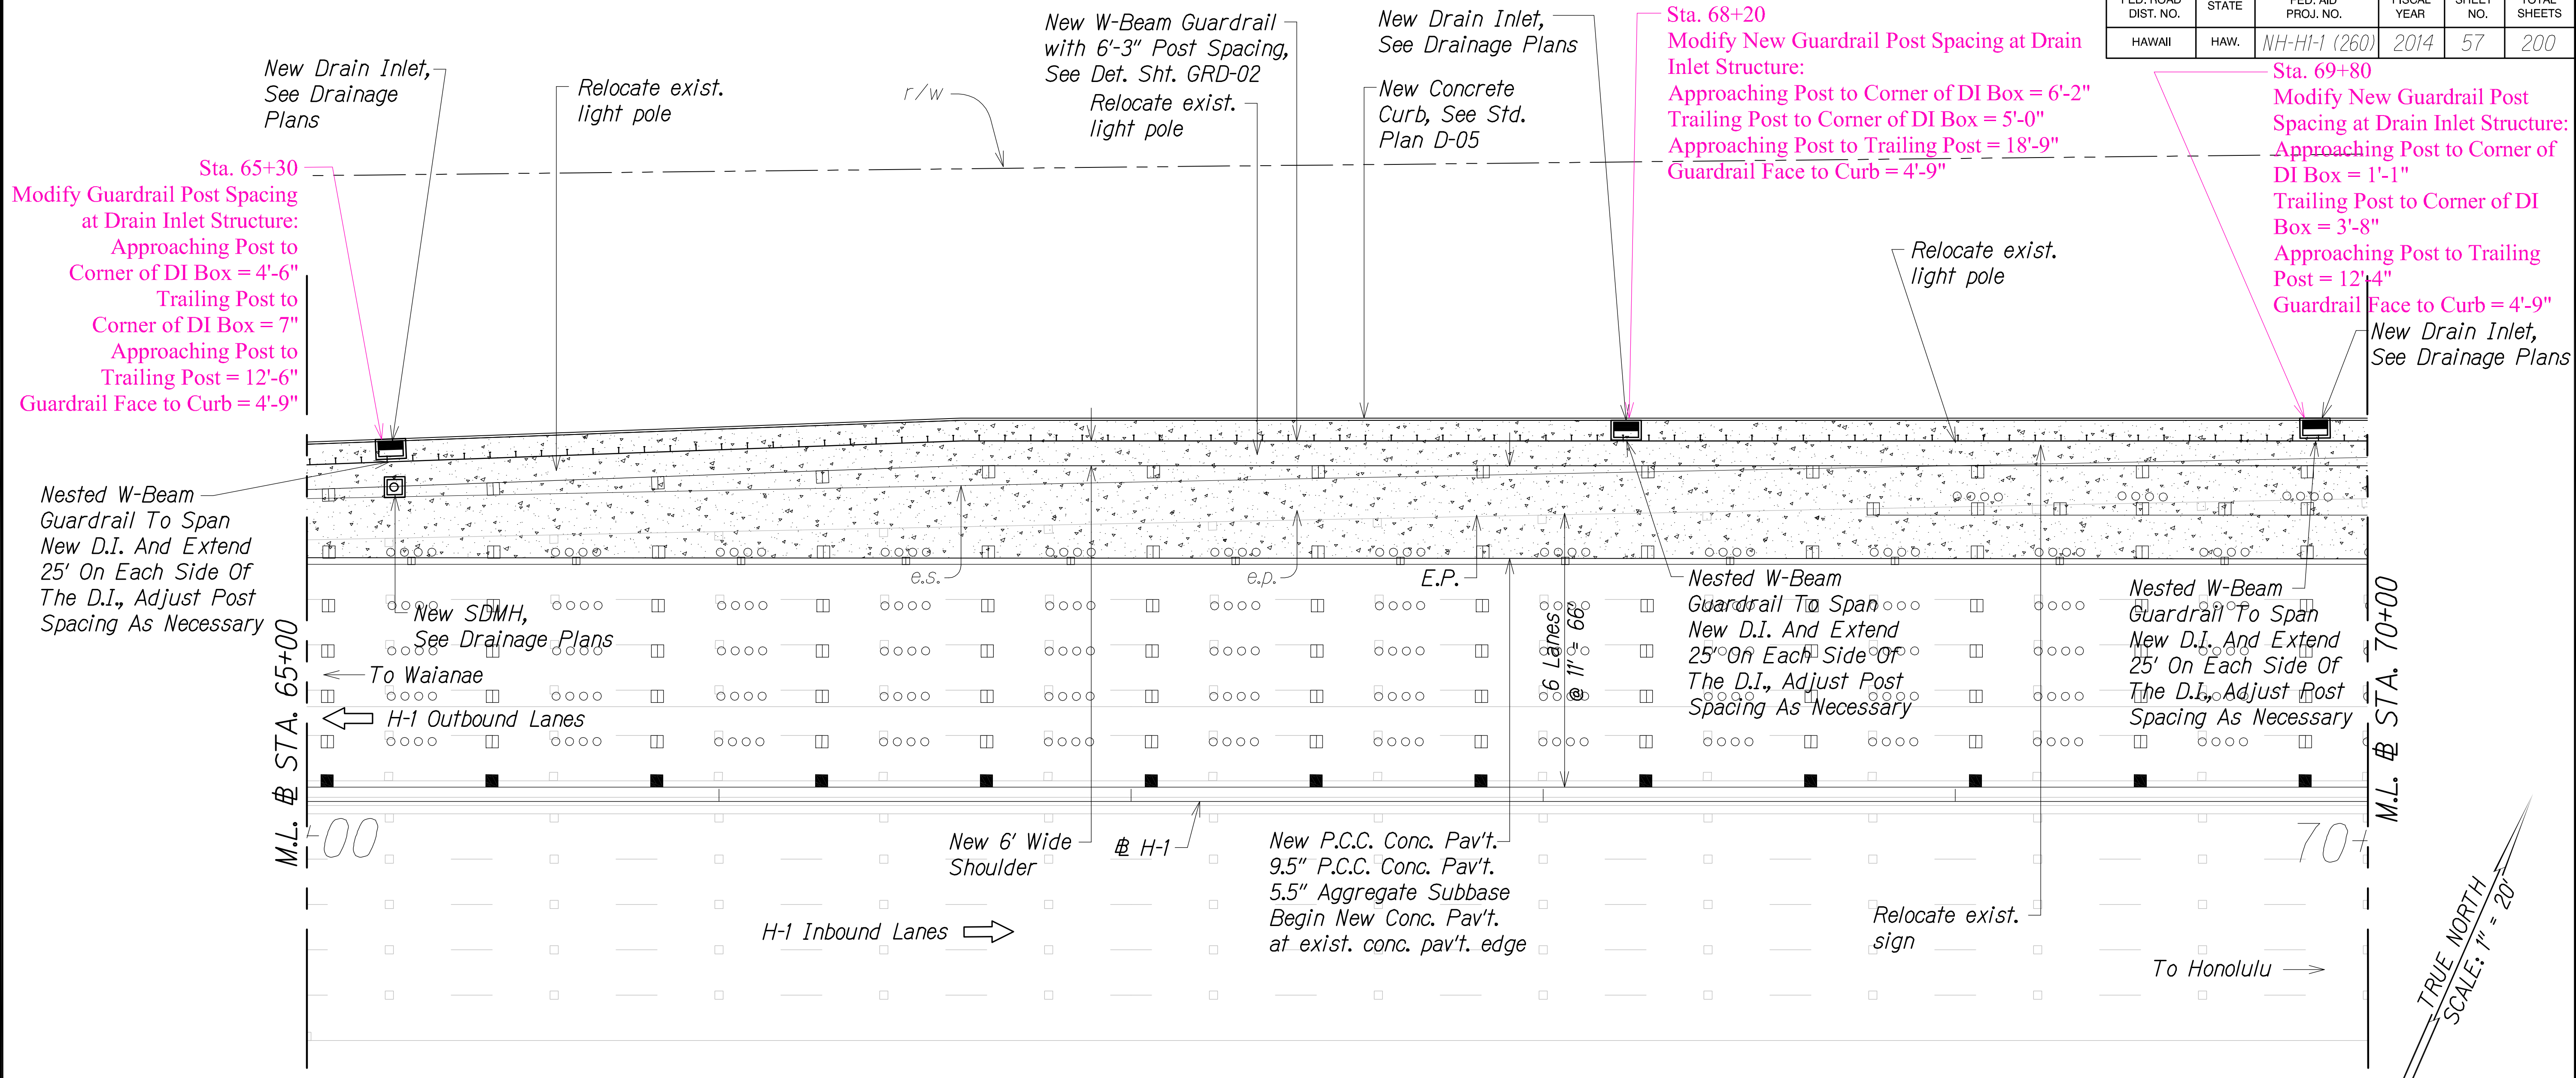

QC/QA REVIEW	100%	DATE	JUL 12, 2015
BY		BY	
BY		BY	
BY		BY	

ORIGINAL PLAN	DATE
NOTE BOOK	
DESIGNED BY	
QUANTITIES BY	
CHECKED BY	

- Legend:**
- New P.C.C. Concrete Pav't.
 - e.p.* Edge of exist. pavement
 - e.s.* Edge of exist. shoulder
 - E.P.* Edge of Pavement
 - E.S.* Edge of Shoulder

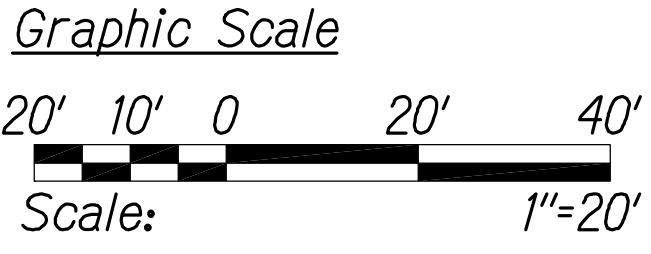

ROADWAY PLAN
STA. 65+00 TO # STA. 70+00
Scale: 1" = 20'

LEGEND FOR AS-BUILT POSTINGS	
	Squiggly line for as-built deletion
	Double line for as-built deletion
Roadway	Text for as-built posting



THIS WORK WAS PREPARED BY ME OR UNDER MY SUPERVISION.
Matthew K. Fujioa
APRIL 30, 2016
WILSON OKAMOTO CORPORATION LIC. EXP. DATE


STATE OF HAWAII
DEPARTMENT OF TRANSPORTATION
HIGHWAYS DIVISION

DETAILED ROADWAY PLAN

INTERSTATE ROUTE H-1
PM CONTRAFLOW LANE, PHASE 3
FEDERAL AID PROJECT NO. NH-HI-1 (260)
Scale: 1" = 20' Date: December, 2014

SHEET No. RWP-36 OF 40 SHEETS


FED. ROAD DIST. NO.	STATE	FED. AID PROJ. NO.	FISCAL YEAR	SHEET NO.	TOTAL SHEETS
HAWAII	HAW.	NH-HI-1 (260)	2014	58	200

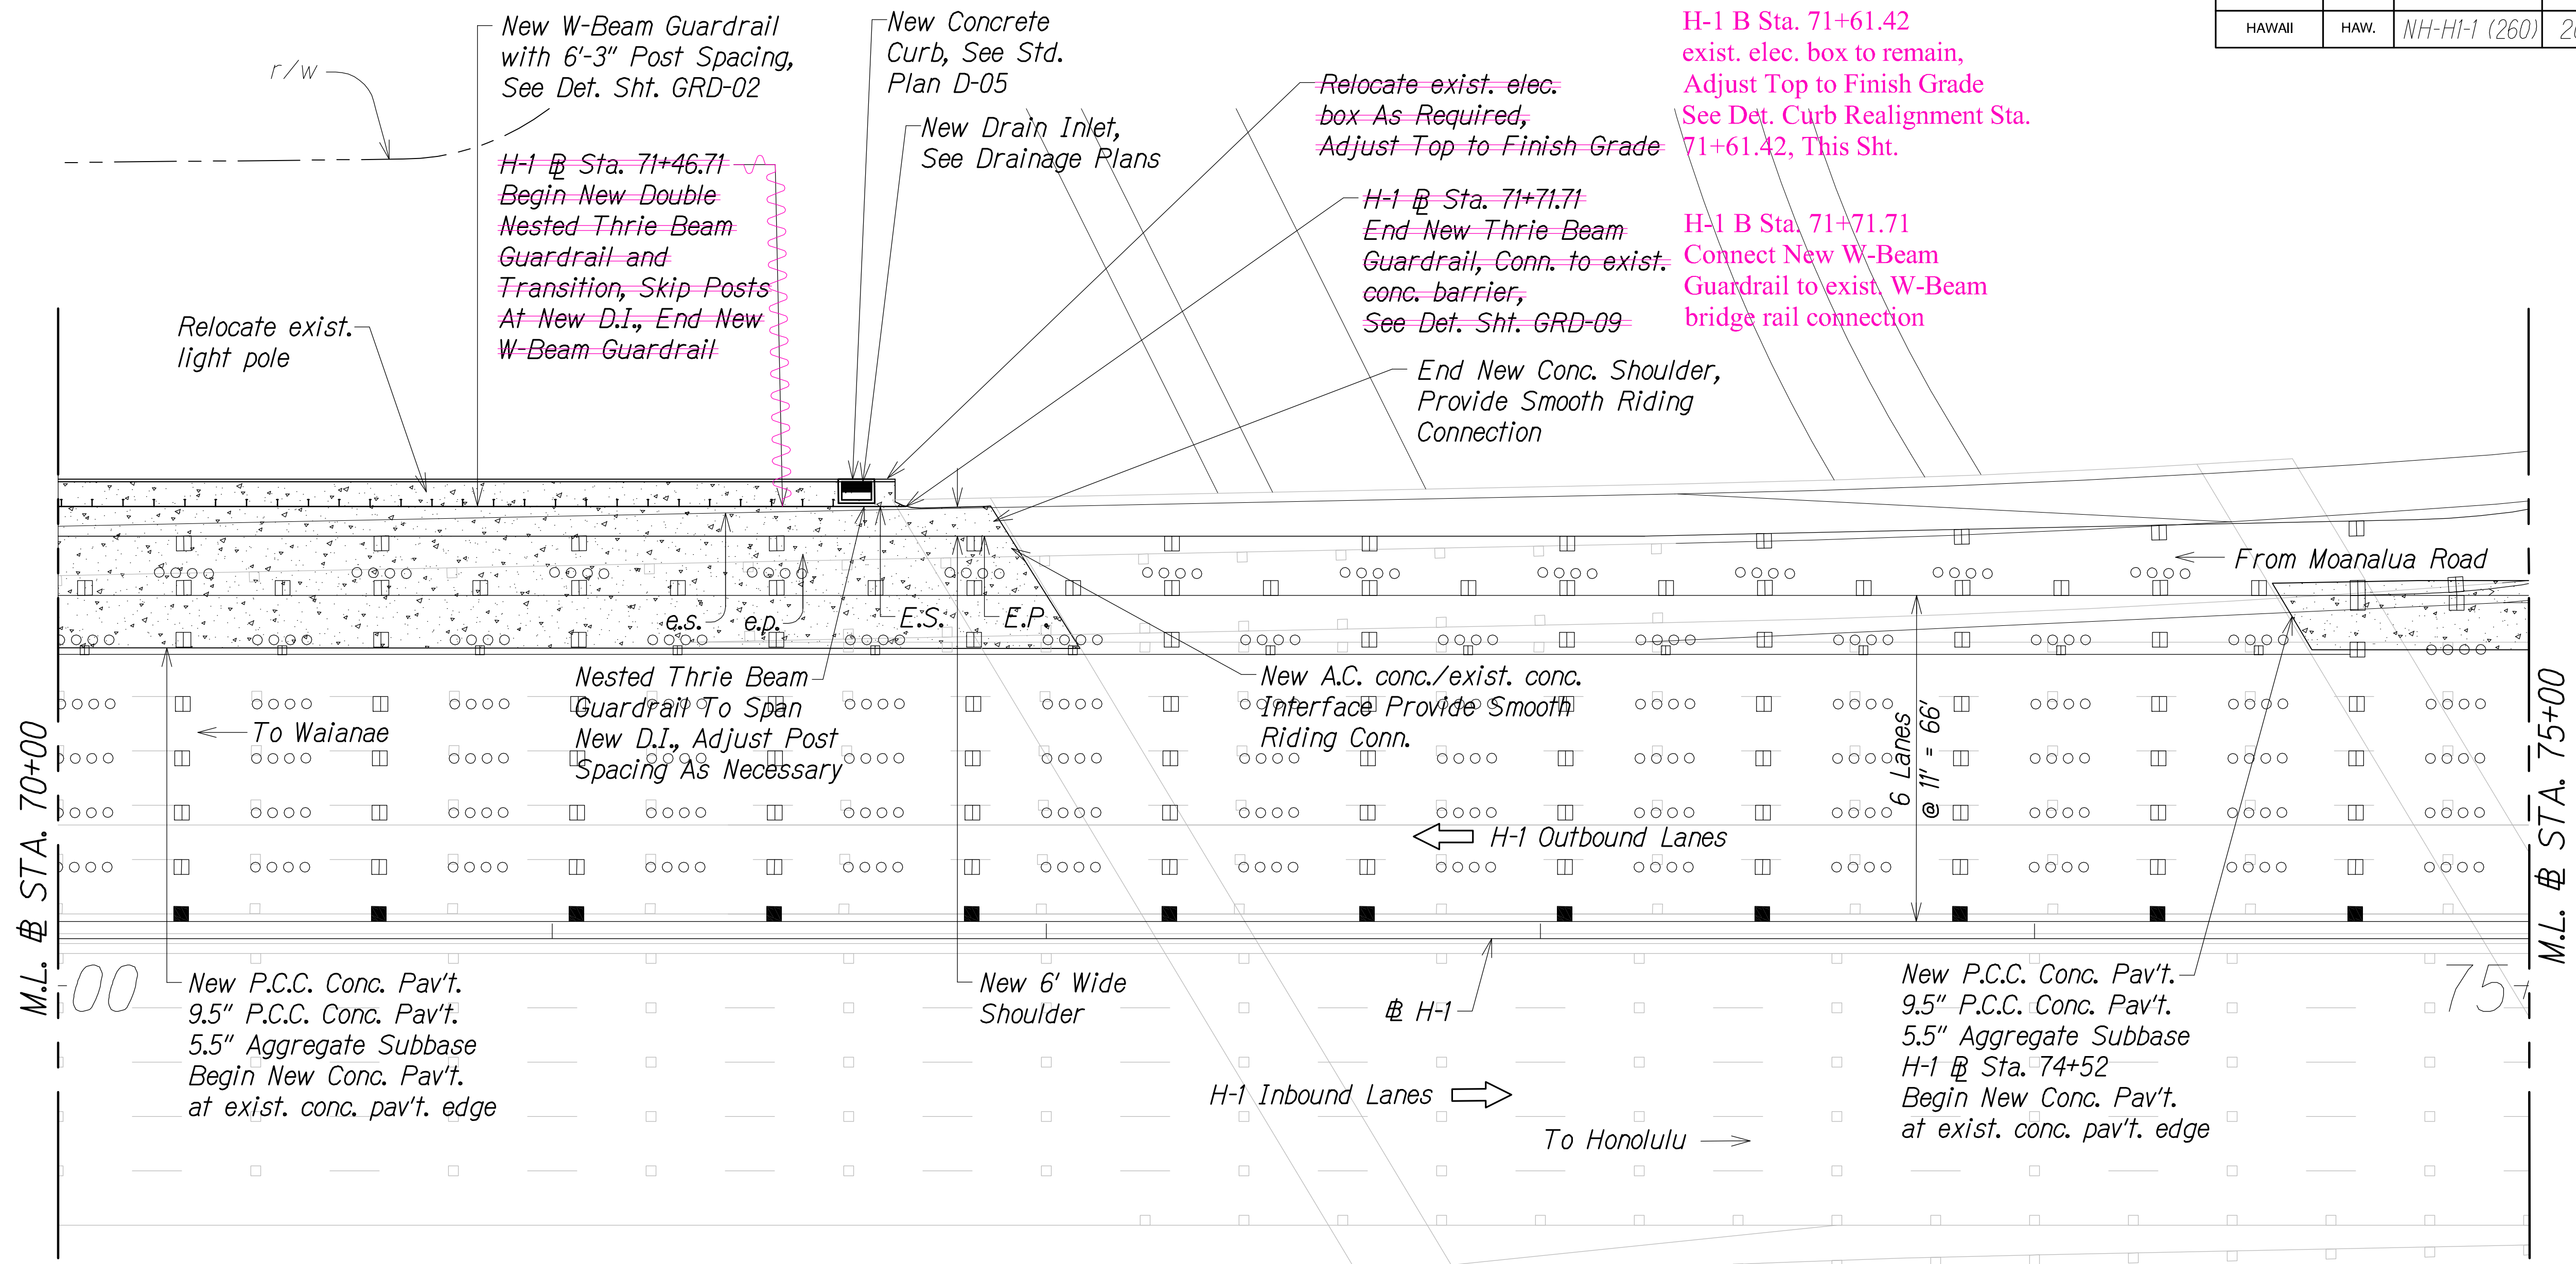

TRUE NORTH
SCALE: 1" = 20'

Legend:


- New P.C.C. Concrete Pav't.
- e.p.* Edge of exist. pavement
- e.s.* Edge of exist. shoulder
- E.P.* Edge of Pavement
- E.S.* Edge of Shoulder

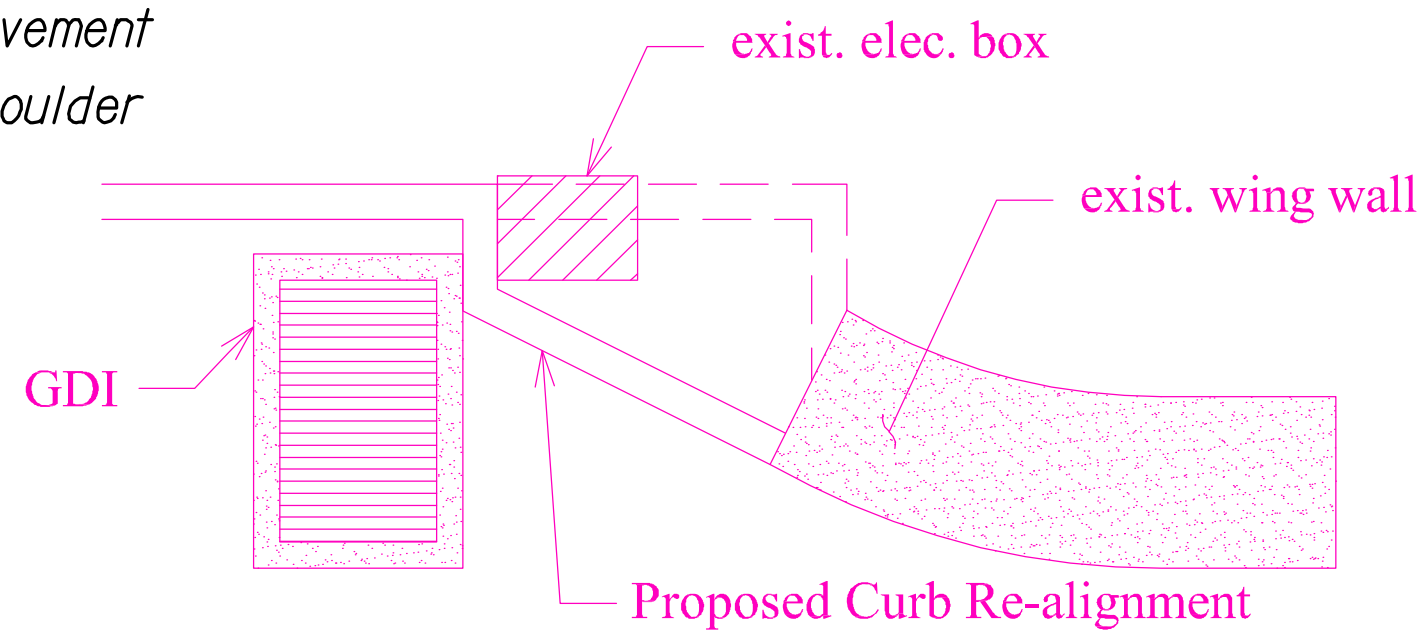

CURB REALIGNMENT STA. 71+61.42
Scale: NTS

ROADWAY PLAN
STA. 70+00 TO # STA. 75+00
Scale: 1" = 20'

- LEGEND FOR AS-BUILT POSTINGS
- Squiggly line for as-built deletion
 - Double line for as-built deletion
 - Text for as-built posting

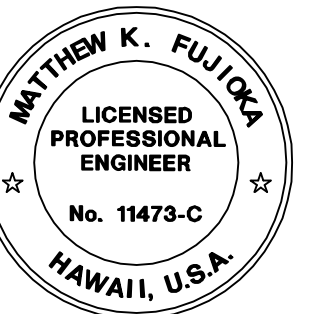

THIS WORK WAS PREPARED BY ME OR UNDER MY SUPERVISION.
Matthew K. Fujioa
APRIL 30, 2016
WILSON OKAMOTO CORPORATION LIC. EXP. DATE


STATE OF HAWAII
DEPARTMENT OF TRANSPORTATION
HIGHWAYS DIVISION

DETAILED ROADWAY PLAN

INTERSTATE ROUTE H-1
PM CONTRAFLOW LANE, PHASE 3
FEDERAL AID PROJECT NO. NH-HI-1 (260)
Scale: 1" = 20' Date: December, 2014

SHEET No. RWP-37 OF 40 SHEETS


FED. ROAD DIST. NO.	STATE	FED. AID PROJ. NO.	FISCAL YEAR	SHEET NO.	TOTAL SHEETS
HAWAII	HAW.	NH-HI-1 (260)	2014	59	200

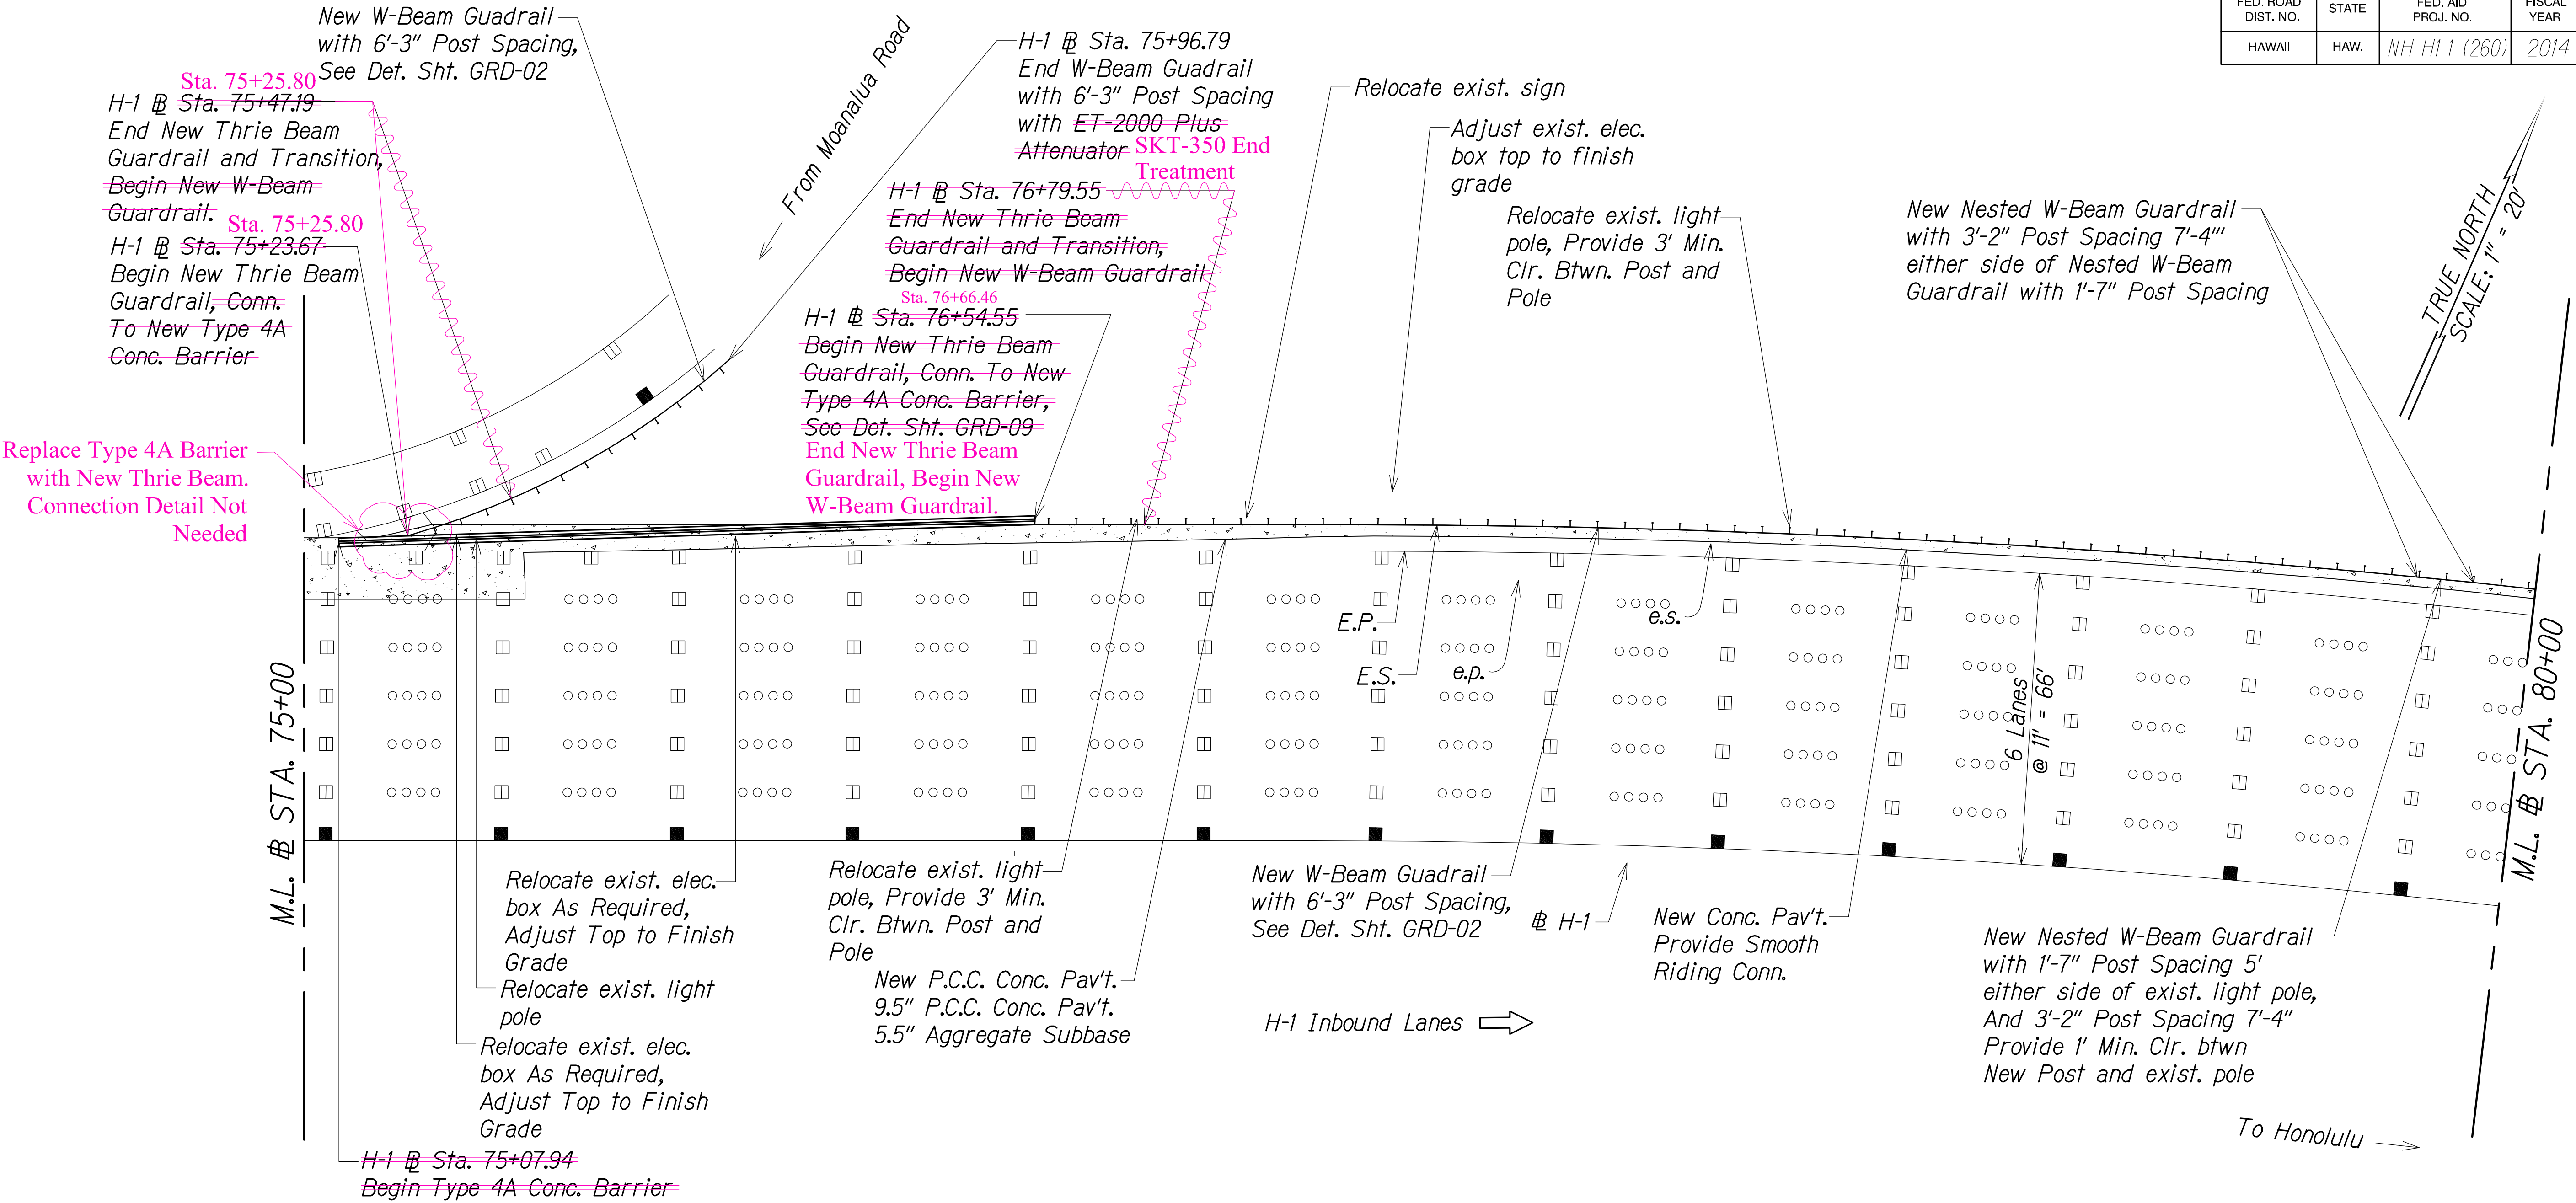

Legend:

- New P.C.C. Concrete Pav't.
- e.p. Edge of exist. pavement
- e.s. Edge of exist. shoulder
- E.P. Edge of Pavement
- E.S. Edge of Shoulder

Graphic Scale

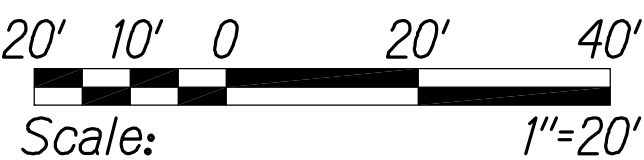

RODWAY PLAN
@ STA. 75+00 TO @ STA. 80+00
Scale: 1" = 20'

- LEGEND FOR AS-BUILT POSTINGS**
- Squiggly line for as-built deletion
 - Double line for as-built deletion
 - Roadway Text for as-built posting



THIS WORK WAS PREPARED BY ME OR UNDER MY SUPERVISION.
Matthew K. Fujio
APRIL 30, 2016
WILSON OKAMOTO CORPORATION LIC. EXP. DATE

STATE OF HAWAII
DEPARTMENT OF TRANSPORTATION
HIGHWAYS DIVISION


DETAILED ROADWAY PLAN

INTERSTATE ROUTE H-1
PM CONTRAFLOW LANE, PHASE 3
FEDERAL AID PROJECT NO. NH-HI-1 (260)
Scale: 1" = 20' Date: December, 2014


SHEET No. RWP-38 OF 40 SHEETS

FED. ROAD DIST. NO.	STATE	FED. AID PROJ. NO.	FISCAL YEAR	SHEET NO.	TOTAL SHEETS
HAWAII	HAW.	NH-H1-1 (260)	2014	60	200

TRUE NORTH
SCALE: 1" = 20'

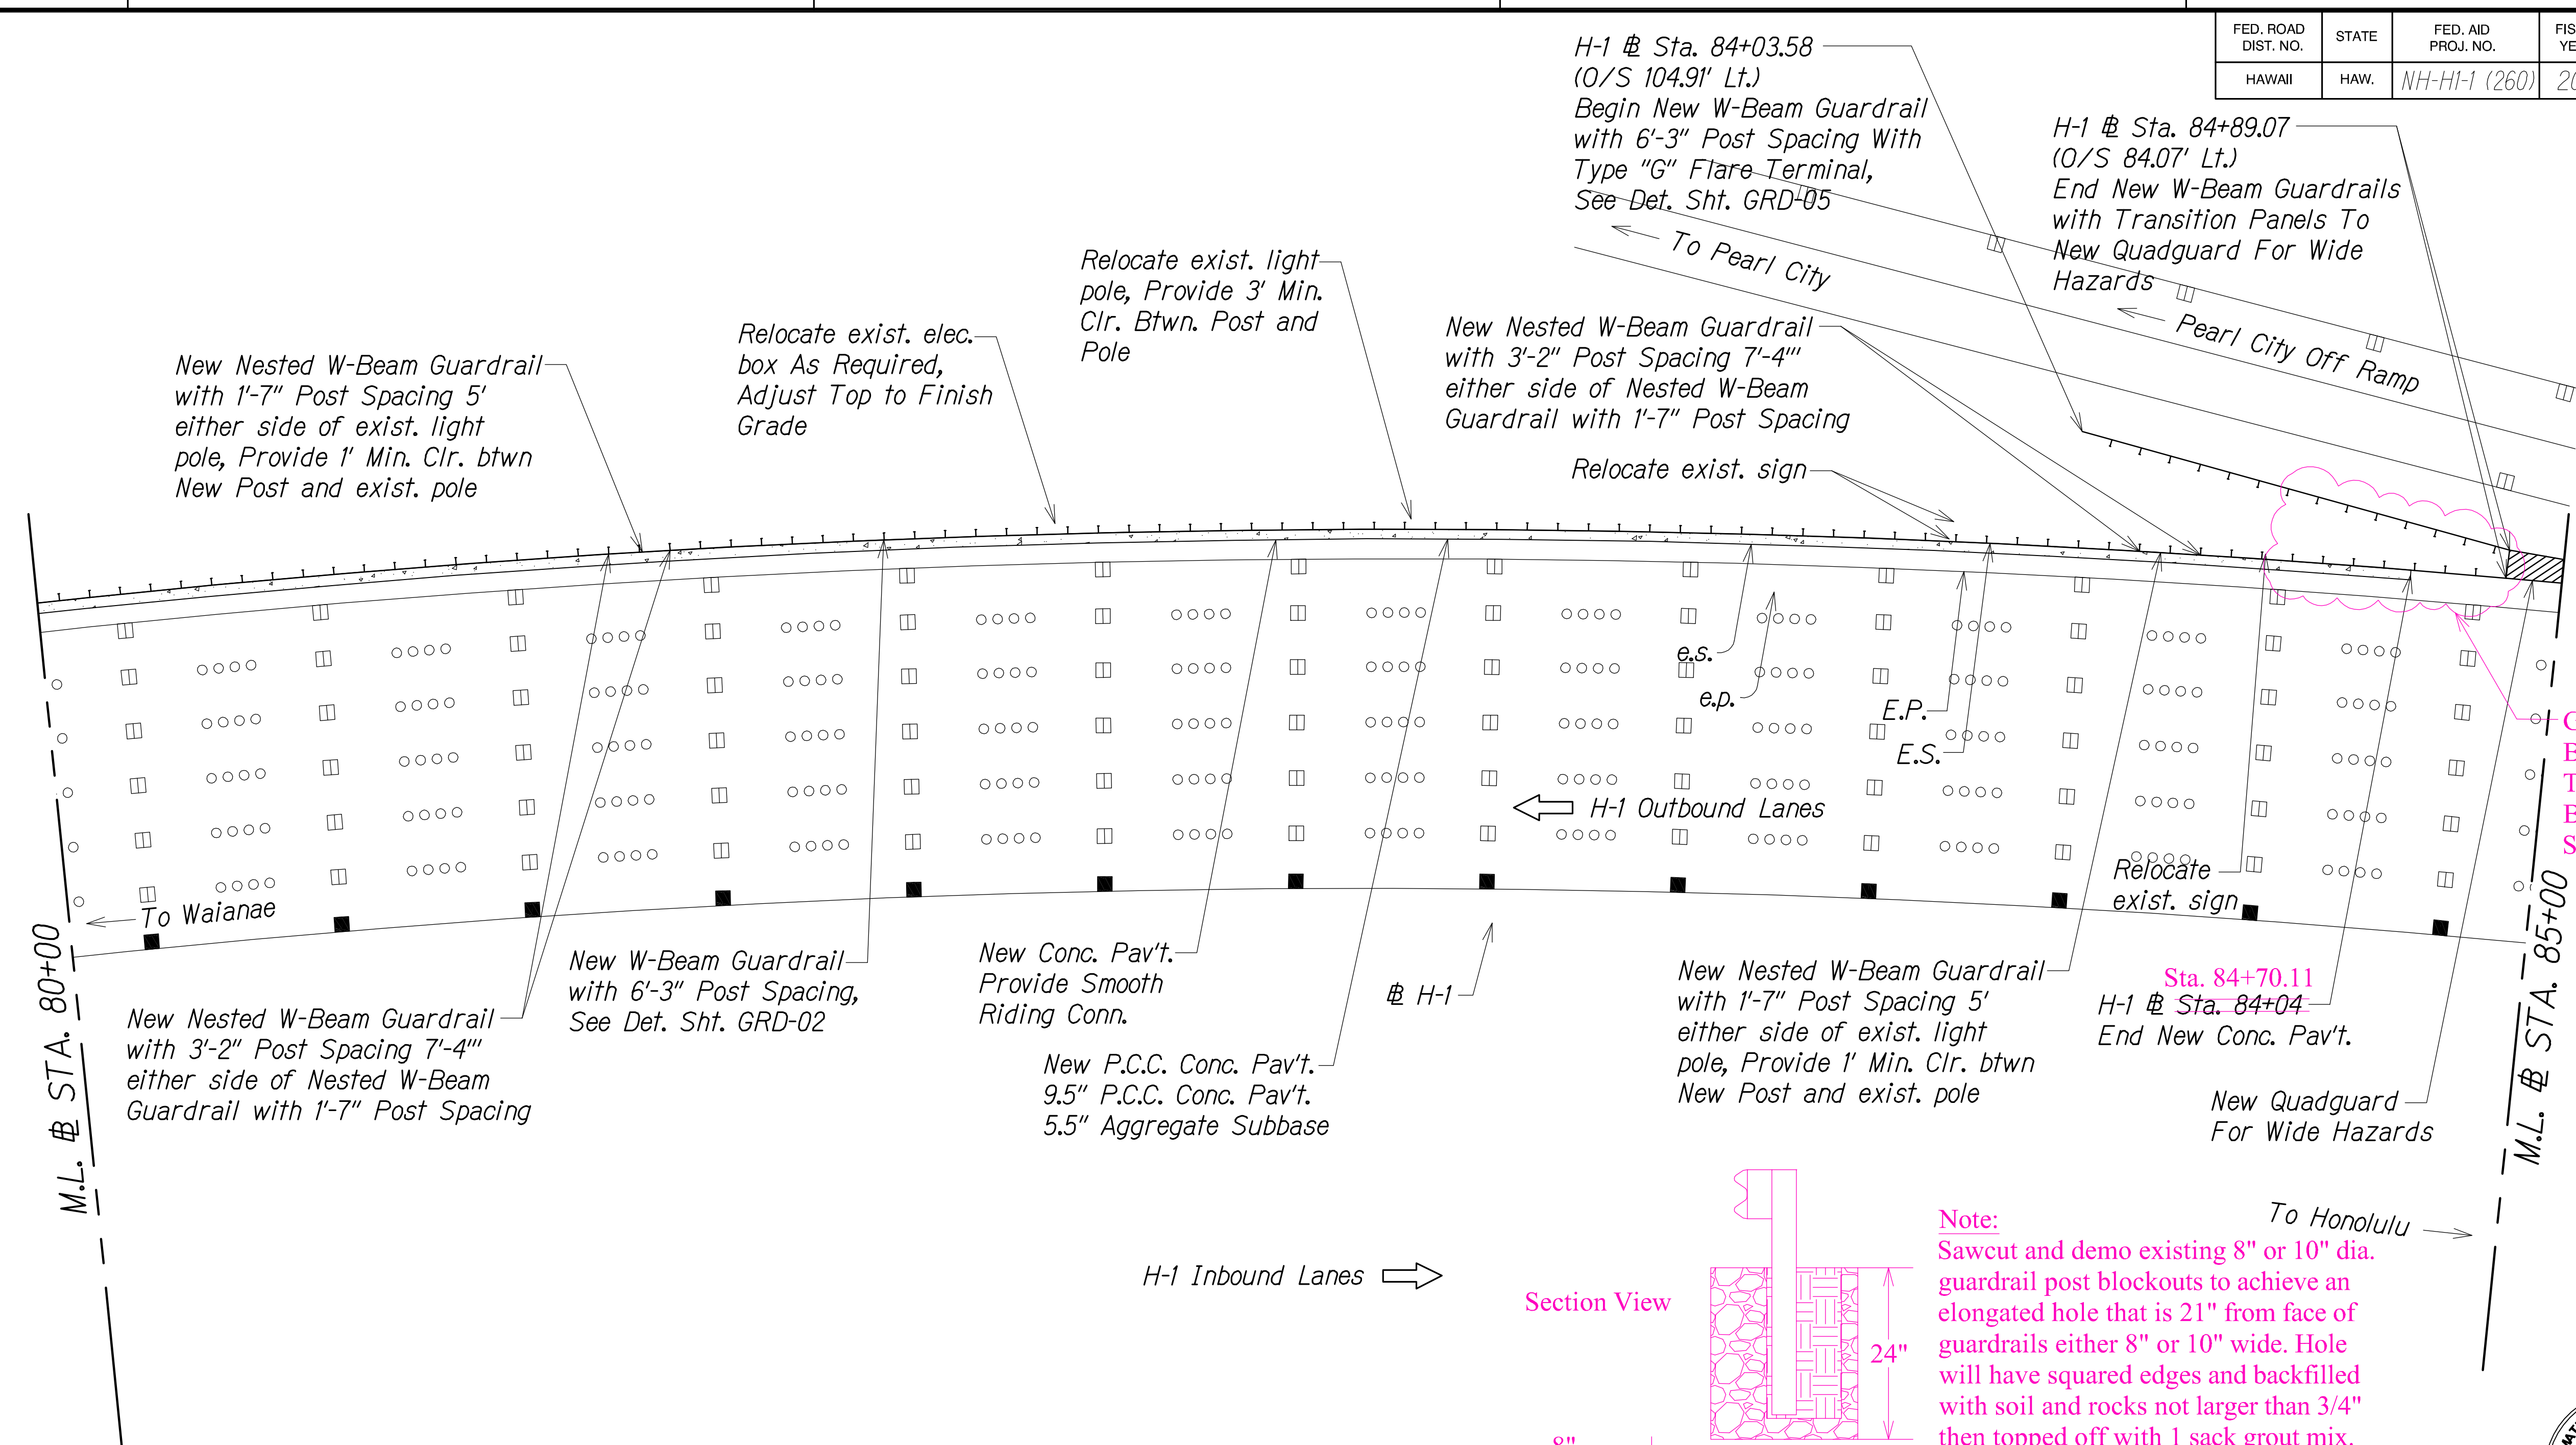

Guardrail Post Blockout Treatment, See Bottom Detail and Sht. GRD-05

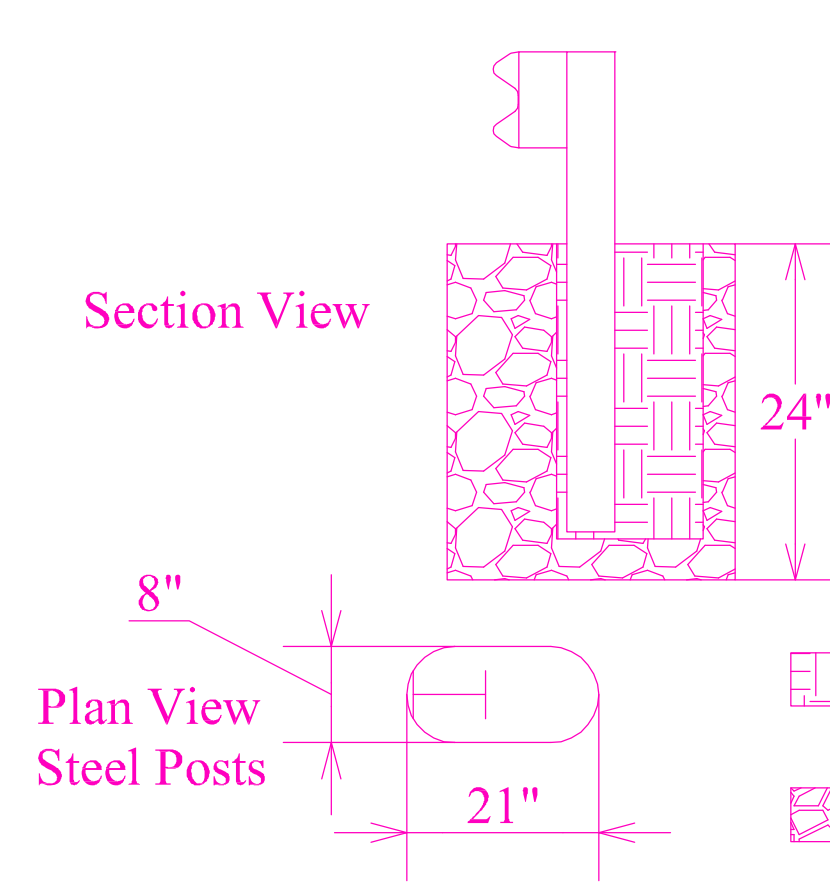



GUARDRAIL POST BLOCKOUT DETAIL
Scale: NTS

LEGEND FOR AS-BUILT POSTINGS	
	Squiggly line for as-built deletion
	Double line for as-built deletion
Roadway	Text for as-built posting

ROADWAY PLAN
STA. 80+00 TO # STA. 85+00
Scale: 1" = 20'

Legend:

	New P.C.C. Concrete Pav't.
e.p.	Edge of exist. pavement
e.s.	Edge of exist. shoulder
E.P.	Edge of Pavement
E.S.	Edge of Shoulder

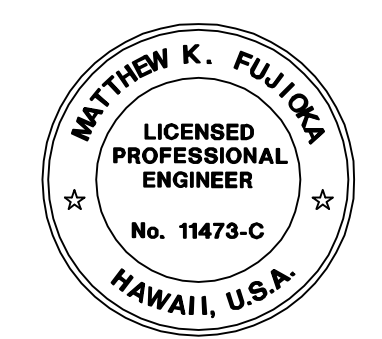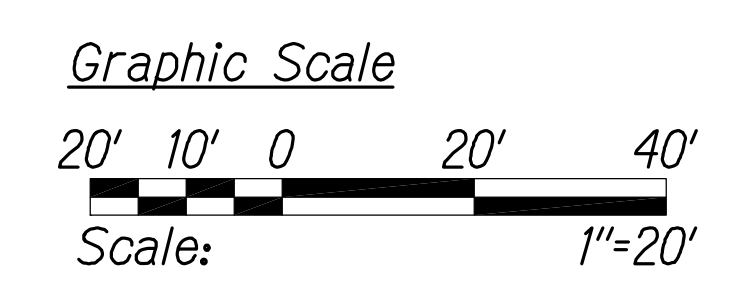

THIS WORK WAS PREPARED BY ME OR UNDER MY SUPERVISION.
Matthew K. Fujioa
APRIL 30, 2016
WILSON OKAMOTO CORPORATION LIC. EXP. DATE

STATE OF HAWAII
DEPARTMENT OF TRANSPORTATION
HIGHWAYS DIVISION


DETAILED ROADWAY PLAN

INTERSTATE ROUTE H-1
PM CONTRAFLOW LANE, PHASE 3
FEDERAL AID PROJECT NO. NH-H1-1 (260)
Scale: 1" = 20' Date: December, 2014


SHEET No. RWP-39 OF 40 SHEETS

FED. ROAD DIST. NO.	STATE	FED. AID PROJ. NO.	FISCAL YEAR	SHEET NO.	TOTAL SHEETS
HAWAII	HAW.	NH-HI-1 (260)	2014	61	200

TRUE NORTH
SCALE: 1" = 20'

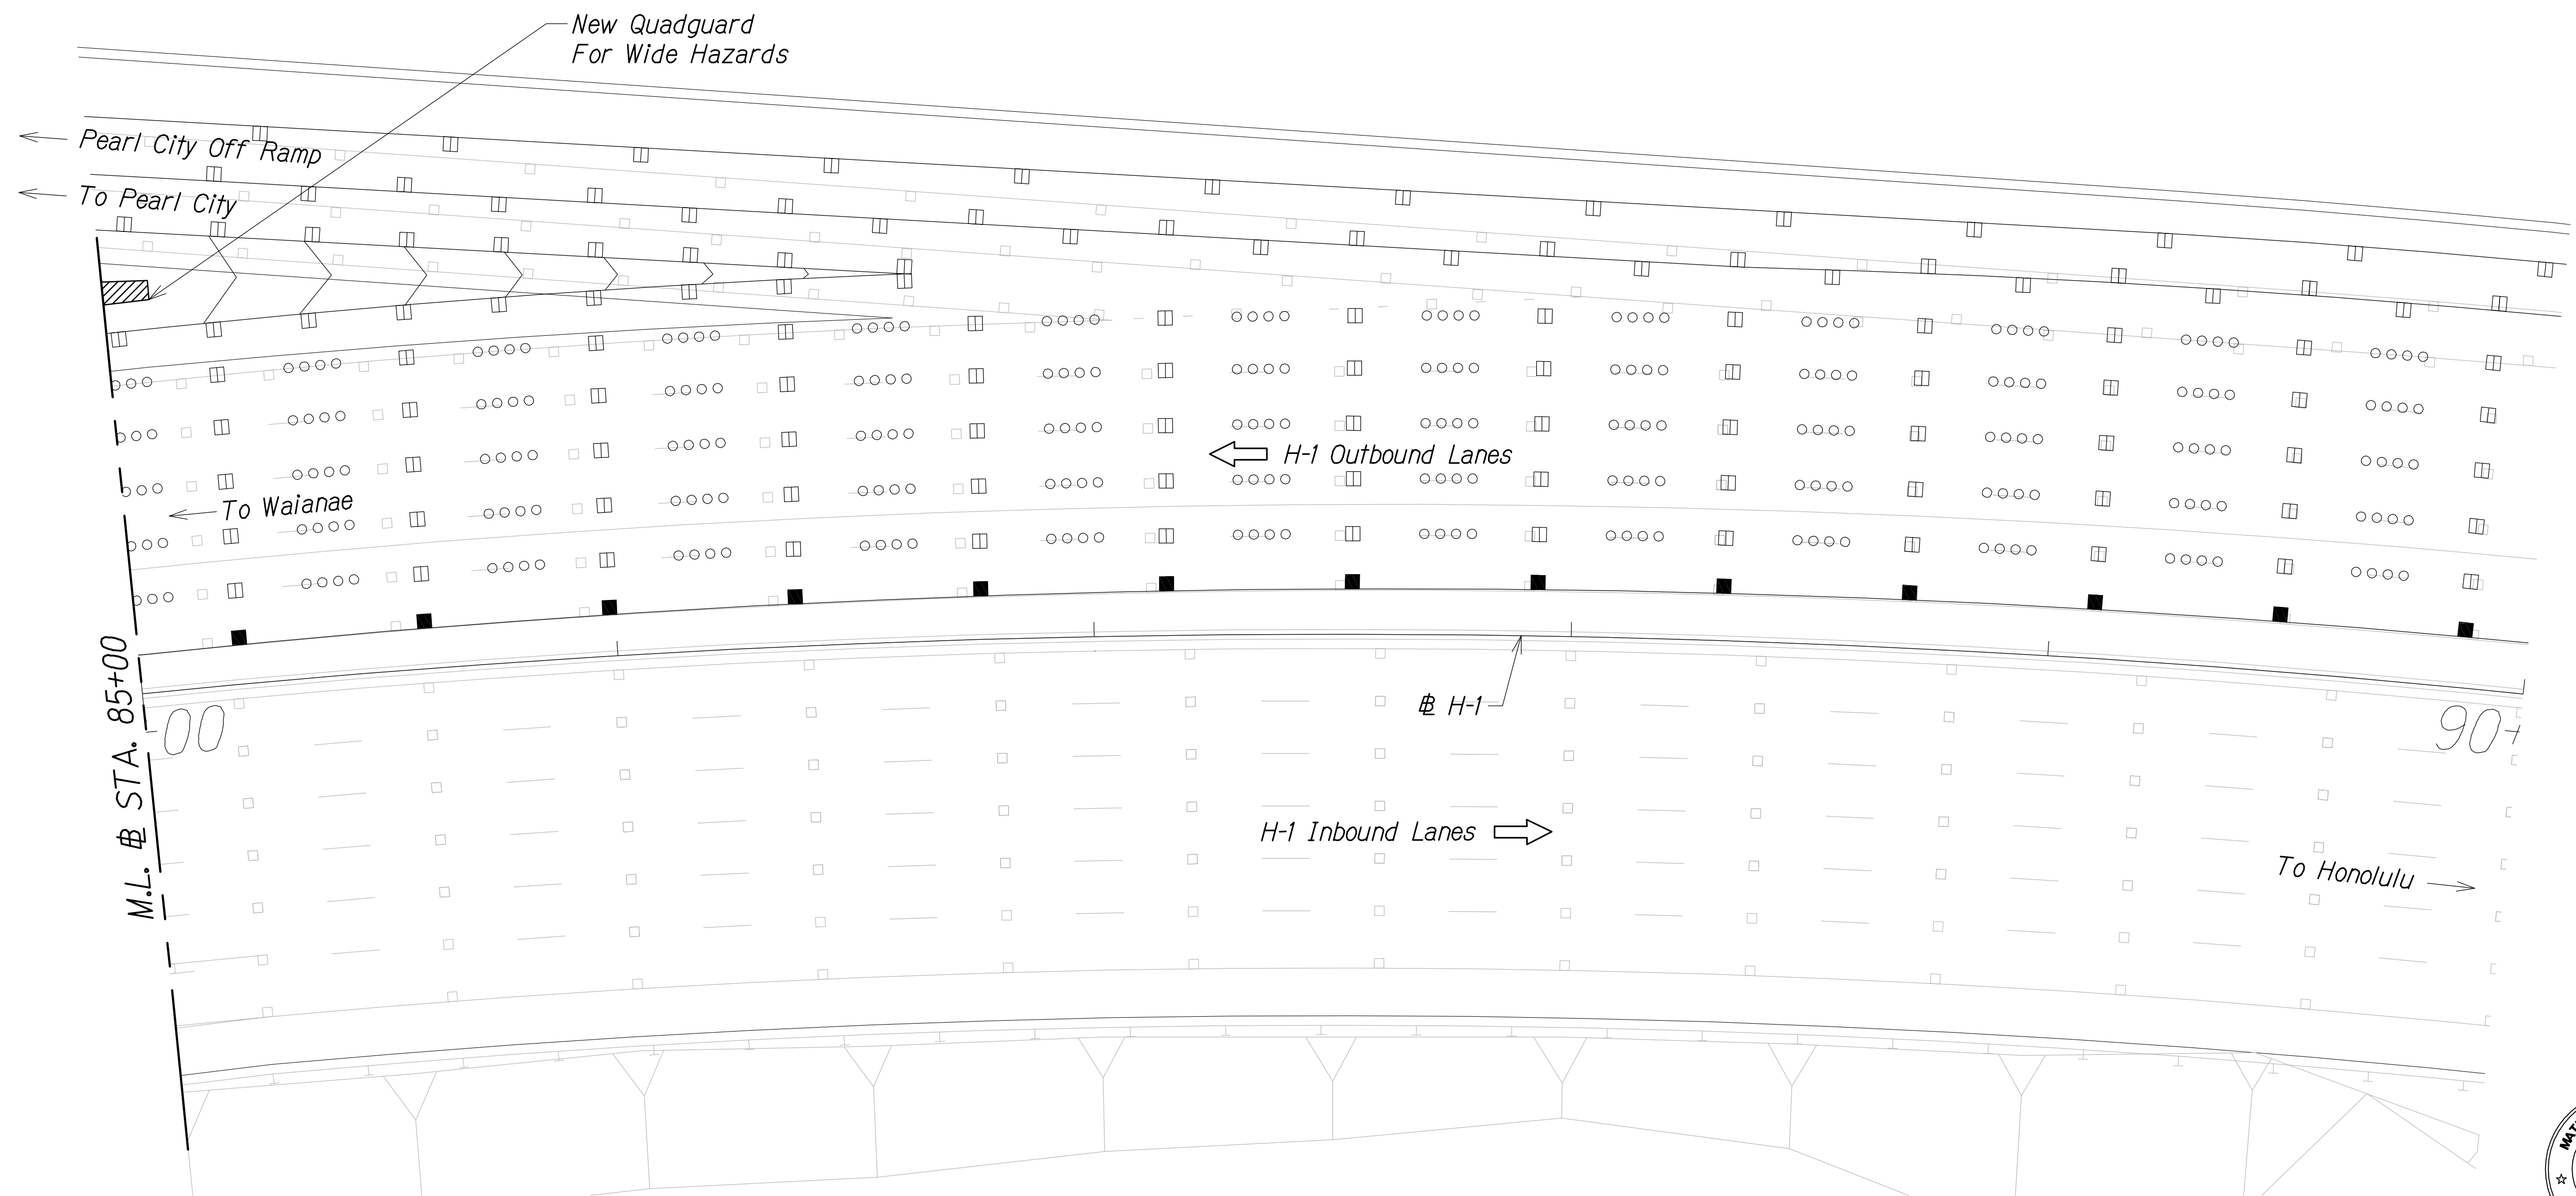

- Legend:**
- New P.C.C. Concrete Pav't.
 - e.p. Edge of exist. pavement
 - e.s. Edge of exist. shoulder
 - E.P. Edge of Pavement
 - E.S. Edge of Shoulder

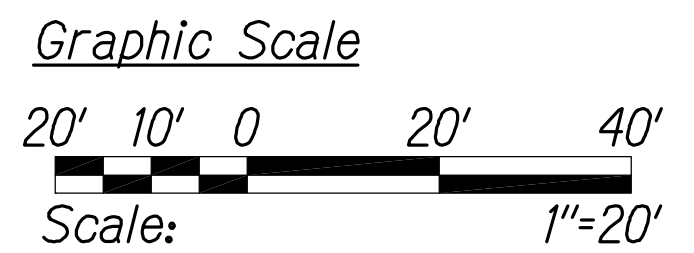

ROADWAY PLAN
± STA. 85+00 TO ± STA. 90+00
Scale: 1" = 20'

LEGEND FOR AS-BUILT POSTINGS

- Squiggly line for as-built deletion
- ±00:00= Double line for as-built deletion
- Roadway Text for as-built posting

THIS WORK WAS PREPARED BY ME OR UNDER MY SUPERVISION.

Matthew K. Fujio
APRIL 30, 2016
WILSON OKAMOTO CORPORATION LIC. EXP. DATE

STATE OF HAWAII
DEPARTMENT OF TRANSPORTATION
HIGHWAYS DIVISION

DETAILED ROADWAY PLAN

INTERSTATE ROUTE H-1
PM CONTRAFLOW LANE, PHASE 3
FEDERAL AID PROJECT NO. NH-HI-1 (260)
Scale: 1" = 20' Date: December, 2014

SHEET No. RWP-40 OF 40 SHEETS

QC/QA REVIEW	100%	DATE	JUL 12, 2015
BY		DESIGNED BY	
BY		TRACED BY	
BY		NOTE BOOK	
BY		QUANTITIES BY	
BY		CHECKED BY	

SURVEY PLOTTED BY	DATE
DRAWN BY	
DESIGNED BY	
TRACED BY	
NOTE BOOK	
QUANTITIES BY	
CHECKED BY	