


FED. ROAD DIST. NO.	STATE	FED. AID PROJ. NO.	FISCAL YEAR	SHEET NO.	TOTAL SHEETS
HAWAII	HAW.	NH-H1-1 (260)	2014	108	200

TRUE NORTH
SCALE: 1" = 40'

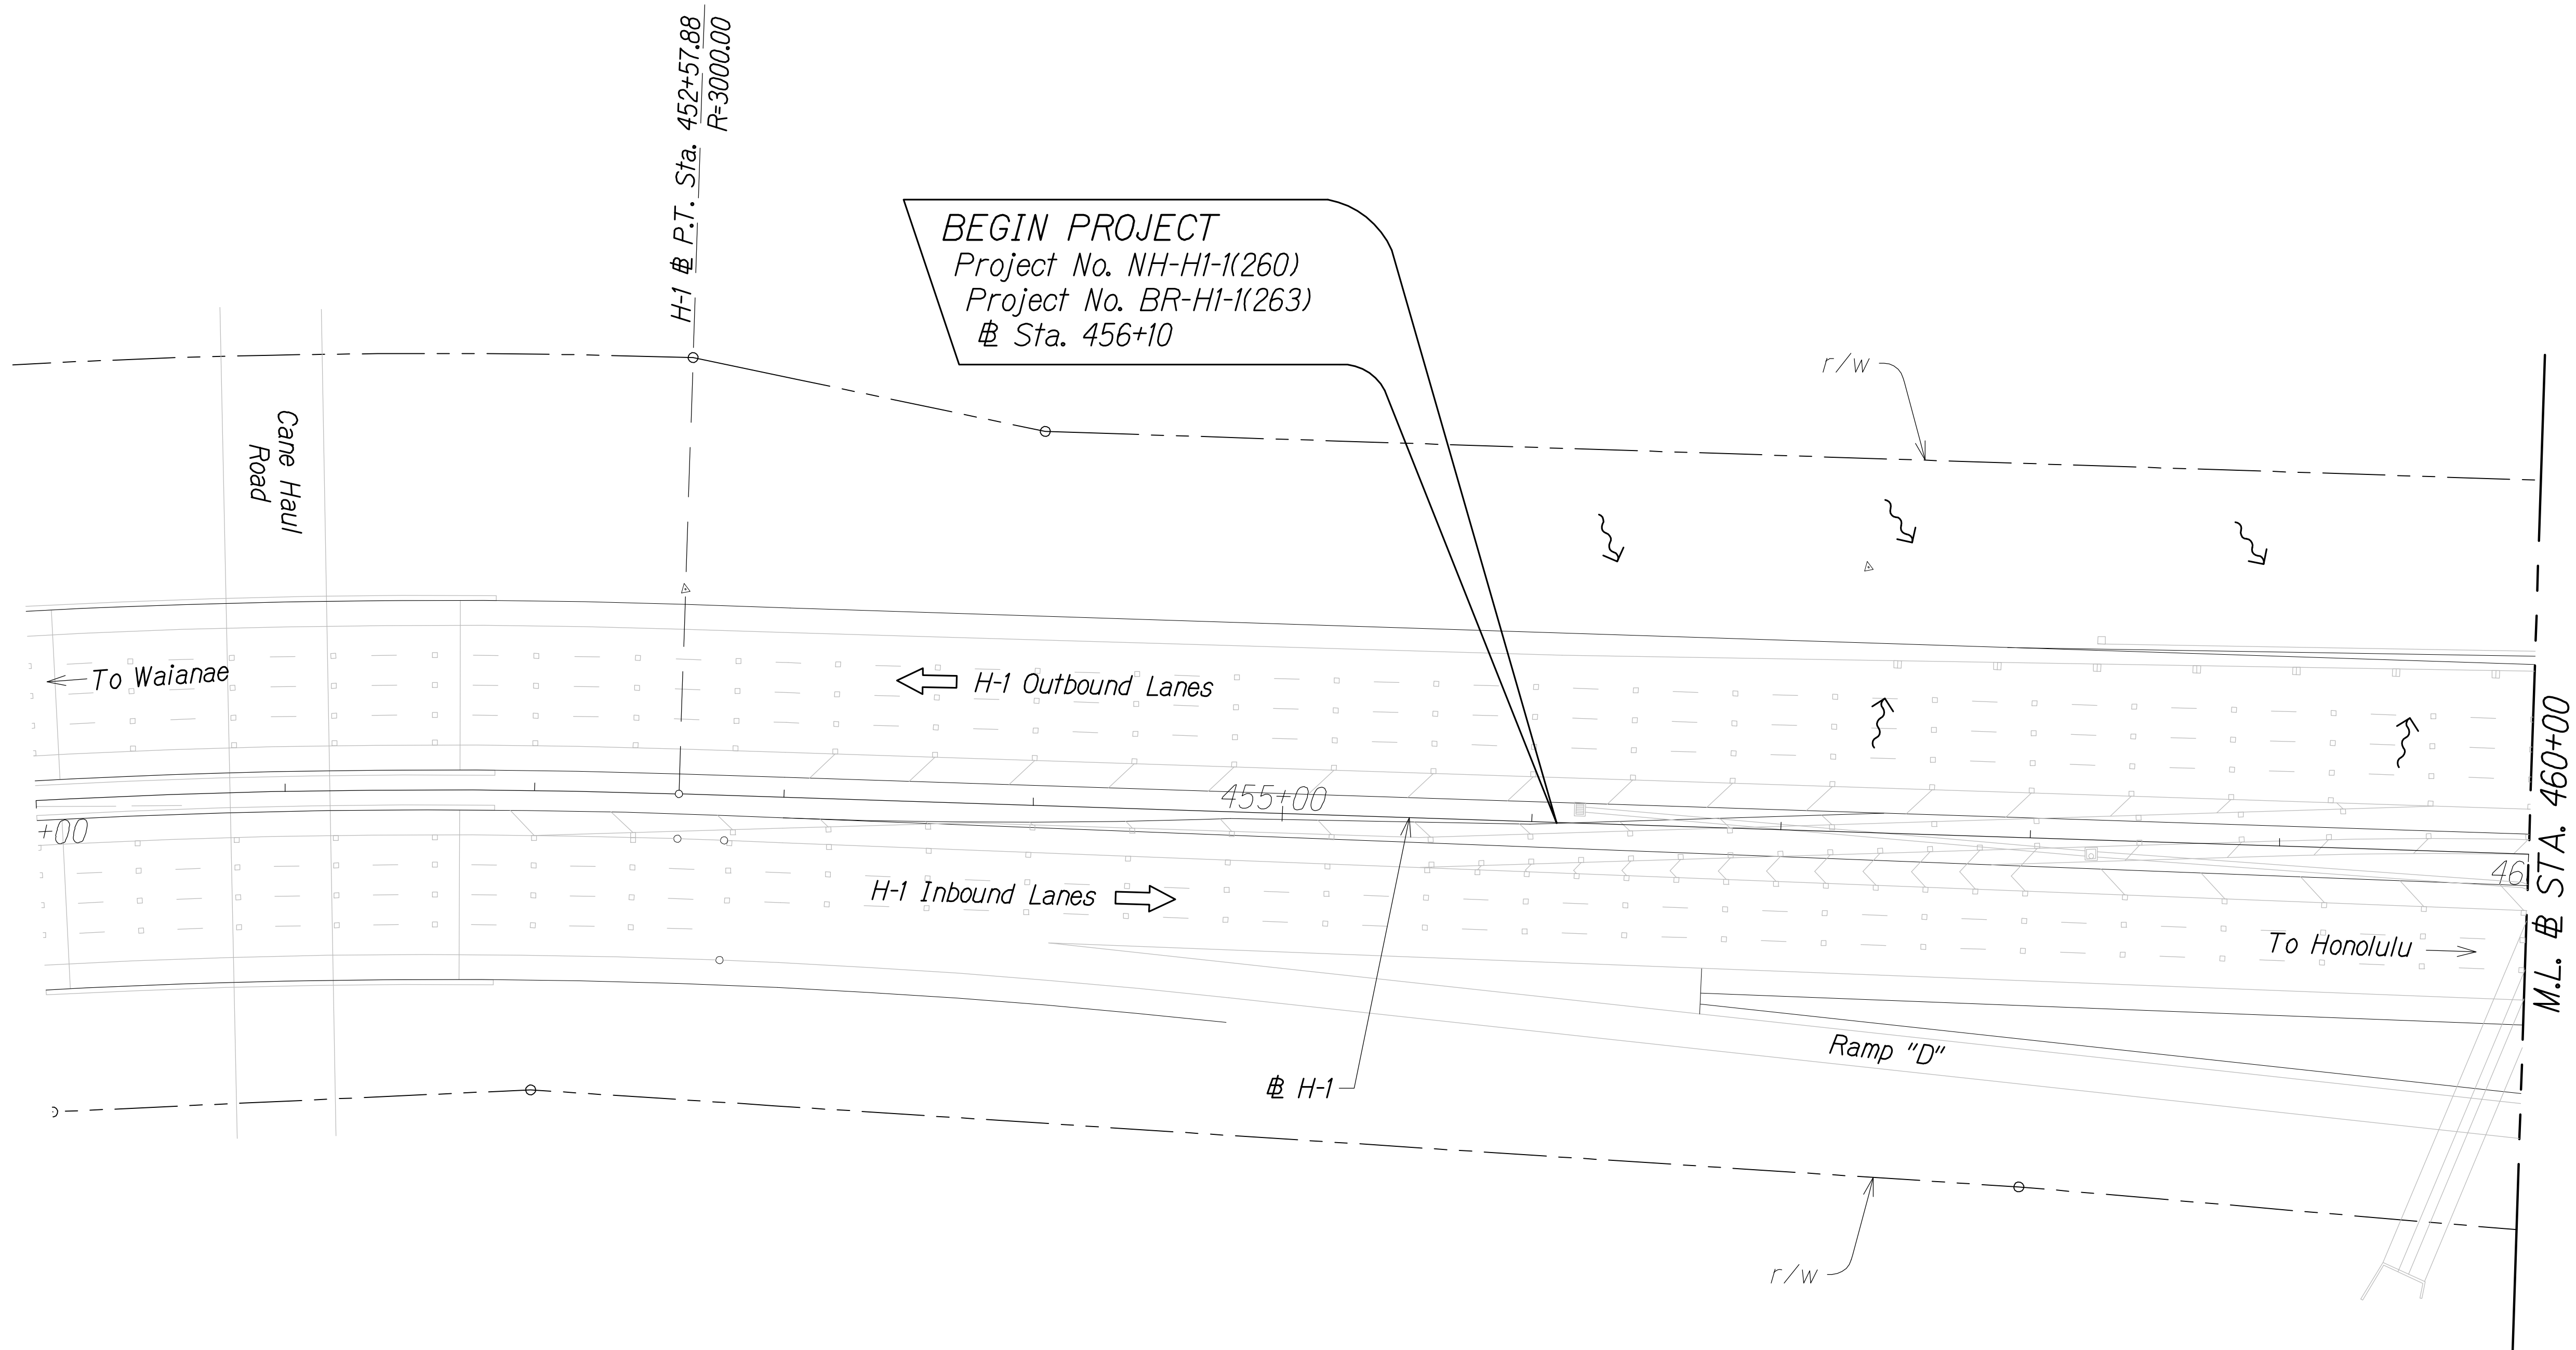

QC/QA REVIEW	100%	DATE	JUL 12, 2015
BY		DESIGNED BY	Matthew K. Fujio
BY		DESIGNED BY	
BY		DESIGNED BY	
BY		DESIGNED BY	

ORIGINAL PLAN	DATE
NOTE BOOK	
QUANTITIES BY	
CHECKED BY	

Legend:

~> Flow Direction


Graphic Scale



EROSION CONTROL/DRAINAGE PLAN
STA. 450+00 TO # STA. 460+00
Scale: 1" = 40'

LEGEND FOR AS-BUILT POSTINGS

Squiggly line for as-built deletion
+00:00= Double line for as-built deletion
Roadway Text for as-built posting

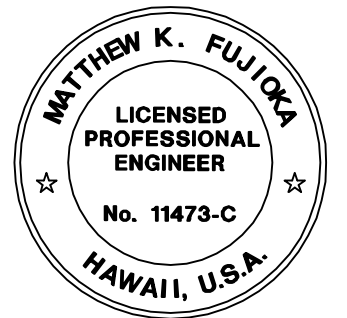


THIS WORK WAS PREPARED BY ME OR UNDER MY SUPERVISION.
Matthew K. Fujio
APRIL 30, 2016
WILSON OKAMOTO CORPORATION LIC. EXP. DATE

STATE OF HAWAII
DEPARTMENT OF TRANSPORTATION
HIGHWAYS DIVISION
EROSION CONTROL AND DRAINAGE PLAN
INTERSTATE ROUTE H-1
PM CONTRAFLOW LANE, PHASE 3
FEDERAL AID PROJECT NO. NH-H1-1 (260)
Scale: 1" = 40' Date: December, 2014
SHEET No. DR-01 OF 40 SHEETS

FED. ROAD DIST. NO.	STATE	FED. AID PROJ. NO.	FISCAL YEAR	SHEET NO.	TOTAL SHEETS
HAWAII	HAW.	NH-HI-1 (260)	2014	109	200

TRUE NORTH
SCALE: 1" = 40'

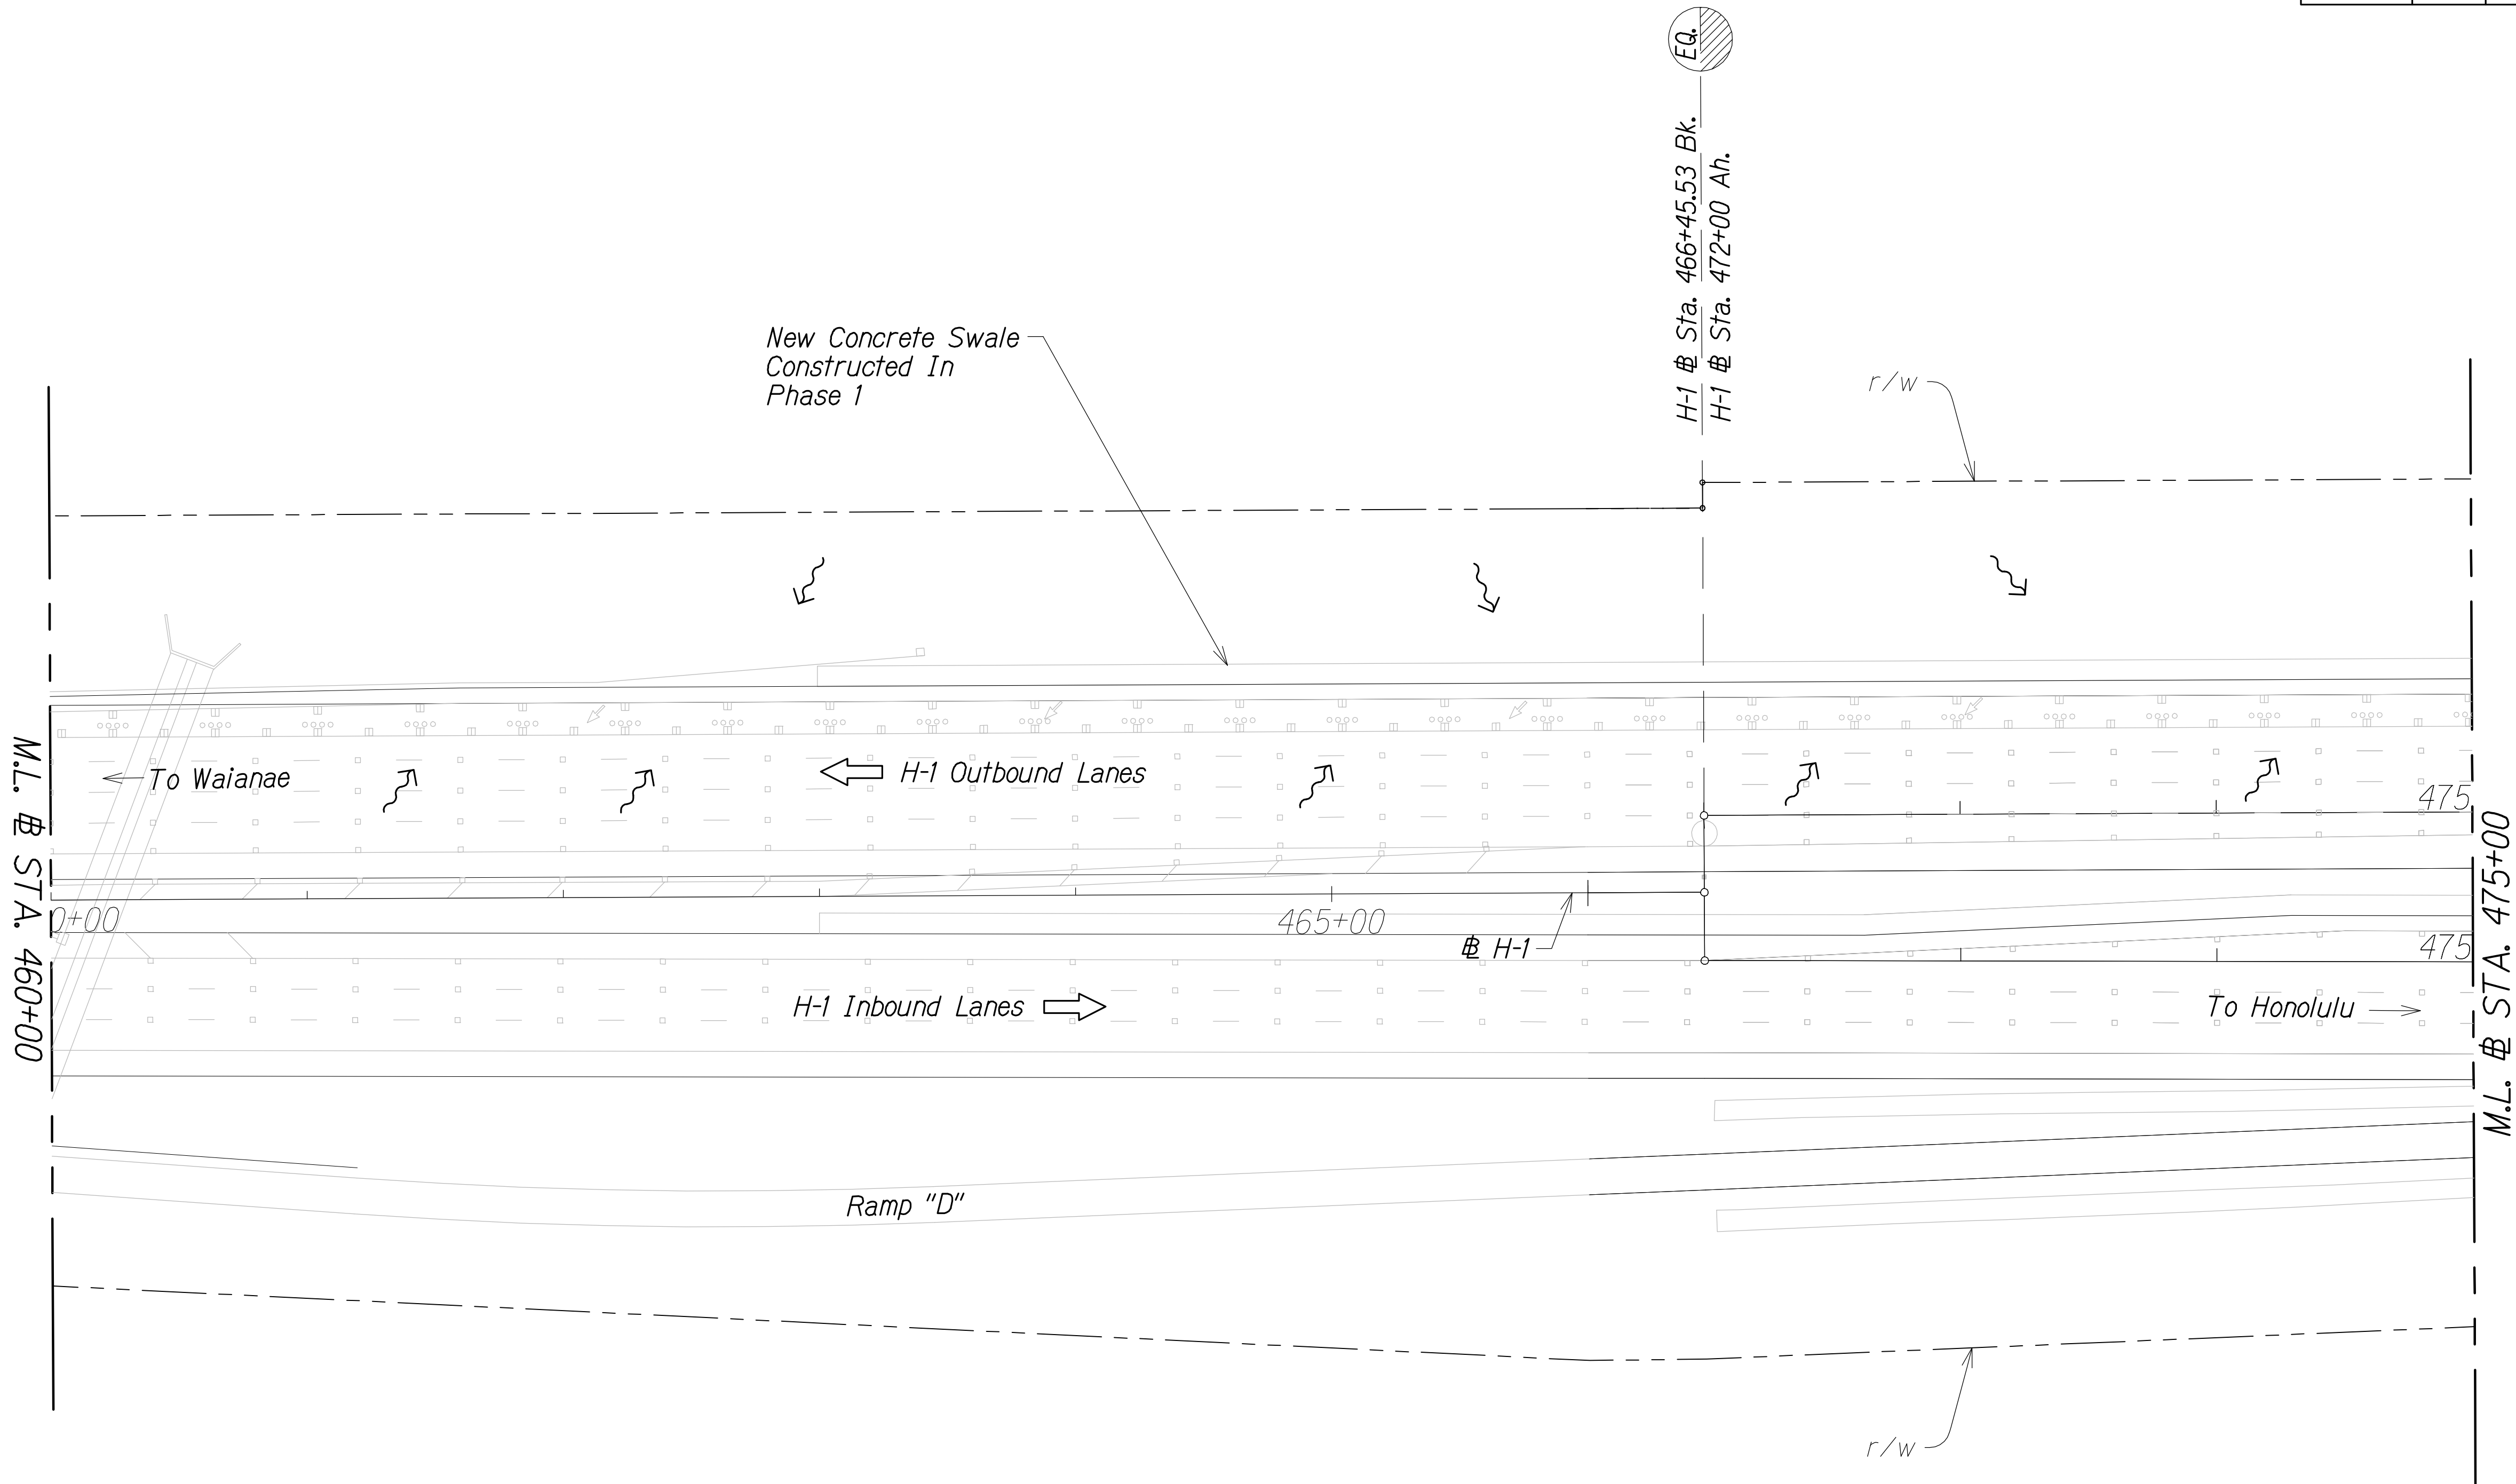


Legend:

~> Flow Direction

Graphic Scale
40' 20' 0 80'
Scale: 1"=40'

EROSION CONTROL/DRAINAGE PLAN
STA. 460+00 TO # STA. 475+00
Scale: 1" = 40'

LEGEND FOR
AS-BUILT POSTINGS
Squiggly line for
as-built deletion
+100.00= Double line for
as-built deletion
Roadway Text for as-built posting

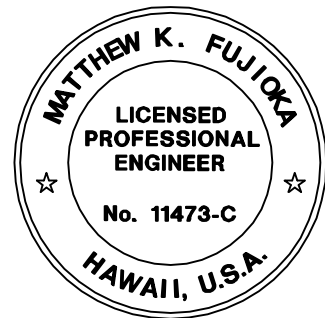

THIS WORK WAS PREPARED BY ME
OR UNDER MY SUPERVISION.
Matthew K. Fujio
APRIL 30, 2016
WILSON OKAMOTO CORPORATION LIC. EXP. DATE

STATE OF HAWAII
DEPARTMENT OF TRANSPORTATION
HIGHWAYS DIVISION
EROSION CONTROL AND
DRAINAGE PLAN
INTERSTATE ROUTE H-1
PM CONTRAFLOW LANE, PHASE 3
FEDERAL AID PROJECT NO. NH-HI-1 (260)
Scale: 1" = 40' Date: December, 2014
SHEET No. DR-02 OF 40 SHEETS

"AS-BUILT" 109

