




FED. ROAD DIST. NO.	STATE	FED. AID PROJ. NO.	FISCAL YEAR	SHEET NO.	TOTAL SHEETS
HAWAII	HAW.	NH-H1-1 (260)	2014	151	200

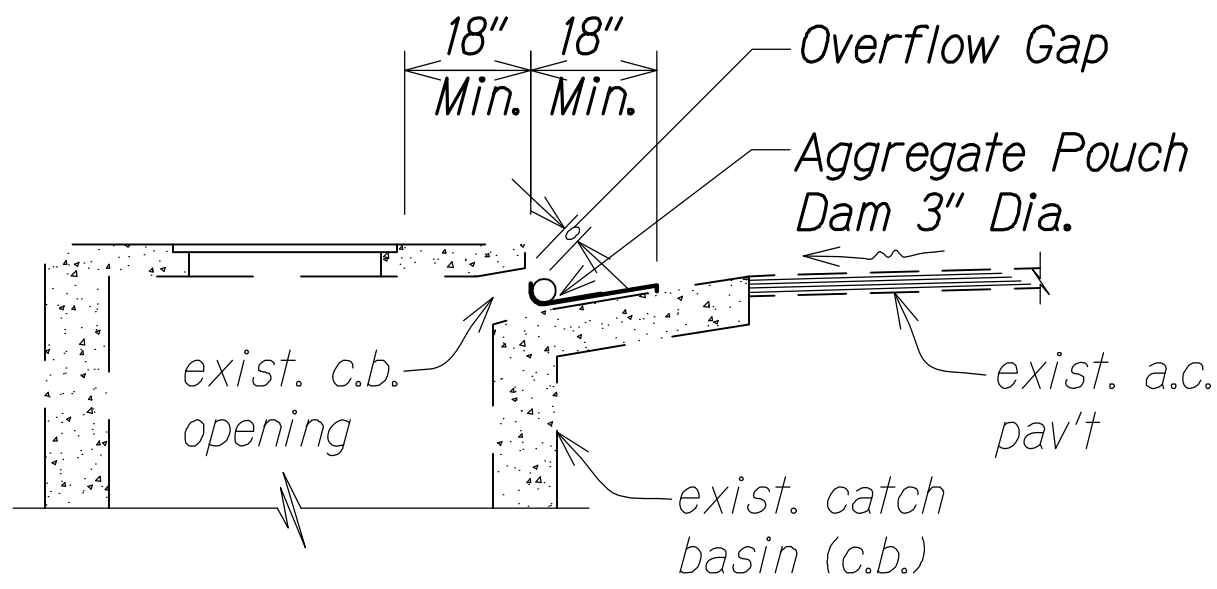


ELEVATION
AGGREGATE POUCH
Not to Scale

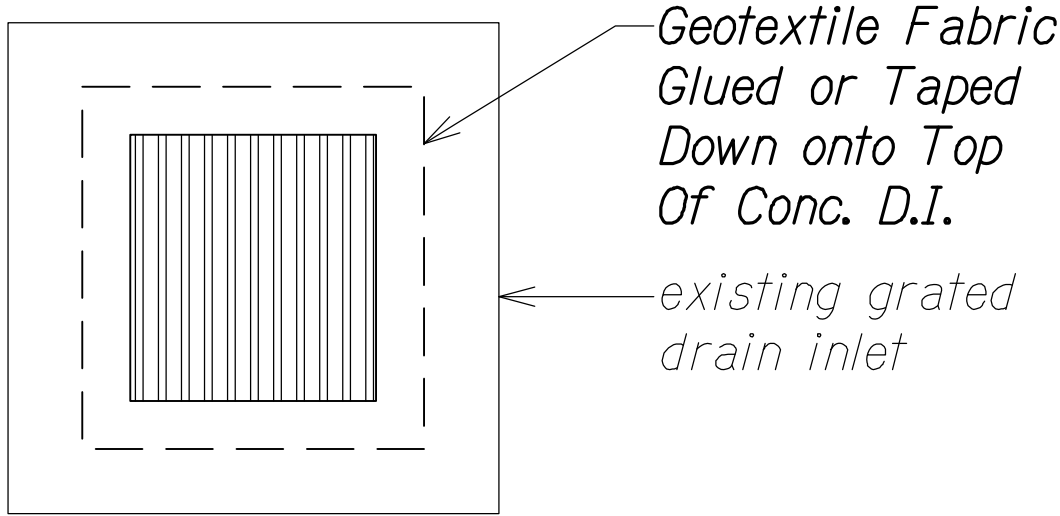


PLAN VIEW

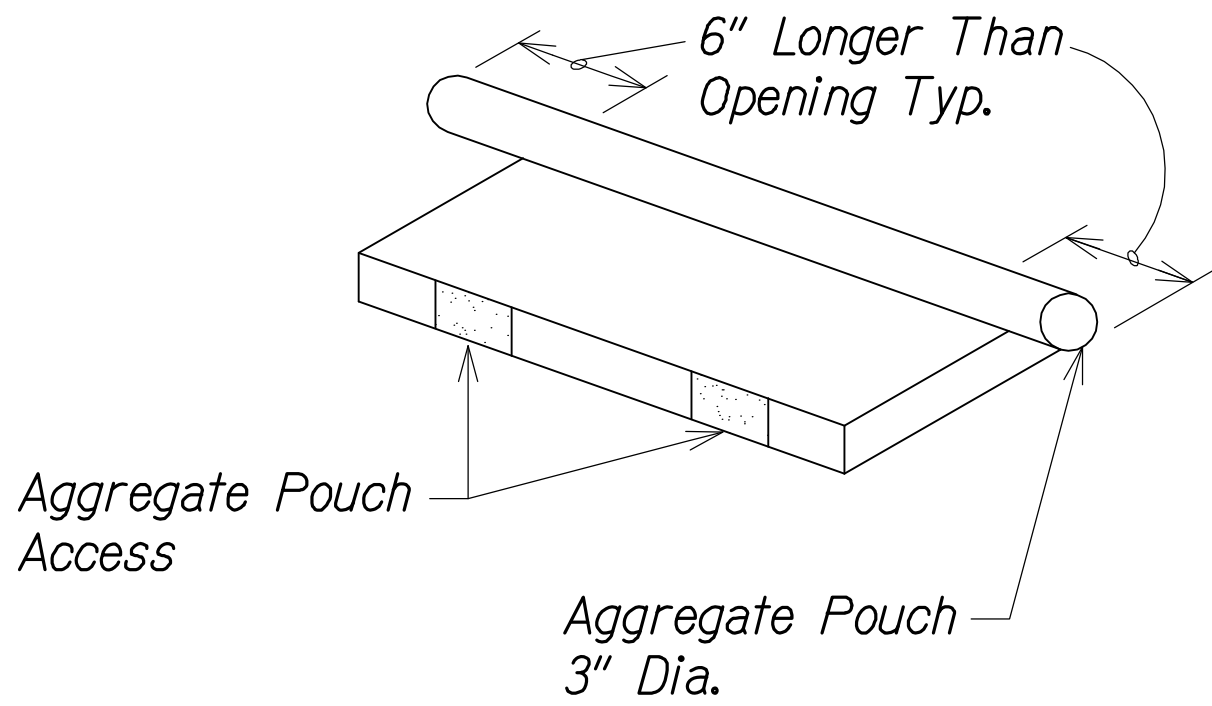


AGGREGATE POUCH AT CATCH BASIN OPENING
Not to Scale

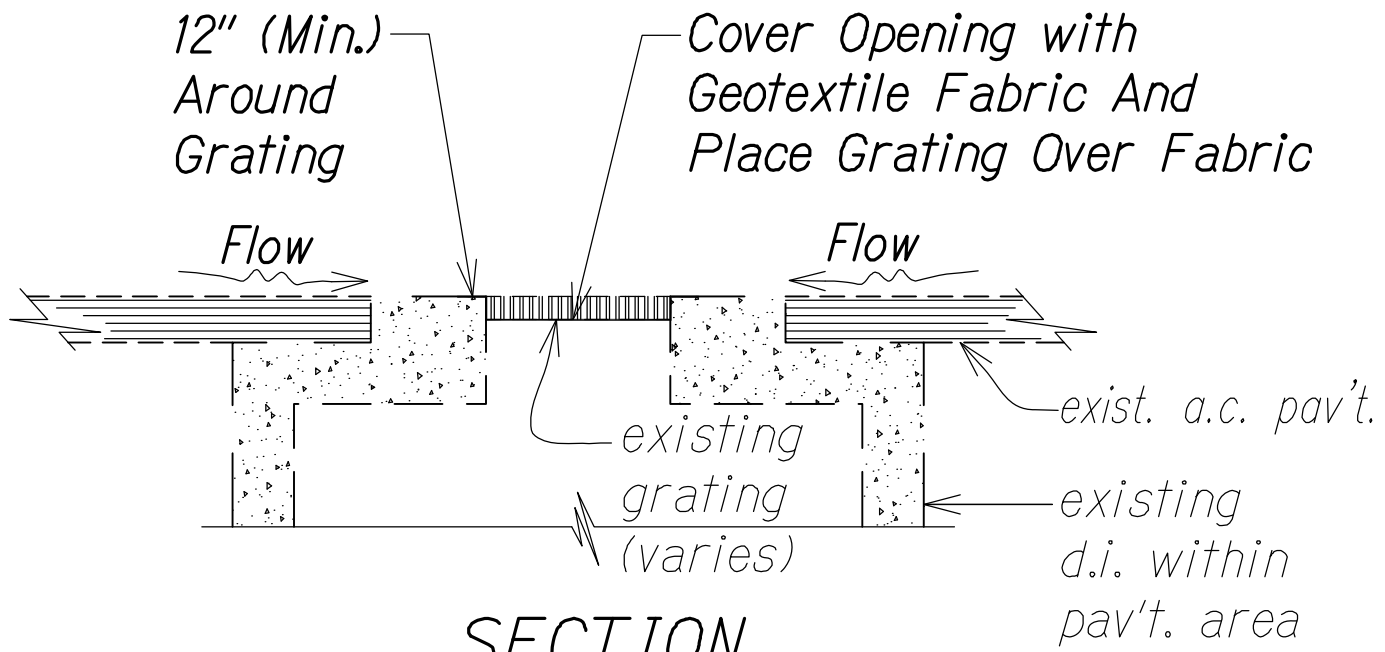

FILTER FABRIC AT GRATED DRAIN INLET
Not to Scale

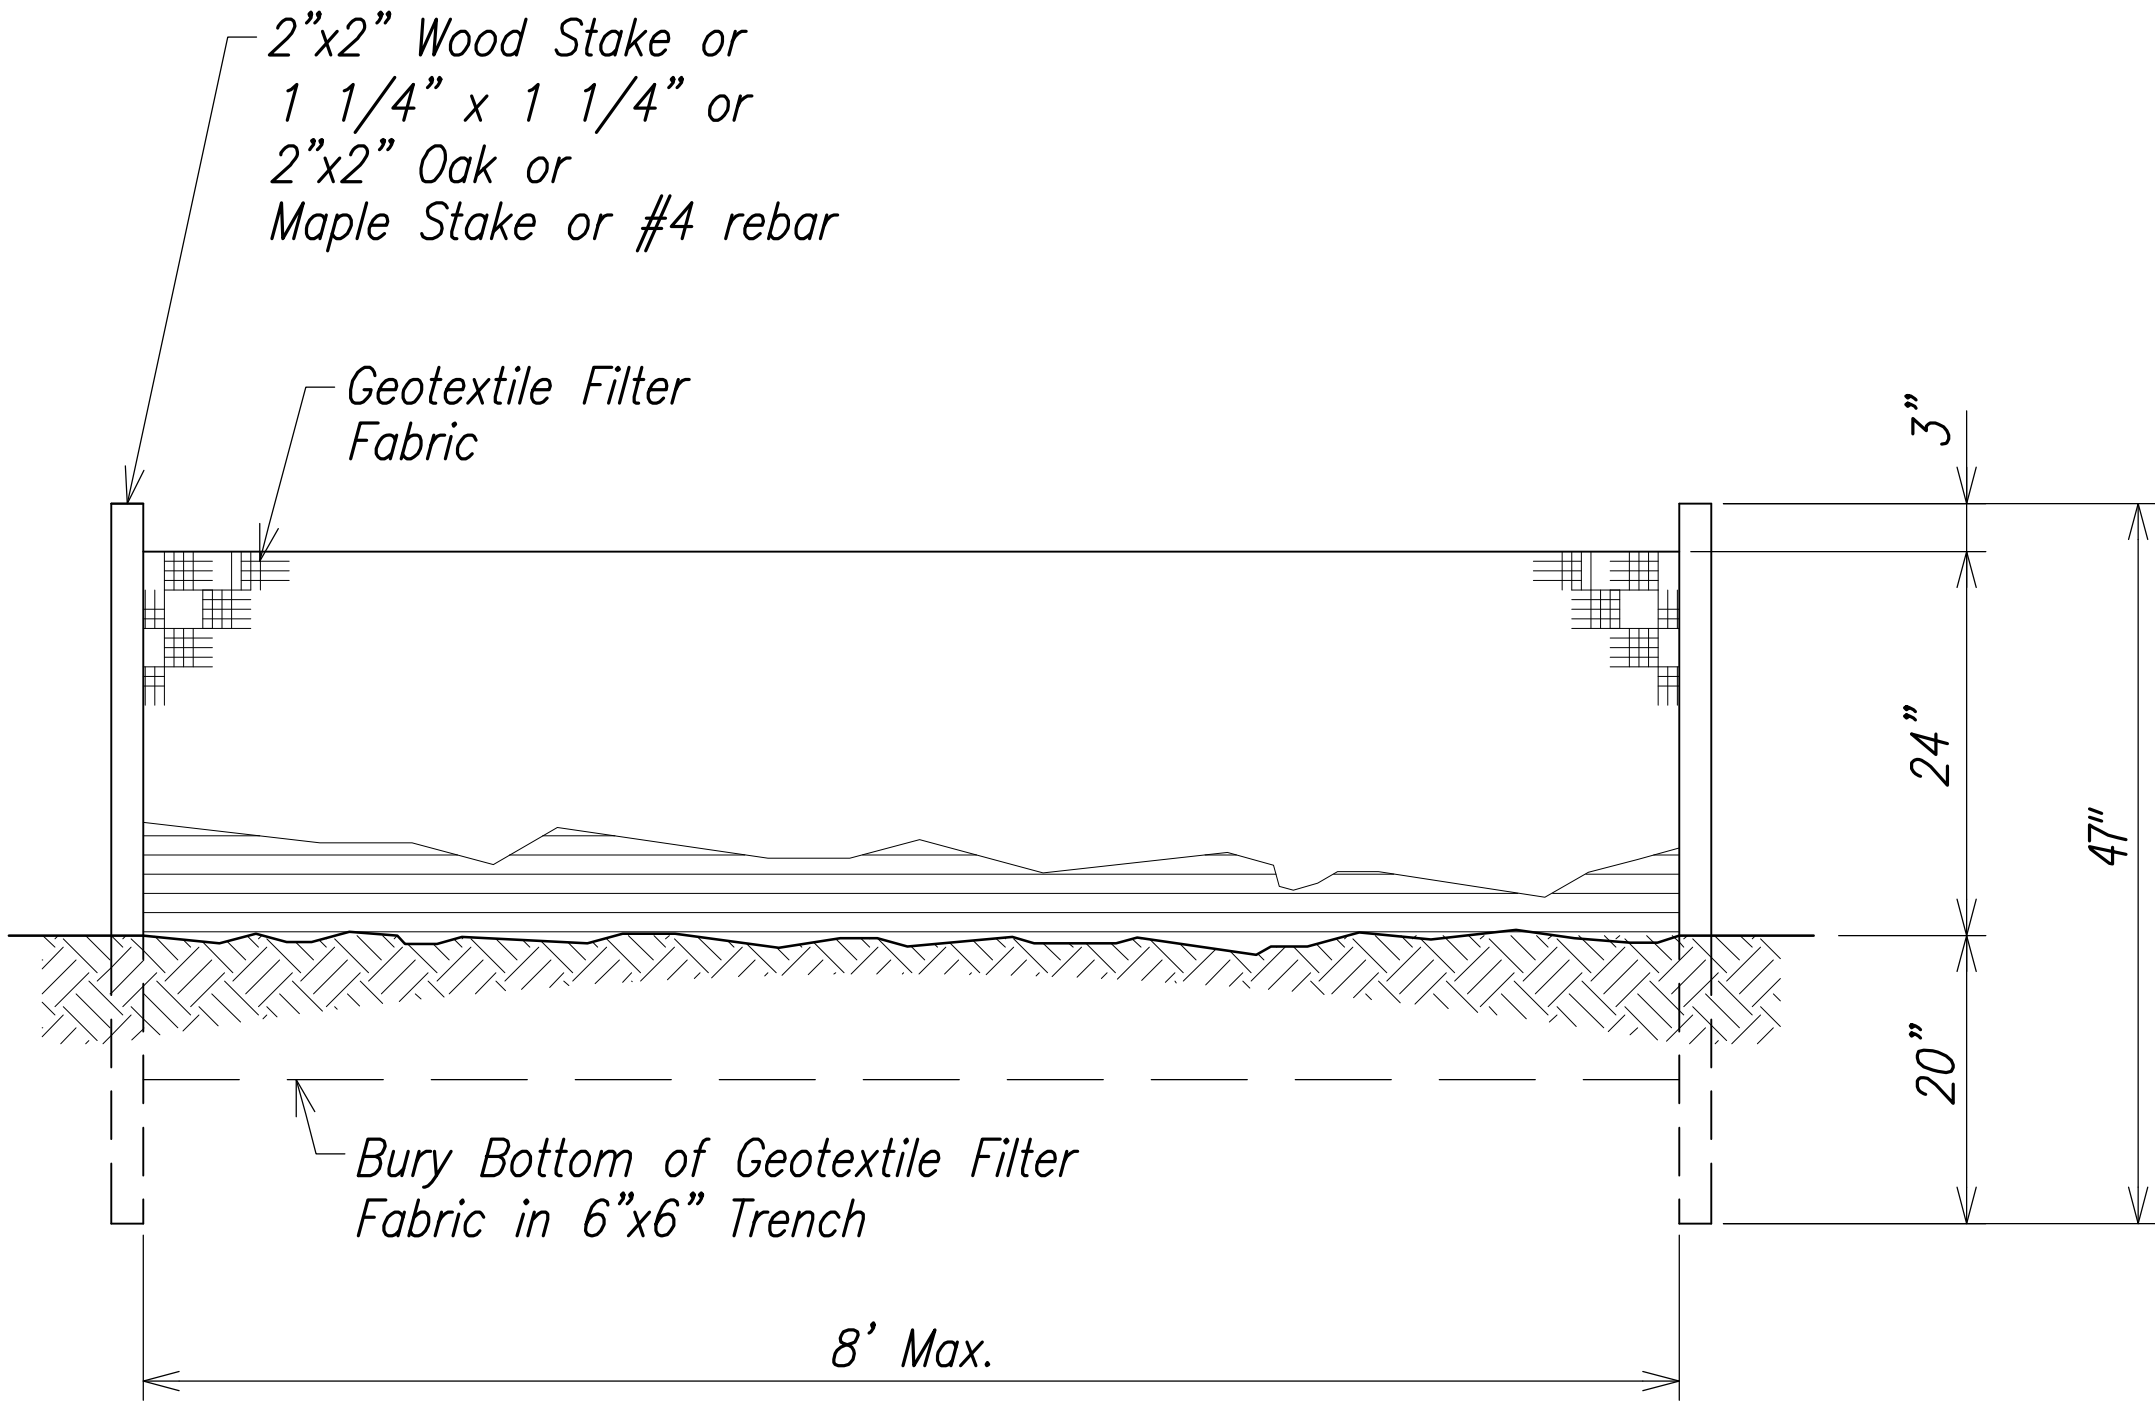

SILT FENCE DETAIL
Not to Scale

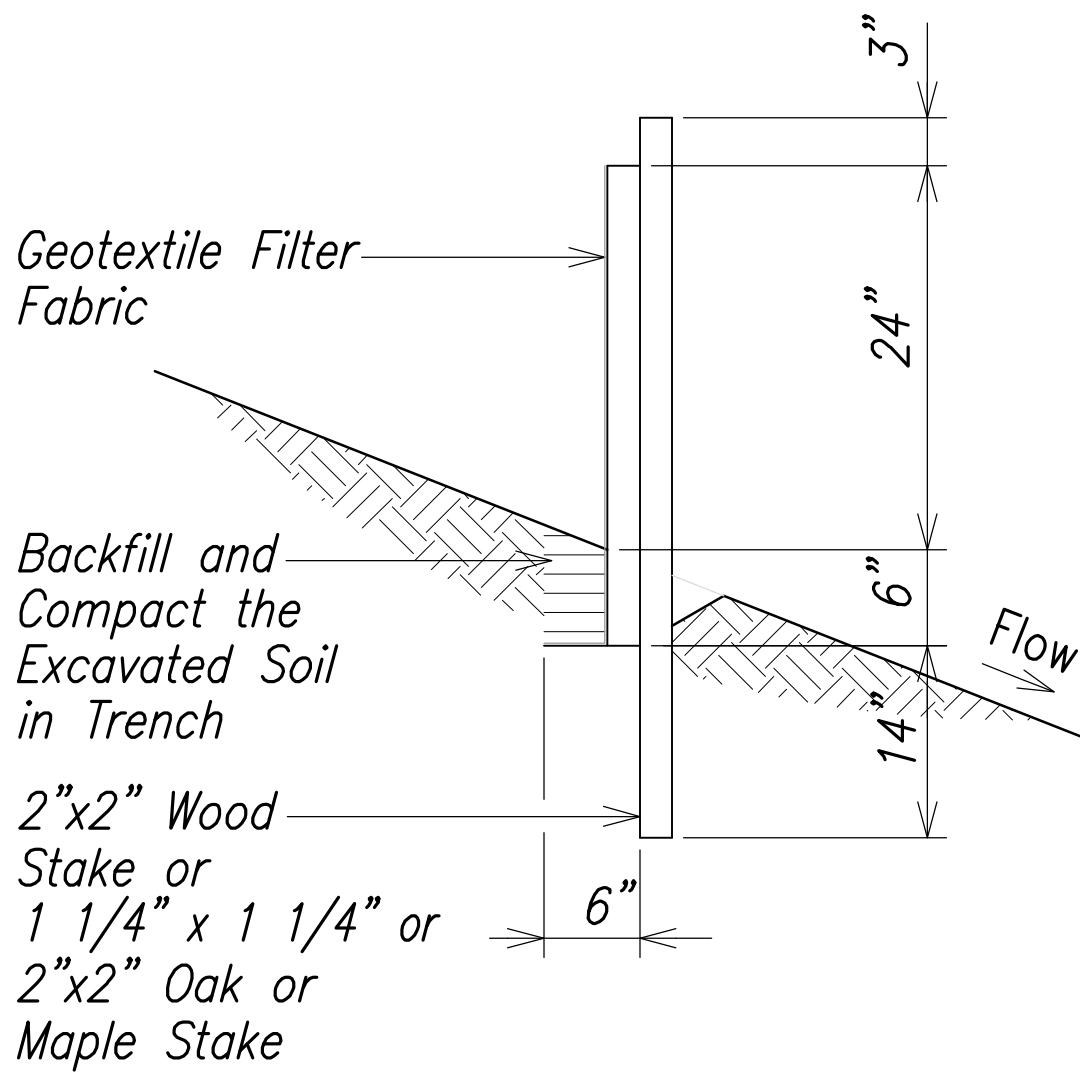

LEGEND FOR AS-BUILT POSTINGS	
	Squiggly line for as-built deletion
	Double line for as-built deletion
Roadway	Text for as-built posting



THIS WORK WAS PREPARED BY ME
OR UNDER MY SUPERVISION.
Matthew K. Fujioa
APRIL 30, 2016
WILSON OKAMOTO CORPORATION LIC. EXP. DATE

STATE OF HAWAII DEPARTMENT OF TRANSPORTATION HIGHWAYS DIVISION	
<u>EROSION CONTROL DETAILS</u>	
INTERSTATE ROUTE H-1 PM CONTRAFLOW LANE, PHASE 3 FEDERAL AID PROJECT NO. NH-H1-1 (260) Scale: Not to Scale Date: December, 2014	
SHEET No. DRD-04 OF 4 SHEETS	