


FED. ROAD DIST. NO.	STATE	FED. AID PROJ. NO.	FISCAL YEAR	SHEET NO.	TOTAL SHEETS
HAWAII	HAW.	NH-H1-1 (260)	2014	25	200

H-1 OUTBOUND # CURVE DATA	
Δ	42°00'
$\Delta/2$	21°00'
R	2500'
T	959.66'
C	1791.84'
LC	1832.60'

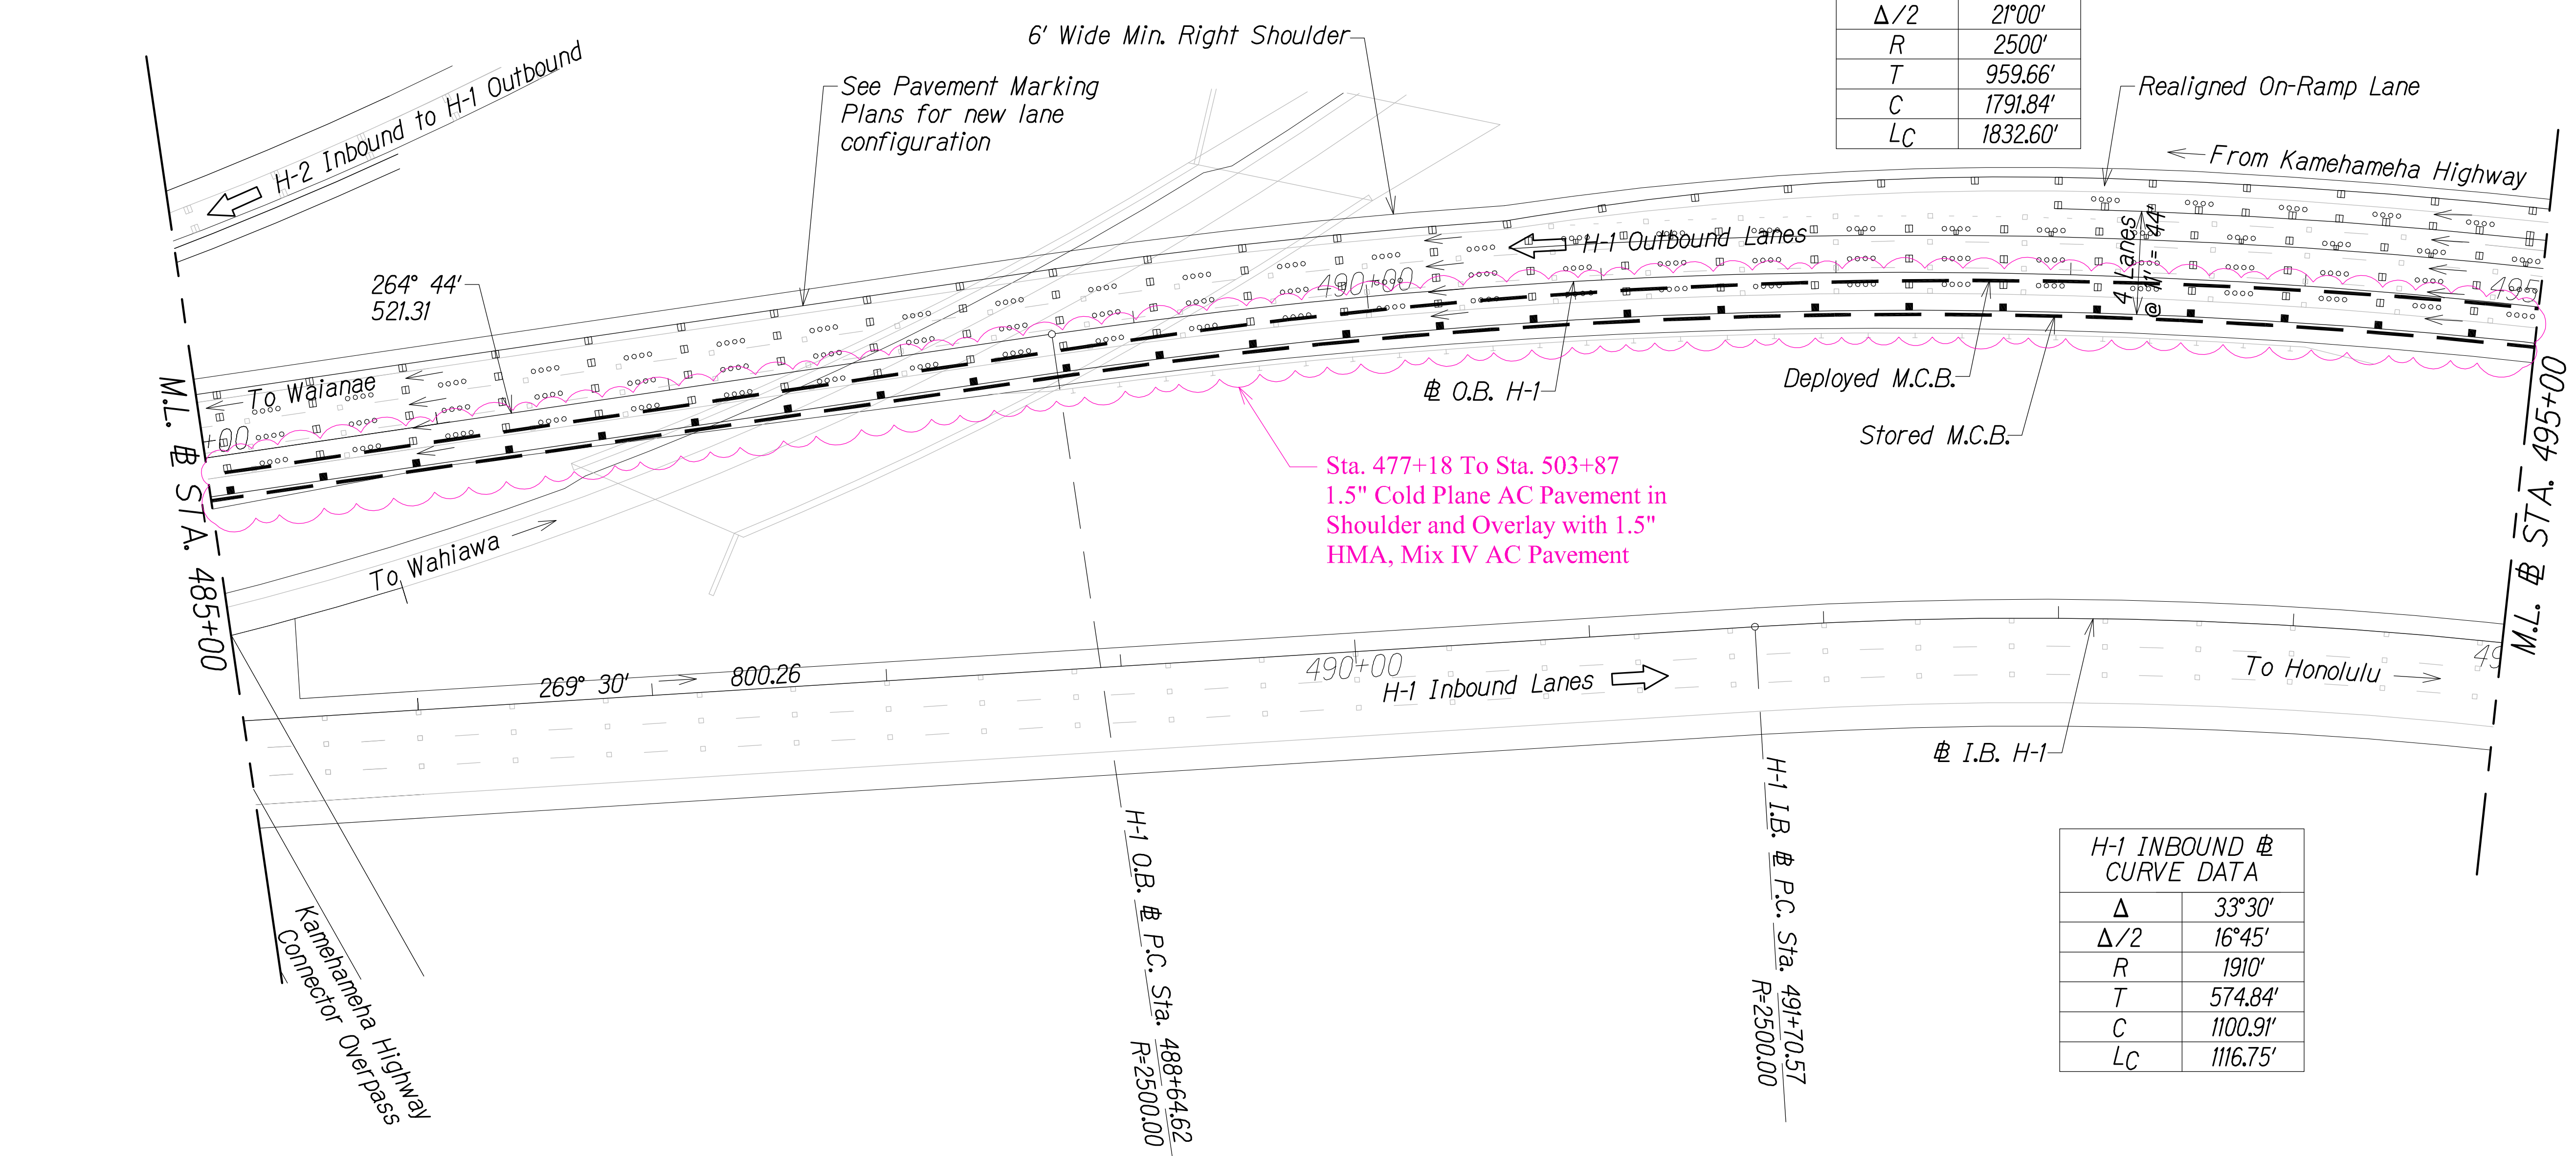

FED. ROAD DIST. NO.	STATE	FED. AID PROJ. NO.	FISCAL YEAR	SHEET NO.	TOTAL SHEETS
HAWAII	HAW.	NH-HI-1 (260)	2014	26	200

H-1 OUTBOUND # CURVE DATA	
Δ	42°00'
$\Delta/2$	21°00'
R	2500'
T	959.66'
C	1791.84'
LC	1832.60'

TRUE NORTH
SCALE: 1" = 40'

