




FED. ROAD DIST. NO.	STATE	FED. AID PROJ. NO.	FISCAL YEAR	SHEET NO.	TOTAL SHEETS
HAWAII	HAW.	NH-H1-1 (260)	2014	13	200

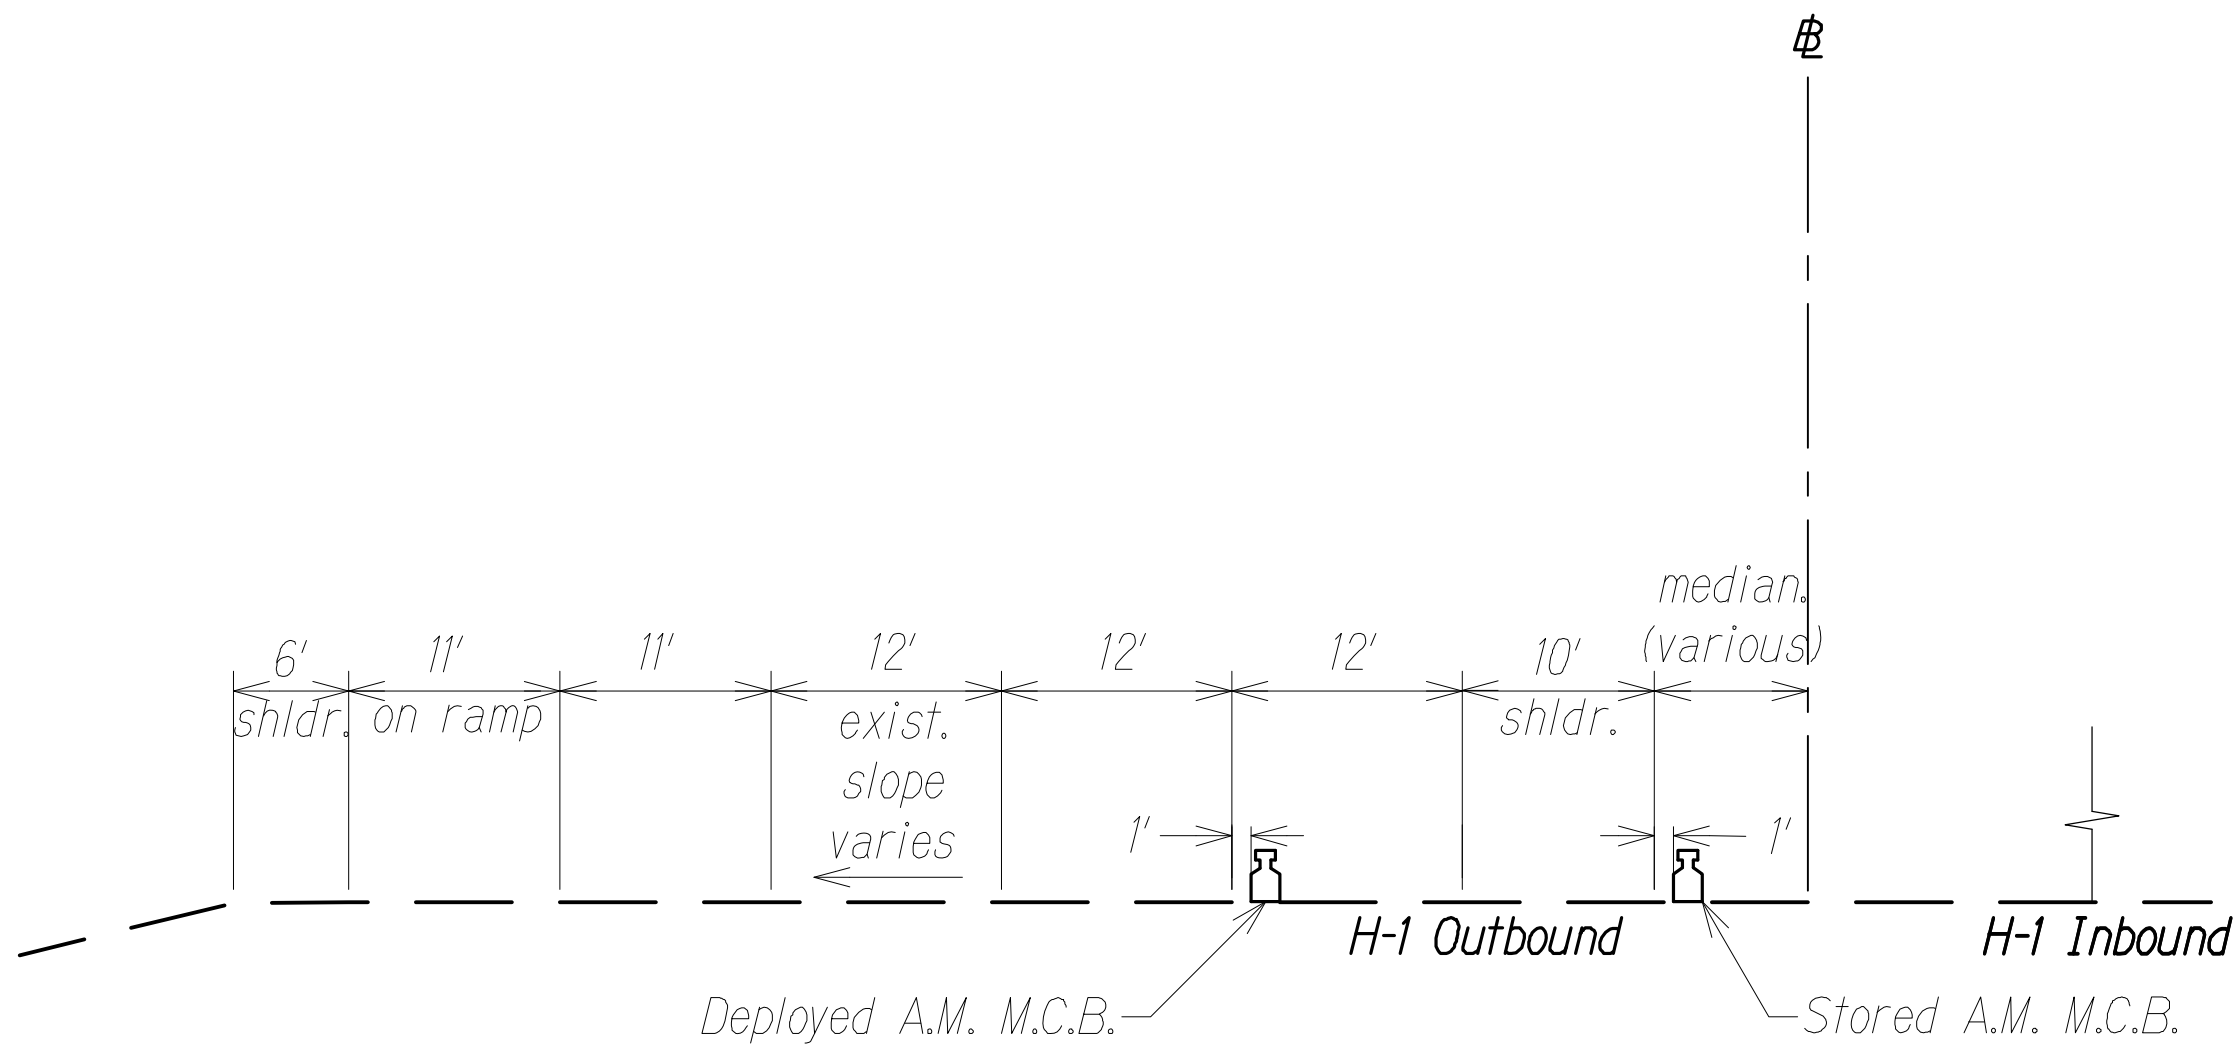


TYPICAL SECTION  
H-1 # STA. 456+10 TO H-1 # STA. 476+48  
Scale: 1" = 10'

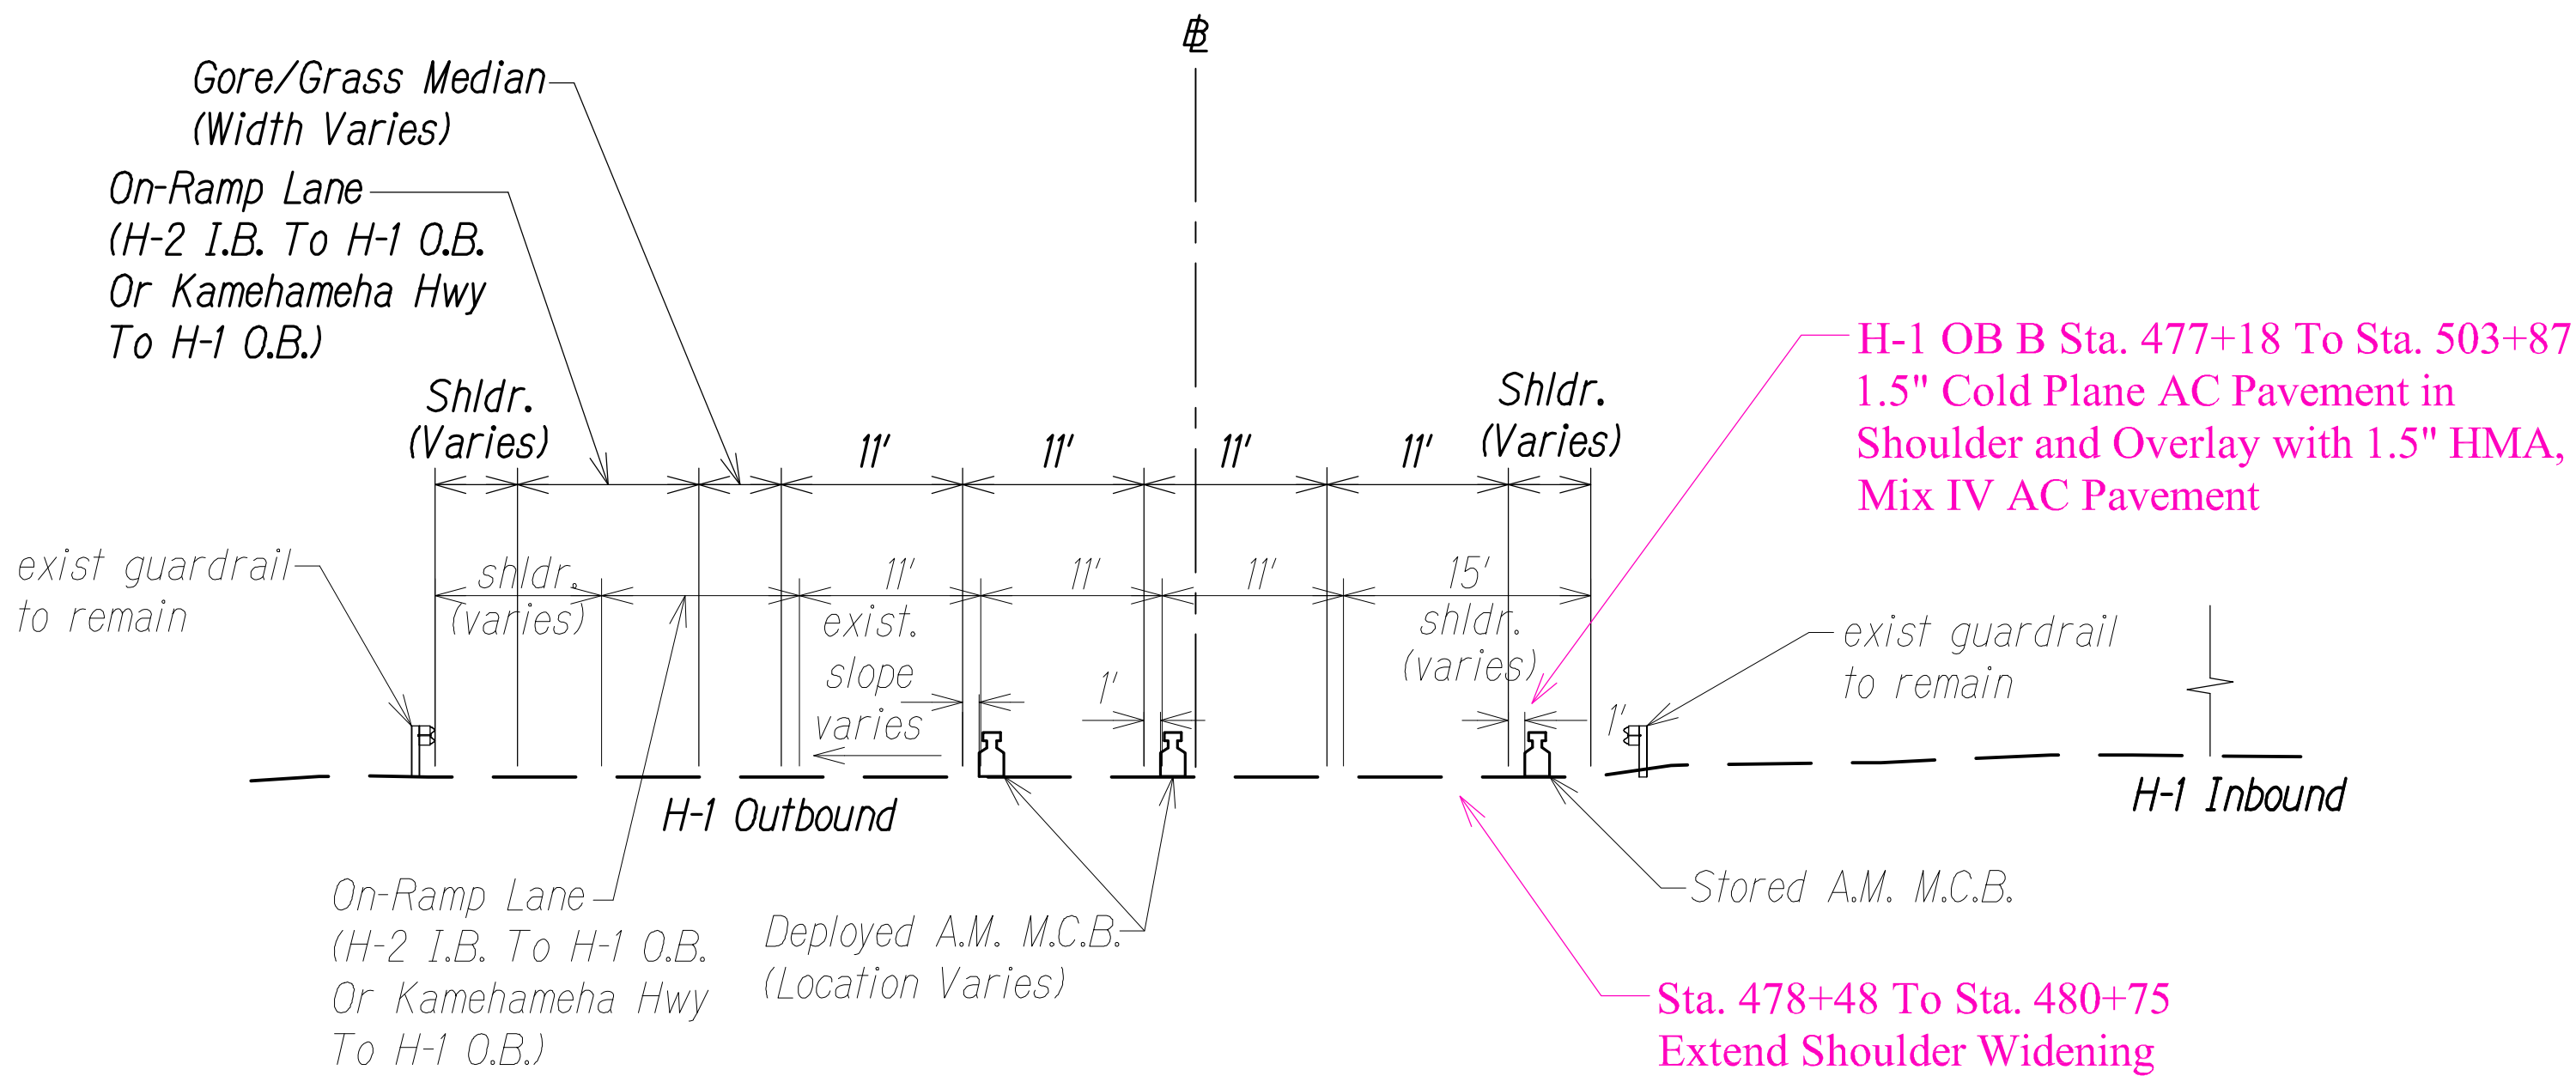

TYPICAL SECTION  
H-1 # STA. 476+48 TO H-1 # STA. 508+00  
Scale: 1" = 10'

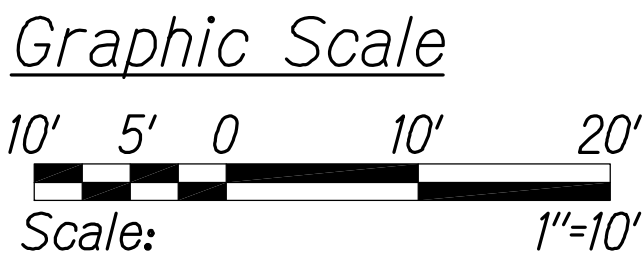

LEGEND FOR AS-BUILT POSTINGS	
	Squiggly line for as-built deletion
	Double line for as-built deletion
Roadway	Text for as-built posting

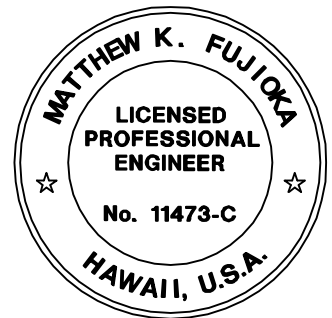

THIS WORK WAS PREPARED BY ME  
OR UNDER MY SUPERVISION.  
*Matthew K. Fujioa*  
WILSON OKAMOTO CORPORATION LIC. EXP. DATE

STATE OF HAWAII  
DEPARTMENT OF TRANSPORTATION  
HIGHWAYS DIVISION


TYPICAL SECTIONS

INTERSTATE ROUTE H-1  
PM CONTRAFLOW LANE, PHASE 3  
FEDERAL AID PROJECT NO. NH-H1-1 (260)  
Scale: 1" = XX' Date: December, 2014


SHEET No. RS-01 OF 9 SHEETS




FED. ROAD DIST. NO.	STATE	FED. AID PROJ. NO.	FISCAL YEAR	SHEET NO.	TOTAL SHEETS
HAWAII	HAW.	NH-H1-1 (260)	2014	15	200

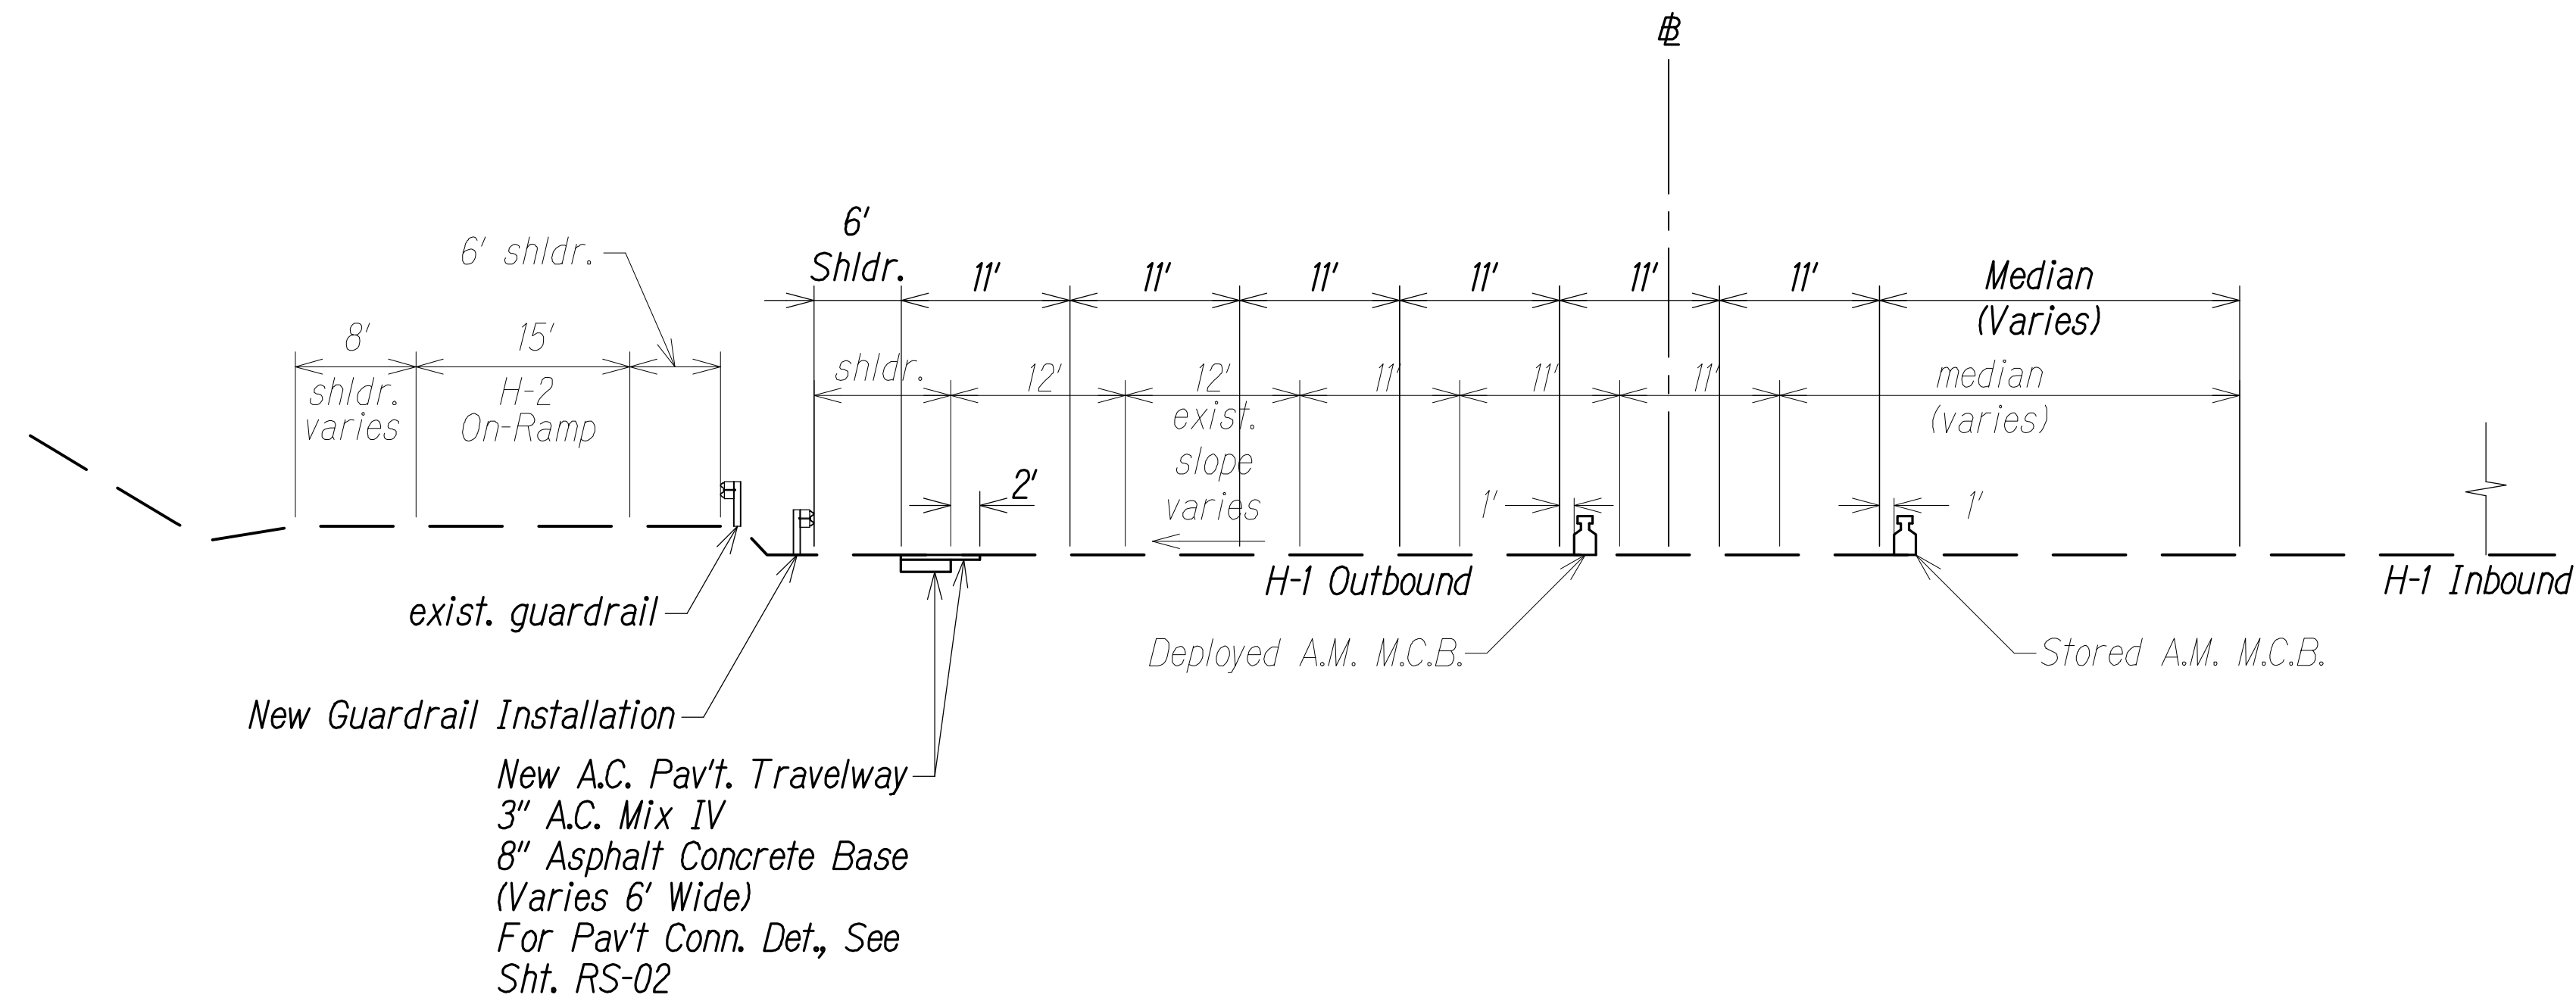

TYPICAL SECTION  
H-1  $\pm$  STA. 513+12 TO H-1  $\pm$  STA. 513+49  
Scale: 1" = 10'

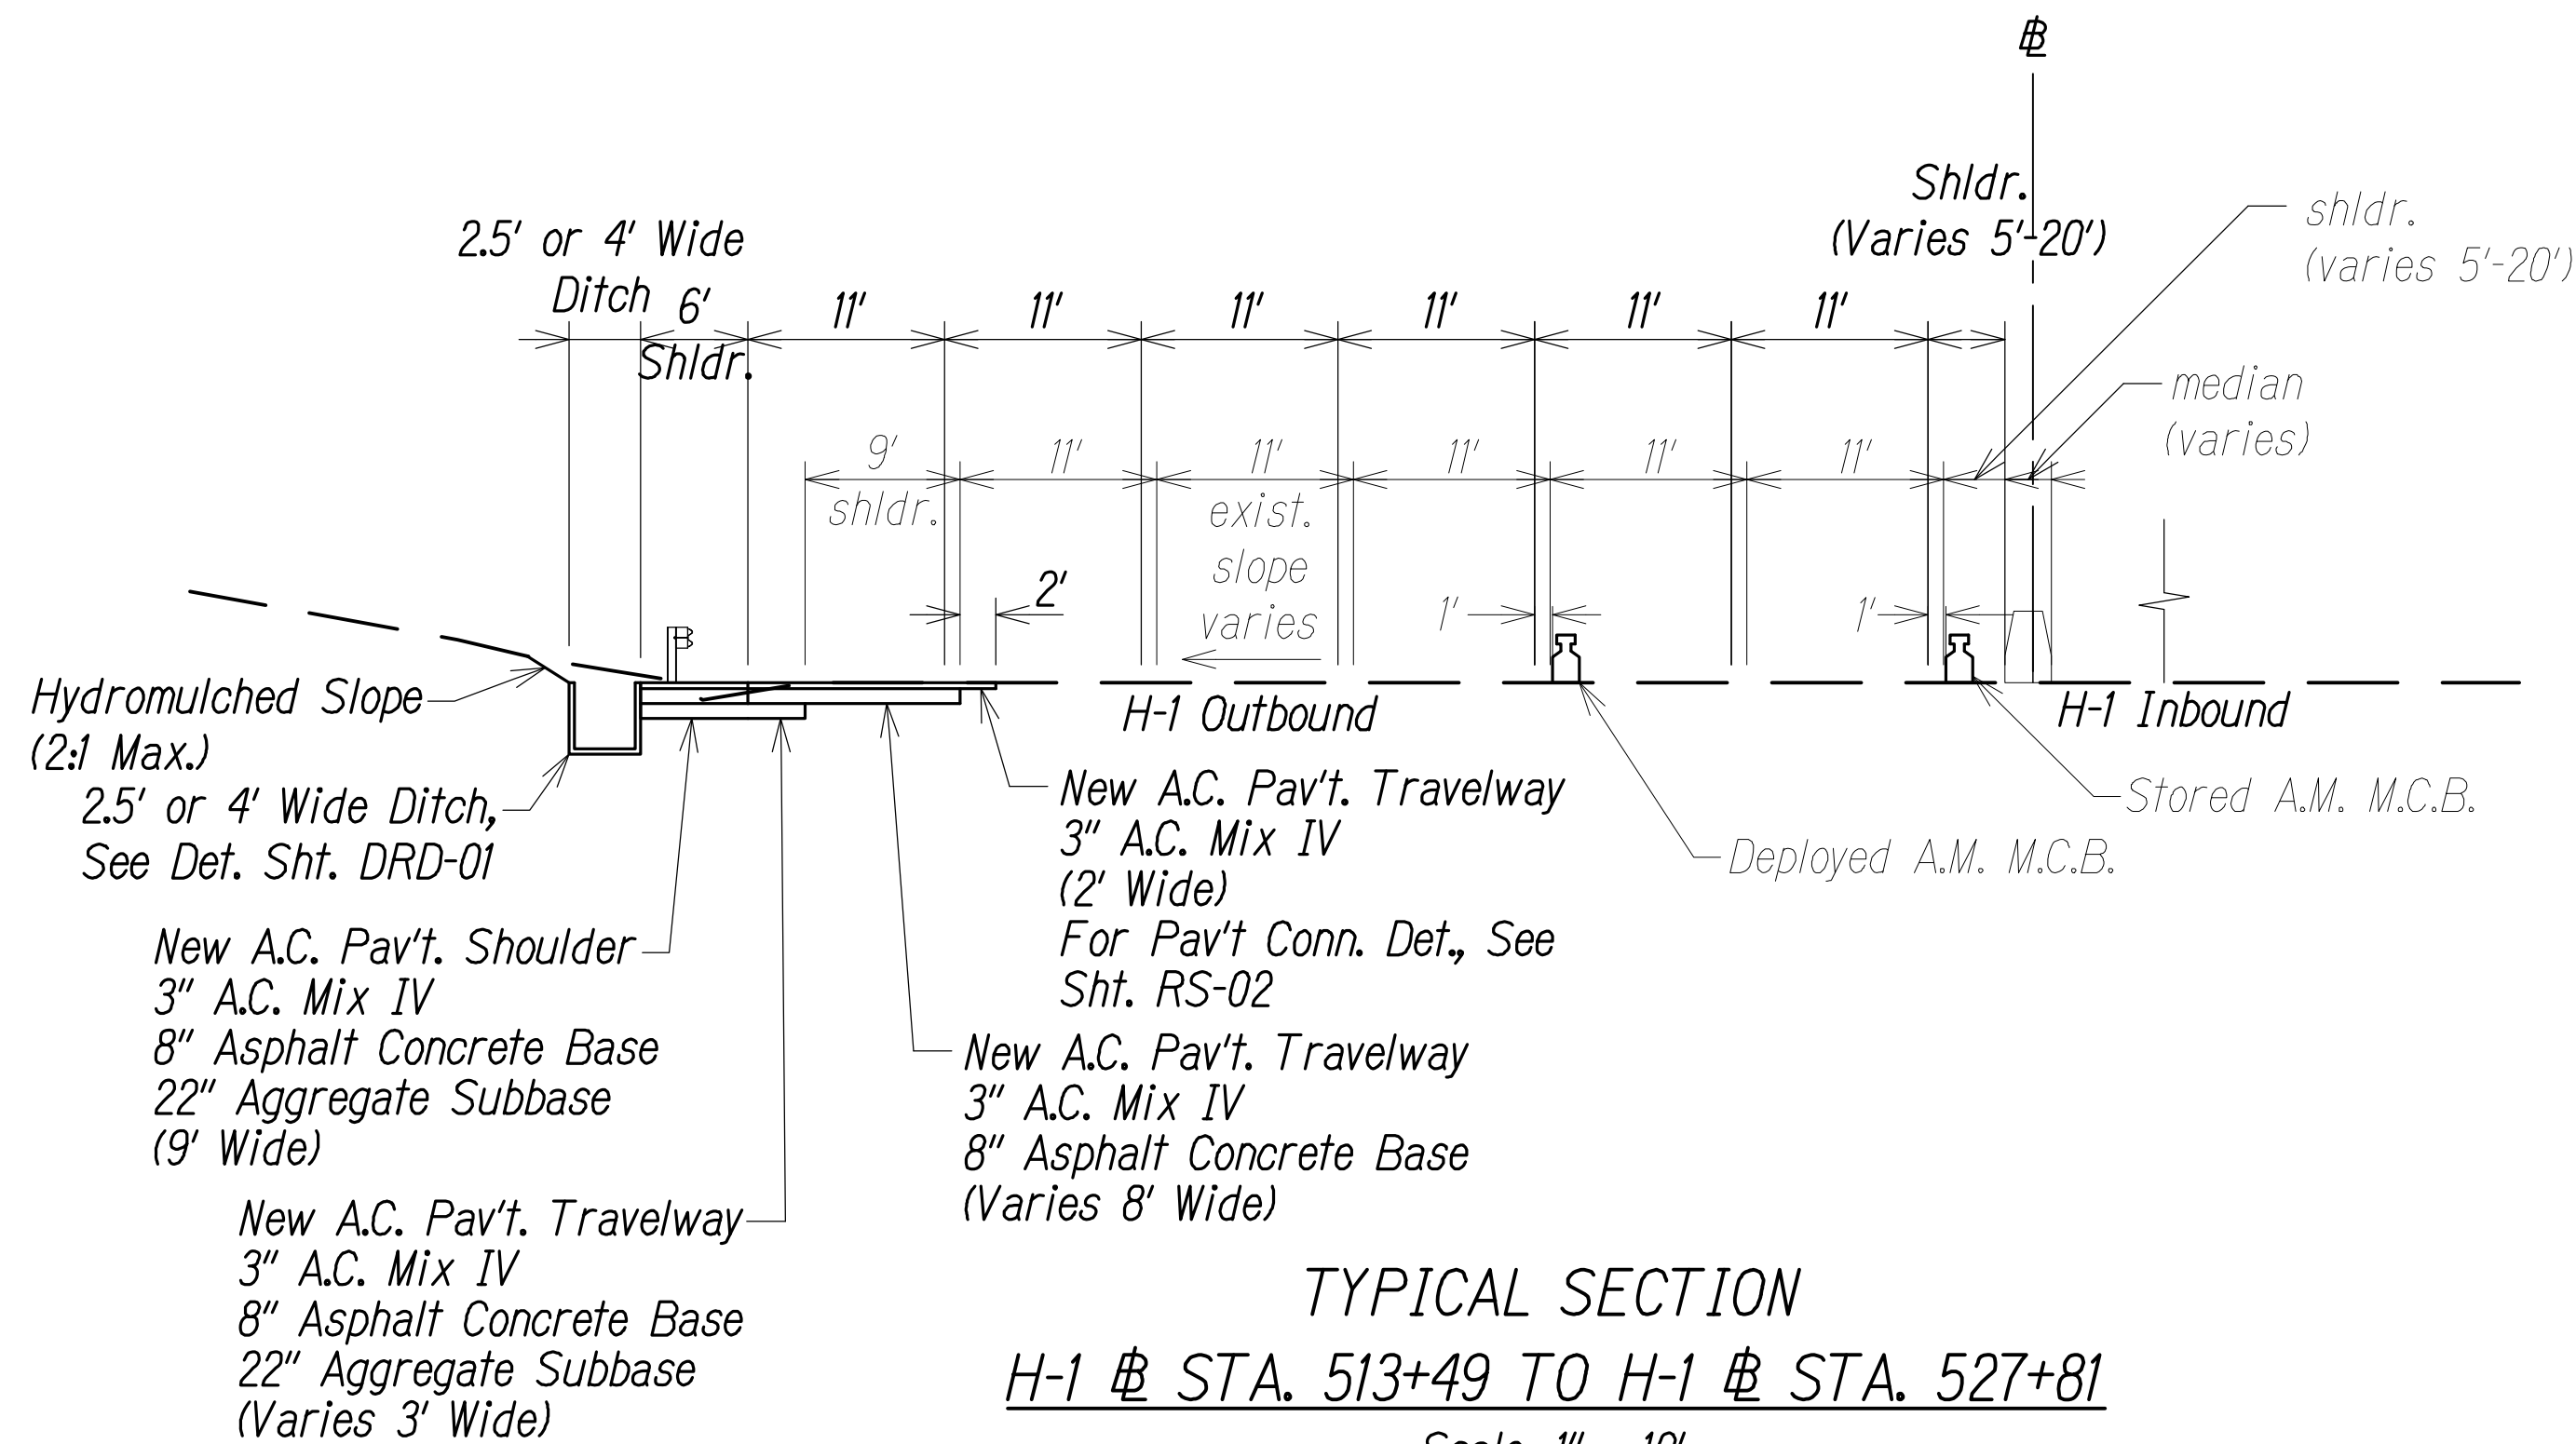

TYPICAL SECTION  
H-1  $\pm$  STA. 513+49 TO H-1  $\pm$  STA. 527+81  
Scale: 1" = 10'

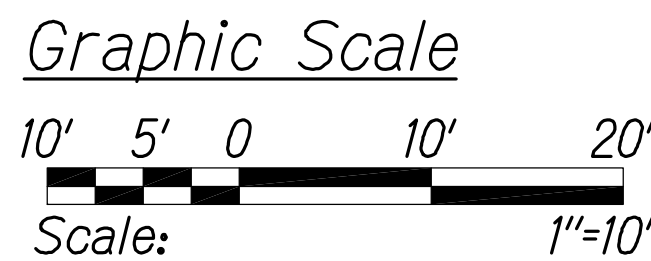

LEGEND FOR AS-BUILT POSTINGS	
	Squiggly line for as-built deletion
	Double line for as-built deletion
Roadway	Text for as-built posting

STATE OF HAWAII  
DEPARTMENT OF TRANSPORTATION  
HIGHWAYS DIVISION

**TYPICAL SECTIONS**

INTERSTATE ROUTE H-1  
PM CONTRAFLOW LANE, PHASE 3  
FEDERAL AID PROJECT NO. NH-H1-1 (260)  
Scale: 1" = XX' Date: December, 2014

SHEET No. RS-03 of 9 SHEETS






THIS WORK WAS PREPARED BY ME  
OR UNDER MY SUPERVISION.  
*Matthew K. Fujioka*  
APRIL 30, 2016  
WILSON OKAMOTO CORPORATION LIC. EXP. DATE





FED. ROAD DIST. NO.	STATE	FED. AID PROJ. NO.	FISCAL YEAR	SHEET NO.	TOTAL SHEETS
HAWAII	HAW.	NH-H1-1 (260)	2014	17	200

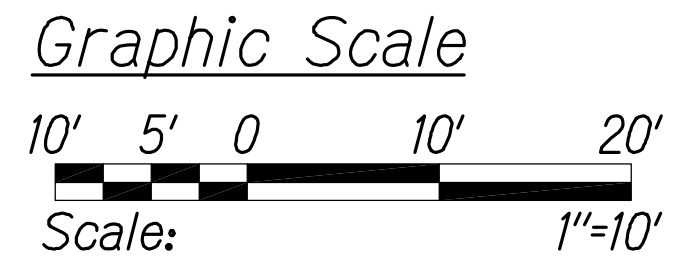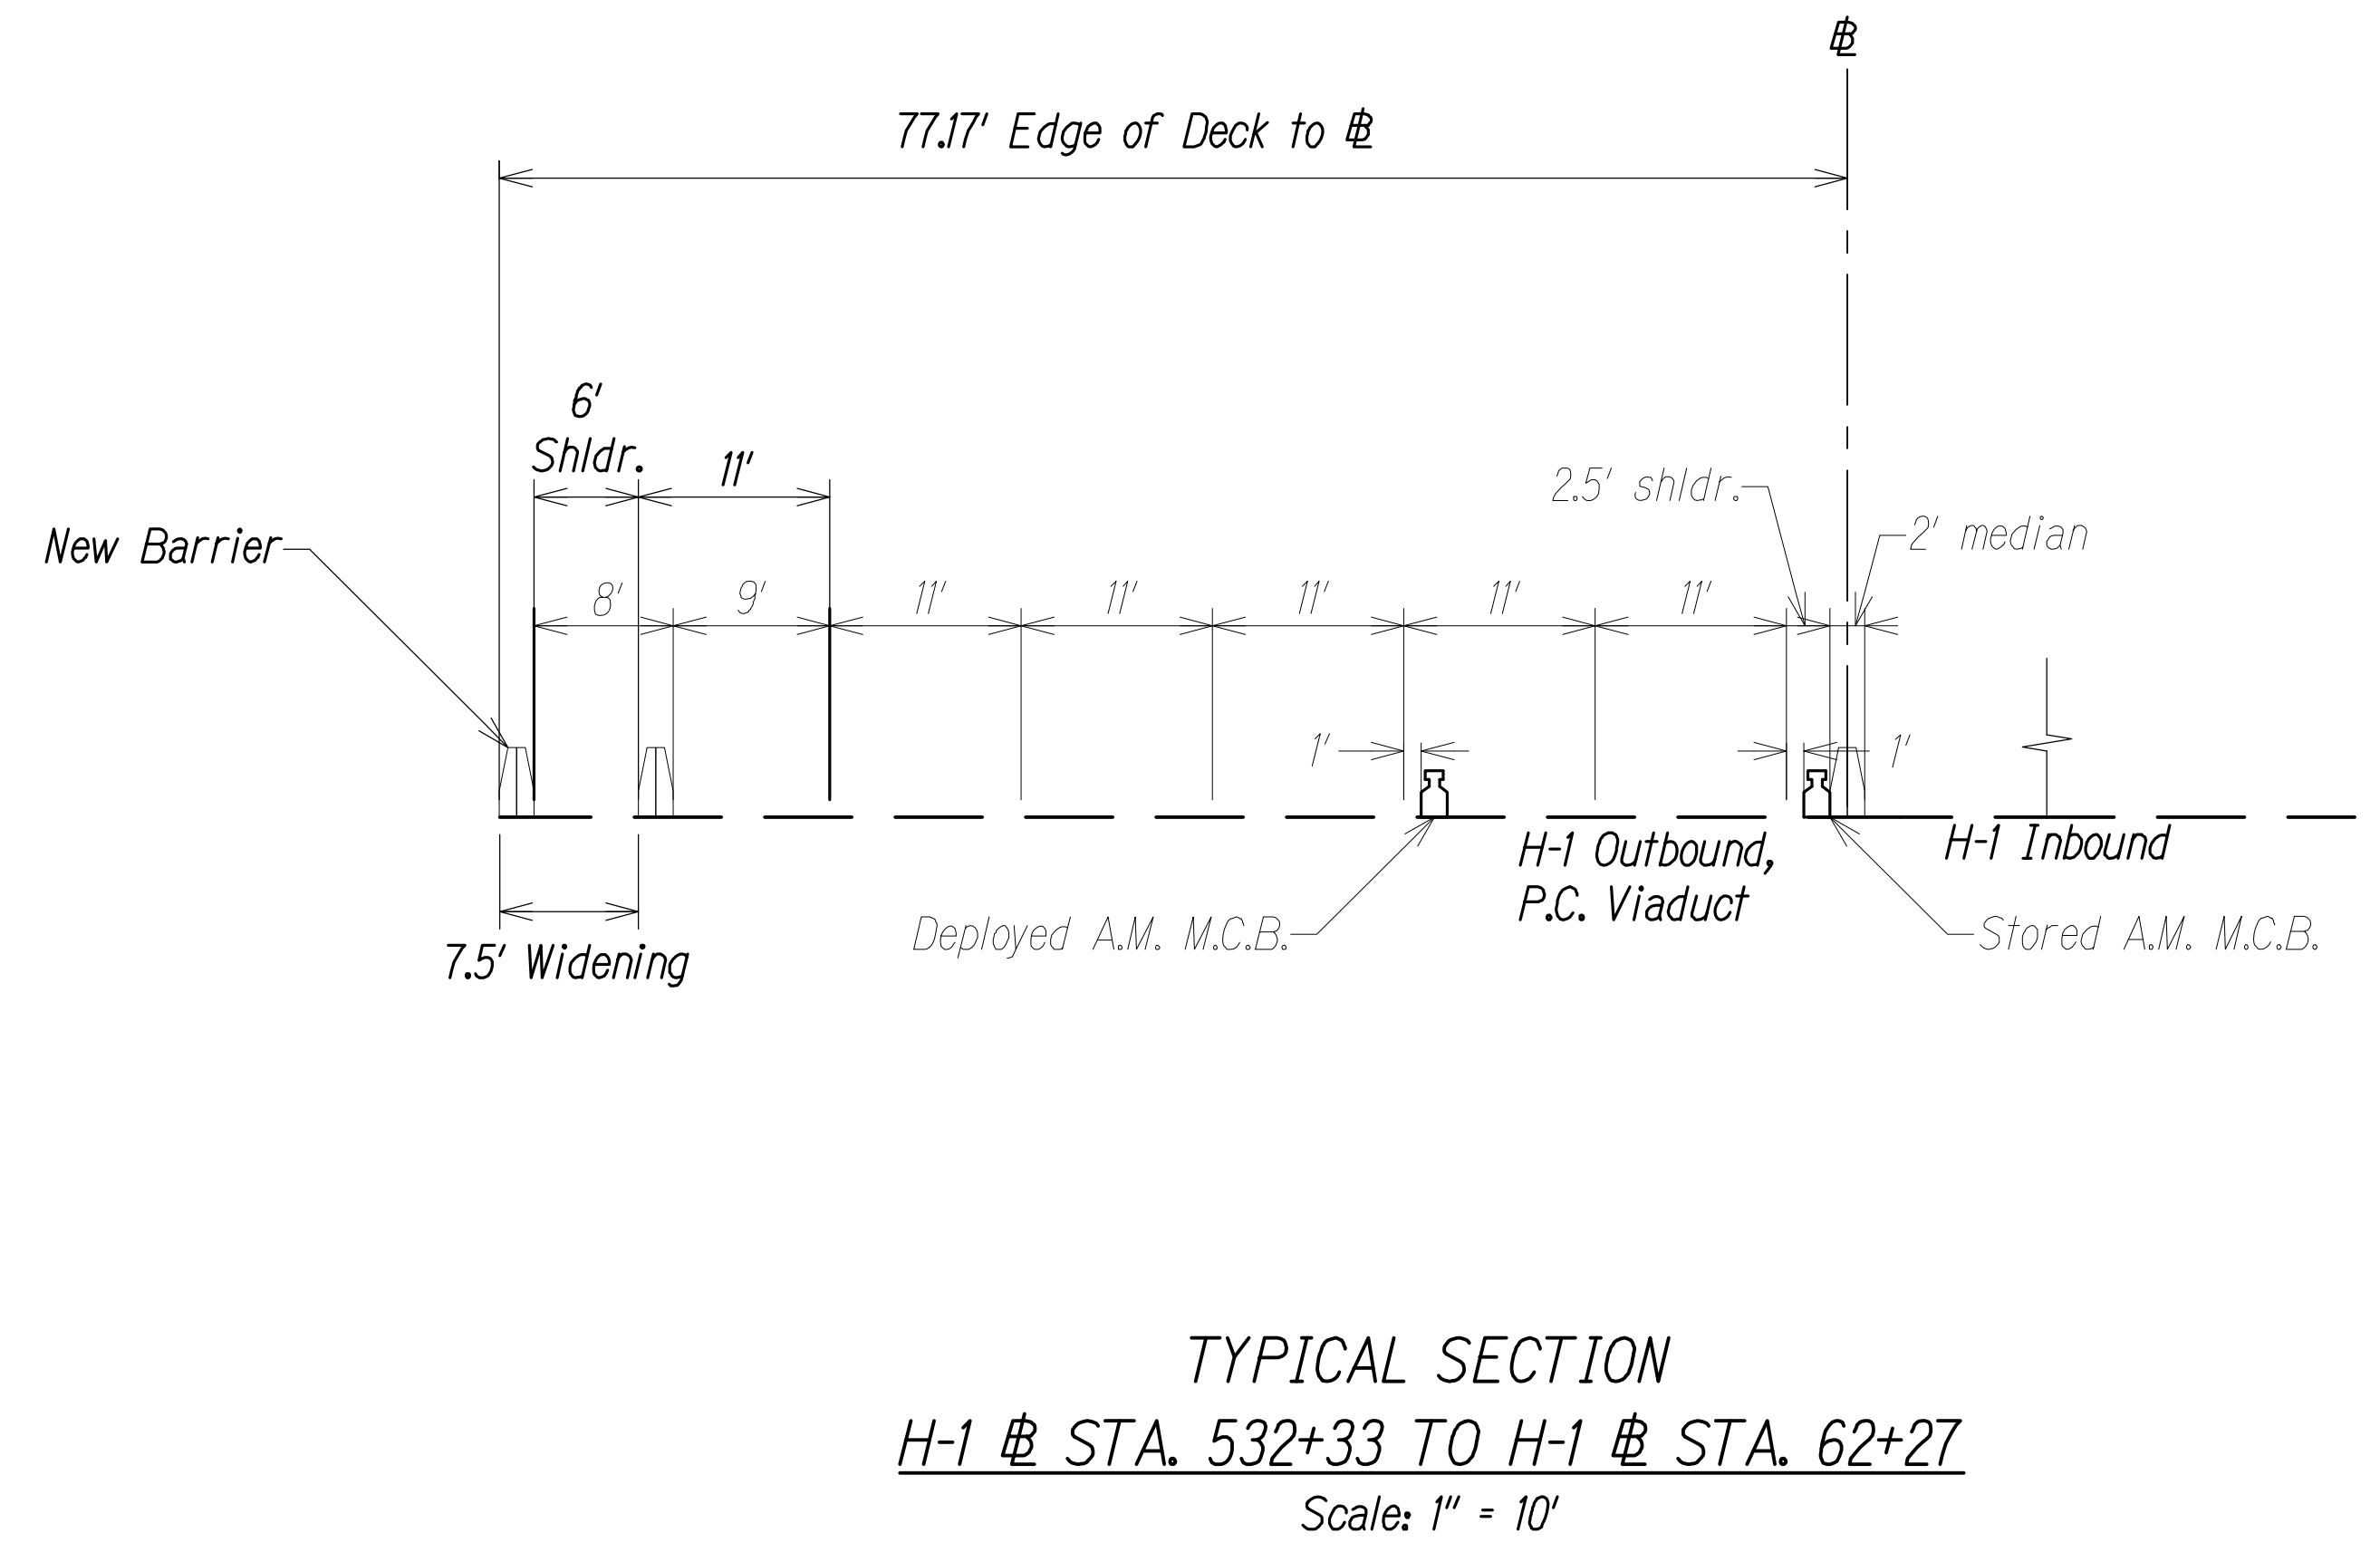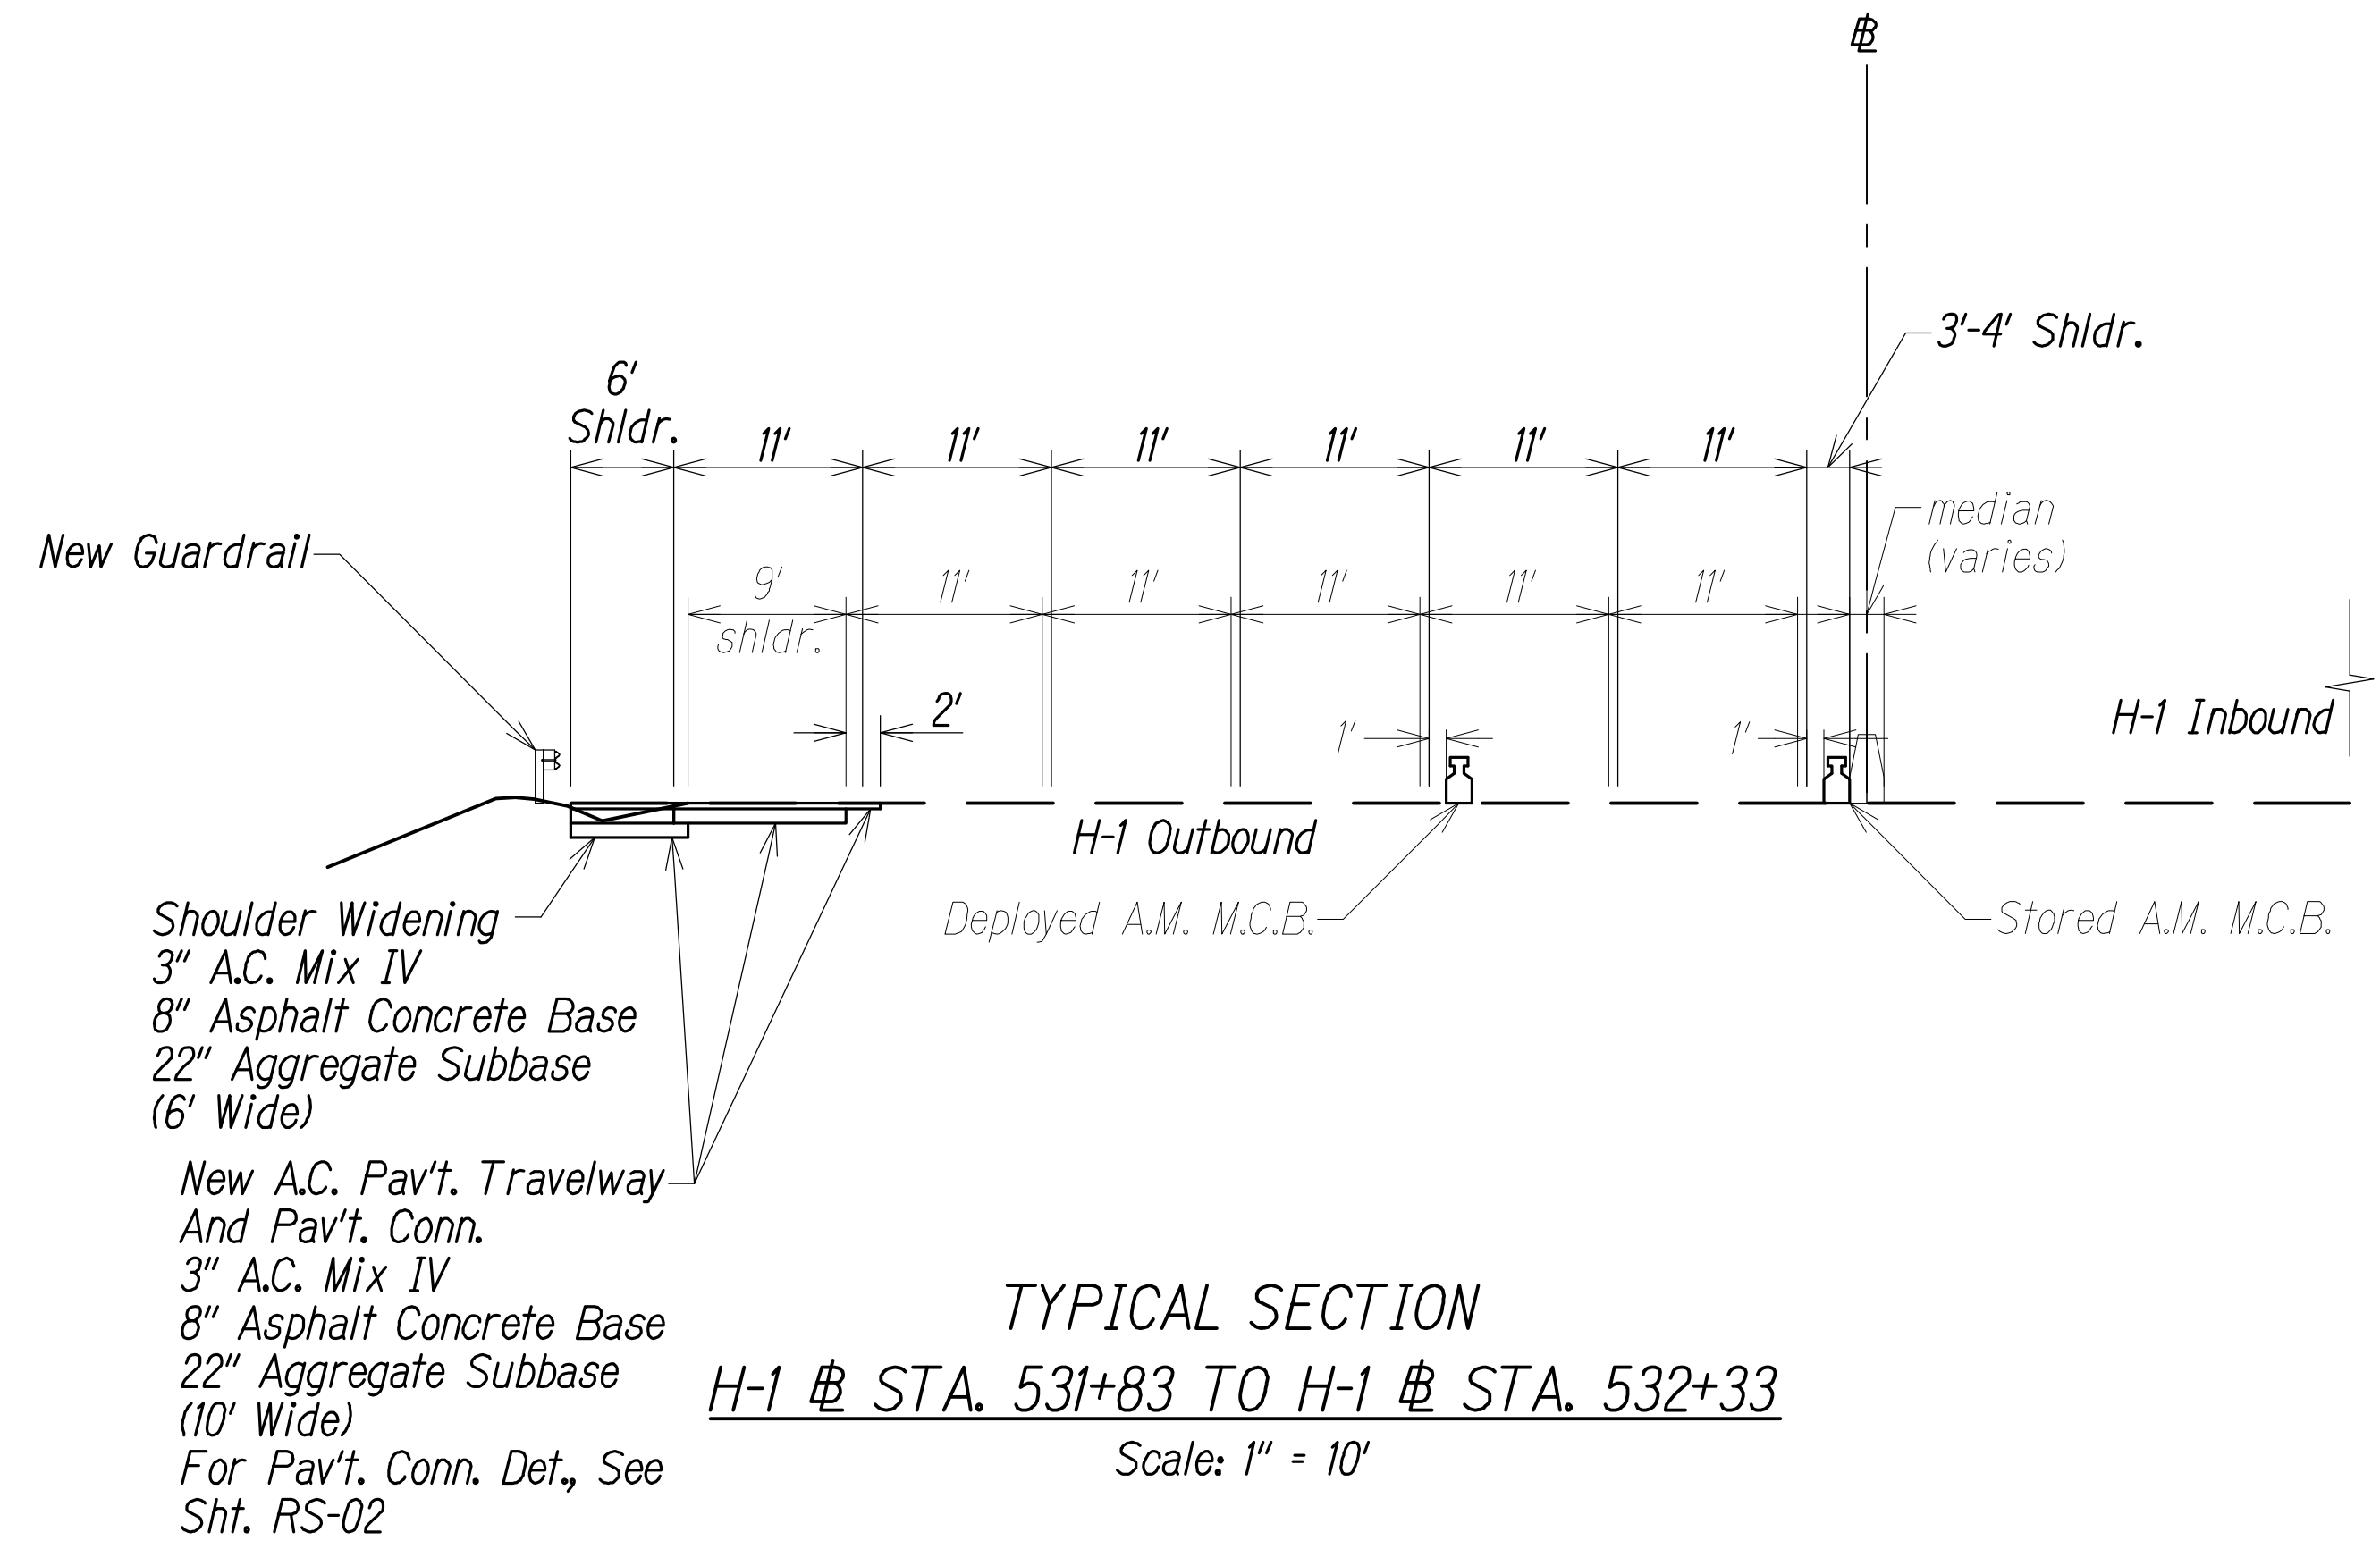

**LEGEND FOR AS-BUILT POSTINGS**

~~~~~ Squiggly line for as-built deletion

±00.00± Double line for as-built deletion

Roadway Text for as-built posting

STATE OF HAWAII  
DEPARTMENT OF TRANSPORTATION  
HIGHWAYS DIVISION

**TYPICAL SECTIONS**

INTERSTATE ROUTE H-1  
PM CONTRAFLOW LANE, PHASE 3  
FEDERAL AID PROJECT NO. NH-H1-1 (260)  
Scale: 1" = XX' Date: December, 2014

SHEET No. RS-05 of 9 SHEETS




THIS WORK WAS PREPARED BY ME  
OR UNDER MY SUPERVISION.  
*Matthew K. Fujioa*  
WILSON OKAMOTO CORPORATION APRIL 30, 2016 LIC. EXP. DATE

|              |      |      |              |
|--------------|------|------|--------------|
| QC/QA REVIEW | 100% | DATE | JUL 12, 2015 |
| BY           |      |      |              |
| BY           |      |      |              |
| BY           |      |      |              |
| BY           |      |      |              |


|                   |      |
|-------------------|------|
| SURVEY PLOTTED BY | DATE |
| DRAWN BY          |      |
| TRACED BY         |      |
| DESIGNED BY       |      |
| QUANTITIES BY     |      |
| CHECKED BY        |      |

|               |     |
|---------------|-----|
| ORIGINAL PLAN | No. |
| NOTE BOOK     |     |


|                     |       |                    |             |           |              |
|---------------------|-------|--------------------|-------------|-----------|--------------|
| FED. ROAD DIST. NO. | STATE | FED. AID PROJ. NO. | FISCAL YEAR | SHEET NO. | TOTAL SHEETS |
| HAWAII              | HAW.  | NH-HI-1 (260)      | 2014        | 18        | 200          |

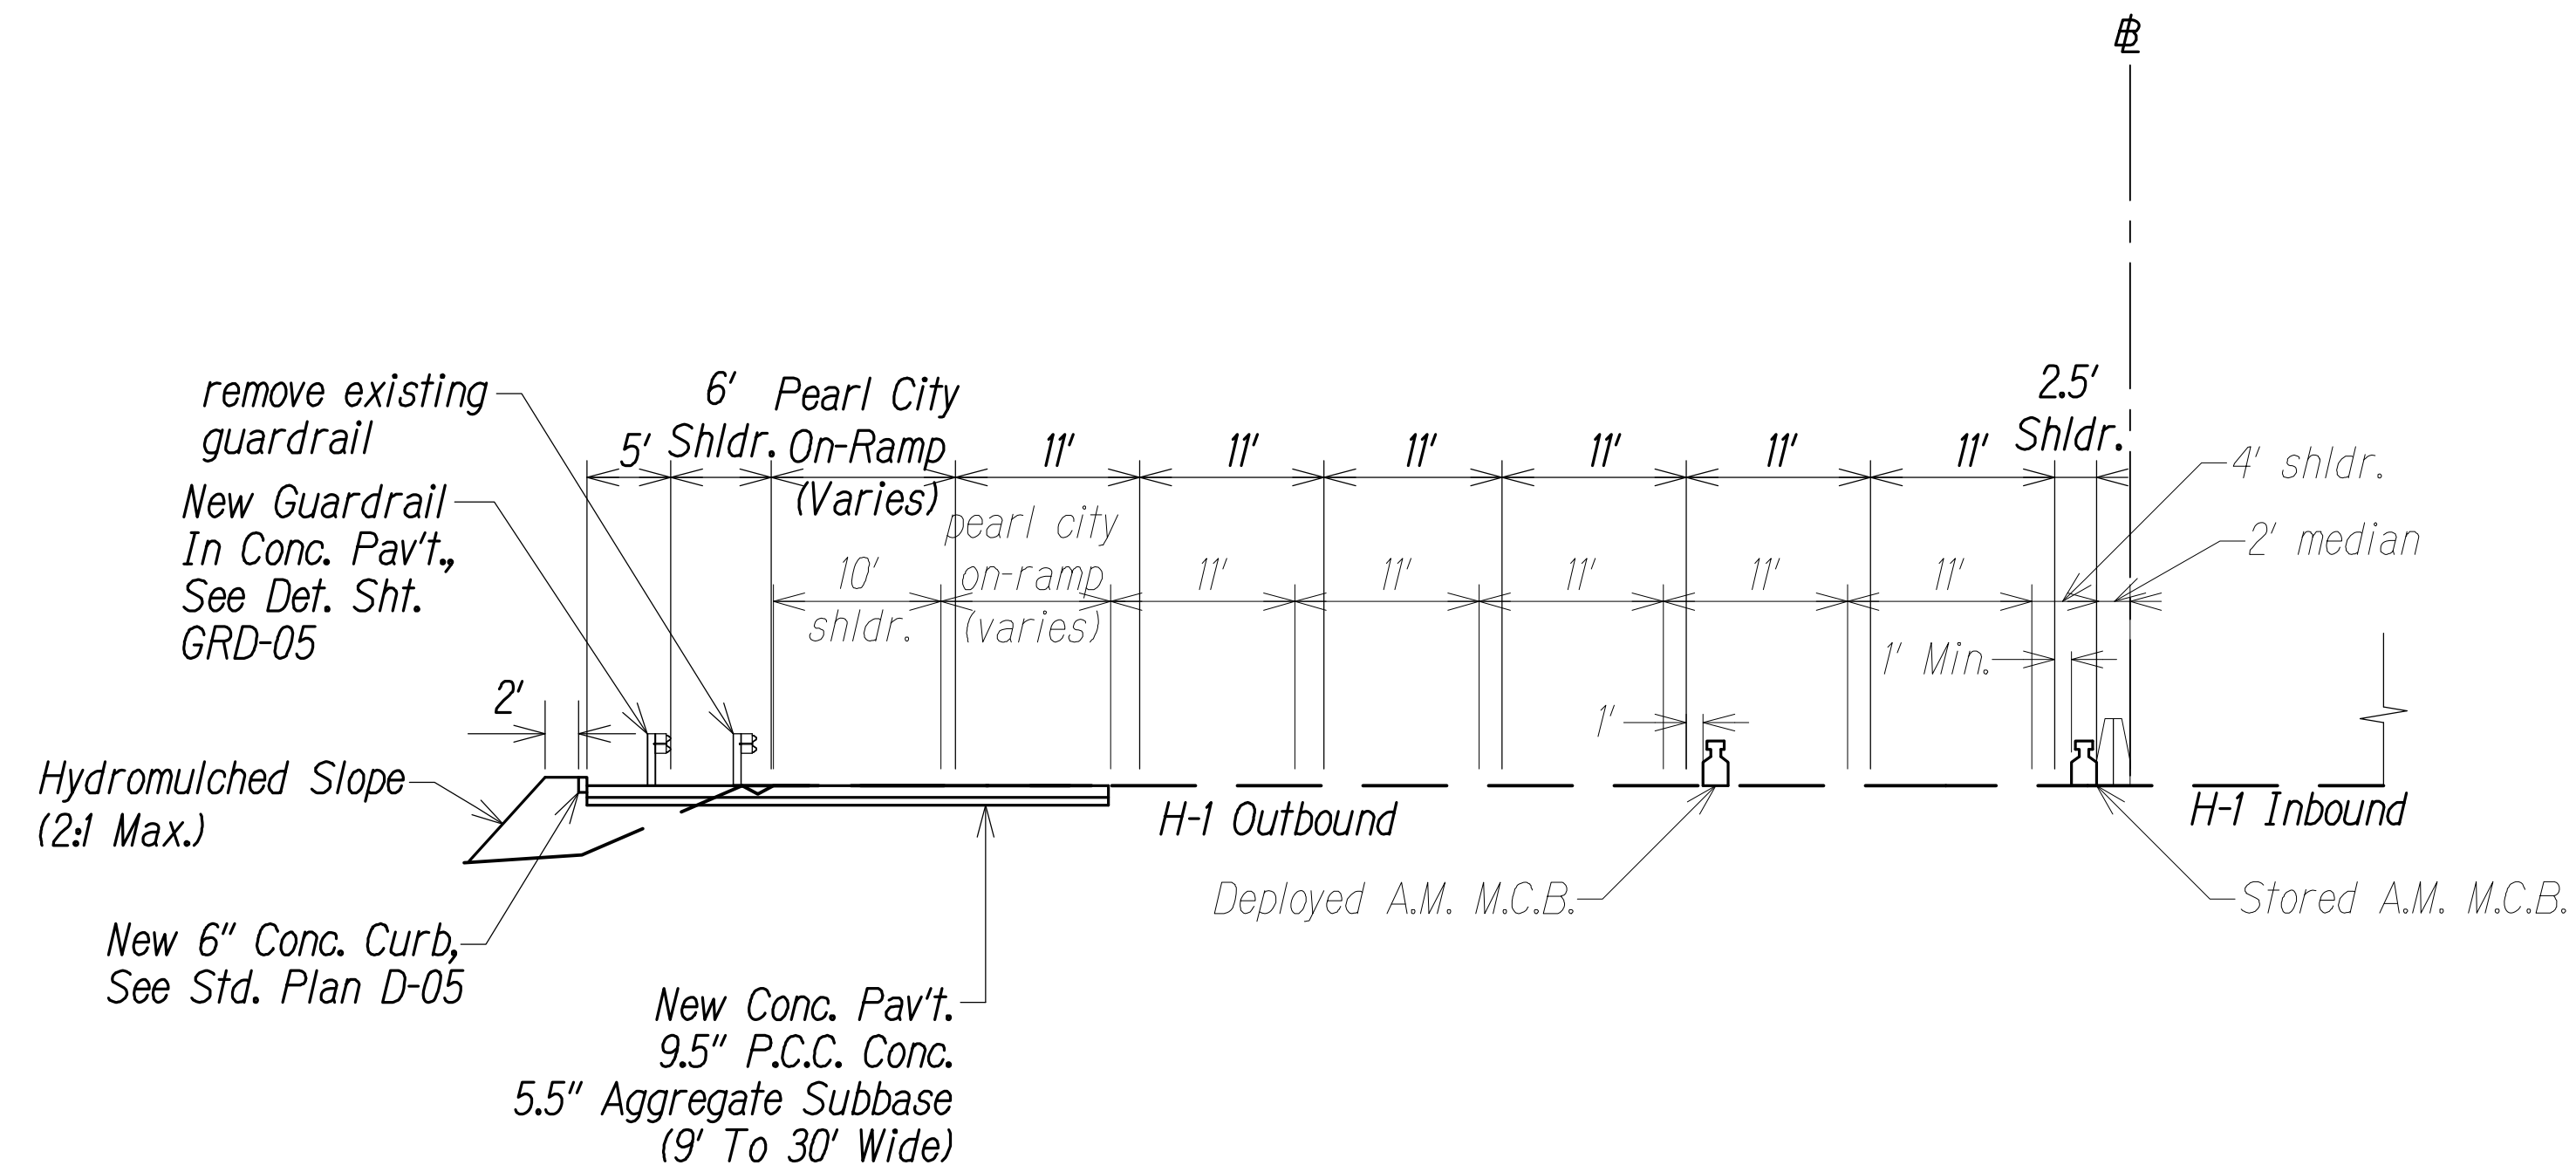

TYPICAL SECTION  
H-1 # STA. 62+27 TO H-1 # STA. 71+69  
Scale: 1" = 10'

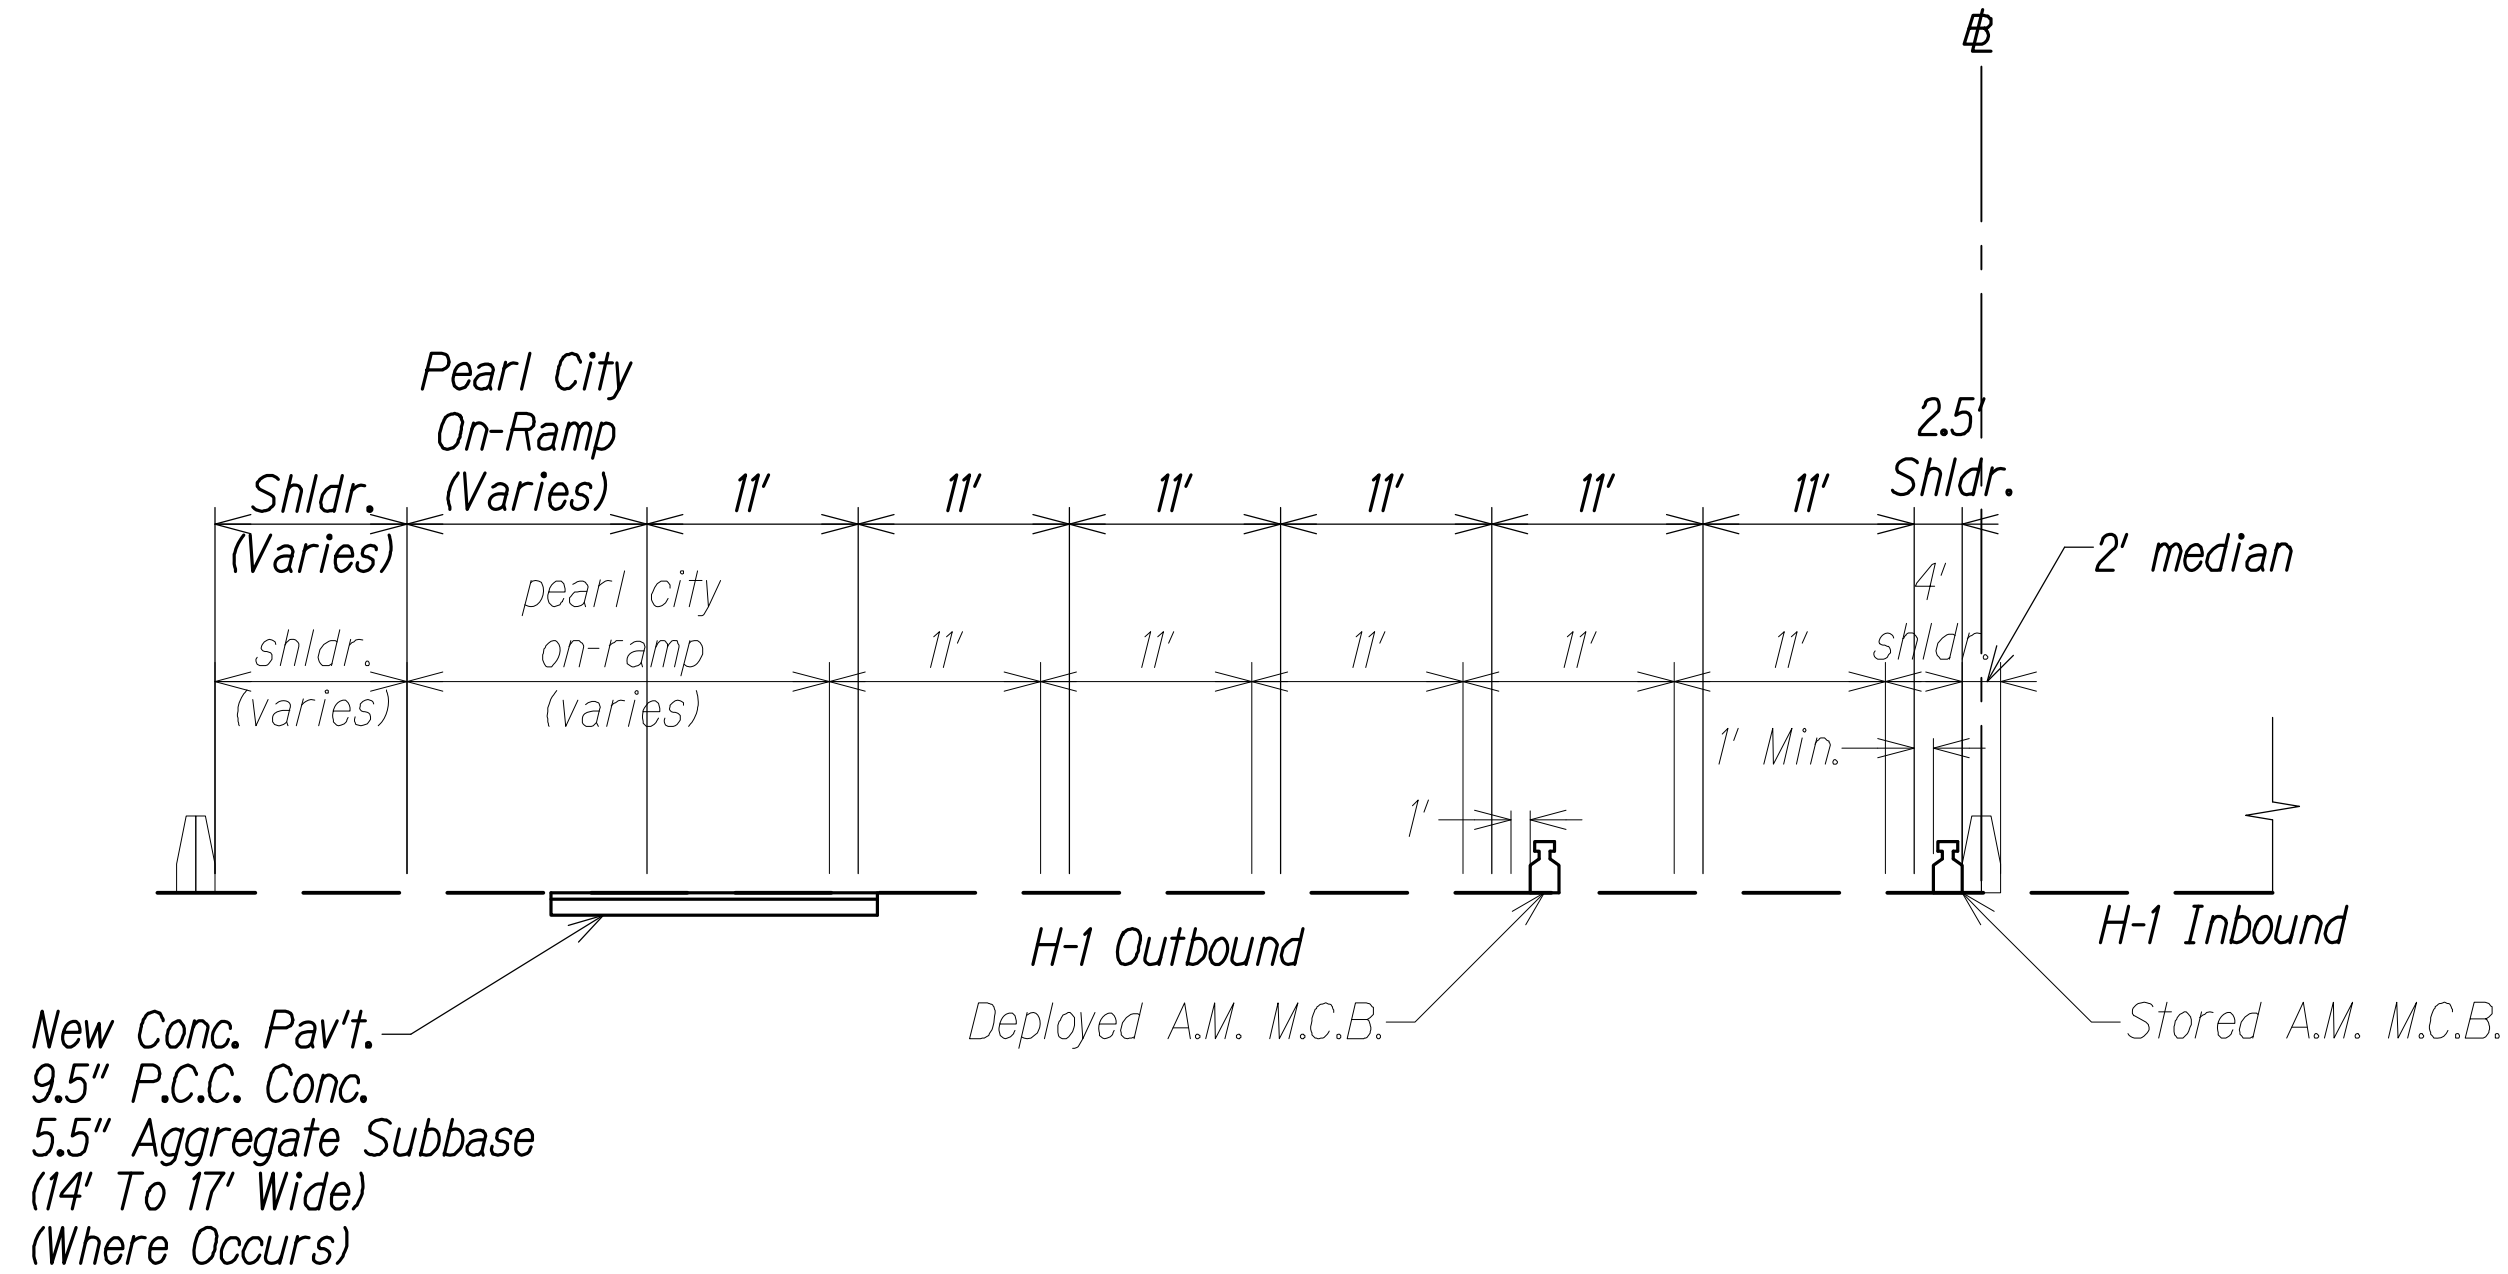

TYPICAL SECTION  
H-1 # STA. 71+69 TO H-1 # STA. 75+29  
Scale: 1" = 10'

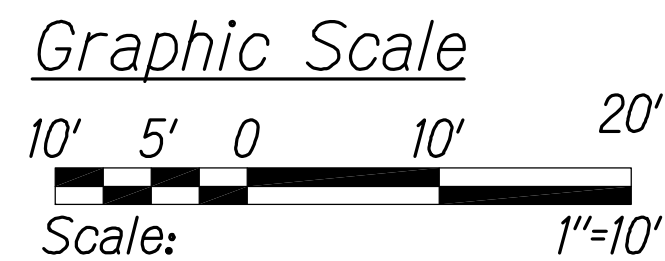

| LEGEND FOR AS-BUILT POSTINGS |                                     |
|------------------------------|-------------------------------------|
|                              | Squiggly line for as-built deletion |
|                              | Double line for as-built deletion   |
| Roadway                      | Text for as-built posting           |

STATE OF HAWAII  
DEPARTMENT OF TRANSPORTATION  
HIGHWAYS DIVISION

TYPICAL SECTIONS

INTERSTATE ROUTE H-1  
PM CONTRAFLOW LANE, PHASE 3  
FEDERAL AID PROJECT NO. NH-HI-1 (260)  
Scale: 1" = XX'      Date: December, 2014

SHEET No. RS-06 of 9 SHEETS



THIS WORK WAS PREPARED BY ME  
OR UNDER MY SUPERVISION.  
*Matthew K. Fujioa*  
APRIL 30, 2016  
WILSON OKAMOTO CORPORATION LIC. EXP. DATE


|              |      |      |              |
|--------------|------|------|--------------|
| QC/QA REVIEW | 100% | DATE | JUL 12, 2015 |
| BY           |      |      |              |
| BY           |      |      |              |
| BY           |      |      |              |
| BY           |      |      |              |

|                   |      |
|-------------------|------|
| SURVEY PLOTTED BY | DATE |
| DRAWN BY          |      |
| TRACED BY         |      |
| DESIGNED BY       |      |
| QUANTITIES BY     |      |
| CHECKED BY        |      |


|               |     |
|---------------|-----|
| ORIGINAL PLAN | No. |
| NOTE BOOK     |     |




|                     |       |                    |             |           |              |
|---------------------|-------|--------------------|-------------|-----------|--------------|
| FED. ROAD DIST. NO. | STATE | FED. AID PROJ. NO. | FISCAL YEAR | SHEET NO. | TOTAL SHEETS |
| HAWAII              | HAW.  | NH-H1-1 (260)      | 2014        | 19        | 200          |

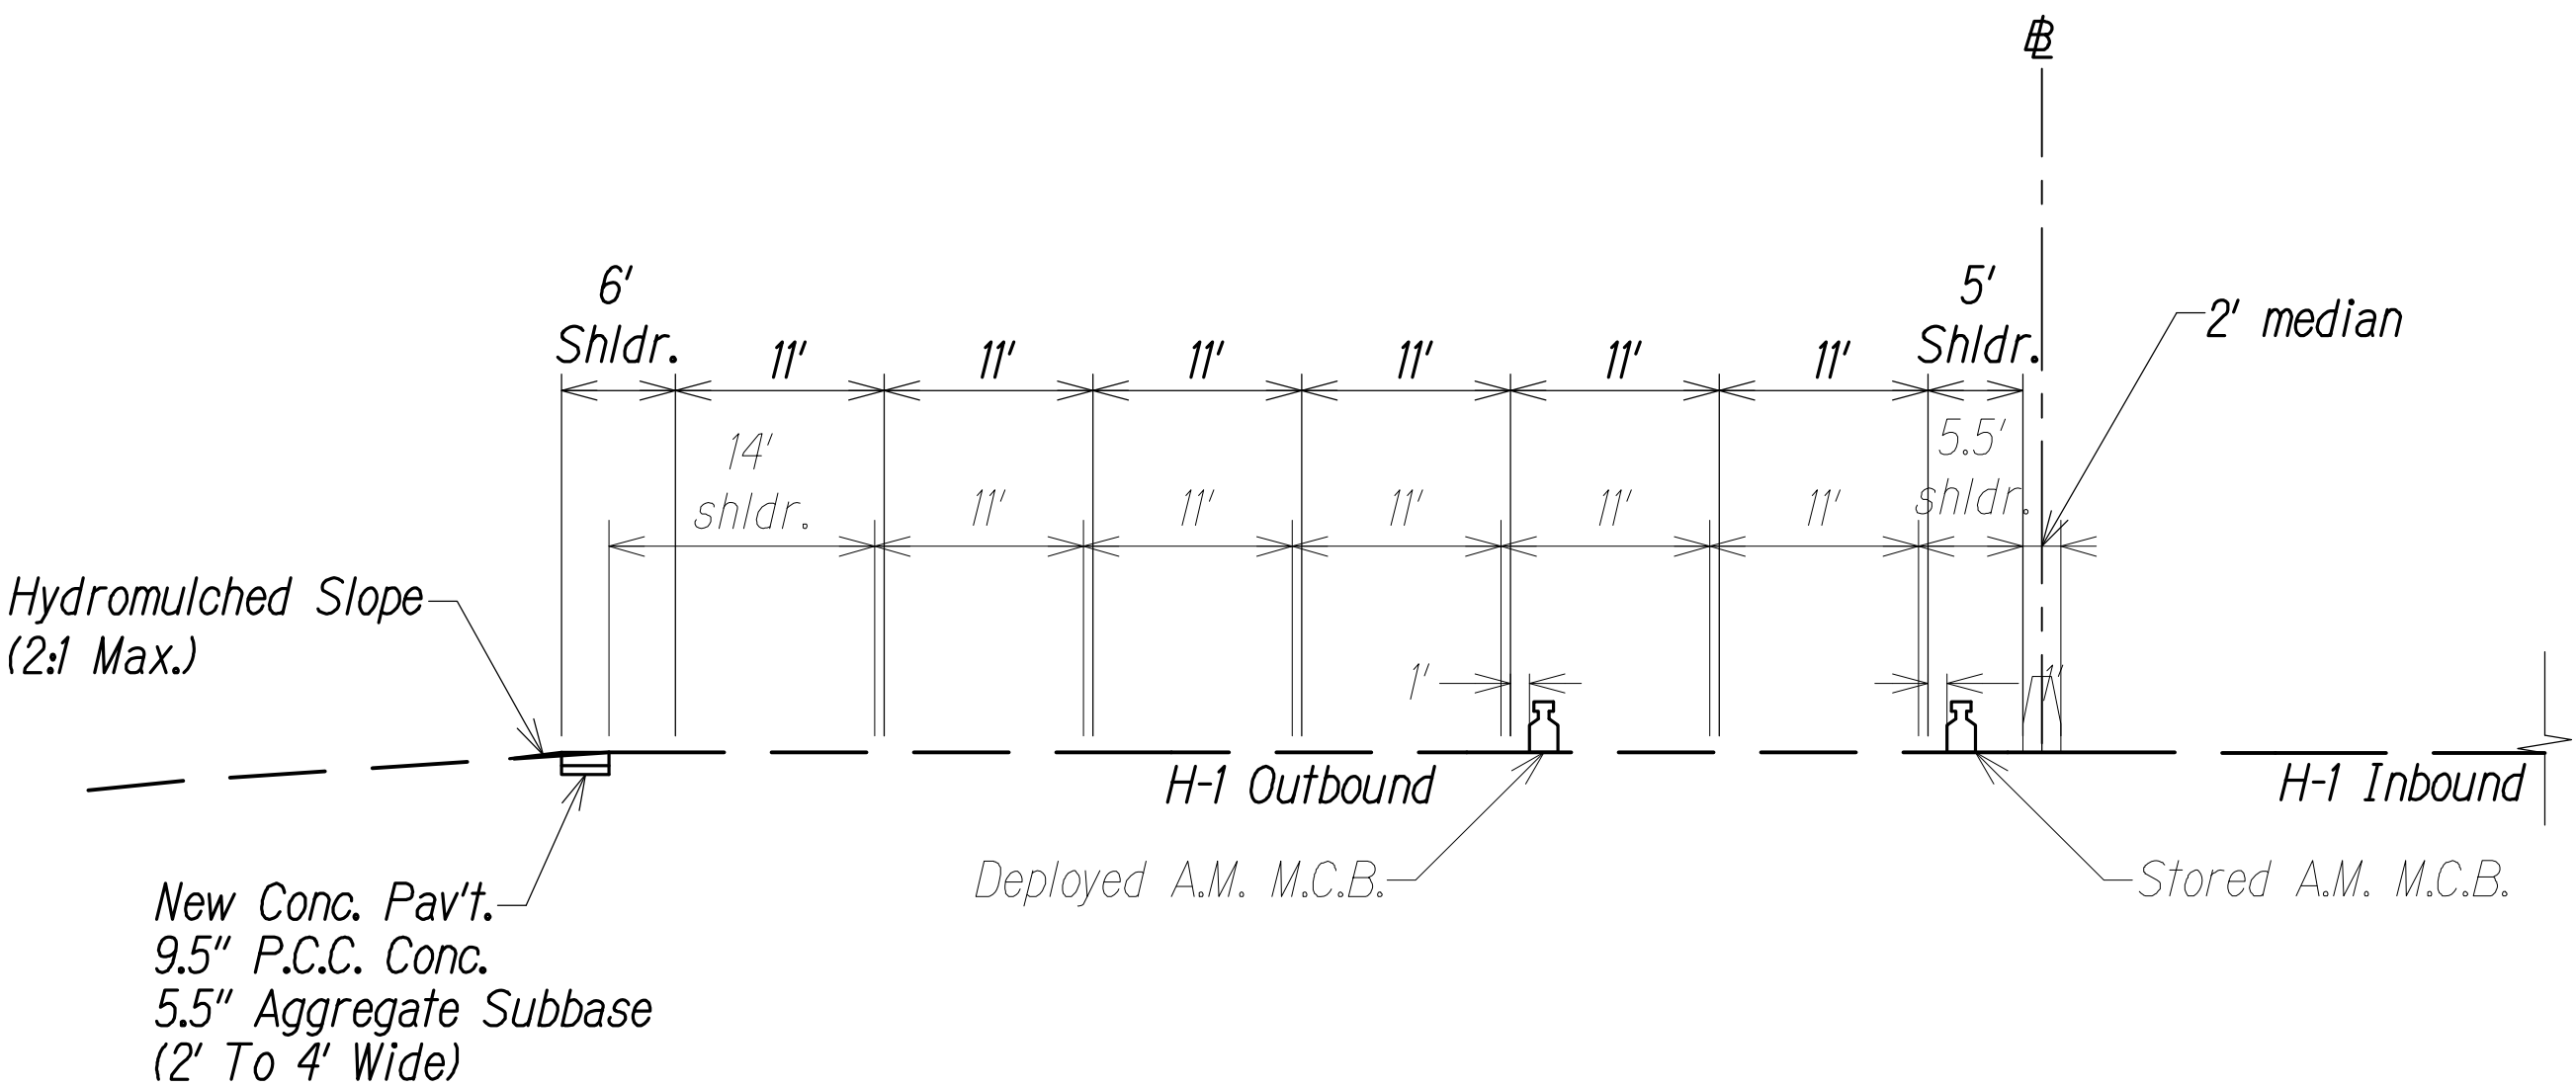

TYPICAL SECTION  
H-1 # STA. 75+29 TO H-1 # STA. 85+00  
Scale: 1" = 10'

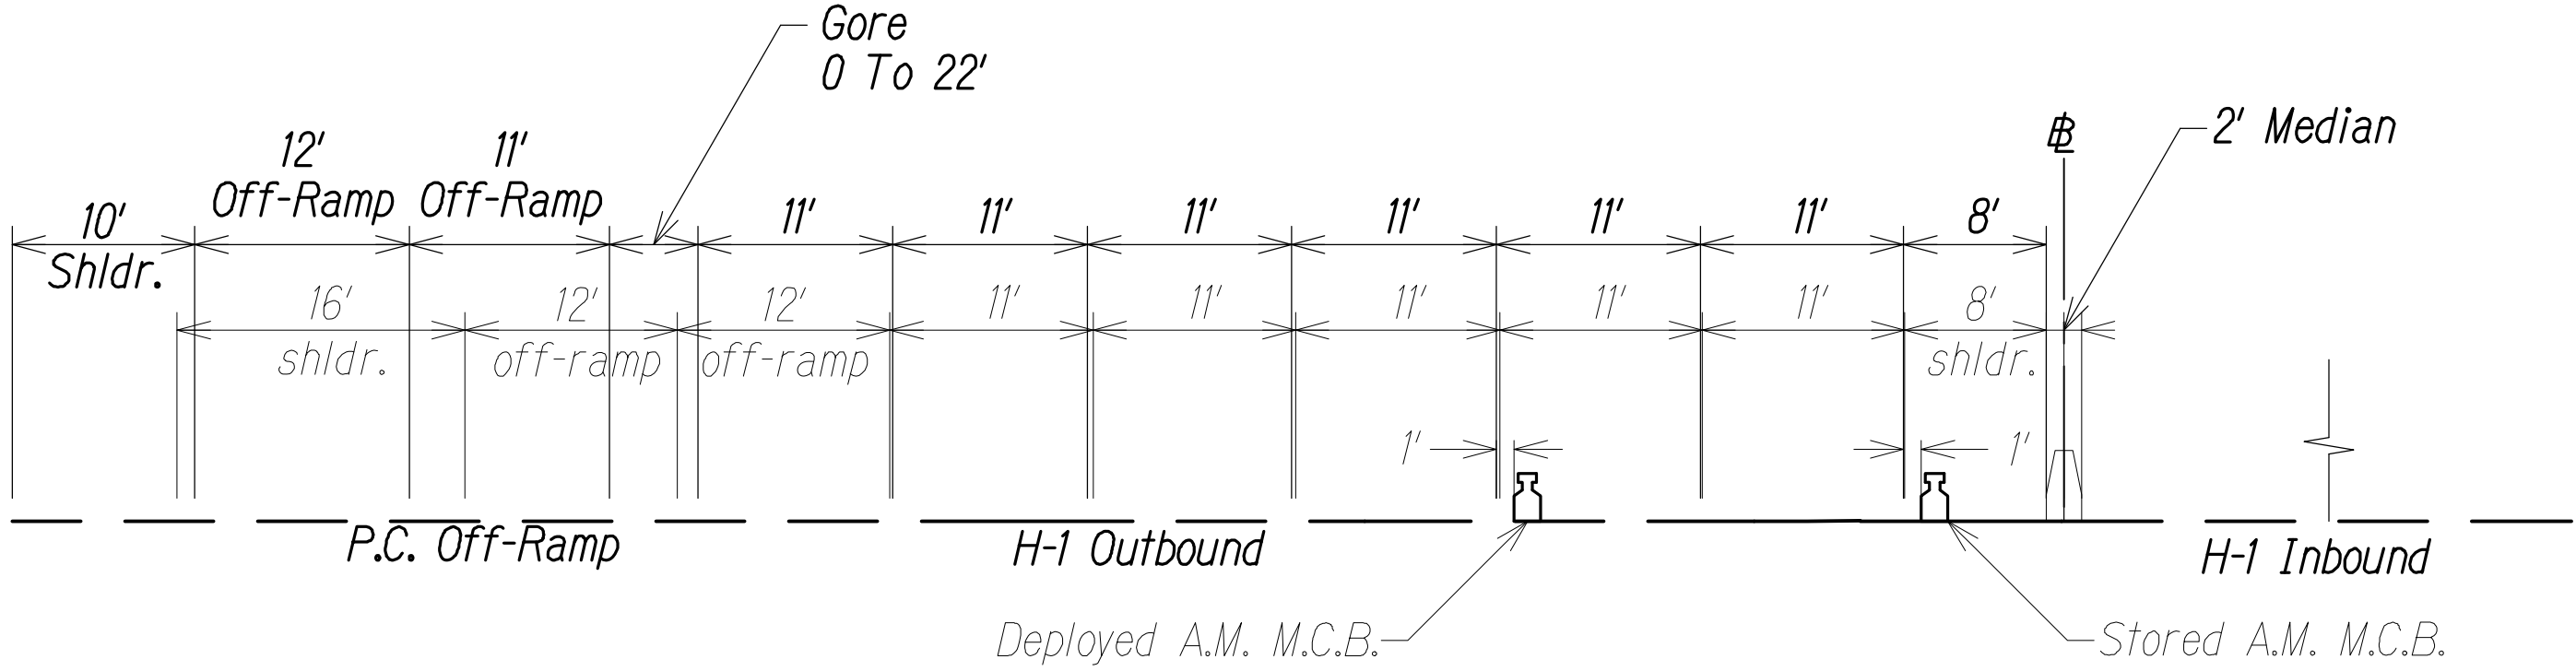

TYPICAL SECTION  
H-1 # STA. 85+00 TO H-1 # STA. 88+34  
Scale: 1" = 10'

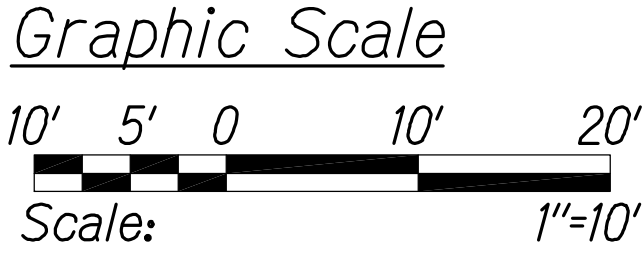

**LEGEND FOR AS-BUILT POSTINGS**

Squiggly line for as-built deletion

Double line for as-built deletion

Roadway Text for as-built posting



THIS WORK WAS PREPARED BY ME  
OR UNDER MY SUPERVISION.  
  
WILSON OKAMOTO CORPORATION APRIL 30, 2016 LIC. EXP. DATE


STATE OF HAWAII  
DEPARTMENT OF TRANSPORTATION  
HIGHWAYS DIVISION

**TYPICAL SECTIONS**


INTERSTATE ROUTE H-1  
PM CONTRAFLOW LANE, PHASE 3  
FEDERAL AID PROJECT NO. NH-H1-1 (260)  
Scale: 1" = XX' Date: December, 2014

SHEET No. RS-07 of 9 SHEETS


|                     |       |                    |             |           |              |
|---------------------|-------|--------------------|-------------|-----------|--------------|
| FED. ROAD DIST. NO. | STATE | FED. AID PROJ. NO. | FISCAL YEAR | SHEET NO. | TOTAL SHEETS |
| HAWAII              | HAW.  | NH-H1-1 (260)      | 2014        | 20        | 200          |

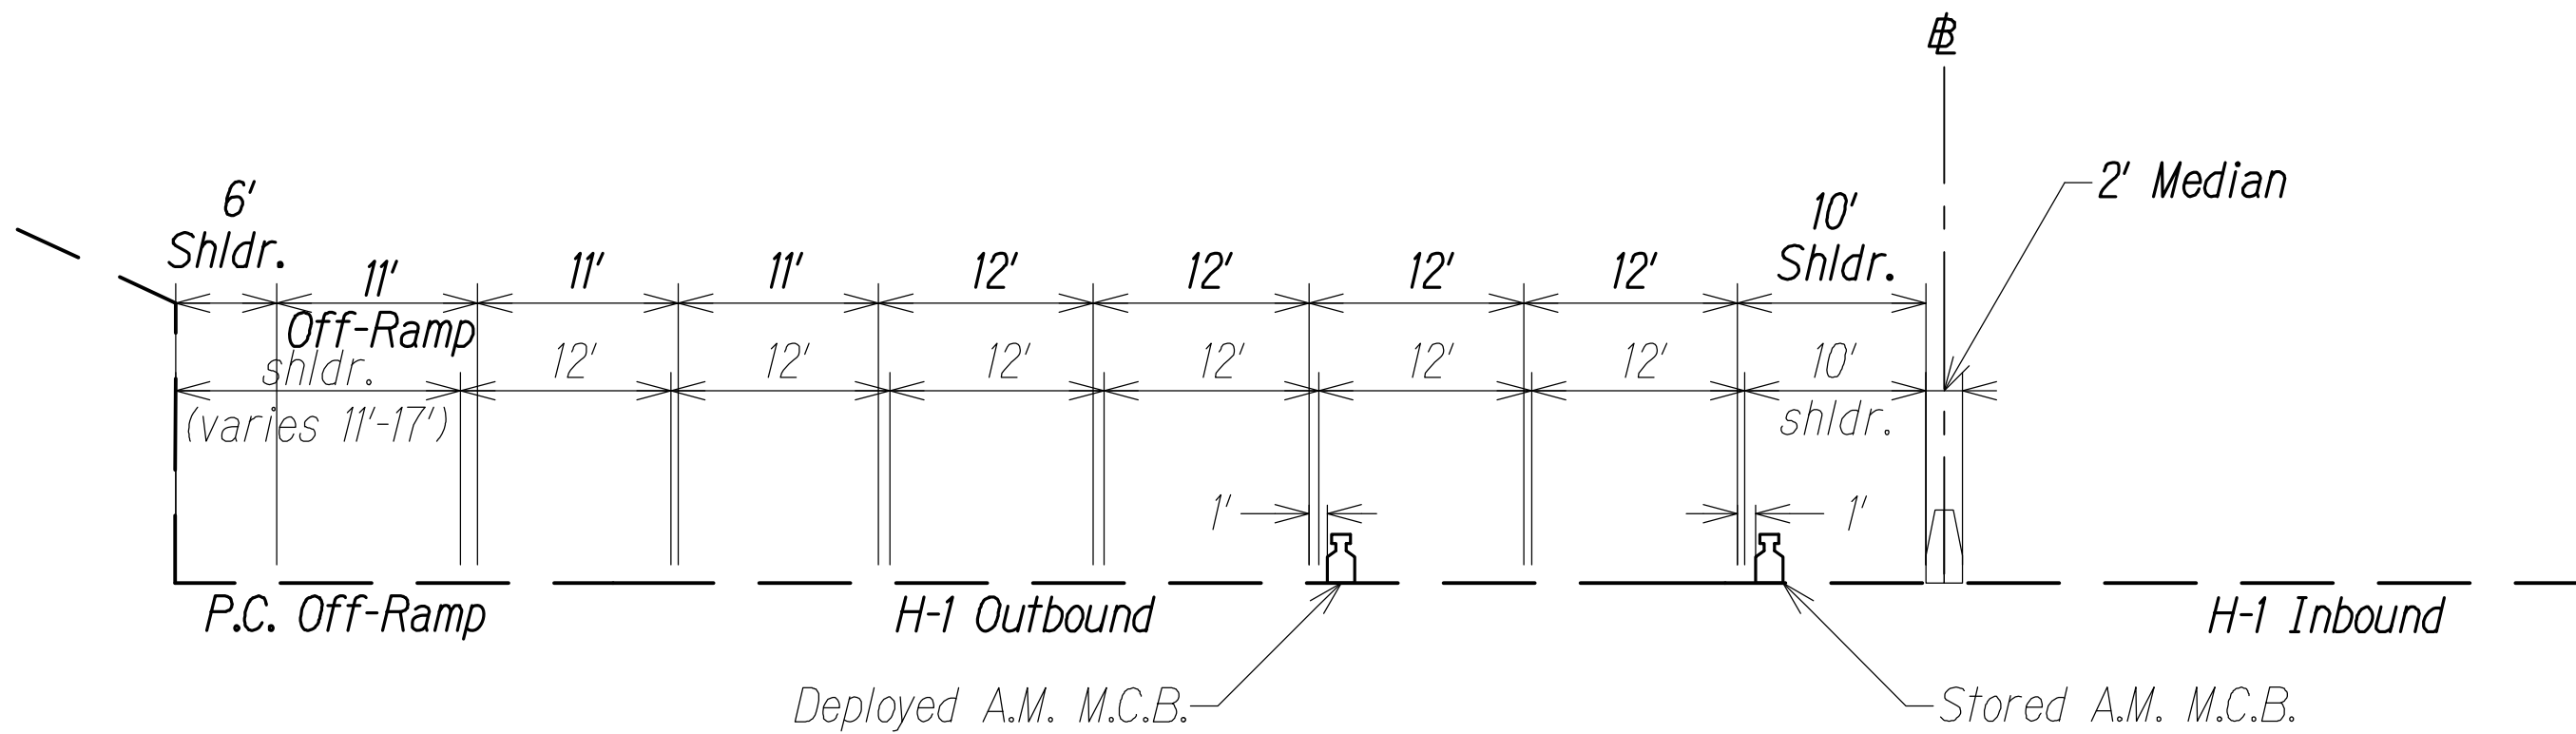

TYPICAL SECTION  
H-1 @ STA. 88+34 TO H-1 @ STA. 97+13  
Scale: 1" = 10'

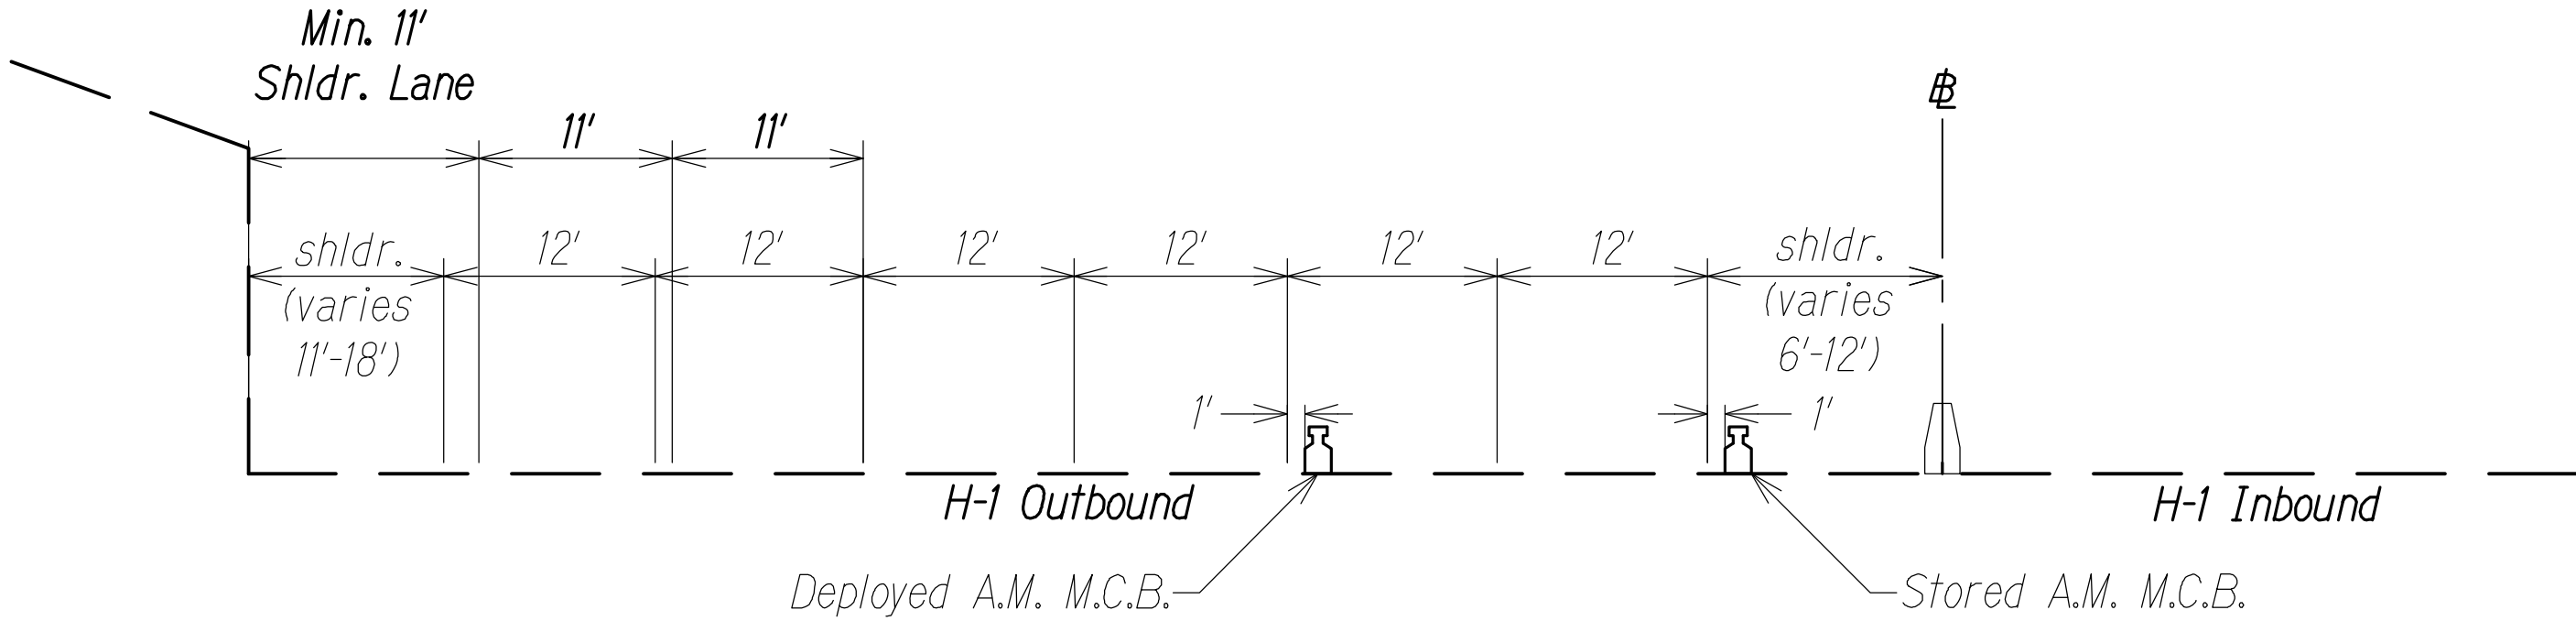

TYPICAL SECTION  
H-1 @ STA. 97+13 TO H-1 @ STA. 177+00  
Scale: 1" = 10'

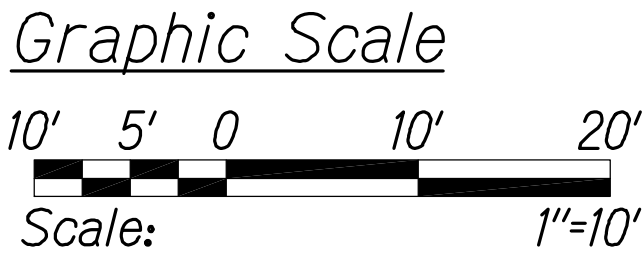

**LEGEND FOR  
AS-BUILT POSTINGS**

~~~~~ Squiggly line for  
as-built deletion

±00.00± Double line for  
as-built deletion

Roadway Text for as-built posting

STATE OF HAWAII  
DEPARTMENT OF TRANSPORTATION  
HIGHWAYS DIVISION

**TYPICAL SECTIONS**

INTERSTATE ROUTE H-1  
PM CONTRAFLOW LANE, PHASE 3  
FEDERAL AID PROJECT NO. NH-H1-1 (260)  
Scale: 1" = XX' Date: December, 2014

SHEET No. RS-08 of 9 SHEETS



THIS WORK WAS PREPARED BY ME  
OR UNDER MY SUPERVISION.  
*Matthew K. Fujioa*  
APRIL 30, 2016  
WILSON OKAMOTO CORPORATION LIC. EXP. DATE


|              |      |      |              |
|--------------|------|------|--------------|
| QC/QA REVIEW | 100% | DATE | JUL 12, 2015 |
| BY           |      |      |              |
| BY           |      |      |              |
| BY           |      |      |              |
| BY           |      |      |              |

|                   |      |
|-------------------|------|
| SURVEY PLOTTED BY | DATE |
| DRAWN BY          |      |
| TRACED BY         |      |
| DESIGNED BY       |      |
| QUANTITIES BY     |      |
| CHECKED BY        |      |


|               |     |
|---------------|-----|
| ORIGINAL PLAN | No. |
| NOTE BOOK     |     |




|                        |       |                       |                |              |                 |
|------------------------|-------|-----------------------|----------------|--------------|-----------------|
| FED. ROAD<br>DIST. NO. | STATE | FED. AID<br>PROJ. NO. | FISCAL<br>YEAR | SHEET<br>NO. | TOTAL<br>SHEETS |
| HAWAII                 | HAW.  | NH-H1-1 (260)         | 2014           | 21           | 200             |

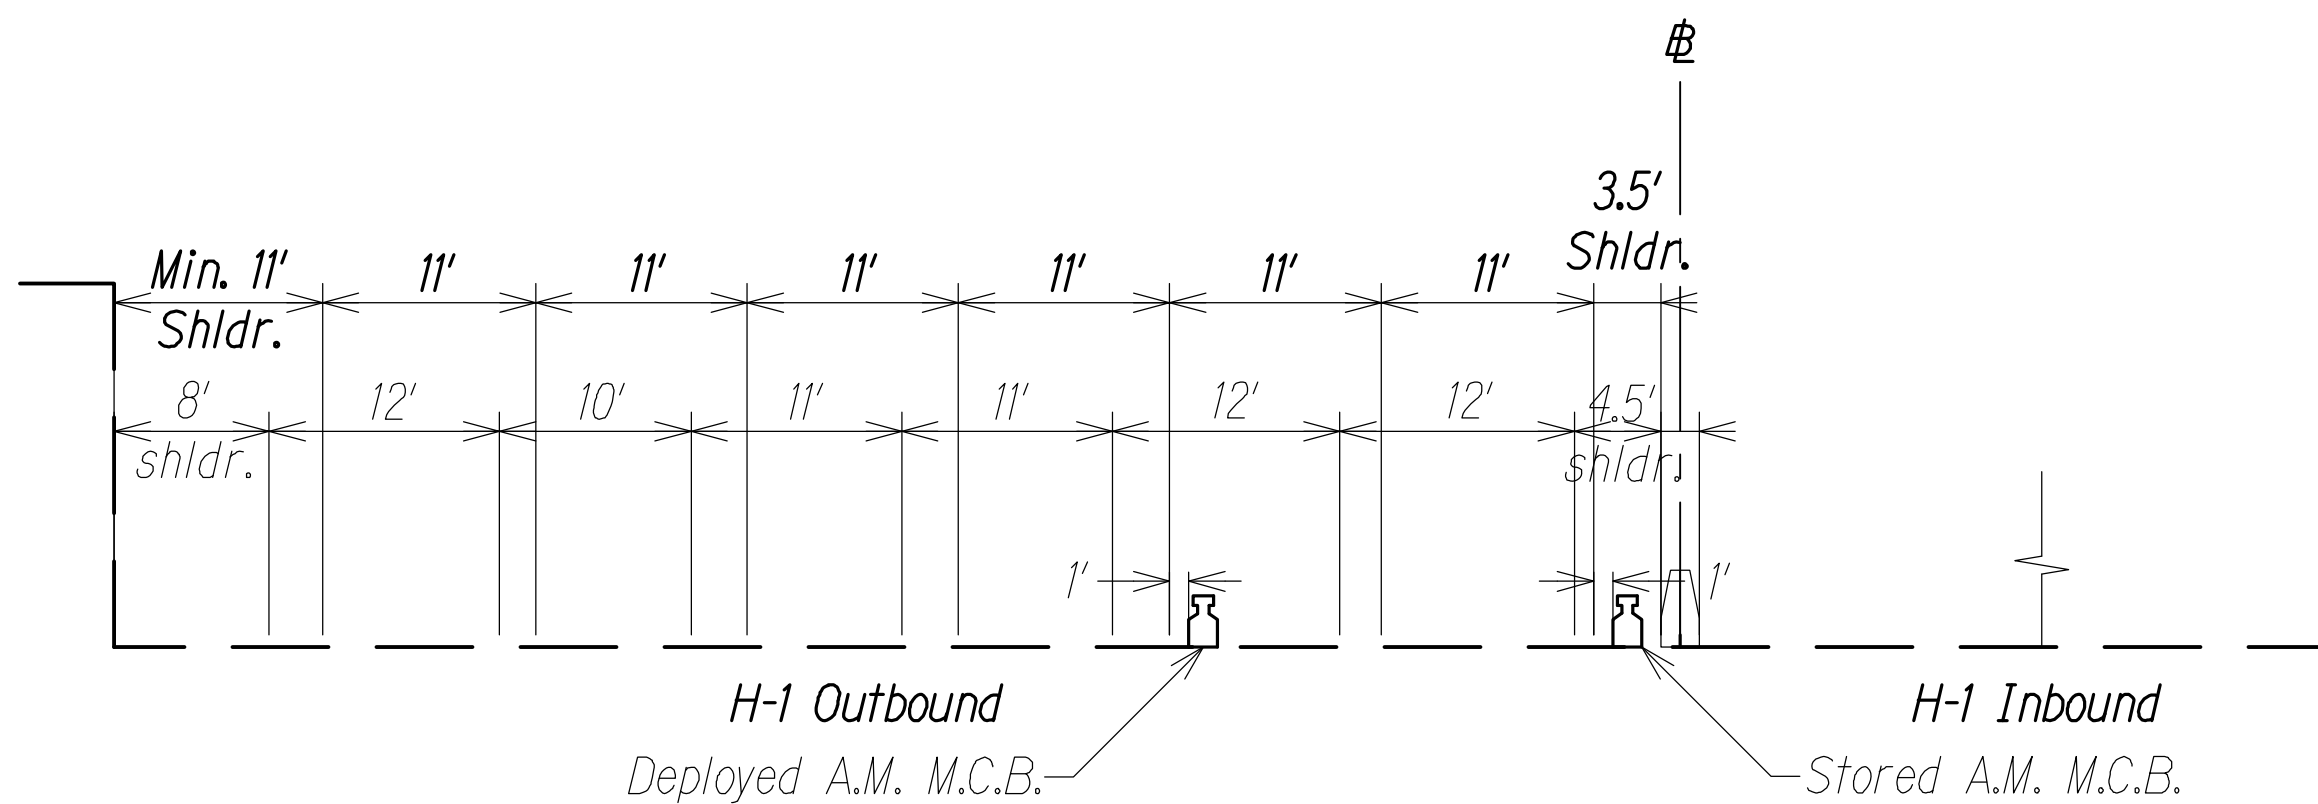

TYPICAL SECTION  
H-1 @ STA. 177+00 TO H-1 @ STA. 184+00  
Scale: 1" = 10'

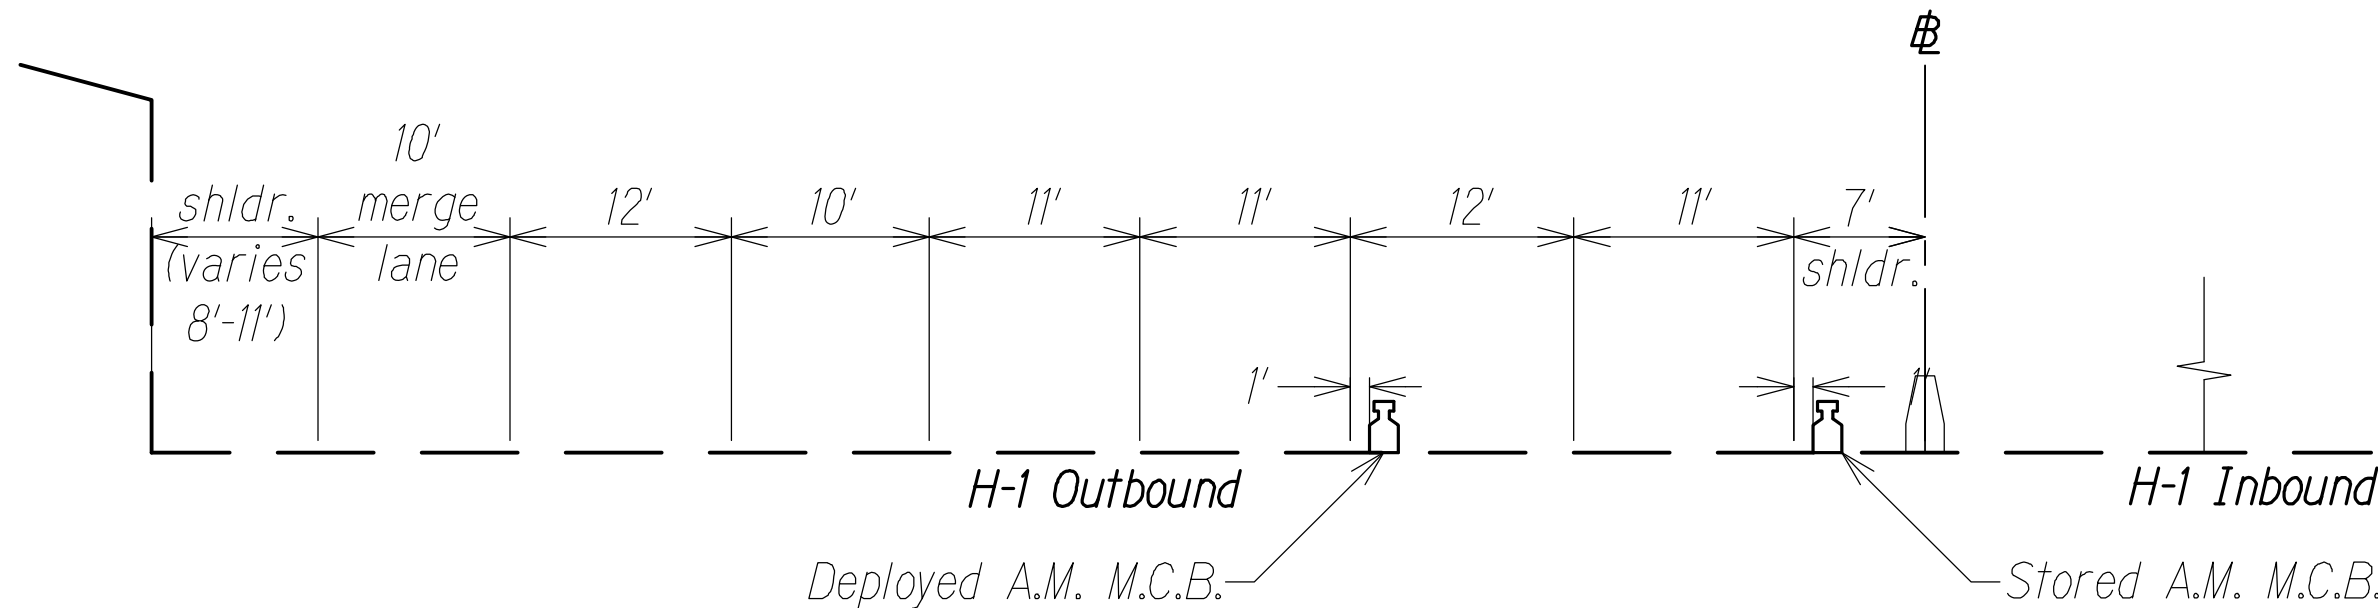

TYPICAL SECTION  
H-1 @ STA. 184+00 TO H-1 @ STA. 191+60  
Scale: 1" = 10'

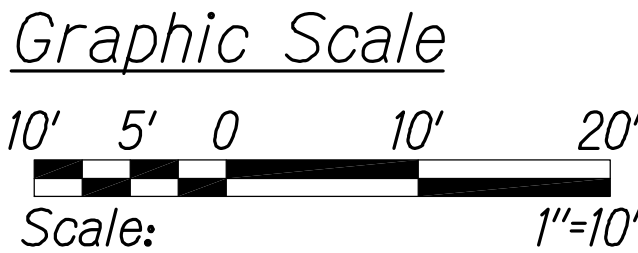


**LEGEND FOR  
AS-BUILT POSTINGS**

~~~~~ Squiggly line for  
as-built deletion

±00:00± Double line for  
as-built deletion

Roadway Text for as-built posting

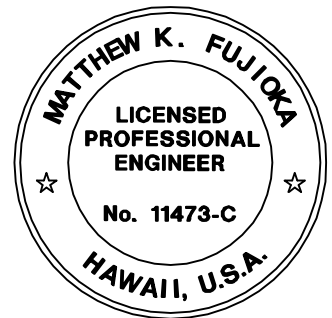

THIS WORK WAS PREPARED BY ME  
OR UNDER MY SUPERVISION.  
*Matthew K. Fujioa*  
APRIL 30, 2016  
WILSON OKAMOTO CORPORATION LIC. EXP. DATE

STATE OF HAWAII  
DEPARTMENT OF TRANSPORTATION  
HIGHWAYS DIVISION

**TYPICAL SECTIONS**

INTERSTATE ROUTE H-1  
PM CONTRAFLOW LANE, PHASE 3  
FEDERAL AID PROJECT NO. NH-H1-1 (260)  
Scale: 1" = XX' Date: December, 2014

SHEET No. RS-09 of 9 SHEETS