



FED. ROAD DIST. NO.	STATE	FED. AID PROJ. NO.	FISCAL YEAR	SHEET NO.	TOTAL SHEETS
HAWAII	HAW.	NH-H1-1 (260)	2014	62	200

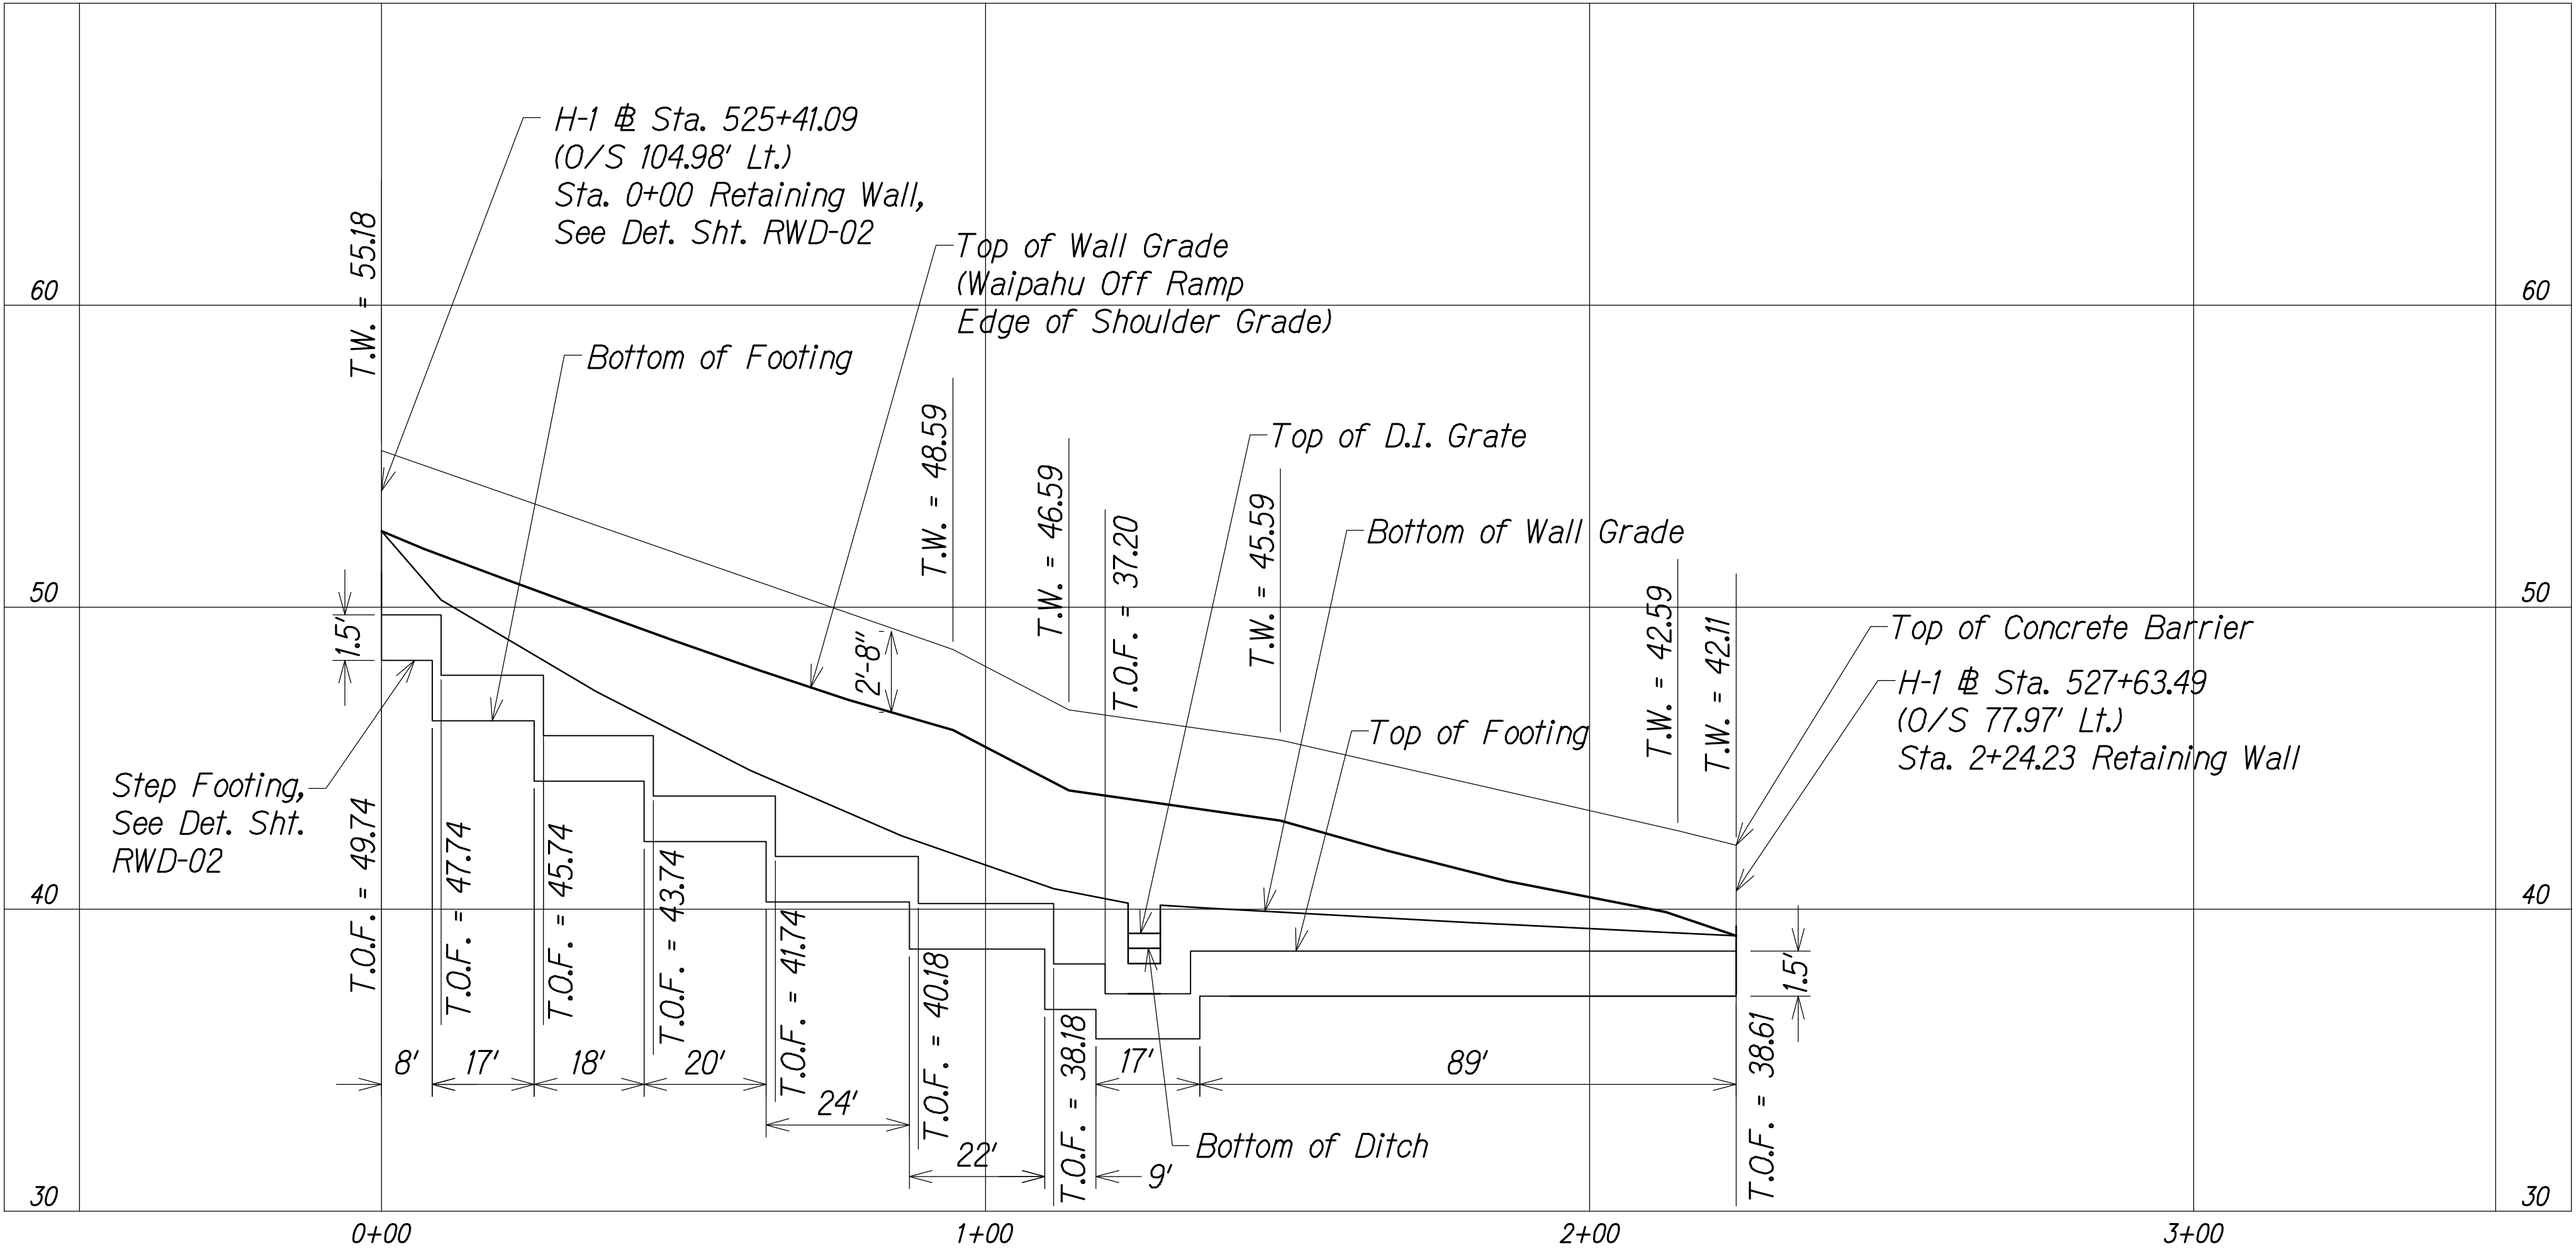

Legend:
T.O.F. = Top of Footing
T.W. = Top of Wall

Graphic Scales:

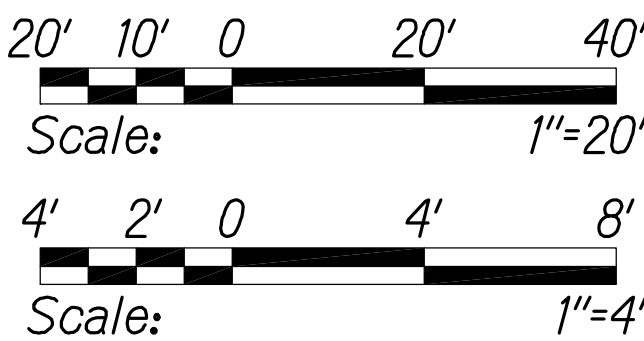


RETAINING WALL PROFILE

Scale: Horiz. 1" = 20'
Vert. 1" = 4'

LEGEND FOR AS-BUILT POSTINGS

- Squiggly line for as-built deletion
- Double line for as-built deletion
- Roadway Text for as-built posting

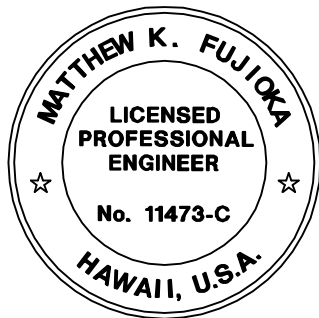

THIS WORK WAS PREPARED BY ME
OR UNDER MY SUPERVISION.
Matthew K. Fujioka
APRIL 30, 2016
WILSON OKAMOTO CORPORATION LIC. EXP. DATE

STATE OF HAWAII
DEPARTMENT OF TRANSPORTATION
HIGHWAYS DIVISION

RETAINING WALL PROFILE

INTERSTATE ROUTE H-1
PM CONTRAFLOW LANE, PHASE 3
FEDERAL AID PROJECT NO. NH-H1-1 (260)

Scale: Date: December, 2014

SHEET No. RWD-01 OF 5 SHEETS

"AS-BUILT"

62