


FED. ROAD DIST. NO.	STATE	FED. AID PROJ. NO.	FISCAL YEAR	SHEET NO.	TOTAL SHEETS
HAWAII	HAW.	NH-HI-1(271)	2022	ADD. 17	167

Legend

----- Limits of Construction



----- Property Line

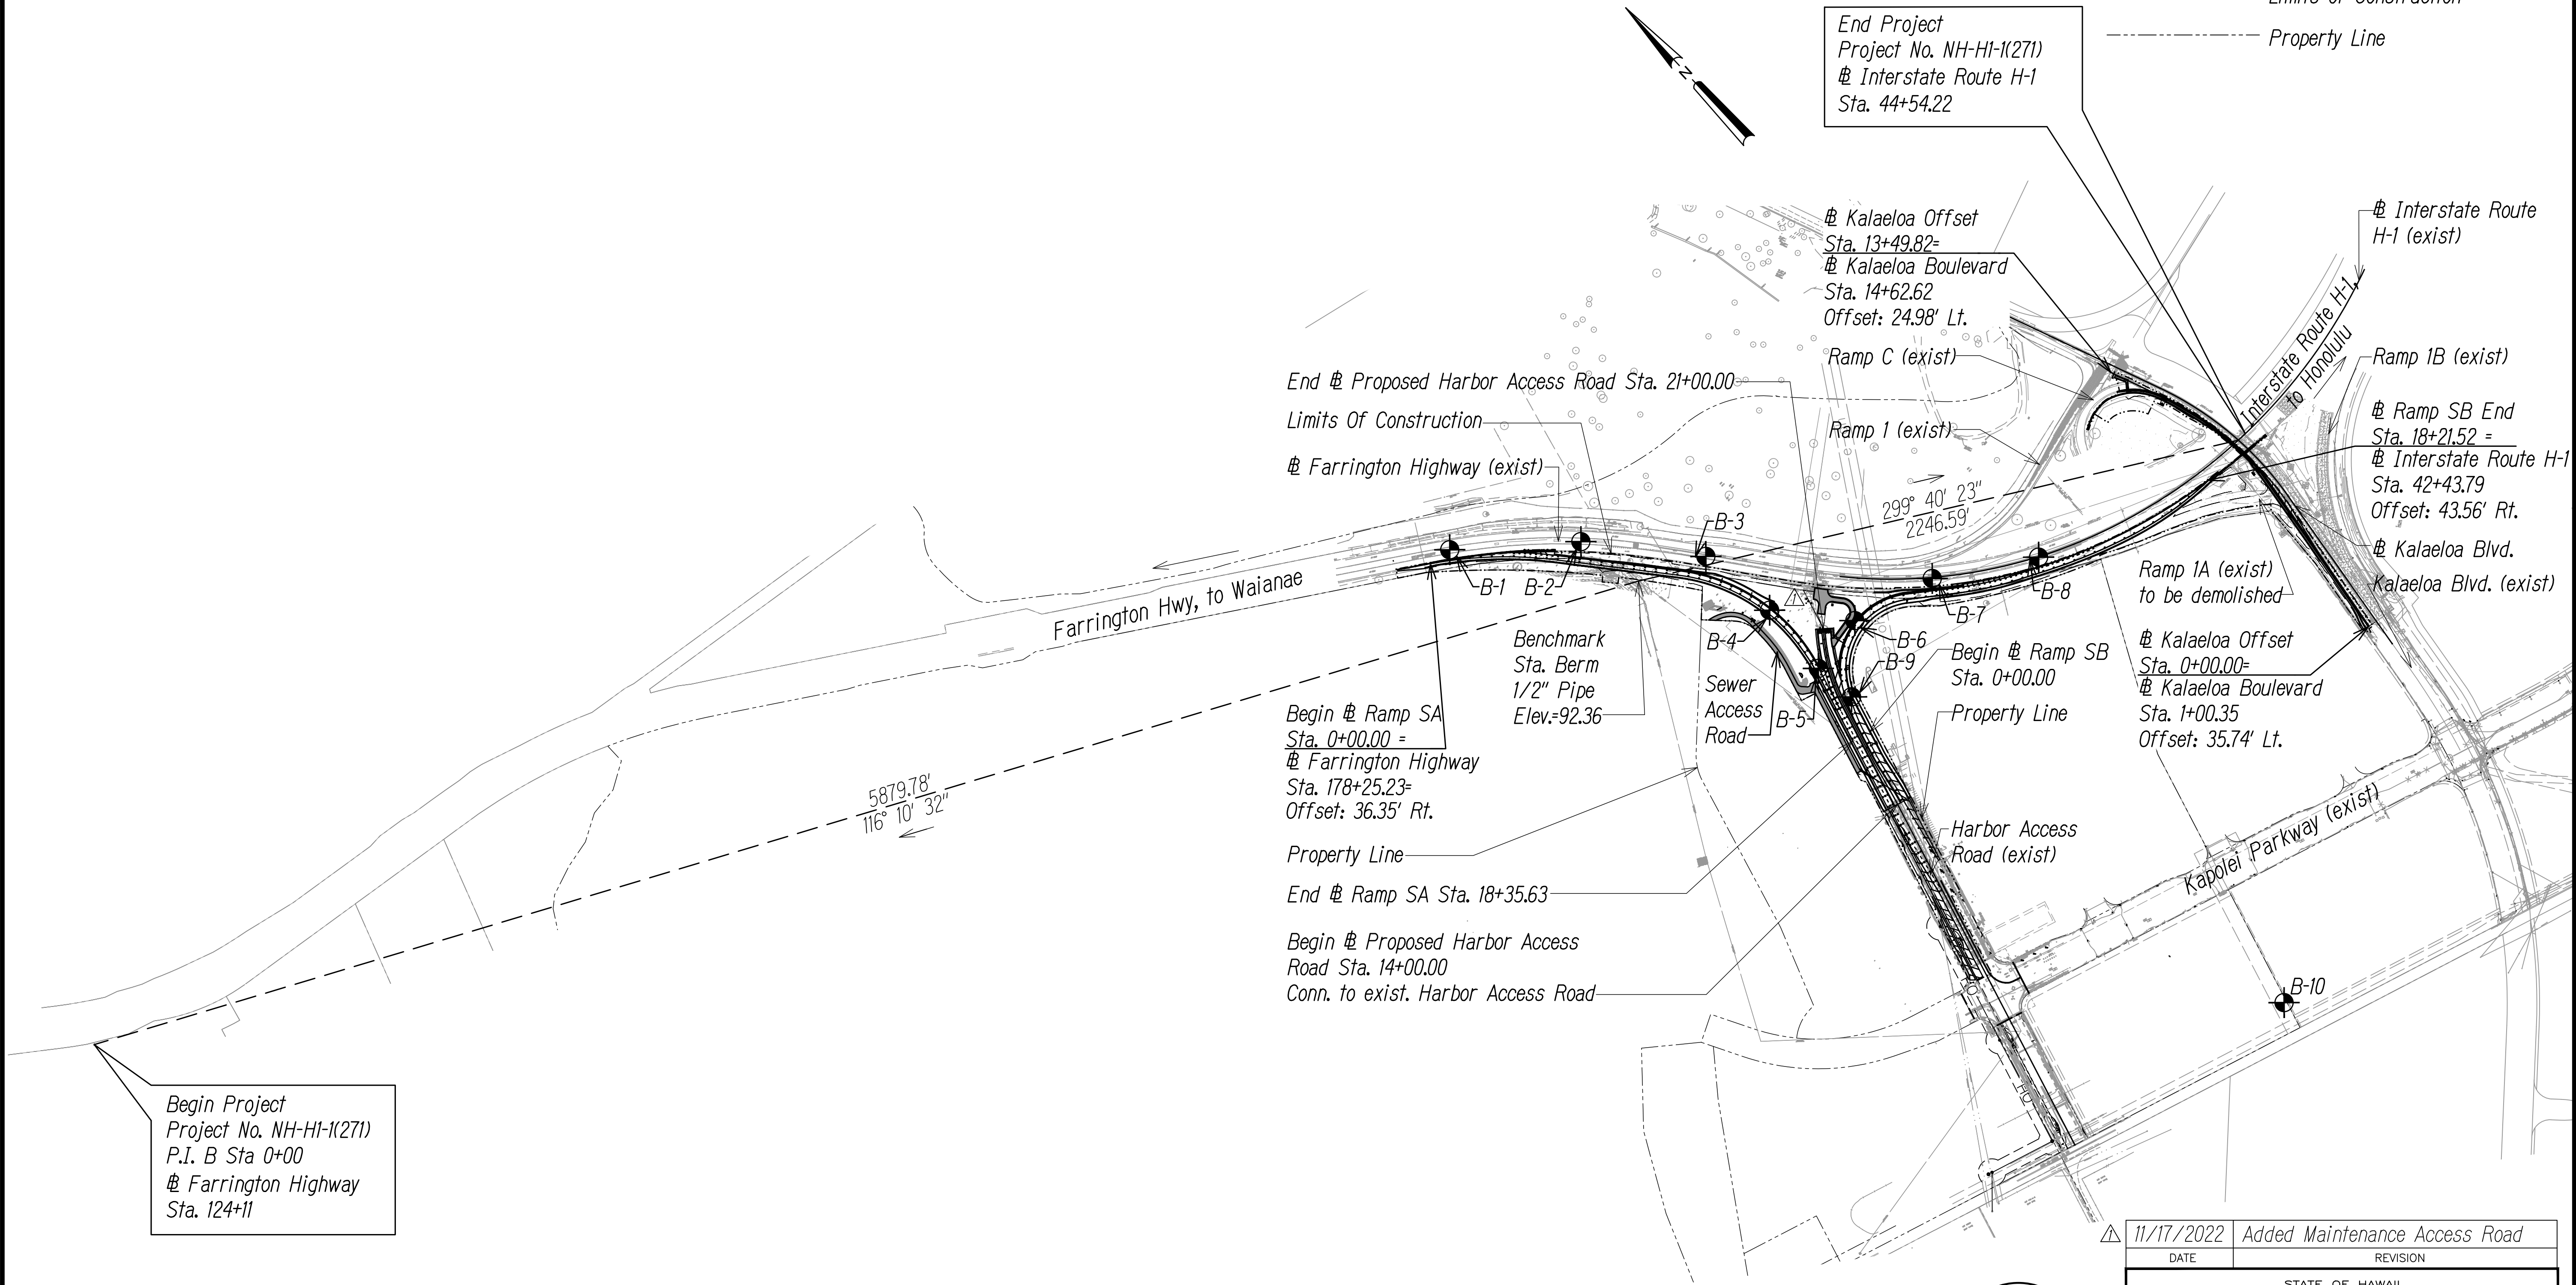

Begin Project
Project No. NH-HI-1(271)
P.I. B Sta 0+00
Farrington Highway
Sta. 124+11

End Project
Project No. NH-HI-1(271)
Interstate Route H-1
Sta. 44+54.22

GENERAL PLAN
Scale: 1" = 300'

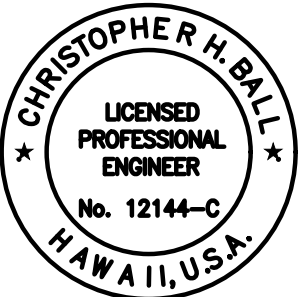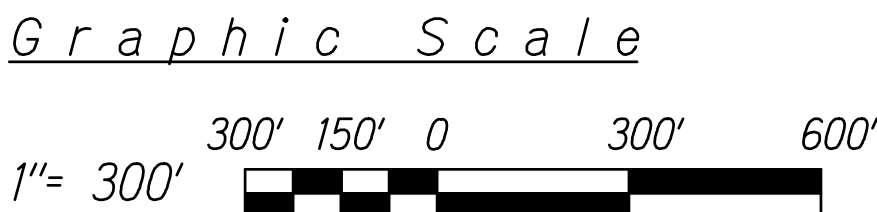

This work was prepared by
me or under my supervision

Chris Ball
MITSUNAGA & ASSOCIATES, INC. 4/30/2024
NOTE: Contractor to check and verify
dimensions at job before proceeding with work.

DATE	REVISION
11/17/2022	Added Maintenance Access Road

STATE OF HAWAII
DEPARTMENT OF TRANSPORTATION
HIGHWAYS DIVISION

GENERAL PLAN

**INTERSTATE ROUTE H-1
ADDITION AND MODIFICATION OF FREEWAY ACCESS
(Kapolei Interchange Complex), Phase 3
Federal Aid Project No. NH-HI-1(271)**

Scale: As Noted Date: August 2022

ORIGINAL PLAN	SURVEY PLOTTED BY	DATE
NOTE BOOK	DESIGNED BY	
	QUANTITIES BY	
	CHECKED BY	