



FED. ROAD DIST. NO.	STATE	FED. AID PROJ. NO.	FISCAL YEAR	SHEET NO.	TOTAL SHEETS
HAWAII	HAW.	NH-H1-K(271)	2022	ADD. 119	167

Legend

- Property Line Right of Way
- Coral Boulder

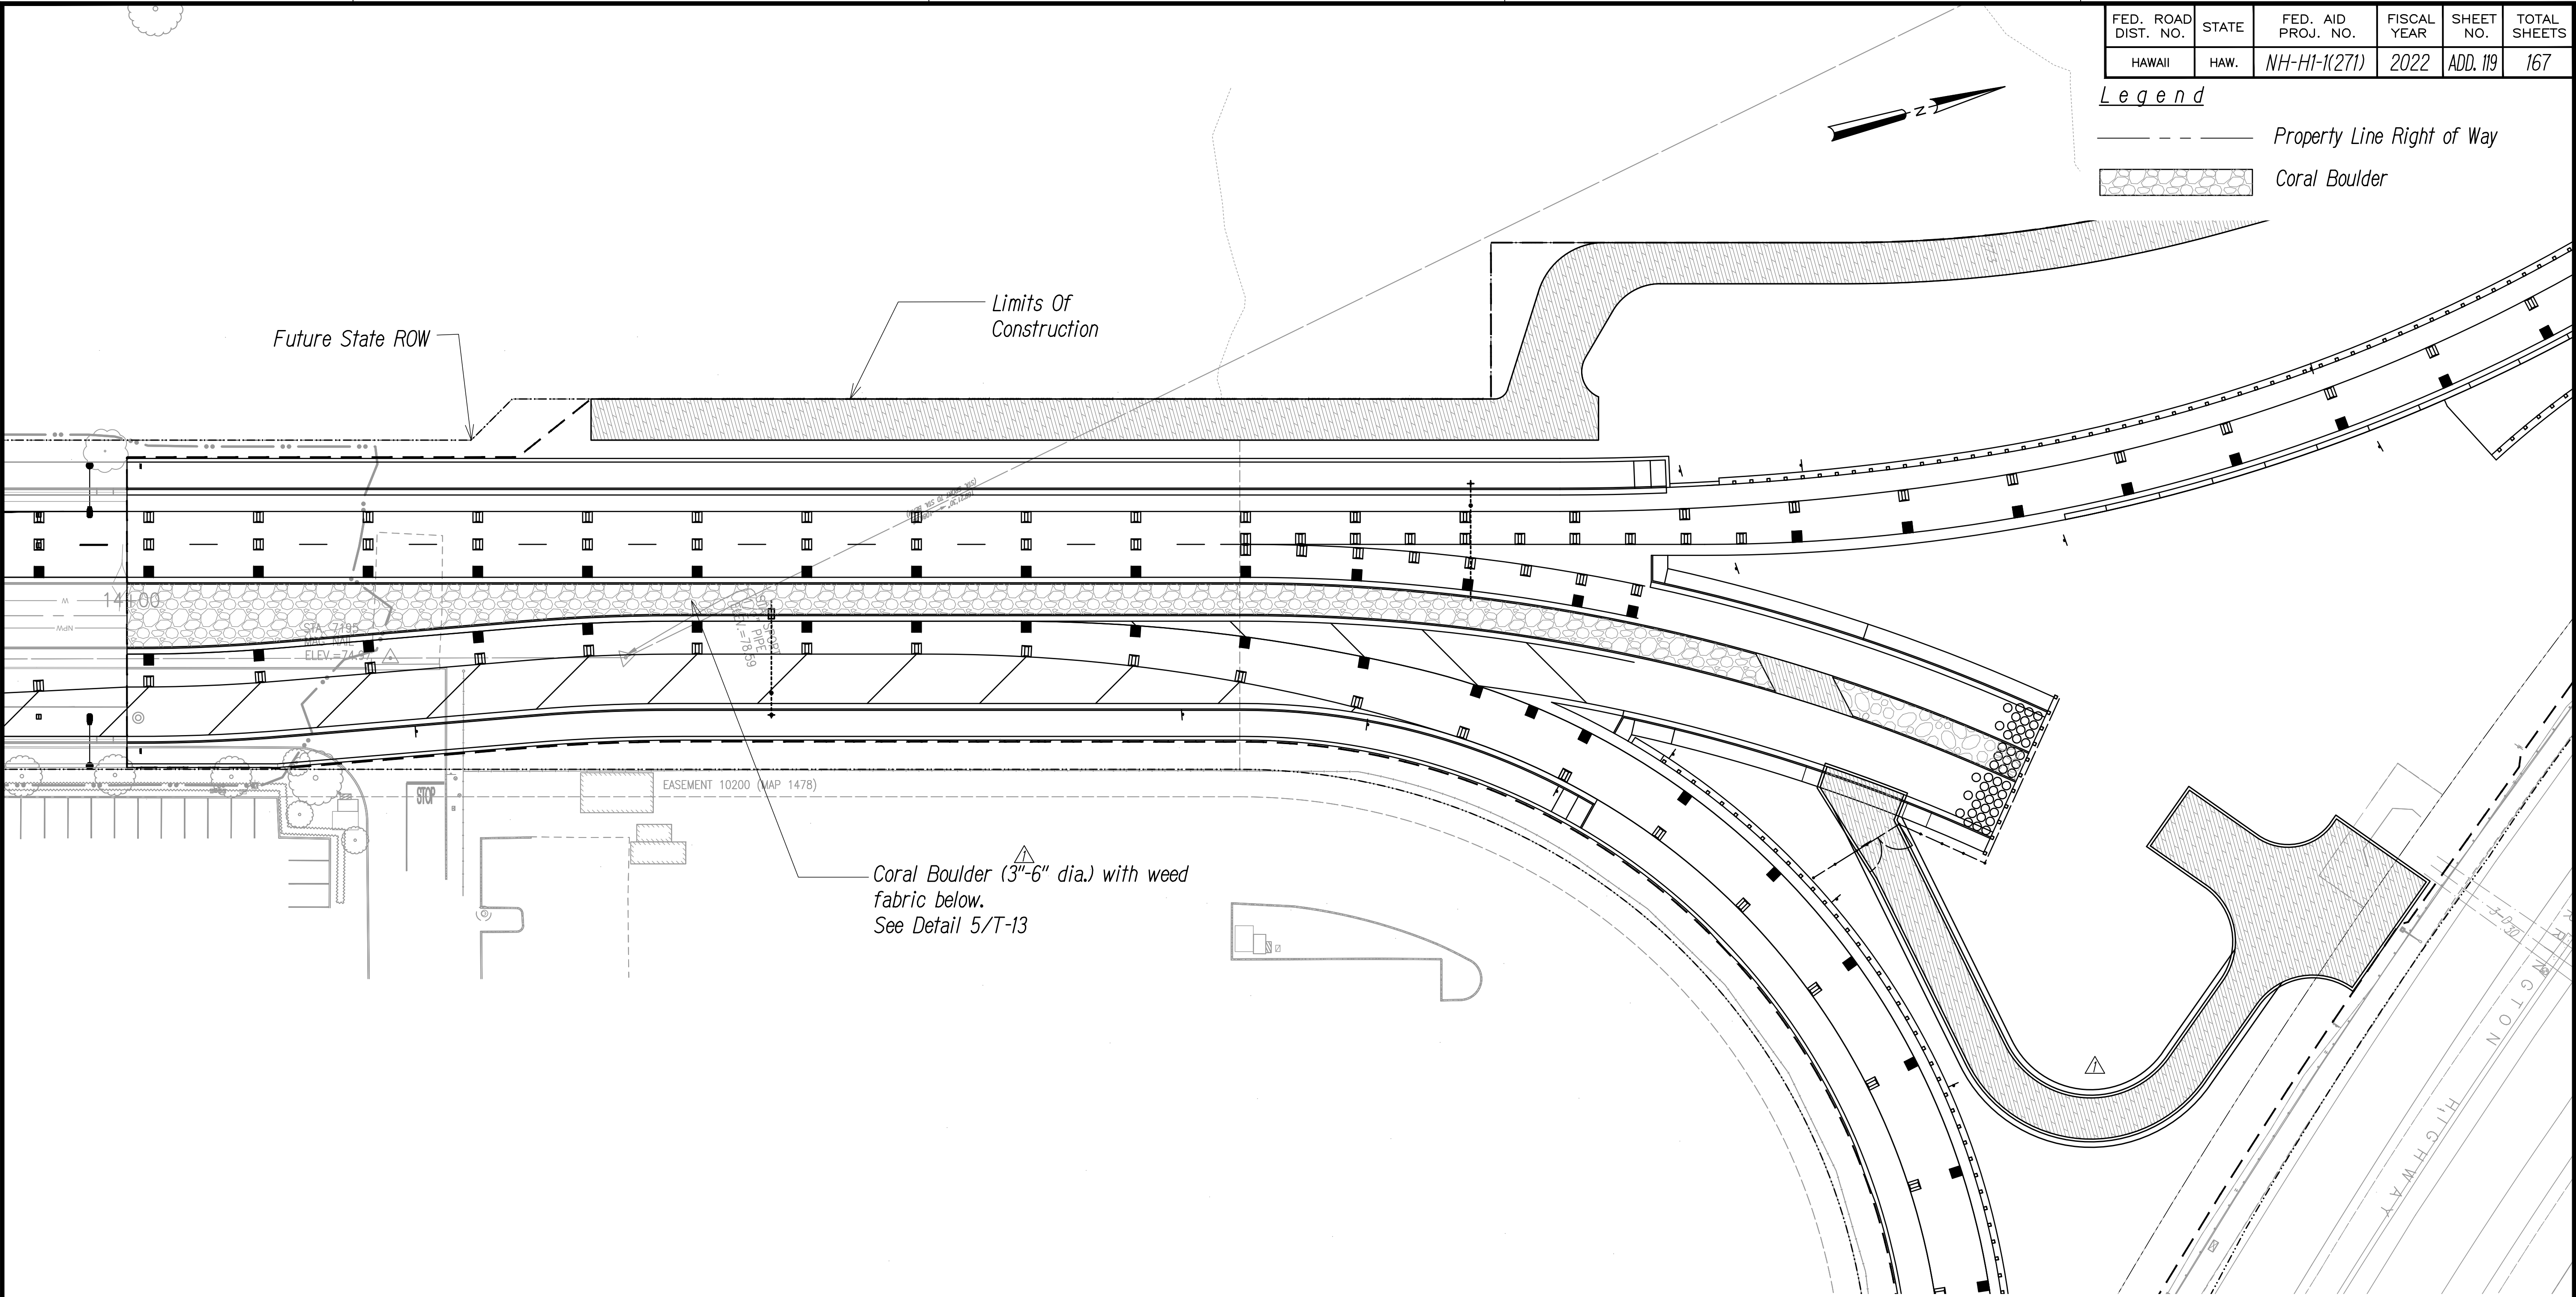

Harbor Access Road - Planting Plan
Scale: 1" = 30'

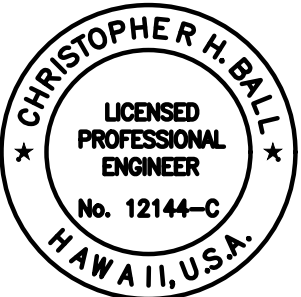

This work was prepared by me or under my supervision
Chris Ball
MITSUNAGA & ASSOCIATES, INC. 4/30/2024
NOTE: Contractor to check and verify dimensions at job before proceeding with work.

11/17/2022	Added Maintenance Access Road Revised Coral Boulder Diameter
DATE	REVISION
STATE OF HAWAII DEPARTMENT OF TRANSPORTATION HIGHWAYS DIVISION	
PLANTING PLAN	
INTERSTATE ROUTE H-1 ADDITION AND MODIFICATION OF FREEWAY ACCESS (Kapolei Interchange Complex), Phase 3 Federal Aid Project No. NH-H1-K(271)	
Scale: As Noted	Date: August 2022

ORIGINAL PLAN	DATE
NOTE BOOK	
NO.	
SURVEY PLOTTED BY	
DESIGNED BY	
QUANTITIES BY	
CHECKED BY	