
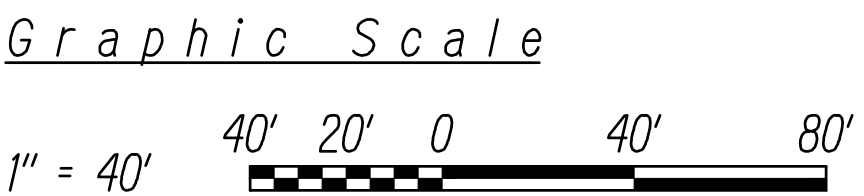



FED. ROAD DIST. NO.	STATE	FED. AID PROJ. NO.	FISCAL YEAR	SHEET NO.	TOTAL SHEETS
HAWAII	HAW.	NH-HI-K(271)	2022	77	167

Legend

- Limits of Construction
- Limits of Grading and Disturbed Area
- Guardrail
- Property Line
- 80 ----- Finish Grade Contour
- 80 ----- Exist. Grade Contour

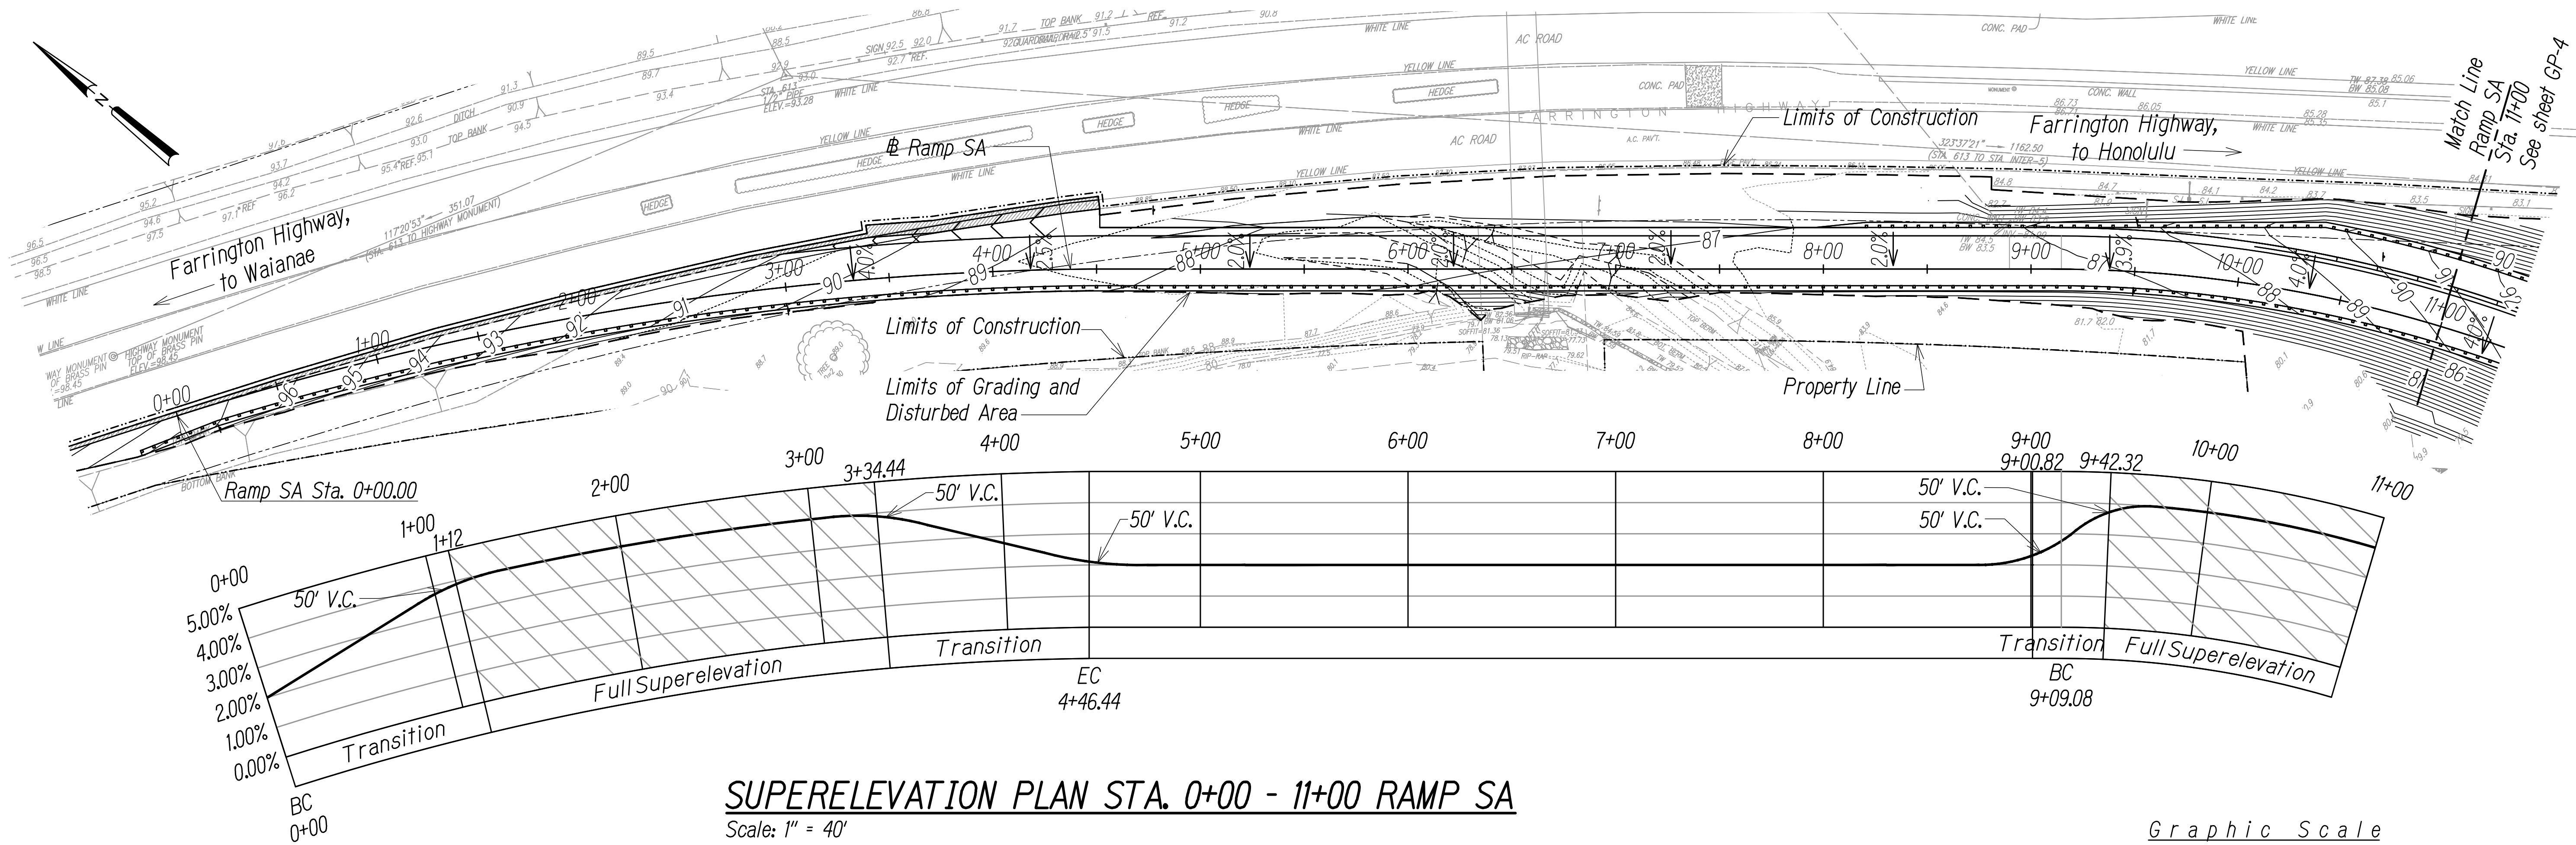

ORIGINAL PLAN	SURVEY PLOTTED BY	DATE
NOTE BOOK	DESIGNED BY	
	QUANTITIES BY	
	CHECKED BY	

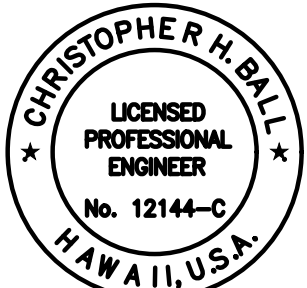

This work was prepared by me or under my supervision  
MITSUNAGA & ASSOCIATES, INC. 4/30/2024  
NOTE: Contractor to check and verify dimensions at job before proceeding with work.

STATE OF HAWAII  
DEPARTMENT OF TRANSPORTATION  
HIGHWAYS DIVISION

**SUPERELEVATION PLAN 1**

INTERSTATE ROUTE H-1  
ADDITION AND MODIFICATION OF FREEWAY ACCESS  
(Kapolei Interchange Complex), Phase 3  
Federal Aid Project No. NH-HI-K(271)


Scale: As Noted      Date: August 2022

SHEET NO. **GP-8** OF **167** SHEETS

FED. ROAD DIST. NO.	STATE	FED. AID PROJ. NO.	FISCAL YEAR	SHEET NO.	TOTAL SHEETS
HAWAII	HAW.	NH-H1-K(271)	2022	78	167

Legend

- Limits of Construction
- Limits of Grading and Disturbed Area
- Guardrail
- Property Line
- 80 ----- Finish Grade Contour
- 80 ----- Exist. Grade Contour

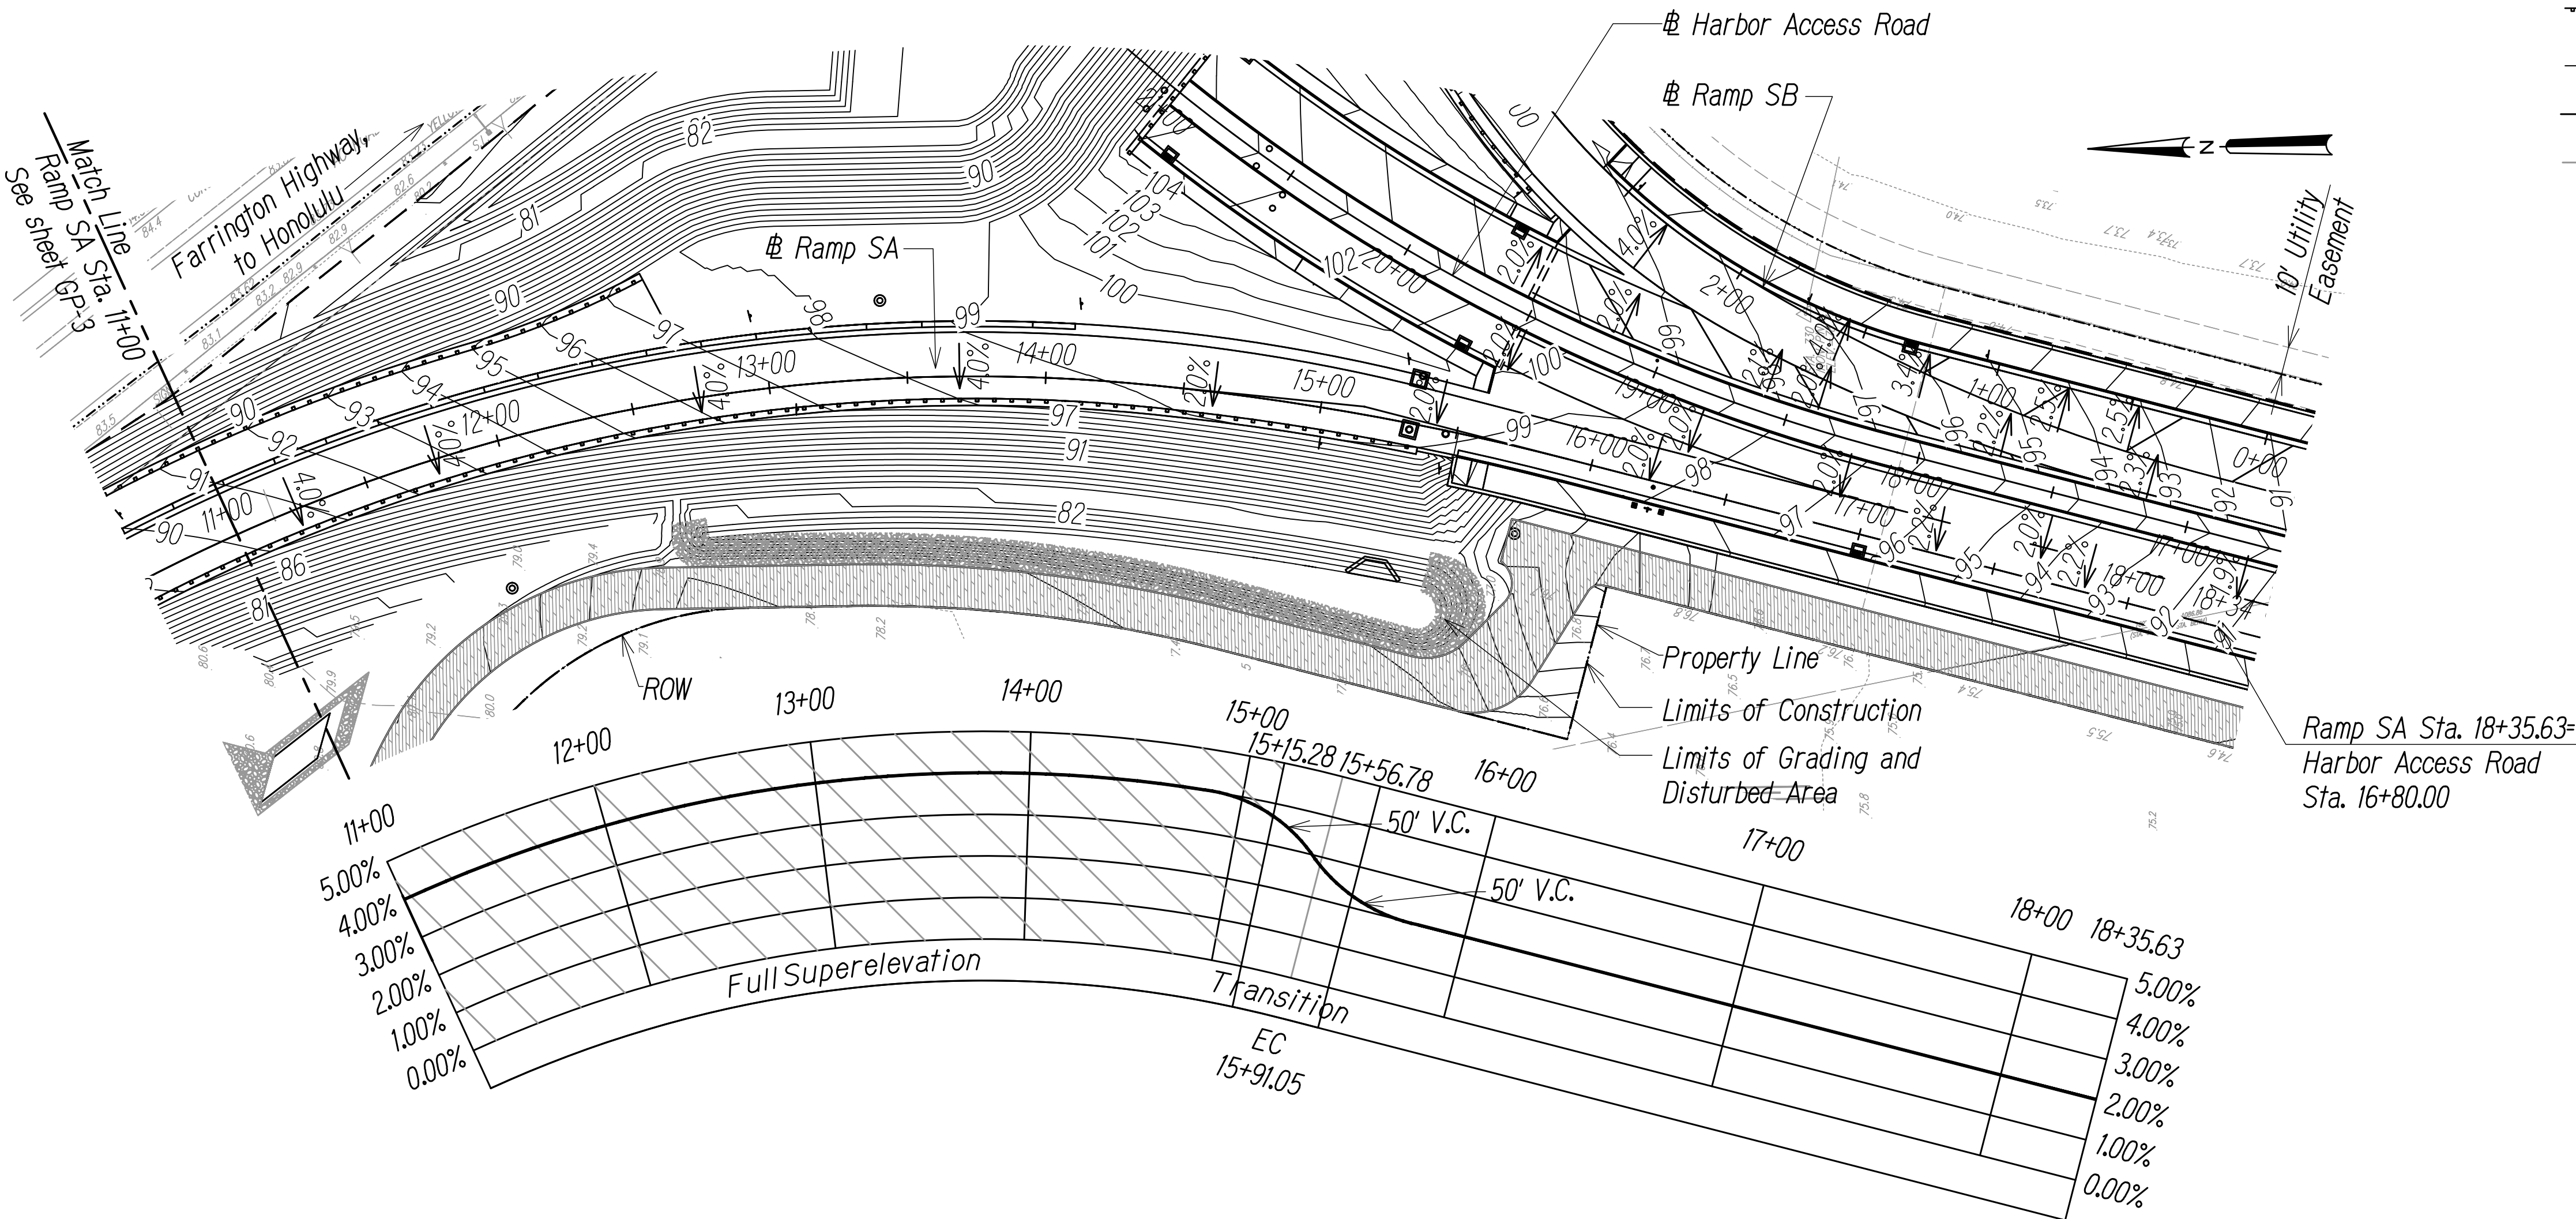


**SUPERELEVATION PLAN STA. 11+00 - 18+35.63 RAMP SA**

Scale: 1" = 40'

Graphic Scale

1" = 40' 40' 20' 0 40' 80'

SURVEY PLOTTED BY	DATE
DESIGNED BY	
NOTED BY	
CHECKED BY	

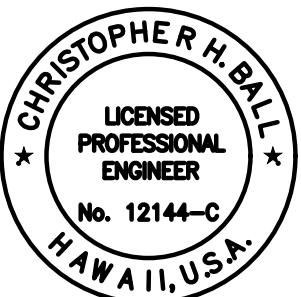

This work was prepared by me or under my supervision

Chris Ball  
MITSUNAGA & ASSOCIATES, INC. 4/30/2024  
NOTE: Contractor to check and verify dimensions at job before proceeding with work.

STATE OF HAWAII  
DEPARTMENT OF TRANSPORTATION  
HIGHWAYS DIVISION

**SUPERELEVATION PLAN 2**

**INTERSTATE ROUTE H-1  
ADDITION AND MODIFICATION OF FREEWAY ACCESS  
(Kapolei Interchange Complex), Phase 3  
Federal Aid Project No. NH-H1-K(271)**

Scale: As Noted Date: August 2022


SHEET NO. GP-9 OF 167 SHEETS



FED. ROAD DIST. NO.	STATE	FED. AID PROJ. NO.	FISCAL YEAR	SHEET NO.	TOTAL SHEETS
HAWAII	HAW.	NH-HI-1(271)	2022	ADD. 79	167

Legend

- Limits of Construction
- Limits of Grading and Disturbed Area
- Guardrail
- Property Line
- 80----- Finish Grade Contour
- 80----- Exist. Grade Contour

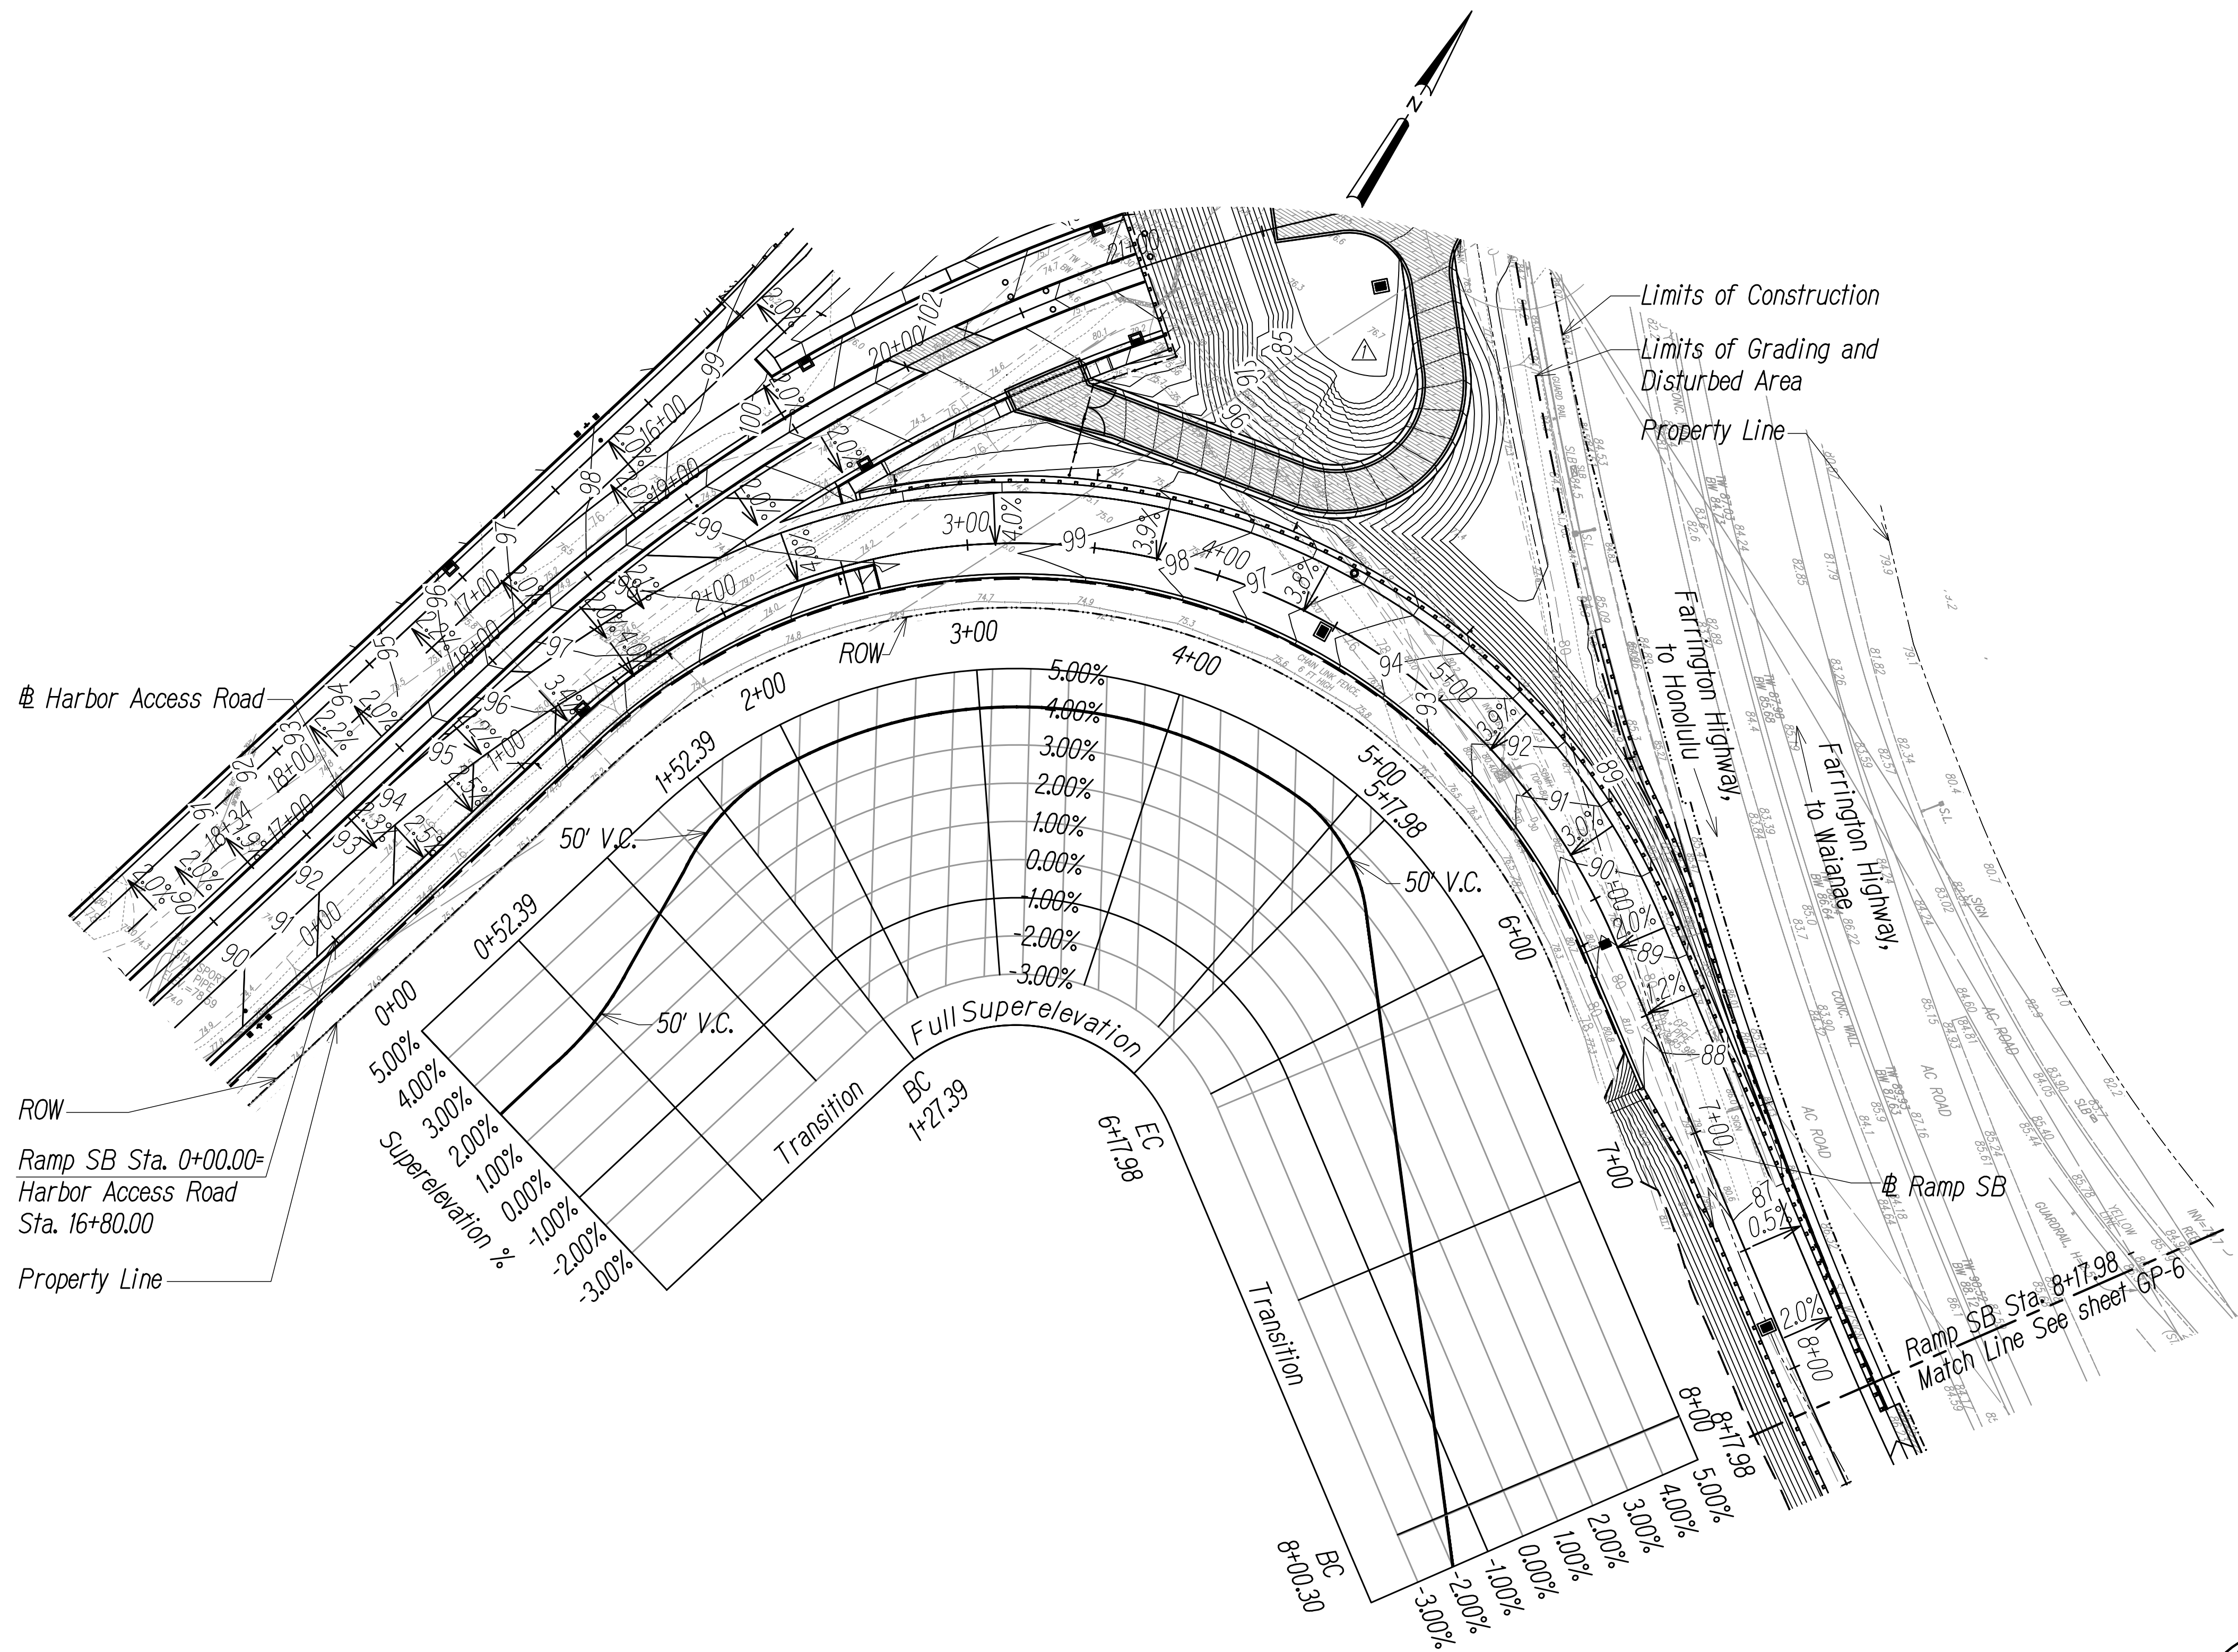


SUPERELEVATION PLAN STA. 0+00 - 8+17.98 RAMP SB

Scale: 1" = 40'

Graphic Scale

1" = 40' 40' 20' 0 40' 80'

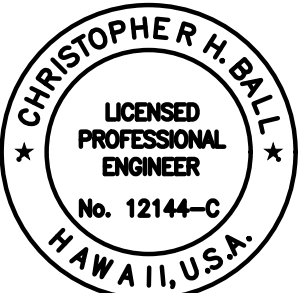

This work was prepared by me or under my supervision



Chris Ball  
MITSUNAGA & ASSOCIATES, INC. 4/30/2024  
NOTE: Contractor to check and verify dimensions at job before proceeding with work.

11/17/2022	Added Maintenance Access Road
DATE	REVISION
STATE OF HAWAII DEPARTMENT OF TRANSPORTATION HIGHWAYS DIVISION	
<b>SUPERELEVATION PLAN 3</b>	
INTERSTATE ROUTE H-1 ADDITION AND MODIFICATION OF FREEWAY ACCESS (Kapolei Interchange Complex), Phase 3 Federal Aid Project No. NH-HI-1(271)	
Scale: As Noted	Date: August 2022


SHEET NO. GP-10 OF 167 SHEETS

FED. ROAD DIST. NO.	STATE	FED. AID PROJ. NO.	FISCAL YEAR	SHEET NO.	TOTAL SHEETS
HAWAII	HAW.	NH-H1-K(271)	2022	80	167

- Legend
- Limits of Construction
  - Limits of Grading and Disturbed Area
  - Guardrail
  - Property Line
  - 80 ----- Finish Grade Contour
  - 80 ----- Exist. Grade Contour

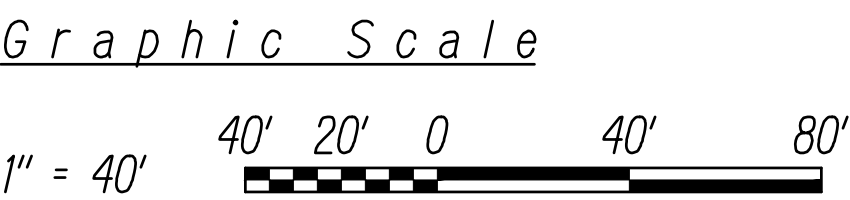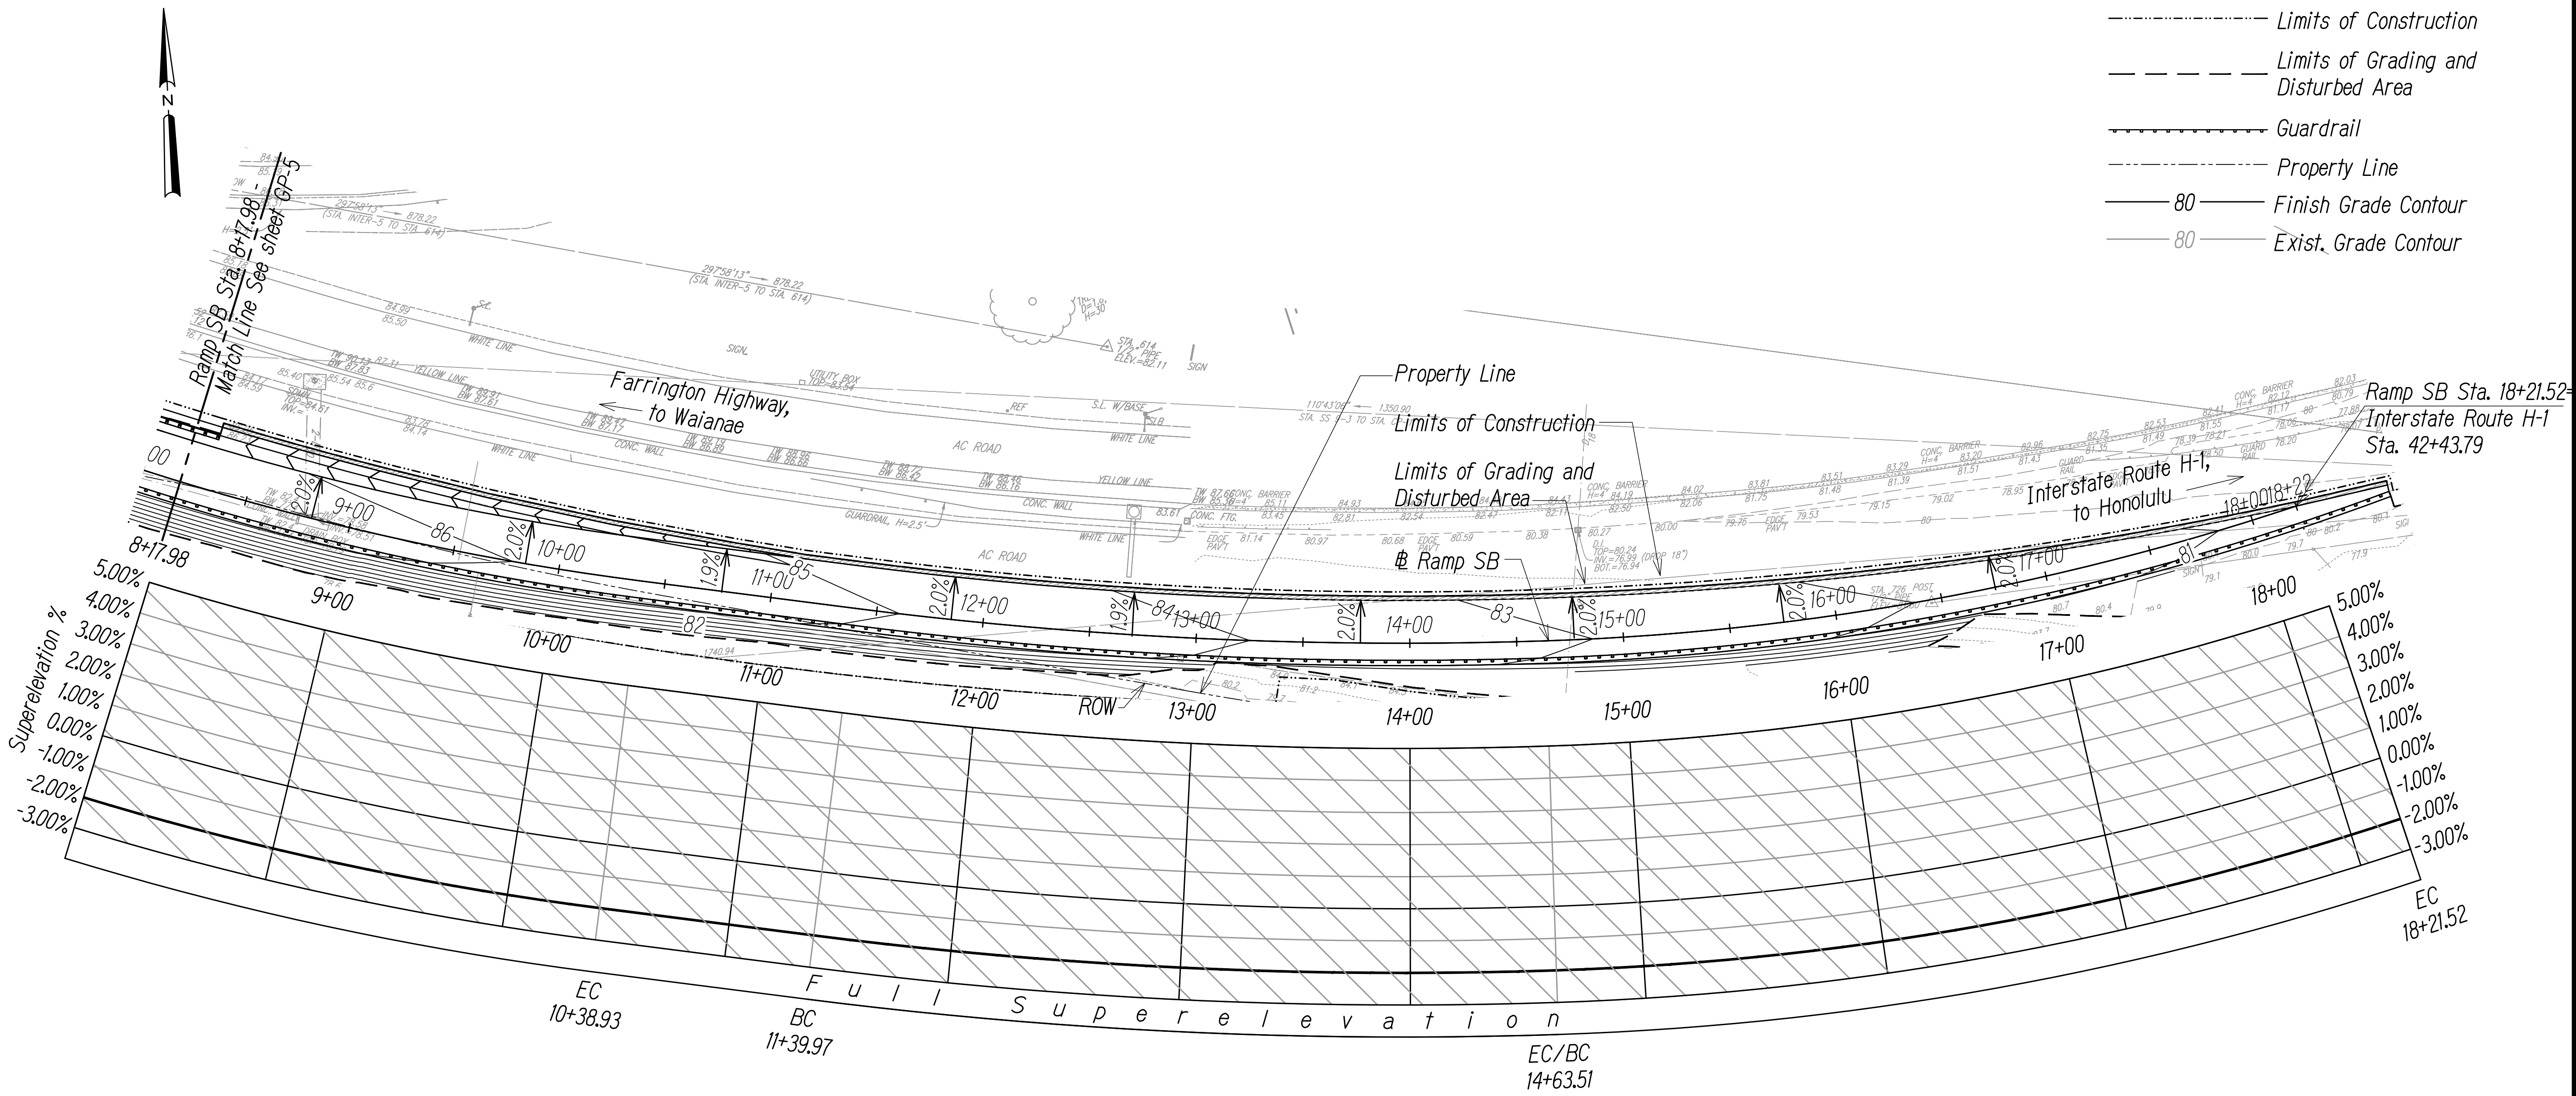

**SUPERELEVATION PLAN STA. 8+17.98 - 18+21.52 RAMP SB**  
Scale: 1" = 40'

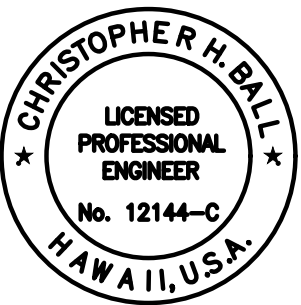

This work was prepared by  
me or under my supervision  
**Chris Ball**  
MITSUNAGA & ASSOCIATES, INC. 4/30/2024  
EXP. DATE

STATE OF HAWAII  
DEPARTMENT OF TRANSPORTATION  
HIGHWAYS DIVISION

**SUPERELEVATION PLAN 4**

**INTERSTATE ROUTE H-1**  
**ADDITION AND MODIFICATION OF FREEWAY ACCESS**  
**(Kapolei Interchange Complex), Phase 3**  
**Federal Aid Project No. NH-H1-K(271)**

Scale: As Noted Date: August 2022