
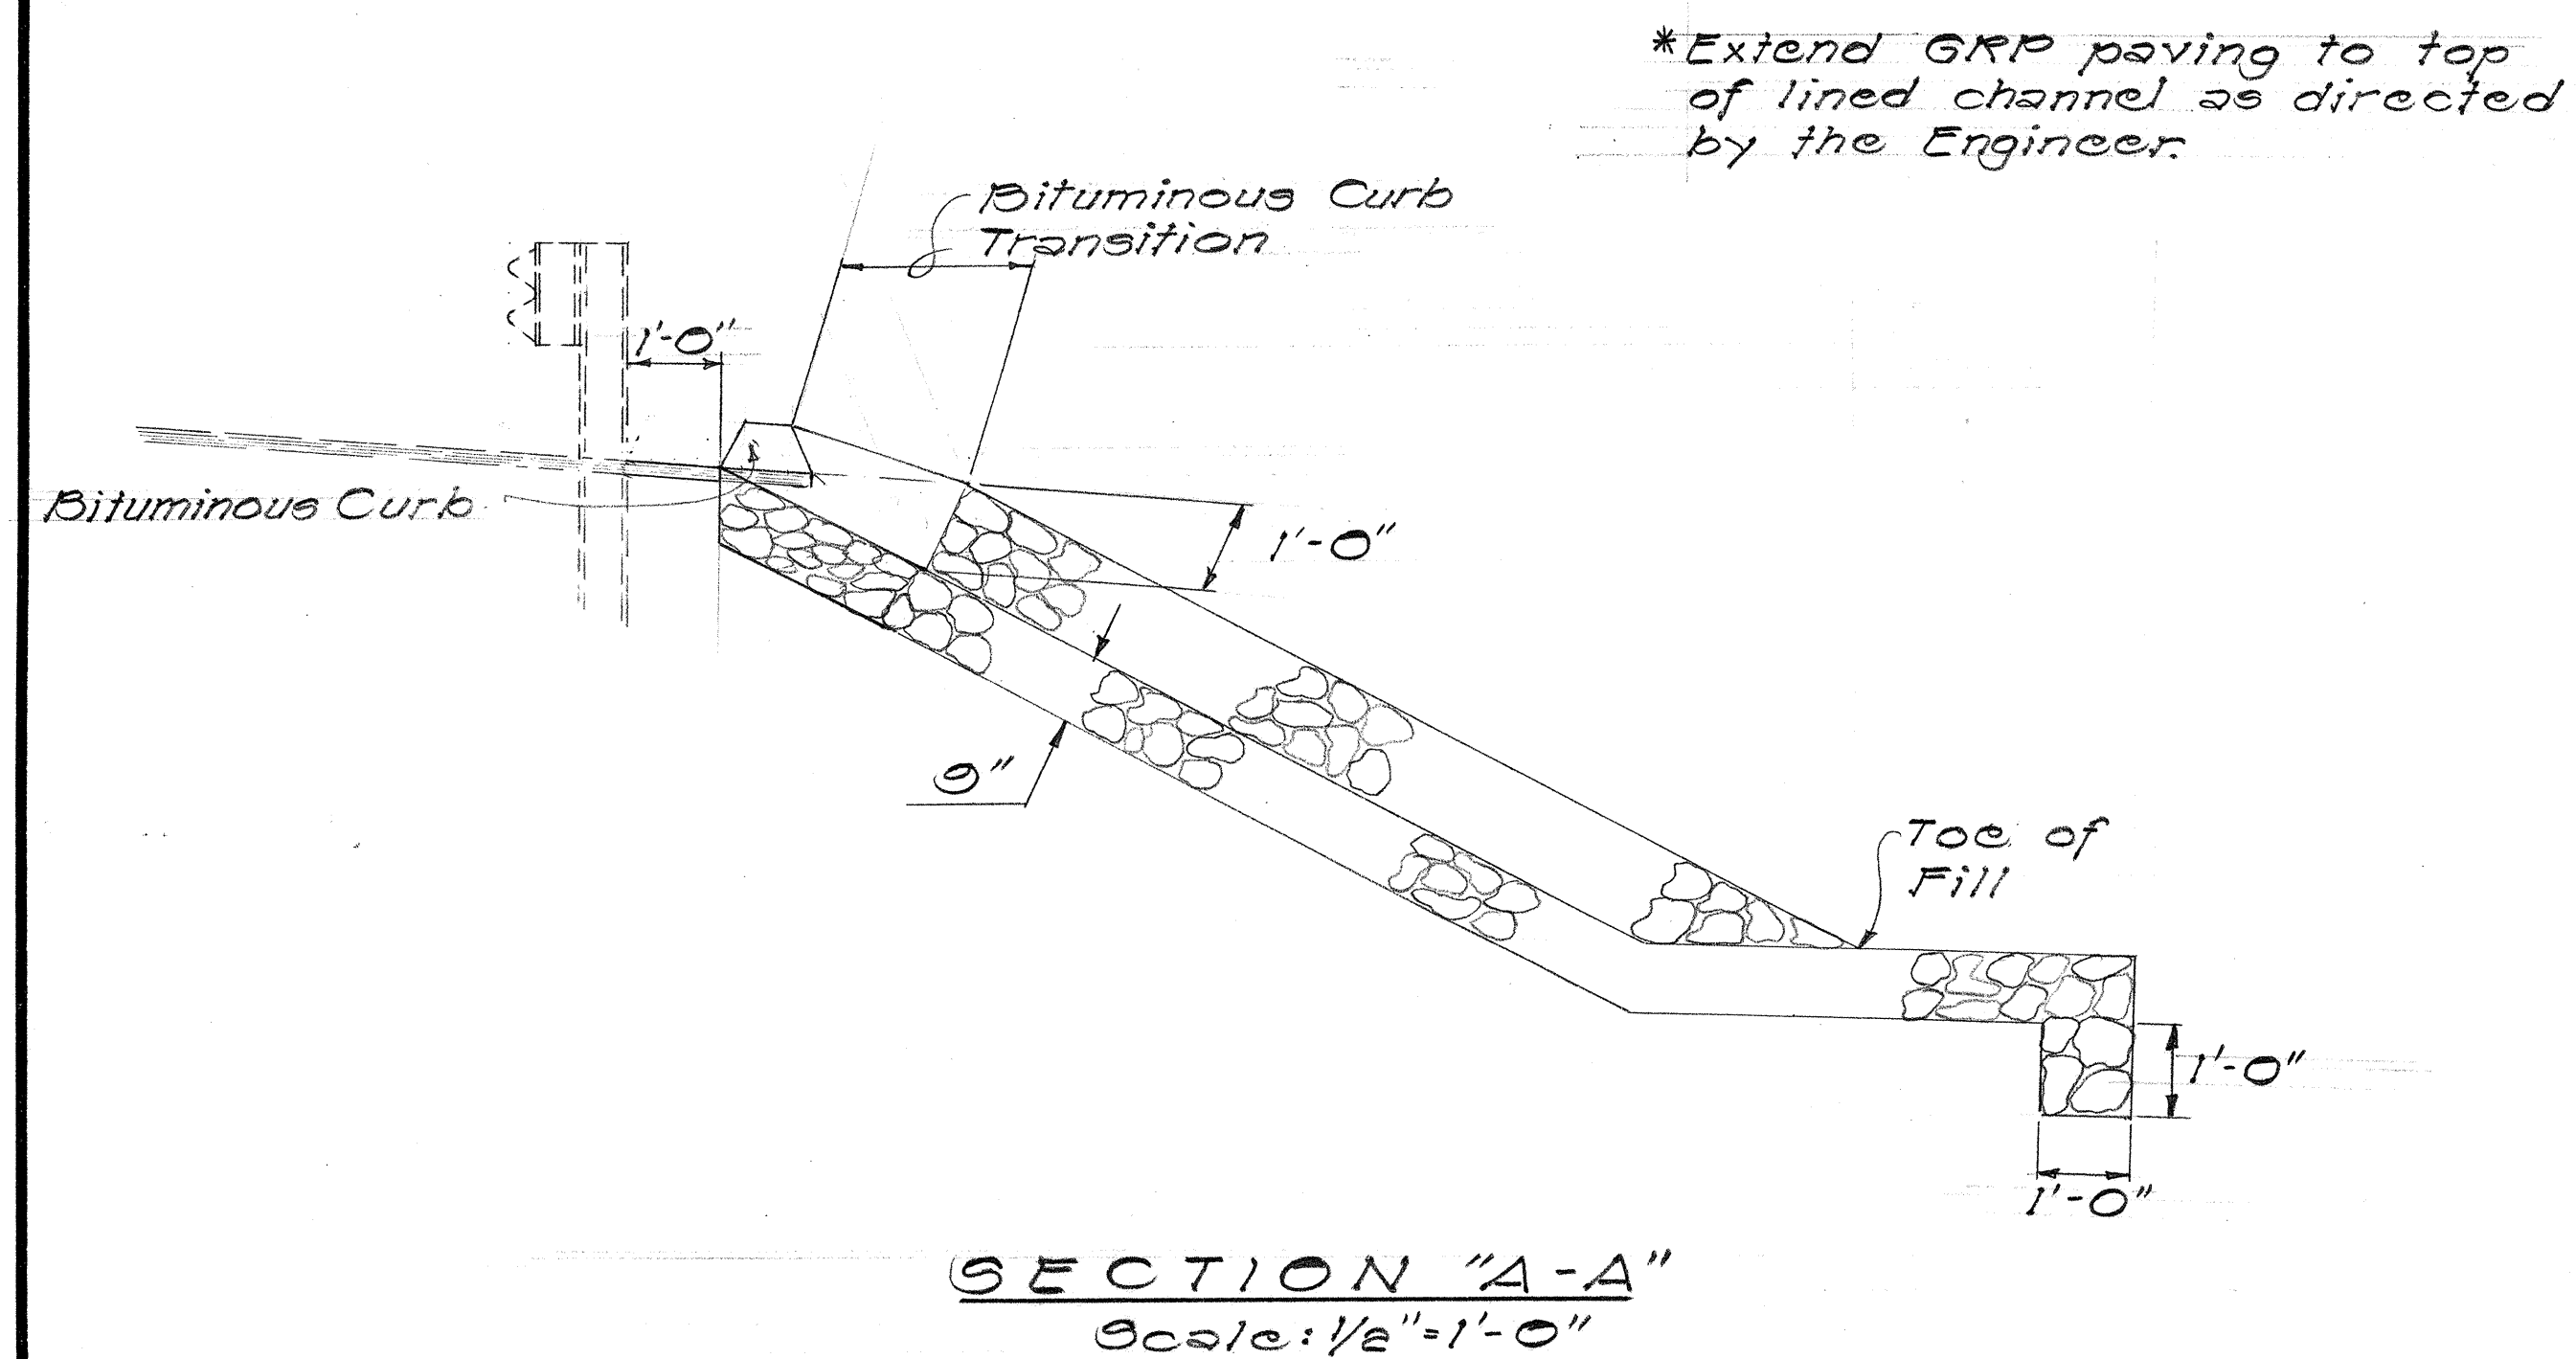
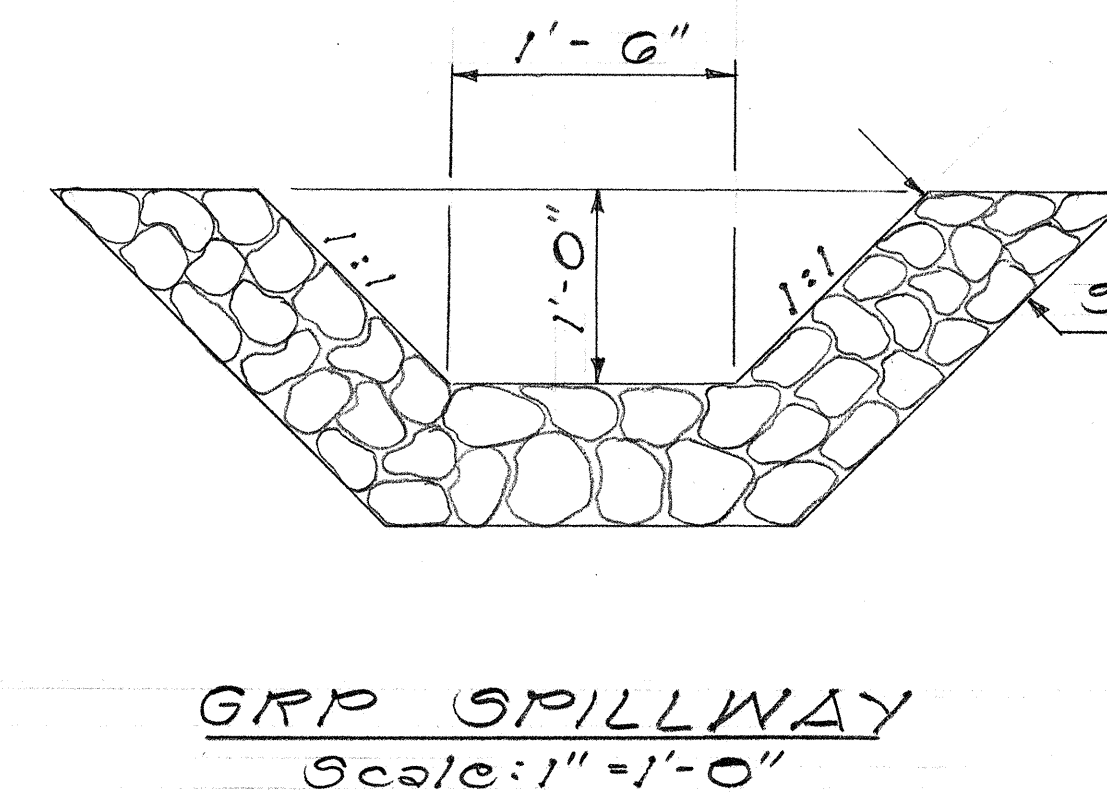
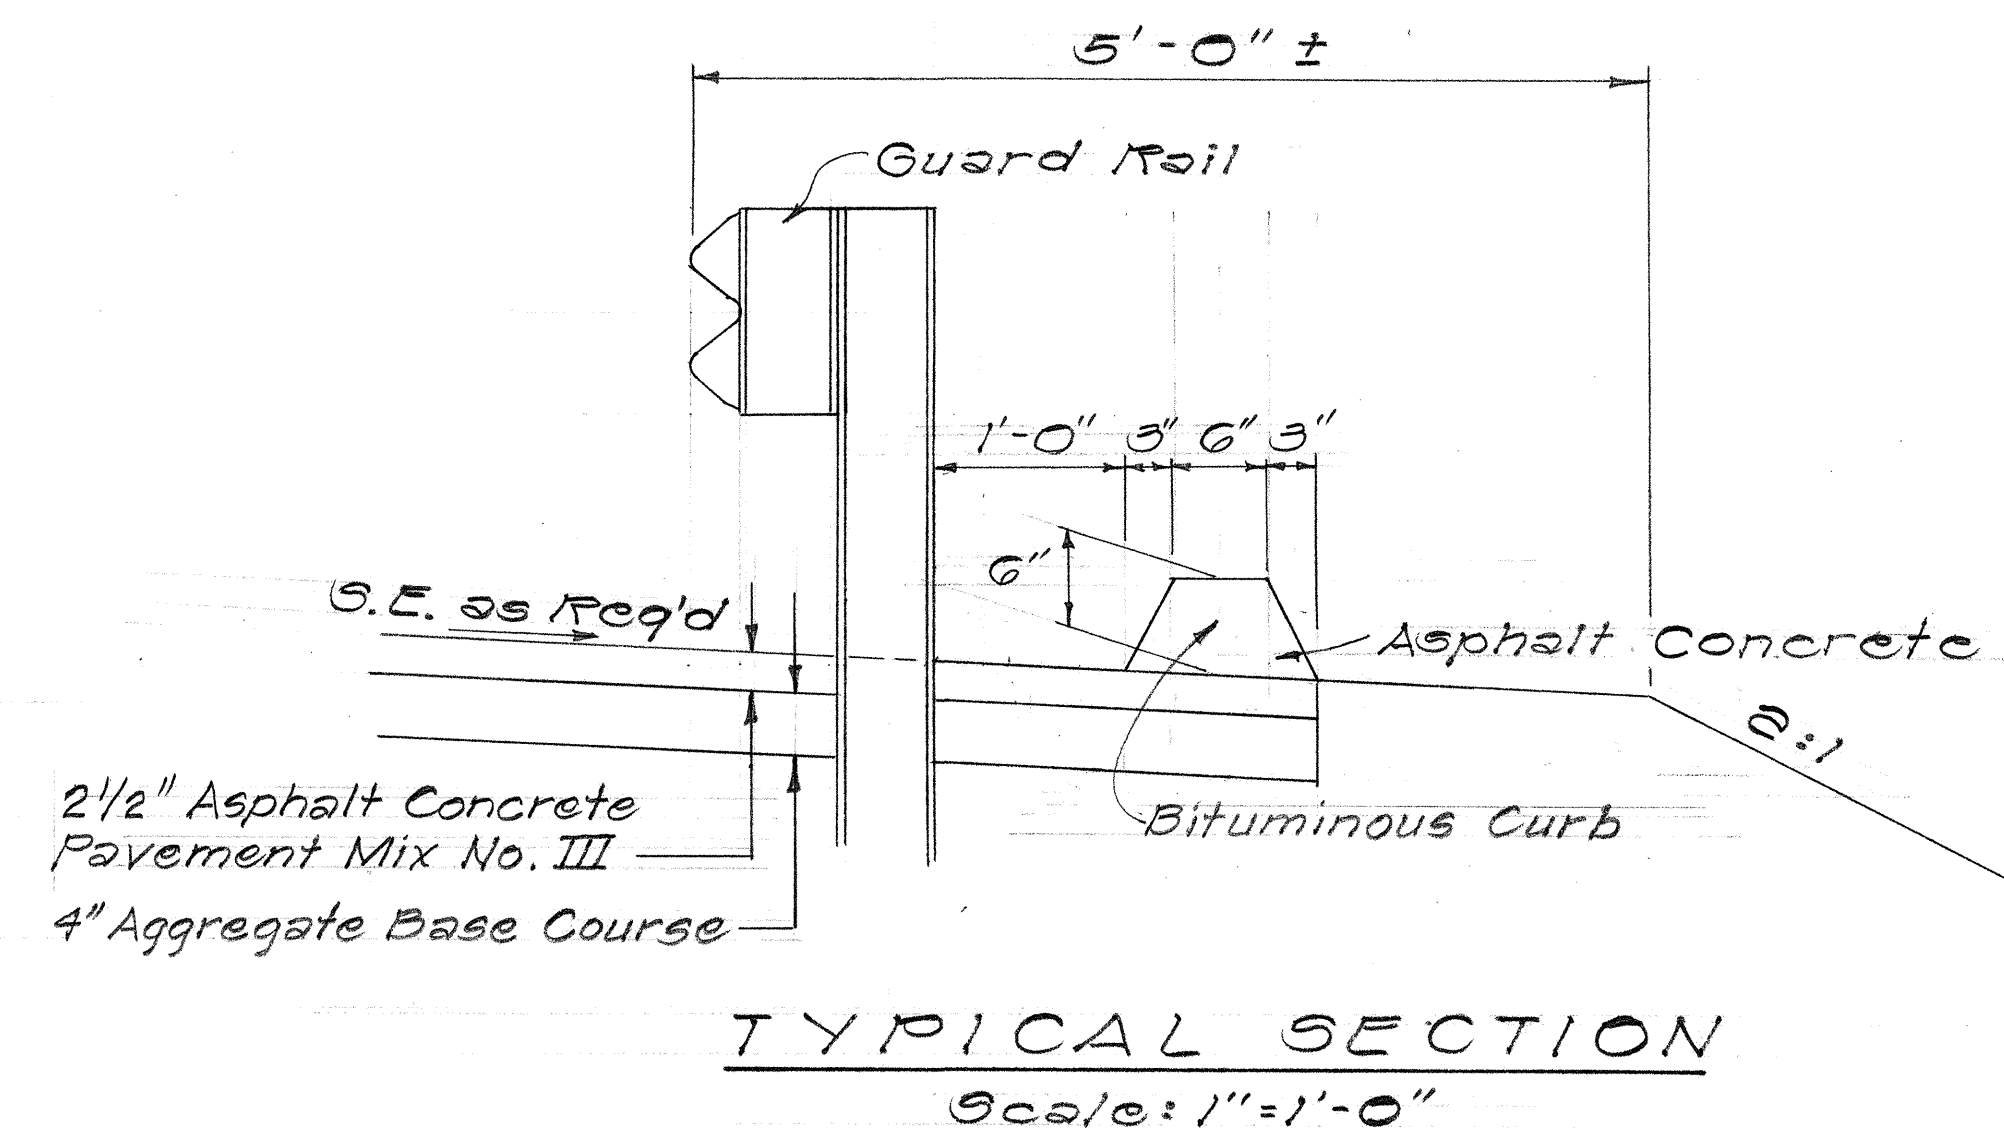


FED. ROAD DIST. NO.	STATE	FED. AID PROJ. NO.	FISCAL YEAR	SHEET NO.	TOTAL SHEETS
HAWAII	HAW.	I-HI-1(113):13	1976	19	63

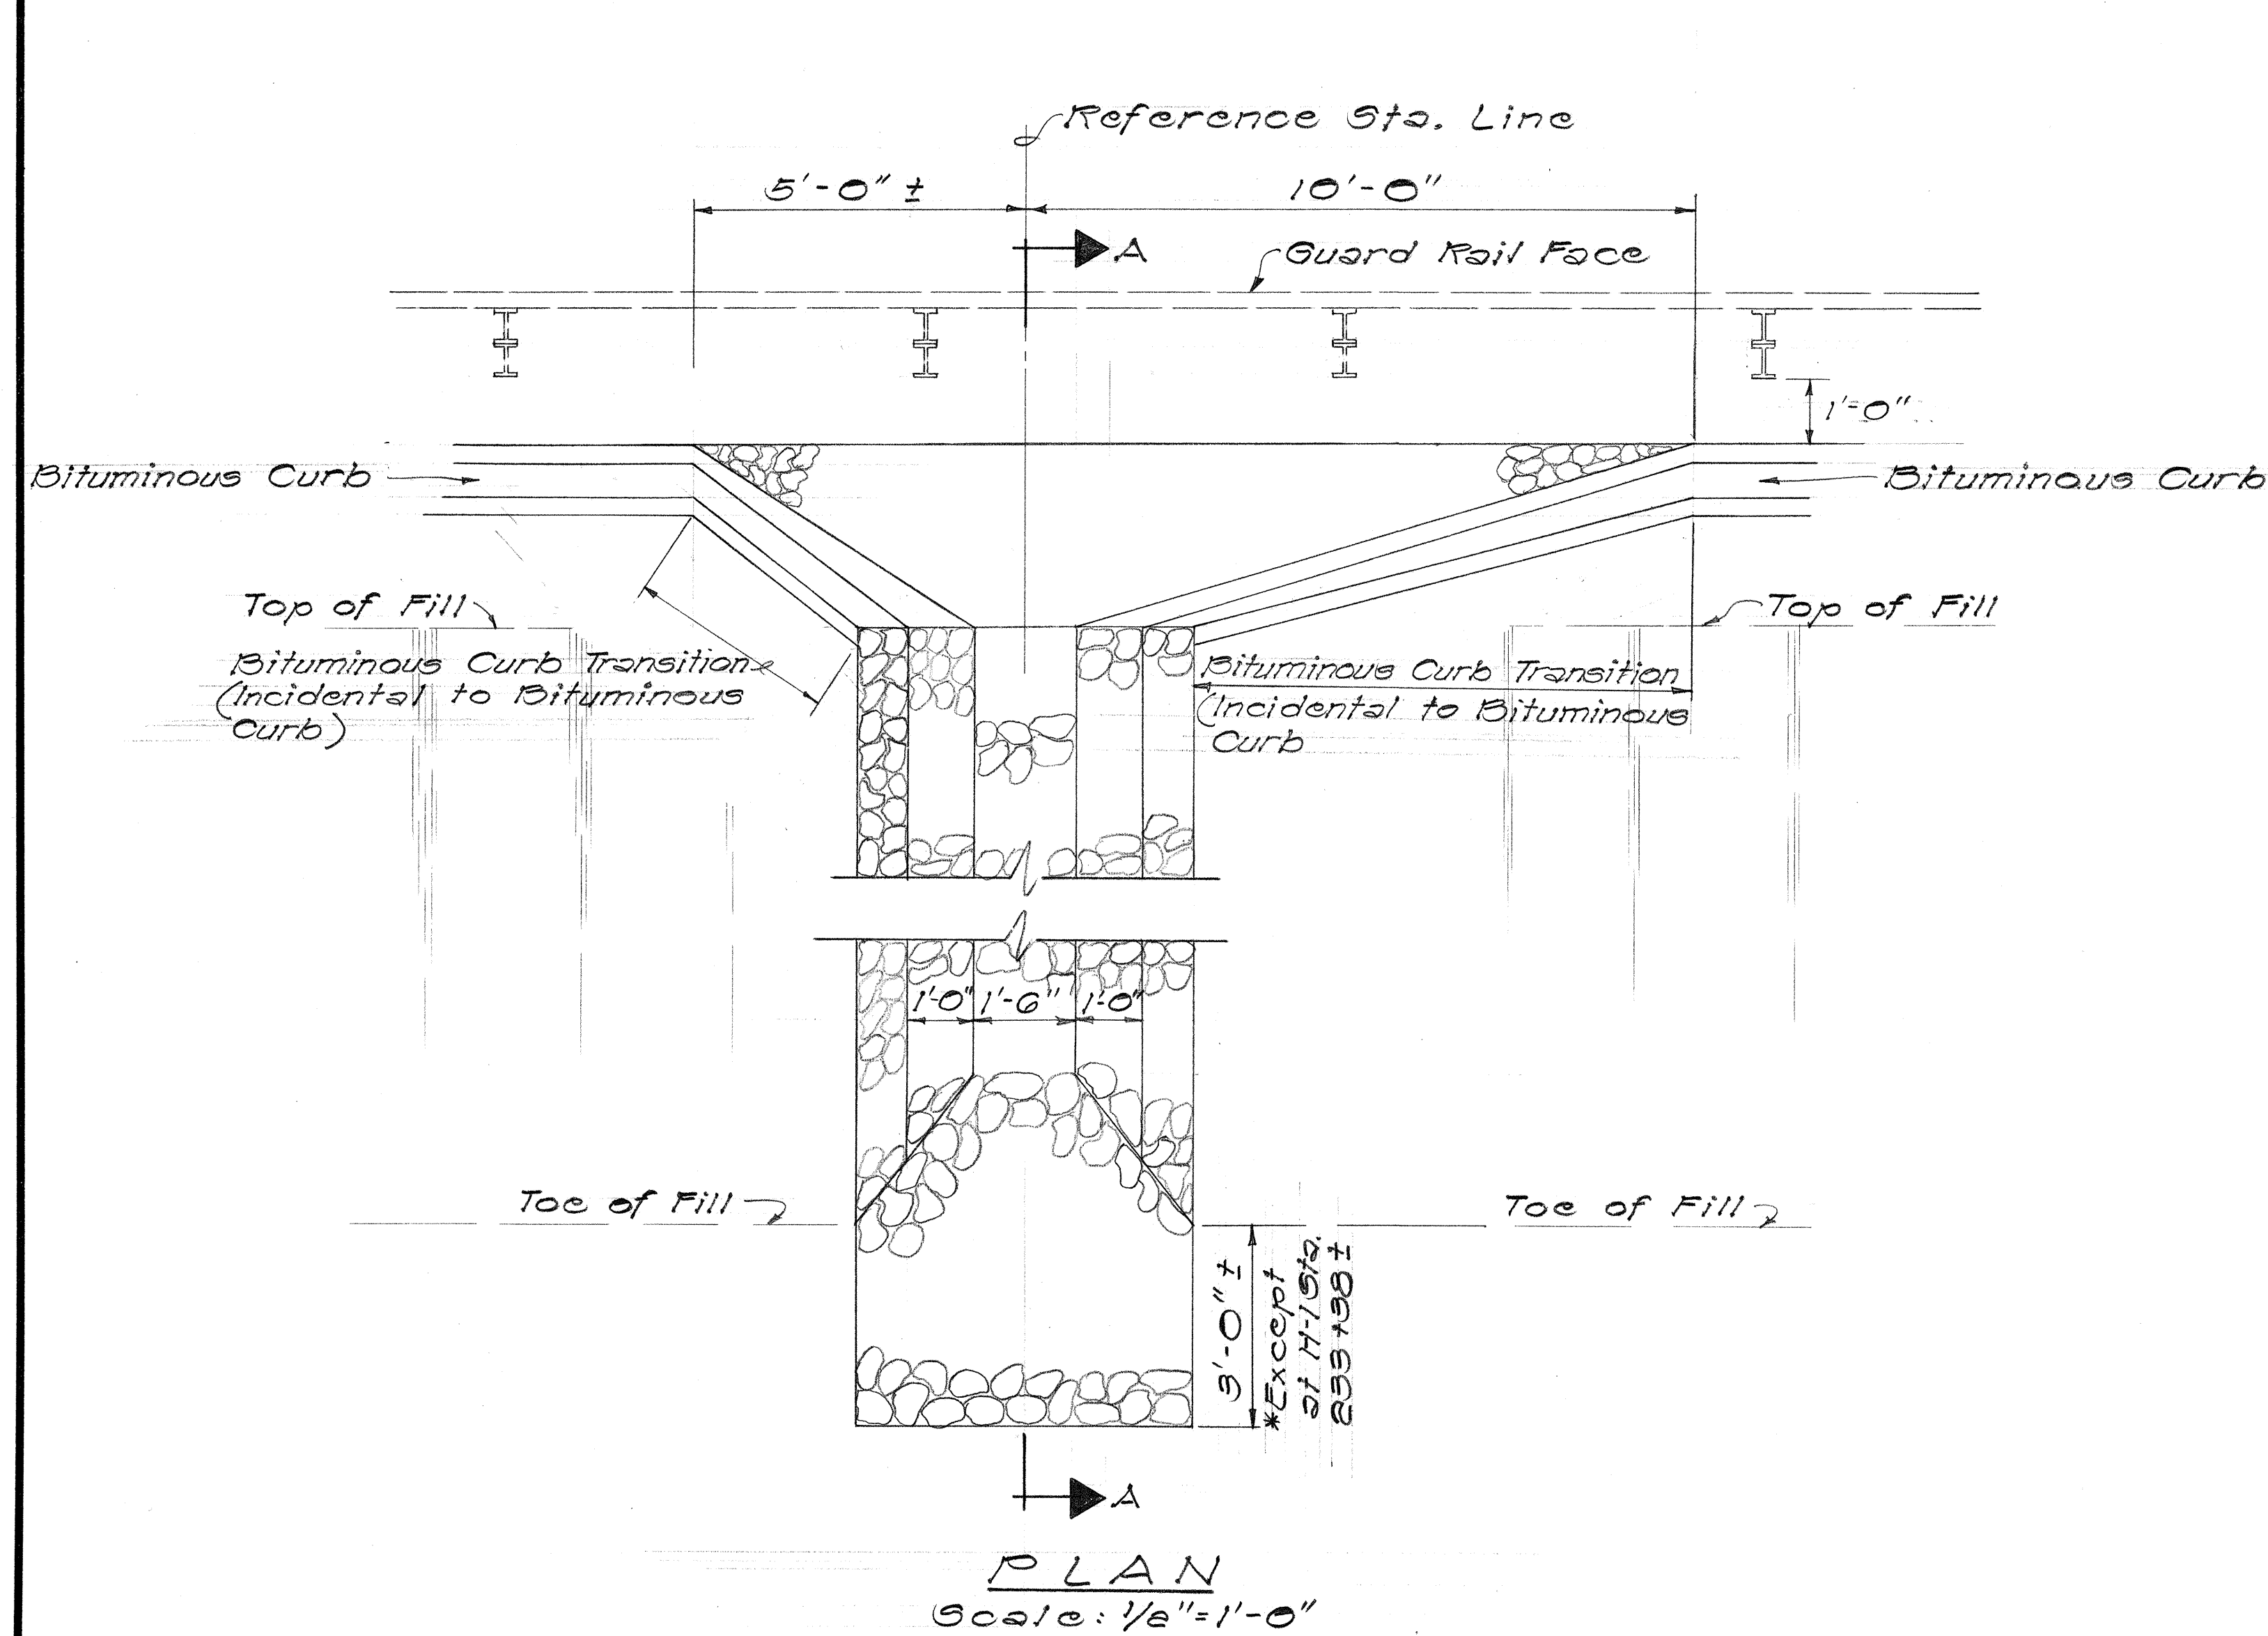

*Extend GRP paving to top of lined channel as directed by the Engineer.

DETAILS OF GRP SPILLWAY AND A.C. CURB

STATE OF HAWAII	
DEPARTMENT OF TRANSPORTATION	
HIGHWAYS DIVISION	
<u>DRAINAGE DETAILS</u>	
INTERSTATE ROUTE H-1	
PROJECT NO. I-HI-1(113):13	
Scale: As Noted	Date: April 1976
SHEET NO. 1 OF 1 SHEETS	