


INDEX TO DRAWINGS	
SHEET NO.	DESCRIPTION
1	TITLE SHEET
2-4	TYPICAL SECTIONS
5-8	PLANS
9-11	TYPICAL GORE AREAS AND RAMP TERMINAL DETAILS
12-18	ROADWAY PROFILE AND SUPERELEVATION DIAGRAMS
19	DRAINAGE DETAILS
20-33	SIGNING AND PAVEMENT MARKINGS
34	EXPRESSWAY SIGN LIGHTING SYSTEM
35	SIGN SCHEDULES
36	MISCELLANEOUS SIGNING NOTES AND DETAILS
37-41	PANEL LAYOUTS
42-43	FRAME LAYOUTS
44-63	MISCELLANEOUS AND STANDARD DETAILS

FED. ROAD DIST. NO.	STATE	FED. AID PROJ. NO.	FISCAL YEAR	SHEET NO.	TOTAL SHEETS
HAWAII	HAW.	I-HI-I(113):13	1976	1	63

STATE OF HAWAII
DEPARTMENT OF TRANSPORTATION
HIGHWAYS DIVISION
HONOLULU, HAWAII
AS BUILT PLANS
PLANS FOR
PAVING OF A PORTION OF
INTERSTATE ROUTE H-1
HALAWA INTERCHANGE
FEDERAL AID INTERSTATE PROJECT NO. I-HI-I(113):13

DISTRICT OF EWA
ISLAND OF OAHU

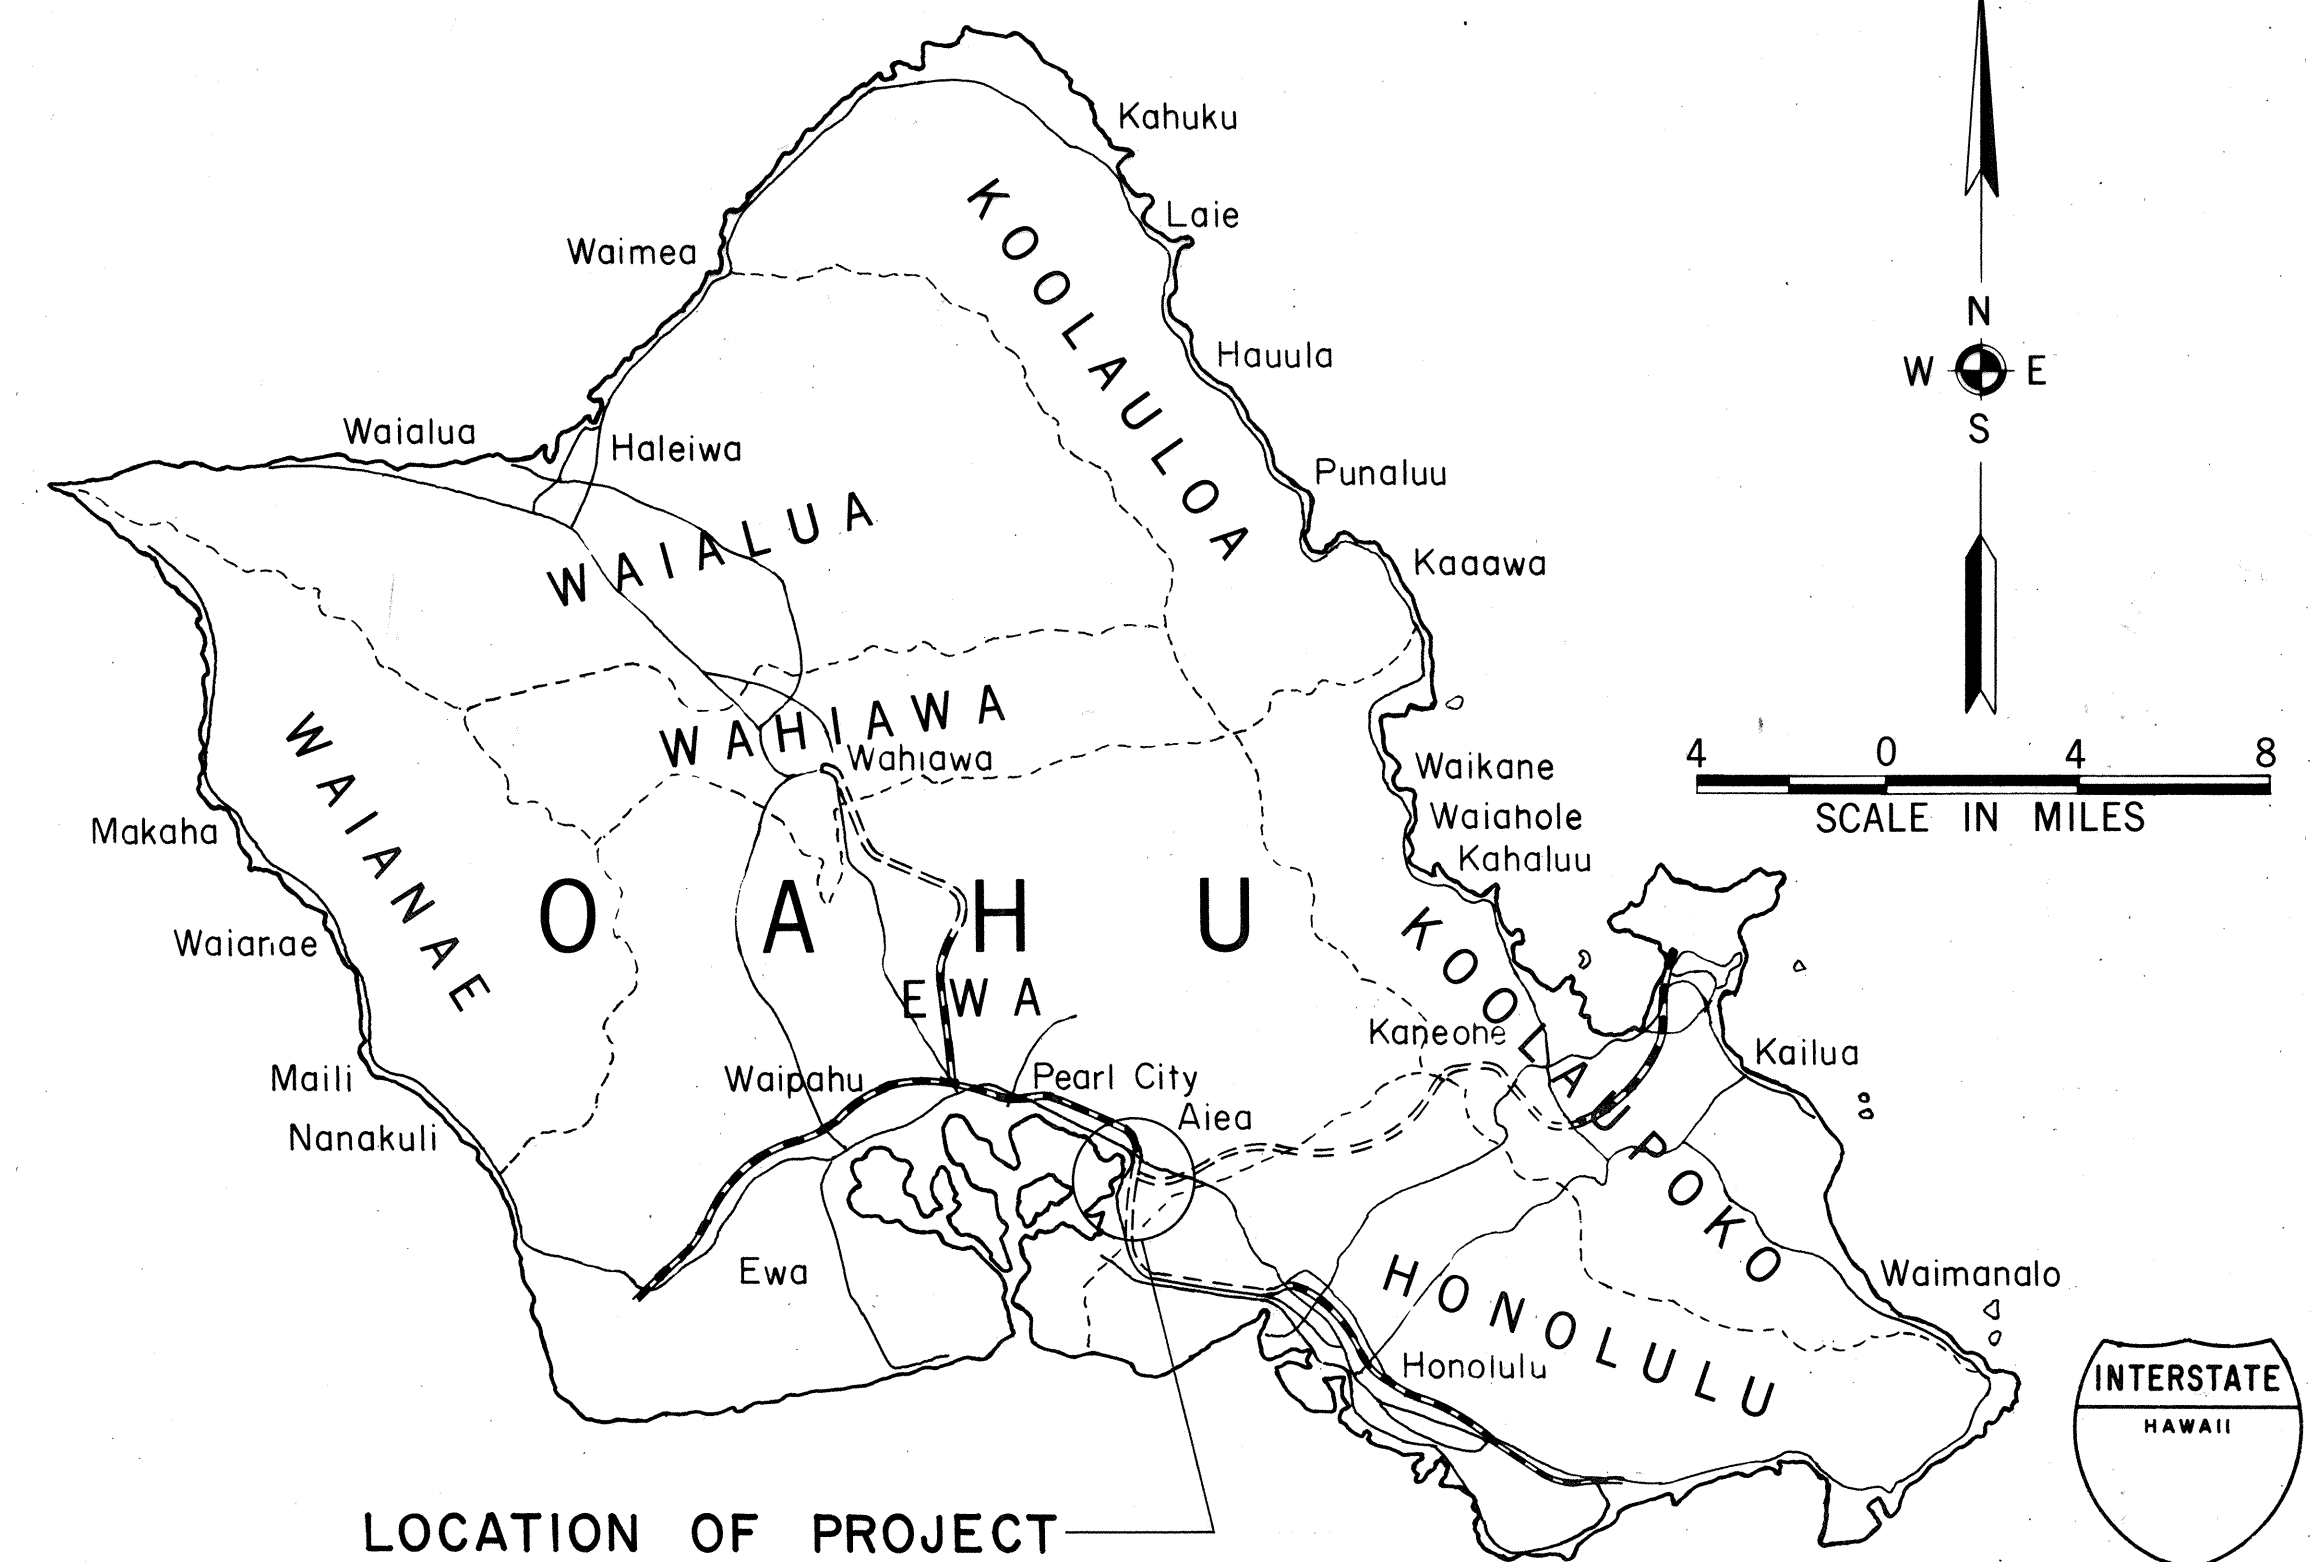


LOCATION OF PROJECT

ALL CHANGES MADE DURING CONSTRUCTION
HAVE BEEN INCORPORATED ON THESE PLANS
EXCEPT CHANGES IN THE ORIGINAL THEORETICAL
QUANTITIES.

E. Kobatake 8-28-78
for RESIDENT ENGINEER DATE

DESIGN	CLASSIFICATION
DESIGN ADT (1990)	56,704
DHV	5,858
D	60/40
T	5%
V	60 MPH

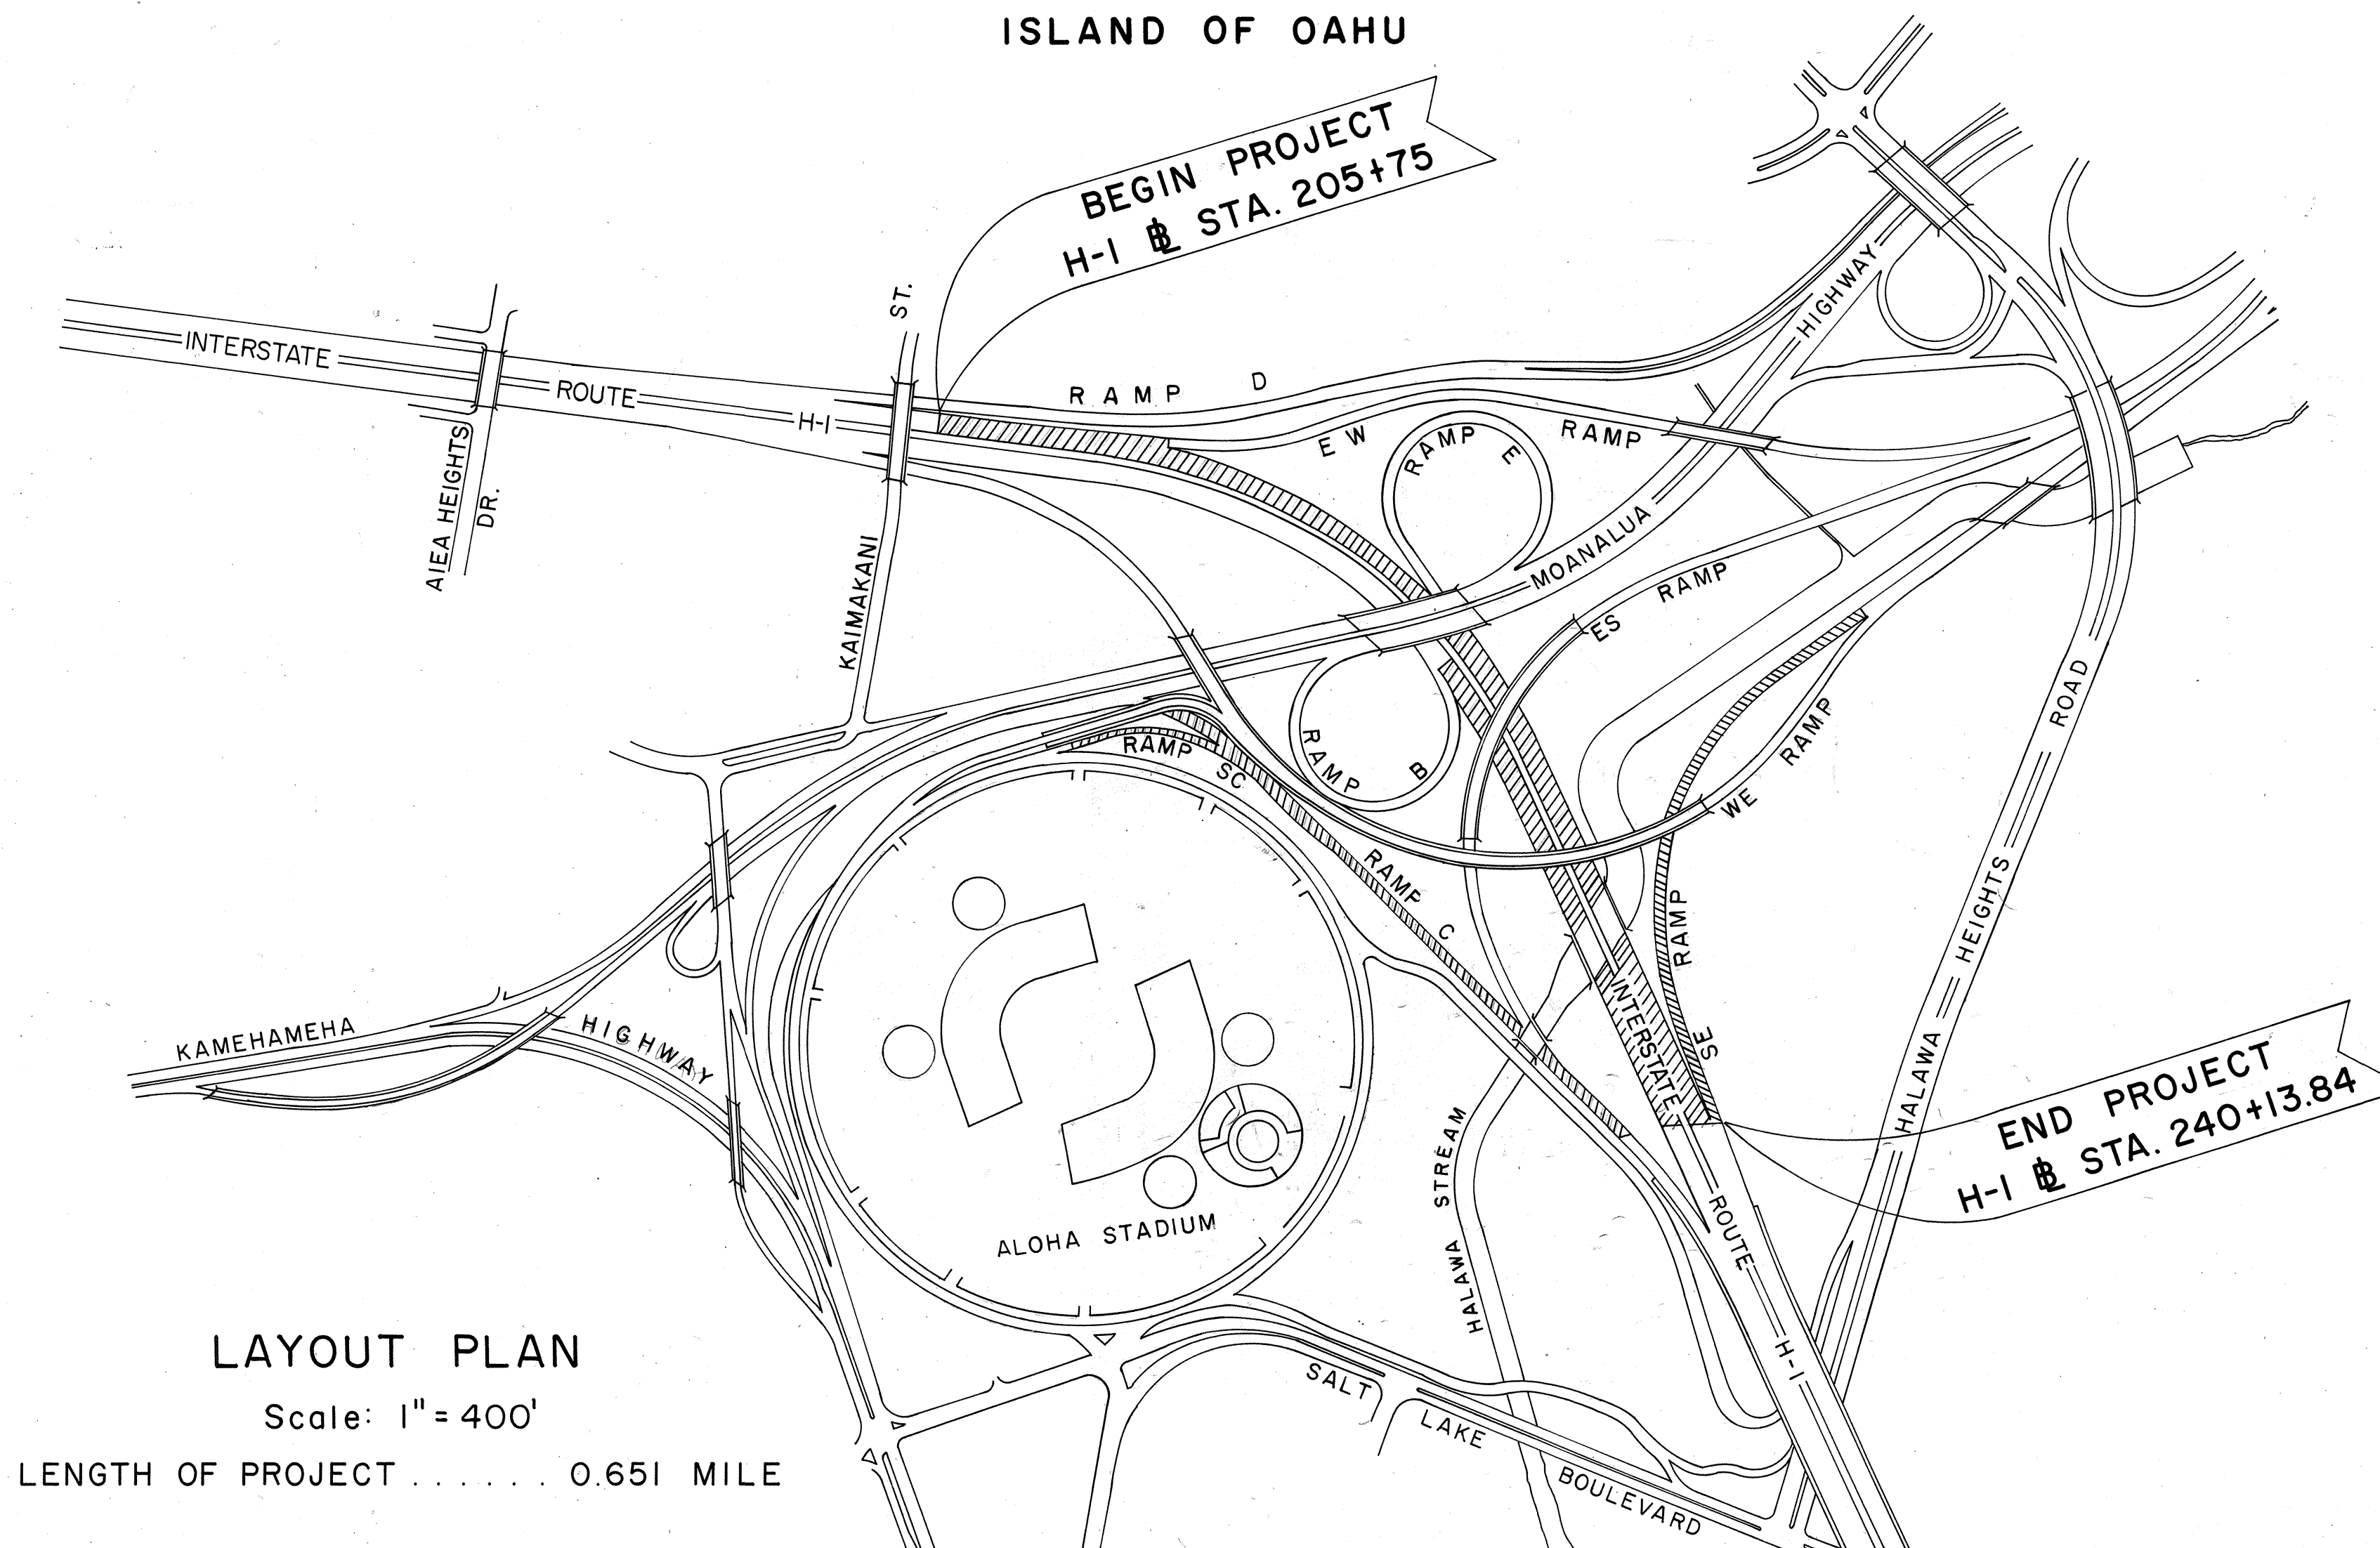

DEPARTMENT OF TRANSPORTATION FEDERAL HIGHWAY ADMINISTRATION	
APPROVED:	7-7-76
<i>[Signature]</i> DIVISION ADMINISTRATOR	DATE

DEPARTMENT OF TRANSPORTATION STATE OF HAWAII	
APPROVED:	7/1/76
<i>R. Higashionna</i> DIR. OF TRANSPORTATION	DATE

DESIGN UNIT "E" DESIGNED BY
D. BEVIER P.S. & E. BY
548-7537 PHONE
May, 1976 DATE