



FED. ROAD DIST. NO.	STATE	FED. AID PROJ. NO.	FISCAL YEAR	SHEET NO.	TOTAL SHEETS
HAWAII	HAW.	H-1EF-01-06MR	2009	ADD. 6	40

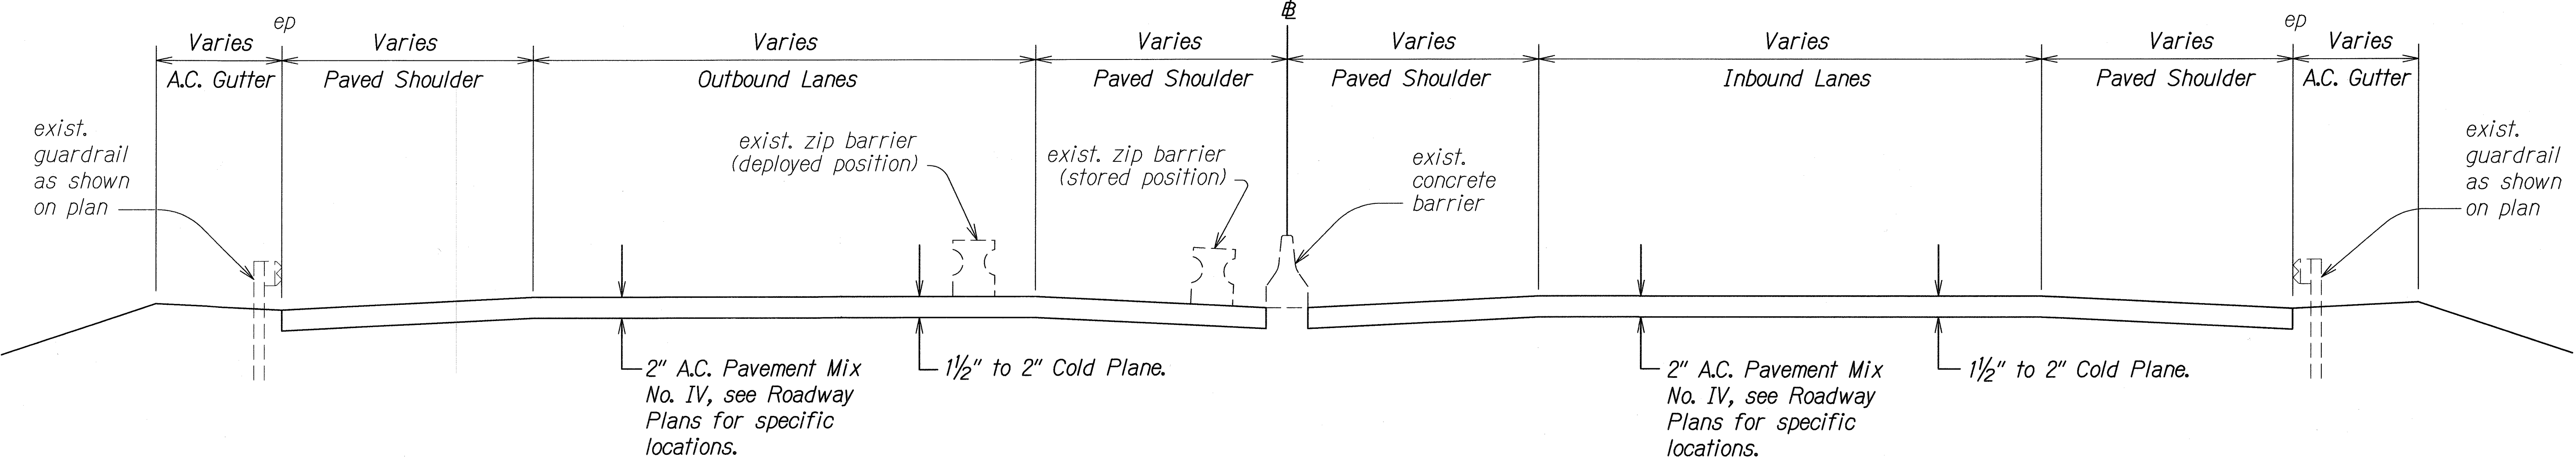

TYPICAL ROADWAY SECTION


Scale: Not to Scale

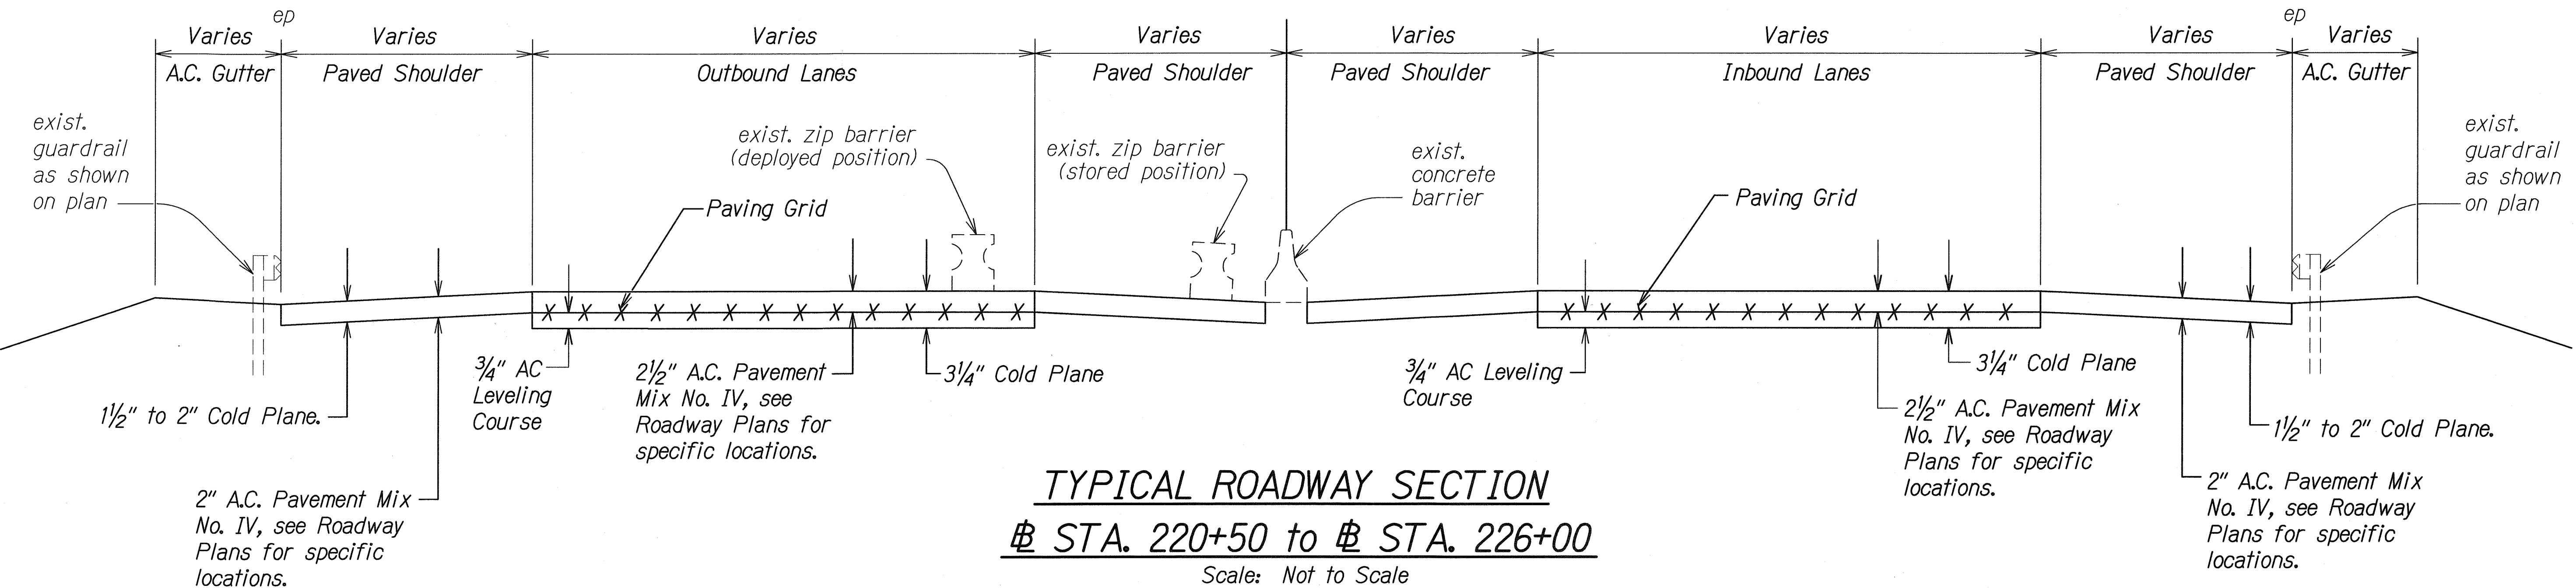

TYPICAL ROADWAY SECTION

STA. 220+50 to STA. 226+00

Scale: Not to Scale

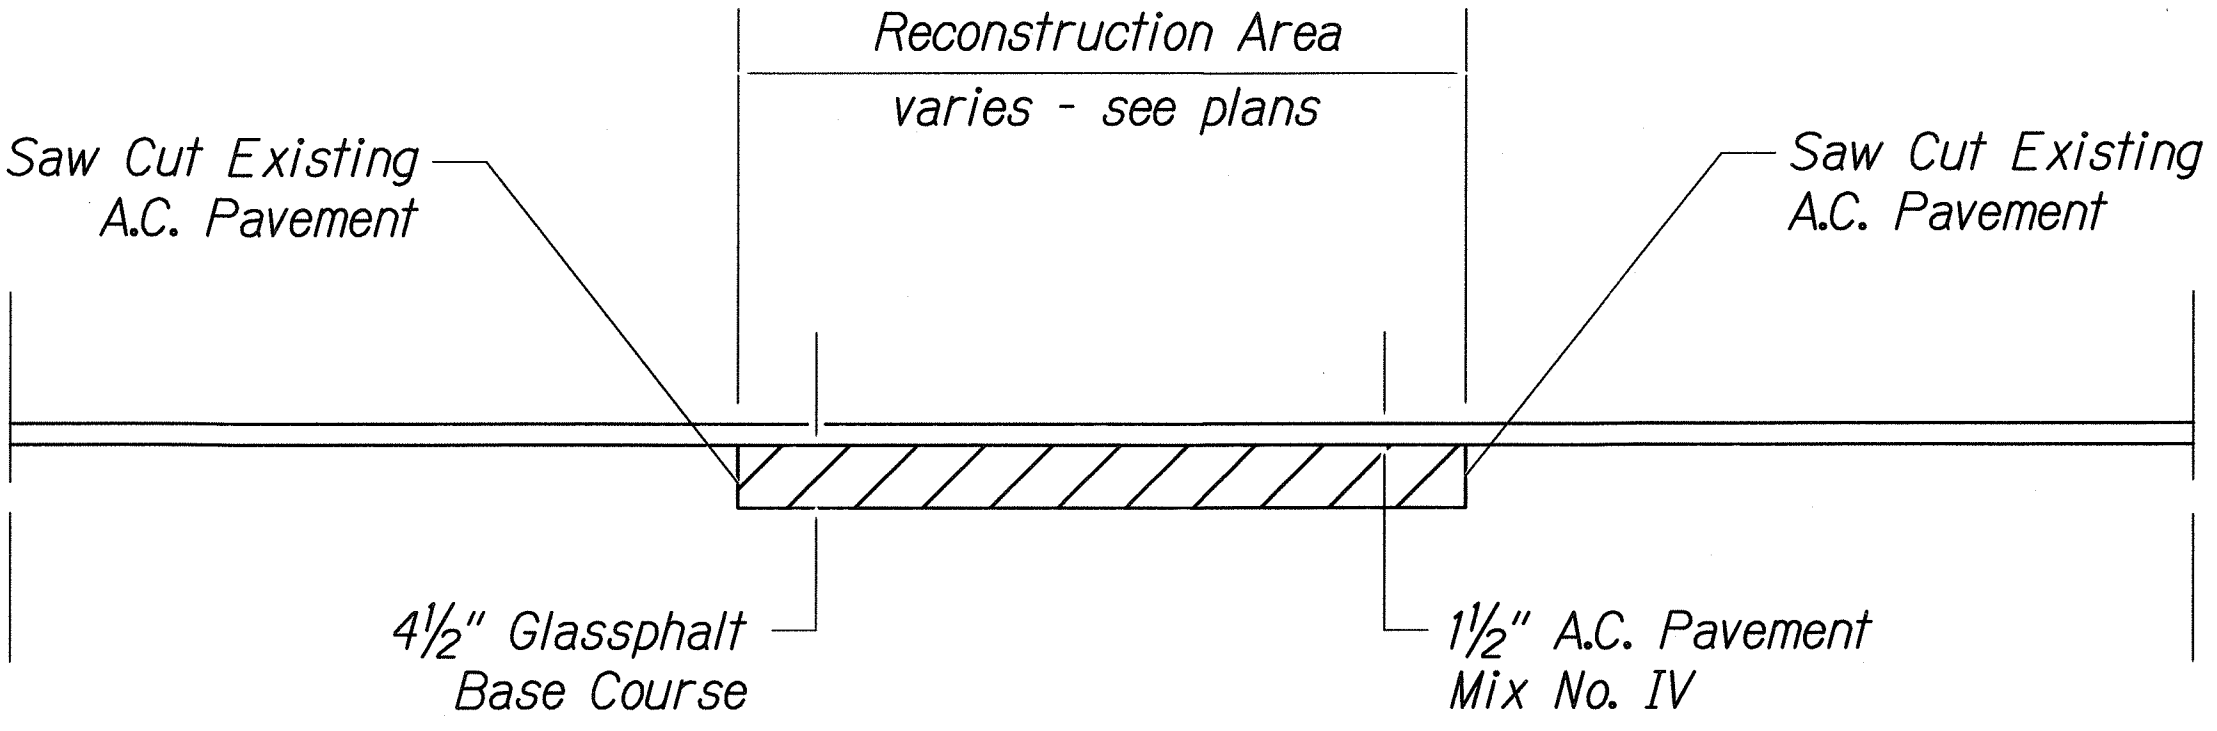


TYPICAL RECONSTRUCTION AREA



Scale: Not to Scale

4/14/09	Revised Typical Roadway Section Sta. 220+00 to Sta. 232+00.
DATE	REVISION
STATE OF HAWAII DEPARTMENT OF TRANSPORTATION HIGHWAYS DIVISION TYPICAL SECTIONS INTERSTATE ROUTE H-1 RESURFACING Kaimakani Street to Salt Lake Viaduct Project No. H-1EF-01-06MR Scale: NTS Date: November, 2008 SHEET No. 1 OF 1 SHEETS	

FED. ROAD DIST. NO.	STATE	FED. AID PROJ. NO.	FISCAL YEAR	SHEET NO.	TOTAL SHEETS
HAWAII	HAW.	H-1EF-01-06MR	2009	ADD. 7	40

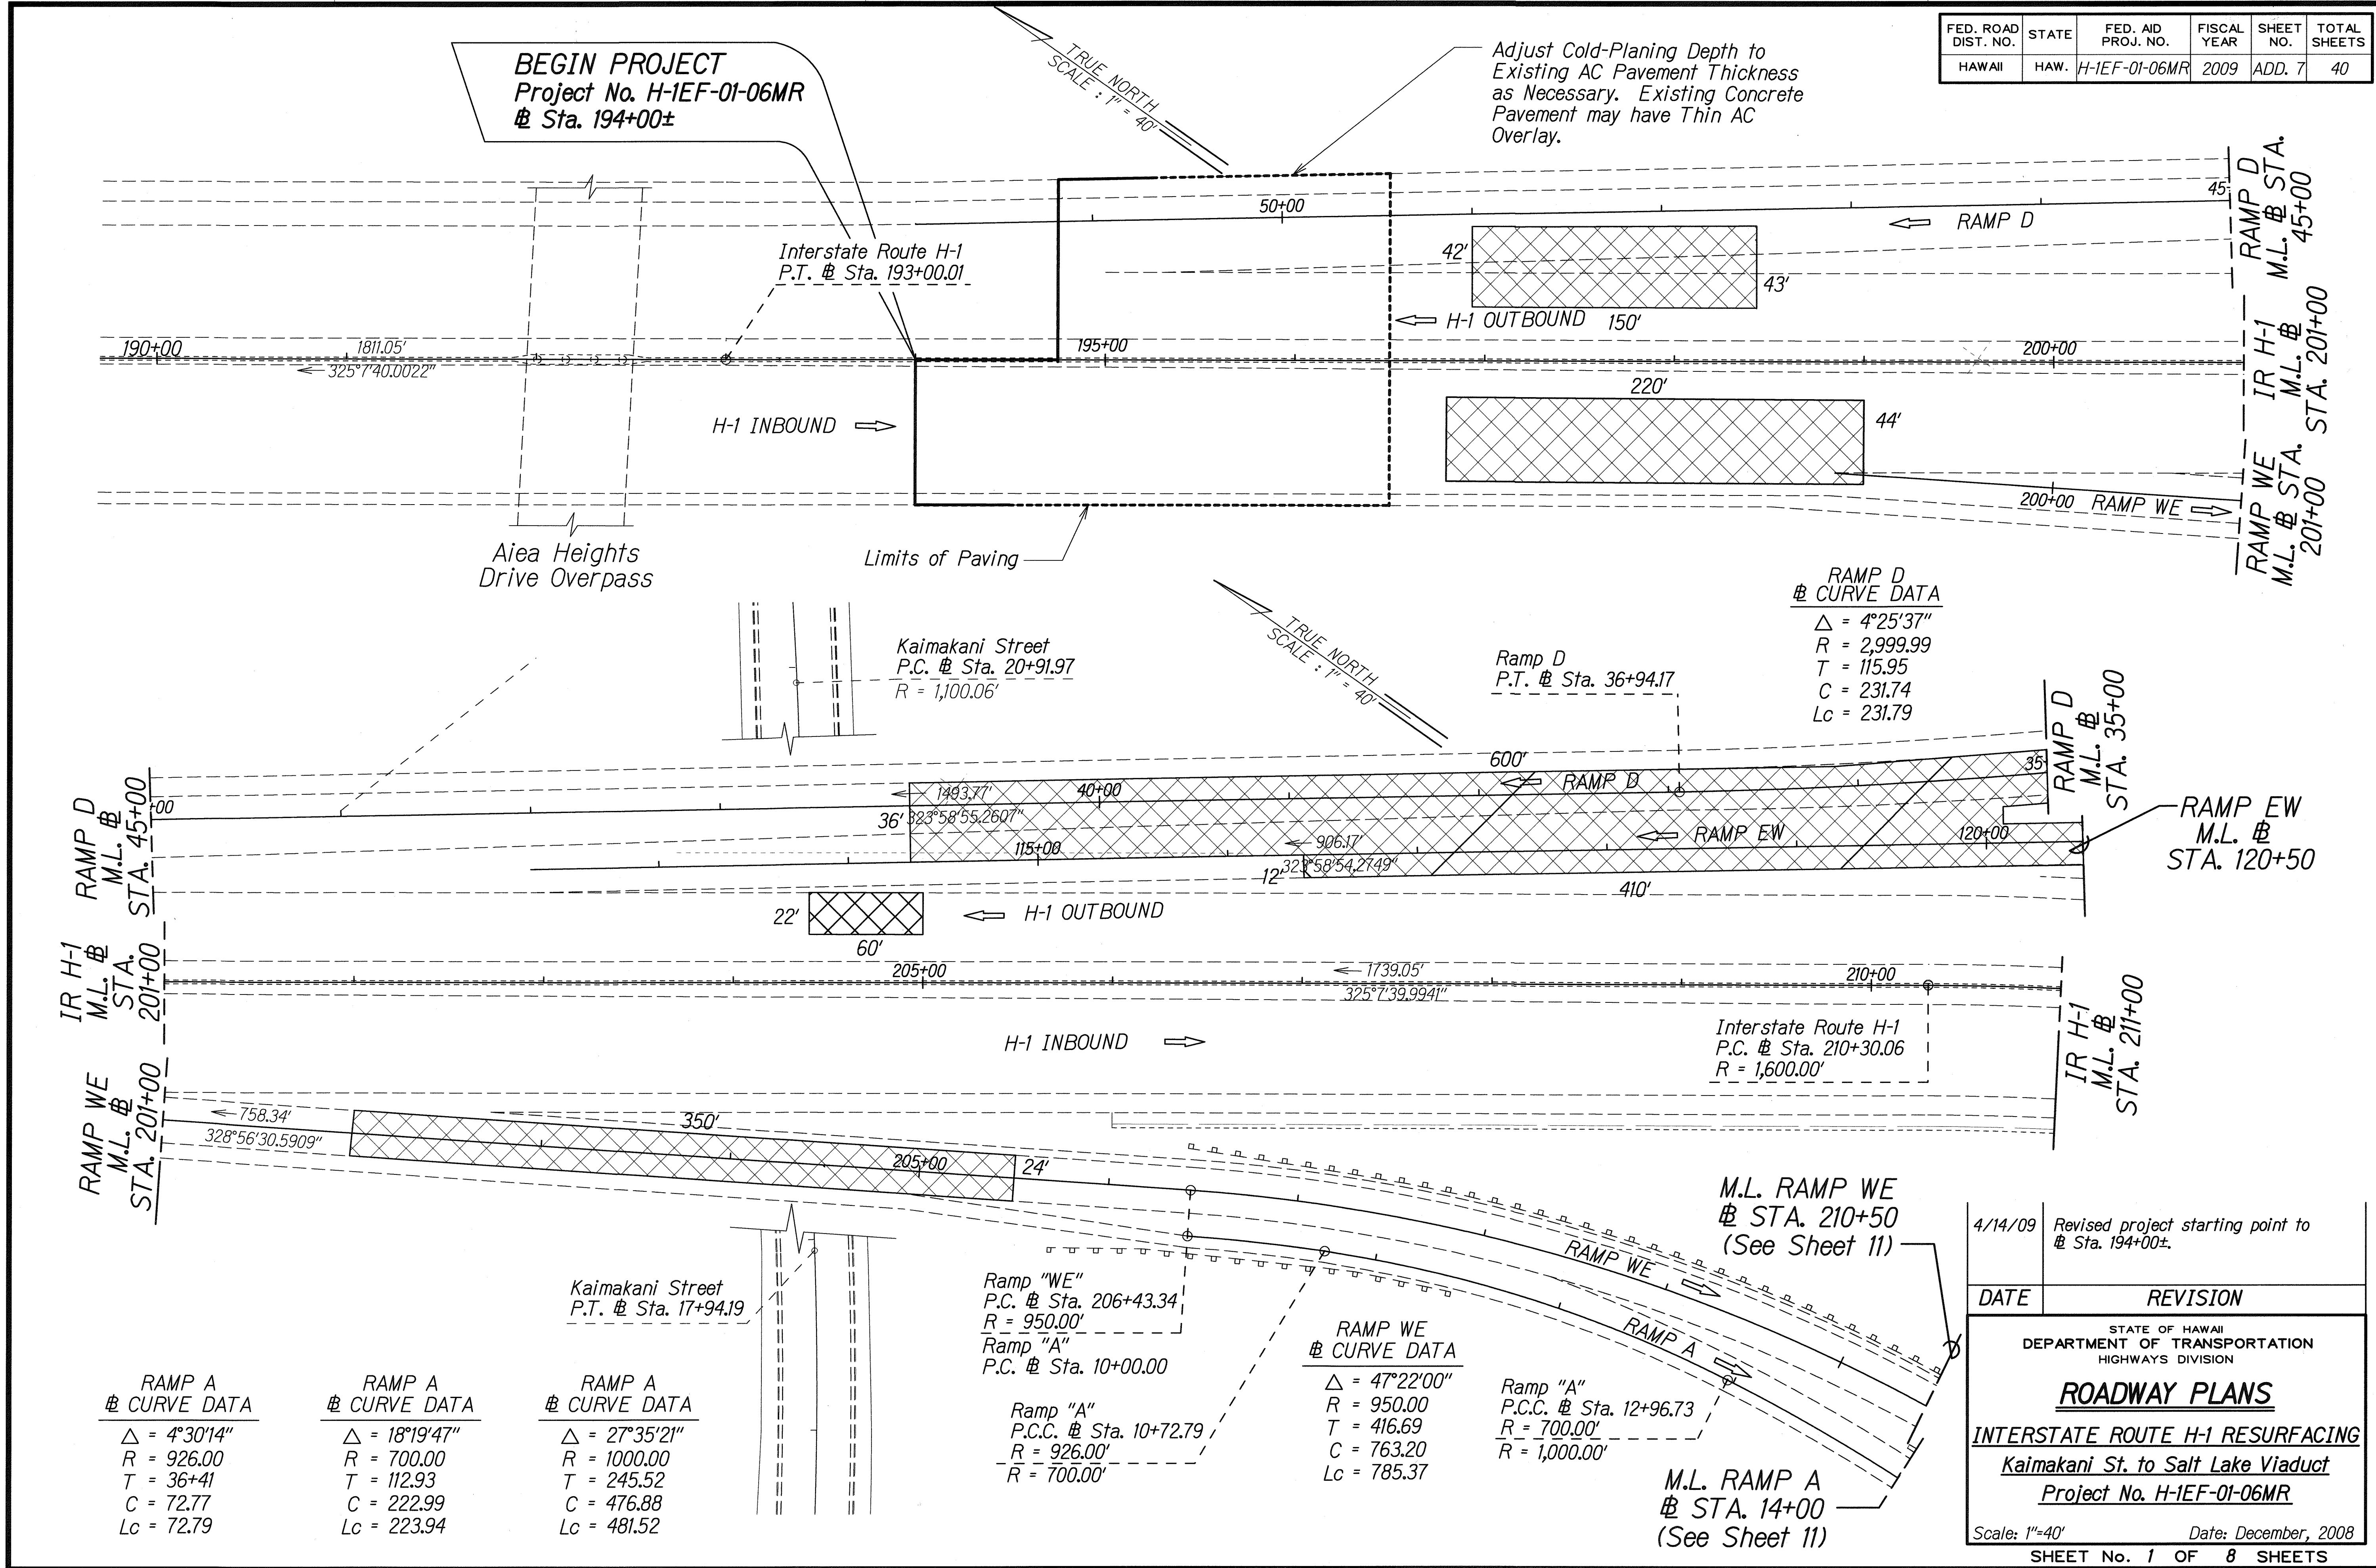

FED. ROAD DIST. NO.	STATE	PROJ. NO.	FISCAL YEAR	SHEET NO.	TOTAL SHEETS
HAWAII	HAW.	H-1EF-01-06MR	2009	ADD.17	40

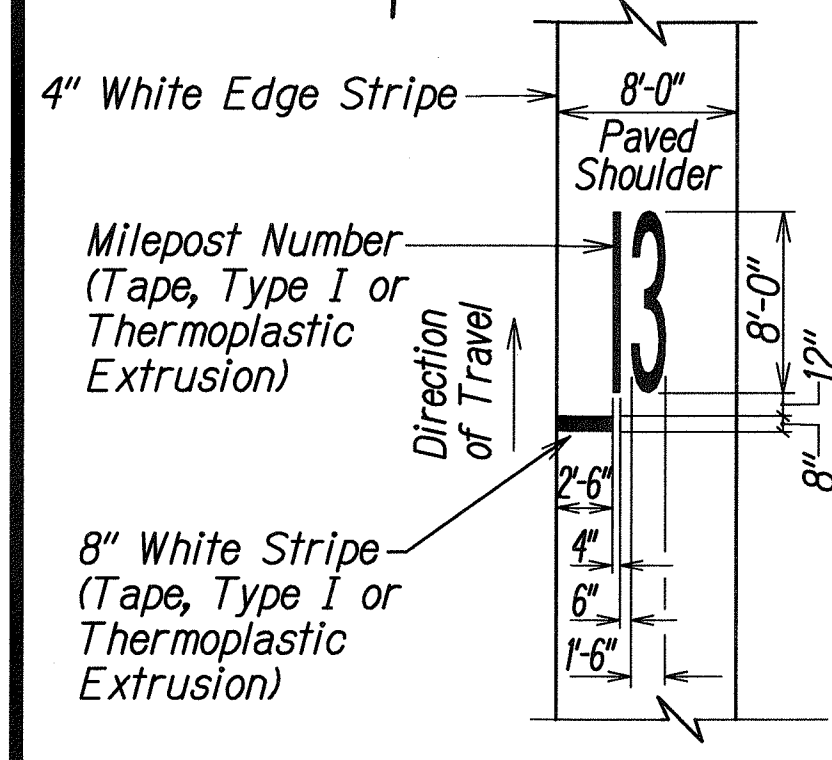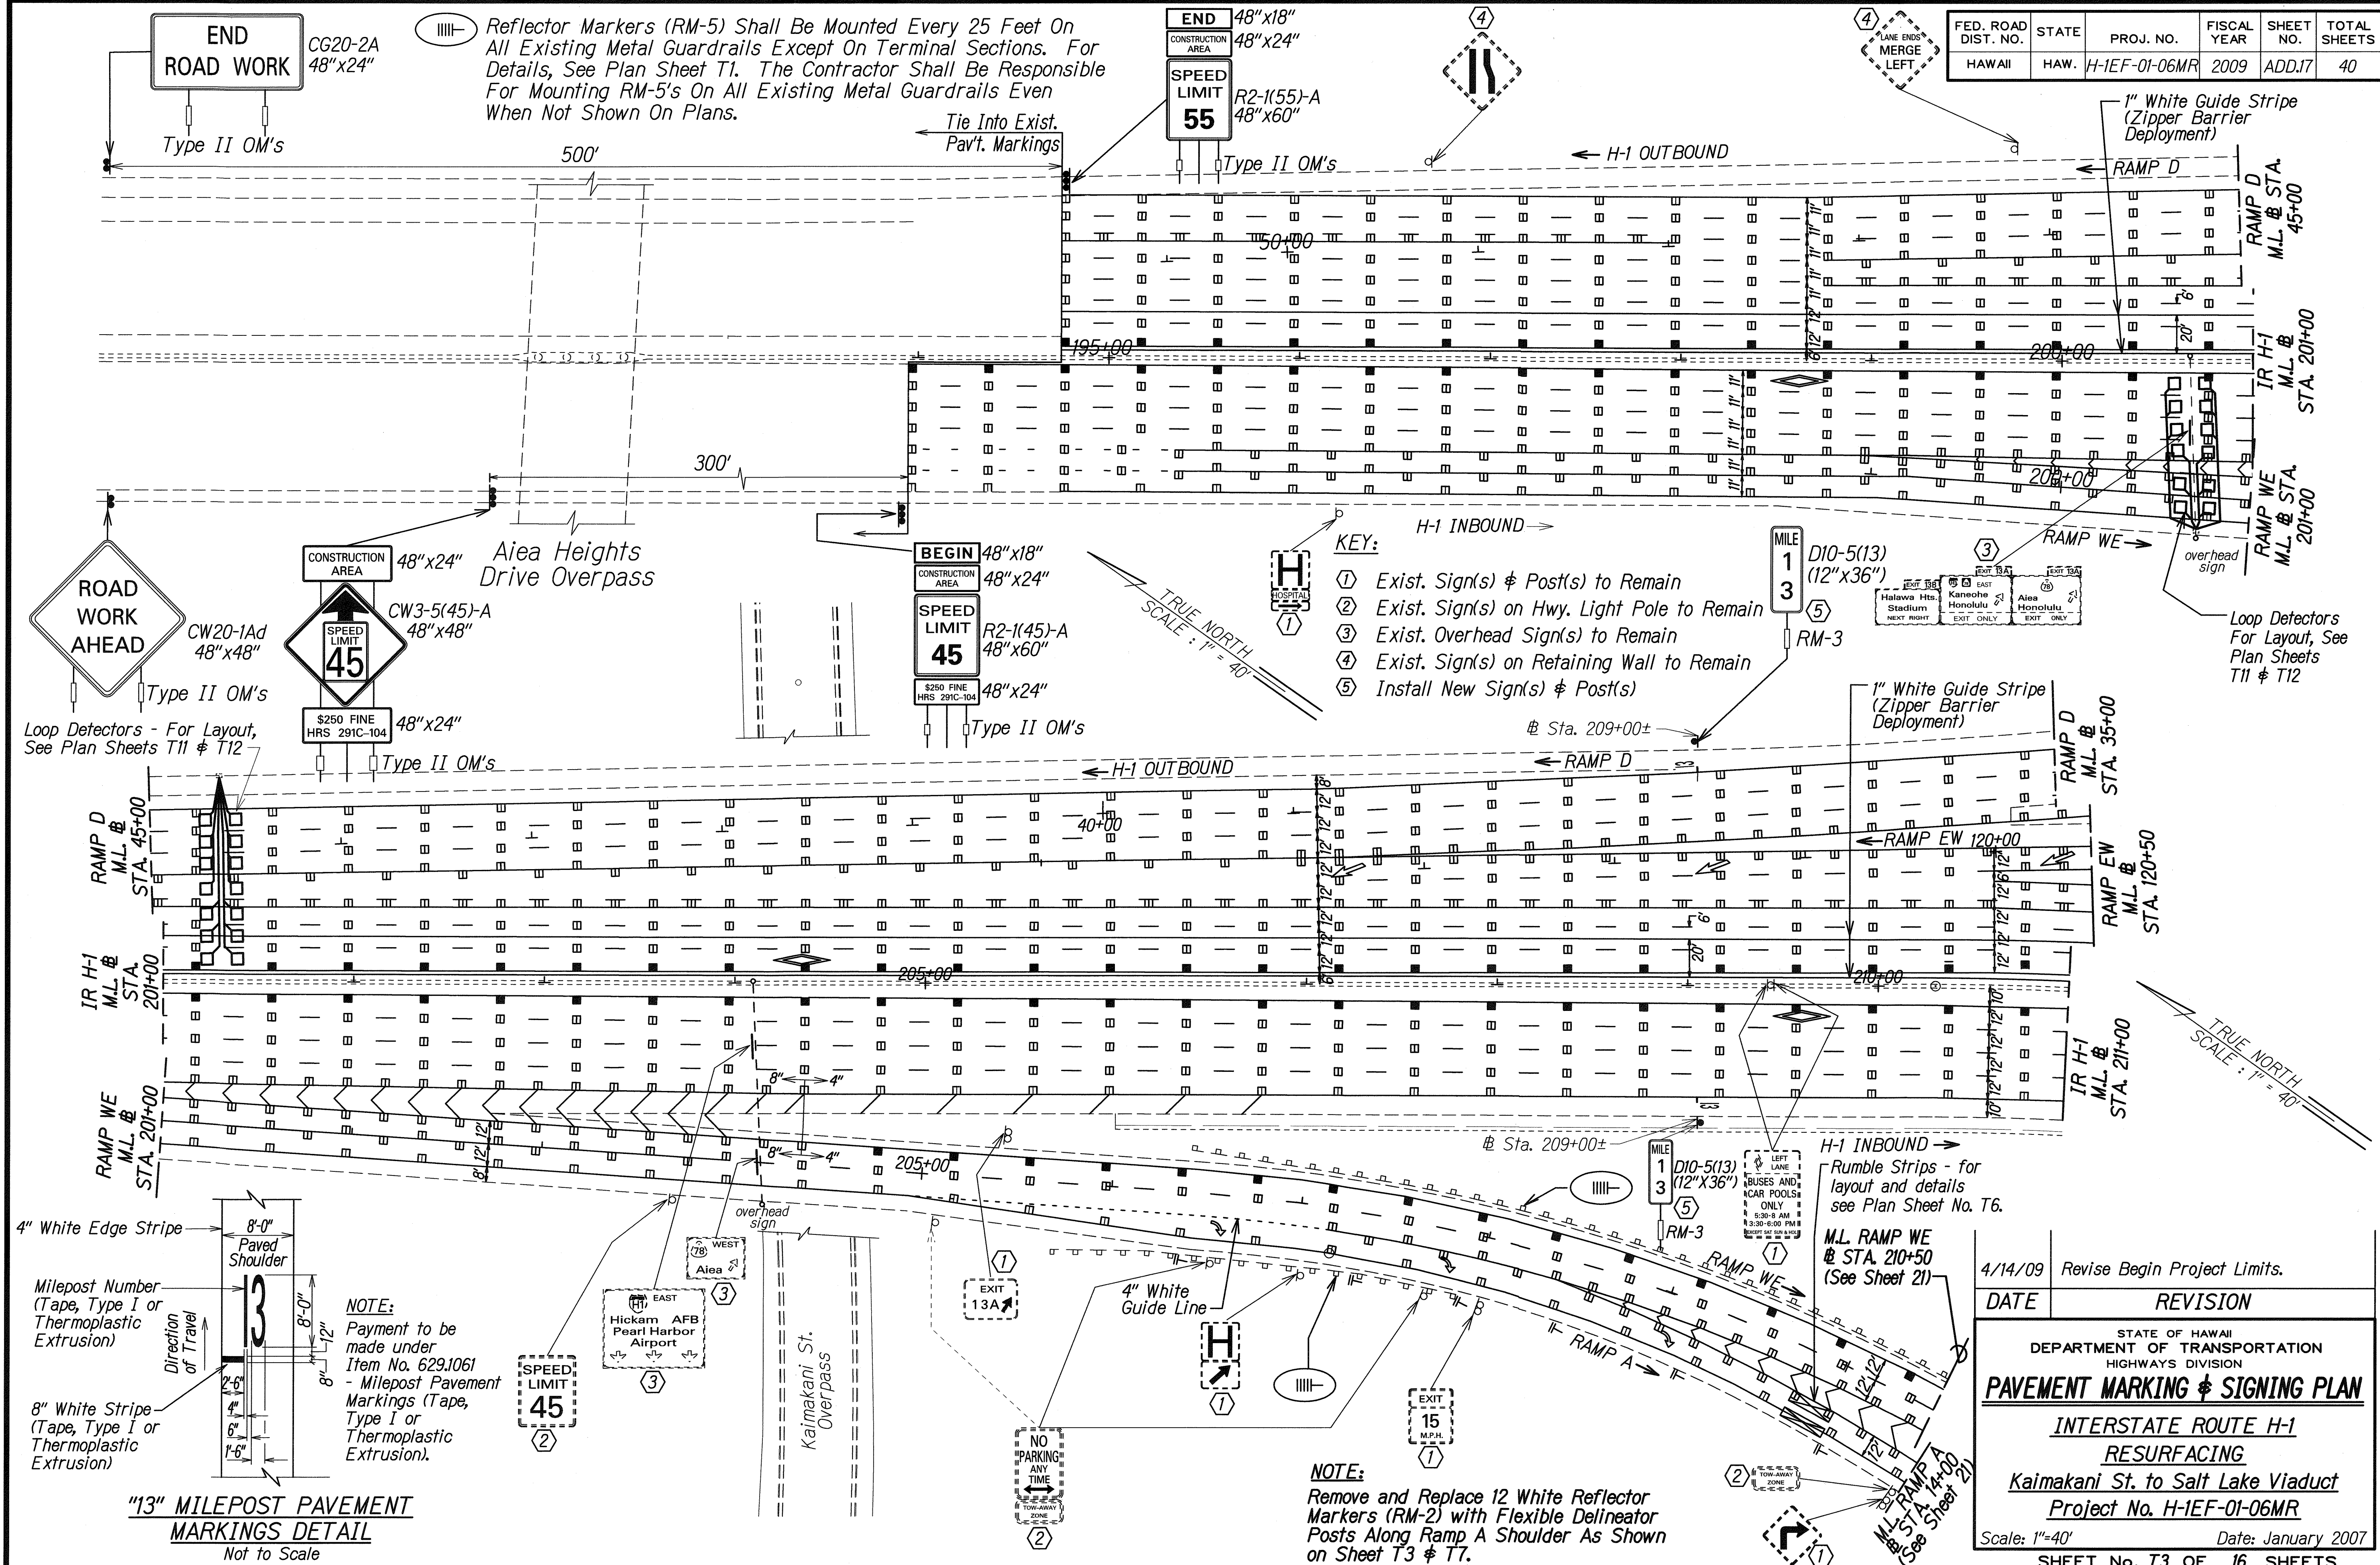

"13" MILEPOST PAVEMENT MARKINGS DETAIL
Not to Scale

4/14/09	Revise Begin Project Limits.
DATE	REVISION
STATE OF HAWAII DEPARTMENT OF TRANSPORTATION HIGHWAYS DIVISION	
PAVEMENT MARKING & SIGNING PLAN	
INTERSTATE ROUTE H-1	
RESURFACING	
Kaimakani St. to Salt Lake Viaduct	
Project No. H-1EF-01-06MR	
Scale: 1"=40'	Date: January 2007
SHEET No. T3 OF 16 SHEETS	