



FED. ROAD DIST. NO.	STATE	PROJ. NO.	FISCAL YEAR	SHEET NO.	TOTAL SHEETS
HAWAII	HAW.	H-IEF-01-06MR	2009	16	40

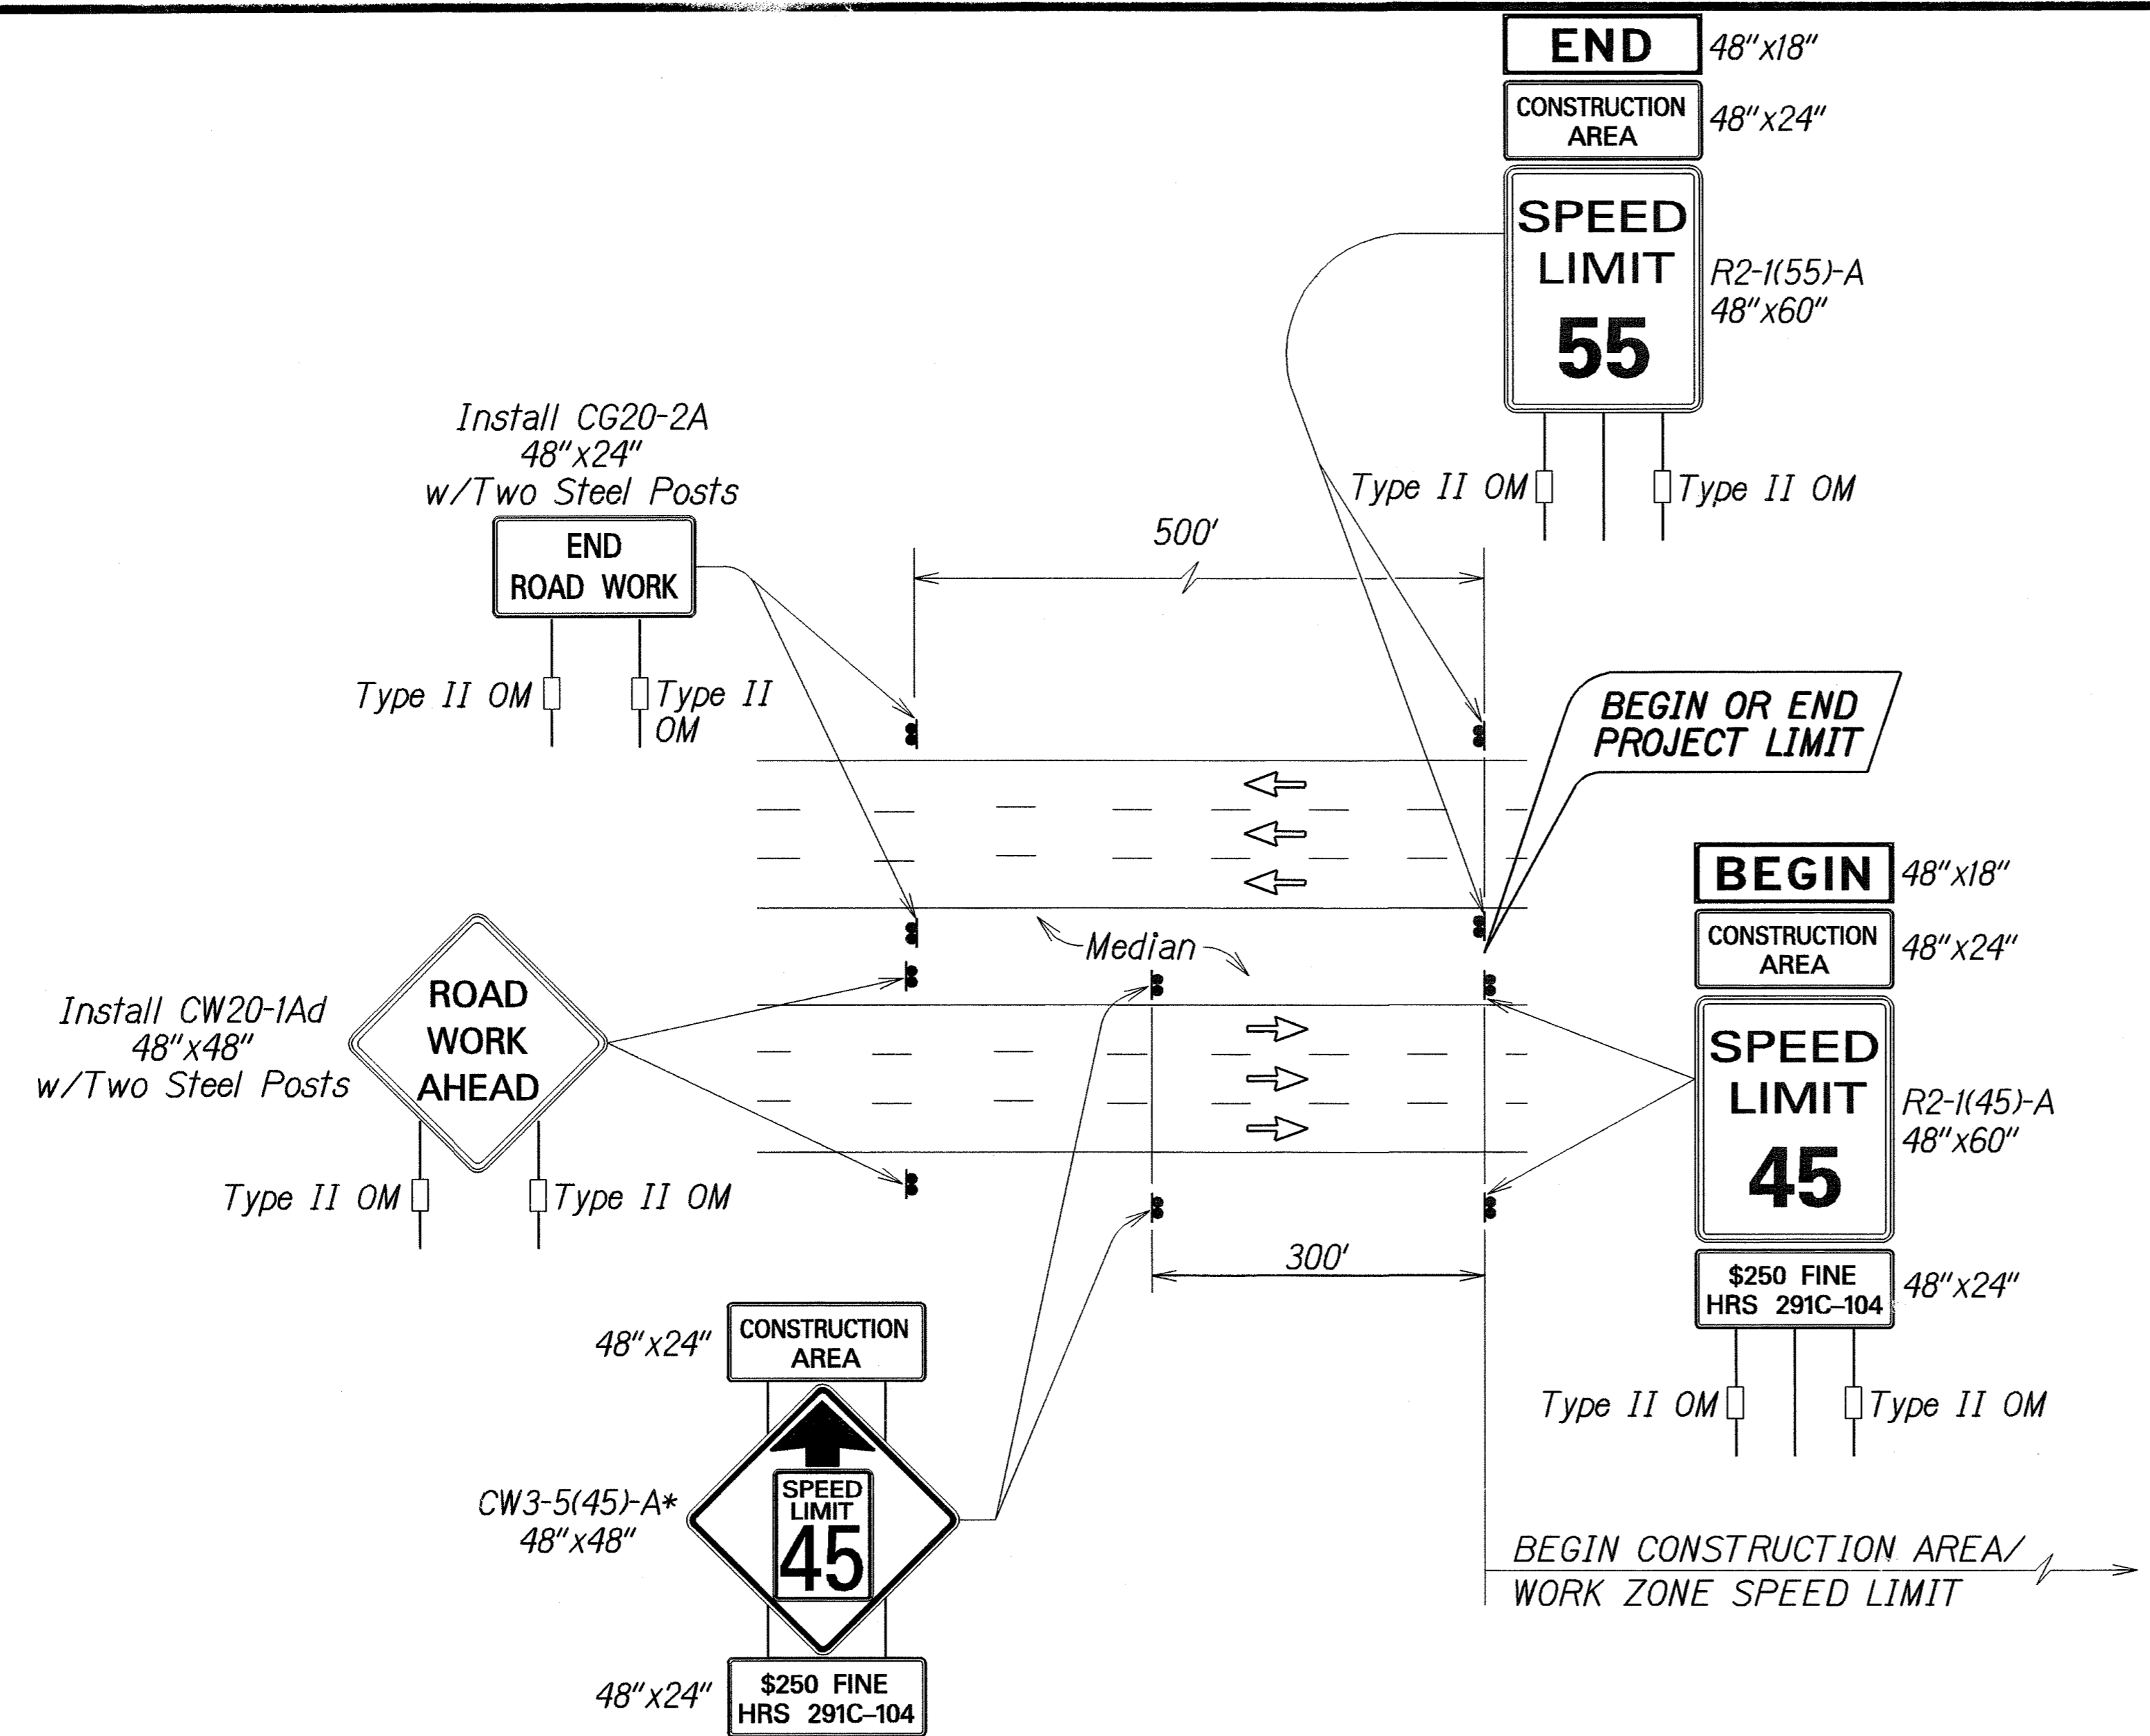


*Note:
 Legend: Black
 Background: Orange
 Speed Limit: Black on White


TYPICAL DETAIL FOR CONSTRUCTION SIGNS
 ON FREEWAY

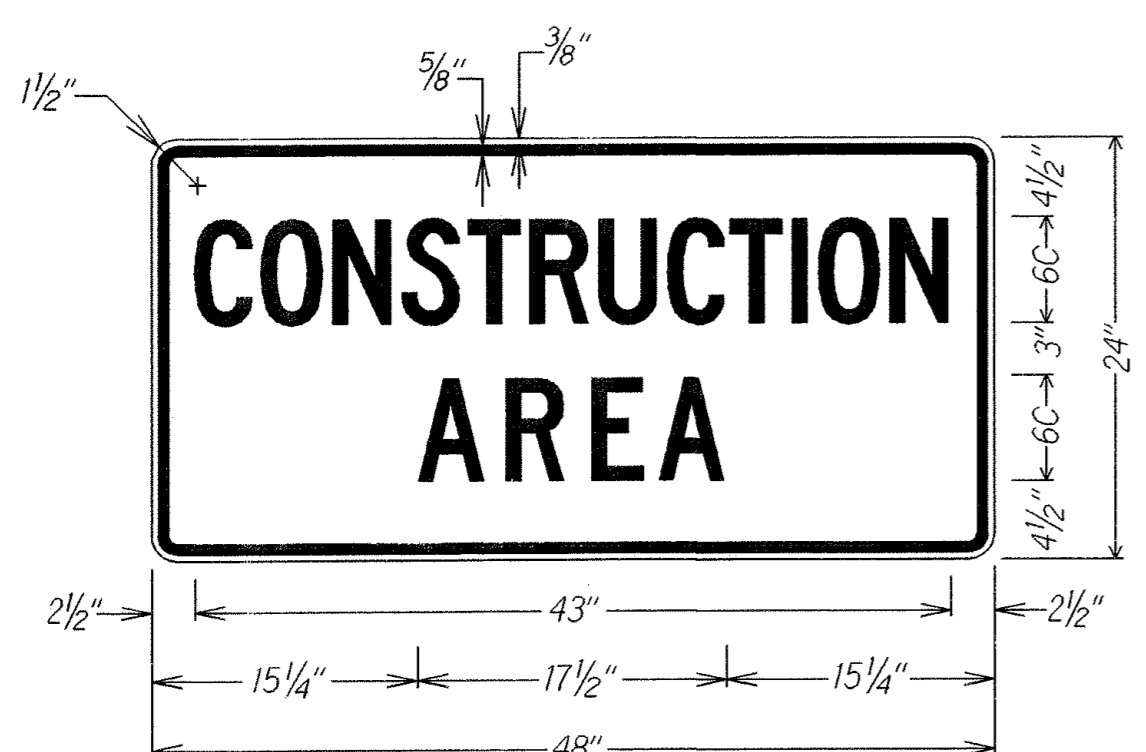


LEGEND: BLACK
 BACKGROUND: ORANGE

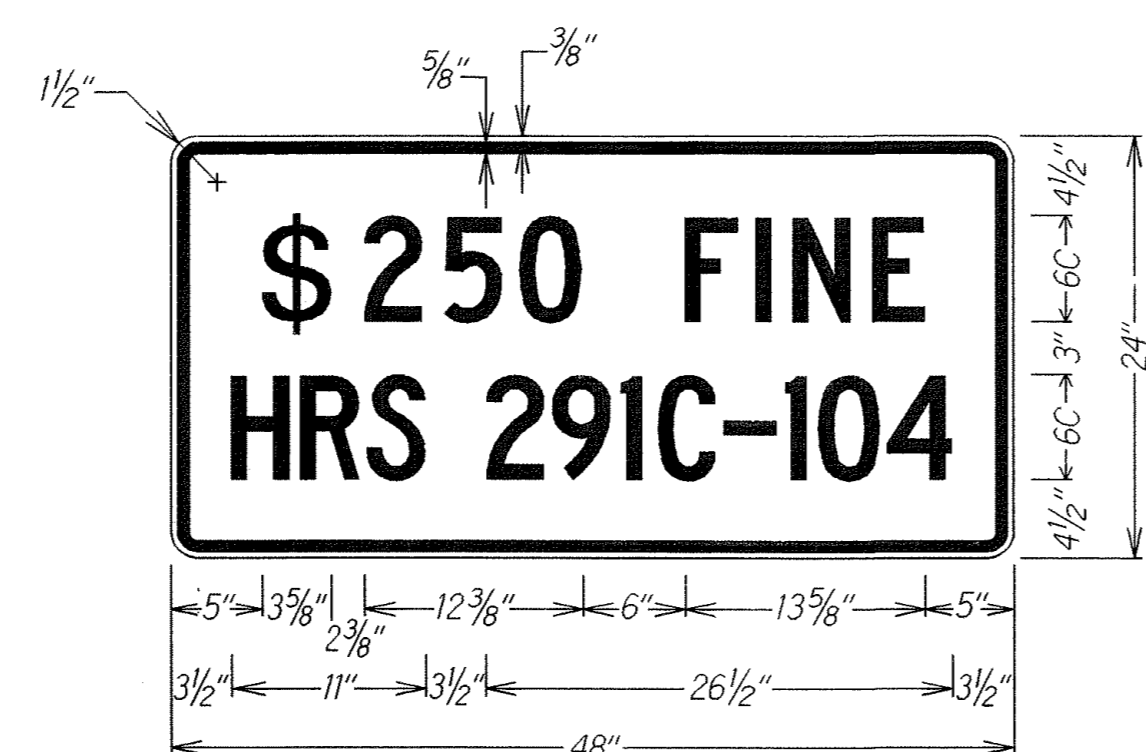

LEGEND: BLACK
 BACKGROUND: WHITE

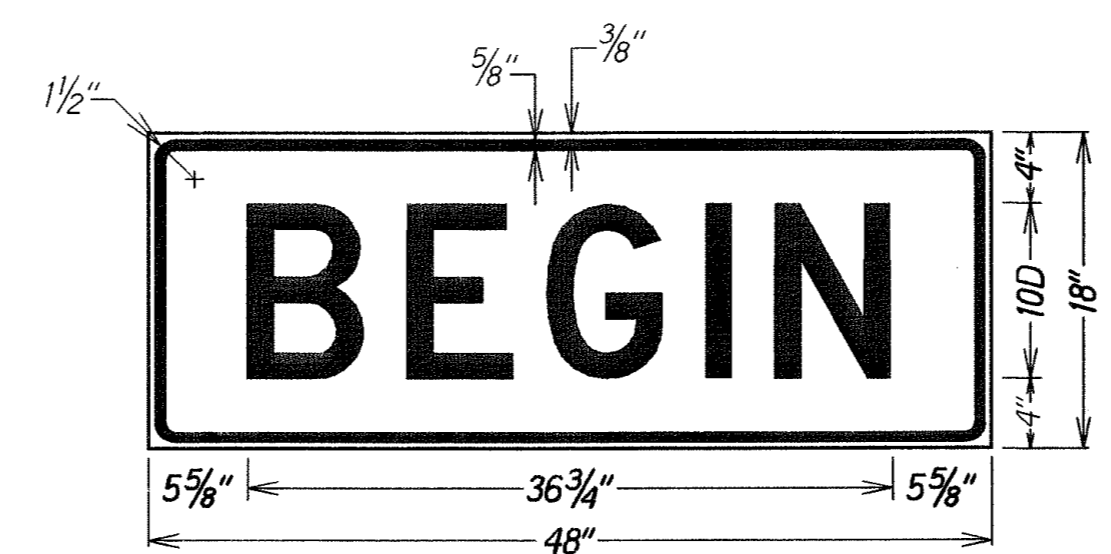

LEGEND: BLACK
 BACKGROUND: ORANGE

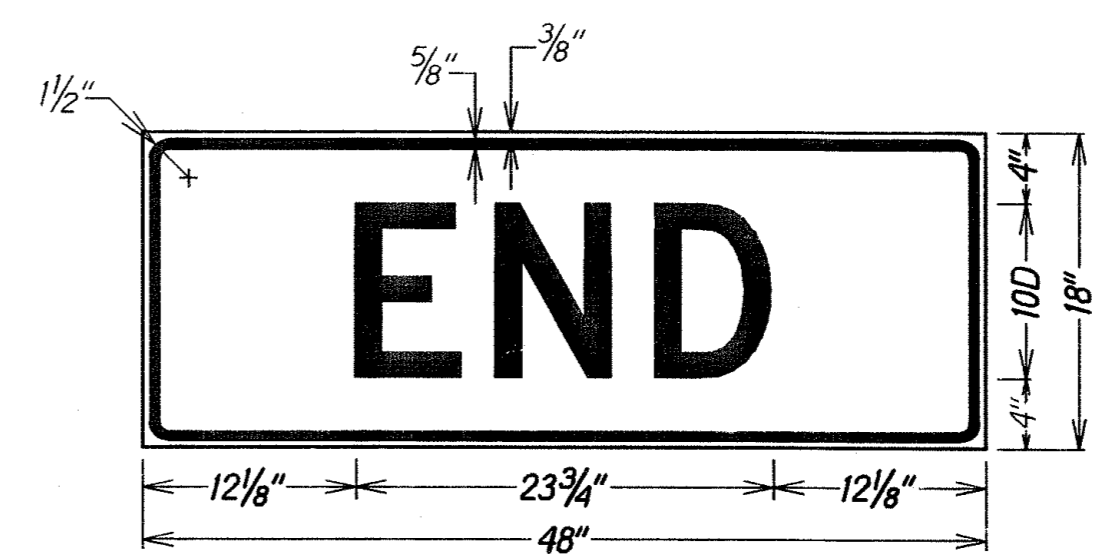

LEGEND: BLACK
 BACKGROUND: ORANGE

Work Zone Notes:


1. This Work Zone Sign Plan is intended for use on long-term stationary work zones/ construction phases (3 Days or more). All work zones or construction phases less than 3 days duration will use Traffic Control Plans shown in Section 645 of the Special Provisions.
2. The Contractor shall erect at the beginning of the project and at the end of the project advance construction warning signs placed as indicated on the plans or as directed by the Engineer for the duration of the freeway project and shall be maintained by the Contractor. These signs shall be placed in addition to the required traffic control signs called for in Section 645 - Traffic Control. The advance construction warning signs shall be new and become the property of the State. The Contractor shall remove, clean and deliver the signs and posts to the District Baseyard, or as directed by the Engineer, upon the completion of the project.
3. All existing regulatory speed limit signs within the work zone/project limits shall be covered and work zone speed limit sign assemblies (R2-1(45)-A and CW3-5(45)-A with "CONSTRUCTION AREA" and "\$250 FINE HRS 291C-104" Supplemental Signs) shall be displayed during lane closure hours.
4. Upon the removal of the lane closure, all work zone speed limit signs shall be covered and existing speed limit signs within the work zone/project limits shall be restored.
5. Construction signs shall be installed on both the approaching and trailing ends of each work zone.
6. Each construction sign shall have a minimum of two (2) Type II OM. Installation of each Type II OM shall be considered incidental to Item No. 645.1000 - Traffic Control.
7. All work zone speed sign assembly shall be mounted on three (3) 4.00 lbs./ft. galvanized flanged channel sign posts with a sign clearance height of five (5) feet. Sign stiffeners as specified by Standard Plan Sheet TE-02 shall be installed as needed or as directed by the Engineer.
8. The daily covering and uncovering of existing regulatory speed limit signs along with the installation, maintenance, removal and daily covering and uncovering of work zone speed limit sign assemblies shall be considered incidental to Item No. 645.1000 - Traffic Control.

SURVEY PLOTTED BY	DATE
DRAWN BY	
DESIGNED BY	
QUANTITIES BY	
CHECKED BY	
ORIGINAL PLAN	
NOTE BOOK	
CONTRACT NO.	

STATE OF HAWAII
 DEPARTMENT OF TRANSPORTATION
 HIGHWAYS DIVISION
FREWAY WORK ZONE SIGNING
PLAN, NOTES & DETAILS
 INTERSTATE ROUTE H-1
 RESURFACING
 Kaimakani St. to Salt Lake Viaduct
 Project No. H-IEF-01-06MR
 Not To Scale Date: January 2007
 SHEET No. T2 OF 16 SHEETS

FED. ROAD DIST. NO.	STATE	PROJ. NO.	FISCAL YEAR	SHEET NO.	TOTAL SHEETS
HAWAII	HAW.	H-IEF-01-06MR	2009	18	40

- KEY:**
- ① Exist. Sign(s) & Post(s) to Remain
 - ② Exist. Sign(s) on Hwy. Light Pole to Remain
 - ③ Exist. Overhead Sign(s) to Remain
 - ④ Exist. Sign(s) on Retaining Wall to Remain
 - ⑥ Replace Exist. Sign(s) & Install New On Hwy Light Pole
 - ⑦ Replace Exist. Sign(s) & Install New On Exist. Post(s)
 - ⑧ Remove Exist. Sign(s) & Post(s)

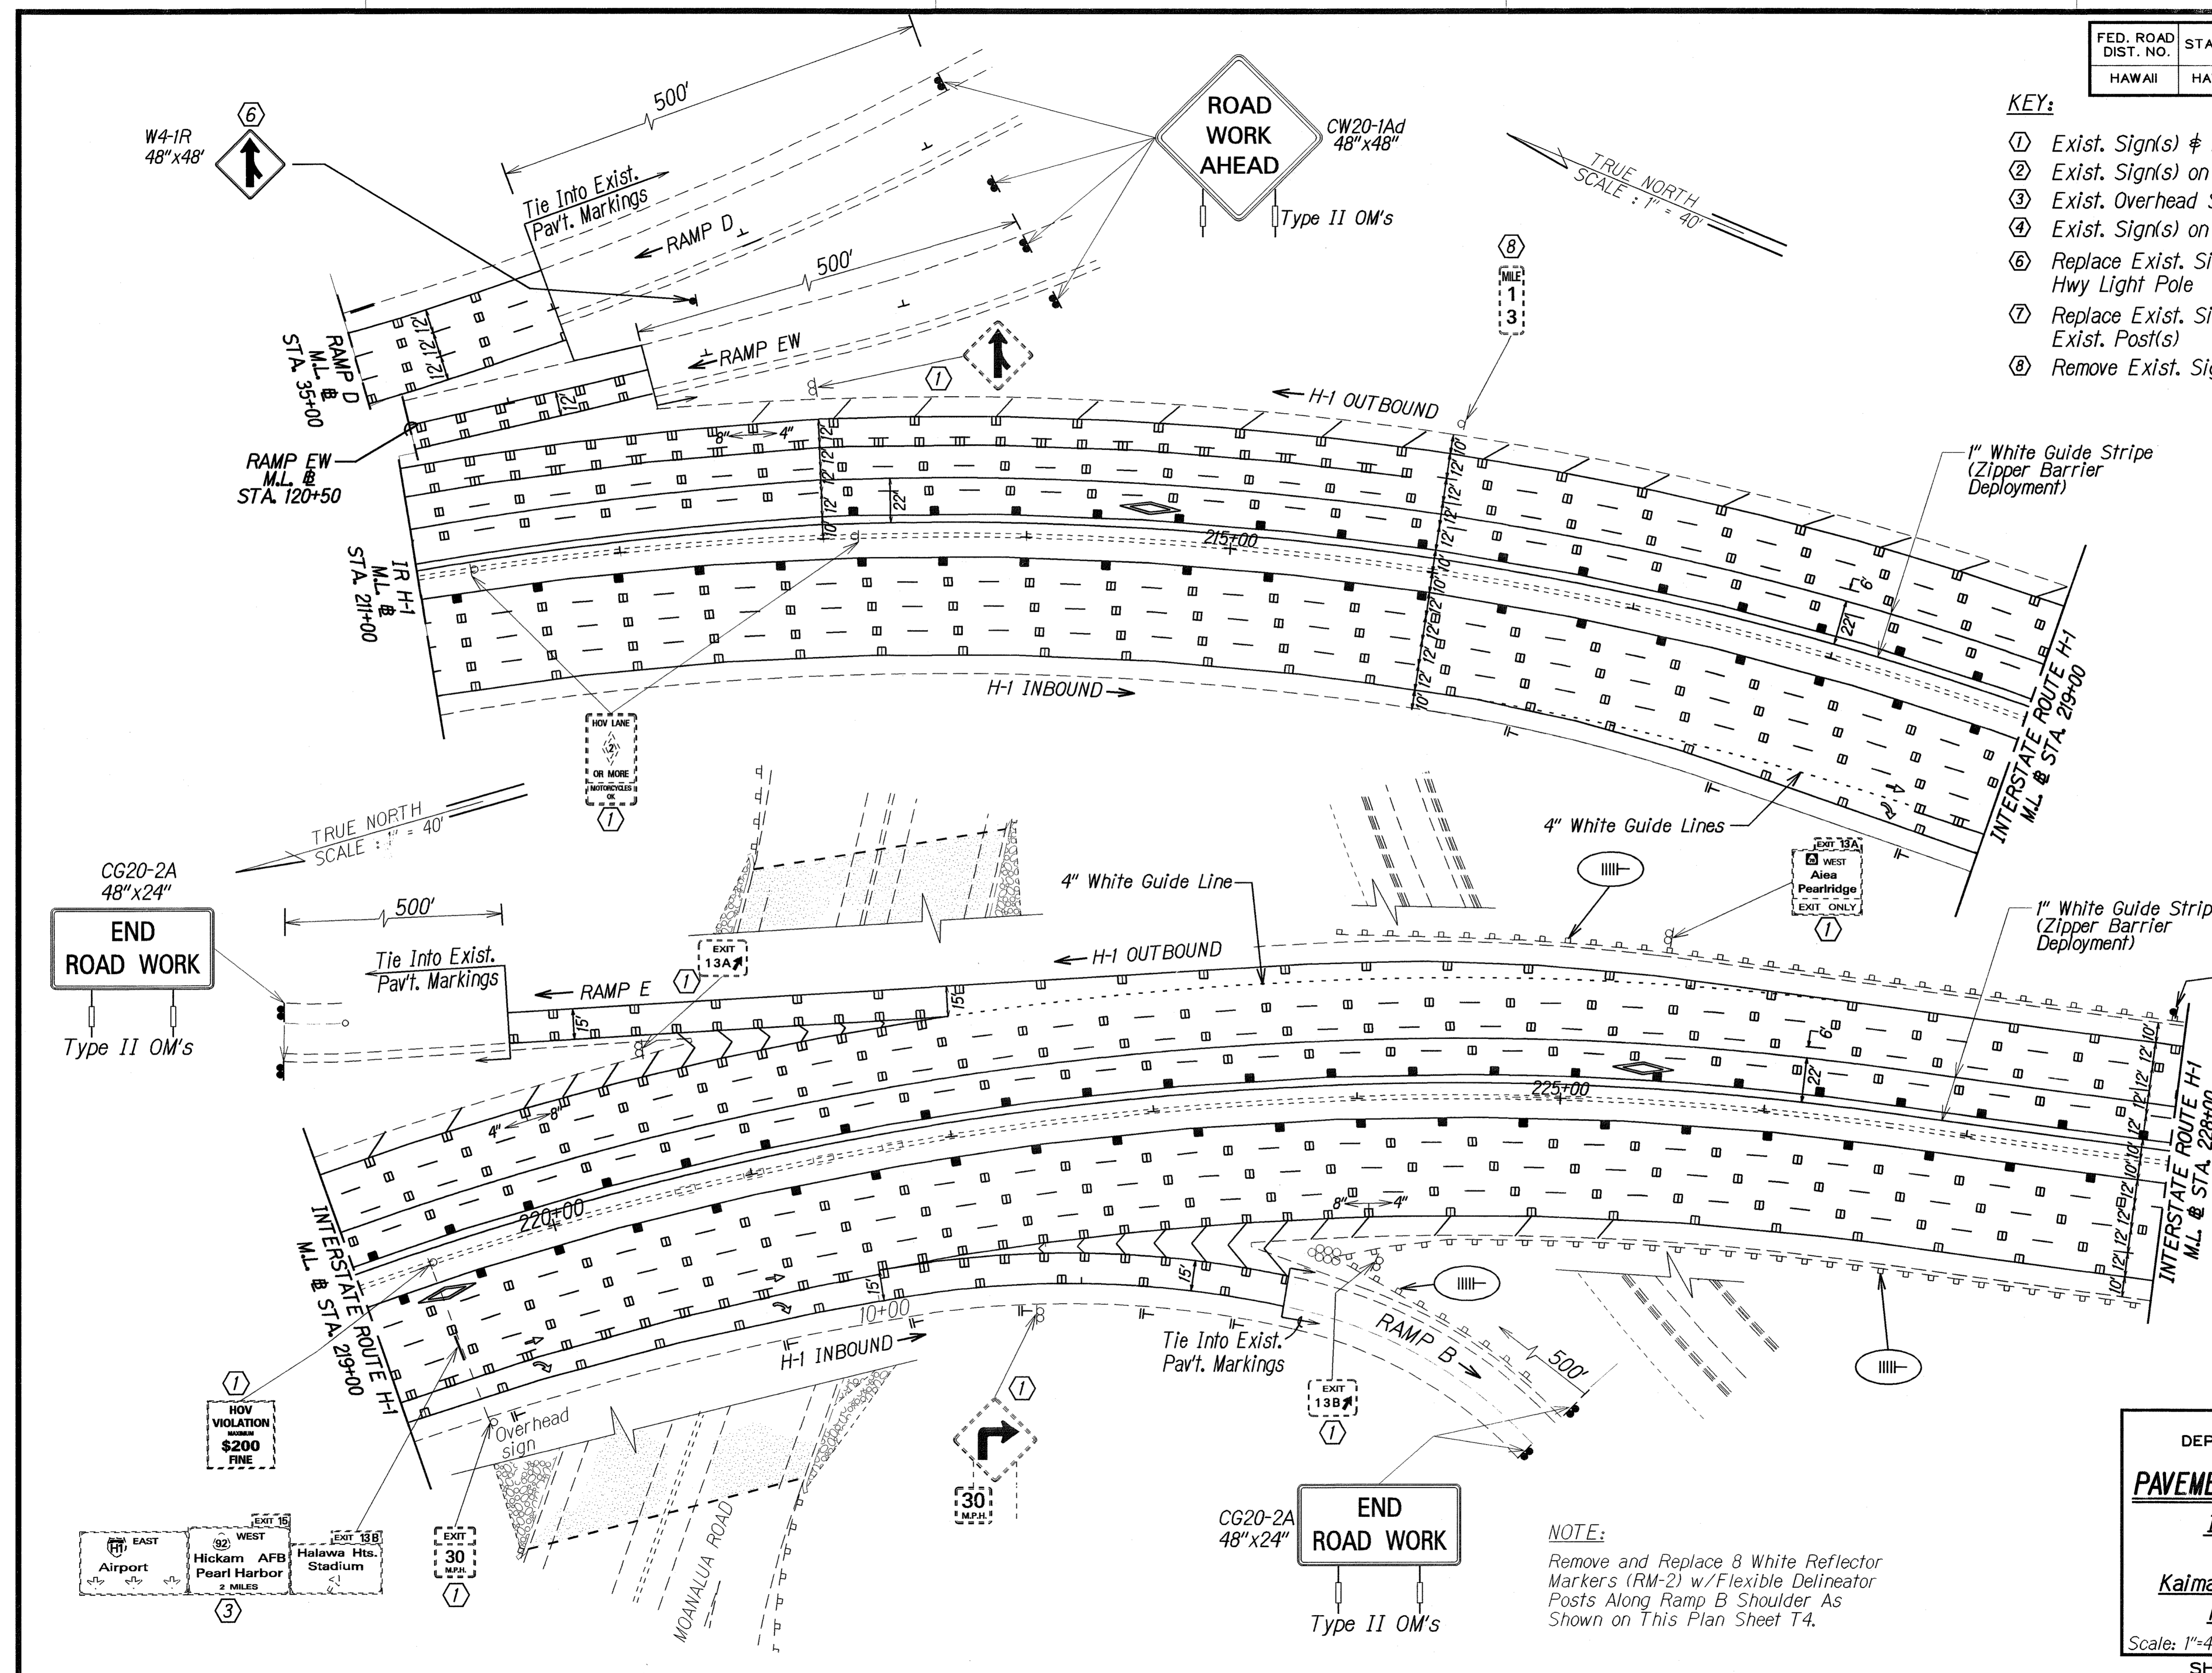

CG20-2A
48"x24"
END ROAD WORK
Type II OM's

CG20-2A
48"x24"
END ROAD WORK
Type II OM's

NOTE:
Remove and Replace 8 White Reflector Markers (RM-2) w/Flexible Delineator Posts Along Ramp B Shoulder As Shown on This Plan Sheet T4.

STATE OF HAWAII
DEPARTMENT OF TRANSPORTATION
HIGHWAYS DIVISION

PAVEMENT MARKING & SIGNING PLAN

**INTERSTATE ROUTE H-1
RESURFACING**

Kaimakani St. to Salt Lake Viaduct



Project No. H-IEF-01-06MR

Scale: 1"=40' Date: January 2007

SHEET No. 14 OF 16 SHEETS

SURVEY PLOTTED BY	DATE
DRAWN BY	
DESIGNED BY	
QUANTITIES BY	
CHECKED BY	
ORIGINAL PLAN	
NOTE BOOK	
DATE	
CHECKED BY	

FED. ROAD DIST. NO.	STATE	PROJ. NO.	FISCAL YEAR	SHEET NO.	TOTAL SHEETS
HAWAII	HAW.	H-IEF-01-06MR	2009	19	40

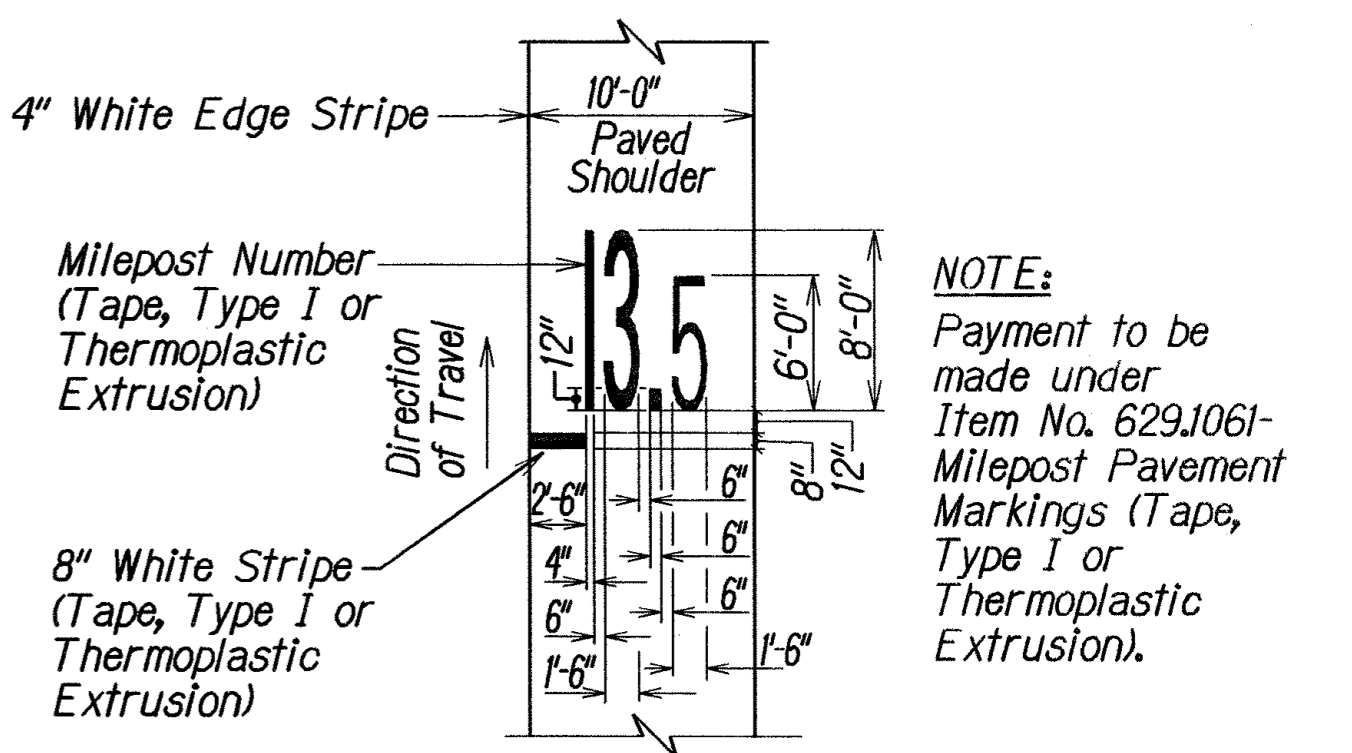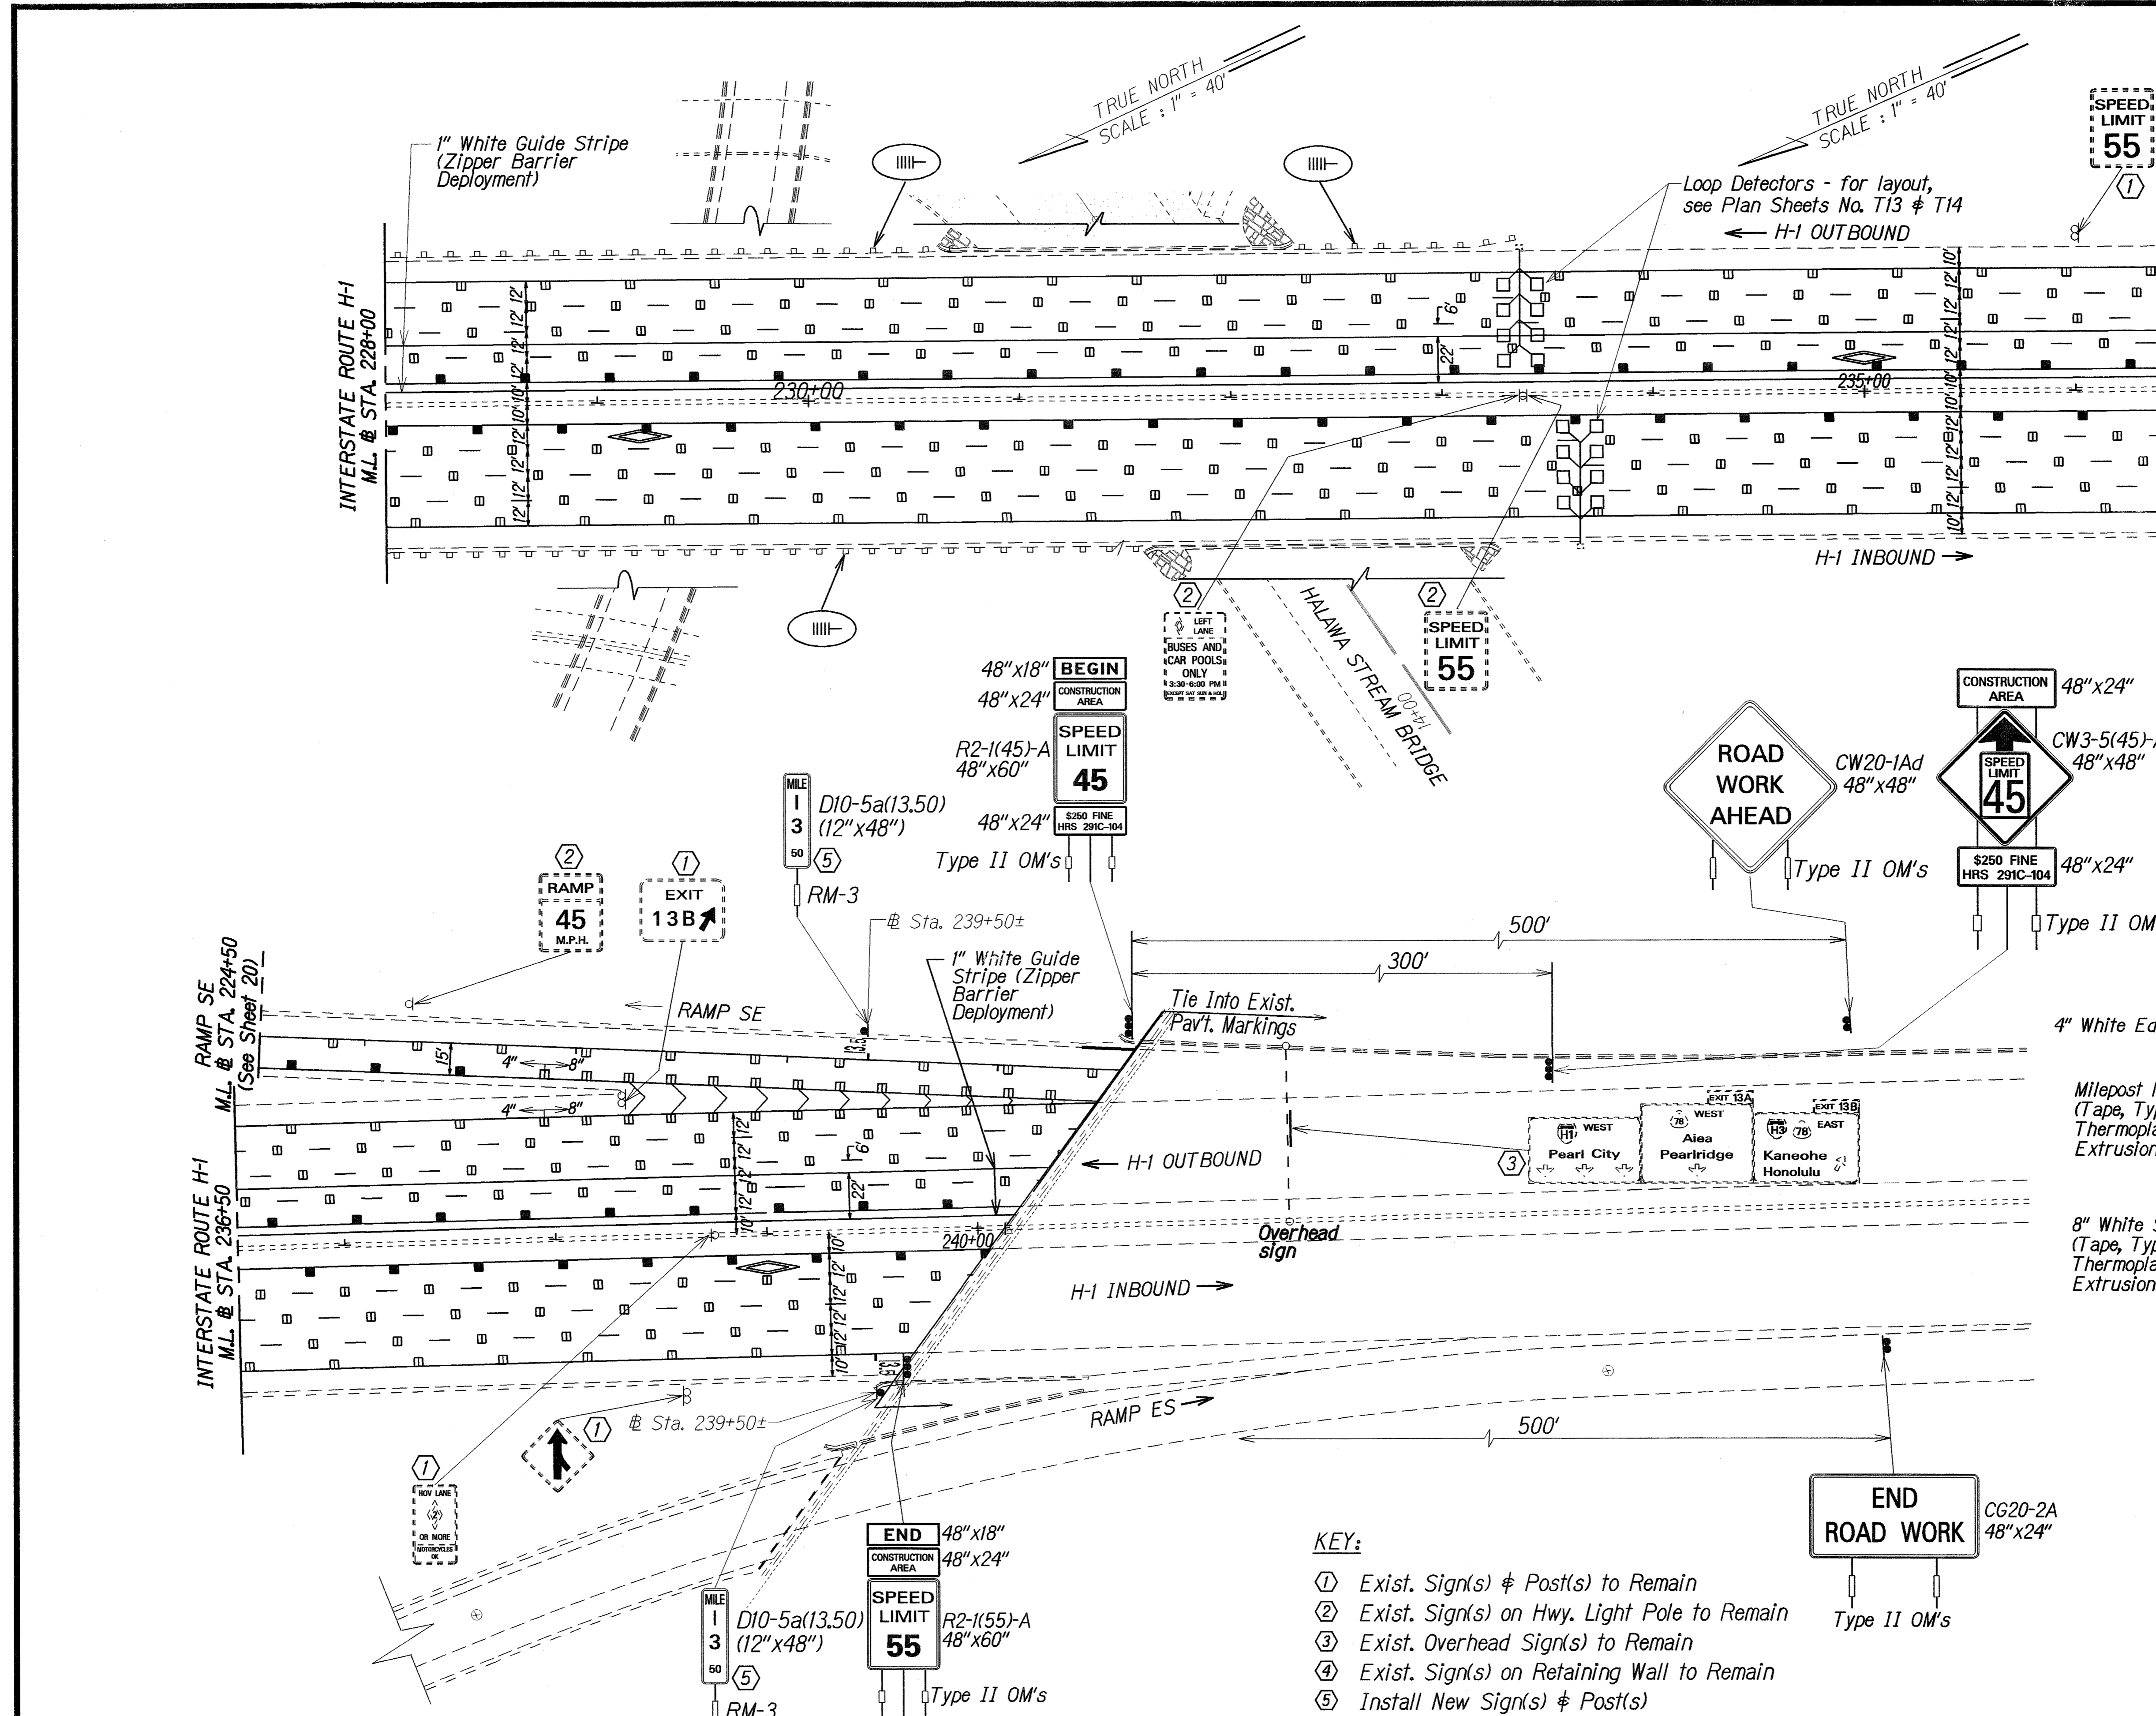

"13.5" MILEPOST PAVEMENT MARKINGS DETAIL
Not to Scale

- KEY:**
- ① Exist. Sign(s) & Post(s) to Remain
 - ② Exist. Sign(s) on Hwy. Light Pole to Remain
 - ③ Exist. Overhead Sign(s) to Remain
 - ④ Exist. Sign(s) on Retaining Wall to Remain
 - ⑤ Install New Sign(s) & Post(s)

ORIGINAL PLAN	DATE
DESIGNED BY	
CHECKED BY	
DATE	

STATE OF HAWAII
DEPARTMENT OF TRANSPORTATION
HIGHWAYS DIVISION

PAVEMENT MARKING & SIGNING PLAN

**INTERSTATE ROUTE H-1
RESURFACING**


Kaimakani St. to Salt Lake Viaduct

Project No. H-IEF-01-06MR

Scale: 1"=40' Date: January 2007



SHEET No. 75 OF 16 SHEETS

FED. ROAD DIST. NO.	STATE	PROJ. NO.	FISCAL YEAR	SHEET NO.	TOTAL SHEETS
HAWAII	HAW.	H-1EF-01-06MR	2009	20	40

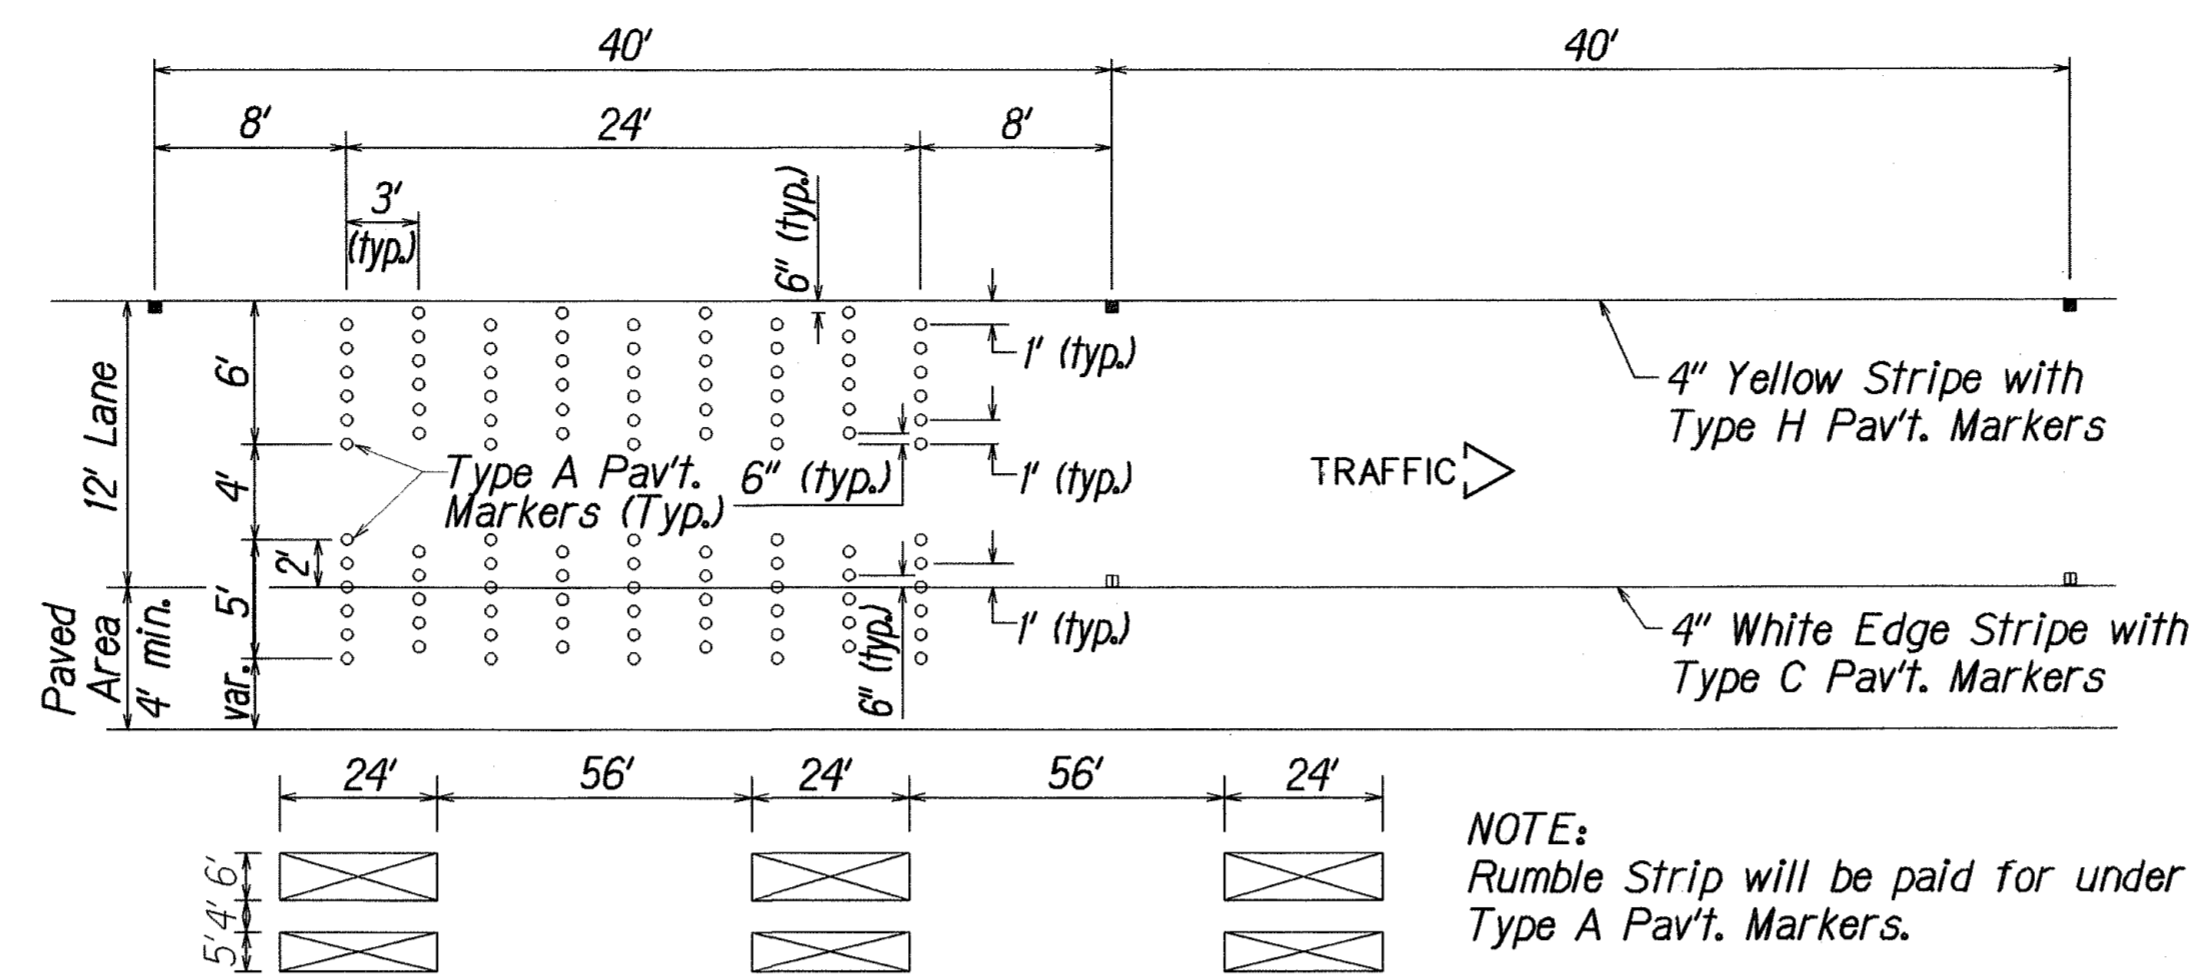

TYPICAL RUMBLE STRIP - LAYOUT & DETAIL

Not to Scale

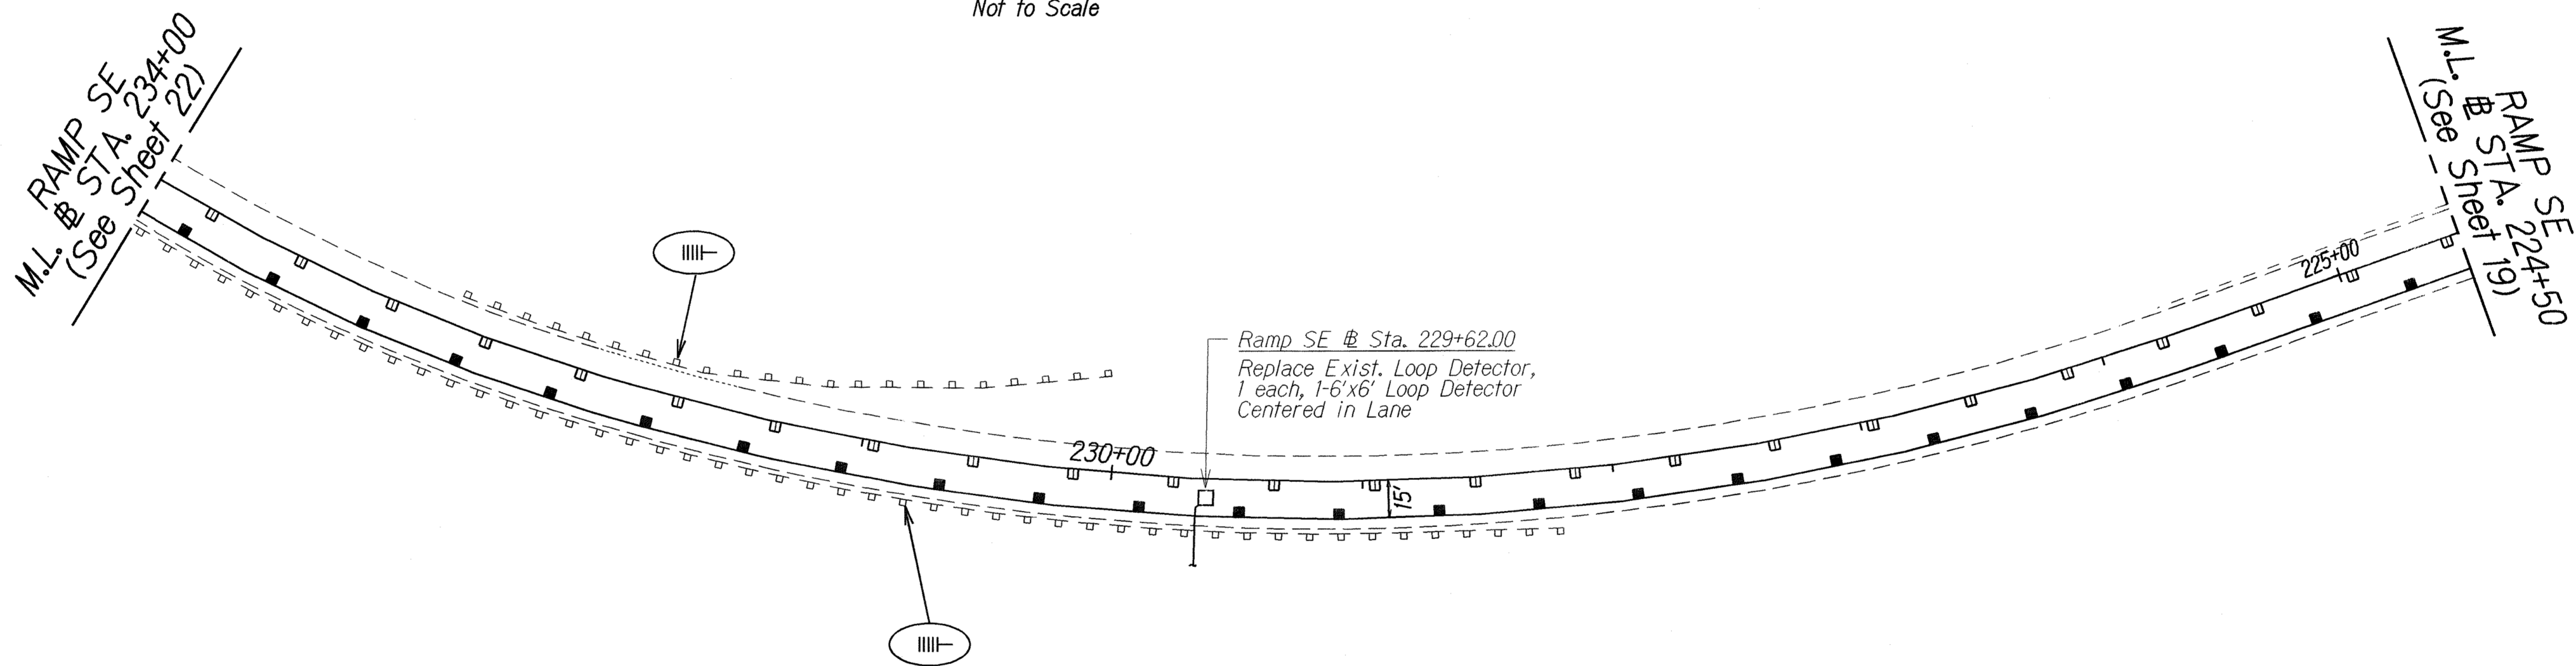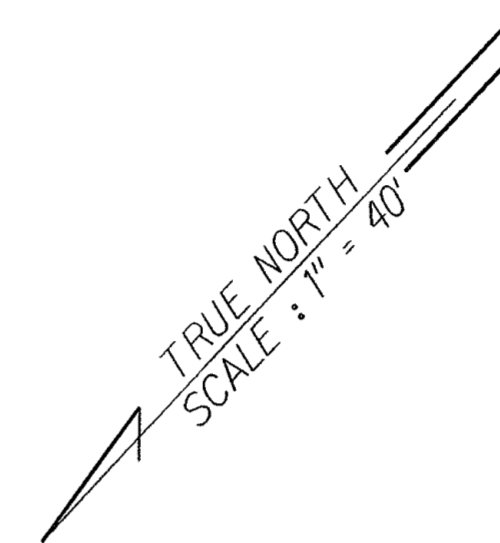

KEY:

- ① Exist. Sign(s) & Post(s) to Remain
- ② Exist. Sign(s) on Hwy. Light Pole to Remain
- ③ Exist. Overhead Sign(s) to Remain
- ④ Exist. Sign(s) on Retaining Wall to Remain

SURVEY PLOTTED BY	DATE
DESIGNED BY	
TRACED BY	
NOTE BOOK	
QUANTITIES BY	
CHECKED BY	
DATE	

STATE OF HAWAII
DEPARTMENT OF TRANSPORTATION
HIGHWAYS DIVISION

PAVEMENT MARKING & SIGNING PLAN

**INTERSTATE ROUTE H-1
RESURFACING**

Kaimakani St. to Salt Lake Viaduct


Project No. H-1EF-01-06MR

Scale: 1"=40' Date: January 2007

SHEET No. 16 OF 16 SHEETS

FED. ROAD DIST. NO.	STATE	PROJ. NO.	FISCAL YEAR	SHEET NO.	TOTAL SHEETS
HAWAII	HAW.	H-IEF-01-06MR	2009	21	40

TRUE NORTH
SCALE: 1" = 40'

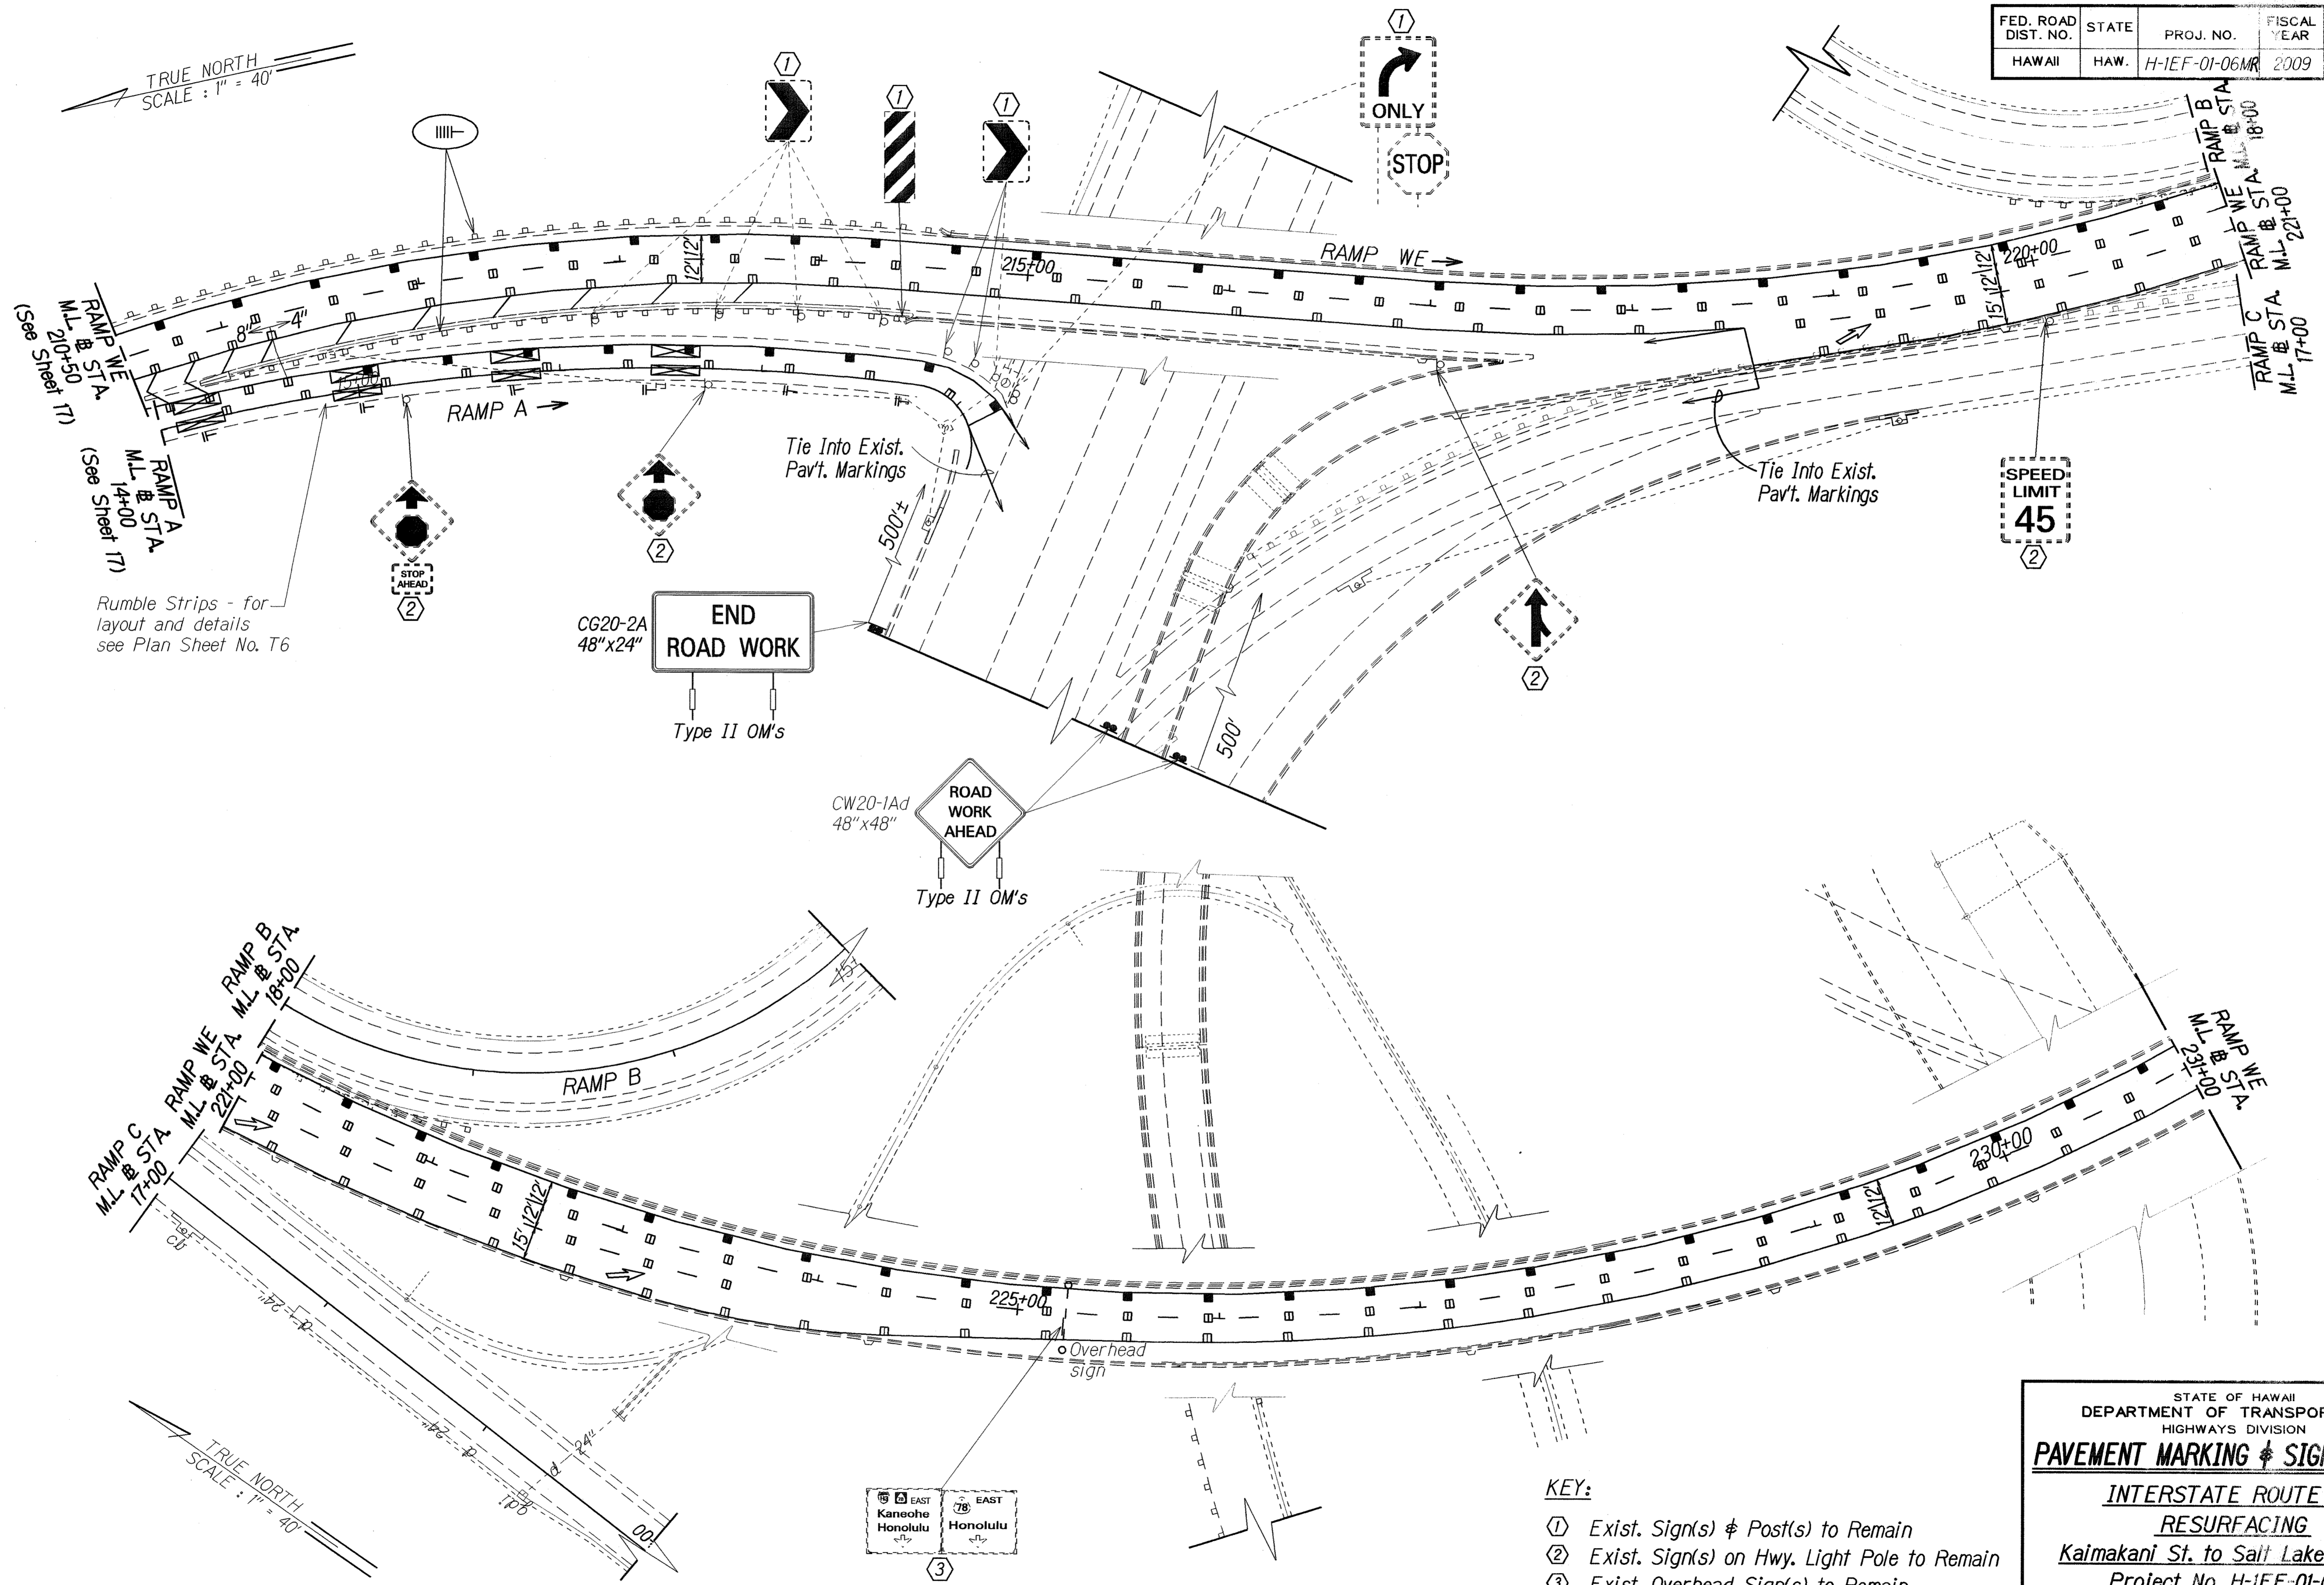

Rumble Strips - for layout and details see Plan Sheet No. T6

CG20-2A
48"x24"
END ROAD WORK
Type II OM's

CW20-1Ad
48"x48"
ROAD WORK AHEAD
Type II OM's

SPEED LIMIT 45

ONLY STOP

ORIGINAL PLAN	SURVEY PLOTTED BY	DATE
TRACED BY		
DESIGNED BY		
CHECKED BY		




TRUE NORTH
SCALE: 1" = 40'

15 EAST Kaneohe Honolulu
18 EAST Honolulu

- KEY:**
- ① Exist. Sign(s) & Post(s) to Remain
 - ② Exist. Sign(s) on Hwy. Light Pole to Remain
 - ③ Exist. Overhead Sign(s) to Remain
 - ④ Exist. Sign(s) on Retaining Wall to Remain

STATE OF HAWAII
DEPARTMENT OF TRANSPORTATION
HIGHWAYS DIVISION
PAVEMENT MARKING & SIGNING PLAN
INTERSTATE ROUTE H-1
RESURFACING
Kaimakani St. to Salt Lake Viaduct
Project No. H-IEF-01-06MR
Scale: 1"=40' Date: January 2007
SHEET No. T7 OF 16 SHEETS

FED. ROAD DIST. NO.	STATE	PROJ. NO.	FISCAL YEAR	SHEET NO.	TOTAL SHEETS
HAWAII	HAW.	H-IEF-01-06MR	2009	22	40

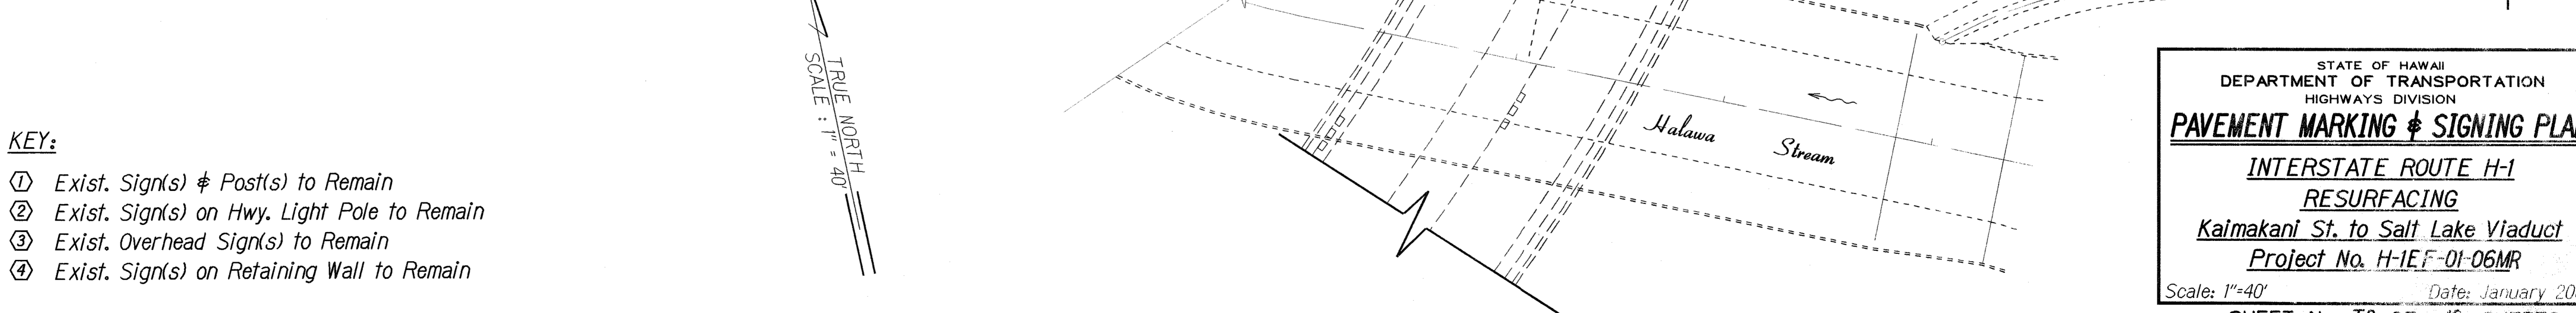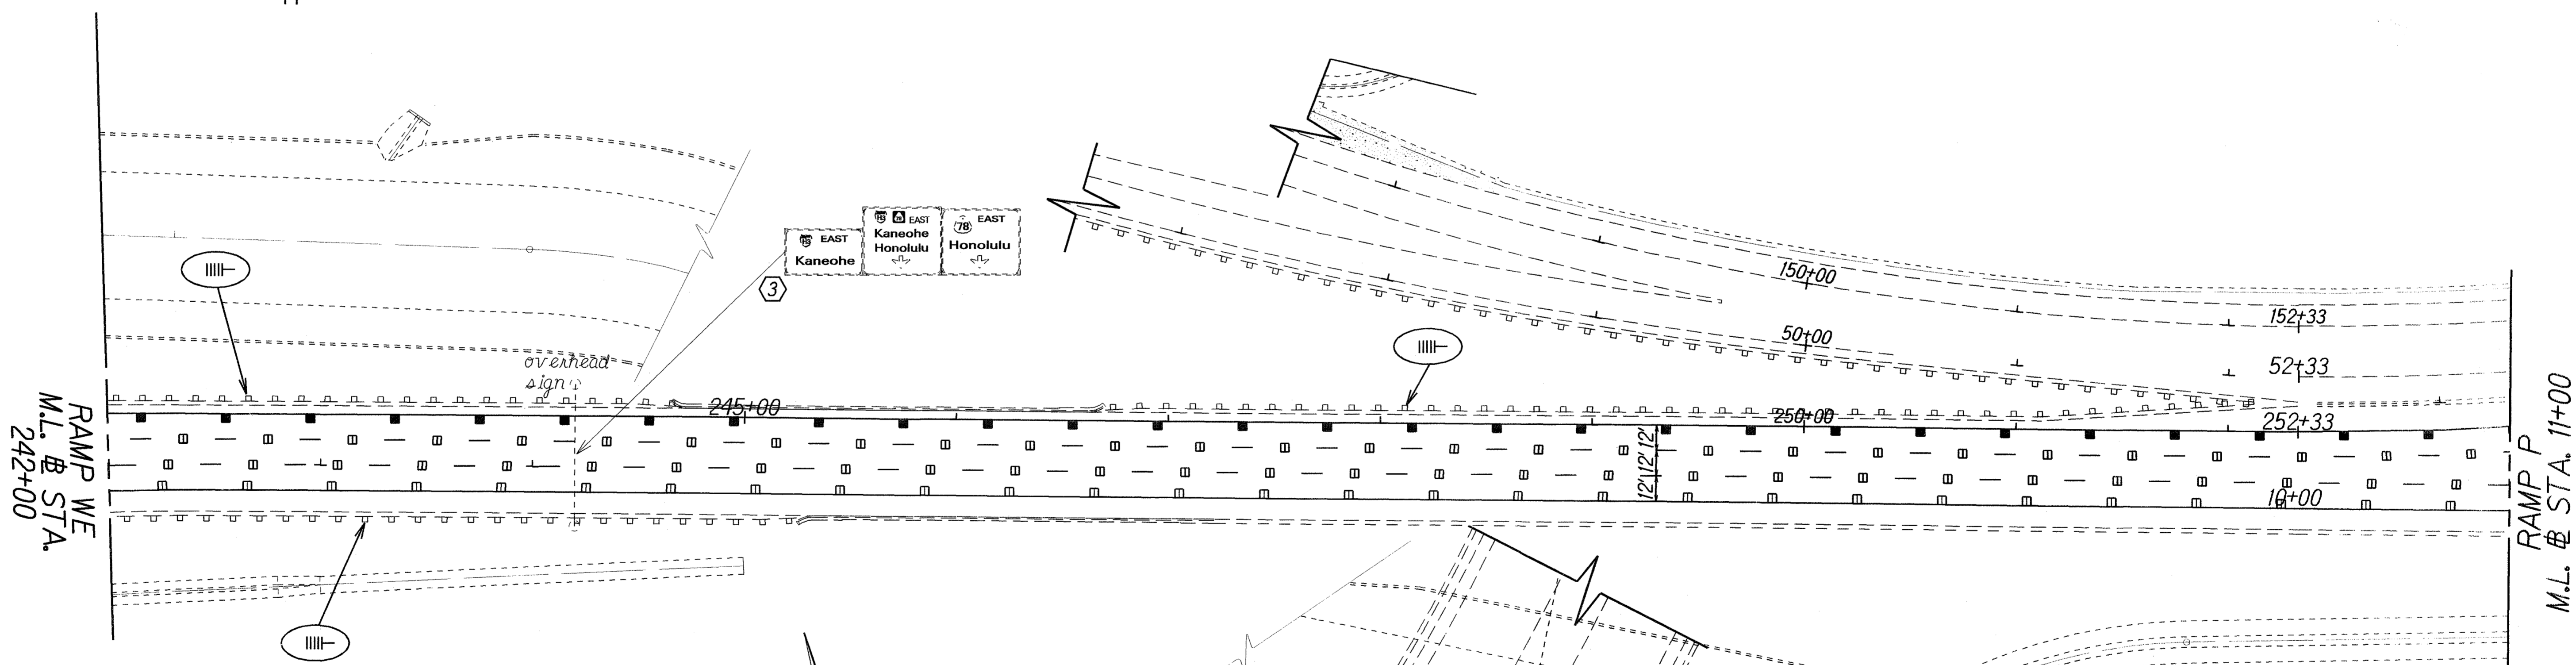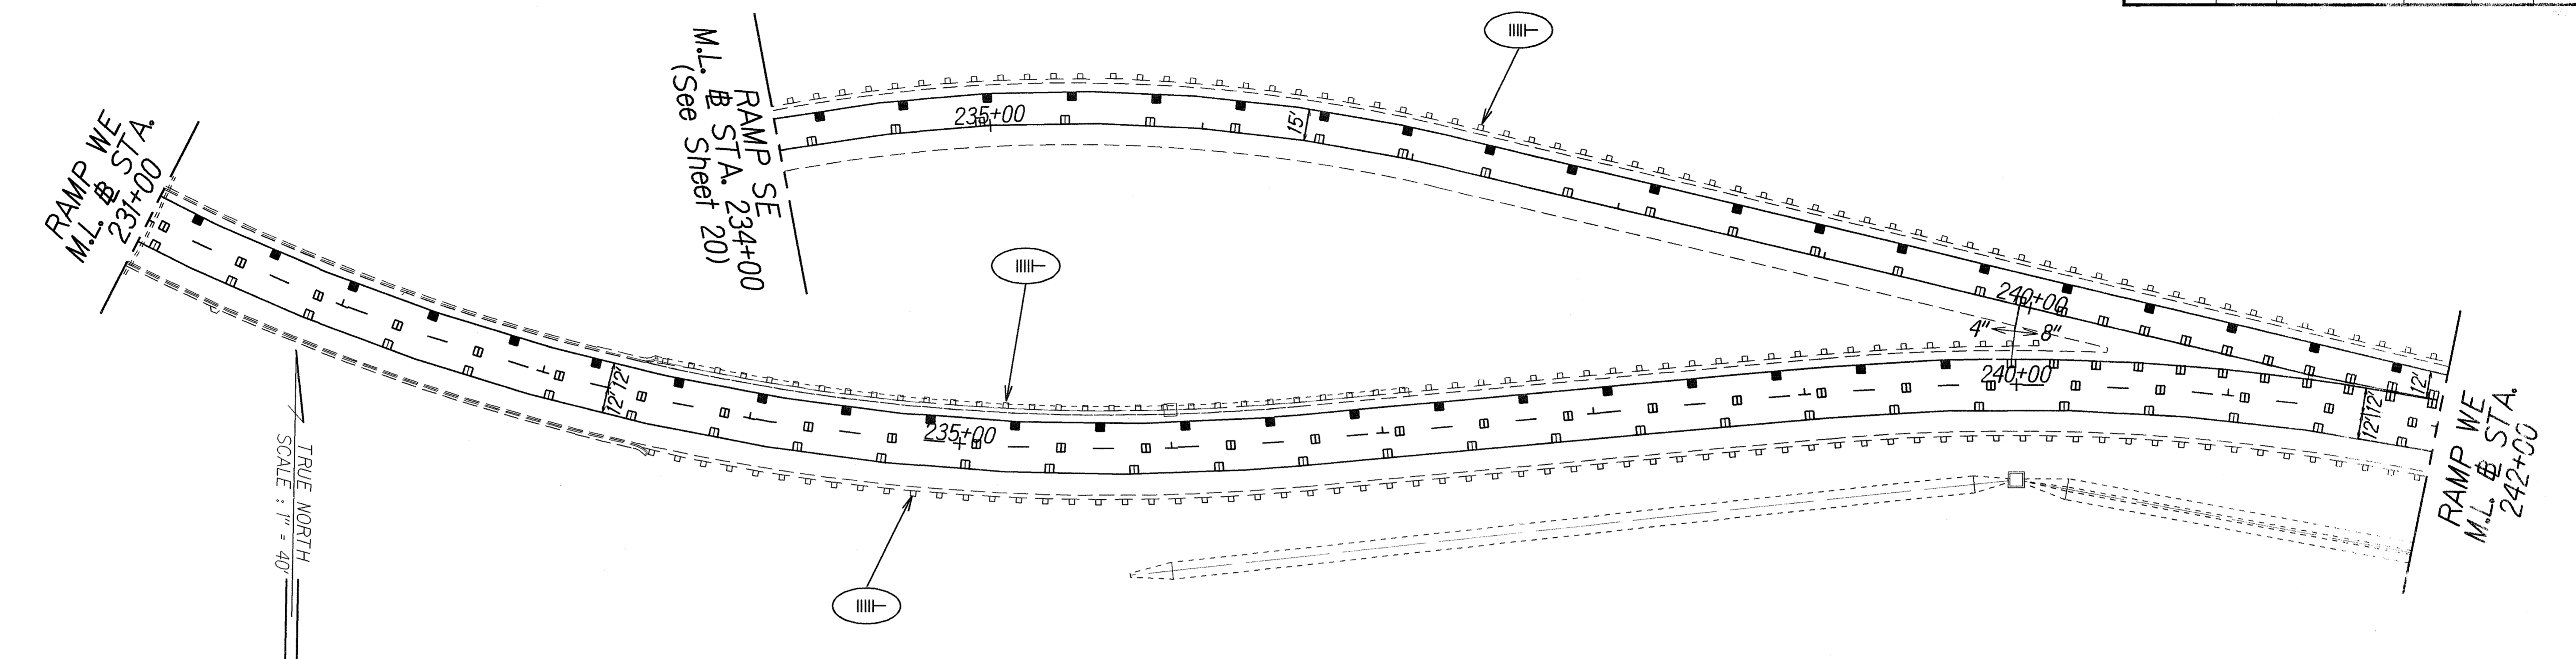


- KEY:**
- ① Exist. Sign(s) & Post(s) to Remain
 - ② Exist. Sign(s) on Hwy. Light Pole to Remain
 - ③ Exist. Overhead Sign(s) to Remain
 - ④ Exist. Sign(s) on Retaining Wall to Remain

SURVEY PLOTTED BY	DATE
DESIGNED BY	
QUANTITIES BY	
CHECKED BY	
ORIGINAL PLAN	
NOTE BOOK	
DATE	
BY	
NO.	

STATE OF HAWAII
DEPARTMENT OF TRANSPORTATION
HIGHWAYS DIVISION
PAVEMENT MARKING & SIGNING PLAN
INTERSTATE ROUTE H-1
RESURFACING
Kaimakani St. to Salt Lake Viaduct
Project No. H-IEF-01-06MR
Scale: 1"=40' Date: January 2007
SHEET No. 78 OF 16 SHEETS

FED. ROAD DIST. NO.	STATE	PROJ. NO.	FISCAL YEAR	SHEET NO.	TOTAL SHEETS
HAWAII	HAW.	H-1EF-01-06MR	2009	23	40

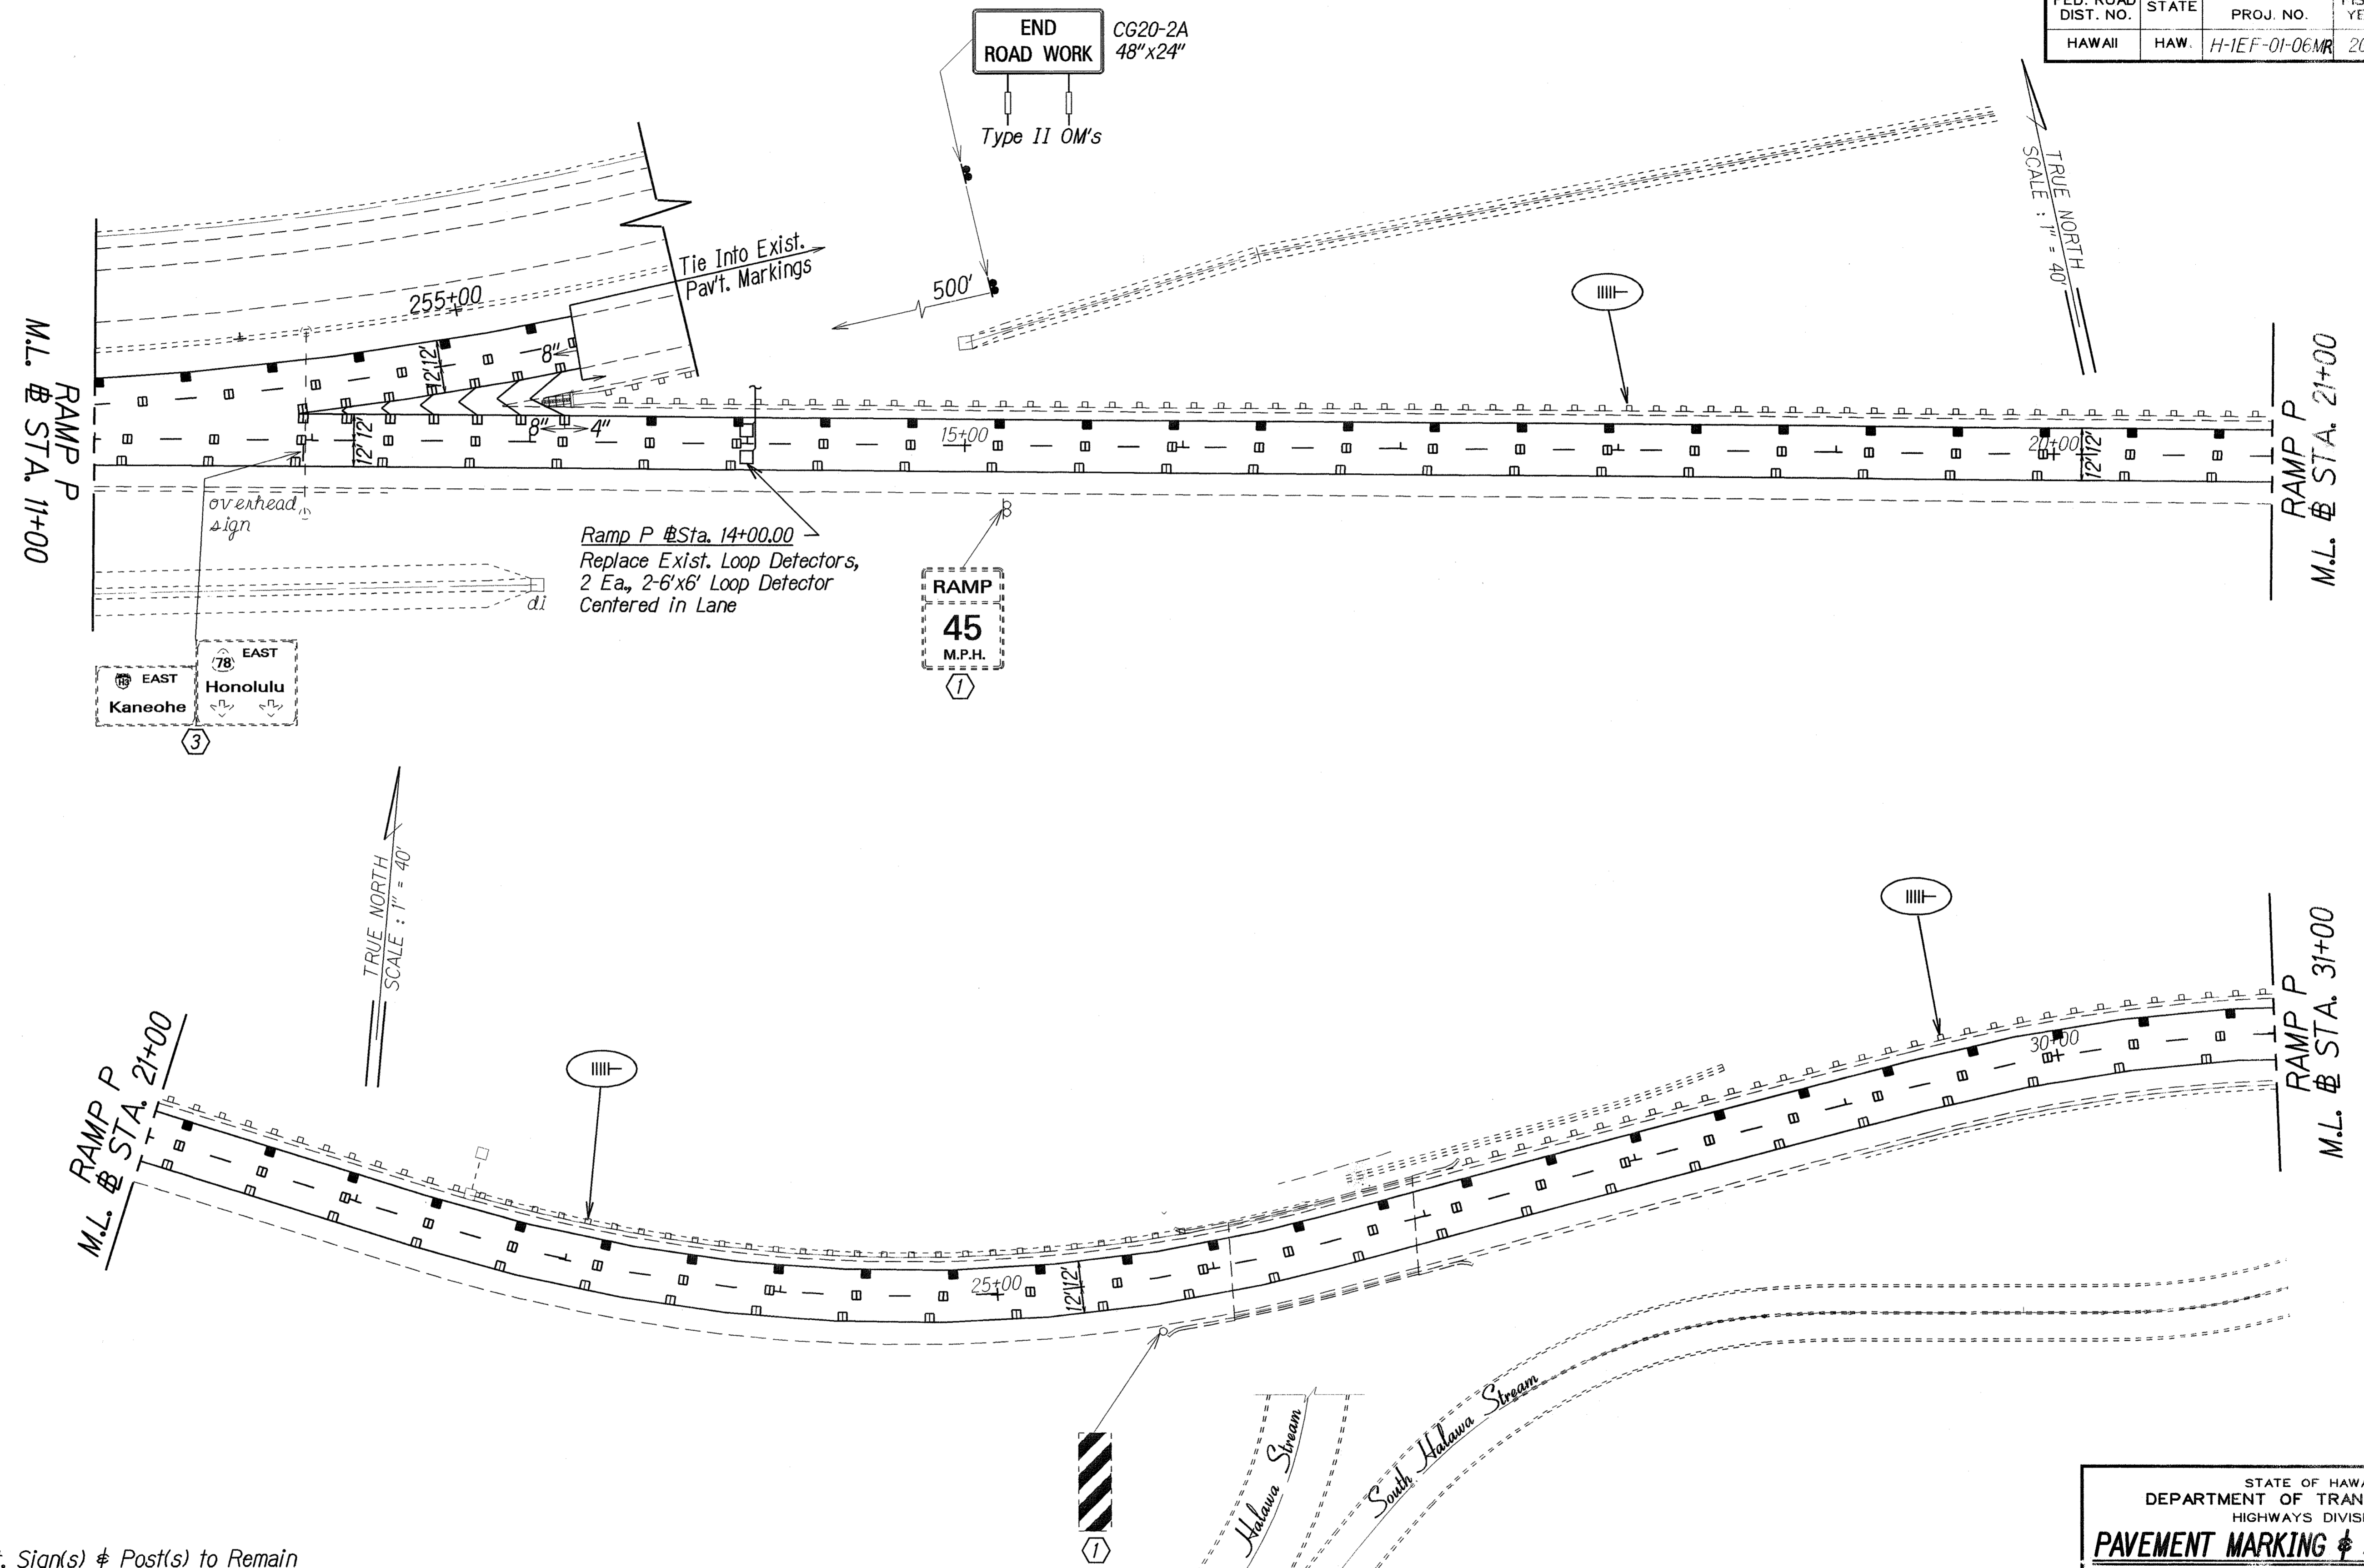

KEY:

- ① Exist. Sign(s) & Post(s) to Remain
- ② Exist. Sign(s) on Hwy. Light Pole to Remain
- ③ Exist. Overhead Sign(s) to Remain
- ④ Exist. Sign(s) on Retaining Wall to Remain

SURVEY PLOTTED BY	DATE
DRAWN BY	
TRACED BY	
NOTE BOOK	
QUANTITIES BY	
CHECKED BY	
ORIGINAL PLAN	
DATE	
NO.	

STATE OF HAWAII
DEPARTMENT OF TRANSPORTATION
HIGHWAYS DIVISION


PAVEMENT MARKING & SIGNING PLAN

INTERSTATE ROUTE H-1
RESURFACING
Kaimakani St. to Salt Lake Viaduct
Project No. H-1EF-01-06MR

Scale: 1"=40' Date: January 2007

SHEET No. 19 OF 16 SHEETS

FED. ROAD DIST. NO.	STATE	PROJ. NO.	FISCAL YEAR	SHEET NO.	TOTAL SHEETS
HAWAII	HAW.	H-IEF-01-06MR	2009	24	40

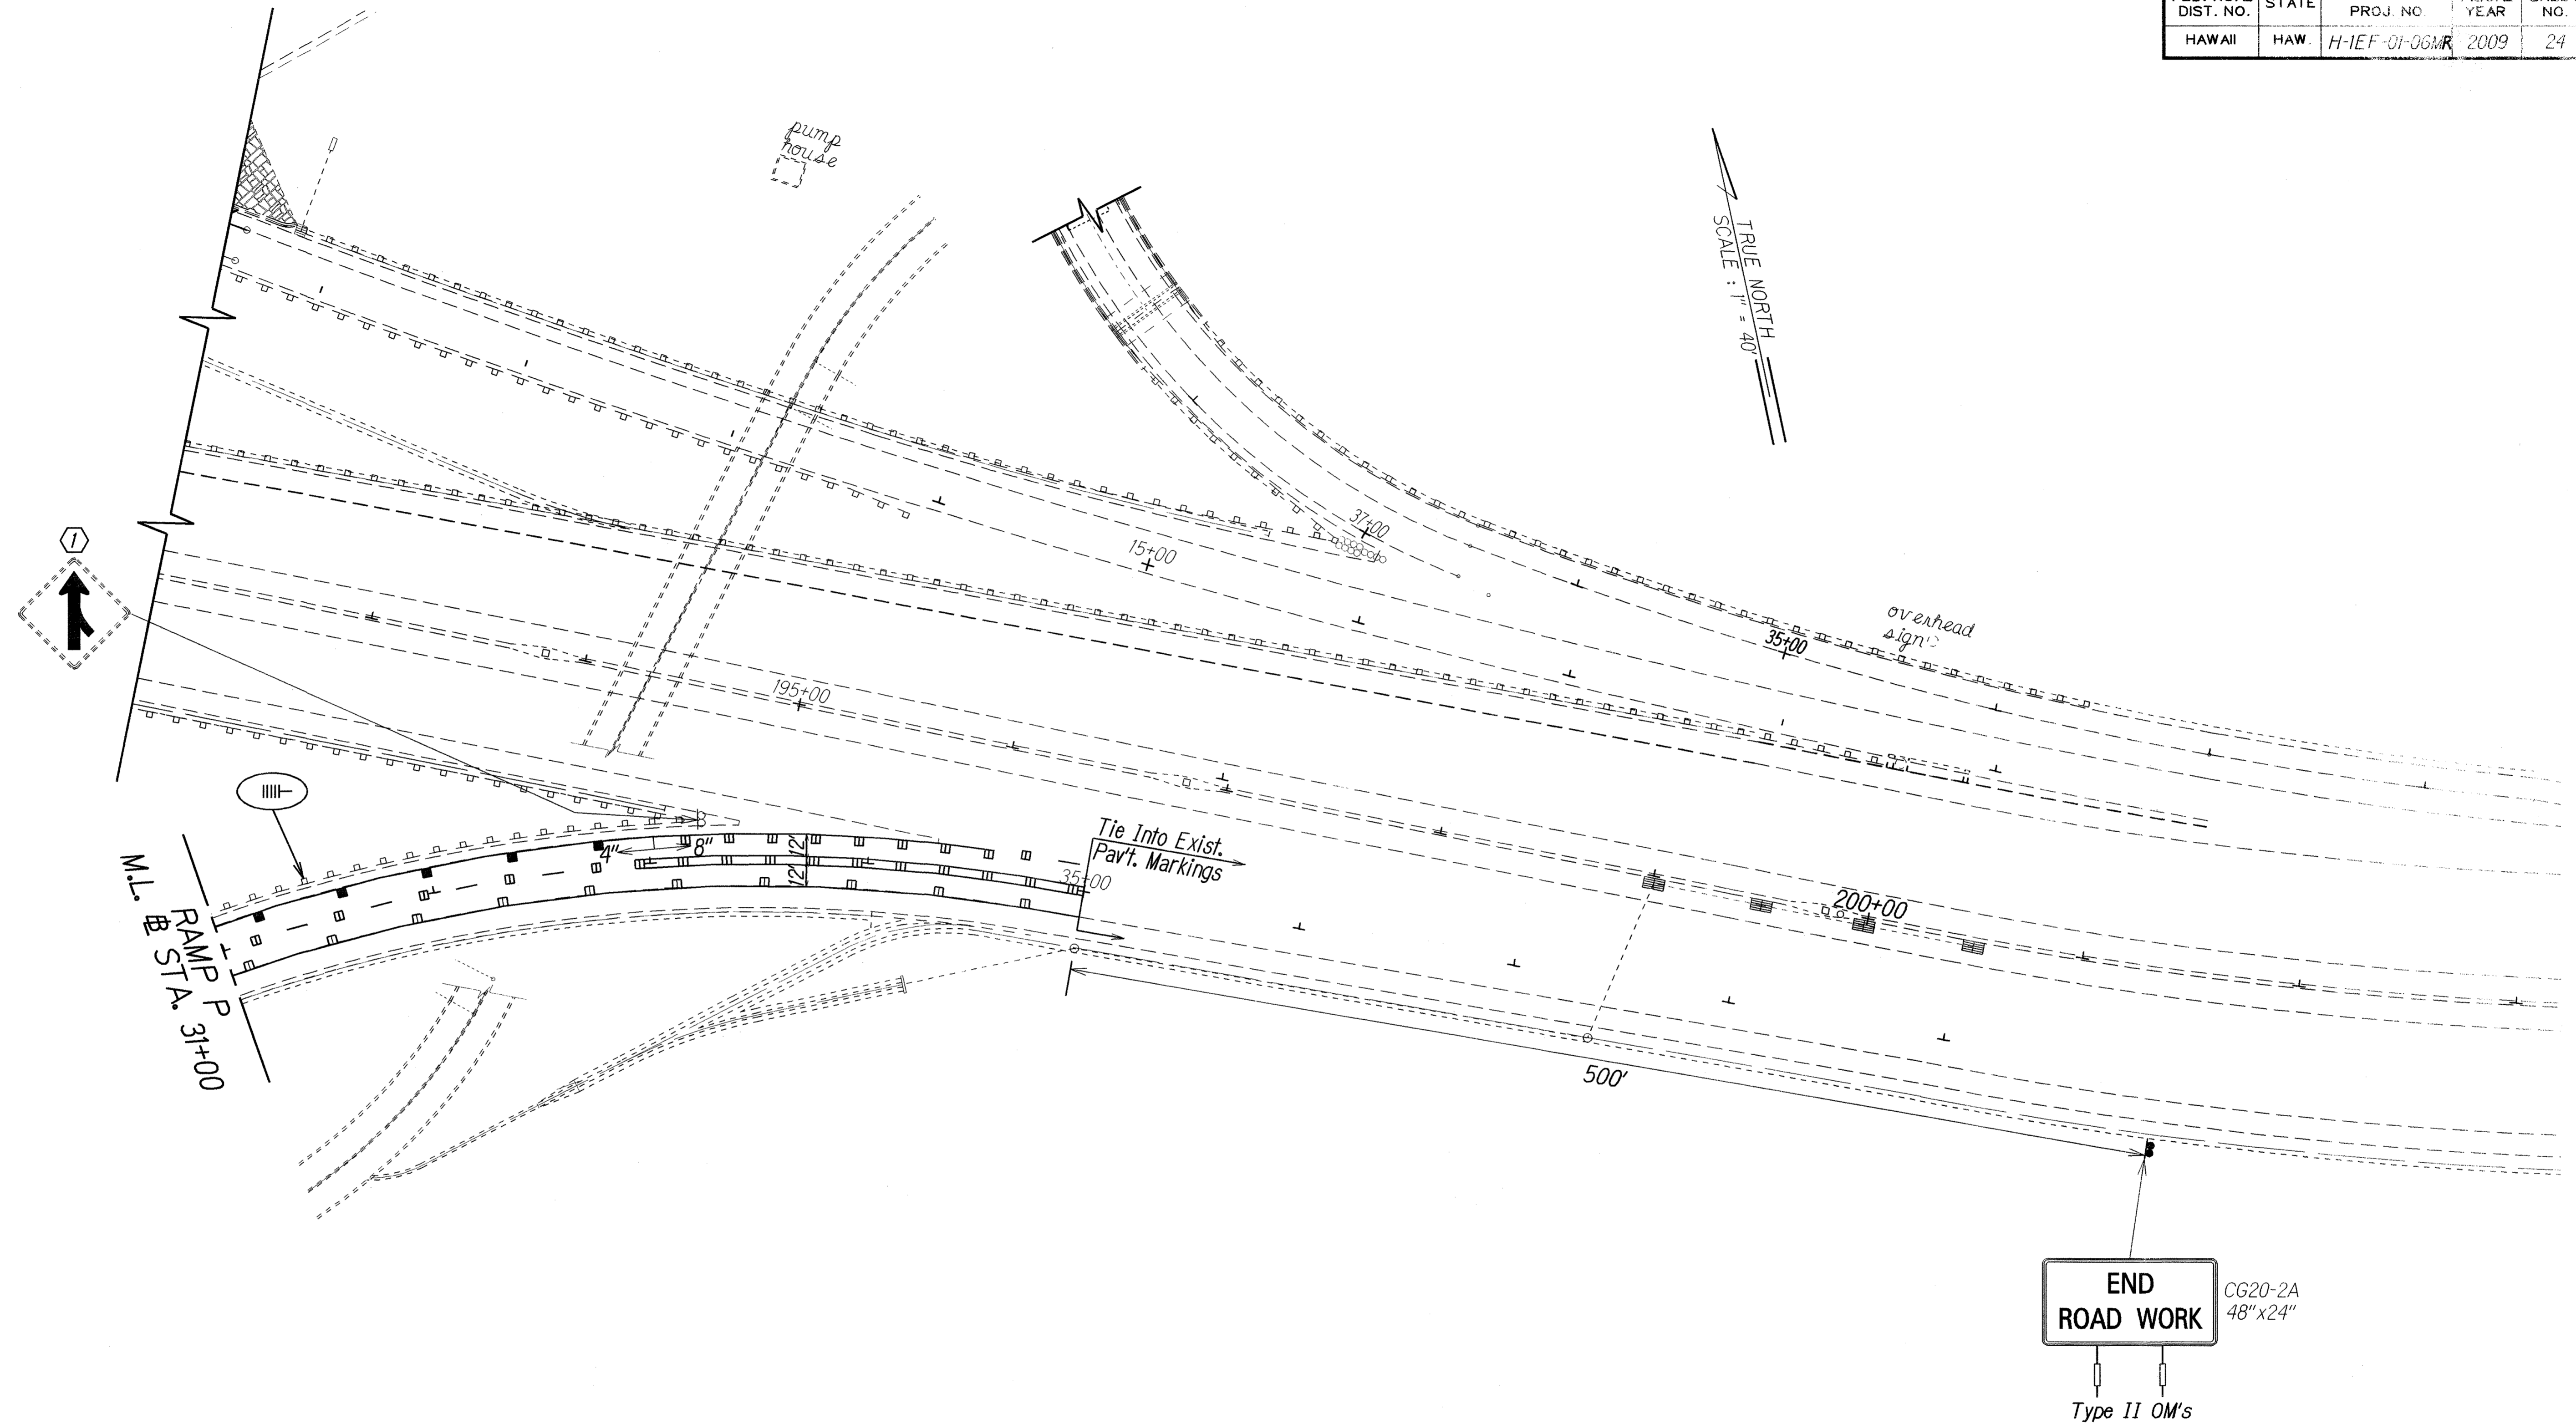

DESIGNED BY	DATE
DRAWN BY	
TRACED BY	
DESIGNED BY	
QUANTITIES BY	
CHECKED BY	

KEY:

- ① Exist. Sign(s) & Post(s) to Remain
- ② Exist. Sign(s) on Hwy. Light Pole to Remain
- ③ Exist. Overhead Sign(s) to Remain
- ④ Exist. Sign(s) on Retaining Wall to Remain

STATE OF HAWAII
DEPARTMENT OF TRANSPORTATION
HIGHWAYS DIVISION


PAVEMENT MARKING & SIGNING PLAN

INTERSTATE ROUTE H-1
RESURFACING
Kaimakani St. to Salt Lake Viaduct
Project No. H-IEF-01-06MR

Scale: 1"=40' Date: January 2007

SHEET No. 110 OF 16 SHEETS

FED. ROAD DIST. NO.	STATE	PROJ. NO.	FISCAL YEAR	SHEET NO.	TOTAL SHEETS
HAWAII	HAW.	H-IEF-01-06MR	2009	25	40

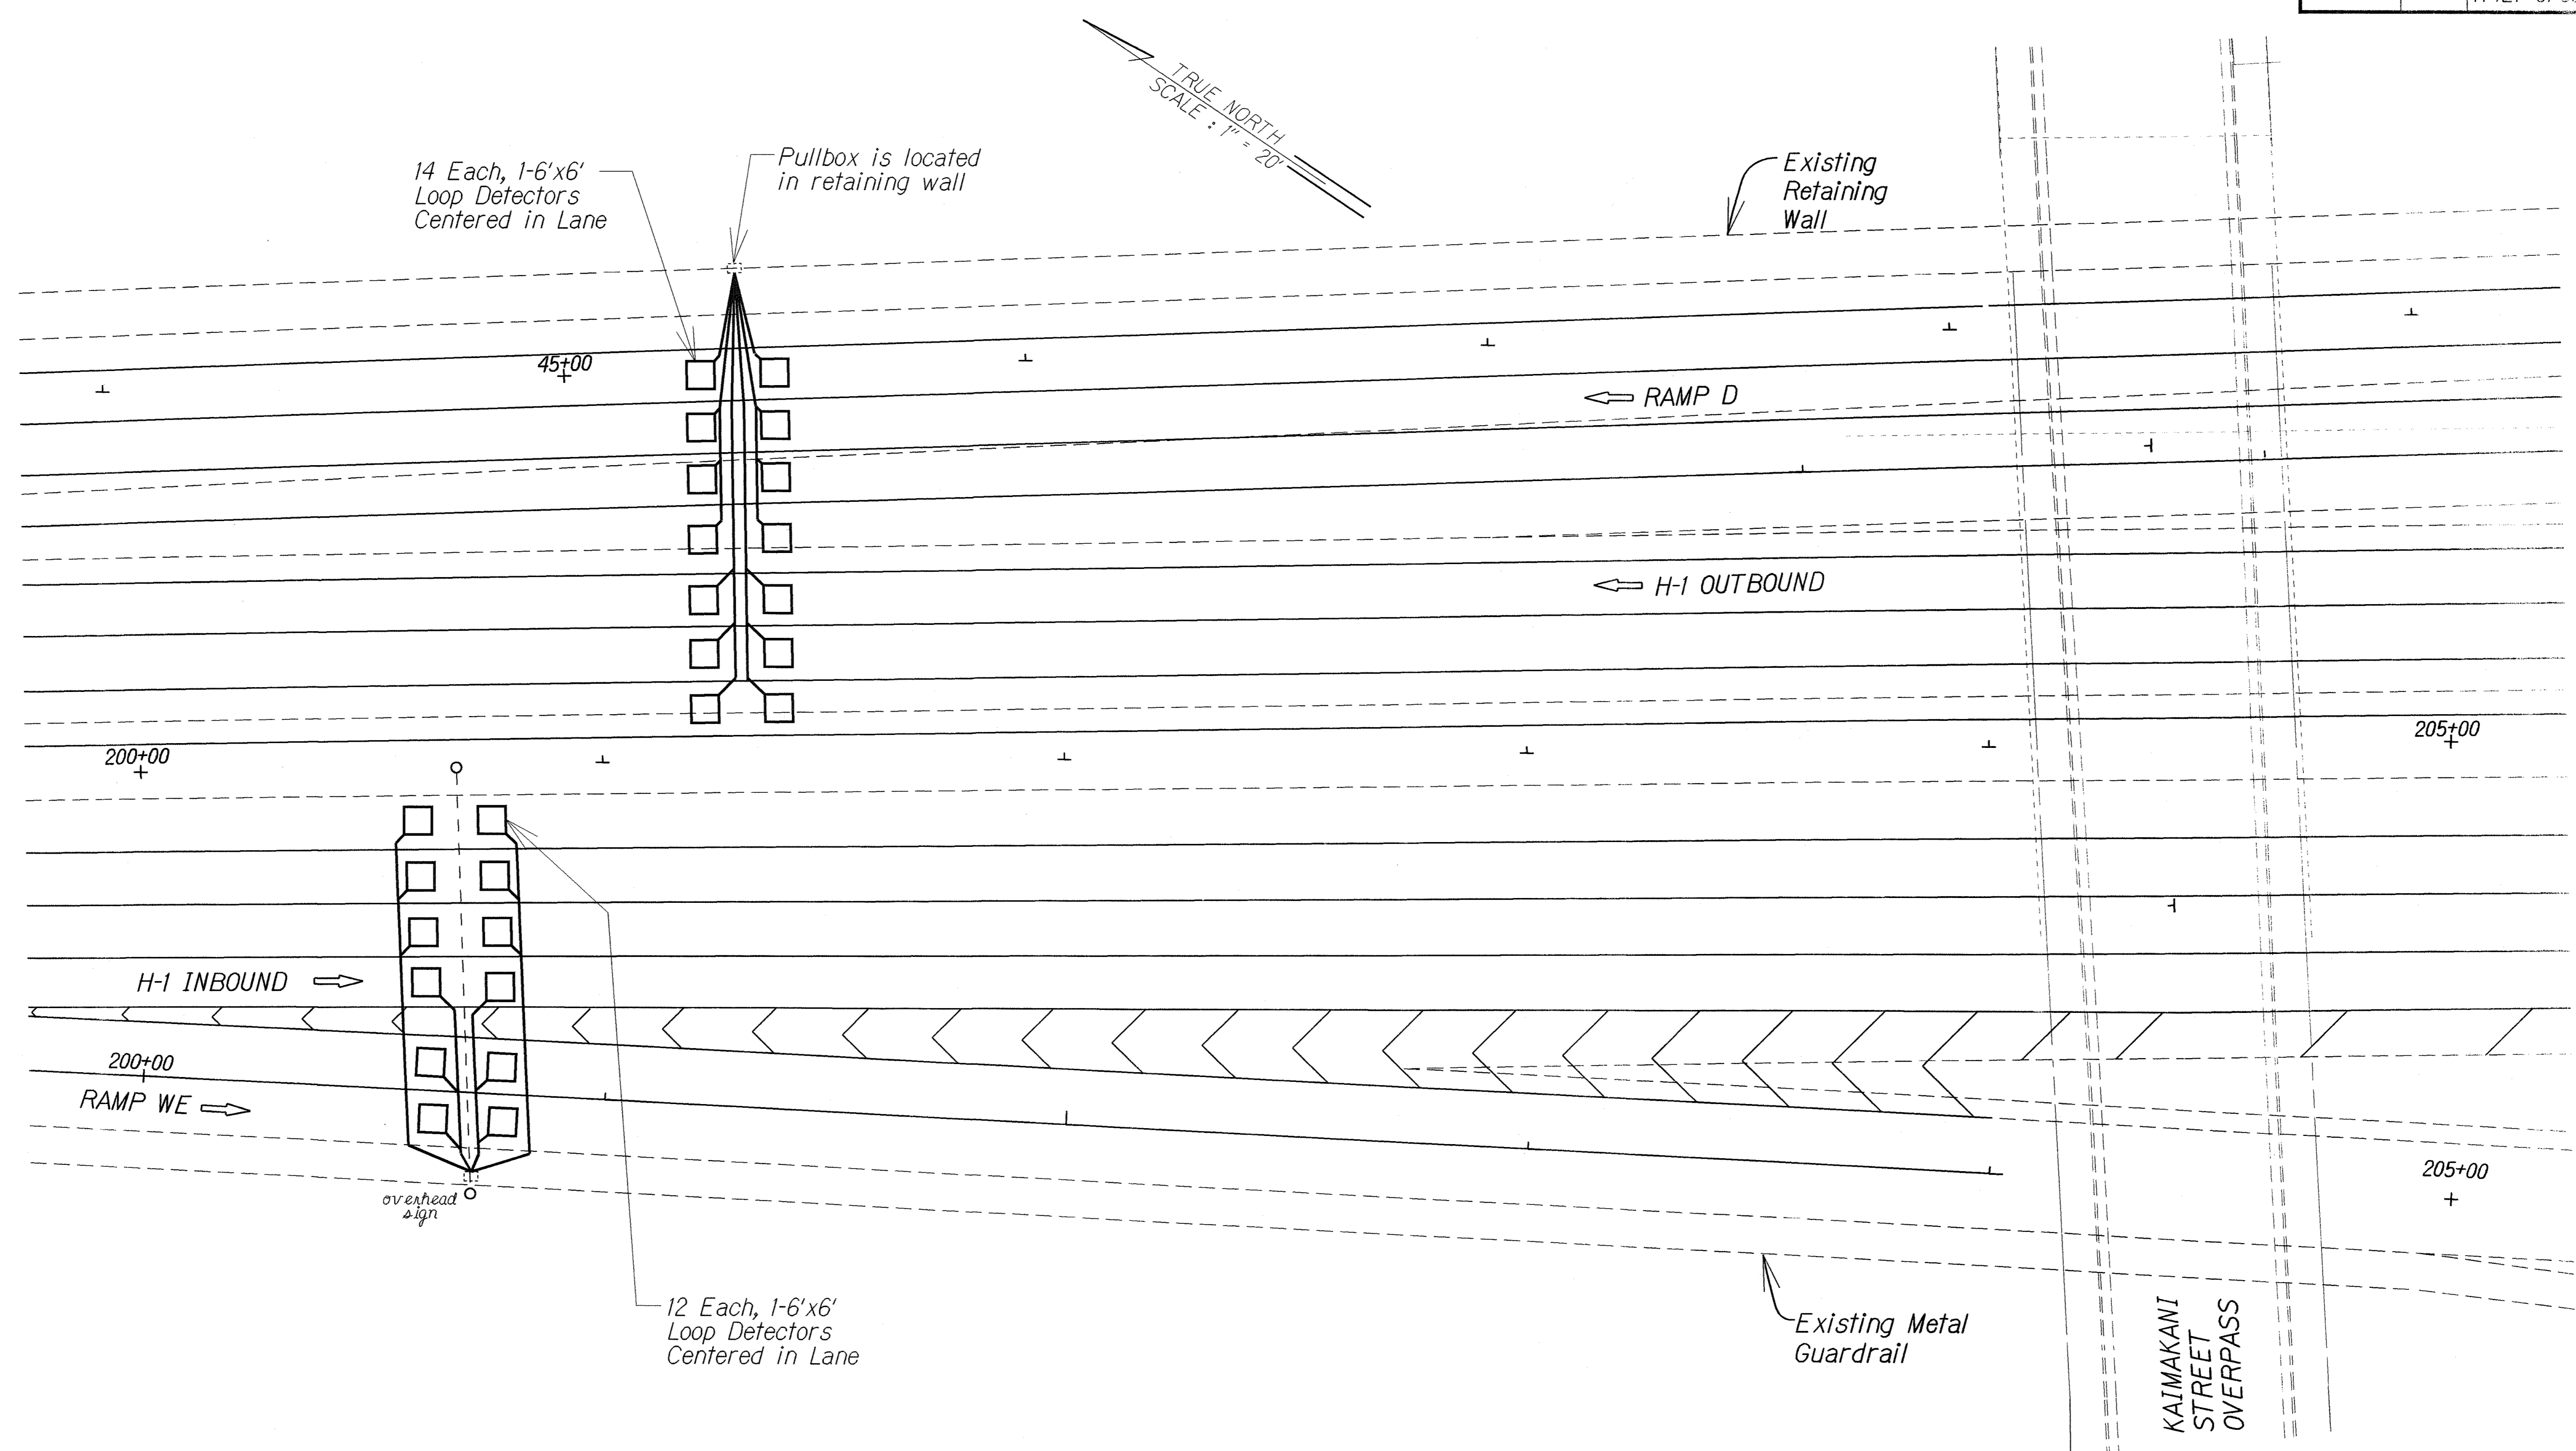

SURVEY PLOTTED BY	DATE
DESIGNED BY	
TRACED BY	
NOTE BOOK	
QUANTITIES BY	
CHECKED BY	


STATE OF HAWAII
DEPARTMENT OF TRANSPORTATION
HIGHWAYS DIVISION

LOOP DETECTOR PLAN

Vicinity of Kaimakani Street Overpass
INTERSTATE ROUTE H-1
RESURFACING
Kaimakani St. to Salt Lake Viaduct
Project No. H-IEF-01-06MR
Scale: 1"=20' Date: January 2007

SHEET No. 25 OF 16 SHEETS

FED. ROAD DIST. NO.	STATE	PROJ. NO.	FISCAL YEAR	SHEET NO.	TOTAL SHEETS
HAWAII	HAW.	H-IEF-01-06MR	2009	26	40

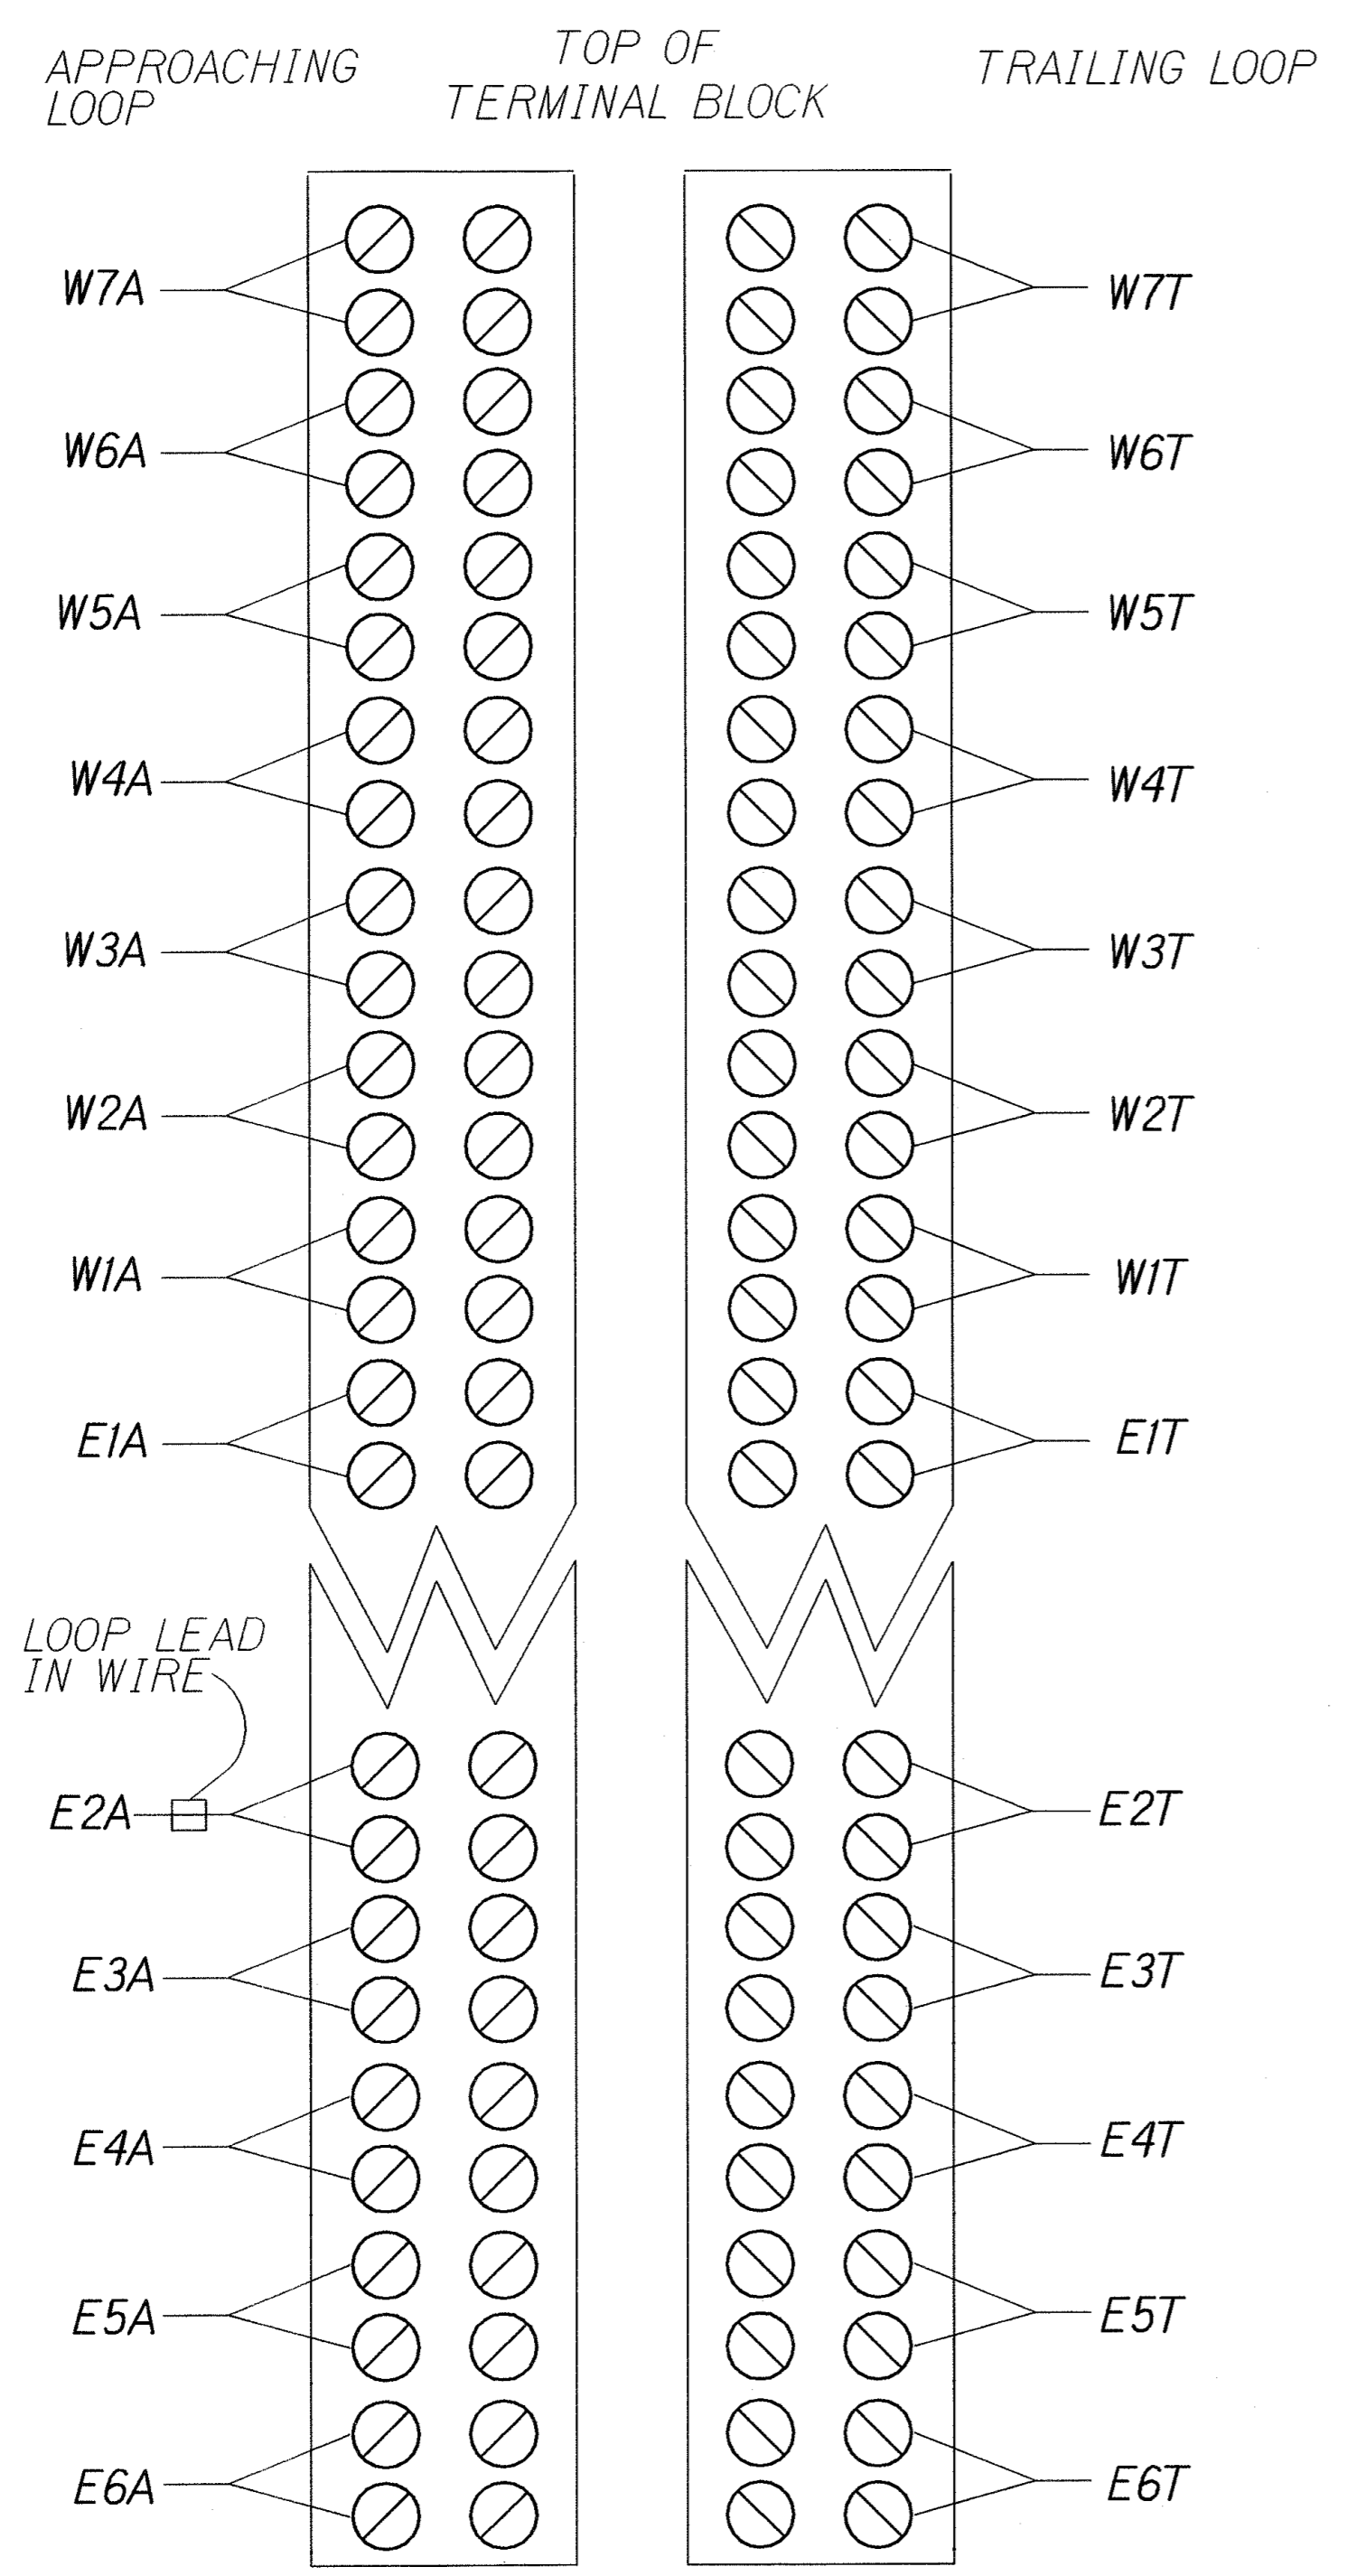


BOTTOM OF TERMINAL BLOCK

M-332A CABINET

CONNECTING LAYOUT OF LOOP LEAD-IN WIRES TO TERMINAL BLOCK INSIDE M-332A CABINET

LEGEND:
W = WEST
E = EAST
A = APPROACHING
T = TRAILING

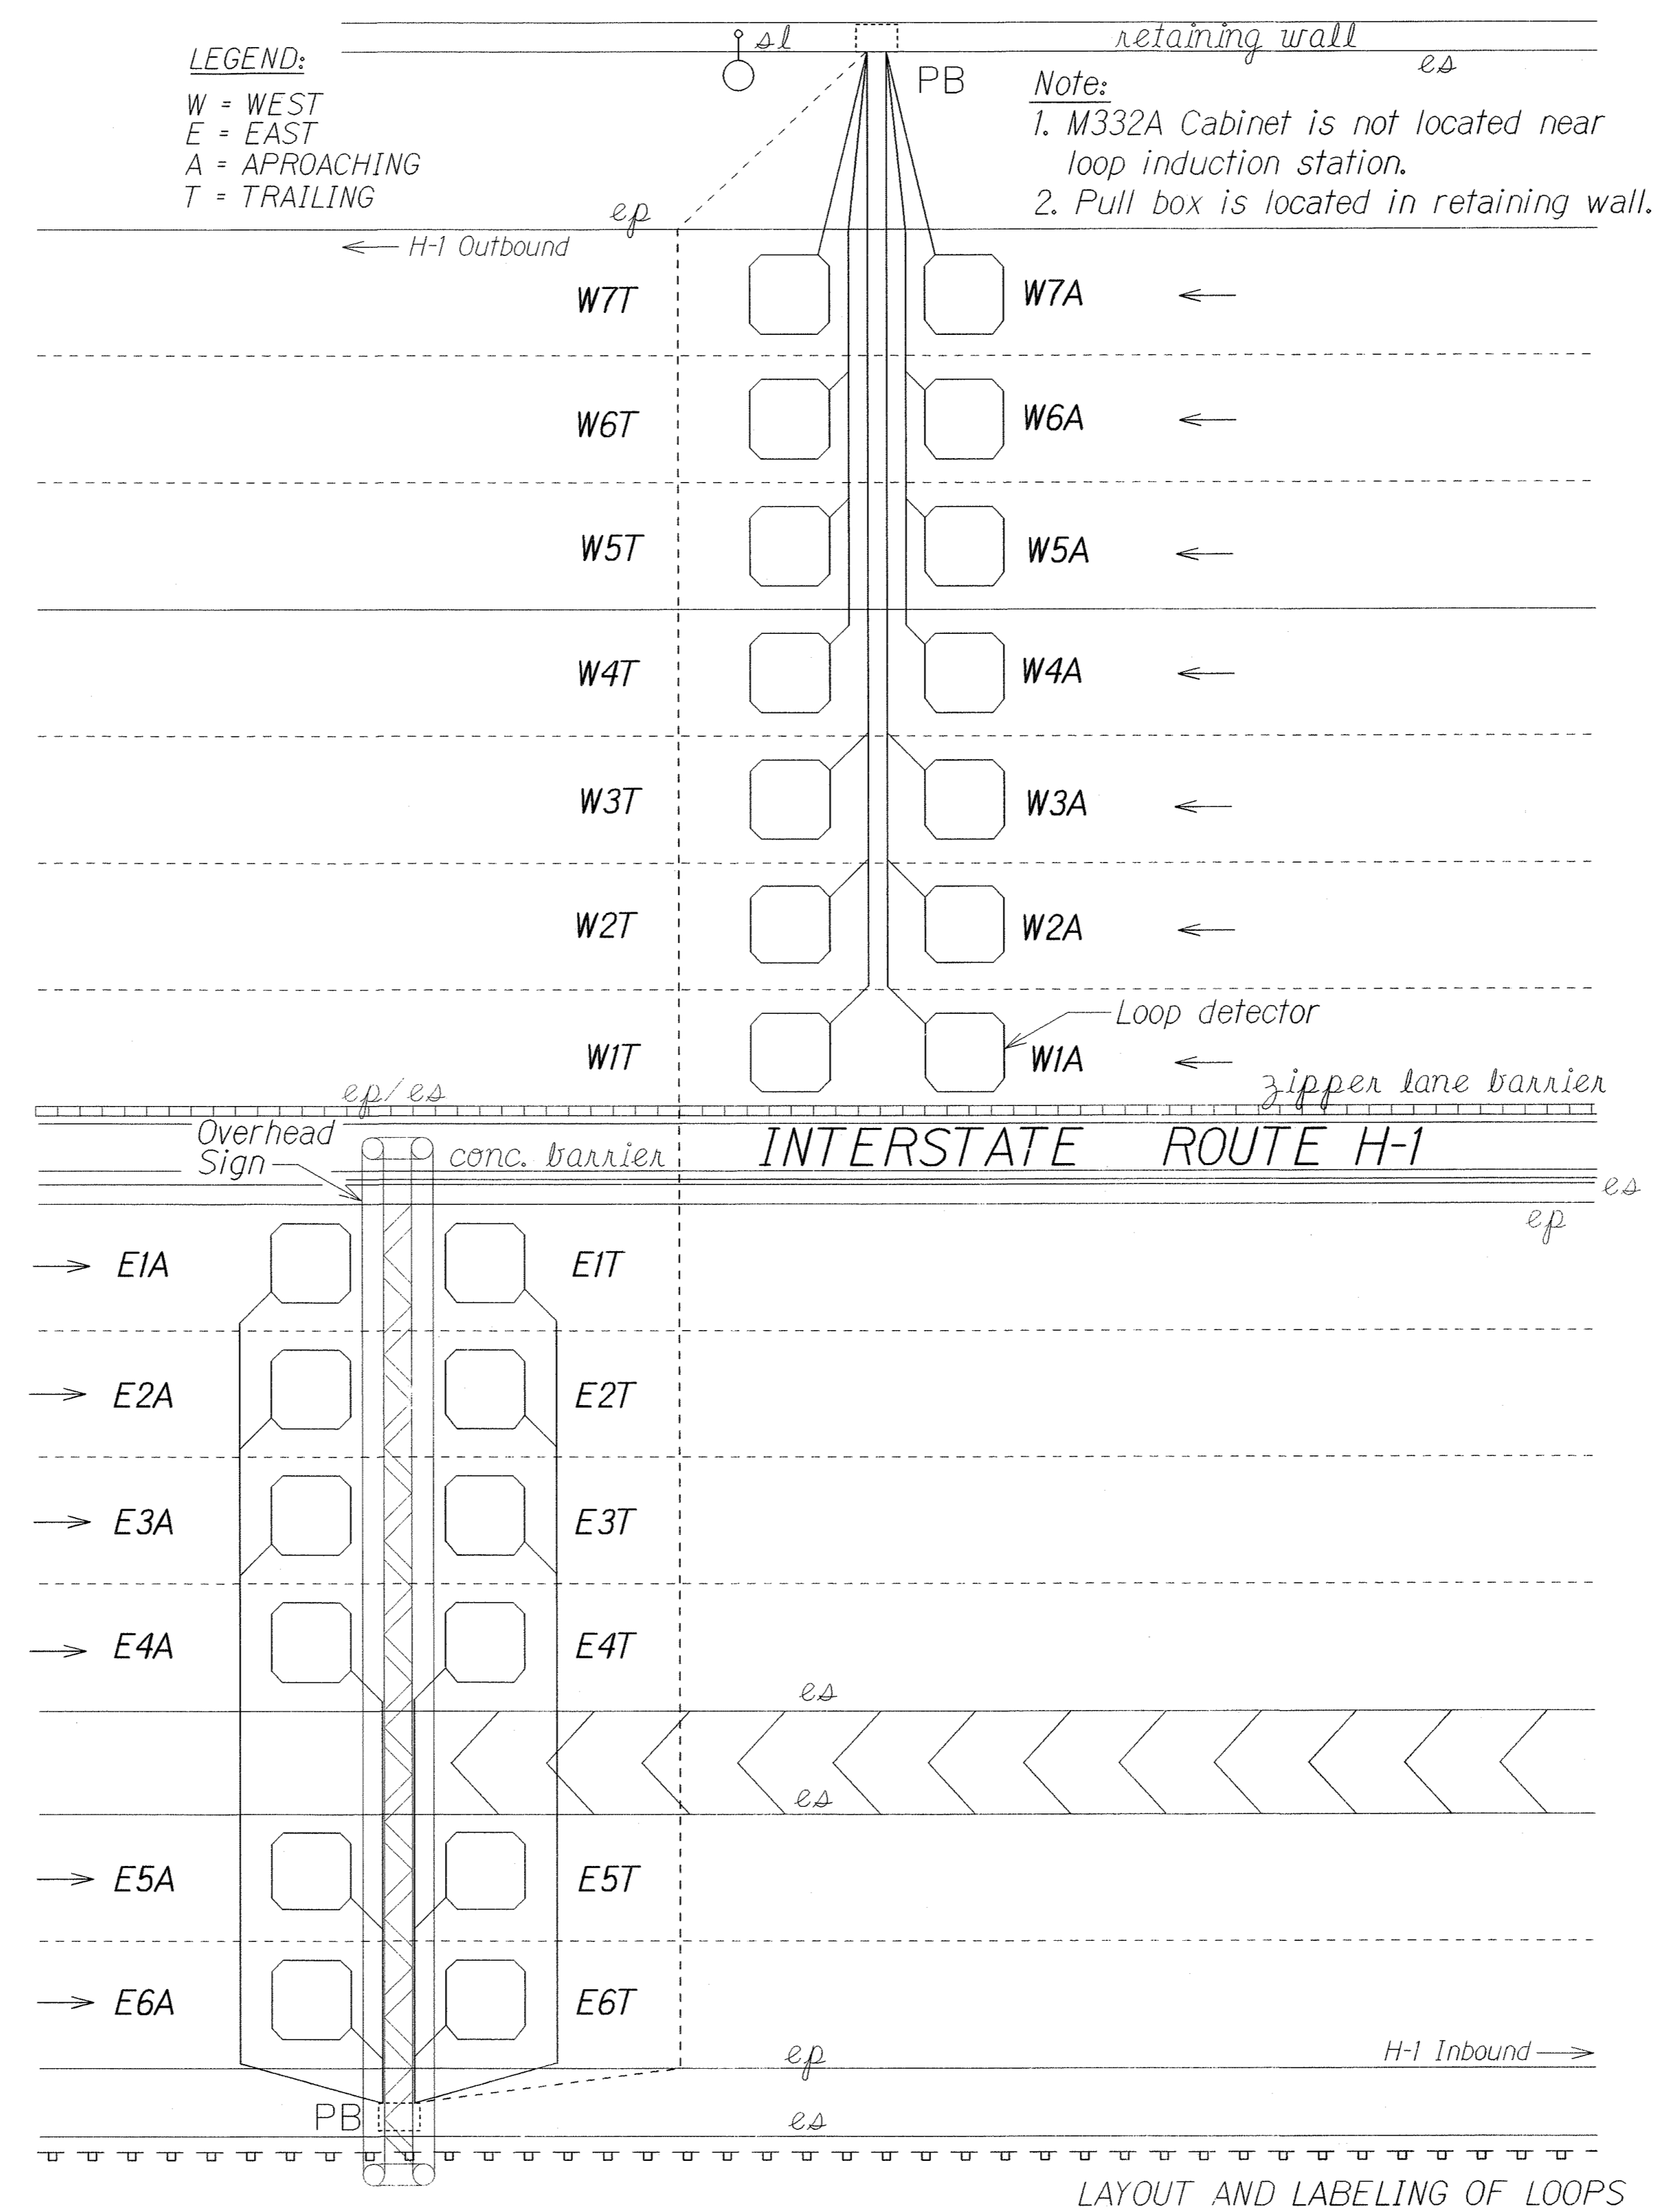

LAYOUT AND LABELING OF LOOPS

LOOP DETECTOR LAYOUT
Vicinity of Kaimakani Street Overpass
Not to Scale

GENERAL NOTES

- The locations of new inductance loops shall be staked out in the field by the Contractor and approved by the Engineer prior to installation.
- The Contractor shall inform the Engineer at least three days prior to saw-cutting pavement and installing inductance loops.
- Continuity of inductance loops and lead-in wires shall be tested and warranted for one year from date of acceptance by the Contractor.
- The Contractor shall restore all affected areas to their original condition. This item of work shall not be paid for separately, but shall be considered incidental to work of other paid items.
- The Contractor shall verify the locations of the existing utilities and underground structures whether or not shown on plans.
- The Contractor shall assume that existing underground utilities not shown on the plans may exist, therefore, he shall contact the different utility companies for information and toning.
- The Contractor shall be held liable for any damages incurred to the existing utilities and underground structures as a result of his operations. All damaged portions shall be replaced in accordance with the standards and specifications of the affected utility company at no cost to the STATE.
- Changes to the contract plans and specifications shall not be permitted, unless otherwise authorized by the Engineer upon written justification and request for approval by the Contractor.

LOOP LAYOUT NOTES


- Detector loop shall consist of three turns of 1/C #12 cable meeting IMSA SPEC 5I-5 or equivalent embedded in a 3/8" minimum sawcut, except as noted.
- Loop and lead-in to the first pullbox shall be one continuous wire. Lead-in wires from the same loop shall be twisted in pairs, two turns per foot. DO NOT twist one loop-pairs with another loop-pairs.
- All lead-in wires shall be crimped with open end lugs that will fit into the terminal board slots snugly.
- The Contractor shall connect the inductance wires on each terminal slot.
- The left lane in the direction of traffic flow is designated as Lane 1, and the lane next to its right as Lane 2 and so on as indicated on plans.
- Vacuum and clean sawcut thoroughly before installing sensors and/or cables and filling with approved sealant.
- All loop lead-in wires in all enclosures including pullboxes shall be identified and labeled by direction of traffic flow and lane numbers as shown on plans.
- All cables and wires terminated within an enclosure shall have a minimum 12" additional slack.

SURVEY PLOTTED BY	DATE
DRAWN BY	
TRACED BY	
NOTED BY	
QUANTITIES BY	
CHECKED BY	
ORIGINAL PLAN	
NOTE BOOK	
1/2" = 100'	
N. CONTINUED	

STATE OF HAWAII
DEPARTMENT OF TRANSPORTATION
HIGHWAYS DIVISION
LOOP DETECTOR PLAN
Vicinity of Kaimakani Street Overpass
INTERSTATE ROUTE H-1
RESURFACING
Kaimakani St. to Salt Lake Viaduct
Project No. H-IEF-01-06MR
Not to Scale Date: January 2007
SHEET No. 712 OF 15 SHEETS

FED. ROAD DIST. NO.	STATE	PROJ. NO.	FISCAL YEAR	SHEET NO.	TOTAL SHEETS
HAWAII	HAW.	H-IEF-01-06MR	2009	27	40

TRUE NORTH
SCALE: 1" = 20'

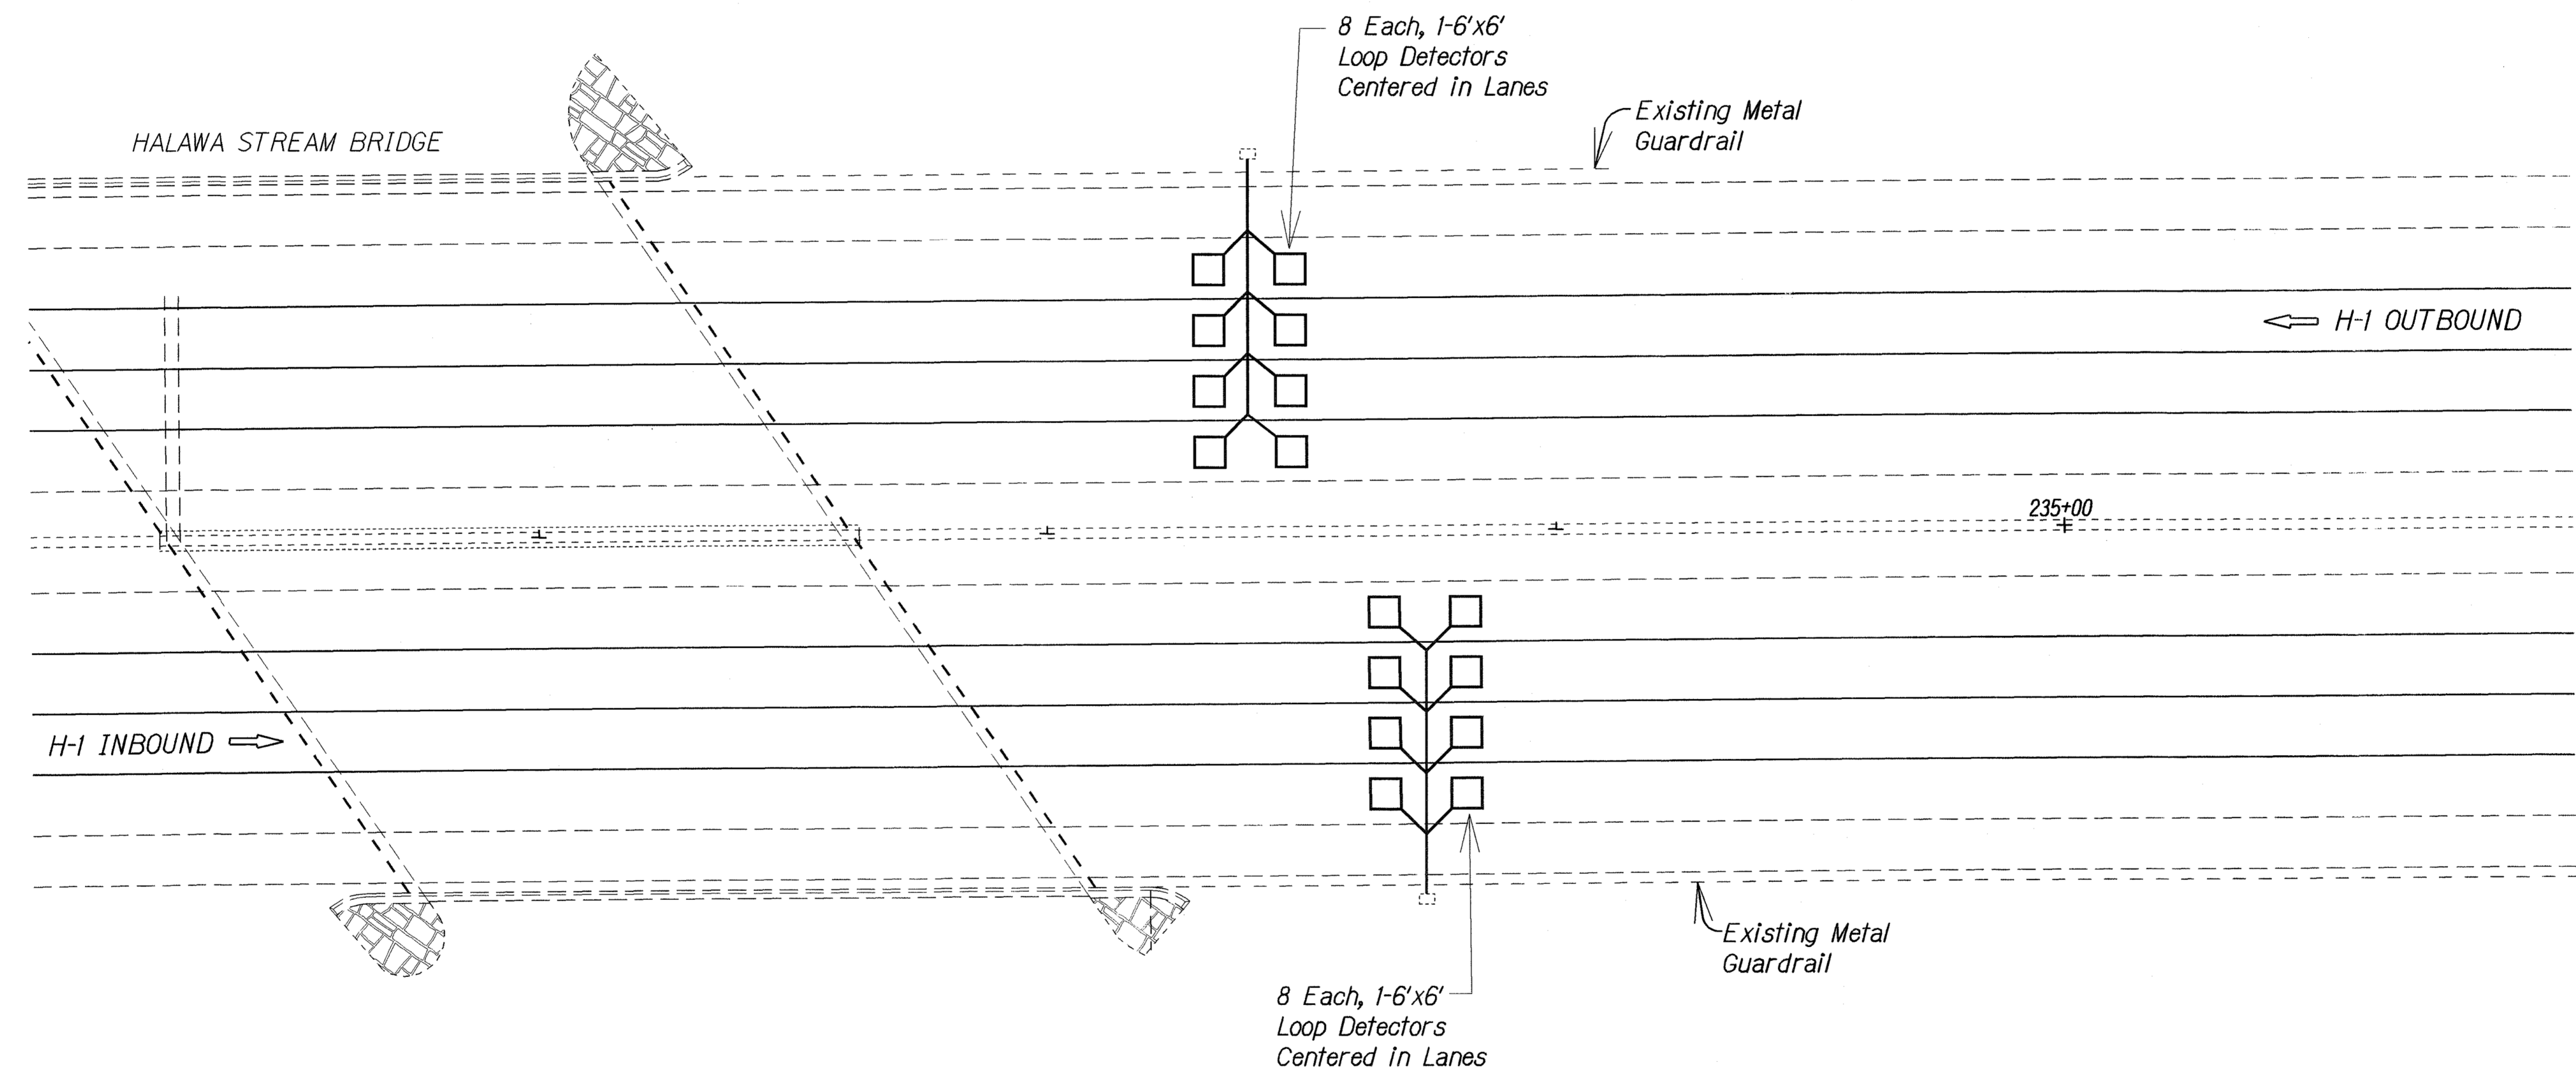


ORIGINAL PLAN	DATE
SURVEY PLOTTED BY	
DRAWN BY	
DESIGNED BY	
QUANTITIES BY	
CHECKED BY	
NOTE BOOK	
10/1/07	
N. [Signature]	

STATE OF HAWAII
DEPARTMENT OF TRANSPORTATION
HIGHWAYS DIVISION

LOOP DETECTOR PLAN
Vicinity of Halawa Stream Bridge
INTERSTATE ROUTE H-1
RESURFACING
Kaimakani St. to Salt Lake Viaduct
Project No. H-IEF-01-06MR
Scale: 1"=20' Date: January 2007

SHEET No. 27 OF 16 SHEETS


FED. ROAD DIST. NO.	STATE	PROJ. NO.	FISCAL YEAR	SHEET NO.	TOTAL SHEETS
HAWAII	HAW.	H-IEF-01-06MR	2009	28	40

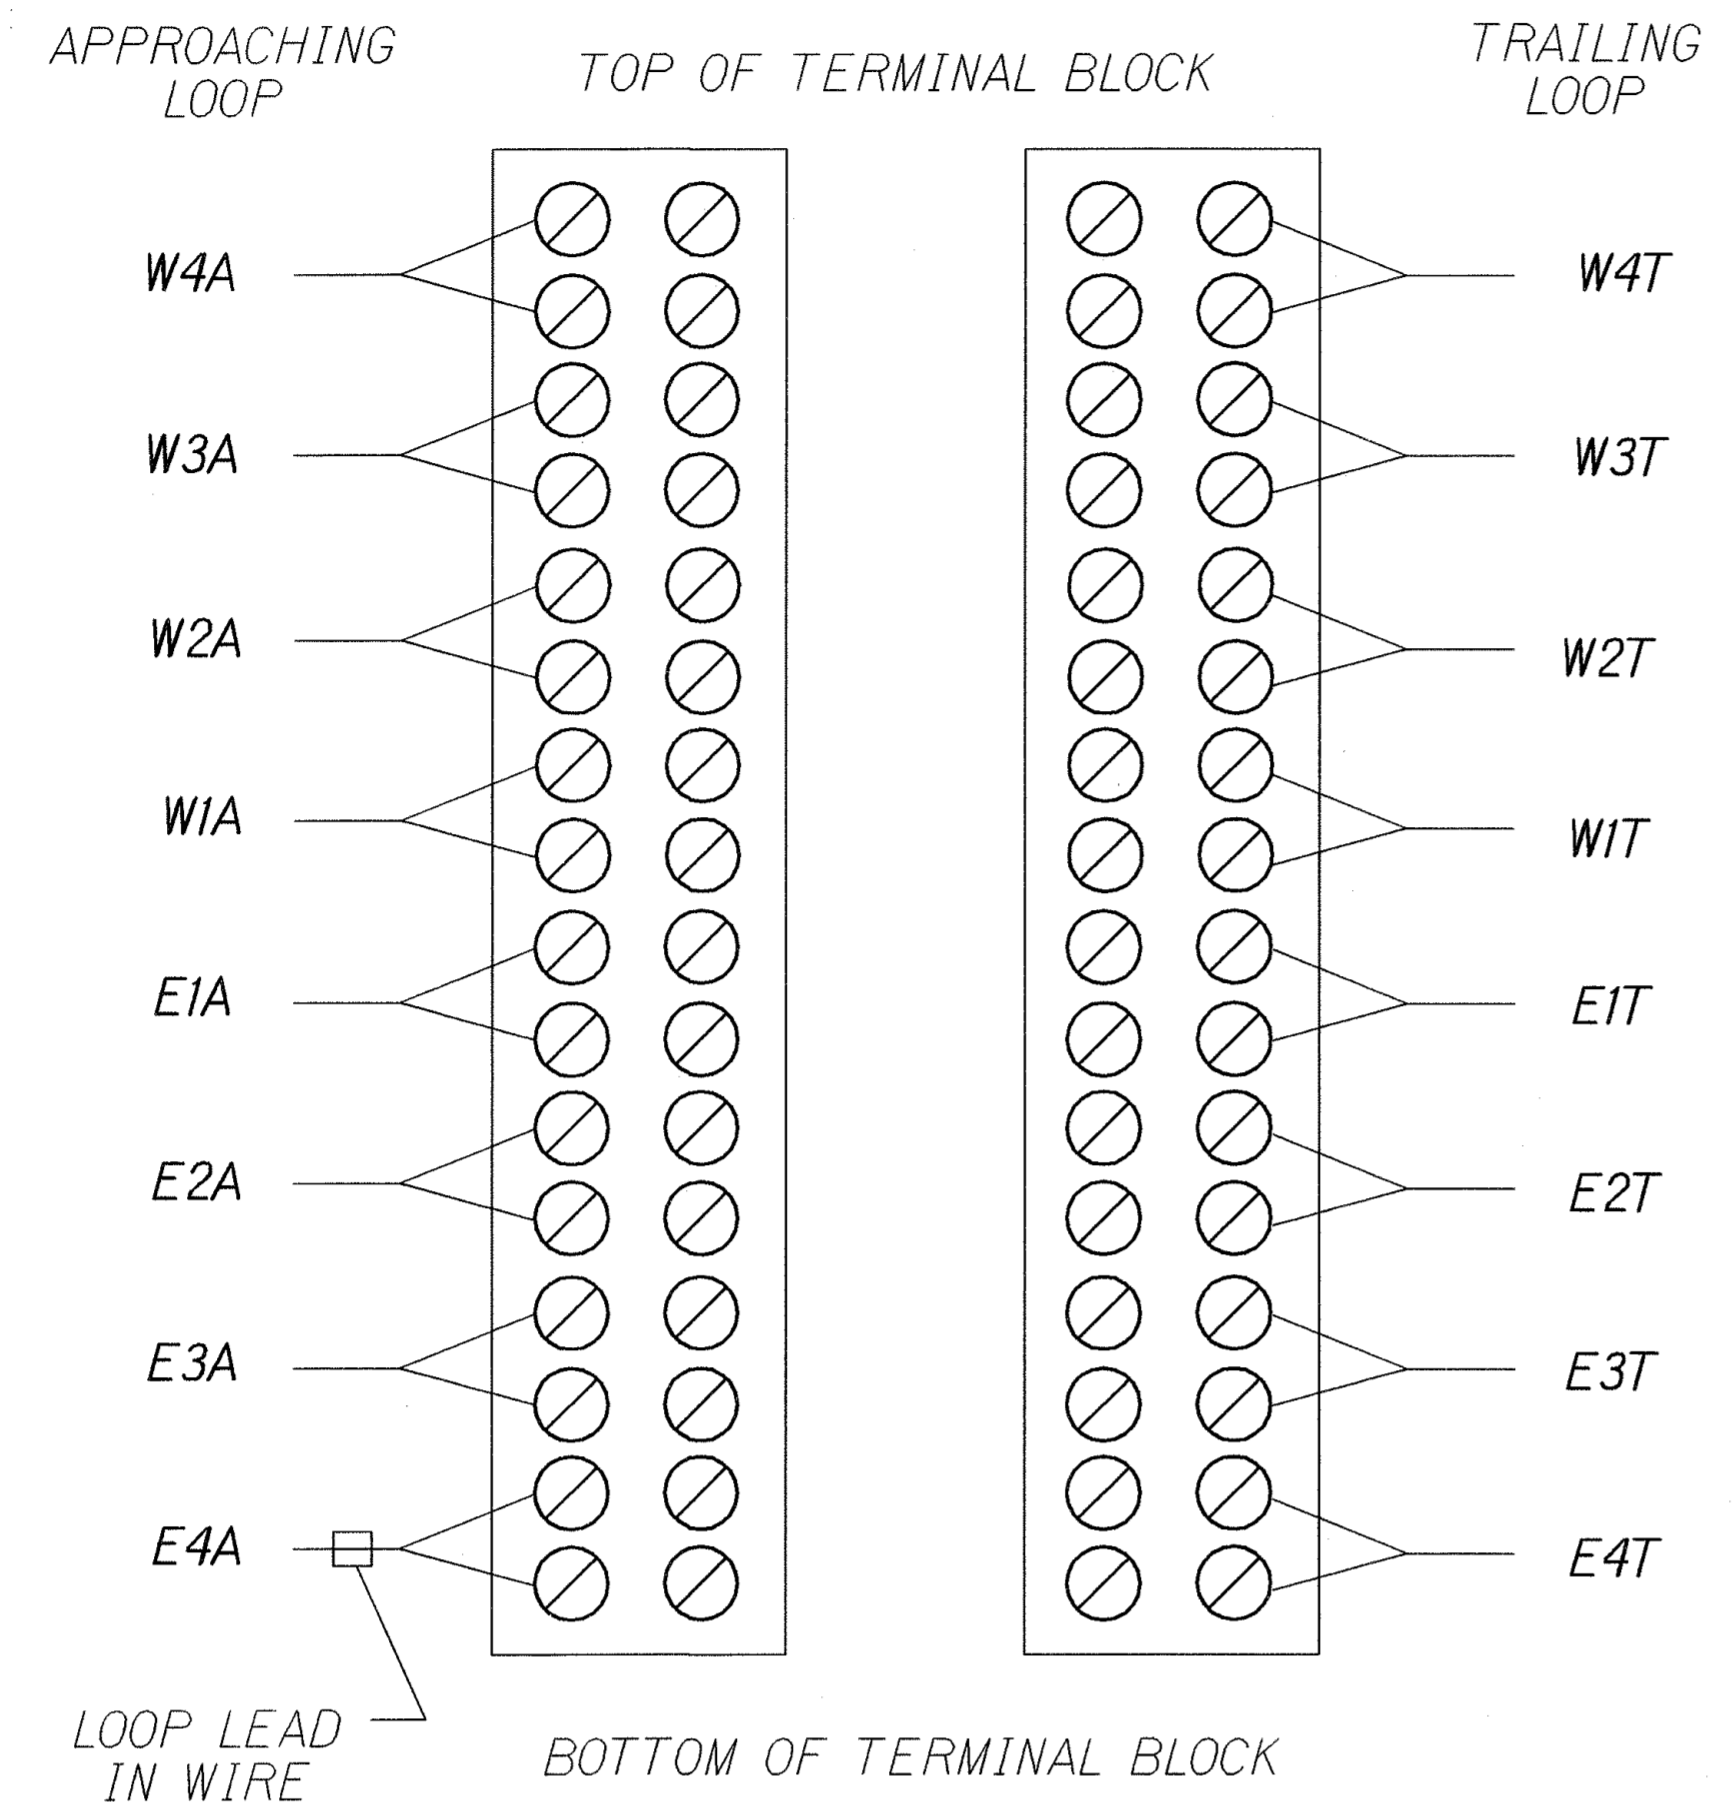

M-332
CABINET

CONNECTING LAYOUT OF LOOP LEAD-IN WIRES TO TERMINAL BLOCK INSIDE M-332 CABINET

LEGEND:
W = WEST
E = EAST
A = APPROACHING
T = TRAILING

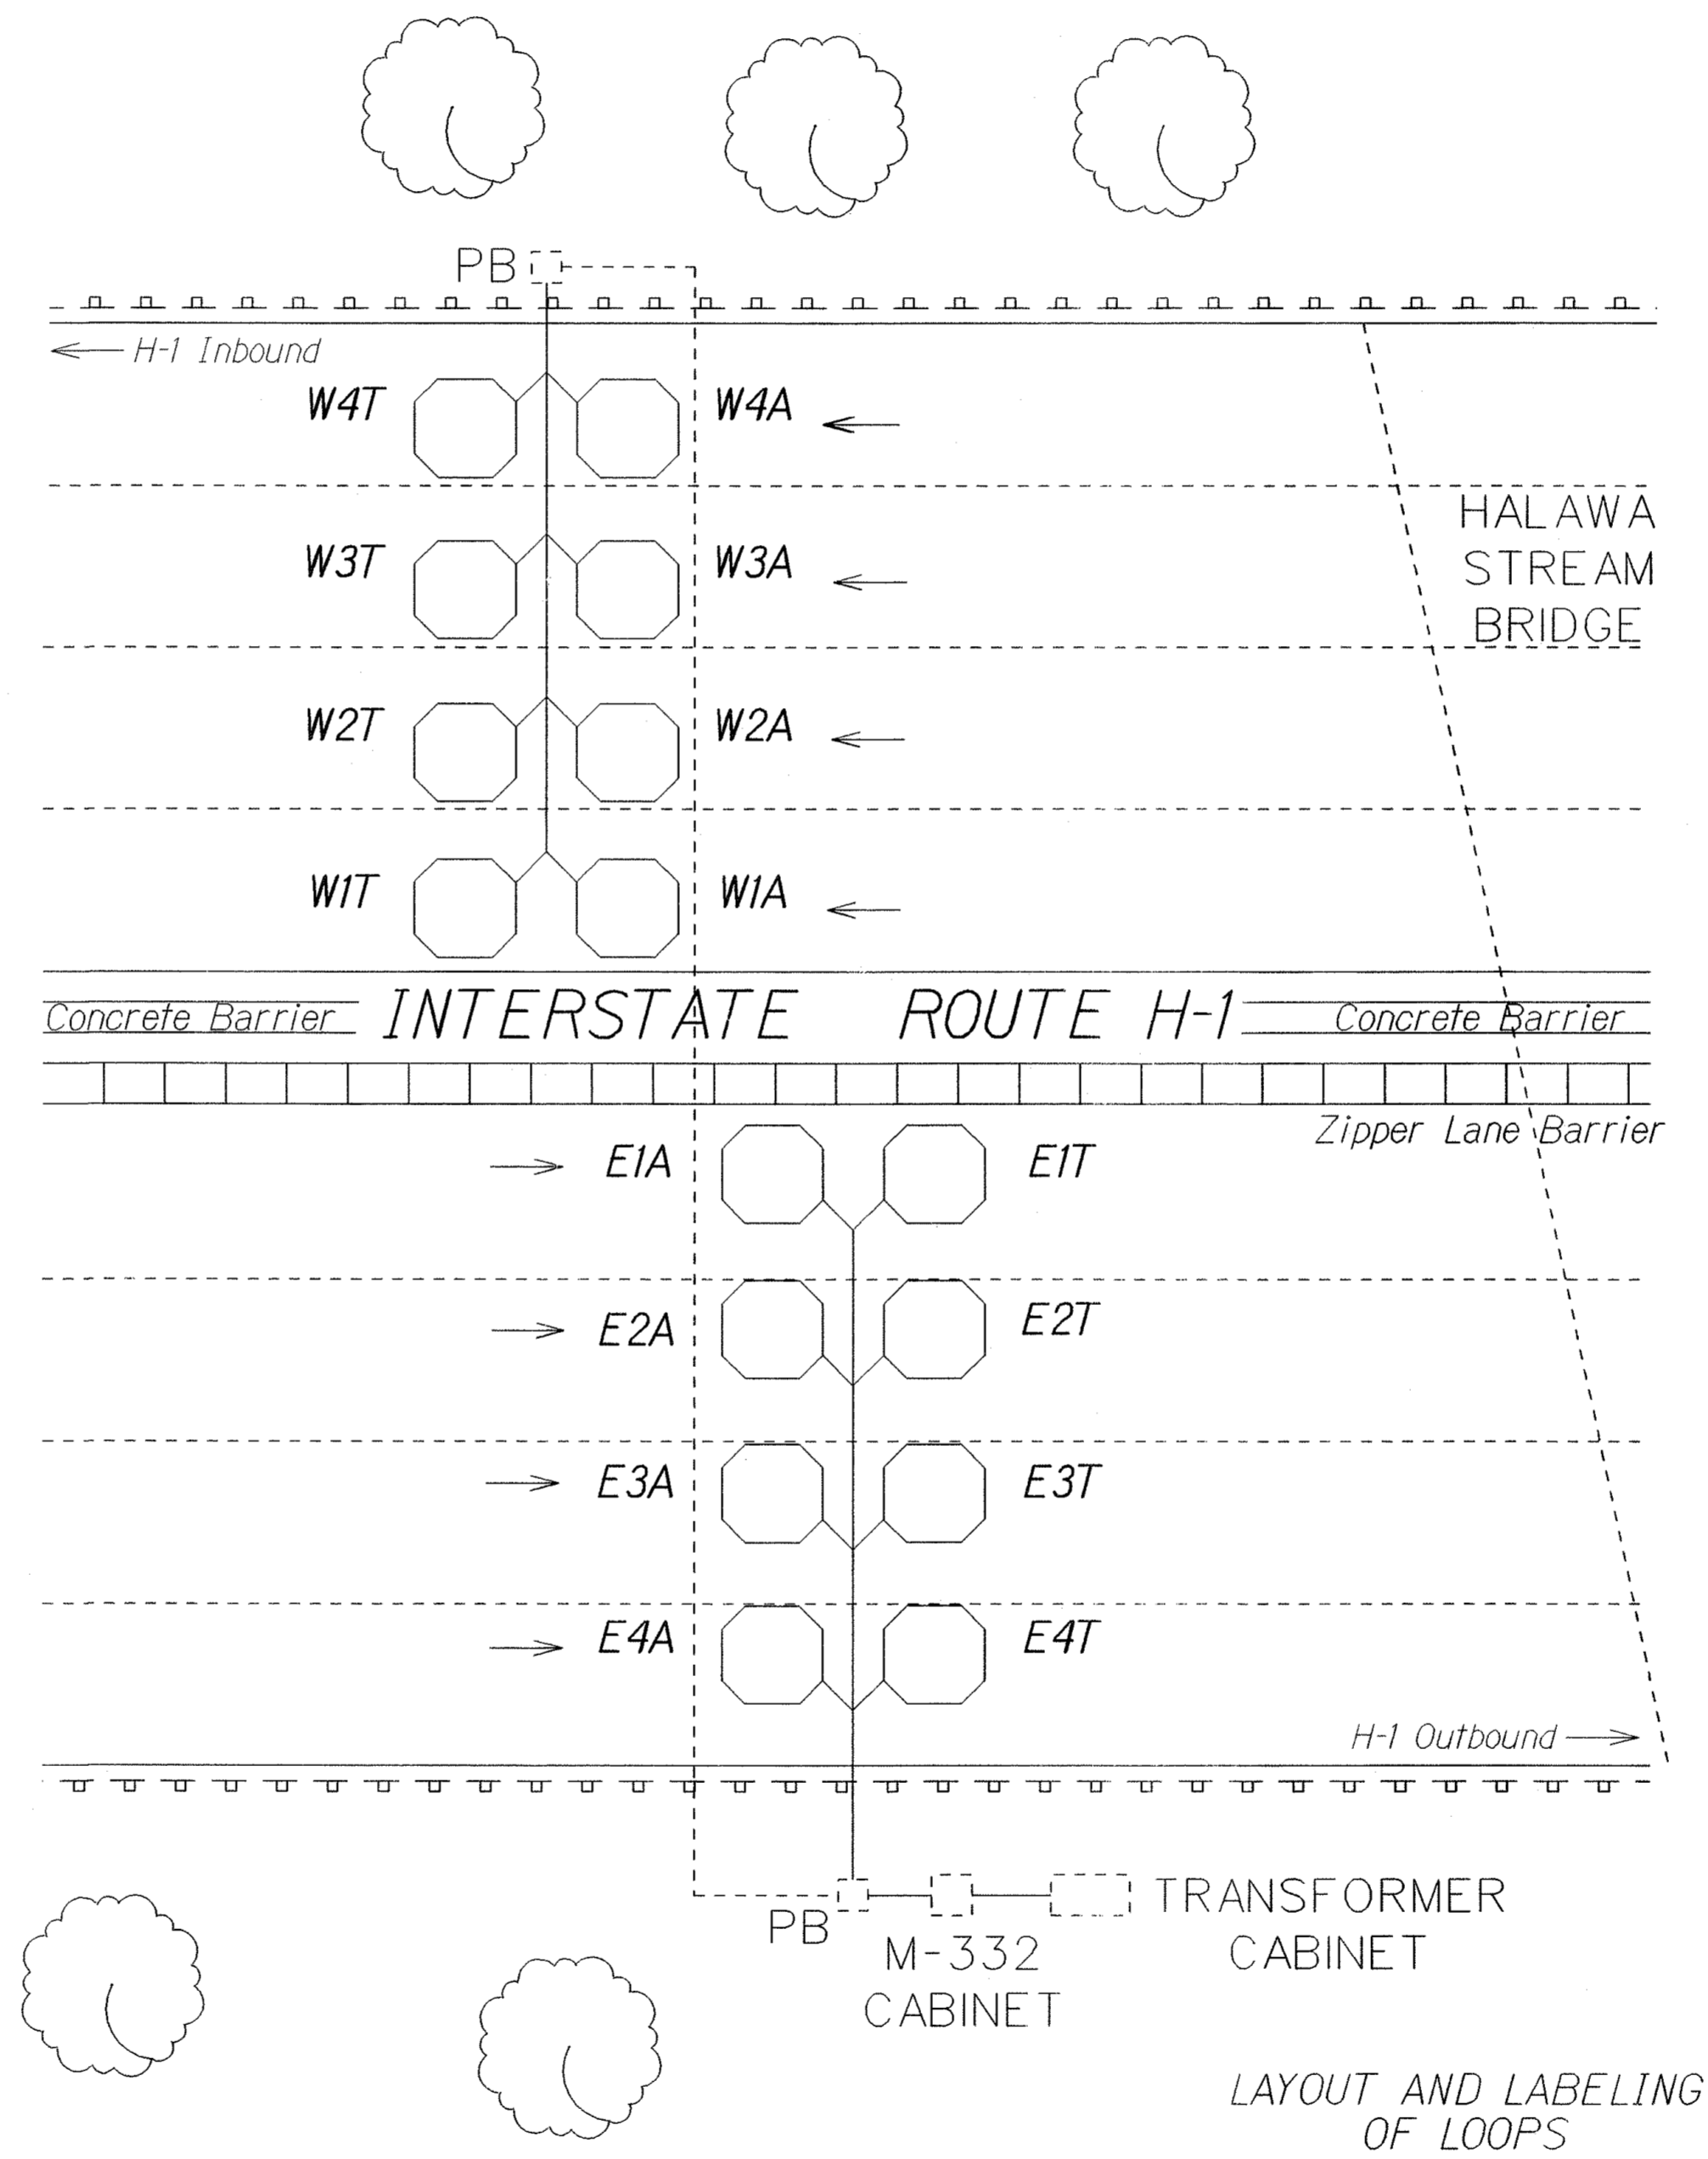

GENERAL NOTES

- The locations of new inductance loops shall be staked out in the field by the Contractor and approved by the Engineer prior to installation.
- The Contractor shall inform the Engineer at least three days prior to saw-cutting pavement and installing inductance loops.
- Continuity of inductance loops and lead-in wires shall be tested and warranted for one year from date of acceptance by the Contractor.
- The Contractor shall restore all affected areas to their original condition. This item of work shall not be paid for separately, but shall be considered incidental to work of other paid items.
- The Contractor shall verify the locations of the existing utilities and underground structures whether or not shown on plans.
- The Contractor shall assume that existing underground utilities not shown on the plans may exist, therefore, he shall contact the different utility companies for information and toning.
- The Contractor shall be held liable for any damages incurred to the existing utilities and underground structures as a result of his operations. All damaged portions shall be replaced in accordance with the standards and specifications of the affected utility company at no cost to the STATE.
- Changes to the contract plans and specifications shall not be permitted, unless otherwise authorized by the Engineer upon written justification and request for approval by the Contractor.

LOOP LAYOUT NOTES

- Detector loop shall consist of three turns of 1/2" #12 cable meeting IMSA SPEC 51-5 or equivalent embedded in a 3/8" minimum sawcut, except as noted.
- Loop and lead-in to the first pullbox shall be one continuous wire. Lead-in wires from the same loop shall be twisted in pairs, two turns per foot. DO NOT twist one loop-pairs with another loop-pairs.
- All lead-in wires shall be crimped with open end lugs that will fit into the terminal board slots snugly.
- The Contractor shall connect the inductance wires on each terminal slot.
- The left lane in the direction of traffic flow is designated as Lane 1, and the lane next to its right as Lane 2 and so on as indicated on plans.
- Vacuum and clean sawcut thoroughly before installing sensors and/or cables and filling with approved sealant.
- All loop lead-in wires in all enclosures including pullboxes shall be identified and labeled by direction of traffic flow and lane numbers as shown on plans.
- All cables and wires terminated within an enclosure shall have a minimum 12" additional slack.

DESIGNED BY	DATE
DRAWN BY	
CHECKED BY	
APPROVED BY	
DATE	


LOOP DETECTOR LAYOUT
Vicinity of Halawa Stream Bridge
Not to Scale

STATE OF HAWAII
DEPARTMENT OF TRANSPORTATION
HIGHWAYS DIVISION

LOOP DETECTOR PLAN
Vicinity of Halawa Stream Bridge
INTERSTATE ROUTE H-1
RESURFACING
Kaimakani St. to Salt Lake Viaduct
Project No. H-IEF-01-06MR
Not to Scale Date: January 2007


SHEET No. 114 OF 115 SHEETS

FED. ROAD DIST. NO.	STATE	PROJ. NO.	FISCAL YEAR	SHEET NO.	TOTAL SHEETS
HAWAII	HAW.	H-IEF-01-06MR	2009	29	40

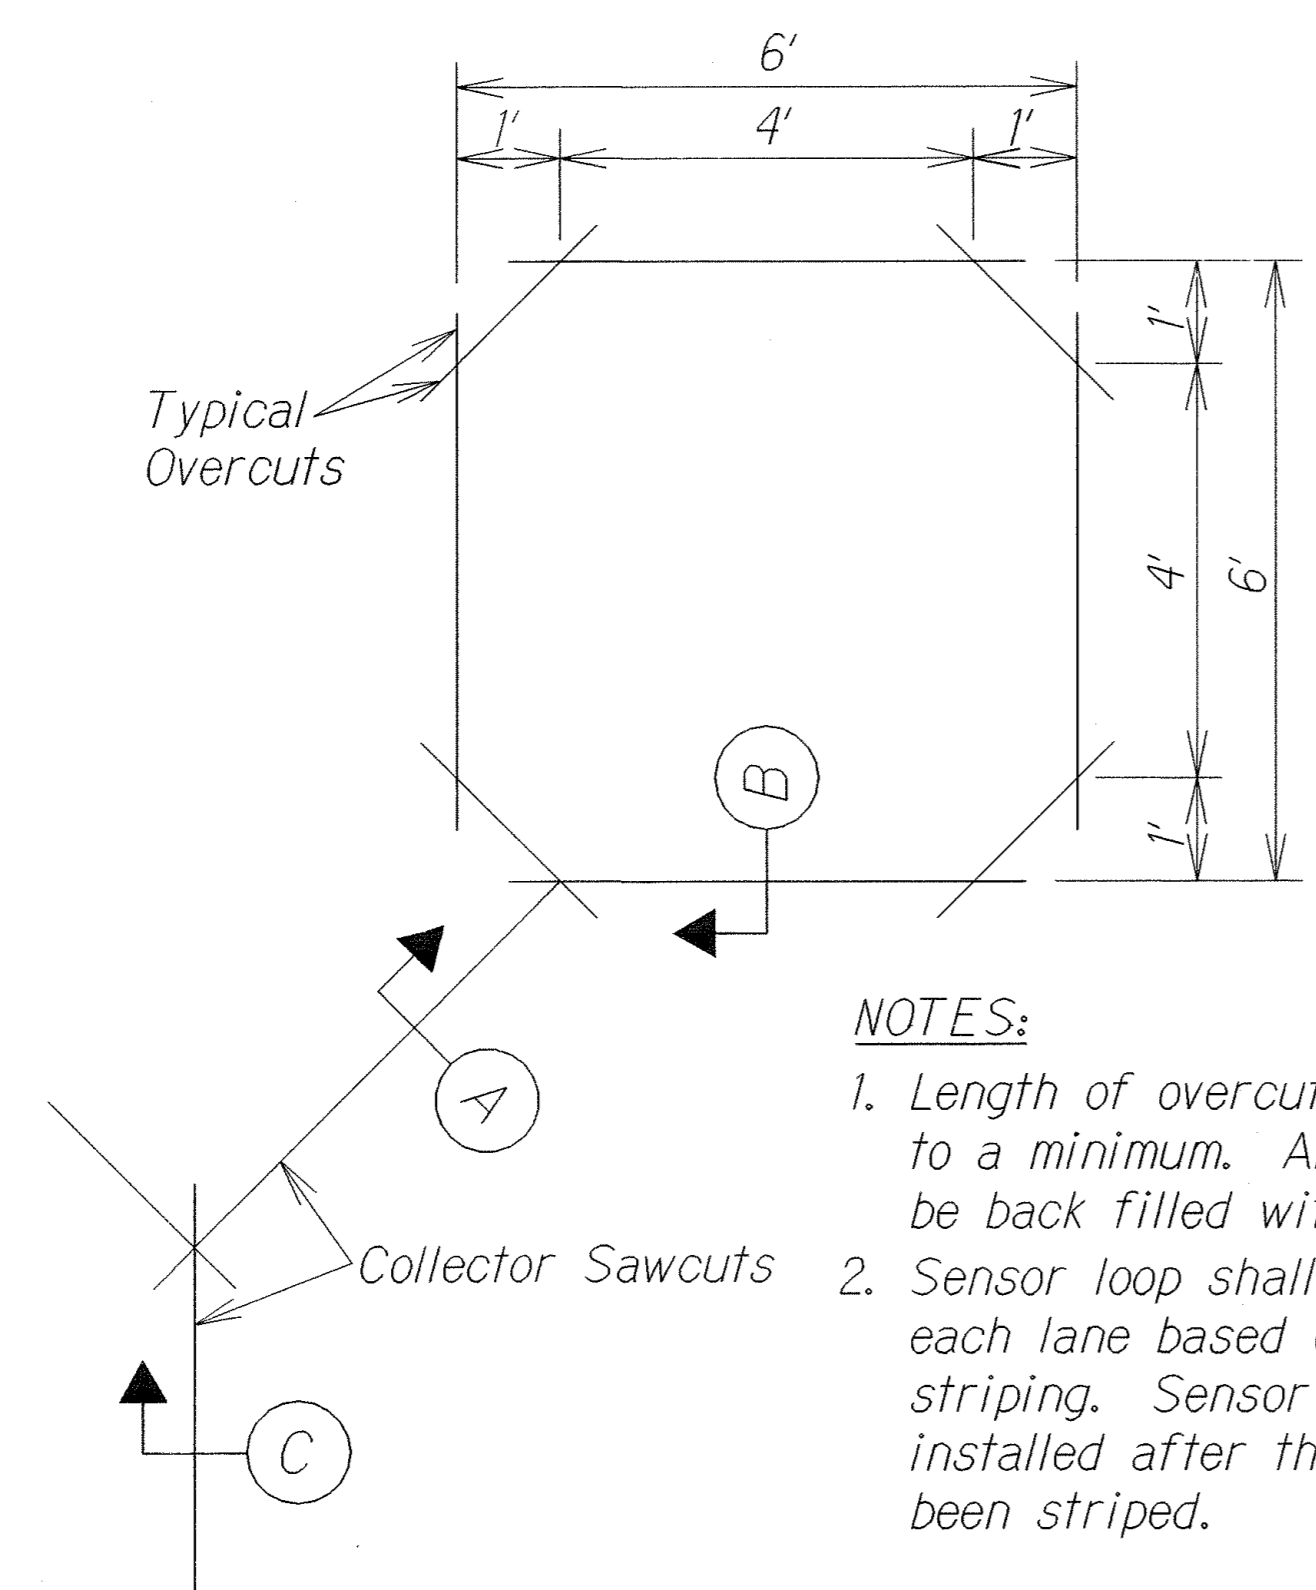


- NOTES:**
1. Length of overcuts shall be kept to a minimum. All overcuts shall be back filled with approved sealant.
 2. Sensor loop shall be centered in each lane based on the final lane striping. Sensor loop shall be installed after the roadway has been striped.

TYPICAL SENSOR LOOP SAWCUT DETAIL
Not to Scale

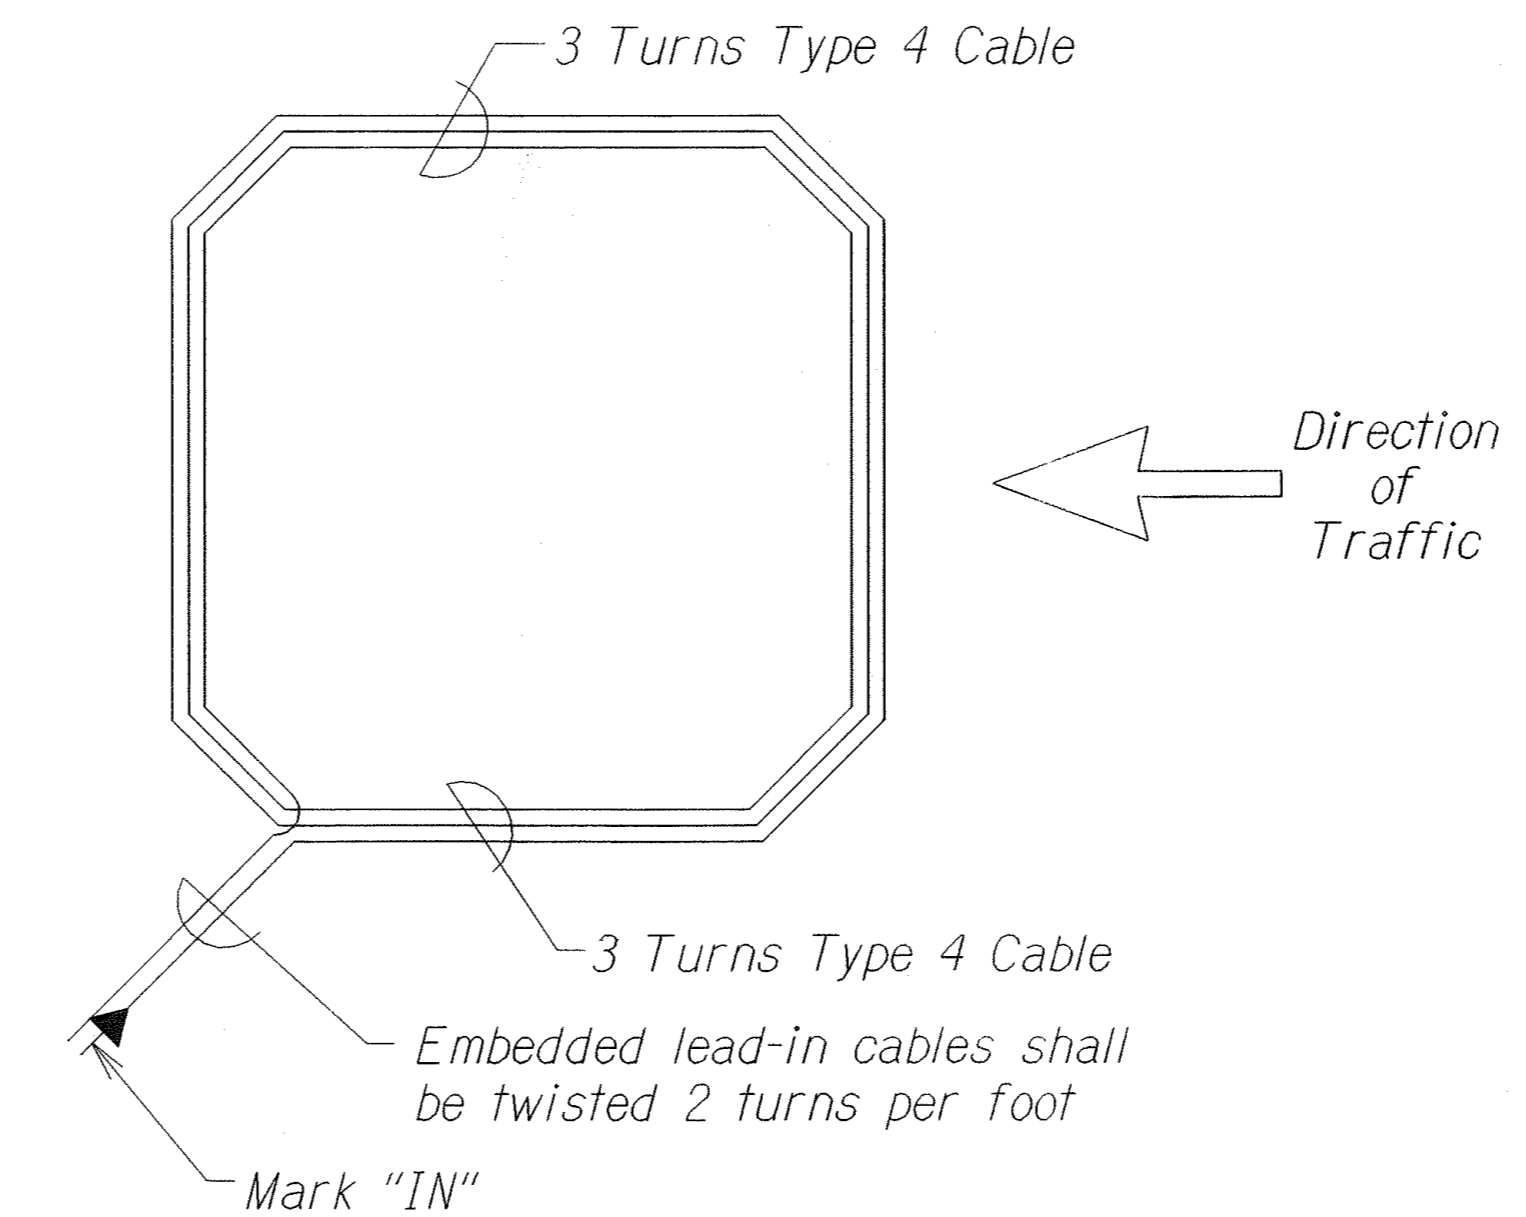


TYPICAL SENSOR LOOP WIRING DIAGRAM
Not to Scale

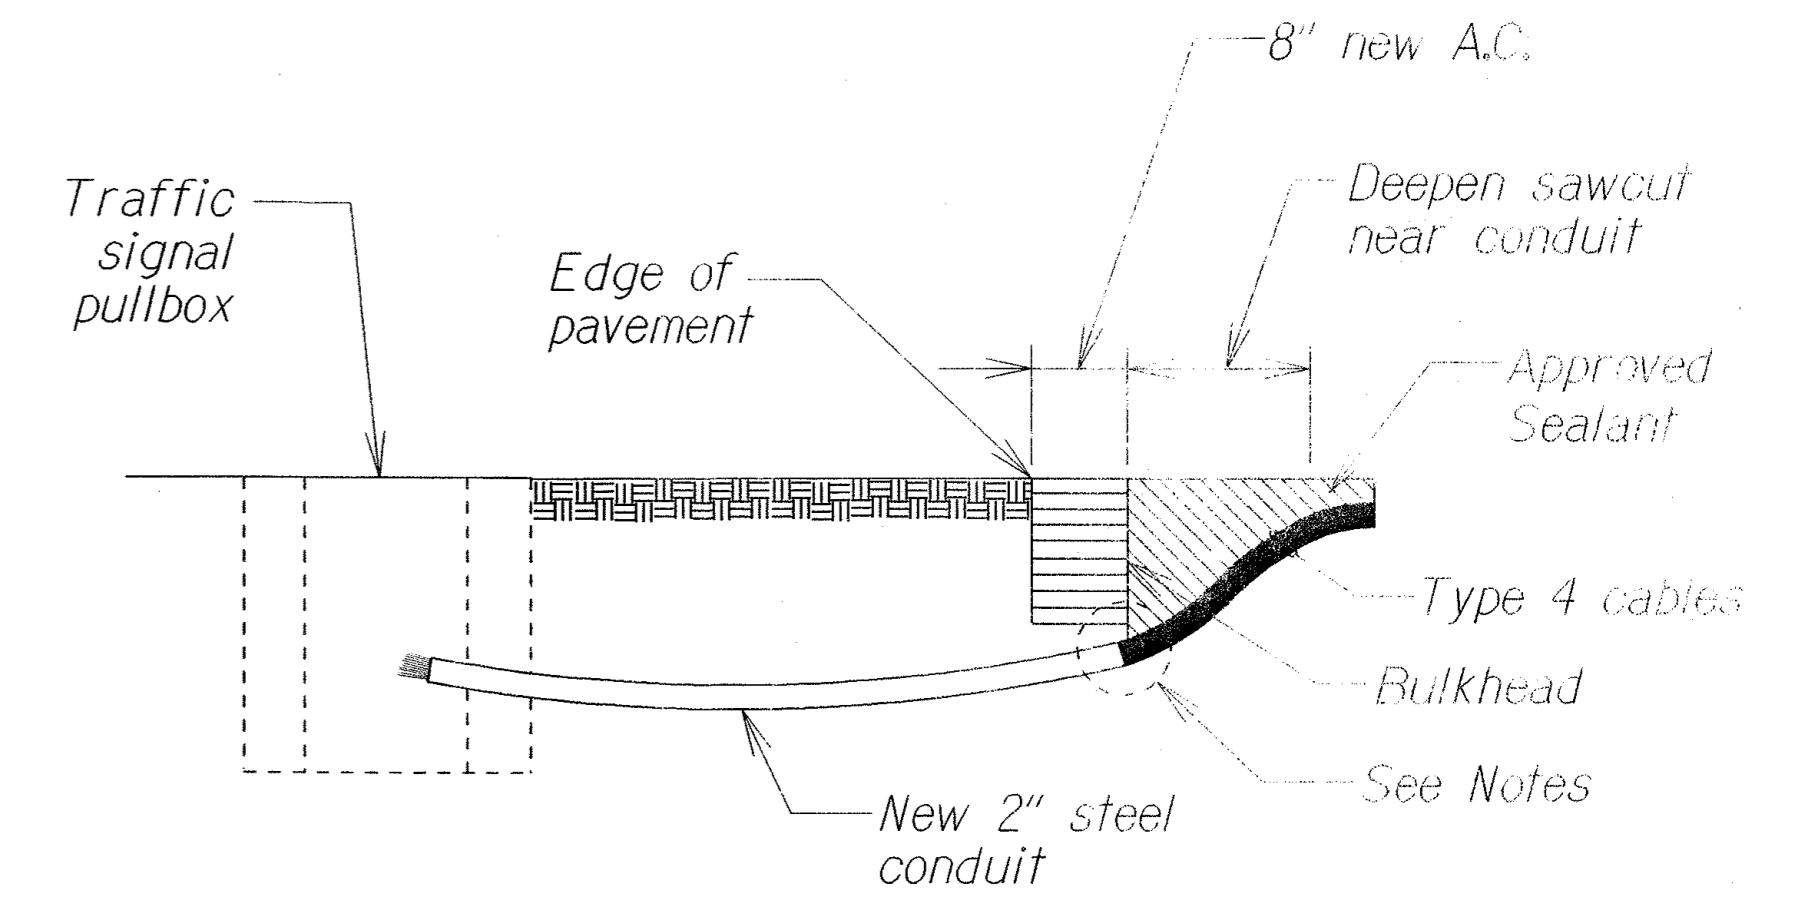


- NOTES ON CONSTRUCTION AT END OF SAWCUT:**
1. Seal roadway end of conduit after installation of conductors.
 2. Install bulkhead across conduit trench.
 3. Place approved sealant in sawcut.
 4. Backfill over conduit with new A.C.

CONDUIT TO SAWCUT TRANSITION
Not to Scale

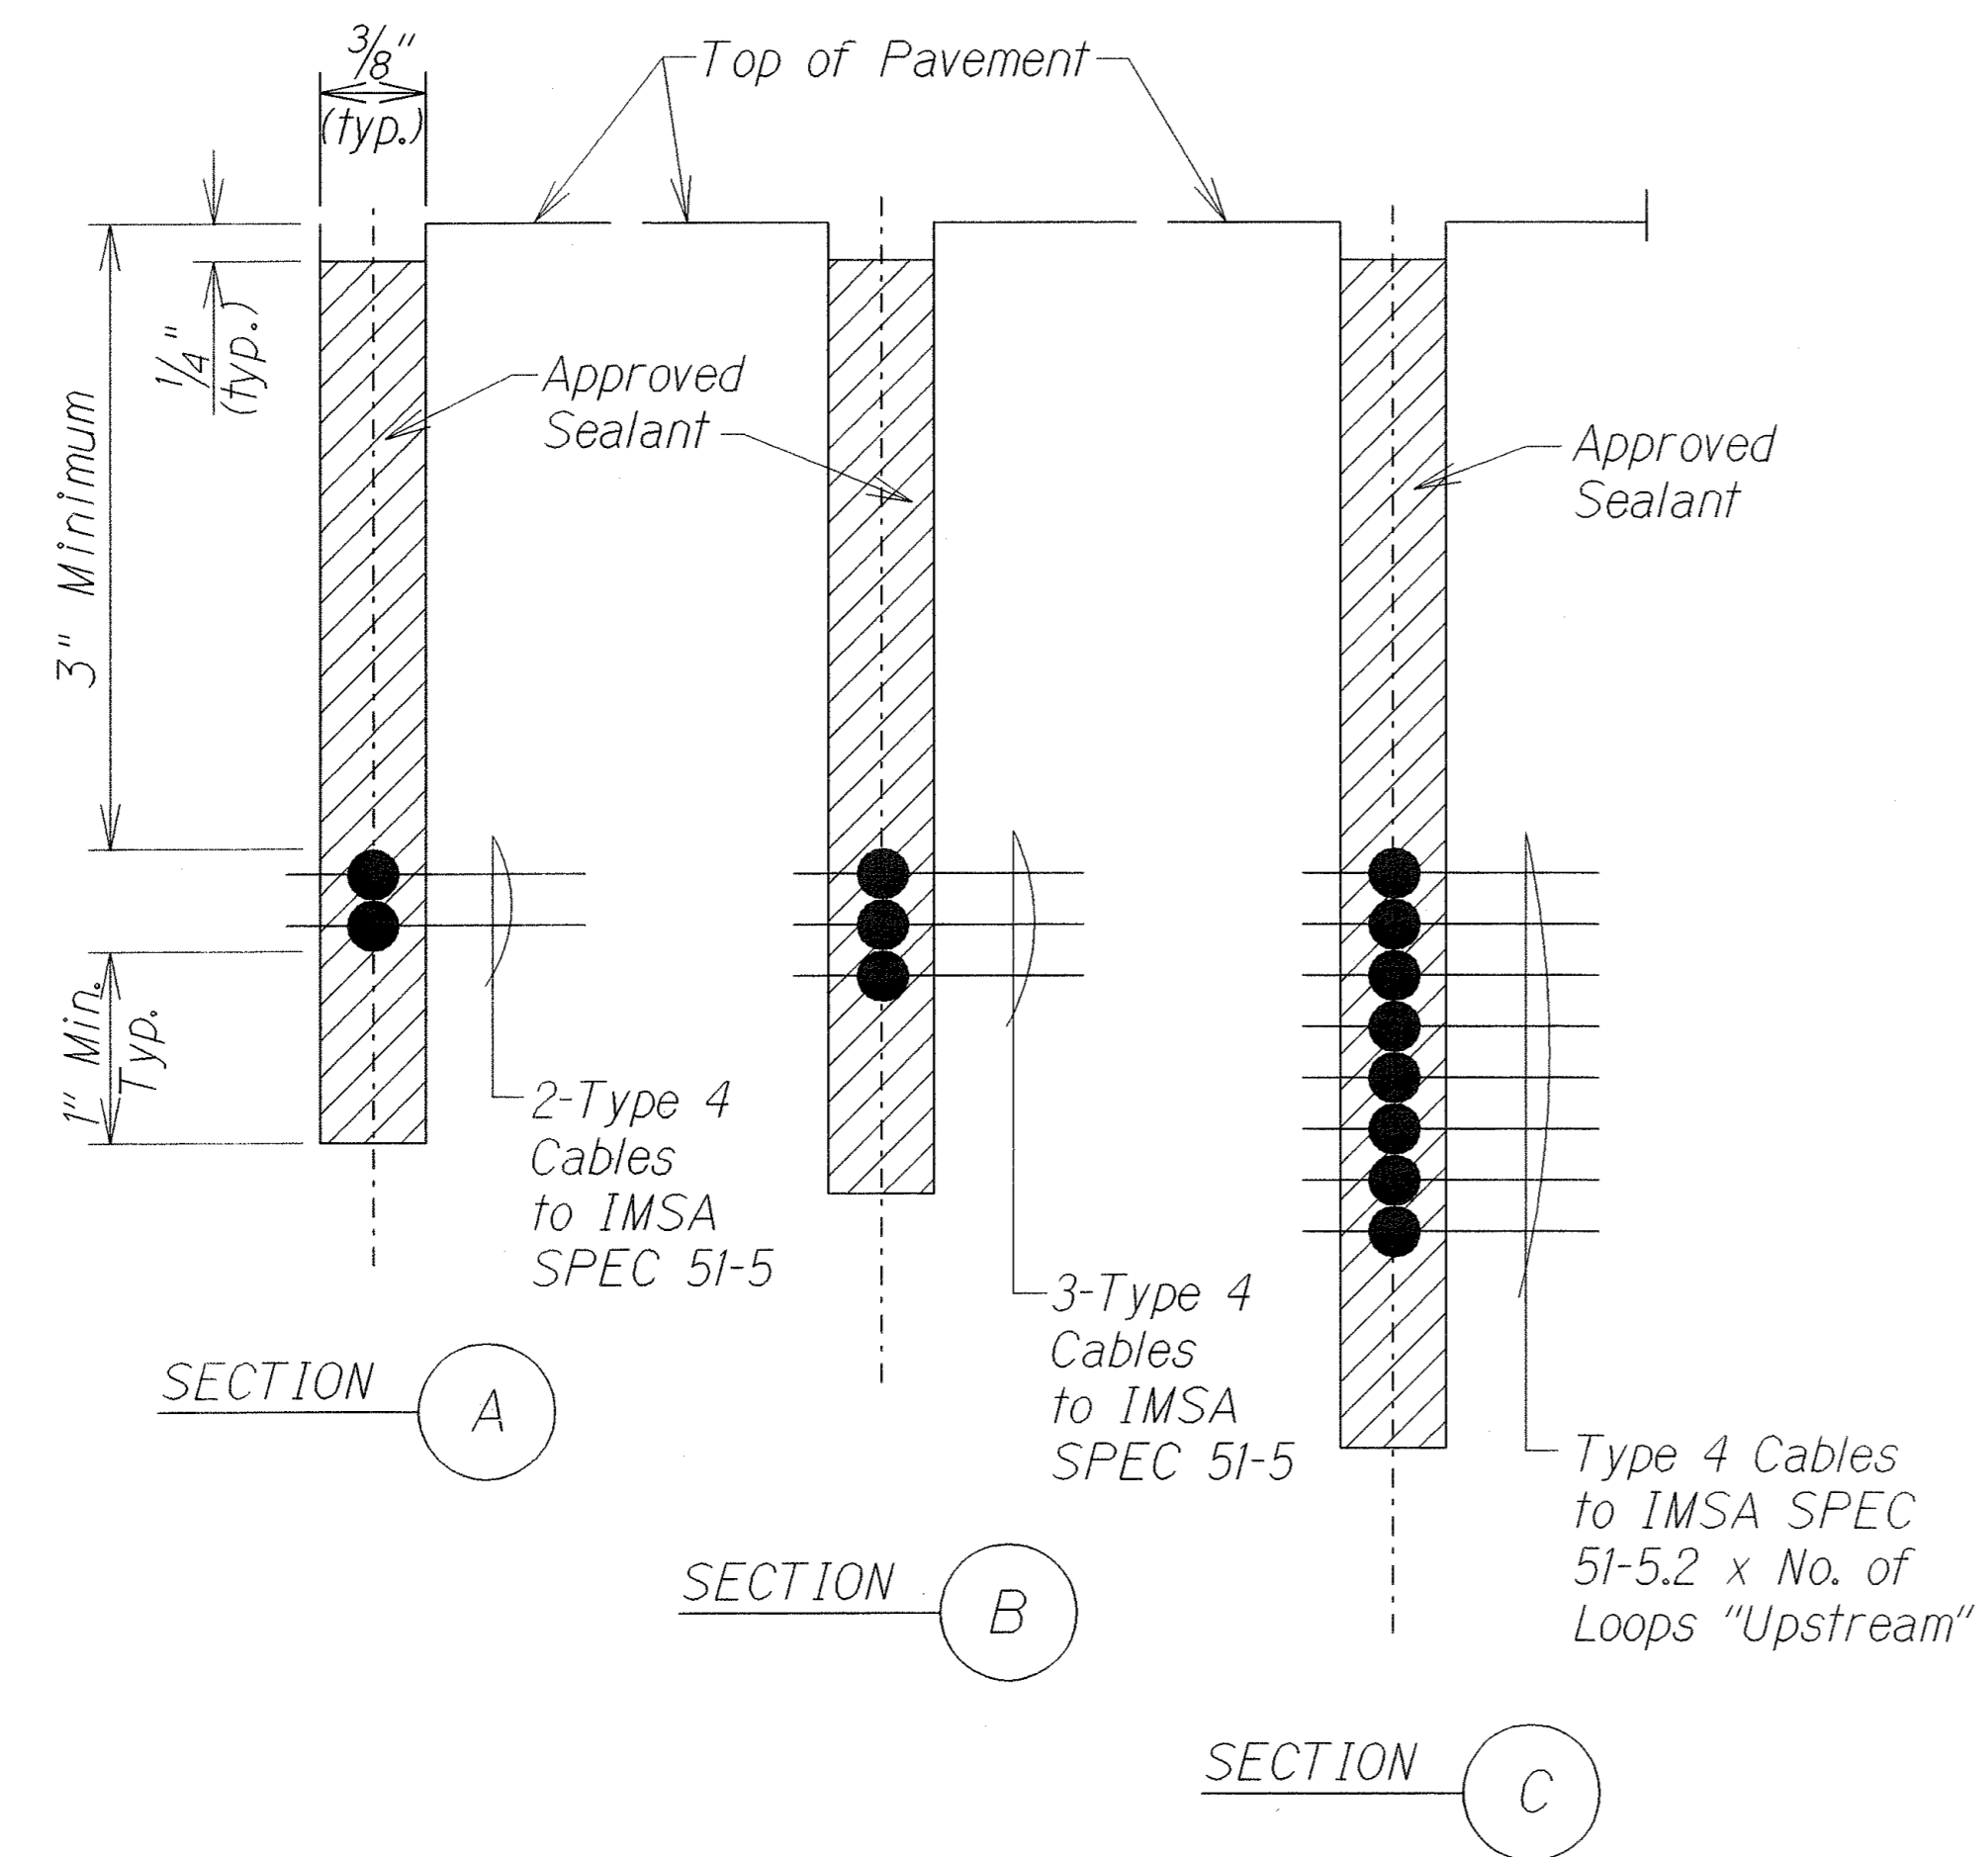

TYPICAL SECTION THROUGH SENSOR LOOP
Not to Scale

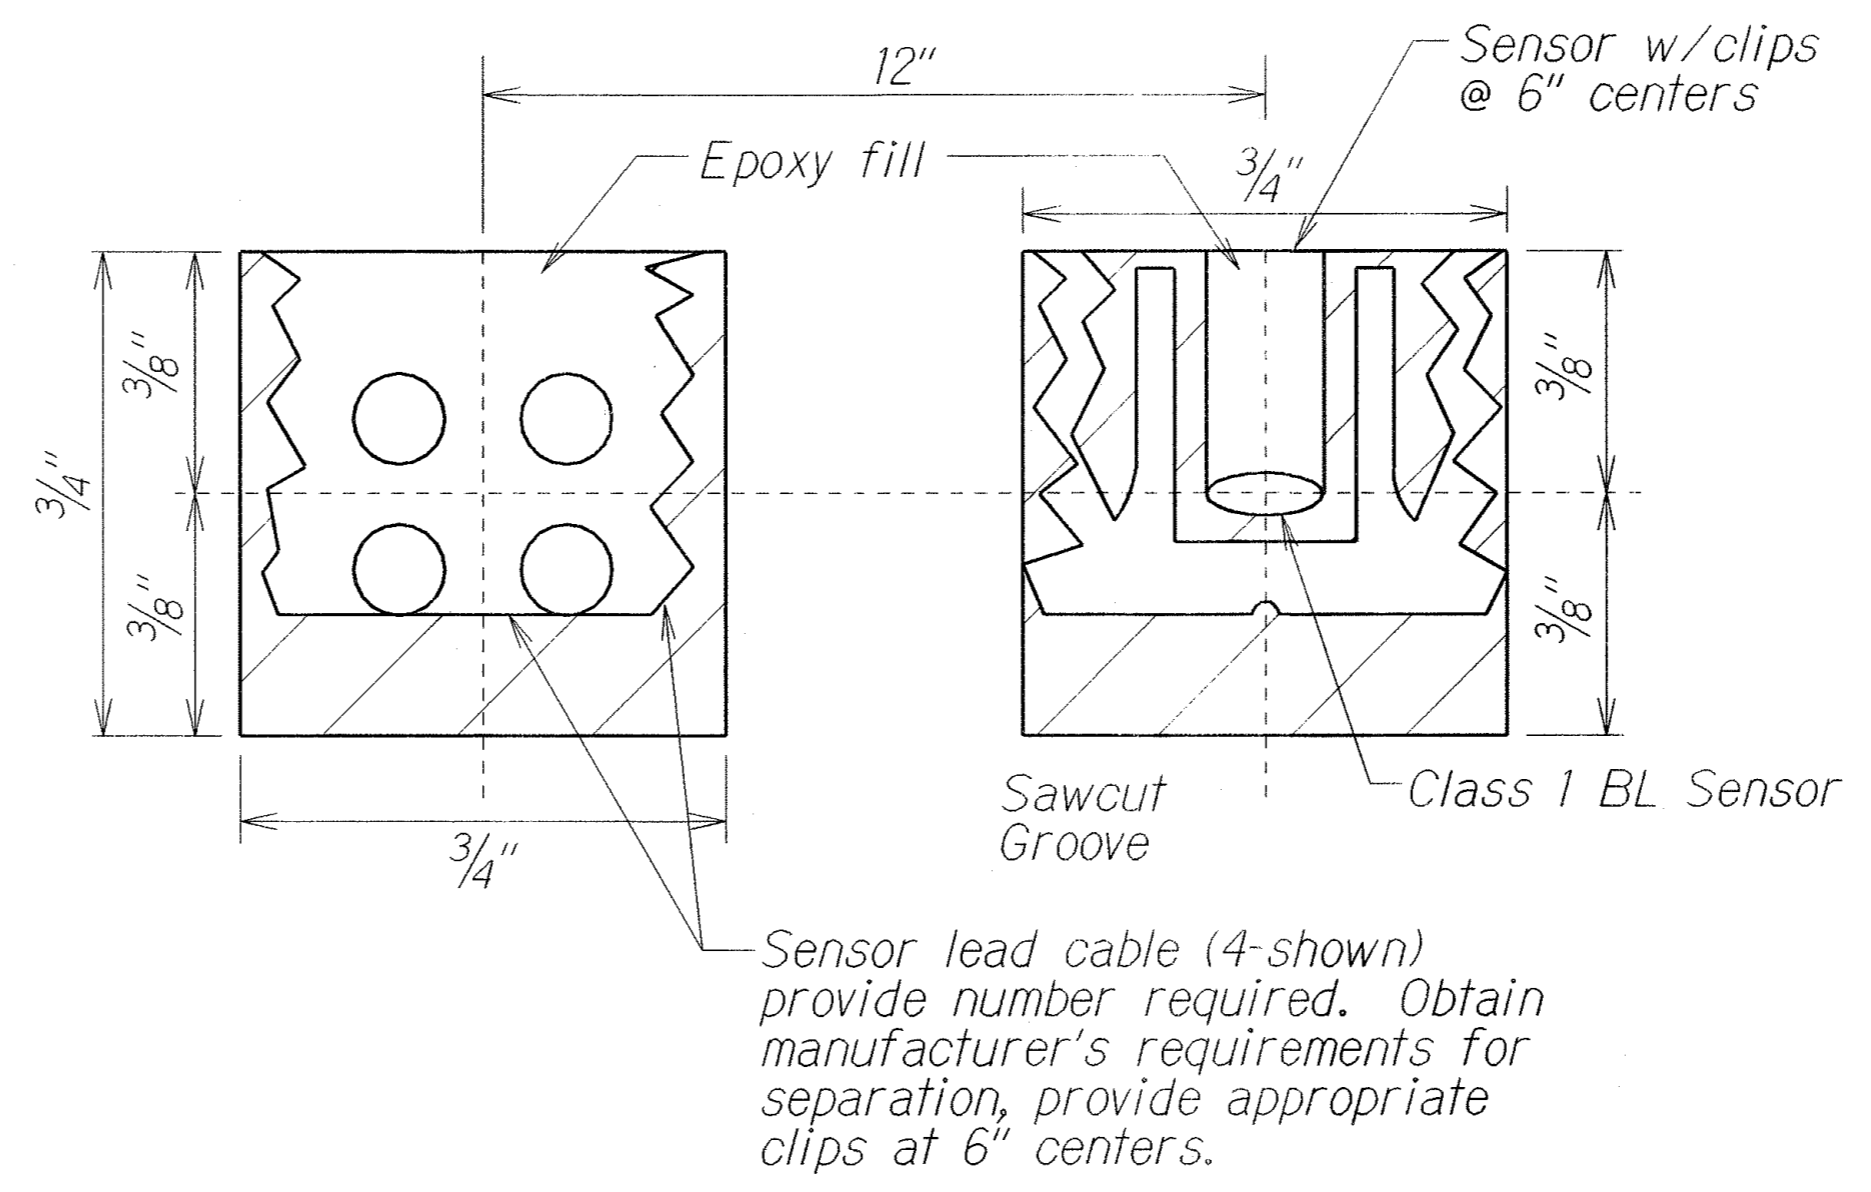


CLASS 1 BL SENSOR AND LEAD INSTALLATION DETAIL
Not to Scale


- NOTES:**
1. BL Sensors shall be terminated with "BNC" type connectors or connectors appropriate to the counting equipment (Automatic Traffic Recorder).
 2. BL Sensor shall be centered in each lane based on the final lane striping. BL sensor shall be installed after the roadway has been striped.

SURVEY PLOTTED BY	DATE
DESIGNED BY	
NOTED BY	
CHECKED BY	
ORIGINAL PLAN	
NOTE BOOK	
16/2/07	
N. 06/10/07	


STATE OF HAWAII
DEPARTMENT OF TRANSPORTATION
HIGHWAYS DIVISION
LOOP DETECTOR DETAIL
Vicinity of Kaimakani Street Overpass
INTERSTATE ROUTE H-1
RESURFACING
Kaimakani St. to Salt Lake Viaduct
Project No. H-IEF-01-06MR
Not to Scale Date: January 2007
SHEET No. 115 of 16 SHEETS

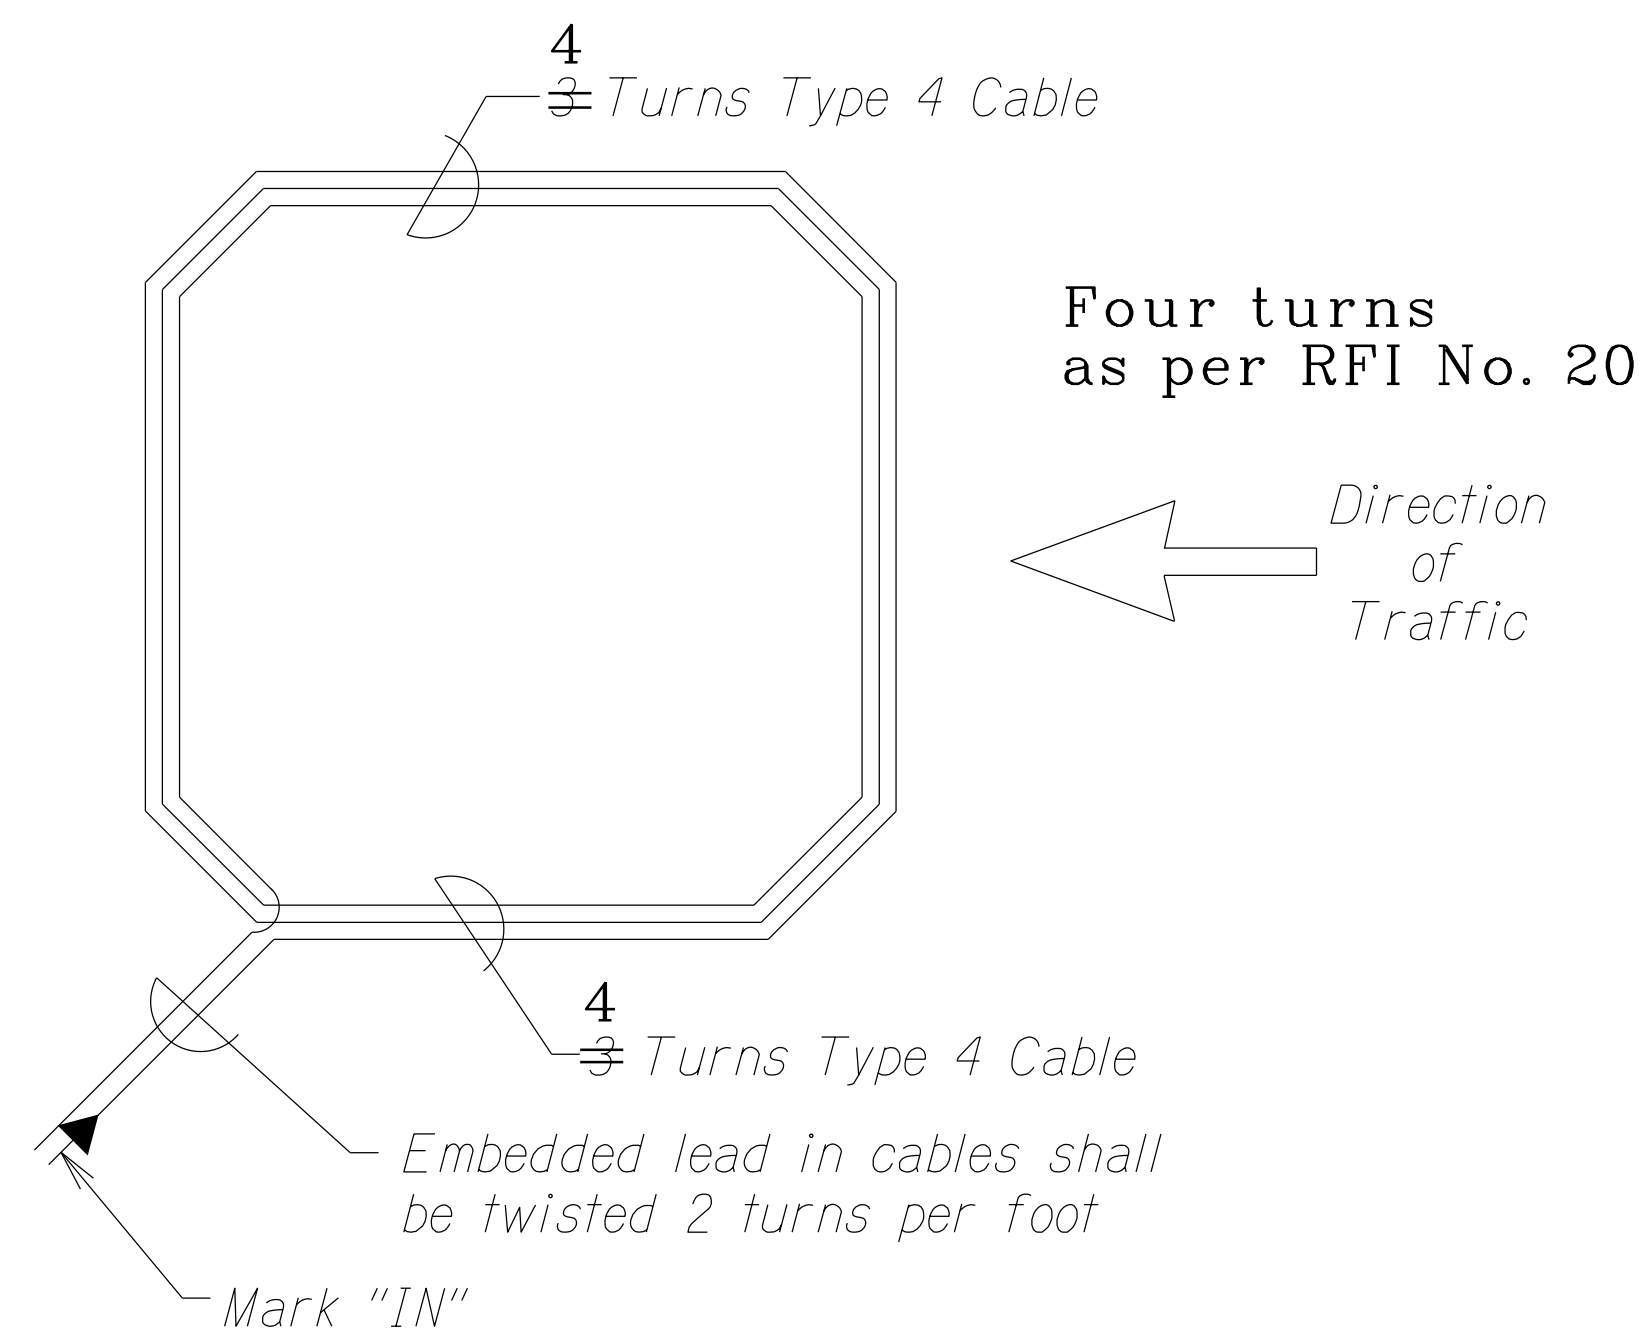

TYPICAL SENSOR LOOP WIRING DIAGRAM
Not to Scale

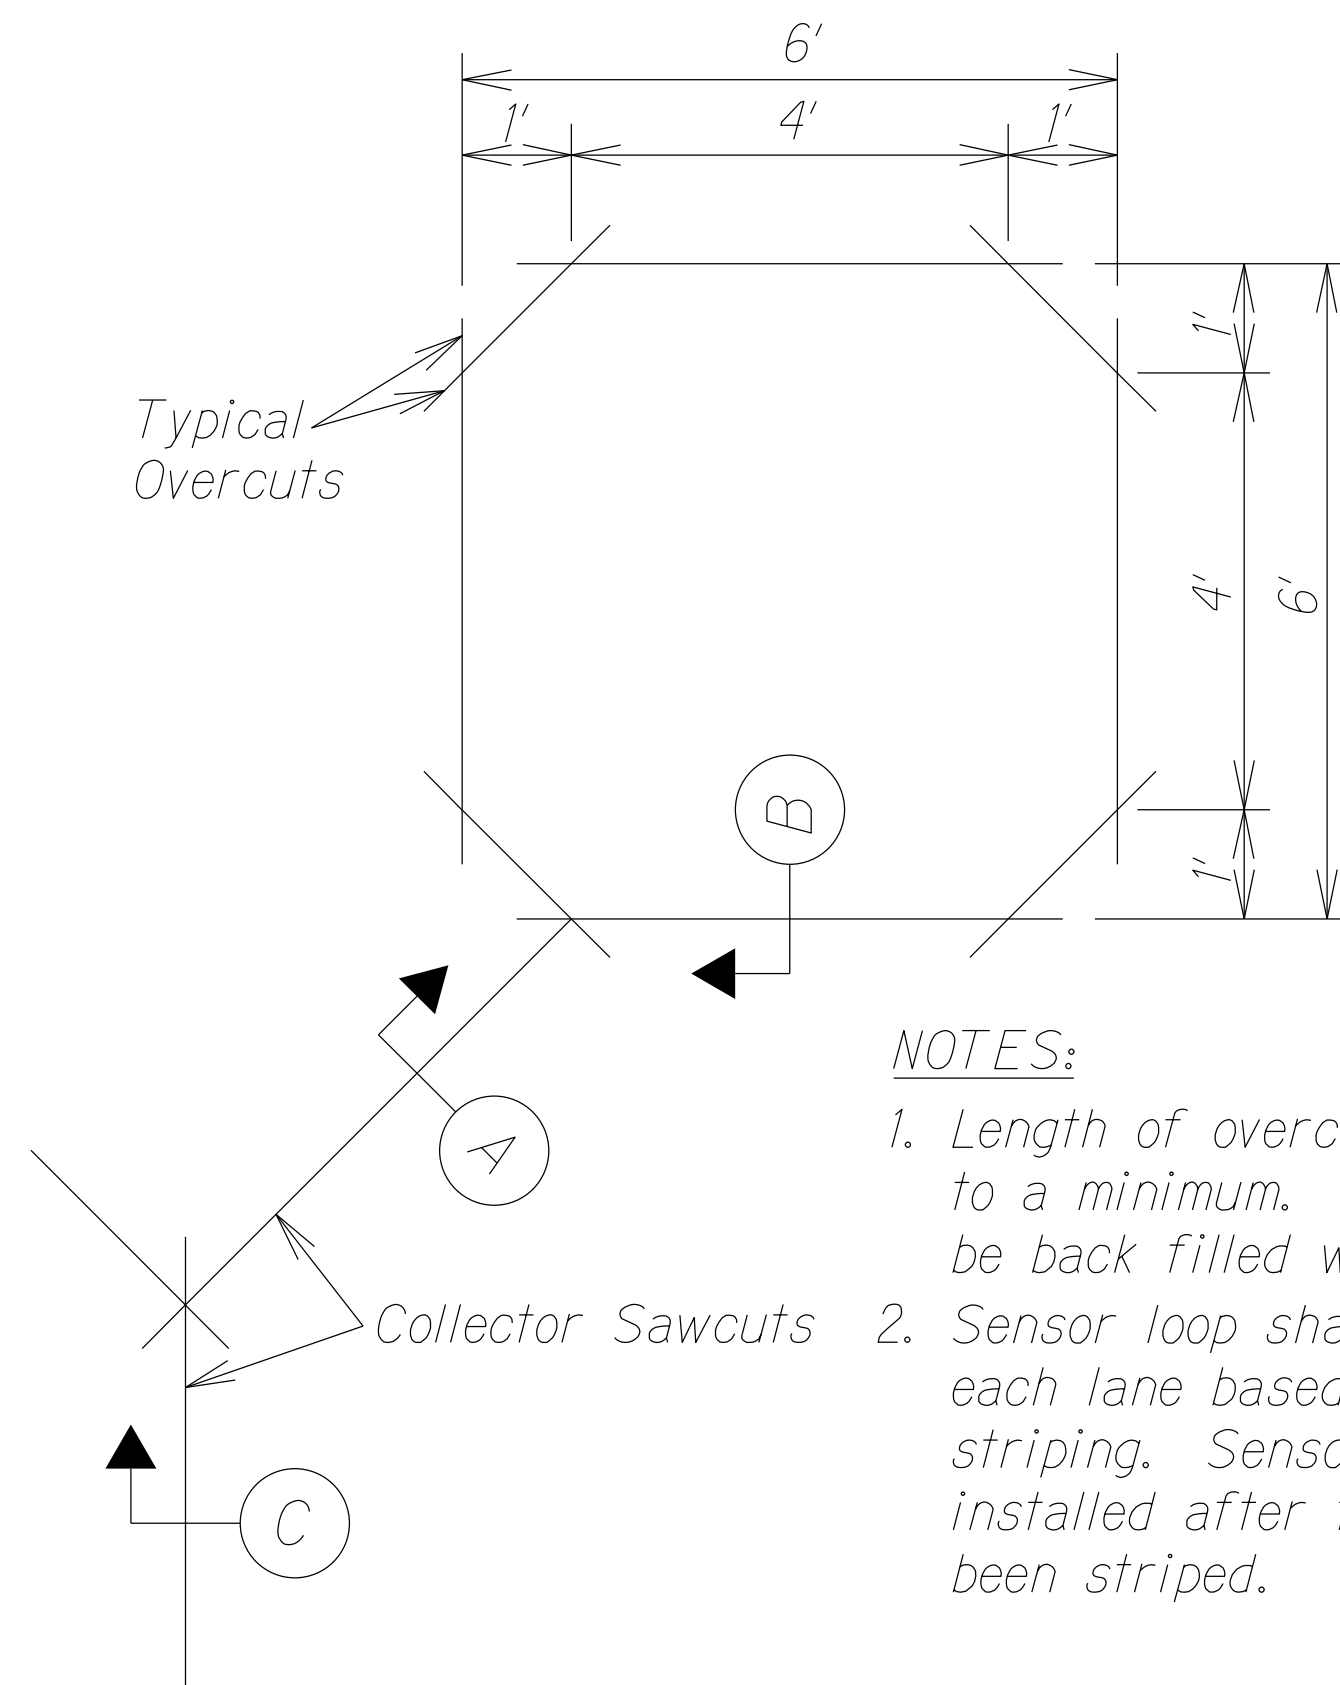


TYPICAL SENSOR LOOP SAWCUT DETAIL
Not to Scale

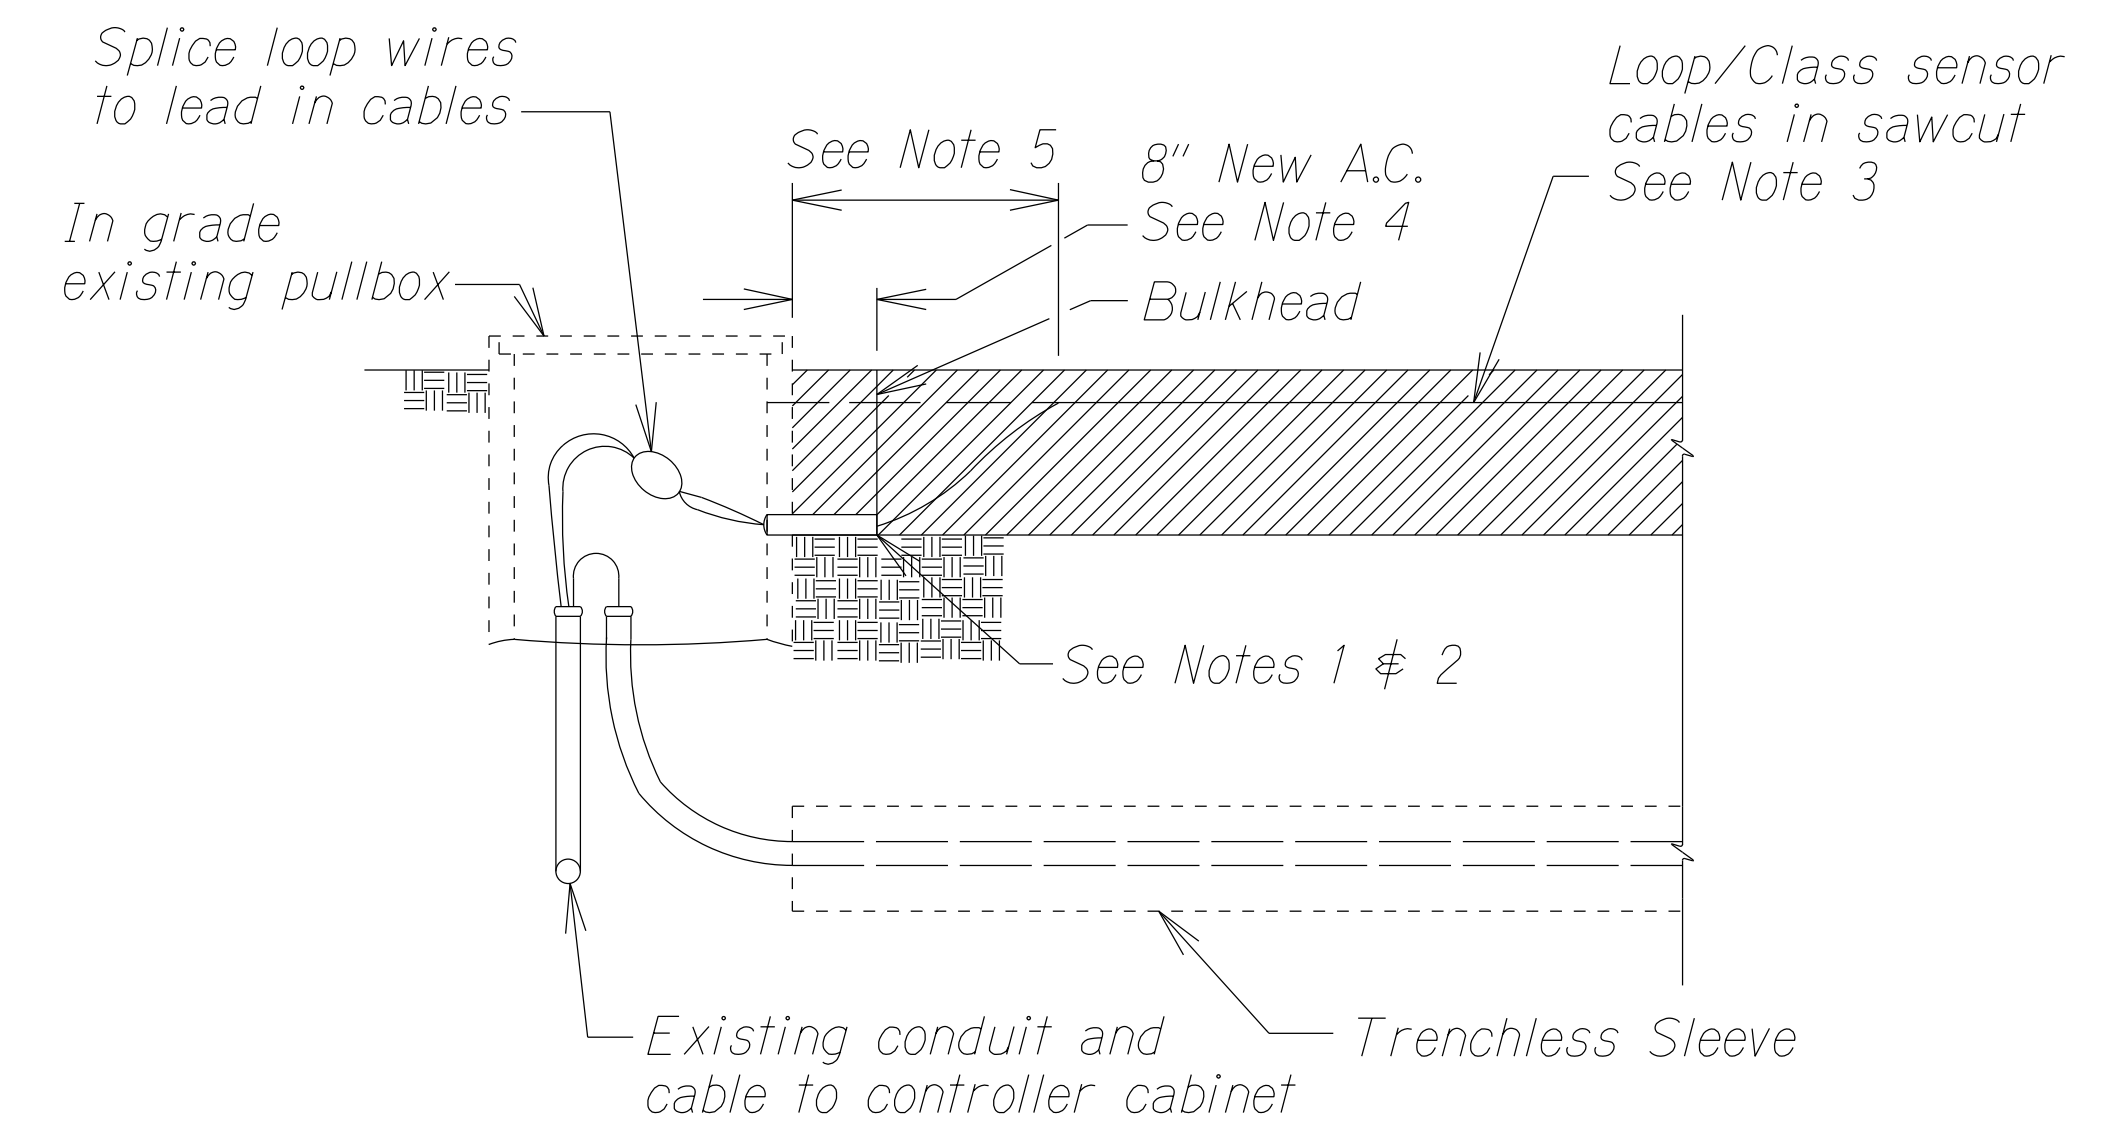

NOTES ON CONSTRUCTION AT END OF SAWCUT:

1. Seal roadway end of conduit after installation of conductors.
2. Install bulkhead across conduit trench.
3. Place hot tar in sawcut.
4. Backfill over conduit with new A.C.
5. Where pavement extends to pullbox, continue sawcut to pullbox location and core side of pullbox for entrance of loop cables. After installation of cables, provide waterproof sealant around cable entrance.

DETAIL OF LOOP DETECTOR INSTALLATION
AT EDGE OF ROADWAY
Not to Scale

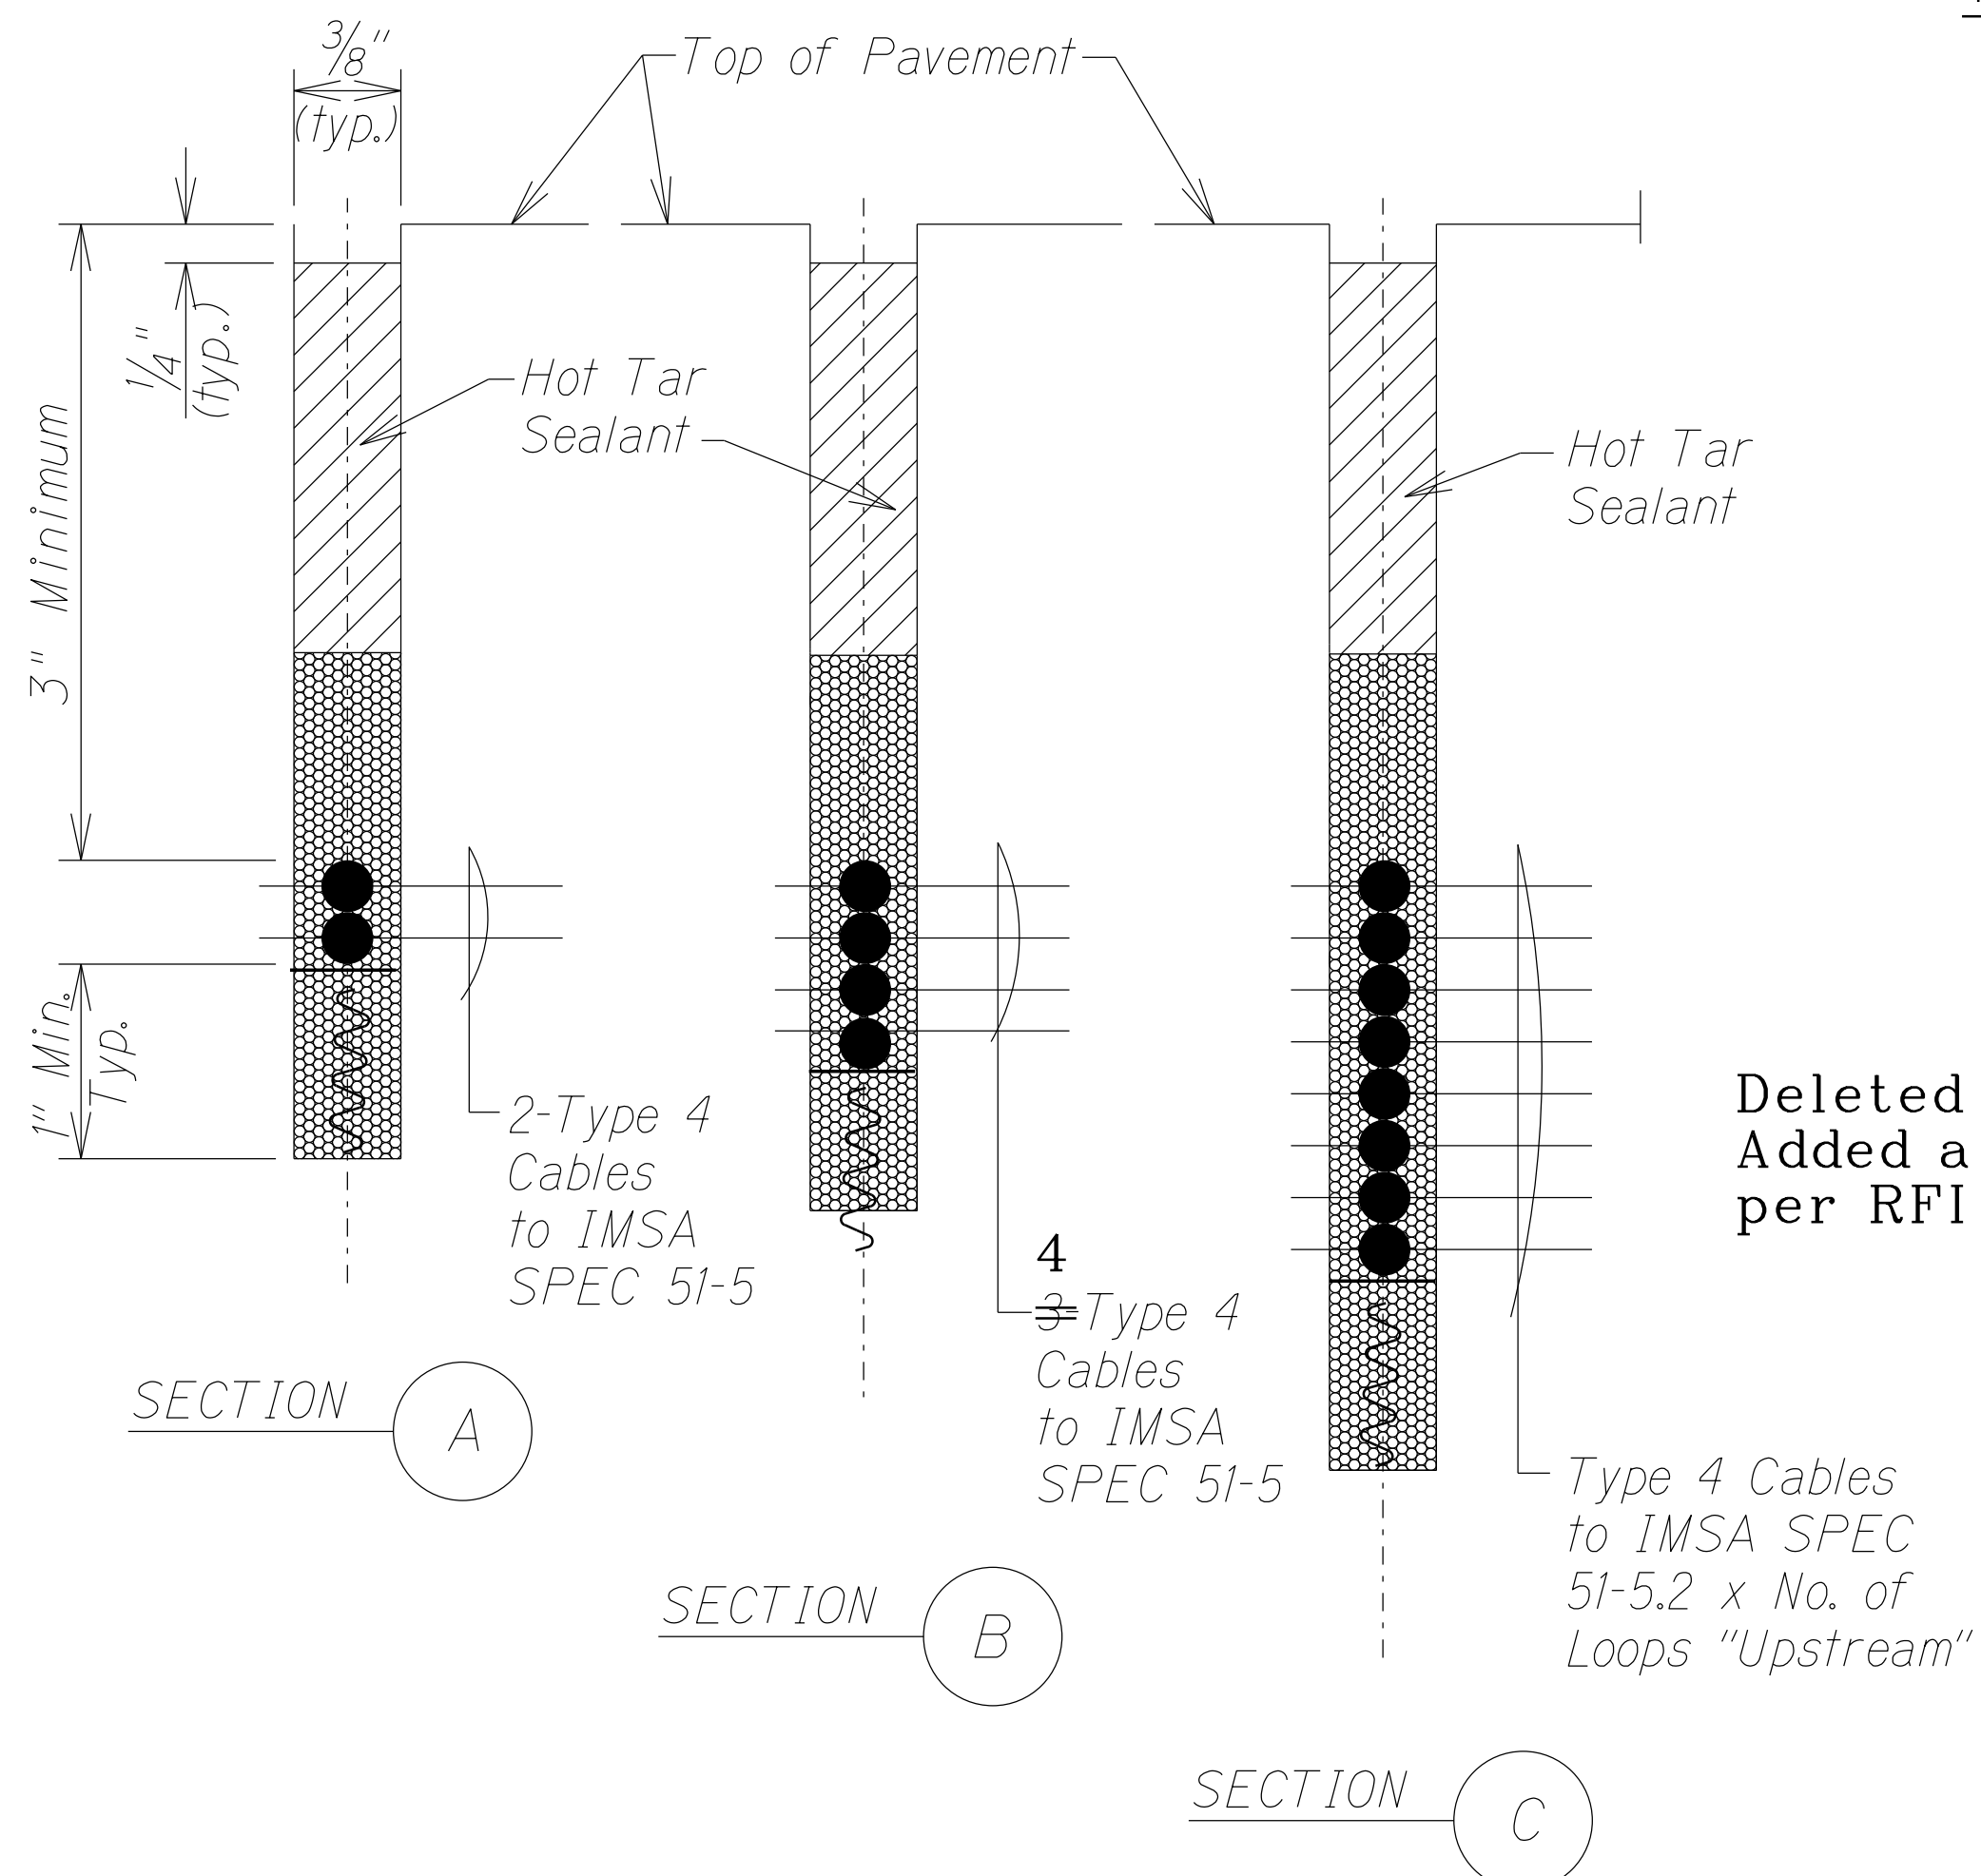

TYPICAL SECTION THROUGH SENSOR LOOP
Not to Scale

LEGEND FOR AS-BUILT POSTINGS	
	Squiggly line for as-built deletion
	Double line for as-built deletion
Roadway	Text for as-built posting

STATE OF HAWAII
DEPARTMENT OF TRANSPORTATION
HIGHWAYS DIVISION
LOOP DETECTOR DETAIL
Vicinity of Halawa Stream Bridge
INTERSTATE ROUTE H-1 FREEWAY
PAVEMENT PRESERVATION
Kaimakani St. to Salt Lake Viaduct
Project No. H-1EF-01-06M
Not to Scale Date: January 2007
SHEET No. T16 OF 16 SHEETS

DATE: _____
SURVEY PLOTTED BY: _____
DRAWN BY: _____
DESIGNED BY: _____
CHECKED BY: _____
NOTE BOOK: 102 new
No. 04hfrd02