




INDEX TO DRAWINGS	
SHEET NO.	DESCRIPTION
1	TITLE SHEET
2	STANDARD PLANS SUMMARY
3	GENERAL NOTES
4-5	WATER POLLUTION & EROSION CONTROL NOTES
6	TYPICAL SECTIONS
7 - 14	ROADWAY PLANS
15	PAVEMENT MARKINGS LEGEND, DETAILS & NOTES
16	FREEWAY WORK ZONE SIGNING PLAN, NOTES & DETAILS
17 - 24	PAVEMENT MARKING & SIGNING PLAN
25 - 28	LOOP DETECTOR PLAN
29 - 30	LOOP DETECTOR DETAIL
31	INDEX, ABBREVIATIONS, SYMBOLS AND BRIDGE GENERAL NOTES
32 - 34	HALAWA INTERCHANGE STRUCTURE NO. 3
35	END POST UPGRADE DETAILS SECTIONS
36 - 38	HALAWA INTERCHANGE STRUCTURE NO. 15
39	END POST UPGRADE DETAILS - TYPICAL SECTIONS & PARTIAL ISOMETRIC VIEW
40	END POST UPGRADE DETAILS - METAL GUARDRAIL TYPE 3 THRIE BEAM & APPURTENANCES DETAILS

STATE OF HAWAII
DEPARTMENT OF TRANSPORTATION
HIGHWAYS DIVISION
HONOLULU, HAWAII
"AS-BUILT"
PLANS FOR
**INTERSTATE ROUTE H-1
RESURFACING**
KAIMAKANI STREET TO SALT LAKE VIADUCT
PROJECT NO. H-1EF-01-06MR
DISTRICT OF EWA
ISLAND OF OAHU

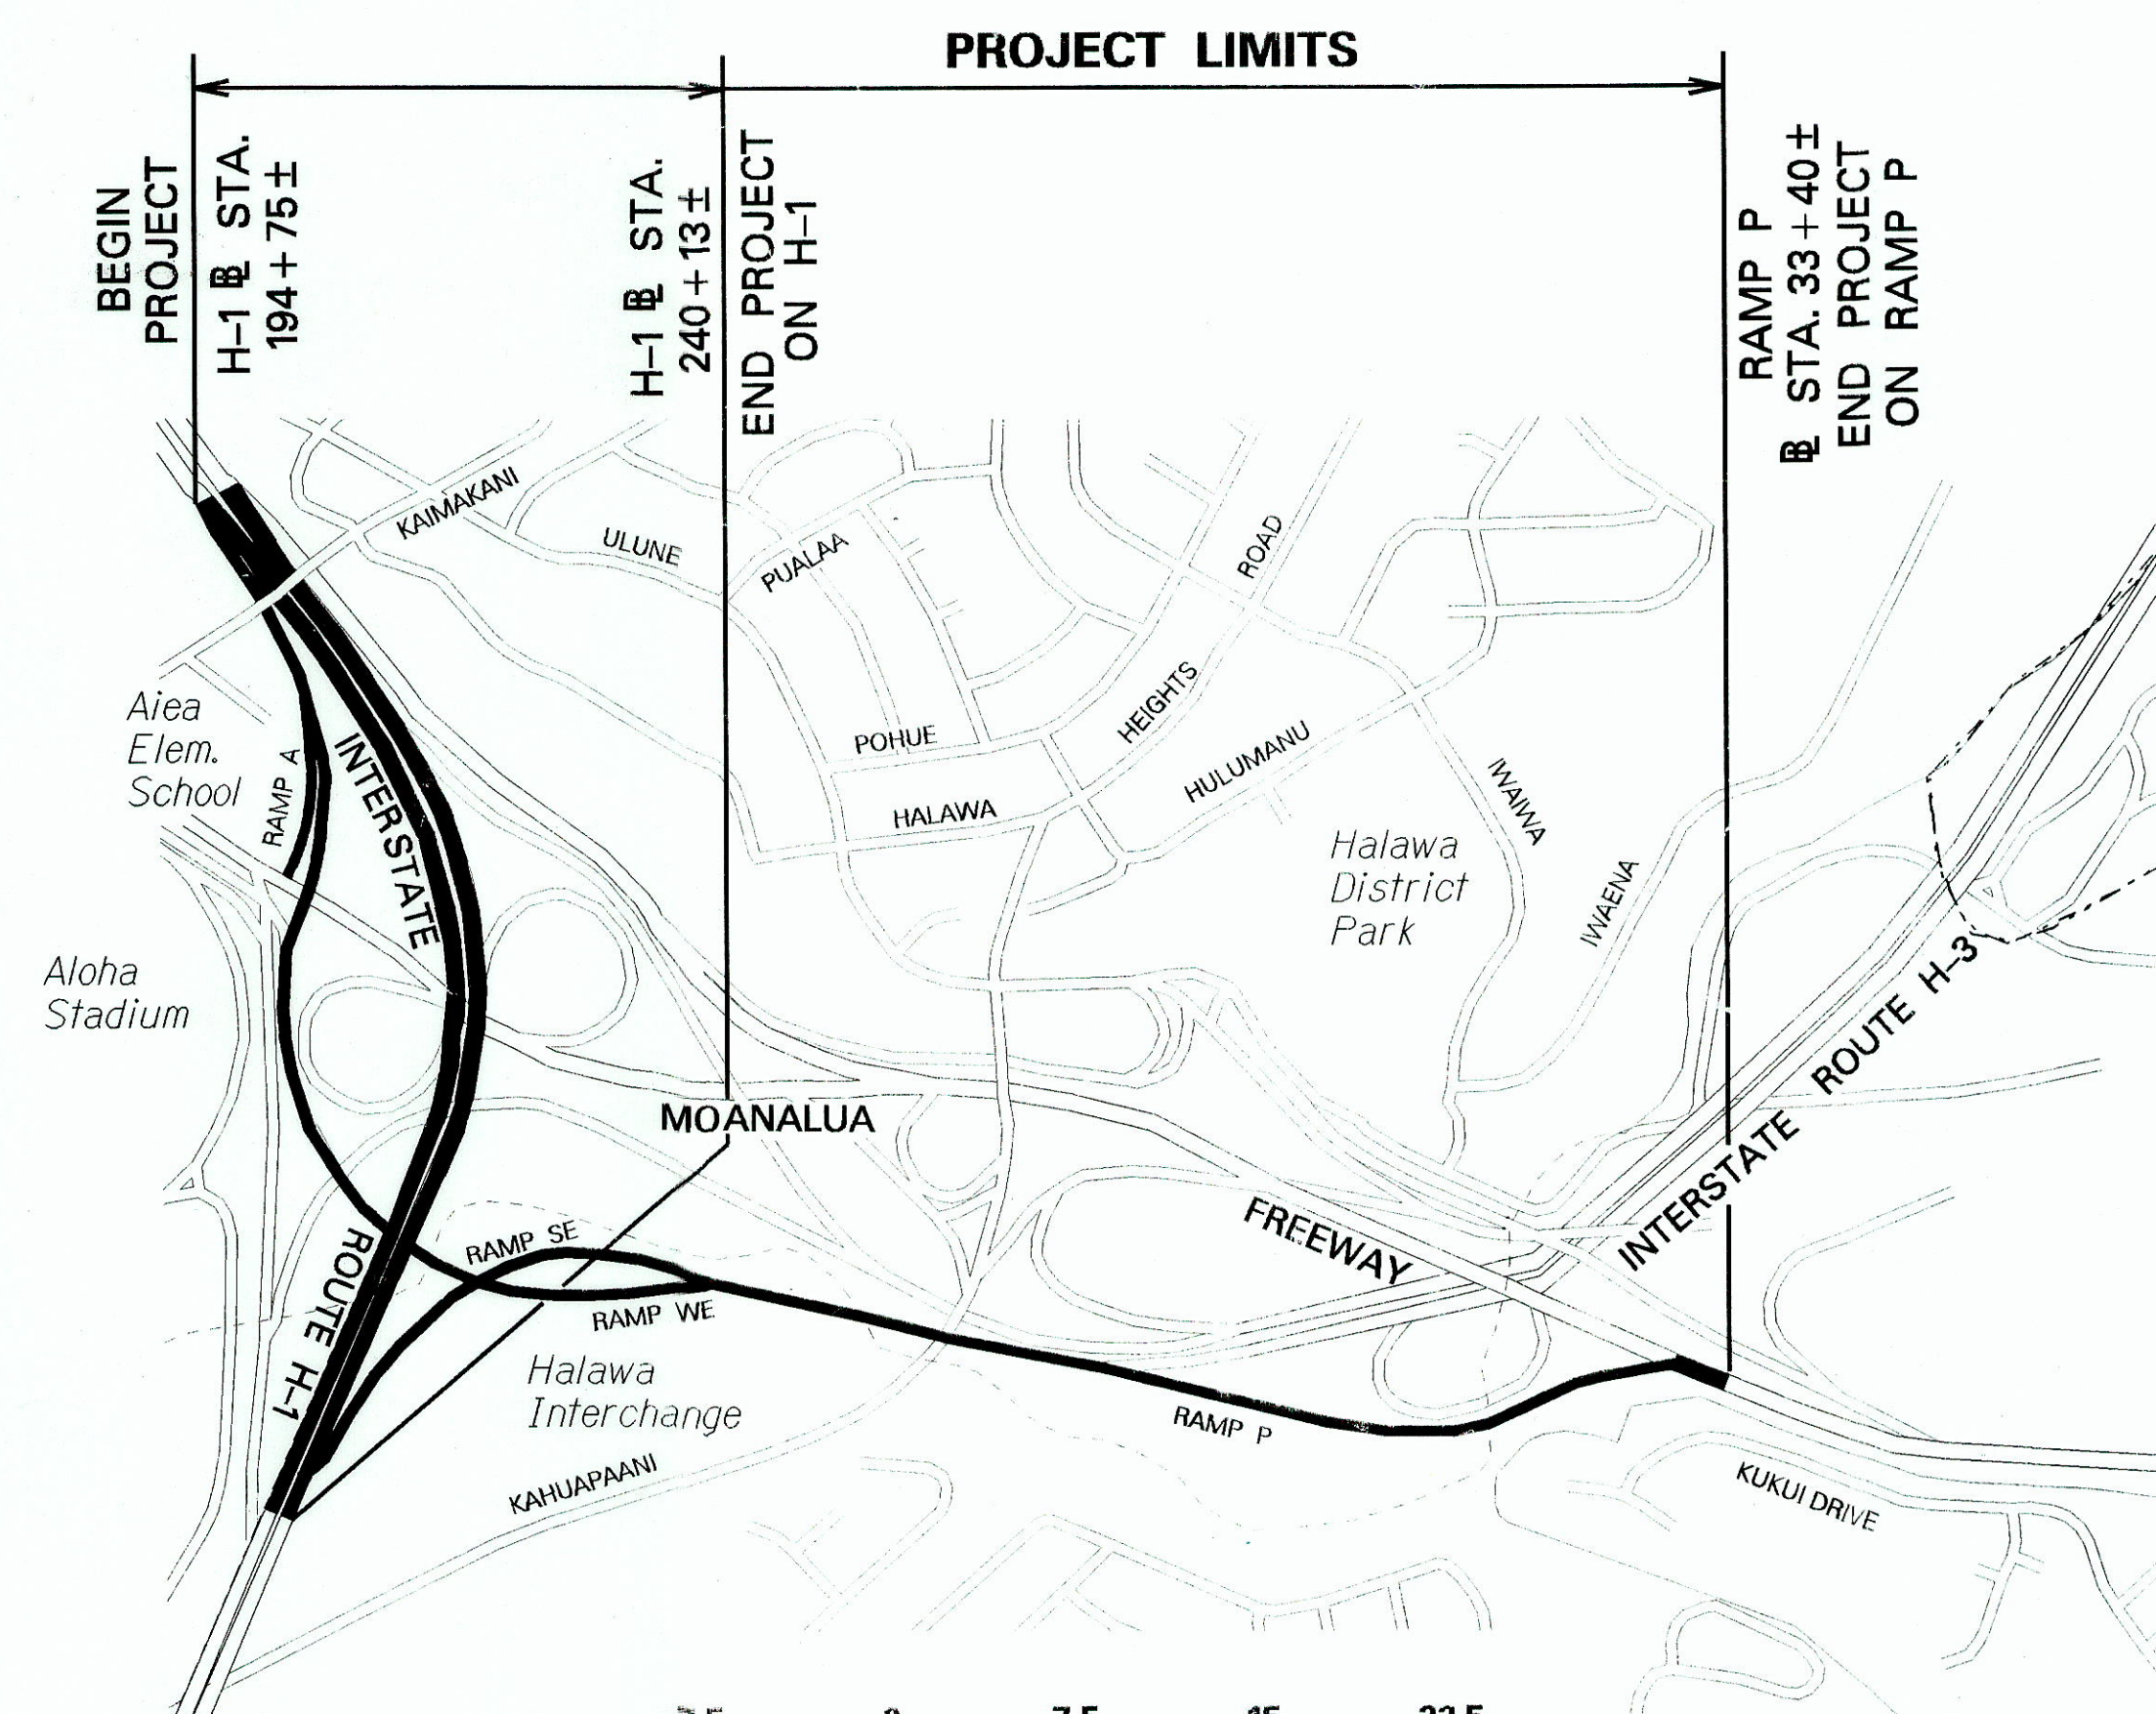

SCALE IN HUNDRED FEET
LAYOUT PLAN
GROSS LENGTH OF PROJECT..... 2.29 MILES
NET LENGTH OF PROJECT..... 1.94 MILES

FED. ROAD DIST. NO.	STATE	PROJ. NO.	FISCAL YEAR	SHEET NO.	TOTAL SHEETS
HAWAII	HAW.	H-1EF-01-06MR	2009	1	40

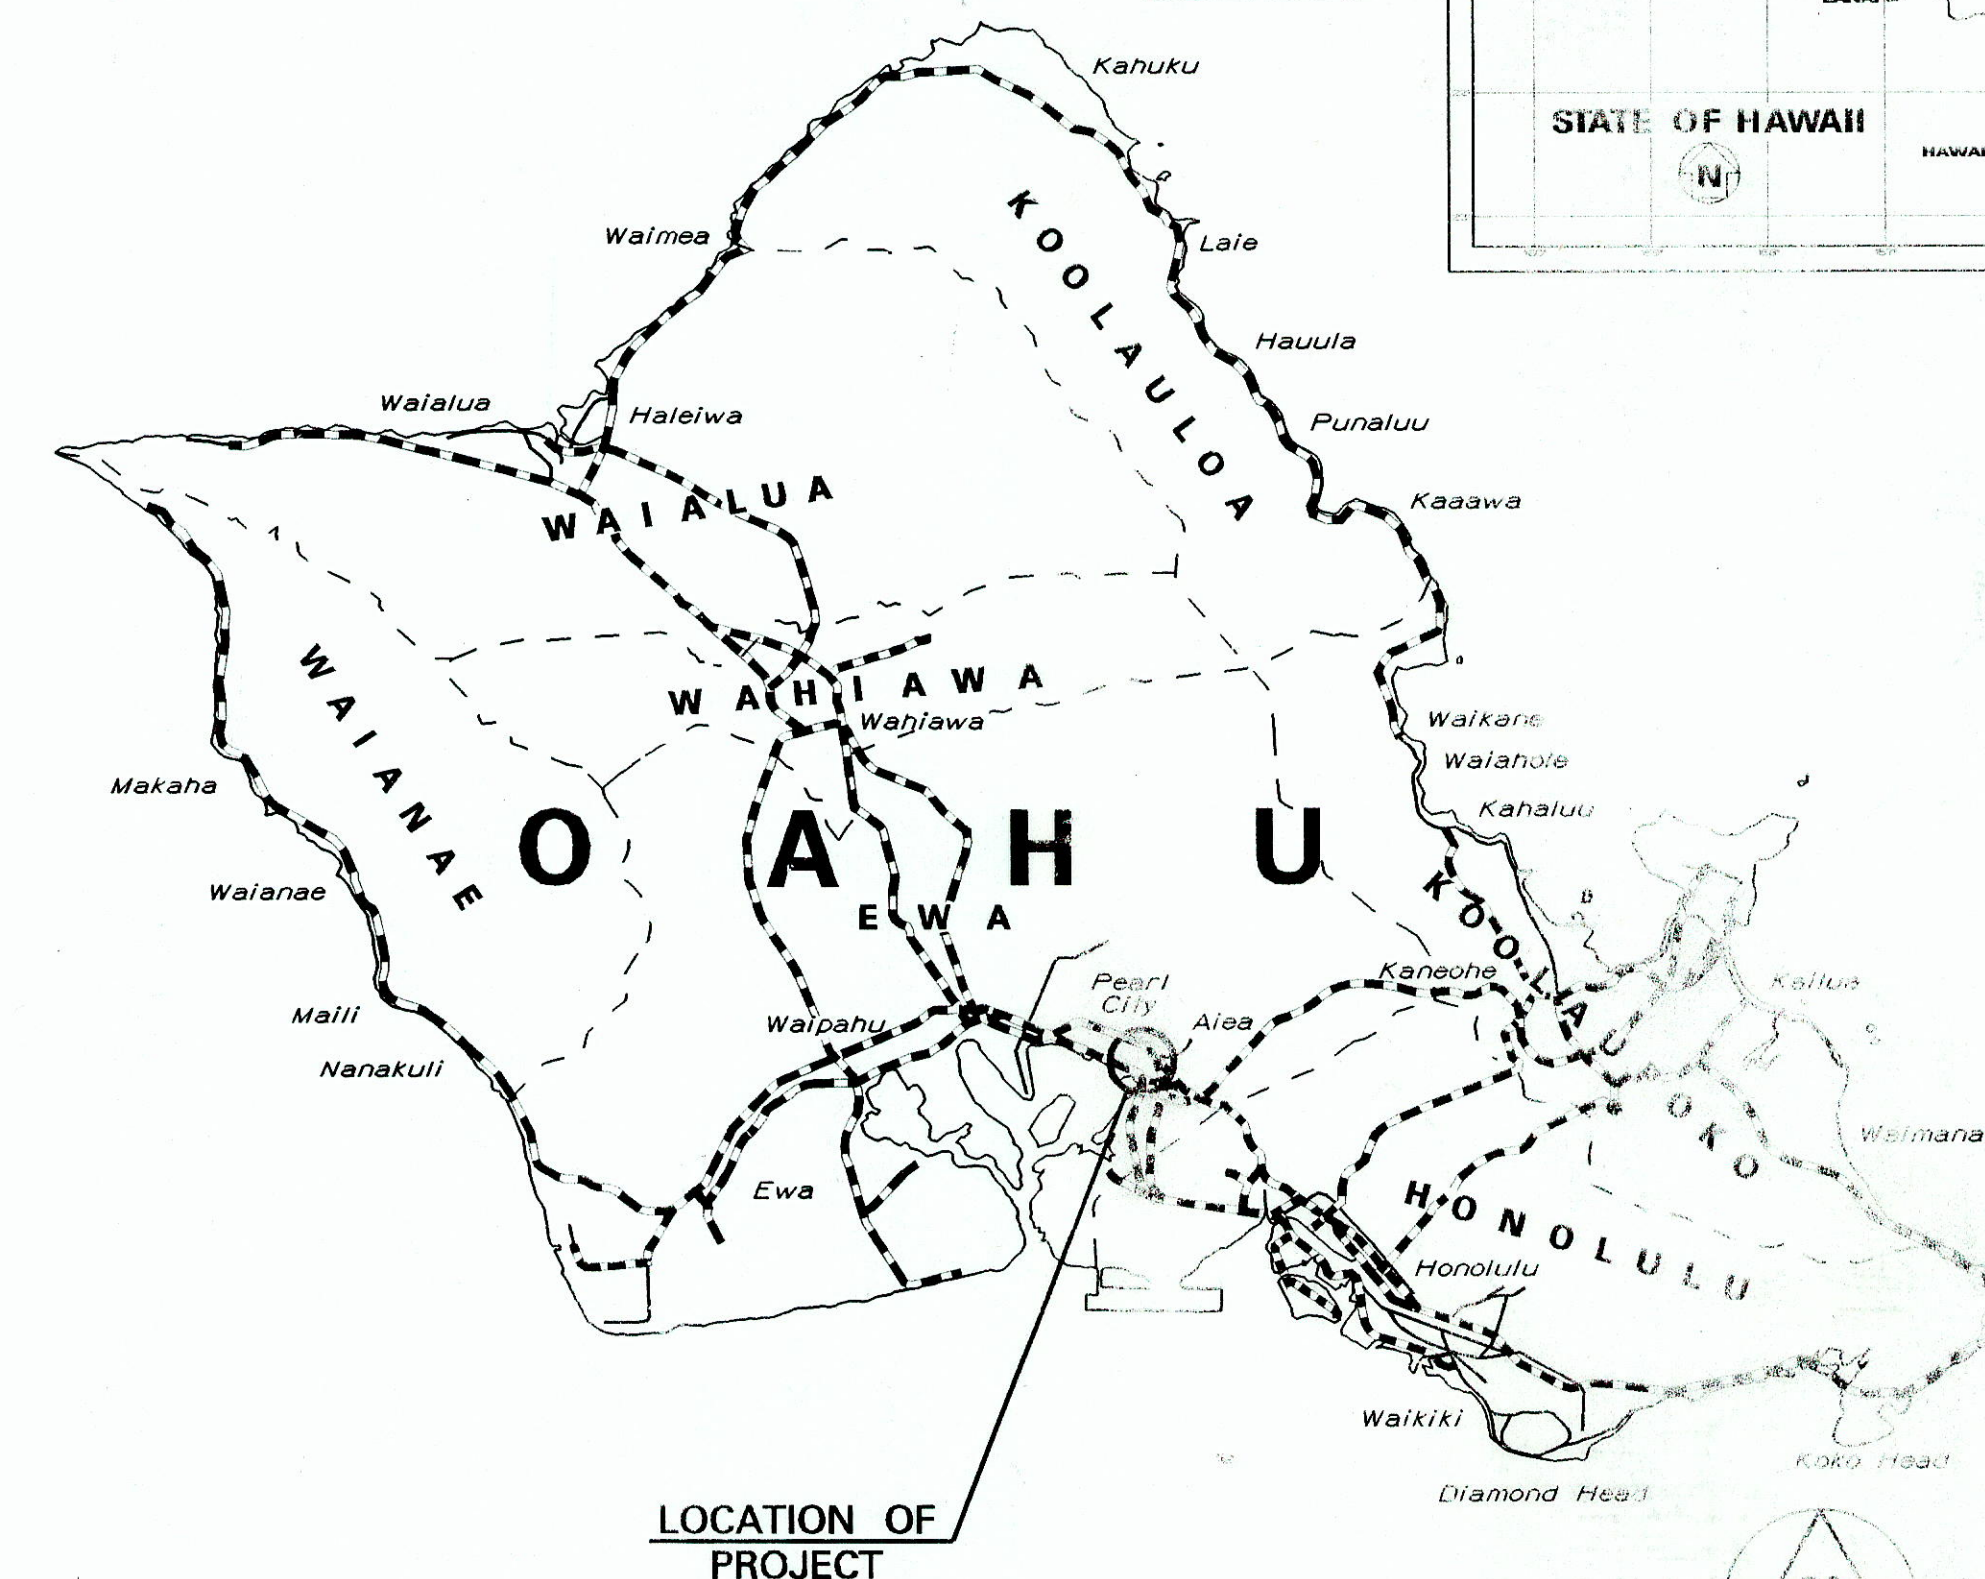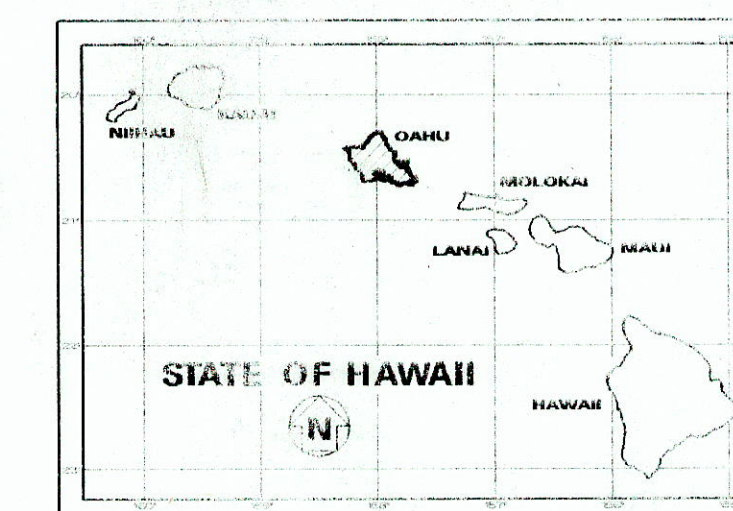

H1 MILE POST ~~12.84~~ TO MILE POST 13.70

DESIGN DESIGNATION

ADT (2007)..... 144,000
ADT (2007)..... 187,000
DHV 15,900
D 80/20
T 3.0
T₂₄ 3.5
V 60 M.P.H.

CHANGES MADE DURING CONSTRUCTION HAVE BEEN INCORPORATED ON THESE PLANS EXCEPT CHANGES IN THE ORIGINAL THEORETICAL QUANTITIES. FOR ACTUAL QUANTITIES, REFER TO PROJECT LEDGER AND/OR COMPUTATION BOOK.

[Signature]
RESIDENT ENGINEER

12/13/09
DATE

DEPARTMENT OF TRANSPORTATION
STATE OF HAWAII

APPROVED:
[Signature] 1/13/09
DIR. OF TRANSPORTATION DATE

DESIGNED BY
HAWY-D
MANAGED BY
HWY-DD
PHONE
692-7570
DATE
MAY 2008