


TYPICAL ROADWAY SECTION


Scale: Not to Scale

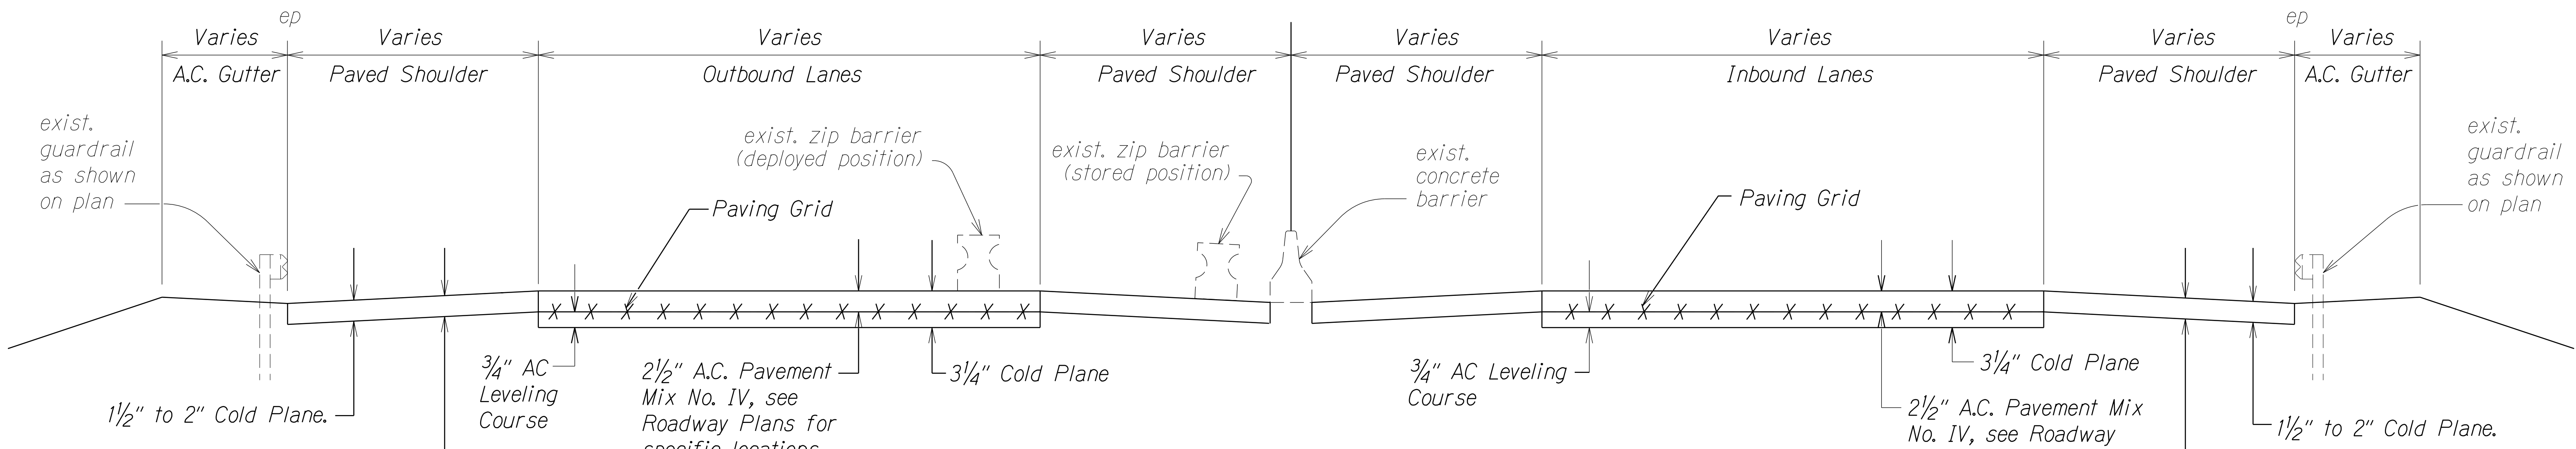

TYPICAL ROADWAY SECTION

± STA. 220+50 to ± STA. 226+00

Scale: Not to Scale

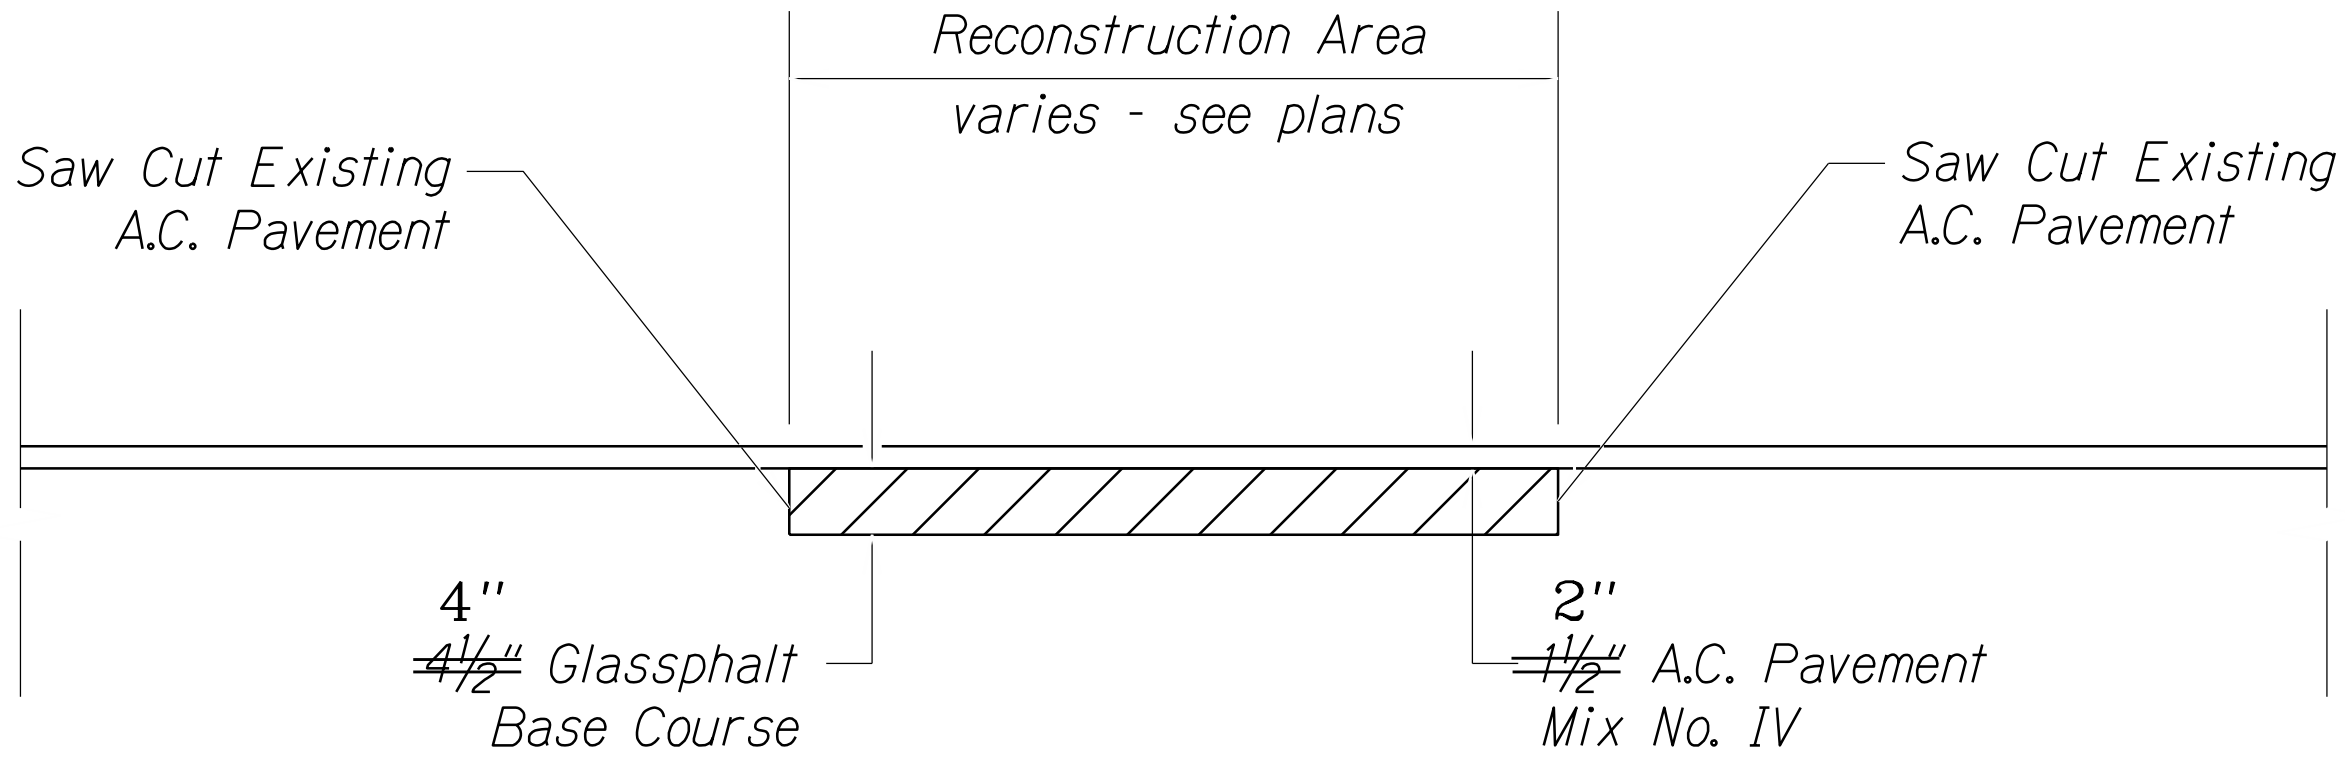

TYPICAL RECONSTRUCTION AREA

Scale: Not to Scale

LEGEND FOR AS-BUILT POSTINGS	
	Squiggly line for as-built deletion
	Double line for as-built deletion
Roadway	Text for as-built posting

4/14/09	Revised Typical Roadway Section ± Sta. 220+00 to ± Sta. 232+00.
DATE	REVISION
STATE OF HAWAII DEPARTMENT OF TRANSPORTATION HIGHWAYS DIVISION	
TYPICAL SECTIONS	
INTERSTATE ROUTE H-1 RESURFACING Kaimakani Street to Salt Lake Viaduct Project No. H-1EF-01-06MR	
Scale: NTS	Date: November, 2008
SHEET No. 1 OF 1 SHEETS	

SURVEY PLOTTED BY	DATE
DRAWN BY	
DESIGNED BY	
CHECKED BY	
ORIGINAL PLAN	
NOTE BOOK	
QUANTITIES BY	
CHECKED BY	